

LAS VIRGENES MUNICIPAL
WATER DISTRICT
LOS ANGELES COUNTY

TRIUNFO COUNTY
SANITATION DISTRICT
VENTURA COUNTY

CONTRACT DOCUMENTS
FOR CONSTRUCTION OF

FILTRATION/DISINFECTION ADDITION
PHASE II-CHEMICAL BUILDING

CONTRACT NO. C-8

CLEAN WATER GRANT
PROJECT NO. C-06-1028-630-01

LAS VIRGENES MUNICIPAL WATER DISTRICT

BOARD OF DIRECTORS
BEN DORGELO-PRESIDENT
A. MACNEIL STELLE
HAROLD V. HELSLEY
RICHARD B. BAIRD-GENERAL MANAGER
ANTHONY K. ELLSWORTH
GEORGE R. LONG

Approved by the Board of Directors
on this TENTH day of AUGUST 1981

By: Ben Dorgelo
BEN DORGELO-PRESIDENT

By: Anthony K. Ellsworth
ANTHONY K. ELLSWORTH-SECRETARY

By: H.W. Stokes
H.W. STOKES-CHIEF ENGINEER

**1979 ADDITIONS-MODIFICATIONS
TAPIA WATER RECLAMATION FACILITY**

VOLUME 2 OF 2-PLANS

DESIGN ENGINEERS

JMM JAMES M. MONTGOMERY, CONSULTING ENGINEERS, INC.

TRIUNFO COUNTY SANITATION DISTRICT

BOARD OF DIRECTORS
EDWIN A. JONES-CHAIRMAN
JAMES DOUGHERTY
MAGGIE ERICKSON
LAWRENCE E. HORNER
GERALDINE ANDREWS
RONALD STARK
JOHN FLYNN

Approved by the Board of Directors
on this 27 day of July 1981

By: Ed Jones
EDWIN A. JONES-CHAIRMAN




By: John Lambie
JOHN LAMBIE-DISTRICT ENGINEER

Recommended: Eric J. Oltmann
ERIC J. OLTMANN-ADMINISTRATIVE ENGINEERING ASSOC.

03539

RECORD DRAWING

870 6090 0001
IDENT. NO.

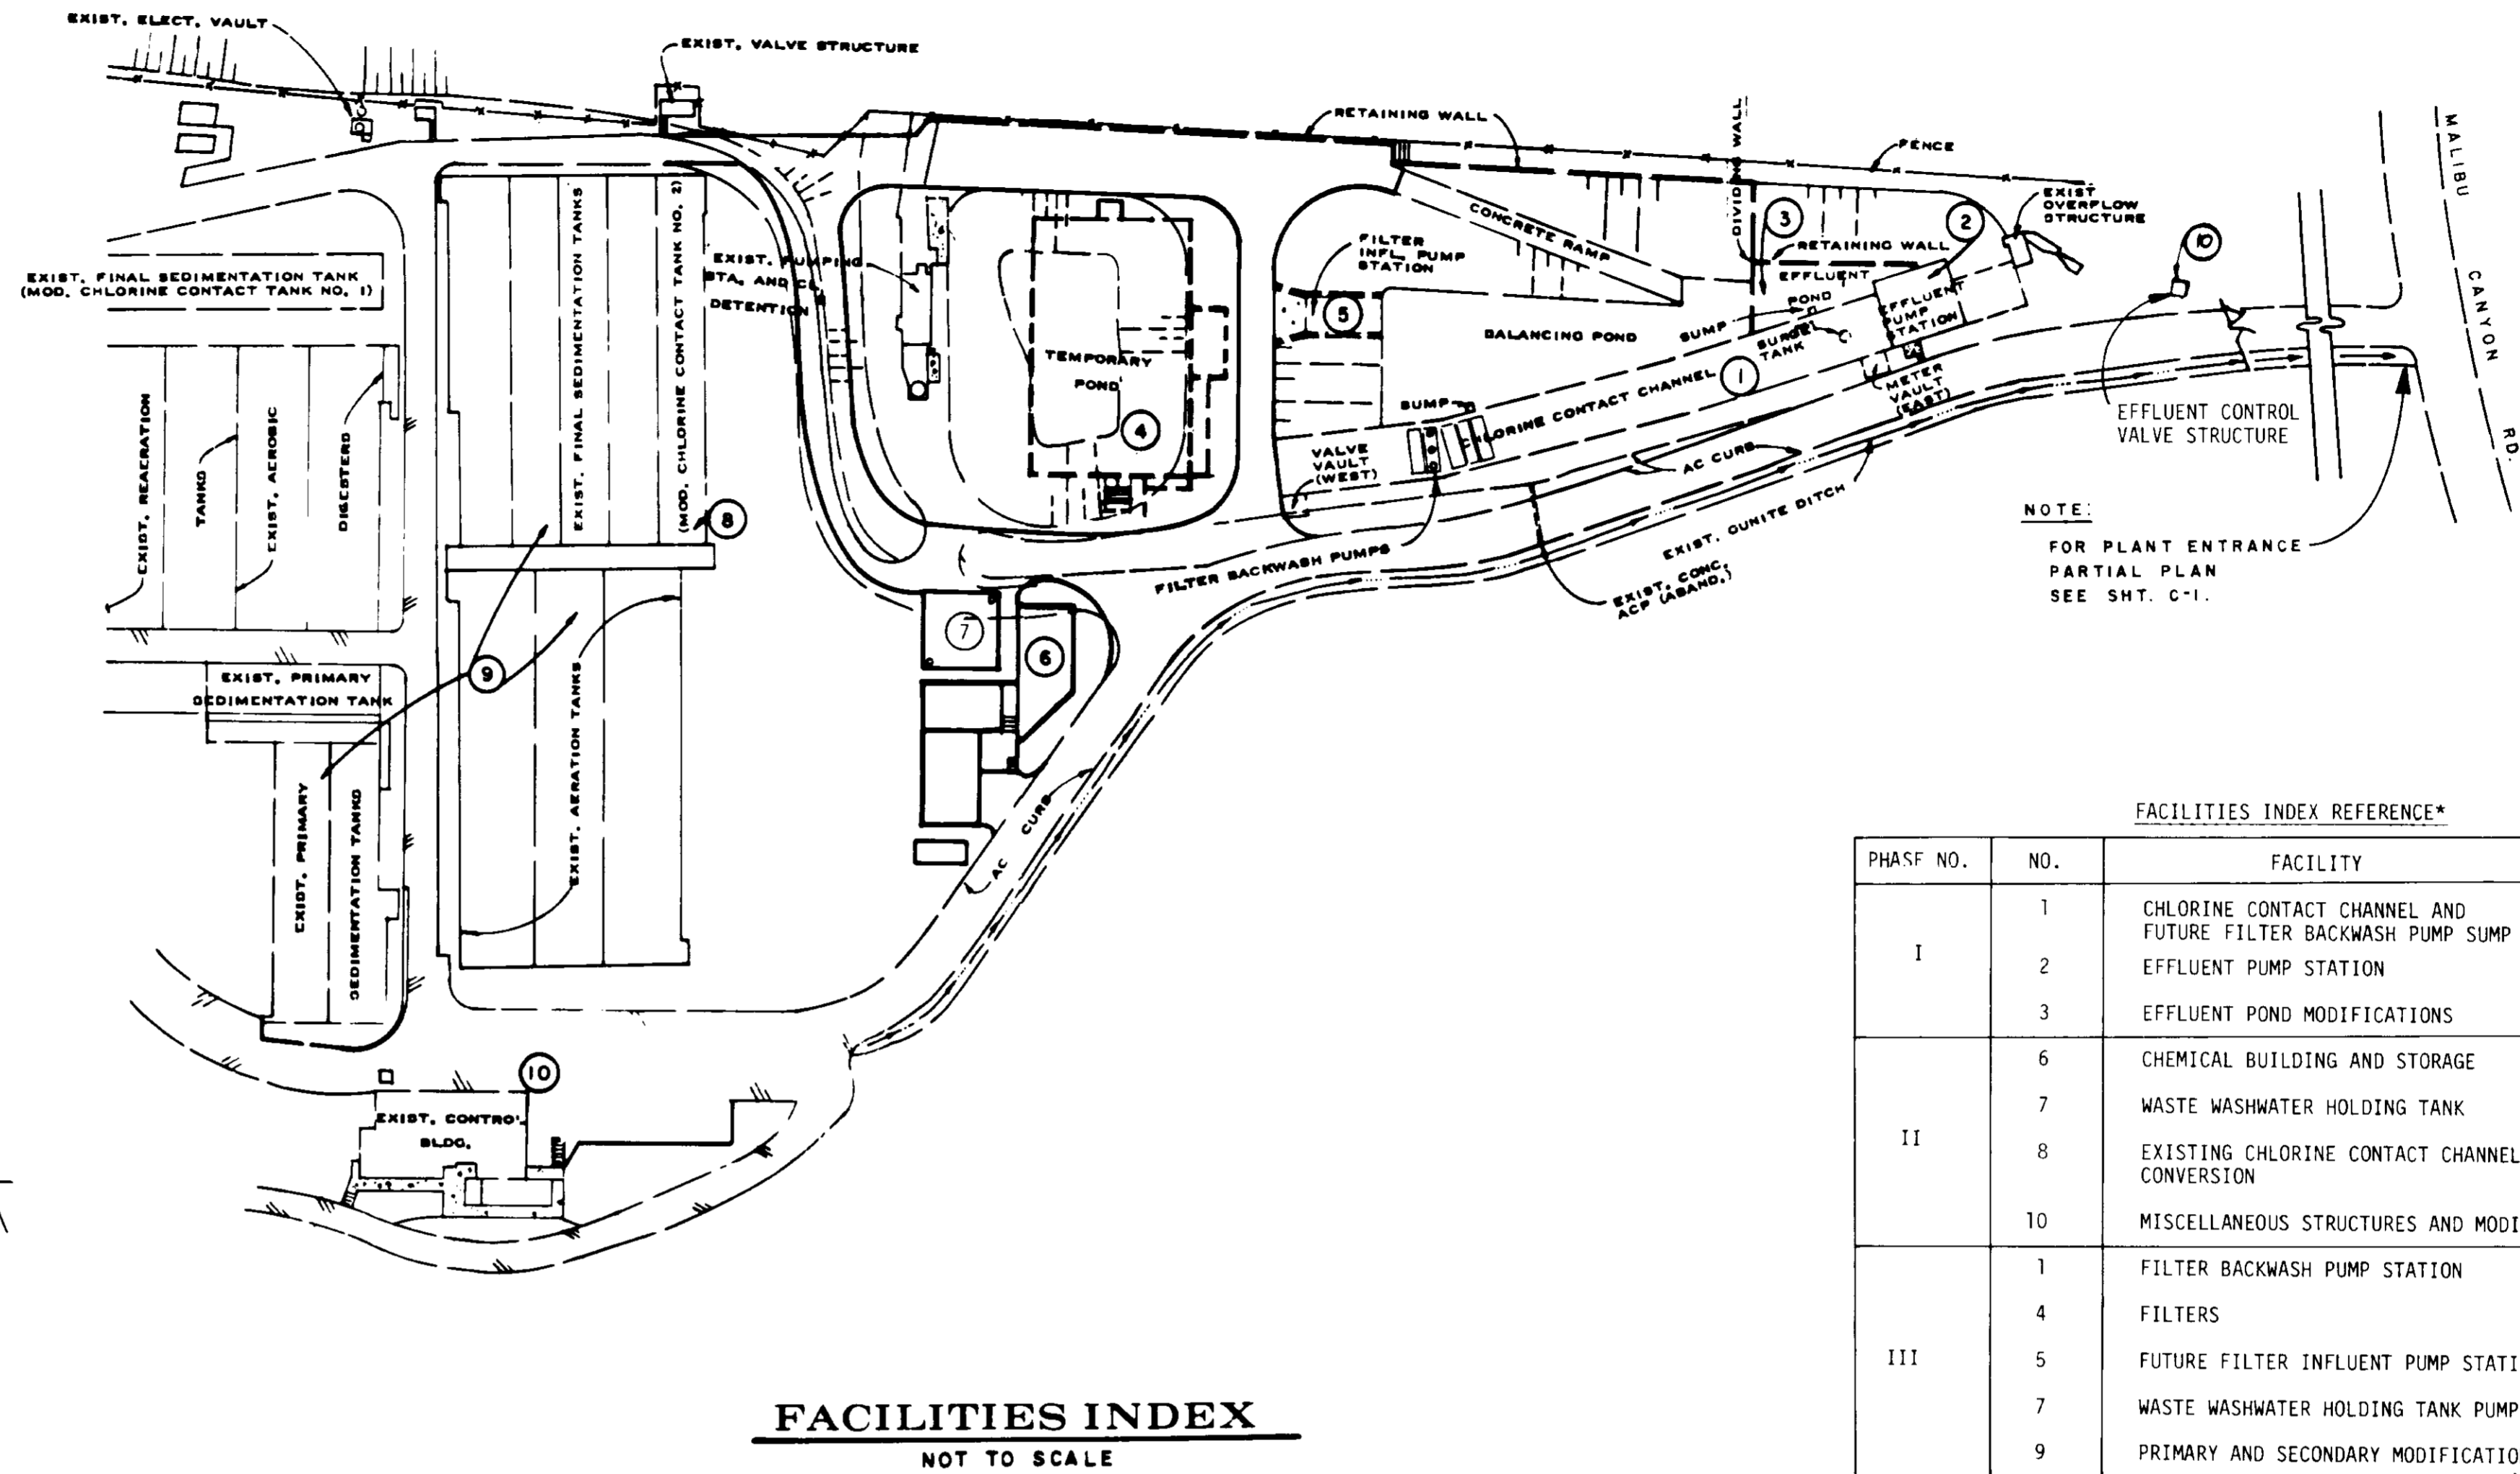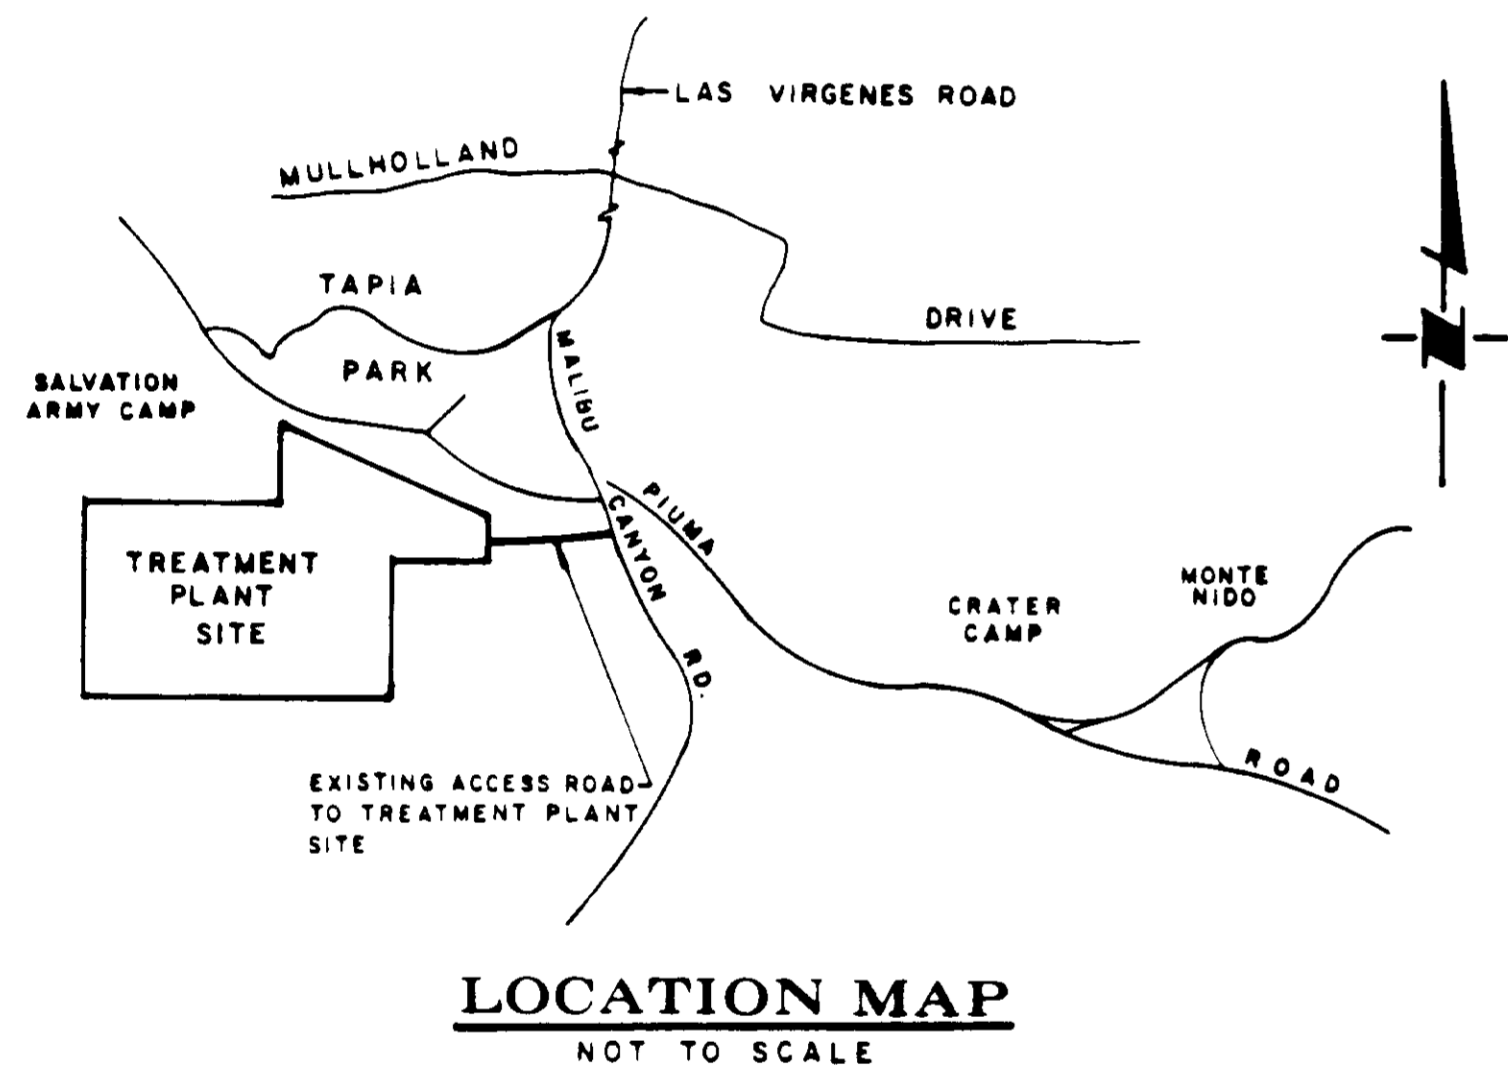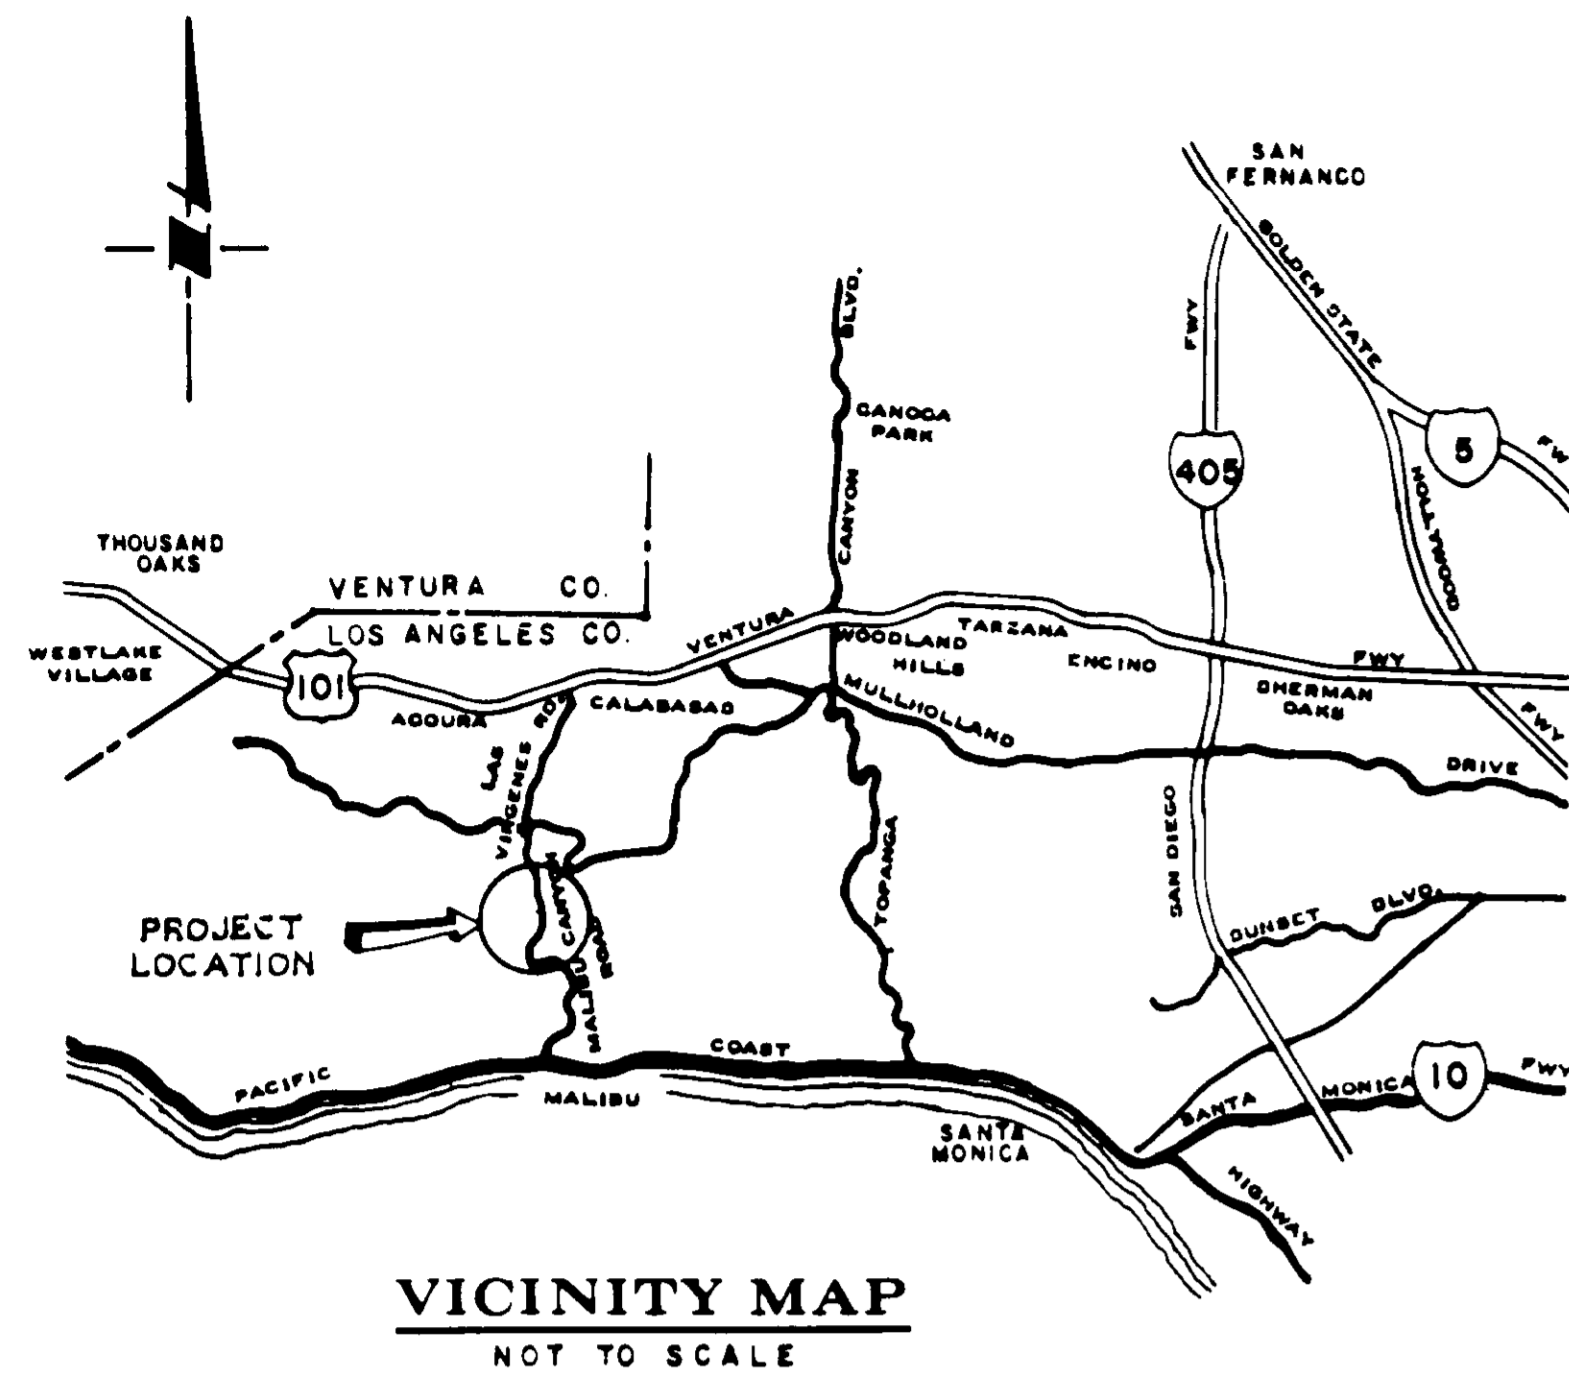

NOTE:
FOR PLANT ENTRANCE
PARTIAL PLAN
SEE SHT. C-1.

FACILITIES INDEX REFERENCE*		
PHASE NO.	NO.	FACILITY
I	1	CHLORINE CONTACT CHANNEL AND FUTURE FILTER BACKWASH PUMP SUMP
	2	EFFLUENT PUMP STATION
	3	EFFLUENT POND MODIFICATIONS
II	6	CHEMICAL BUILDING AND STORAGE
	7	WASTE WASHWATER HOLDING TANK
	8	EXISTING CHLORINE CONTACT CHANNEL CONVERSION
	10	MISCELLANEOUS STRUCTURES AND MODIFICATIONS
III	1	FILTER BACKWASH PUMP STATION
	4	FILTERS
	5	FUTURE FILTER INFLUENT PUMP STATION
	7	WASTE WASHWATER HOLDING TANK PUMP STATION
	9	PRIMARY AND SECONDARY MODIFICATIONS

*NOTE: FOR REFERENCE ONLY, ALL DRAWINGS CONTAINED IN THIS DOCUMENT PERTAIN TO PHASE II.

LIST OF DRAWINGS

DRAWING NO.	TITLE	DRAWING NO.	TITLE	DRAWING NO.	TITLE	DRAWING NO.	TITLE		
GENERAL									
G-1	LOCATION AND VICINITY MAP, FACILITIES INDEX, AND LIST OF DRAWINGS	C-1	SITE GRADING AND PAVING PLAN	6M-1	CHEMICAL BUILDING AND STORAGE - PIPING PLAN	6S-2	CHEMICAL BUILDING - MISCELLANEOUS WALL SECTIONS AND DETAILS		
G-2	HYDRAULIC PROFILE AND DESIGN CRITERIA	C-2	GRADING AND PAVING PLAN, SECTIONS AND DETAILS	6M-2	CHEMICAL BUILDING AND STORAGE - PIPING SECTIONS, SHEET A	6S-3	CHEMICAL BUILDING - WALLS AND ROOF SLAB SECTIONS		
G-3	SYMBOLS	C-3	YARD PIPING PLAN	6M-3	CHEMICAL BUILDING AND STORAGE - PIPING SECTION, SHEET B	6S-4	CHEMICAL BUILDING - ROOF SLAB SECTIONS AND PLATFORM FRAMING DETAILS		
G-4	ABBREVIATIONS	C-4	20" RECLAIMED WATER LINE - PLAN AND DETAILS	6M-4	CHEMICAL BUILDING AND STORAGE - HEATING, VENTILATING, AND DRAINAGE	6S-5	CHEMICAL BUILDING - TANK SUPPORT DETAILS		
ARCHITECTURAL									
A-1	ARCHITECTURAL SCHEDULES, NOTES, AND DETAILS	C-5	20" RECLAIMED WATER LINE - PROFILE AND DETAILS	8M-1	EXISTING CHLORINE CONTACT - CHANNEL CONVERSION - PLANS AND SECTIONS	6S-6	MODIFICATION OF EXISTING ELECTRICAL PULL BOXES		
6A-1	CHEMICAL BUILDING - PLAN	C-6	DETAILS AND OUTFALL STRUCTURE PLAN AND PIPING PROFILE	3M-2	EXISTING CHLORINE CONTACT - CHANNEL CONVERSION - DETAILS	7S-1	WASTE WASHWATER TANK - PLANS AND SECTIONS		
6A-2	CHEMICAL BUILDING - ELEVATIONS AND SECTIONS	C-7	MISCELLANEOUS YARD PIPING DETAILS - A	10M-1	MISCELLANEOUS MODIFICATIONS - RESERVOIR OUTLETS	7S-2	WASTE WASHWATER TANK - SECTIONS AND DETAILS		
6A-3	CHEMICAL BUILDING - INTERIOR ELEVATIONS AND DETAILS	C-8	MISCELLANEOUS YARD PIPING DETAILS - B	10M-2	EFFLUENT CONTROL VALVE STRUCTURE	8S-1	ACCESS STAIRS TO EXISTING CHLORINE CONTACT TANK		
LANDSCAPE									
L-1	LANDSCAPE PLAN	MECHANICAL		10M-3	EFFLUENT CONTROL VALVE STRUCTURE	10S-1	OUTFALL STRUCTURE AND RETAINING WALL DETAILS		
L-2	IRRIGATION PLAN	M-1	PROCESS FLOW DIAGRAM	STRUCTURAL					
L-3	LEGEND AND DETAILS	M-2	PIPING SCHEDULE	S-1	GENERAL NOTES AND CONSTRUCTION JOINT DETAILS	ELECTRICAL			
L-4	ENTRANCE ROAD PLANTING AND IRRIGATION PLAN	M-3	PUMP, FEEDER, AND TANK SCHEDULES	S-2	MISCELLANEOUS REINFORCEMENT DETAILS	E-1	ELECTRICAL SYMBOLS AND ABBREVIATIONS		
		M-4	VALVE, GATE, AND FAN SCHEDULES	S-3	MISCELLANEOUS STRUCTURAL DETAILS	E-2	PLOT PLAN		
		M-5	MISCELLANEOUS MECHANICAL EQUIPMENT AND METER SCHEDULES	S-4	MISCELLANEOUS METALWORK DETAILS	E-3	SINGLE LINE DIAGRAM AND EQUIPMENT ELEVATIONS		
		M-6	MISCELLANEOUS MECHANICAL DETAILS - A	6S-1	CHEMICAL BUILDING - FOUNDATION AND ROOF PLANS	E-4	SCHEMATIC DIAGRAMS		
		M-7	MISCELLANEOUS MECHANICAL DETAILS - B					E-5	CONDUIT AND WIREFILL SCHEDULE
		M-8	MISCELLANEOUS MECHANICAL DETAILS - C					E-6	PANEL AND FIXTURE SCHEDULE
		M-9	MISCELLANEOUS MECHANICAL DETAILS - D					E-7	MISCELLANEOUS DETAILS
		M-10	MISCELLANEOUS MECHANICAL DETAILS - E					6E-1	CHEMICAL BUILDING - LIGHTING AND RECEPTACLE PLAN
		M-11	CHLORINATION AND DECHLORINATION SCHEMATICS					6E-2	CHEMICAL BUILDING - POWER AND CONTROL PLAN

INSTRUMENTATION
 I-1 SYMBOLS AND SYMBOL NOMENCLATURE
 I-2 INSTRUMENTATION LOOP DIAGRAMS
 I-3 LOCAL CONTROL BOARD (LCB-3) - ELEVATION AND DETAILS

CHANGE ORDER
 1. CHEMICAL BUILDING FOOTING REVISION.

03540
RECORD DRAWING

REV	DATE	BY	DESCRIPTION


DESIGNED	J. EFFORT	SUBMITTED	2/23/01	DATE	2/23/01
DRAWN	A. QUINTANA	PROJECT ENGINEER	27304	R.C.E. NO.	
CHECKED	J. W. [Signature]	RECOMMENDED	27633	R.C.E. NO.	
		JAMES M. MONTGOMERY CONSULTING ENGINEERS, INC.			

JAMES M. MONTGOMERY CONSULTING ENGINEERS, INC.
 555 EAST WALNUT STREET, PASADENA, CALIFORNIA 91101

DISTRICT APPROVAL ON TITLE PAGE

LAS VIRGENES MUNICIPAL WATER DISTRICT		SHEET
TAPIA WRF - FILTRATION/DISINFECTION ADDITION		
PHASE II	VICINITY AND LOCATION MAP, FACILITIES INDEX AND LIST OF DRAWINGS	G-1


OF 66 SHEETS

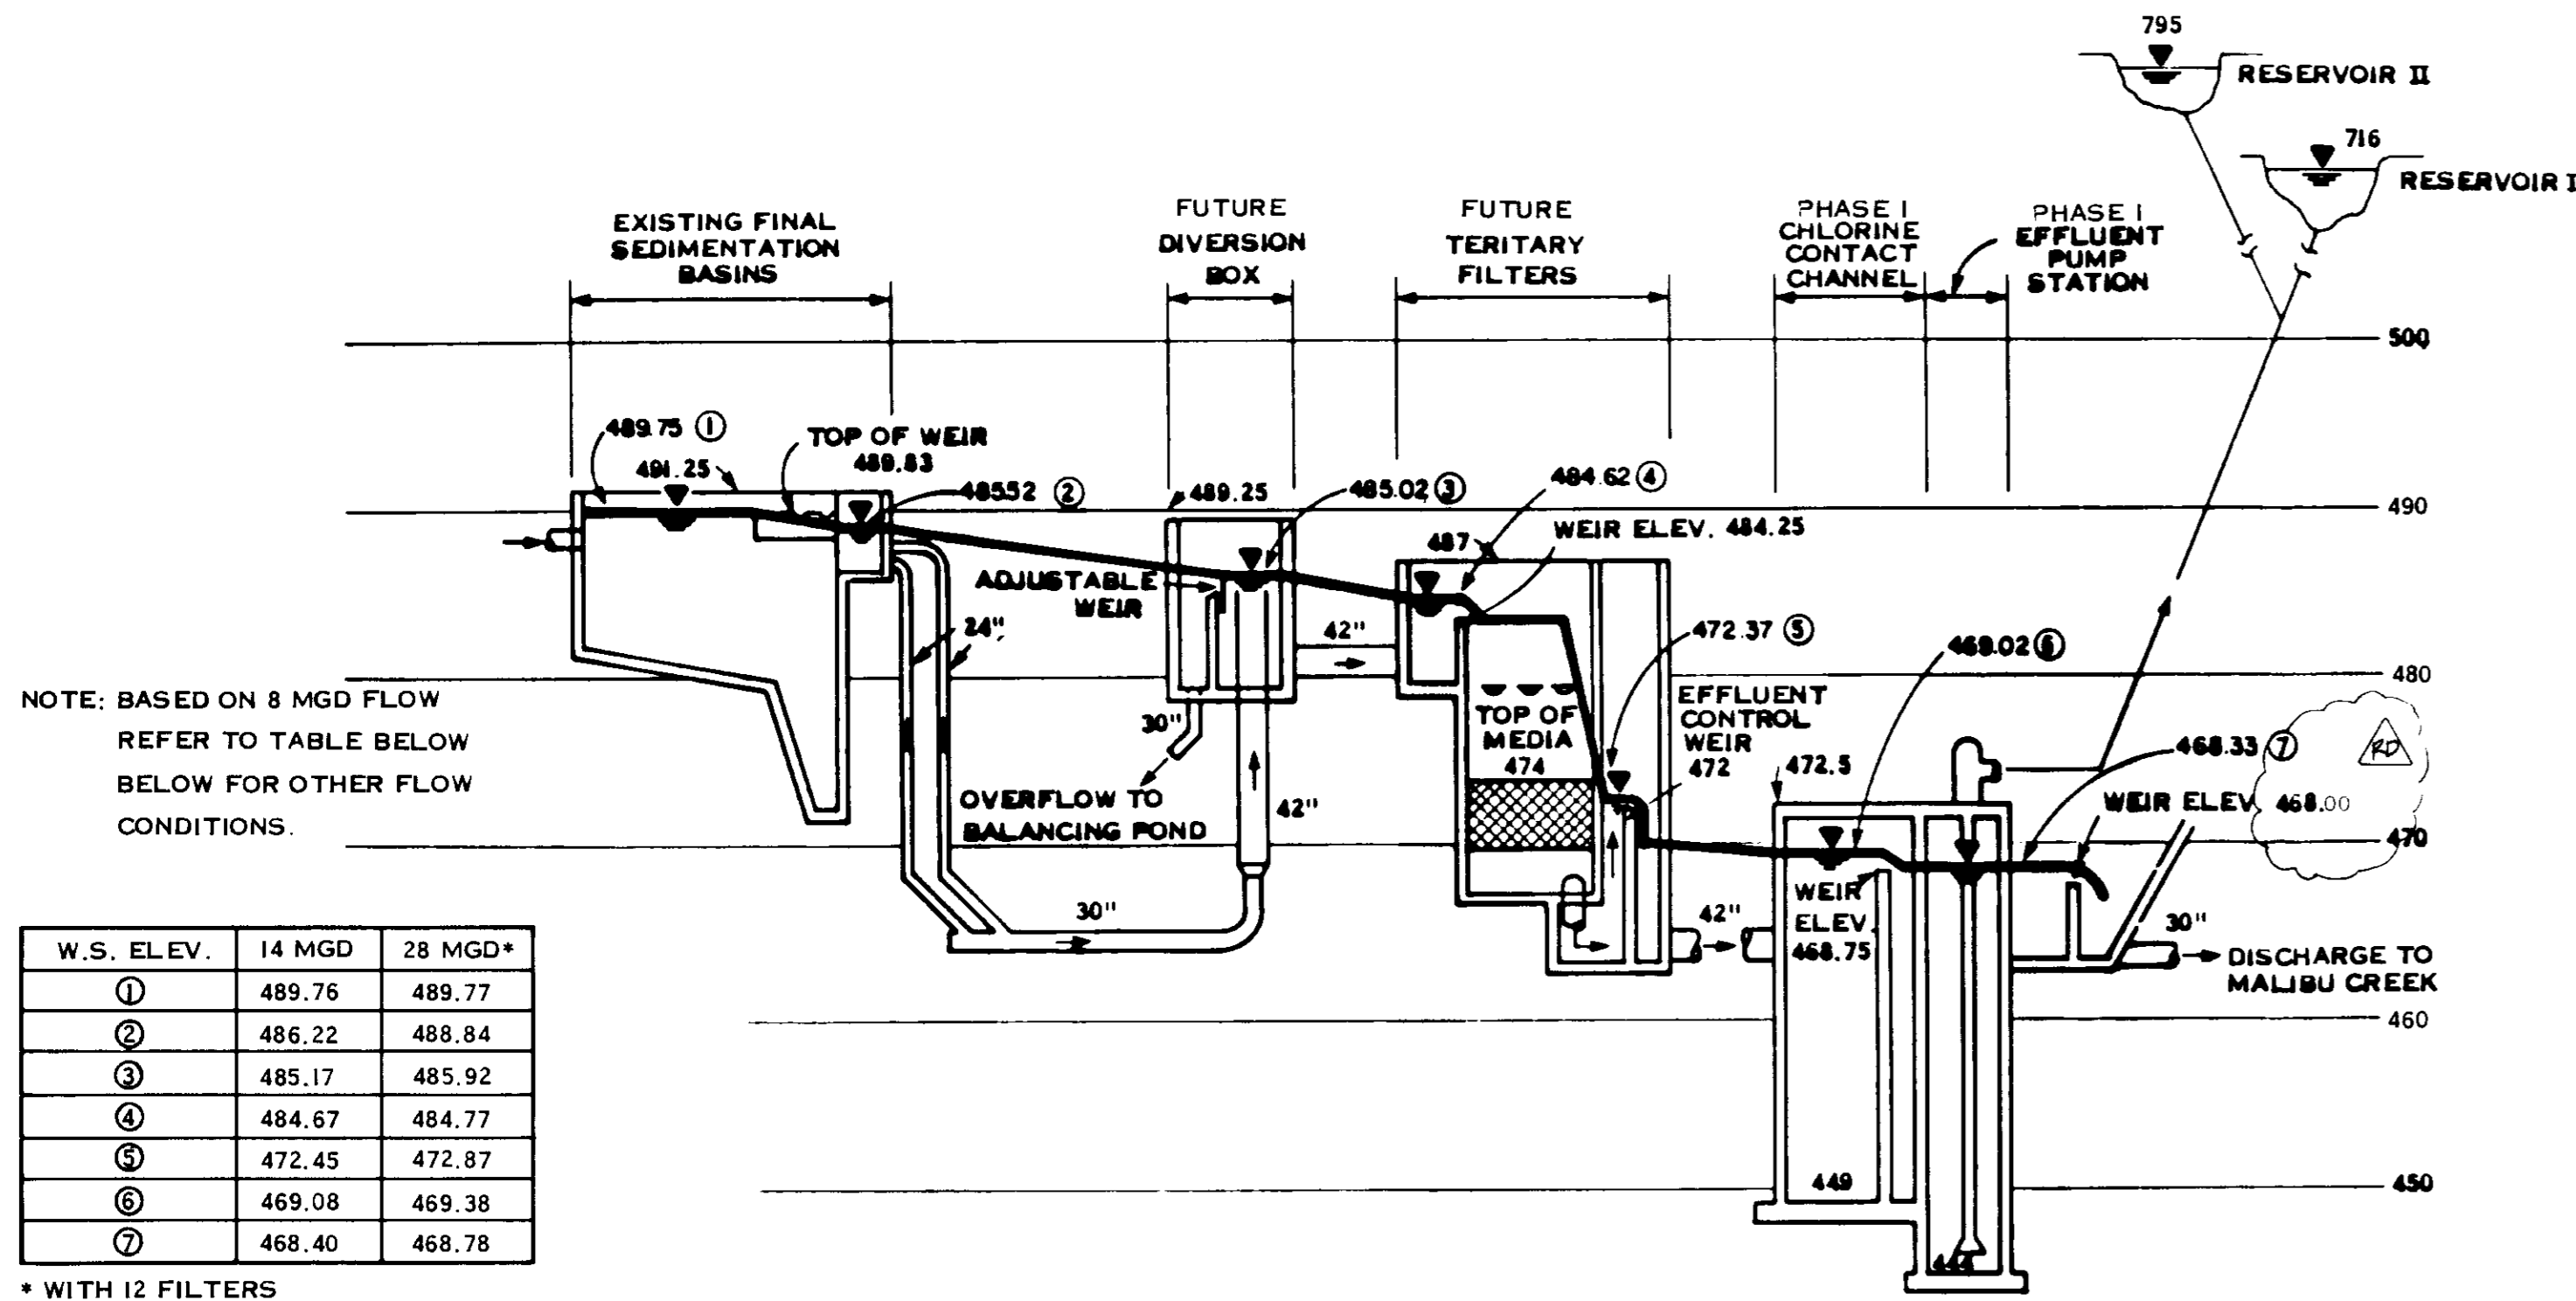

W.S. ELEV.	14 MGD	28 MGD*
①	489.76	489.77
②	486.22	488.84
③	485.17	485.92
④	484.67	484.77
⑤	472.45	472.87
⑥	469.08	469.38
⑦	468.40	468.78

* WITH 12 FILTERS

HYDRAULIC PROFILE - FUTURE FACILITIES WITH FILTERS - PHASE III

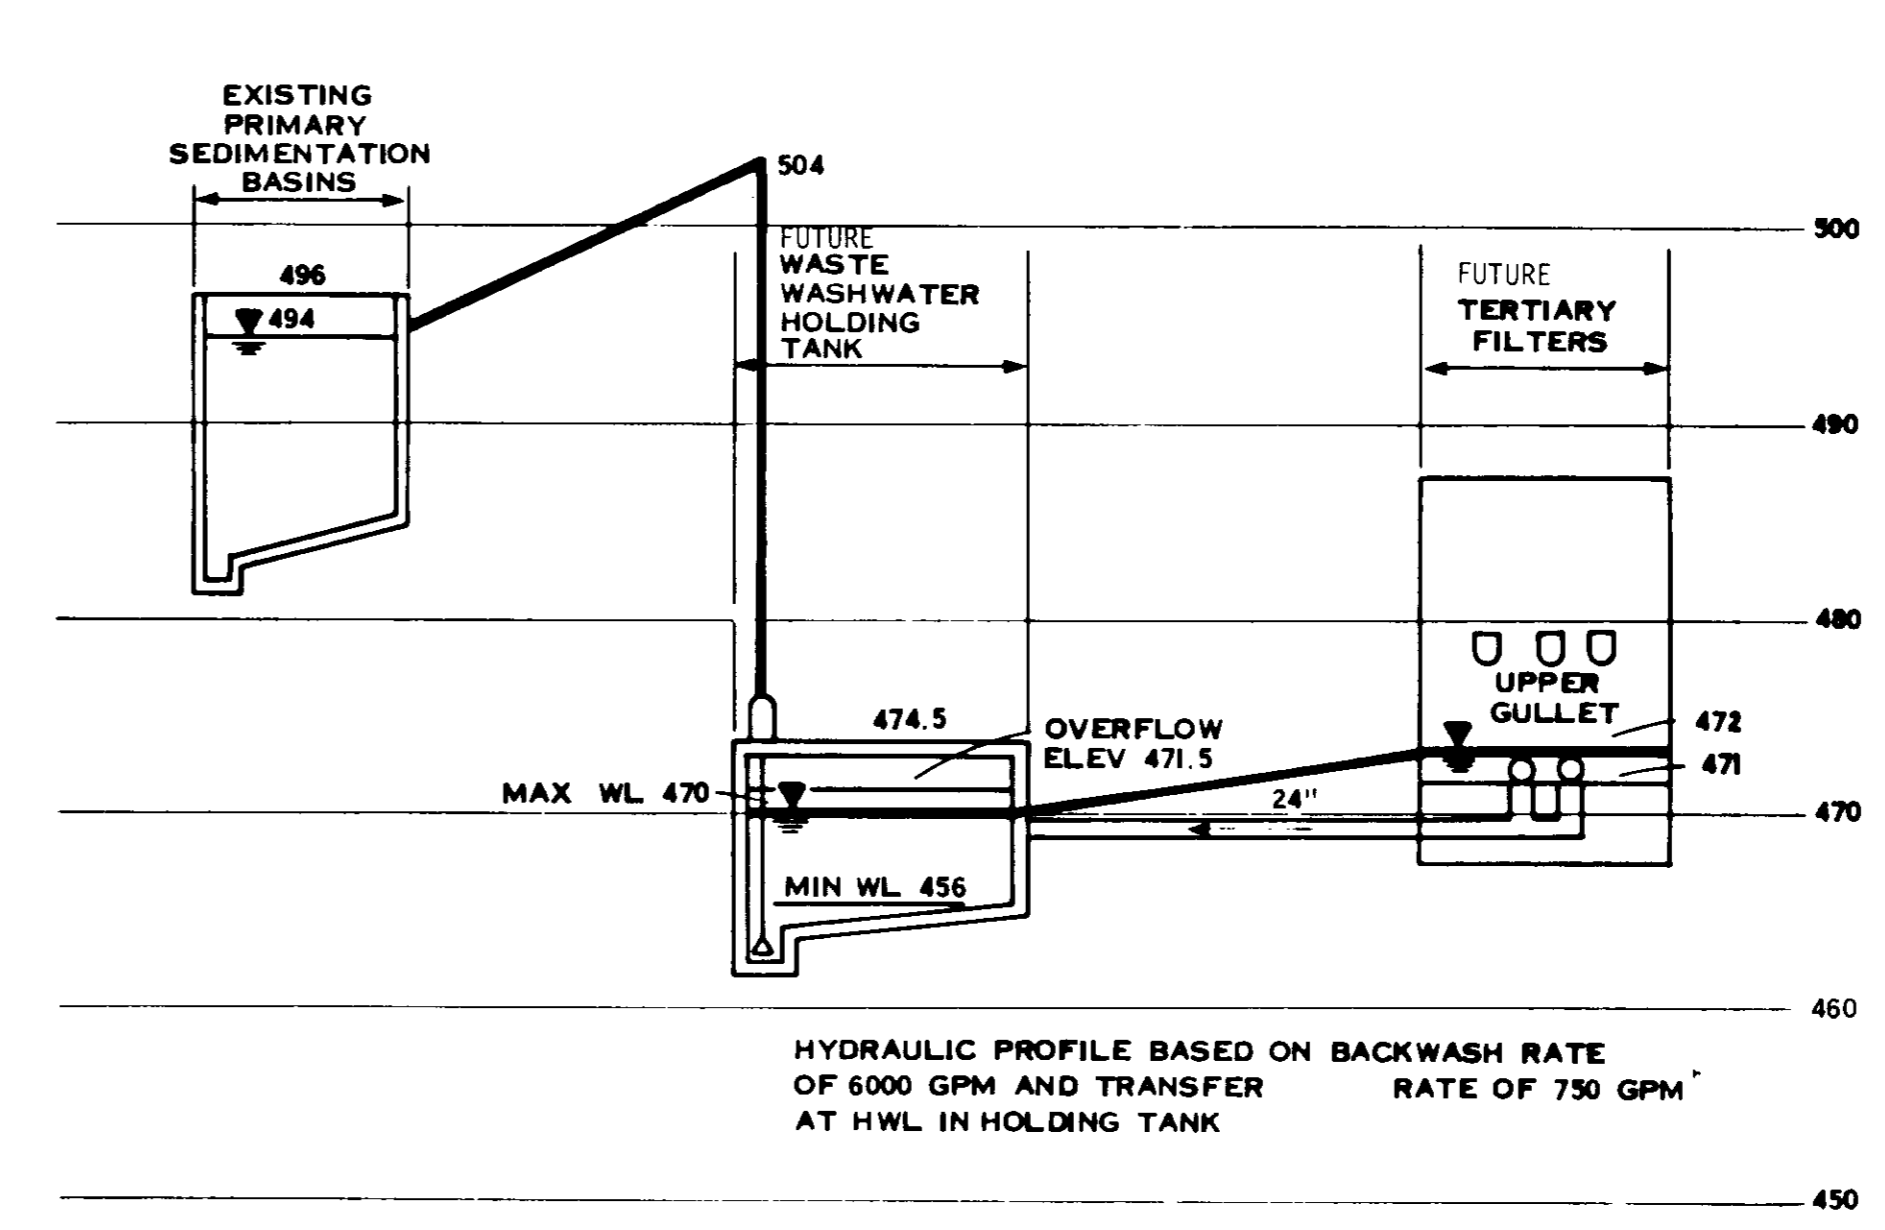

HYDRAULIC PROFILE - FUTURE BACKWASH RECOVERY SYSTEM - PHASE III

DESIGN CRITERIA

Description	Units	Average Phase II	Description	Units	Average	Description	Units	Average
Plant Flow	mgd	8.0	WASTE WASHWATER HOLDING TANK					
FILTRATION SYSTEM FILTER IMPELLER PUMPS Type: mixed flow Number: 2 Capacity, each: 5700 @ 32' TDH Motor horsepower: 2000			Number: 1 Volume: 120,000 gal Effective: 100,000 gal Size: 34' x 34' x 14' Transfer pumps: Number: 2 Capacity, each: 175 @ 35' TDH Motor horsepower: 1 1/2 Minimum filter run length: 6000 Maximum washwater flow: 6000			DISINFECTION SYSTEM (PHASE II) CHLORINE CONTACT CHANNEL Detention time: 120 min. Volume: 667,000 gal. Number of channels: 3 Width: 6 ft Depth: 20 ft Length: 250 ft Mixer: Number: 1 Horsepower: 15		
FLASH MIXING Mixing pump (hydraulic pump mixing): 1 Capacity: 500 @ 21 TDH Motor horsepower: 5 Energy input: approx. 1000			CHEMICAL SYSTEM CHEMICAL DOSAGES Coagulant (alum): 15 mg/l (Average), 25 mg/l (Maximum) Polyelectrolyte - liquid: 1.0 mg/l (Average), 2.0 mg/l (Maximum) Polyelectrolyte - dry: 0.05 mg/l (Average), 0.20 mg/l (Maximum) Chlorine (gas): 10 (Final) mg/l (Average), 20 (Final) mg/l (Maximum) Sulfur Dioxide (gas): 7.5 (Final) mg/l (Average), 15 (Final) mg/l (Maximum)			BALANCING POND Volume: 1.8 mil gal EFFLUENT POND Volume: 0.4 mil gal EFFLUENT PUMP STATION Constant speed vertical turbine: Number: 2 Capacity: 4200 @ 560' TDH, 5500 @ 420' TDH Horsepower, each: 900		
TERTIARY FILTERS Type: sandmedia Filtration rates: 1) Avg. flow (w/recycle): 3.20 gpm/sq ft a) All filters on-line b) One filter in backwash 2) Peak flow (w/recycle): 3.65 gpm/sq ft a) All filters on-line b) One filter in backwash Media area/filter: 5.25 sq ft Total filter area: 253 sq ft Anthracite: 2024 sq ft Depth: 48 in Effective size: 1.5 mm Uniformity coefficient: less than 1.4 Specific gravity: 1.45-1.55 Depth: 12 in Maximum backwash rate: 24 in/min Maximum air scour rate: 20 in/min Filter underdrain system (see specs.): 20 in/min			CHEMICAL FEEDER CAPACITY Coagulant (alum): 2 gal/hr Polyelectrolyte (cationic): 26 (max) @ 50 psi Polyelectrolyte (nonionic): 2 gal/hr Dry feeder: 13 (max) @ 50 psi Chlorine: 50 (max) @ 50 psi Sulfur Dioxide: 1 lb/day Chlorine: 37 (max) lbs/day Sulfur Dioxide: 2000 lbs/day			LEGEND Existing (Phase I) Proposed (Phase II) Future (Phase III)		
FILTER BACKWASH PUMPS Type: constant speed vertical mixed flow Number: 2 Capacity, each: 5700 @ 20' TDH Motor horsepower: 2000			CHEMICAL STORAGE Coagulant (alum): 1, 7500 gal Polyelectrolyte (cationic): 8, 440 gal Polyelectrolyte (nonionic): 6, 300 lbs Chlorine: 2, 3500 gallons each Sulfur Dioxide: 2, 1350 gallons each			PHASE II HYDRAULIC PROFILE AND DESIGN CRITERIA		

03541

RECORD DRAWING

RD 03541	JMH	RECORD DRAWING	
REV	DATE	BY	DESCRIPTION

SCALE: NONE	DESIGNED: R. SIEMAK	SUBMITTED: 27304 8/19/81
	DRAWN: L. QUAY	DATE: 8/19/81
	CHECKED: J. NICHOLS	RECOMMENDED: 27638 8/20/81
		DATE: 8/20/81

JAMES M. MONTGOMERY CONSULTING ENGINEERS, INC.
 555 EAST WALNUT STREET, PASADENA, CALIFORNIA 91101

DISTRICT APPROVAL ON TITLE PAGE

LAS VIRGENES MWD/TRIUNFO CSD		SHEET
TAPIA WRF - FILTRATION/DISINFECTION ADDITION		G-2
PHASE II	HYDRAULIC PROFILE AND DESIGN CRITERIA	OF 66 SHEETS

SYMBOLS

	CAST IRON OR MASONRY
	STEEL
	BRONZE
	GRAVEL
	INSULATION
	ALUMINUM OR METAL DECKING
	CONCRETE
	EARTH
	SAND
	PLASTIC, RUBBER OR NEOPRENE
	WOOD - (FINISH)
	WOOD - (ROUGH FRAMING)
	SUPPLY AIR DUCT
	EXHAUST OR RETURN AIR DUCT
	TURNING VANES IN DUCT
	EXHAUST GRILLE
	SUPPLY GRILLE
	DEFLECTING DAMPER
	UNIT HEATER
	CENTERLINE
	ROUND OR DIAMETER
	AT
	SQUARE
	STOP GATE
	SLIDE GATE
	SLUICE GATE
	CHANGE IN PIPING MATERIAL
	VAULT OR JUNCTION STRUCTURE
	ANGLE
	PIPE SUPPORT (IN PLAN ONLY)
	PIPE CALLOUT (SEE PIPING SCHEDULE)
	EQUIPMENT NUMBER (SEE EQUIPMENT SCHEDULE)
	PIPE SIZE AND TYPE/FLUID ABBREVIATION
	RAILINGS

	GATE VALVE
	GLOBE VALVE
	BALL VALVE
	DIAPHRAGM VALVE
	PRESSURE REGULATING VALVE
	MOTOR OPERATED VALVE
	PLUG VALVE OR LUBRICATED PLUG VALVE
	NEEDLE VALVE
	TEMPERATURE CONTROL VALVE
	PRESSURE RELIEF VALVE
	HOSE BIBB, H/B
	FLOAT VALVE
	SOLENOID VALVE
	MULTIPORT VALVE-3 WAY
	MULTIPORT VALVE-4 WAY
	CHECK VALVE
	BUTTERFLY VALVE
	CENTRIFUGAL OR TURBINE PUMP OR FAN
	METERING PUMP
	BLOWER OR COMPRESSOR
	ORIFICE PLATE AND FLANGES
	FLOW TUBE
	DENSITY METER
	MAGNETIC METER
	CONDENSATE TRAP
	PROPELLER METER
	AIR VACUUM AND AIR RELEASE ASSEMBLY
	BACKWATER VALVE
	BACKFLOW PREVENTER
	BUBBLER
	ROOM THERMOSTAT
	PRESSURE GAGE W/ OR W/O DIAPHRAGM SEAL
	PRESSURE SWITCH W/ OR W/O DIAPHRAGM SEAL
	ROTAMETER

	FLAME ARRESTER
	INJECTOR
	THERMOMETER
	FLANGED FITTINGS
	SCREWED OR SOCKET WELD FITTINGS
	MECHANICAL - TYPE FITTINGS (GROOVED)
	WELDED FITTINGS
	PIPE ANCHOR
	MECHANICAL JOINT FITTINGS
	BELL AND SPIGOT FITTINGS
	STRAINER
	UNION
	MECHANICAL TYPE COUPLING
	SLEEVE TYPE COUPLING
	EXPANSION JOINT
	FLEXIBLE CONN.
	CUT PIPE
	REDUCER
	DRAIN TRAP
	FLOOR DRAIN
	FLOOR SINK
	HUB DRAIN
	CLEANOUT
	BLOW OFF ASSEMBLY
	QUICK CONNECT COUPLER
	FIRE EXTINGUISHER
	FIRE HOSE CABINET
	CAPPED END
	PLUGGED END

	EXISTING STRUCTURE OR FACILITY
	NEW STRUCTURE OR FACILITY
	FUTURE STRUCTURE OR FACILITY
	PROPERTY LINE
	EXISTING FENCE
	NEW FENCE
	SOIL BORING
	BENCH MARK
	CONTOUR LINE, EXISTING GRADE
	CONTOUR LINE, FINISHED GRADE
	CUT OR FILL SLOPE TO BE CONSTRUCTED
	EXISTING ELEVATION
	FINISHED ELEVATION
	EXISTING UNDERGROUND PIPELINES
	NEW UNDERGROUND PIPELINES
	MANHOLE AND CLEANOUT (SANITARY SEWER)
	CATCH BASIN
	FIRE HYDRANT
	EXISTING A.C. PAVEMENT
	NEW A.C. PAVEMENT

- NOTES:
- (1) ELECTRICAL SYMBOLS SHOWN ON ELECTRICAL SHEETS.
 - (2) FOR WELDING SYMBOLS USE AMERICAN WELDING SOCIETY STANDARD SYMBOLS; SEE AMERICAN INSTITUTE OF STEEL CONSTRUCTION MANUAL.

EXAMPLE OF SECTION NUMBERING SYSTEM

(FOR DETAILS SUBSTITUTE DETAIL LETTER FOR SECTION NUMBER)

(1) SECTION CUT ON DWG. G-9

SECTION NUMBER OR DETAIL LETTER

DRAWING ON WHICH SECTION OR DETAIL APPEARS

(2) ON DWG G10 THIS SECTION IS IDENTIFIED AS:

SECTION NUMBER OR DETAIL LETTER

DRAWING FROM WHICH SECTION OR DETAIL WAS TAKEN

03542

RECORD DRAWING

REV	DATE	BY	DESCRIPTION

SCALE: NONE

DESIGNED	L.M.
DRAWN	G.M.
CHECKED	H.M.

<p>SUBMITTED</p> <p><i>[Signature]</i></p> <p>PROJECT ENGINEER</p> <p>RECOMMENDED</p> <p><i>[Signature]</i></p> <p>JAMES M. MONTGOMERY CONSULTING ENGINEERS, INC.</p>	<p>27304</p> <p>R.C.E. NO.</p> <p>8/19/01</p> <p>DATE</p> <hr/> <p>27030</p> <p>R.C.E. NO.</p> <p>9/20/01</p> <p>DATE</p>
---	---

JAMES M. MONTGOMERY CONSULTING ENGINEERS, INC.

555 EAST WALNUT STREET, PASADENA, CALIFORNIA 91101

DISTRICT APPROVAL ON TITLE PAGE

L.A.S VIRGENES MWD/TRIUNFO CSD	
TAPIA WRF - FILTRATION/DISINFECTION ADDITION	
PHASE II	SYMBOLS

SHEET

G-3

OF 66 SHEETS

AB ANCHOR BOLT
 ABBR ABBREVIATION
 AC ACTIVATED CARBON OR ASPHALT CONCRETE
 A/C AIR CONDITIONING
 ACP ASPHALTIC CONCRETE PAVEMENT OR ASBESTOS CEMENT PIPE
 AER AERATION
 AL ALUMINUM OR ALUM
 ALUM ALUMINUM
 API AMERICAN PETROLEUM INSTITUTE
 ANSI AMERICAN NATIONAL STANDARDS INSTITUTE (FORMERLY A. S. A.)
 APPD APPROVED
 APPROX APPROXIMATE
 ARCH ARCHITECTURAL
 ASA AMERICAN STANDARDS ASSOCIATION (NOW ANSI)
 ASME AMERICAN SOCIETY OF MECHANICAL ENGINEERS
 ASTM AMERICAN SOCIETY FOR TESTING AND MATERIAL
 ASSY ASSEMBLY
 ATM ATMOSPHERE
 AVAR AIR VACUUM AND AIR RELEASE VALVE
 AWWA AMERICAN WATER WORKS ASSOCIATION

BC BEGIN CURVE, BOLT CIRCLE OR BETWEEN CENTERS
 BCR BEGIN CURB RETURN
 BD BOARD
 BF BLIND FLANGE
 BFP BACK FLOW PREVENTER
 BHP BRAKE HORSEPOWER
 BLDG BUILDING
 BLD FLG BLIND FLANGE
 BLK BLACK OR BLOCK
 BLKG BLOCKING
 BM BEAM OR BENCH MARK
 BO BLOW-OFF ASSEMBLY
 BOD BIOCHEMICAL OXYGEN DEMAND
 BPV BACK PRESSURE VALVE
 BBS BELL AND SPOGOT
 BSMT BASEMENT
 BTU BRITISH THERMAL UNIT
 BV BUTTERFLY VALVE
 BVC BEGIN VERTICAL CURVE
 BWV BACK WATER VALVE

C CENTRIGRADE
 CAP CAPACITY
 CB CATCH BASIN, CHALK BOARD
 CC CENTER TO CENTER
 CD CEILING DIFFUSOR
 CFH CUBIC FEET PER HOUR
 CFM CUBIC FEET PER MINUTE
 CFS CUBIC FEET PER SECOND
 CHK V CHECK VALVE
 CHKD PL CHECKERED PLATE
 CI CAST IRON
 CL CHLORINE GAS, CHLORINATOR, CHAIN LINK, CLEARANCE OR CENTERLINE
 CML&C CEMENT MORTAR LINED AND COATED
 CMP CORRUGATED METAL PIPE
 CO CLEANOUT
 COL COLUMN
 CONC CONCRETE, CONCENTRIC,
 CONN CONNECTION
 CONSTR CONSTRUCTION OR CONSTRUCT
 CONT CONTINUED OR CONTINUOUS
 CONTR CONTRACTOR
 COMP COMPRESSOR
 COTG CLEAN-OUT TO GRADE
 CPLG COUPLING
 CS CAUSTIC SODA OR CAST STEEL
 CT CERAMIC TILE
 CTSK COUNTERSUNK
 CTR CENTER
 CU COPPER OR CUBIC
 CYL CYLINDER
 CHEM CHEMICAL
 CM CENTIMETER

DET DETAIL
 DG DOOR GRILLE
 DI DUCTILE IRON
 DIA DIAMETER
 DIAPH DIAPHRAGM
 DISCH DISCHARGE
 DISP DISPENSER
 DN DOWN OR DECANT
 DO DISSOLVED OXYGEN
 DR DOOR
 DWG DRAWING
 DIFF DIFFUSER, DIFFERENTIAL

E EAST
 EA EACH
 EC END CURVE
 ECC ECCENTRIC
 ECR END CURB RETURN
 EF EACH FACE OR EXHAUST FAN
 EFF EFFLUENT
 EG EXHAUST GRILLE
 EL/ELEV ELEVATION
 ELEC ELECTRICAL, ELECTRONIC,
 ELL ELBOW

ENG ENGINE
 EQ EQUAL
 EQUIP EQUIPMENT
 EVAP EVAPORATOR
 EVC END VERTICAL CURVE
 EW EACH WAY
 EXH EXHAUST
 EX-HY EXTRA HEAVY
 EXIST EXISTING
 EXP JT EXPANSION JOINT
 EXT EXTERIOR

F FAHRENHEIT OR FINISH
 FABR FABRICATION
 FAI FRESH AIR INTAKE
 FB FLAT BAR, FLOOR BEAM OR FIELD BOOK
 FCO FLOOR CLEANOUT
 FD FLOOR DRAIN
 FE FIRE EXTINGUISHER OR FINAL EFFLUENT
 FF FLAT FACE OR FAR FACE
 F TO F FACE TO FACE
 FG FINISHED GRADE
 FH FIRE HYDRANT
 FIG FIGURE
 FL FLOWLINE
 FLOCC FLOCCULATOR OR FLOCCULATION
 FLG FLANGE
 FLGD FLANGED
 FLR FLOOR
 FMH FLEXIBLE METAL HOSE
 FOC FACE OF CONCRETE
 FOM FACE OF MASONRY
 FOS FACE OF STUDS
 FOW FACE OF WALL
 FPC FLEXIBLE PIPE COUPLING
 FPM FEET PER MINUTE
 FPS FEET PER SECOND
 FS FAR SIDE, FLOOR SINK, FINISHED SURFACE, FORGED STEEL, FROTH SPRAY
 FT FEET OR FOOT
 FTG FOOTING
 FUT FUTURE

GA GAGE OR GAUGE
 GAL GALLON
 GALV GALVANIZED
 GI GALVANIZED IRON
 GPD GALLONS PER DAY
 GPH GALLONS PER HOUR
 GPM GALLONS PER MINUTE
 GRD GRADE OR GROUND
 GR BRK GRADE BREAK OR GRADE CHANGE
 GV GATE VALVE
 GLV GLOBE VALVE
 GYP GYPSUM

 HB HOSE BIBB
 HDR HEADER
 HEX HEXAGONAL
 Hg MERCURY
 HORIZ HORIZONTAL
 HP HORSEPOWER OR HIGH PRESSURE
 HR HEATING RETURN OR HOUR
 HTG HEATING
 HTR HEATER
 H8V HEATING AND VENTILATING
 HWO HANDWHEEL OPERATED
 HYD HYDRAULIC OR HYDRANT

ID INSIDE DIAMETER
 IF INSIDE FACE
 IN INCH
 INFL INFLUENT
 INSL INSULATION
 INSTR INSTRUMENT
 INV INVERT ELEVATION
 IP IRON PIPE
 IRRG IRRIGATION
 IPS IRON PIPE SIZE

JT JOINT

 KV KILOVOLT
 KW KILOWATT
 KWH KILOWATT HOUR
 KM KILOMETER
 KG KILOGRAM

LAV LAVATORY
 LB POUND
 LT LEFT
 LWR LOWER
 L LITER, LENGTH

 M METER
 MAN MANUAL
 MACH MACHINE
 MAX MAXIMUM
 MCC MOTOR CONTROL CENTER
 MECH MECHANICAL
 MFR MANUFACTURER
 MGD MILLION GALLONS PER DAY
 MH MANHOLE
 MI MALLEABLE IRON
 MIN MINIMUM OR MINUTE
 MISC MISCELLANEOUS
 MK MARK
 MO MOTOR OPERATED OR MASONRY OPENING
 MOD MODEL
 MTD MOUNTED
 MTR MOTOR
 MTC MECHANICAL TYPE COUPLING
 MTL MATERIAL OR METAL

N NORTH
 NBS NATIONAL BUREAU OF STANDARDS
 NEMA NATIONAL ELECTRICAL MANUFACTURERS ASSOCIATION
 NFPA NATIONAL FIRE PROTECTION ASSOCIATION
 NF NEAR FACE
 NIC NOT IN CONTRACT
 NO NUMBER
 NPT NATIONAL PIPE THREAD
 NRS NON-RISING STEM
 NS NEAR SIDE
 NTS NOT TO SCALE
 NPS NOMINAL PIPE SIZE (FORMERLY I. P. S.)

OC OVER-CROSSING OR ON CENTER
 OD OUTSIDE DIAMETER
 OF OVERFLOW OR OUTSIDE FACE
 OH OVER HEAD
 OPER OPERATOR OR OPERATING
 OPING OPENING
 OS&Y OUTSIDE SCREW AND YOKE
 OWG OIL, WATER, GAS
 OZ OUNCE

PP POWER POLE
 P POLE OR PAGE
 PC PRIMARY CLARIFIER OR PORTLAND CEMENT
 PE PLANT EFFLUENT, POLYELECTROLYTE
 PG PRESSURE GAGE
 PI PLANT INFLUENT OR POINT OF INTERSECTION
 PL PLATE, PROPERTY LINE OR PLACE
 PLAS PLASTER OR PLASTIC
 PLT PLANT
 PPD POUNDS PER DAY
 PPH POUNDS PER HOUR
 PPM PARTS PER MILLION
 PR PAIR
 PRESS PRESSURE
 PRV PRESSURE REGULATING, RELIEF OR REDUCING VALVE
 PSF POUNDS PER SQUARE FOOT
 PSI POUNDS PER SQUARE INCH
 PSIA POUNDS PER SQUARE INCH ABSOLUTE
 PTDF PRESSURE TREATED DOUGLAS FIR
 PS PRESSURE SWITCH
 PV PLUG VALVE
 PVC POLYVINYL CHLORIDE
 pH HYDROGEN ION CONCENTRATION
 PAVMT PAVEMENT

R RADIUS, RISER OR RETURN, RATE OF SLOPE
 RAG RETURN AIR GRILLE
 RC REINFORCED CONCRETE
 RCP REINFORCED CONCRETE PIPE
 RD ROOF DRAIN, ROUND, OR ROAD
 RDWD REDWOOD
 RED REDUCER, REDUCING
 REF REFERENCE, REFER
 REIN REINFORCE OR REINFORCED
 RE-STL REINFORCING STEEL
 REQD REQUIRED
 REV REVISION
 RM ROOM
 RPM REVOLUTIONS PER MINUTE OR REINFORCED PLASTIC MORTAR PIPE
 RT RIGHT
 R/W RIGHT OF WAY
 REG REGULATING
 RWL RAINWATER LEADER

S SOUTH, SCUM, SINK, SECOND, SLOPE
 SA SAMPLE
 SC SPARE CHEMICAL OR SECONDARY CLARIFIER, SCUM
 SCD SCREWED
 SCH SCHEDULE
 SCHED SCHEDULE
 SDR STORM DRAINS
 SEC SECONDARY
 SECT SECTION
 SER SERIES
 SETT SETTLING
 SHT SHEET
 SIM SIMILAR
 SL SLUDGE OR SLOPE
 SPECS SPECIFICATIONS
 SQ SQUARE
 SS SANITARY SEWER, STAINLESS STEEL OR SERVICE SINK
 SSK SERVICE SINK
 SSU SECONDS SAYBOLT UNIVERSAL
 STA STATION
 STD STANDARD
 STL STEEL
 STN STAINLESS
 STN STL STAINLESS STEEL
 STRUCT STRUCTURAL OR STRUCTURE
 SUCT SUCTION
 SV SOLENOID VALVE
 SWR SIDEWALL REGISTER
 SYM SYMMETRICAL OR SYMBOL
 STC SLEEVE TYPE COUPLING

T THERMOSTAT, TREAD OF STAIR OR TOP, TANGENT
 TB TACK BOARD
 T&B TOP AND BOTTOM
 TBM TEMPORARY BENCH MARK
 TC TOP OF CURB
 THR'D THREADED
 TK TANK
 TP TELEPHONE POLE OR TELEGRAPH POLE
 TRANS TRANSITION, TRANSMITTER
 TV THERMOSTATIC VALVE
 TW TOP OF WALL
 TYP TYPICAL
 T B E THREAD BOTH ENDS
 T O E THREAD ONE END
 T&G TONGUE AND GROOVE

UR URINAL
 UC UNDER-CROSSING
 UG UNDERGROUND
 UGC UNDERGROUND CONDUIT
 UH UNIT HEATER
 UL UNDERWRITERS LABORATORIES

V VACUUM, VALVE, VERTICAL, VENT, VOLT OR VOLUME
 VAR VARIES OR VARIABLE
 VC VICTAULIC COUPLING
 VCP VITRIFIED CLAY PIPE
 VERT VERTICAL
 VTC VENT TO CEILING
 VTR VENT THROUGH ROOF

W WEST OR WASTE
 W/ WITH
 WC WATER COLUMN OR WATER CLOSET
 WCO WALL CLEANOUT
 WD WOOD
 WS WATER SURFACE
 WSTP WATER STOP
 WT WEIGHT
 WWM WELDED WIRE MESH

XS EXTRA STRONG
 YD YARD

NOTES:
 PIPING ABBREVIATIONS SHOWN ON PIPING SCHEDULE SHEET:
 ELECTRICAL ABBREVIATIONS SHOWN ON ELECTRICAL SHEETS.
 ADDITIONAL ABBREVIATIONS CONFORM TO ASA STANDARD
 ABBREVIATIONS Z 32, 13

03543
 RECORD DRAWING

REV	DATE	BY	DESCRIPTION

SCALE:
 NONE

DESIGNED L.M.
 DRAWN G.M.
 CHECKED J.S.

SUBMITTED
 PROJECT ENGINEER
 RECOMMENDED
 27704
 R.C.E. NO.
 3/19/81
 DATE
 27633
 R.C.E. NO.
 3/23/81
 DATE

JAMES M. MONTGOMERY CONSULTING ENGINEERS, INC.
555 EAST WALNUT STREET, PASADENA, CALIFORNIA 91101

DISTRICT APPROVAL ON TITLE PAGE

LAS VIRGENES MWD/TRIUNFO CSD	SHEET
TAPIA WRF - FILTRATION/DISINFECTION ADDITION	G-4
PHASE II	ABBREVIATIONS

OF 66 SHEETS


EXTERIOR FINISH SCHEDULE

INTERIOR FINISH SCHEDULE


LOCATION	MATERIAL	FINISH	REMARKS	AREA	FLOOR		BASE		WALL		CEILING		TRIM		MISCELLANEOUS		REMARKS
					MATERIAL	FINISH	MATERIAL	FINISH	MATERIAL	FINISH	MATERIAL	FINISH	MATERIAL	FINISH	ITEM	MATERIAL	
ROOFS	BLT-UP	-		01 CHLORINE STOR.	CONC.	HRDN 'O	CONC.	-	CONC.	* -	CONC.	-	-	-	-	-	* - LIQUID WATERPROOFER
METALWORK @ ROOF	MET.	PAIN		02 CHLORINATOR	CONC.	HRDN 'O	CONC.	-	WD.	* STAIN 'AA	WD.	STAIN 'AA	WD.	STAIN 'AA	-	-	* " " " "
WALLS & RAILS	CONC.	SMOOTH	W/ LIQUID WATERPROOFER	03 SULFONATOR	CONC.	HRDN 'O	CONC.	-	WD.	* STAIN 'AA	WD.	STAIN 'AA	WD.	STAIN 'AA	-	-	* " " " "
DOORS & FRAMES	MET.	PAIN		04 SULFUR DIOXIDE STOR.	CONC.	HRDN 'O	CONC.	-	CONC.	* -	CONC.	-	-	-	-	-	* " " " "
LOUVERS	ALUM.	ANODIZED	CLEAR	05 BREEZEWAY	CONC.	DRUM	CONC.	-	CONC.	* -	WD.	STAIN 'AA	-	-	-	-	* " " " "
WALKWAYS & PAVINGS	CONC.	BRUSH/ BROOM		06 ELECTRICAL / STOR.	CONC.	HRDN 'O	CONC./CMU	-	CONC./CMU	* -	CONC.	-	-	-	-	-	* " " " "
DOWNSPOUTS & OVERFLOWS	MET.	PAIN		07 CHEMICAL FEED	CONC.	HRDN 'O	CONC./CMU	-	WD.	* STAIN 'AA	WD.	STAIN 'AA	WD.	STAIN 'AA	-	-	* " " " "
MISC. METALWORK	MET.	PAIN															
HANDRAILING	ALUM.	ANODIZED *	CLEAR	MISC. METALWORK	-	-	-	-	-	-	-	-	-	-	-	-	METAL PAINT 'A' 'B'

GENERAL NOTES


- PLAN DIMENSIONS ARE TO FACE OF CONCRETE OR CONCRETE BLOCK UNLESS OTHERWISE NOTED.
 - FIGURE DIMENSIONS SHALL TAKE PRECEDENCE OVER SCALED DIMENSIONS.
 - REPETITIVE FEATURES ARE NOT DRAWN IN THEIR ENTIRETY AND SHALL BE COMPLETELY PROVIDED AS IF DRAWN IN FULL.
 - REFER TO CIVIL, STRUCTURAL, MECHANICAL, ELECTRICAL, AND OTHER CATEGORIES OF DRAWINGS FOR DIMENSIONS, DETAILS, EQUIPMENT AND OTHER INFORMATION.
 - VERIFY SIZE AND LOCATION OF AND PROVIDE: ALL OPENINGS THROUGH FLOORS AND WALLS, FURRING, CURBS, ANCHORS AND INSERTS. PROVIDE ALL BASES, BLOCKING REQUIRED FOR ACCESSORIES, MECHANICAL, ELECTRICAL AND OTHER EQUIPMENT.
 - BITUMINOUS MEMBRANE WATERPROOFING AND PROTECTION BOARD TYPICAL BELOW GRADE ON EXTERIOR CONCRETE WALLS AT CHEMICAL BLDG. AND OTHER SPACES AS NOTED.
- T PAINT SYSTEMS SEE SPECIFICATIONS. LETTER INDICATION IN THE "FINISH" COLUMN INDICATES PAINT SYSTEM

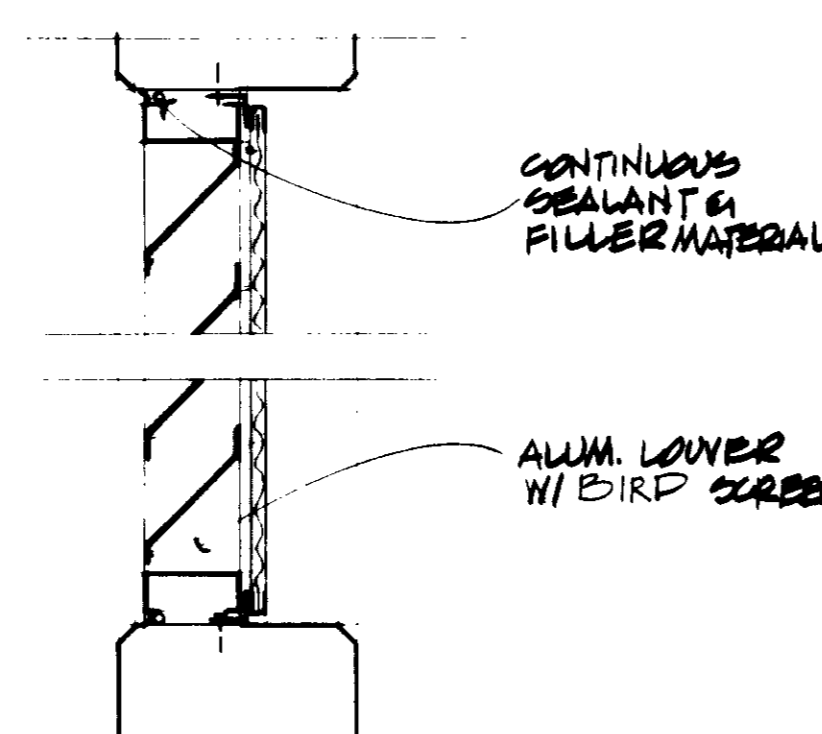

TYP. LOUVER H GA-2

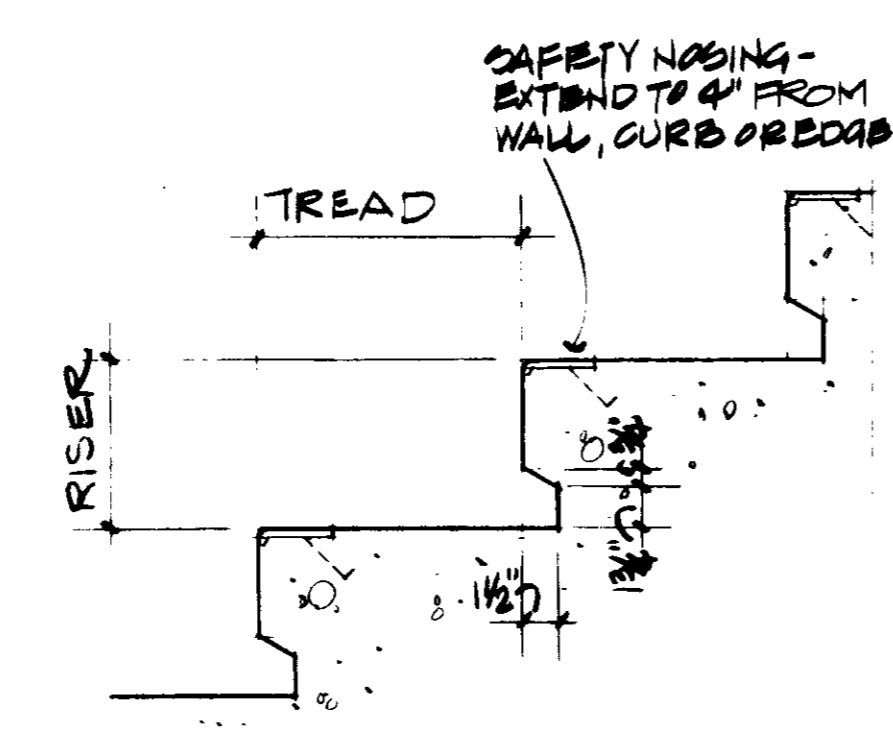


TYP. TREAD & RISER I GA-2

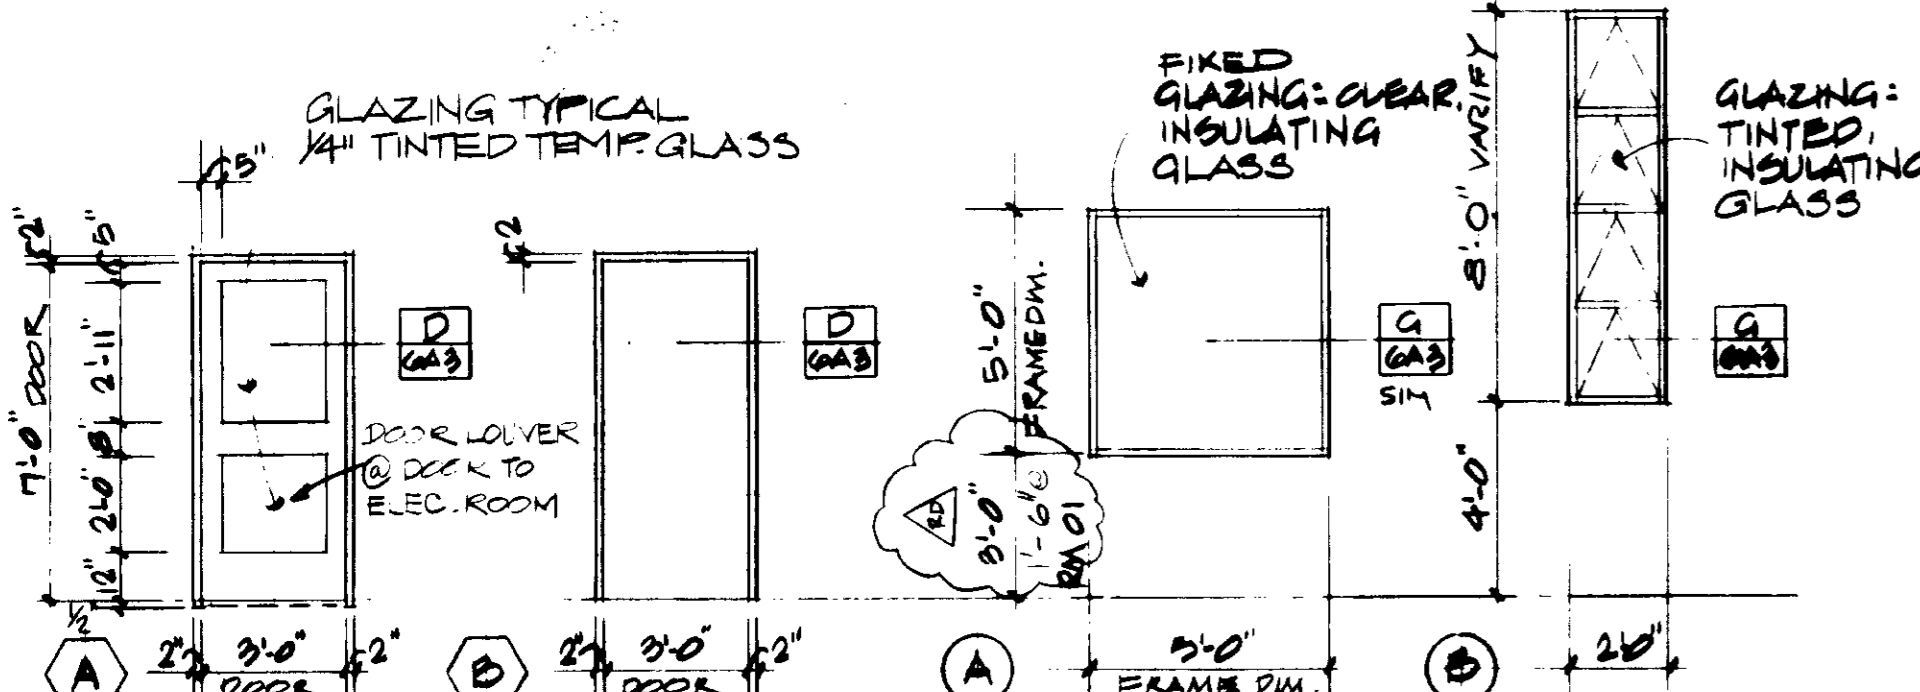


DOOR SCHEDULE 1. DIM. ARE 1/4" 2. HARDWARE, SEE SPECS. 3. ALL DOORS 1 1/2" THICK U.M. WITH HOLLOW METAL FRAME


WINDOW SCHEDULE 1. DIM. TO FACE OF CONC. 2. DIM. TO FACE OF CONC.

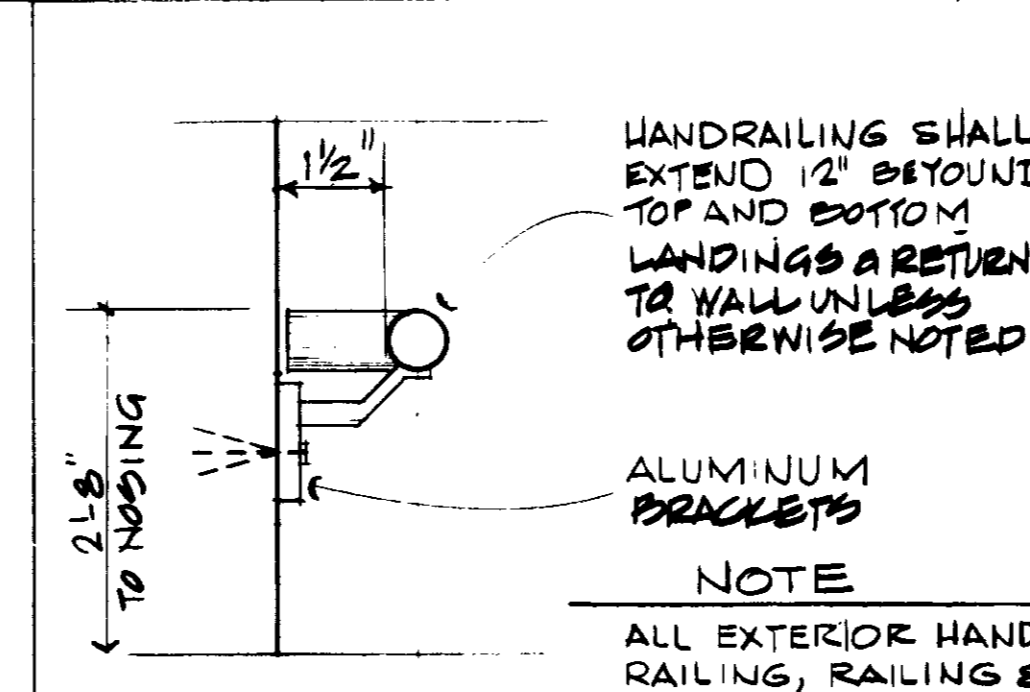


HANDRAIL G GA-2

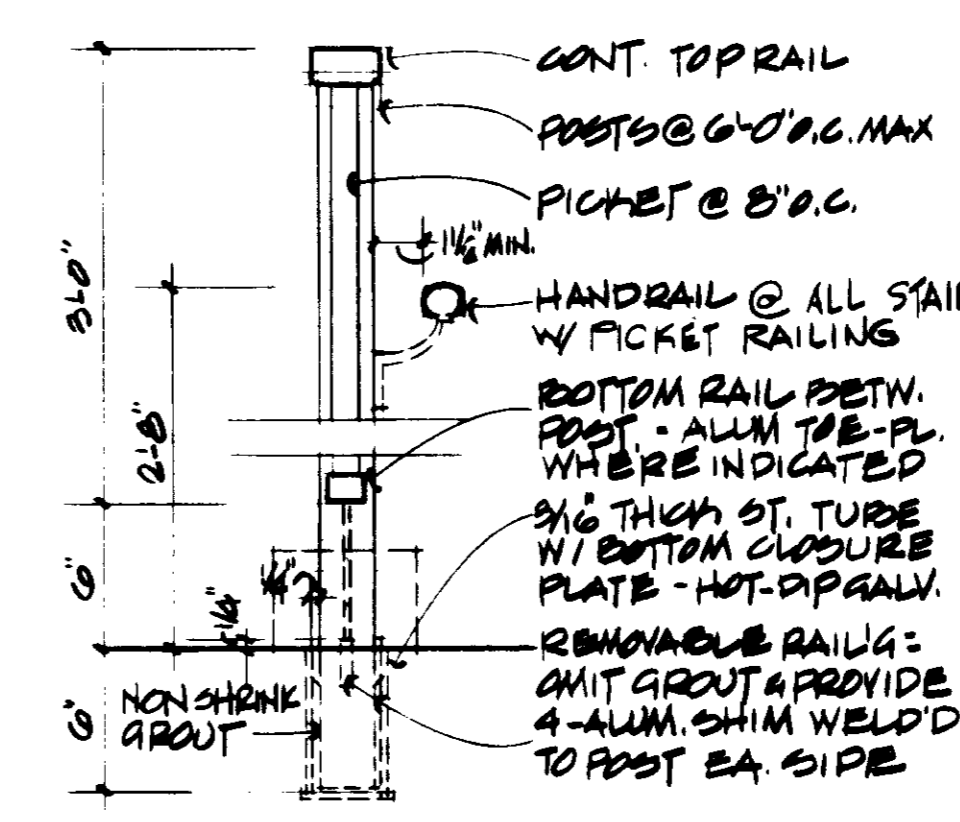


TYP. PICKET RAILING D GA-2

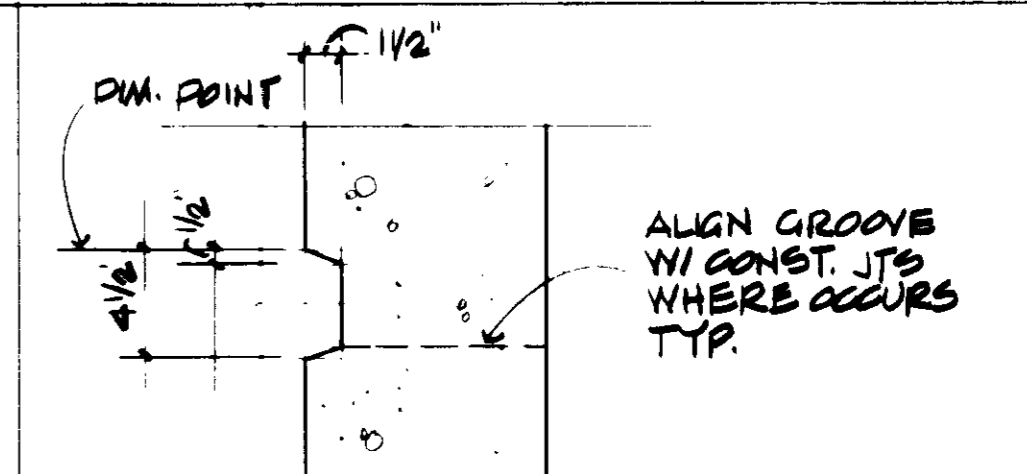


A1 GA-2

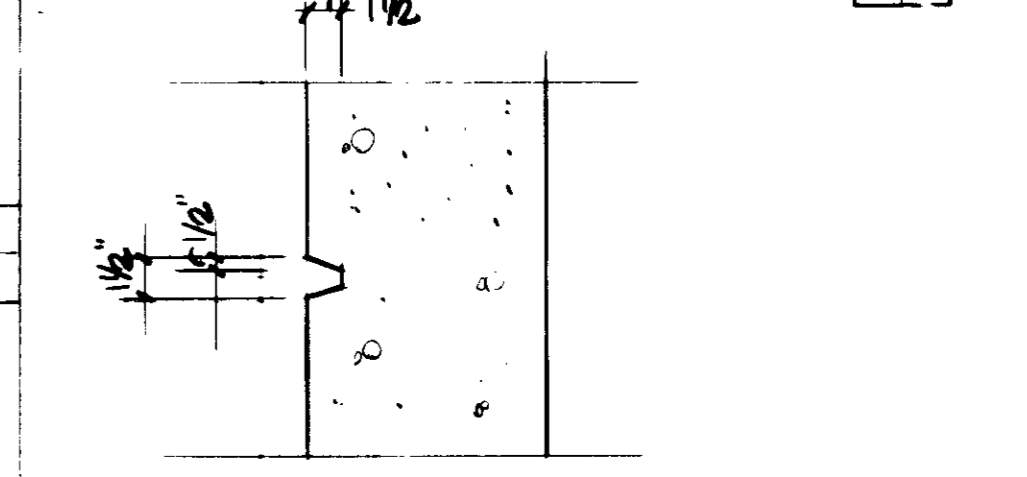

A2 GA-2

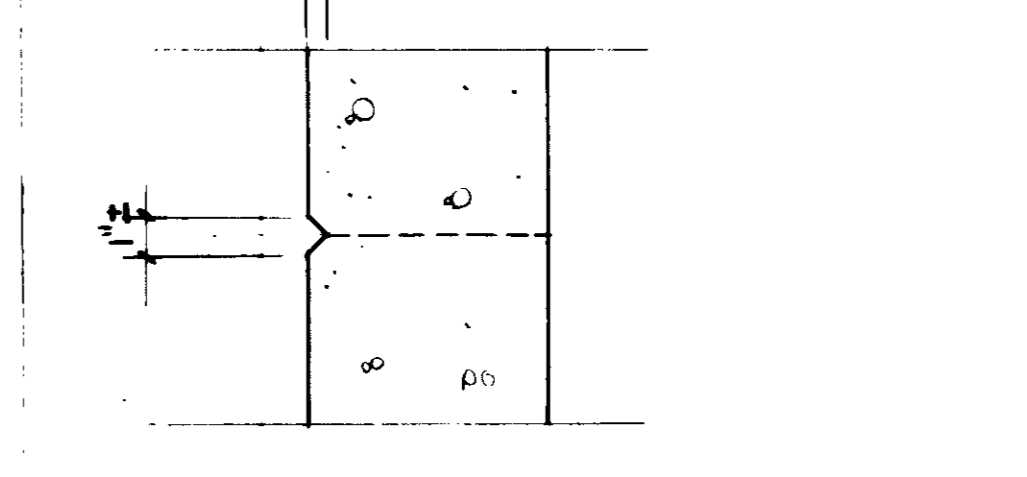

A3 GA-2

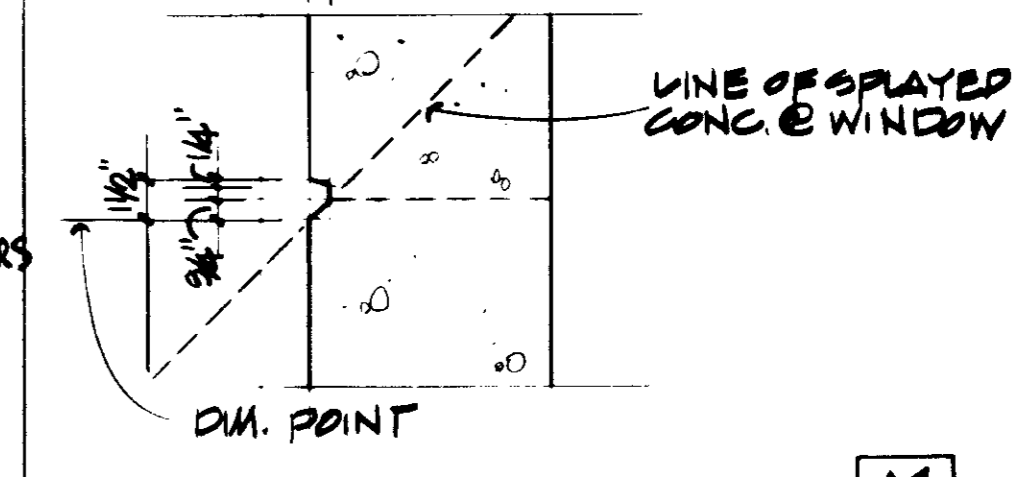

A4 GA-2


03544

RECORD DRAWING

HK IGT


Hardison Komatsu Ivelich & Tucker

RD 4/18/14 MDJ	RECORD DRAWINGS	SCALE: 1/2" = 1'-0" OR AS NOTED	DESIGNED: H/K	DRAWN: H/K	CHECKED: WAB	SUBMITTED: 27304 8/19/13	PROJECT ENGINEER: [Signature]	RECOMMENDED: [Signature]	DATE: 9/20/13	JAMES M. MONTGOMERY CONSULTING ENGINEERS, INC.	355 EAST WALNUT STREET, PASADENA, CALIFORNIA 91101	DISTRICT APPROVAL ON TITLE PAGE	LAS VIRGENES MWD/TRIUNFO CSD	TAPIA WRF - FILTRATION/DISINFECTION ADDITION	PHASE II	ARCHITECTURAL SCHEDULES, NOTES, AND DETAILS	SHEET A-1 OF 66 SHEETS
----------------	-----------------	---------------------------------	---------------	------------	--------------	--------------------------	-------------------------------	--------------------------	---------------	--	--	---------------------------------	------------------------------	--	----------	---	------------------------

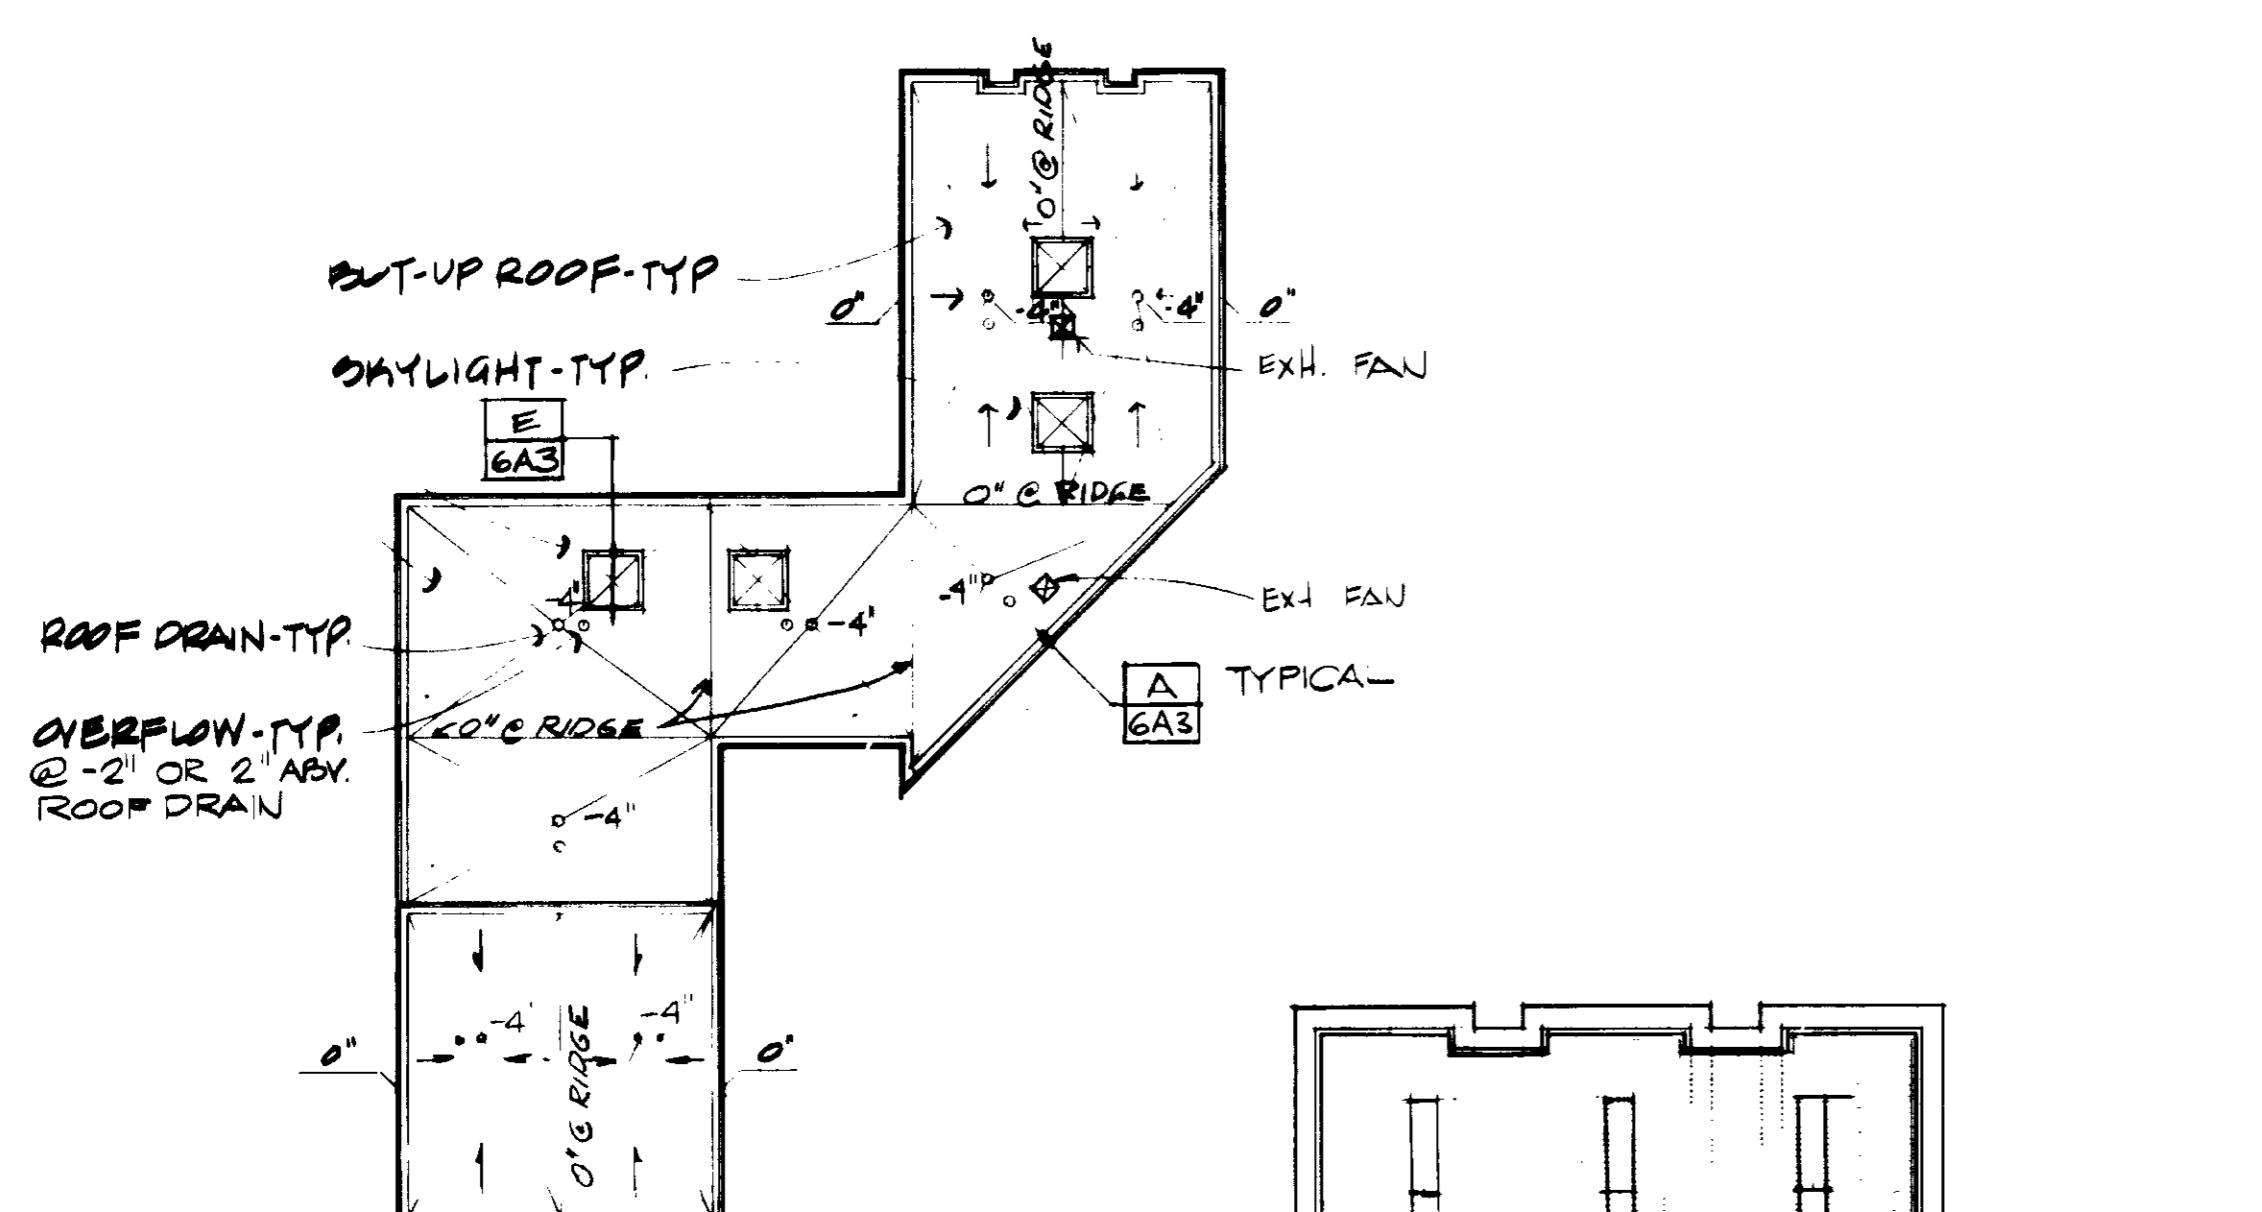

ROOF PLAN

1/16"

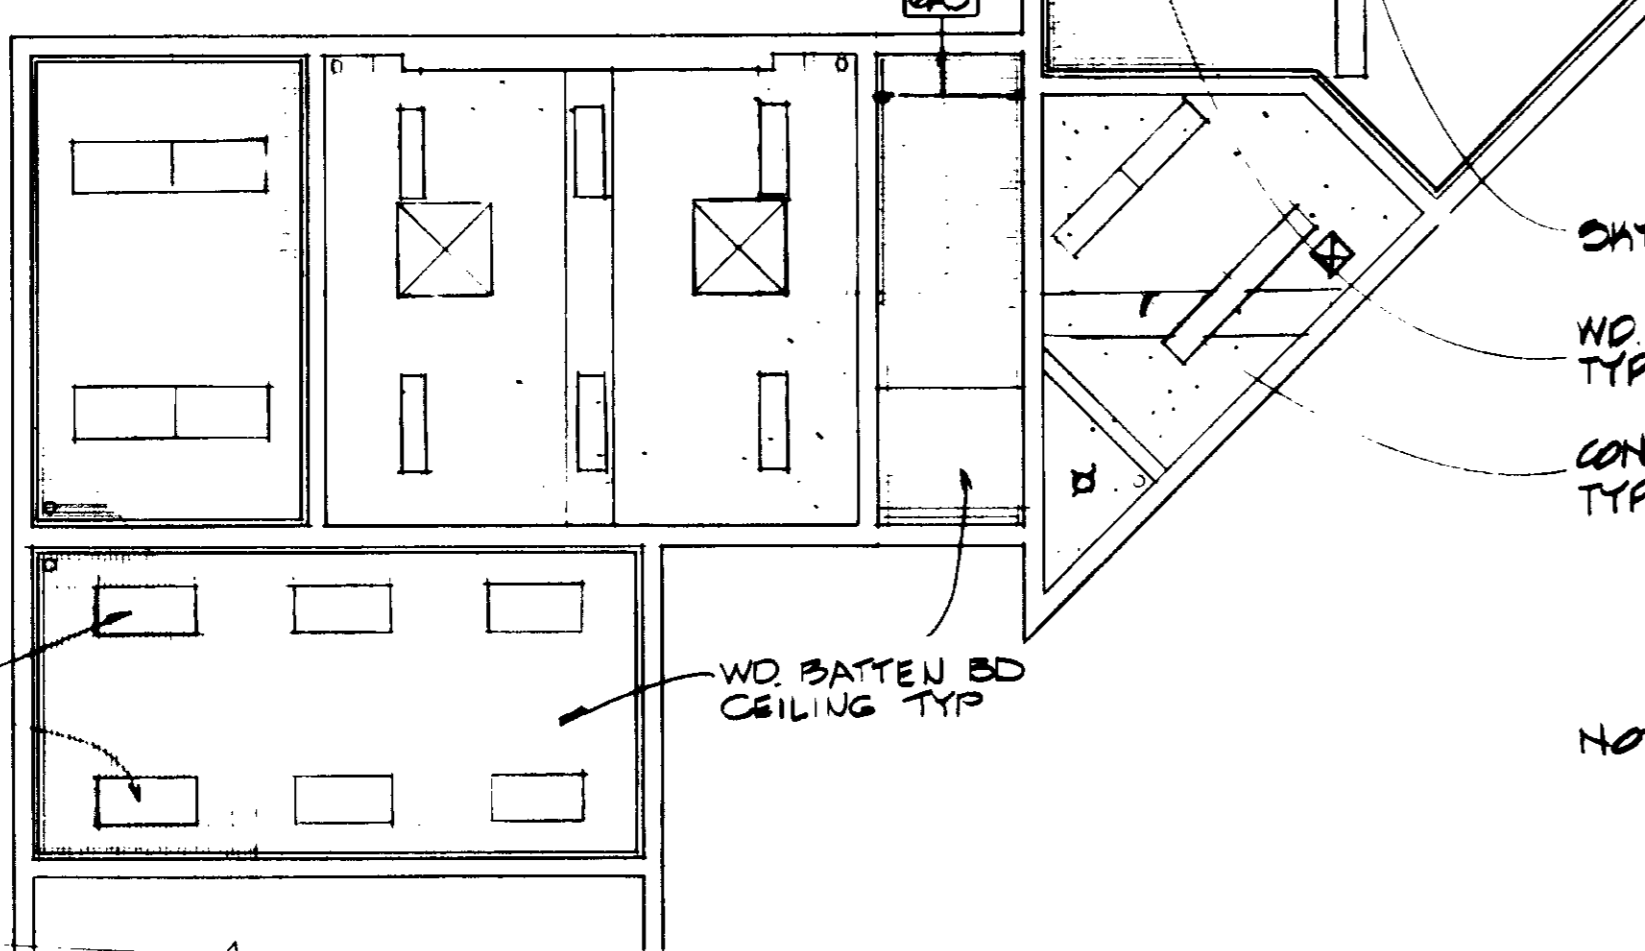


PARTIAL REFLECTED CEILING PLAN

1/8"

NOTE: REFER TO CIVIL, STRUCTURAL, MECHANICAL, ELECTRICAL DRAWINGS FOR FIXTURES, EQUIPMENTS & OTHER INFORMATION.

SEE SHEET A-1 FOR DOOR, WINDOW AND ROOM FINISH SCHEDULES

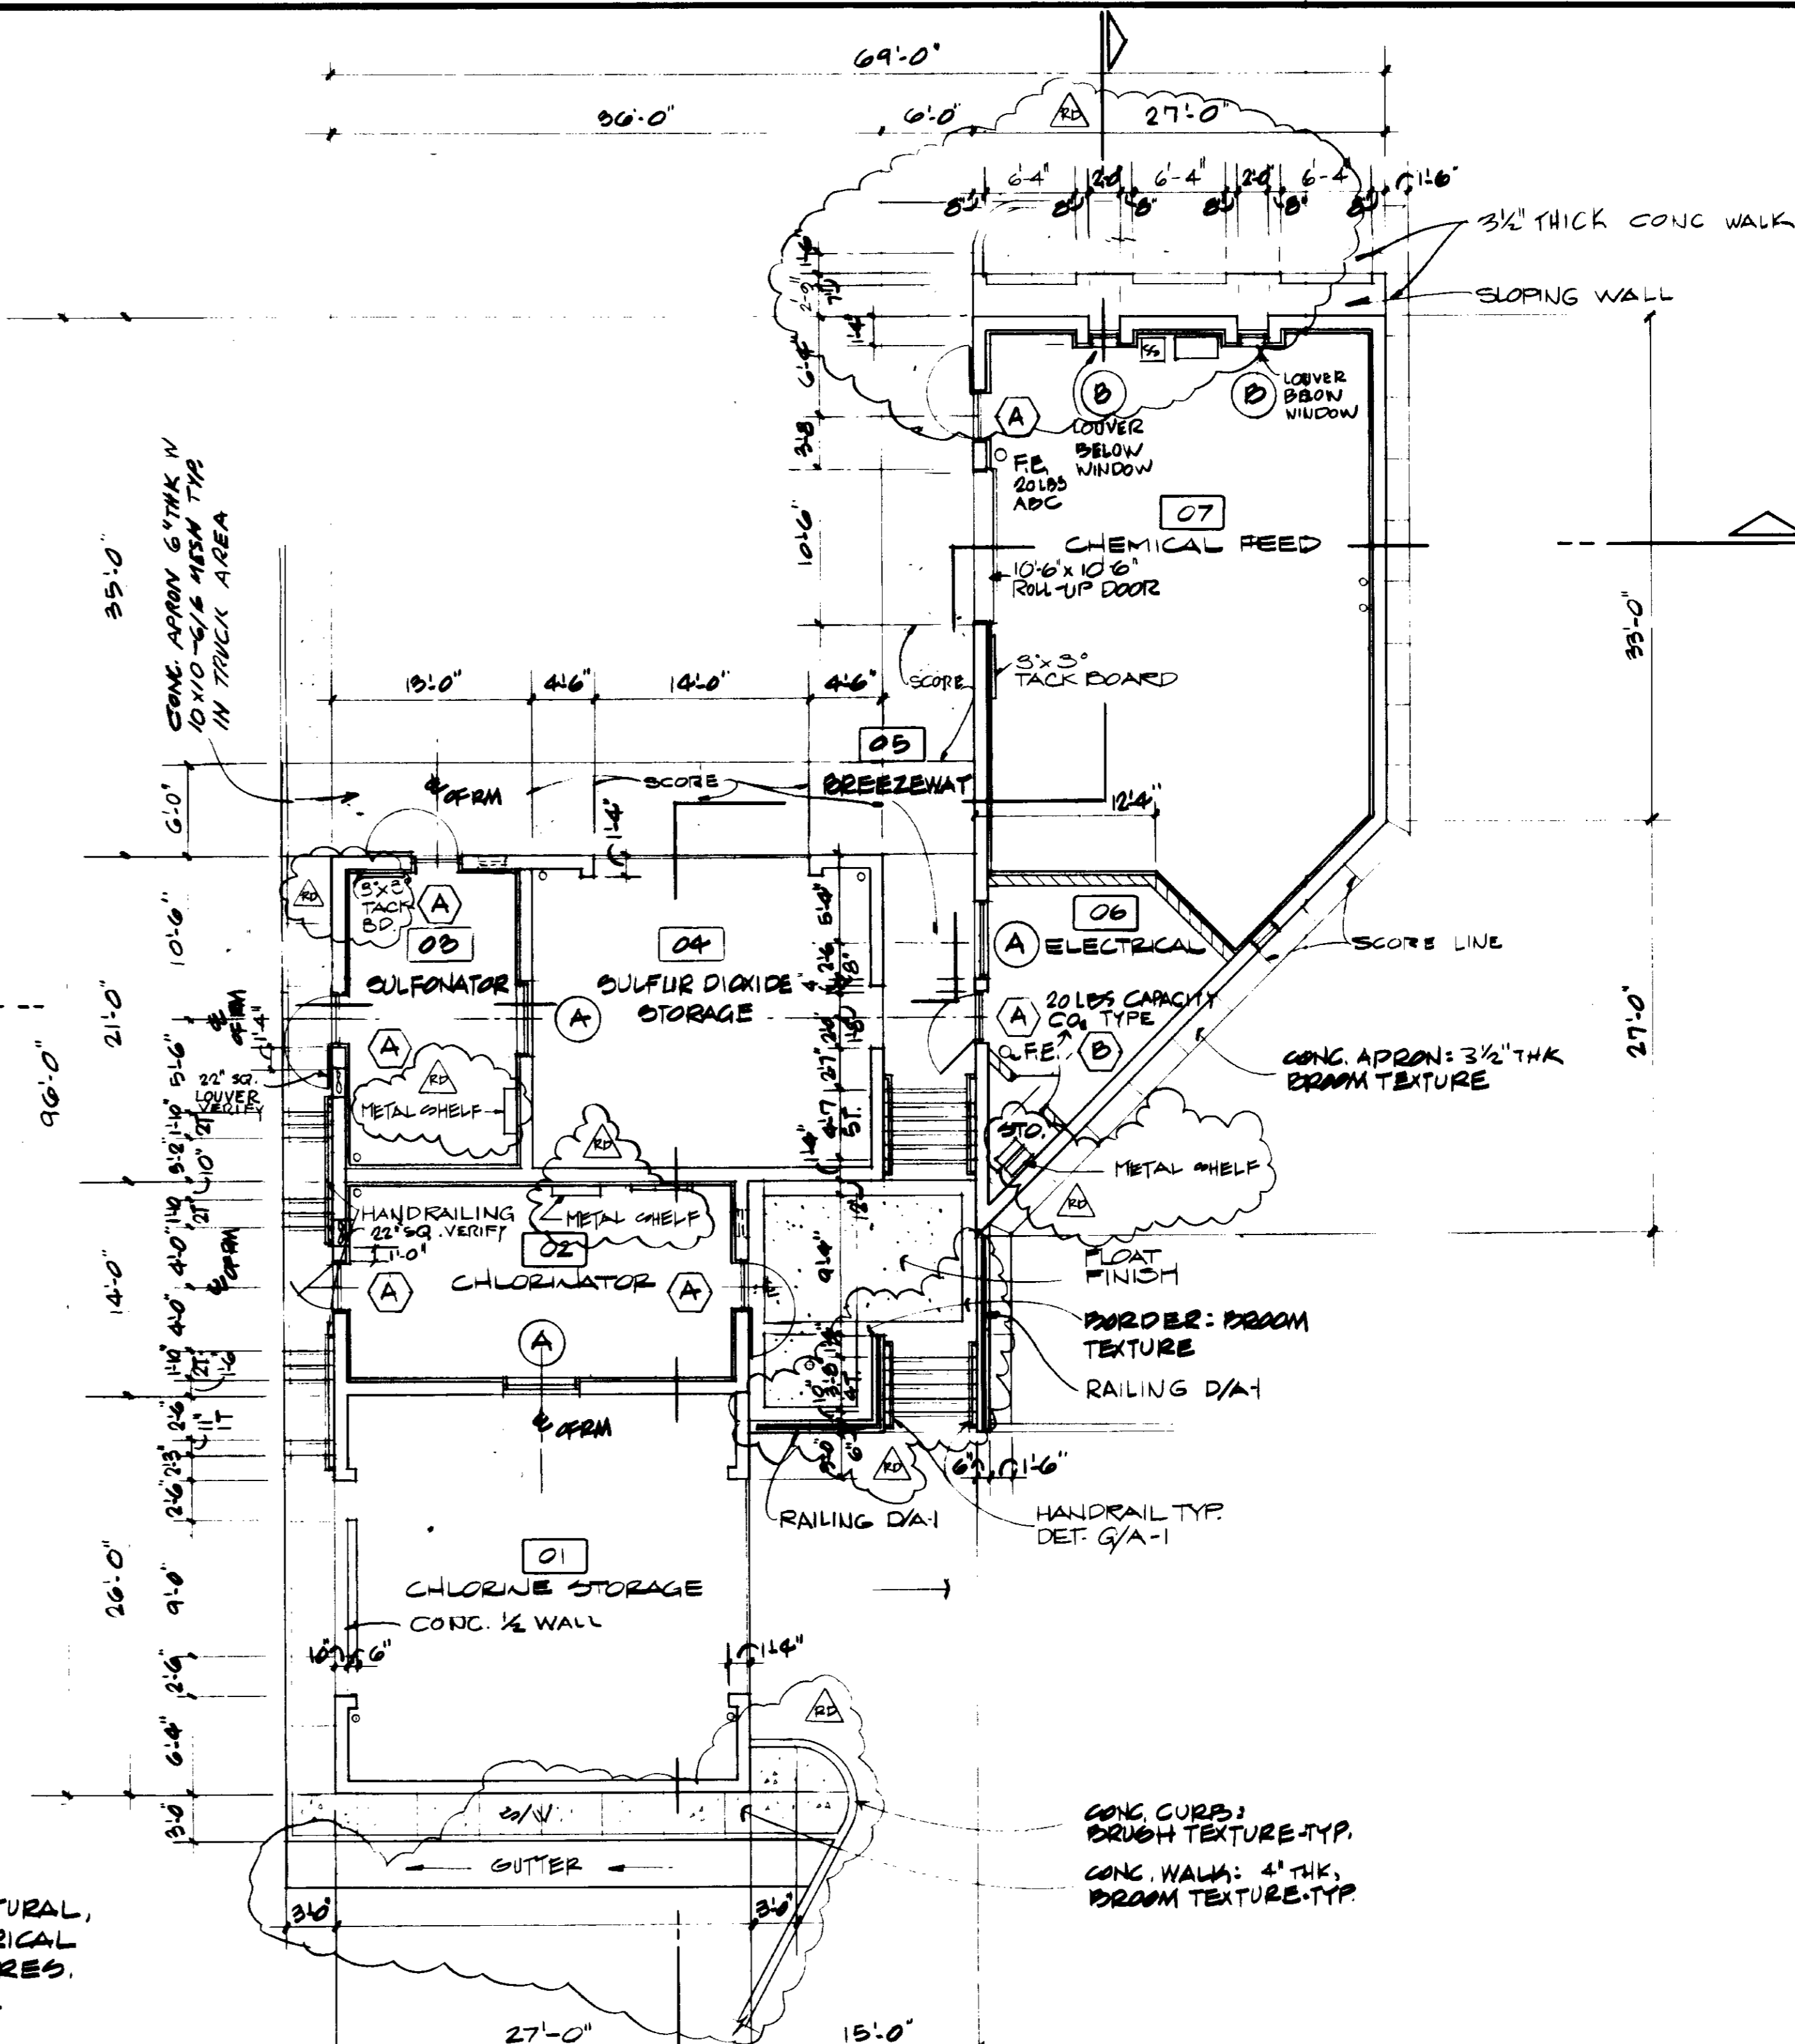

FLOOR PLAN

1/8"

CONG. CURBS: BRUSH TEXTURE-TYP.
CONG. WALKS: 4\"/>

REFER TO SHEET A-1 FOR FINISH, DOOR, AND WINDOW SCHEDULES

03545

RECORD DRAWING



RD	1/1/84	MPU	RECORD DRAWINGS
REV	DATE	BY	DESCRIPTION

SCALE:	DESIGNED	H/K
AS NOTED	DRAWN	H/K
	CHECKED	W/HB

SUBMITTED	27304	8/19/81
PROJECT ENGINEER	R.C.E. NO.	DATE
RECOMMENDED	27638	3/20/81
JAMES M. MONTGOMERY CONSULTING ENGINEERS, INC.	R.C.E. NO.	DATE







JAMES M. MONTGOMERY CONSULTING ENGINEERS, INC.
355 EAST WALNUT STREET, PASADENA, CALIFORNIA 91101

DISTRICT APPROVAL ON TITLE PAGE

LAS VIRGENES MWD/TRIUNFO CSD	
TAPIA WRF - FILTRATION/DISINFECTION ADDITION	
PHASE II	CHEMICAL BUILDING - PLAN

SHEET
6A-1
OF 66 SHEETS

NOTE: EXPOSED CONCRETE TEXTURE: SMOOTH WHERE SHOWN

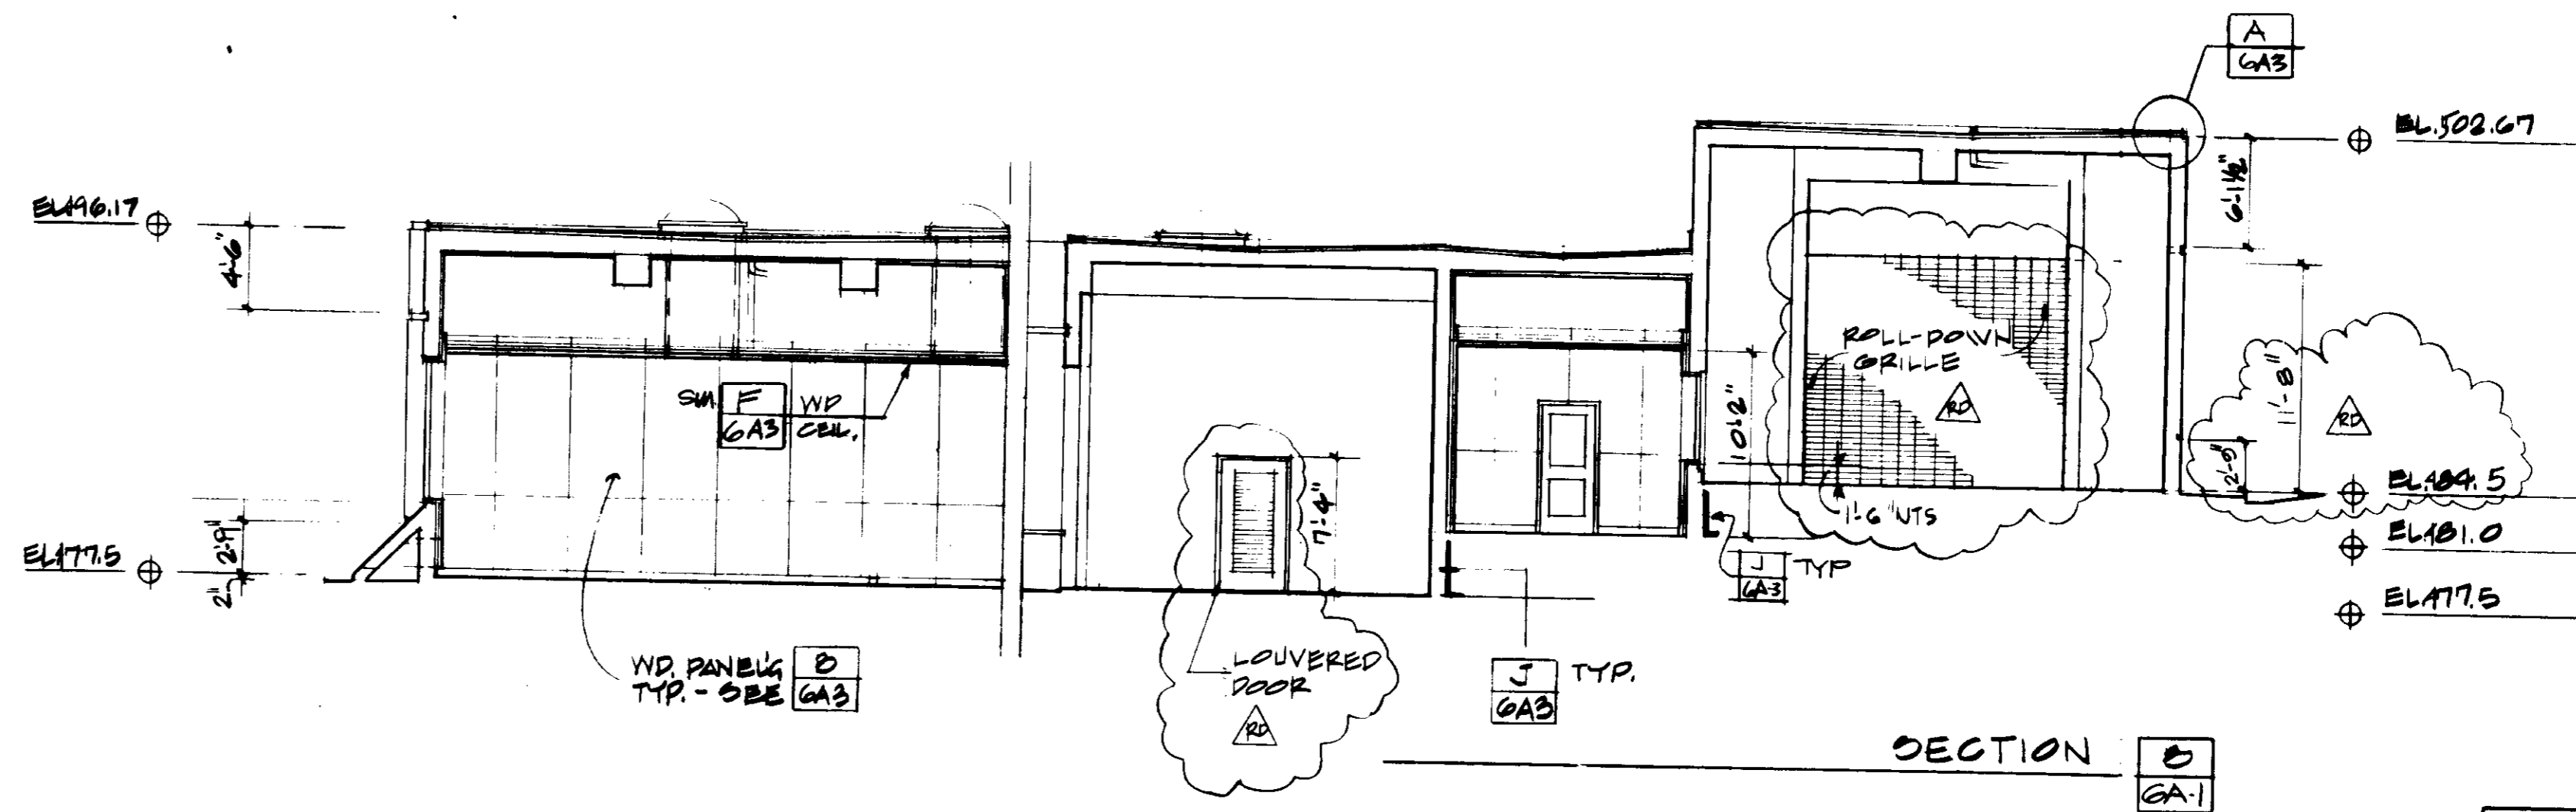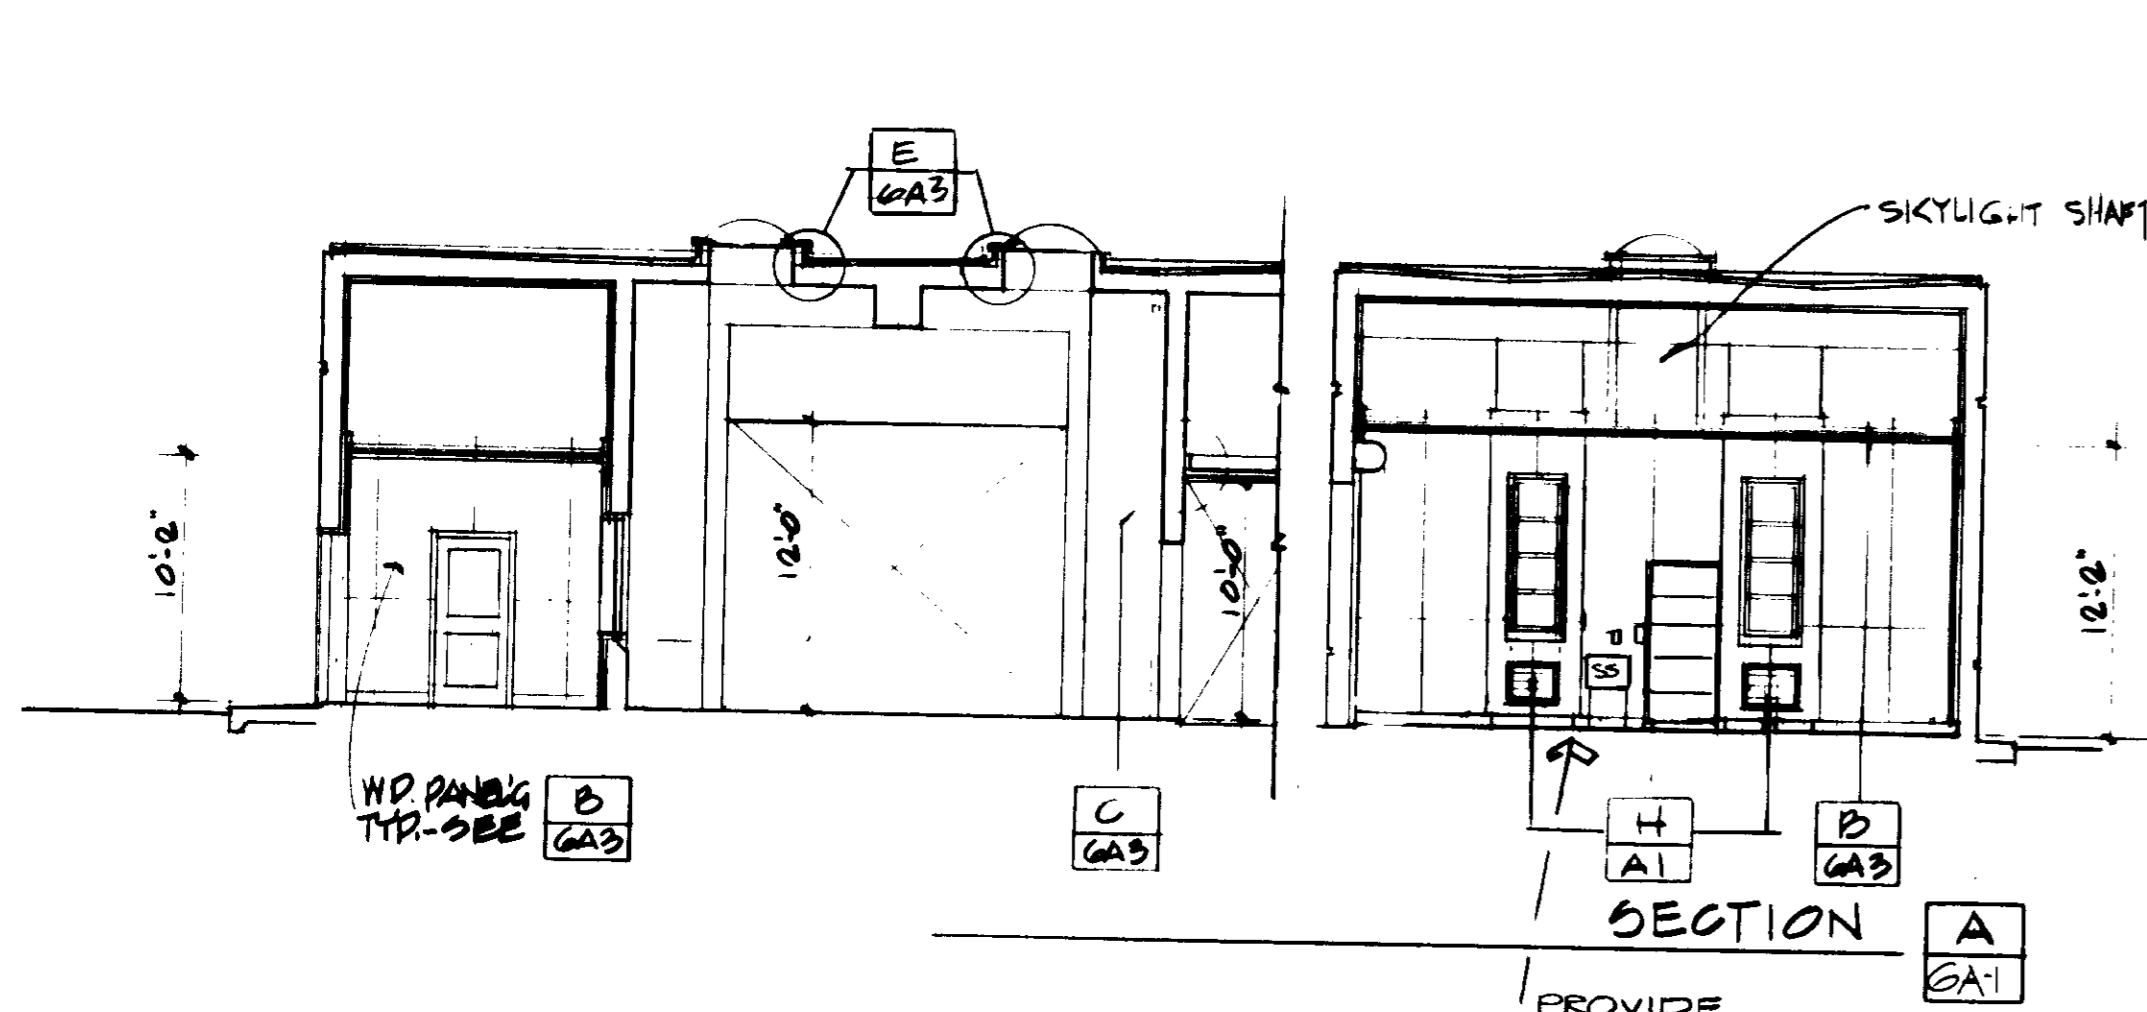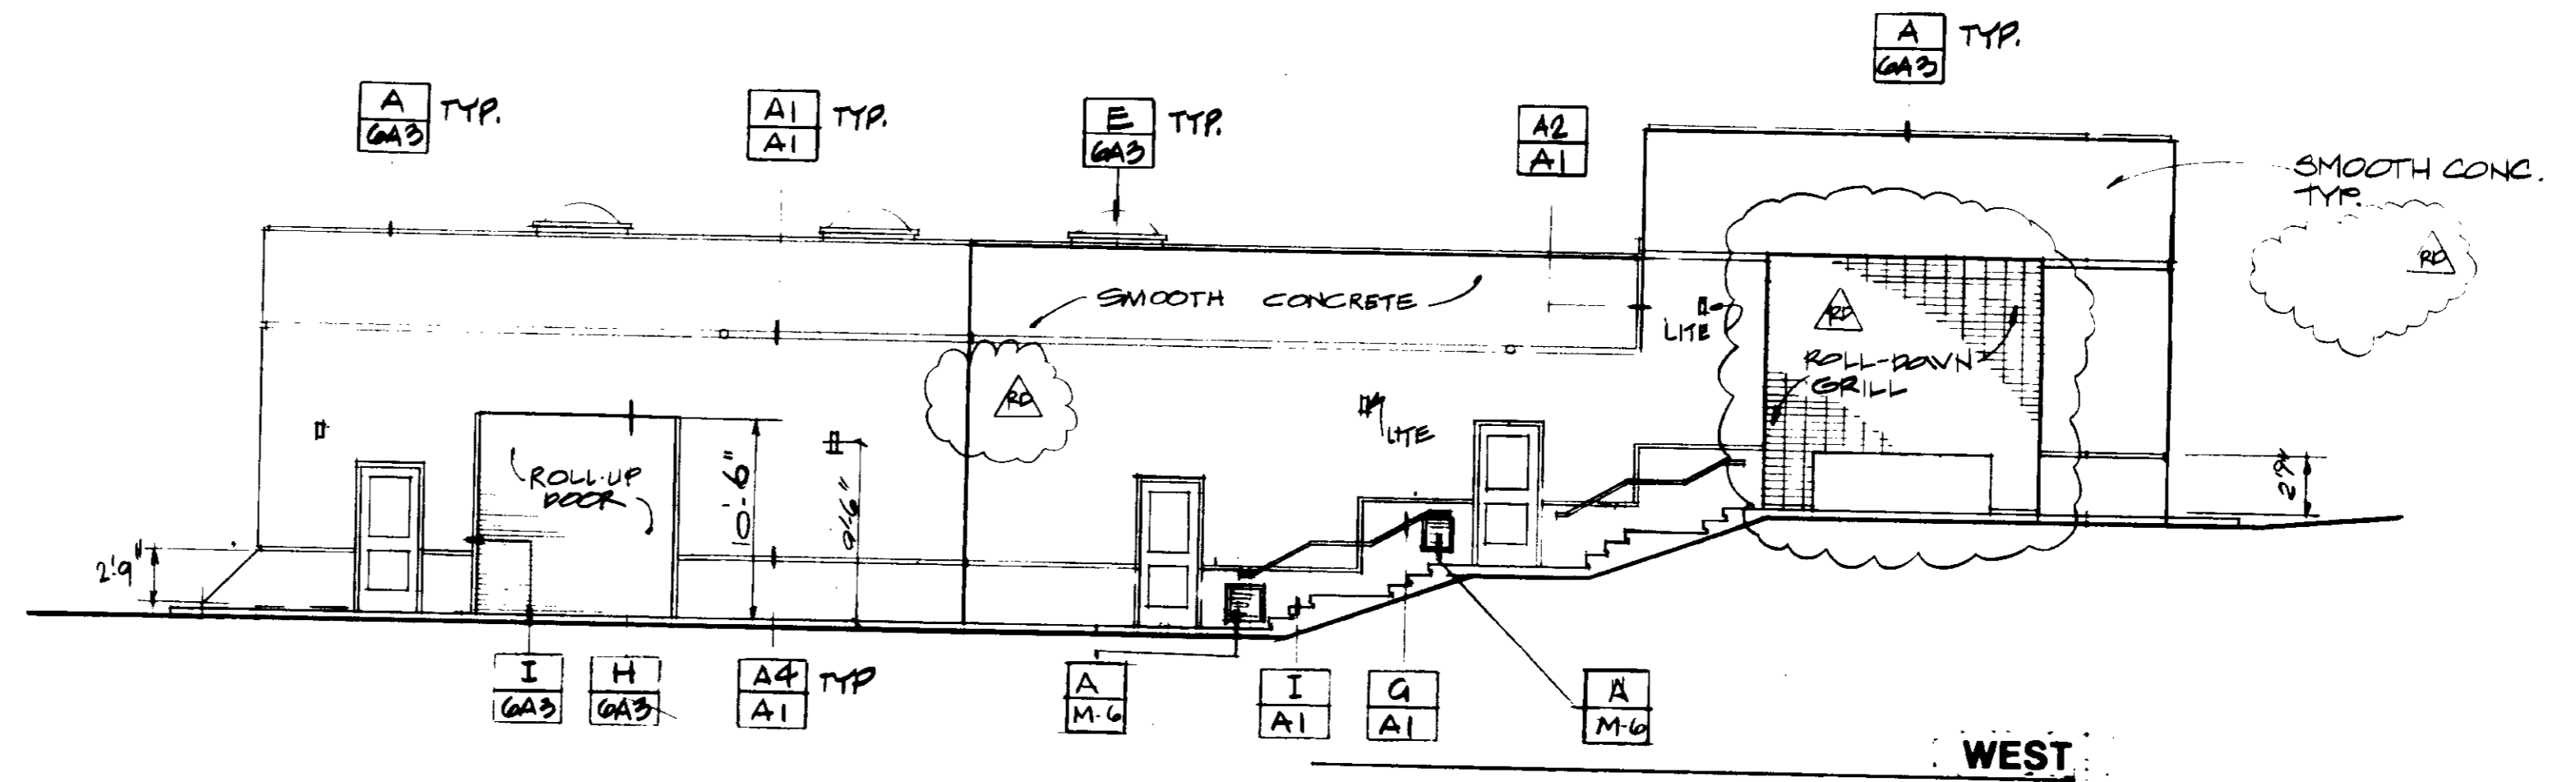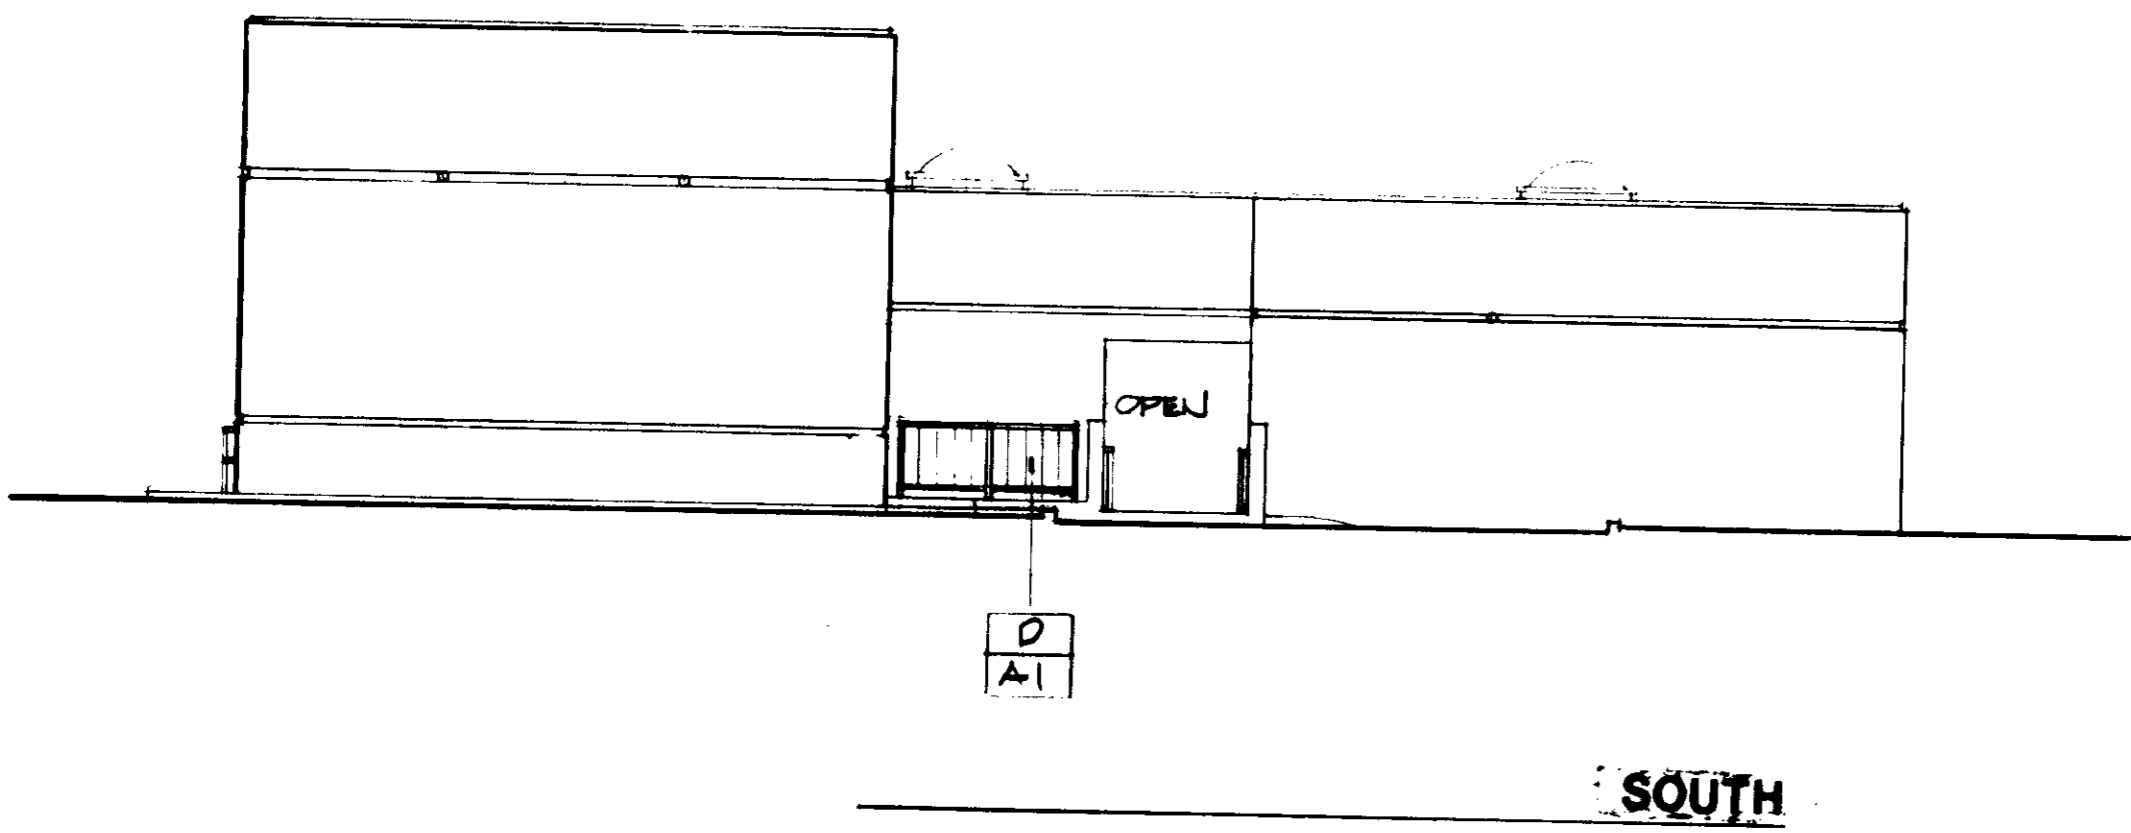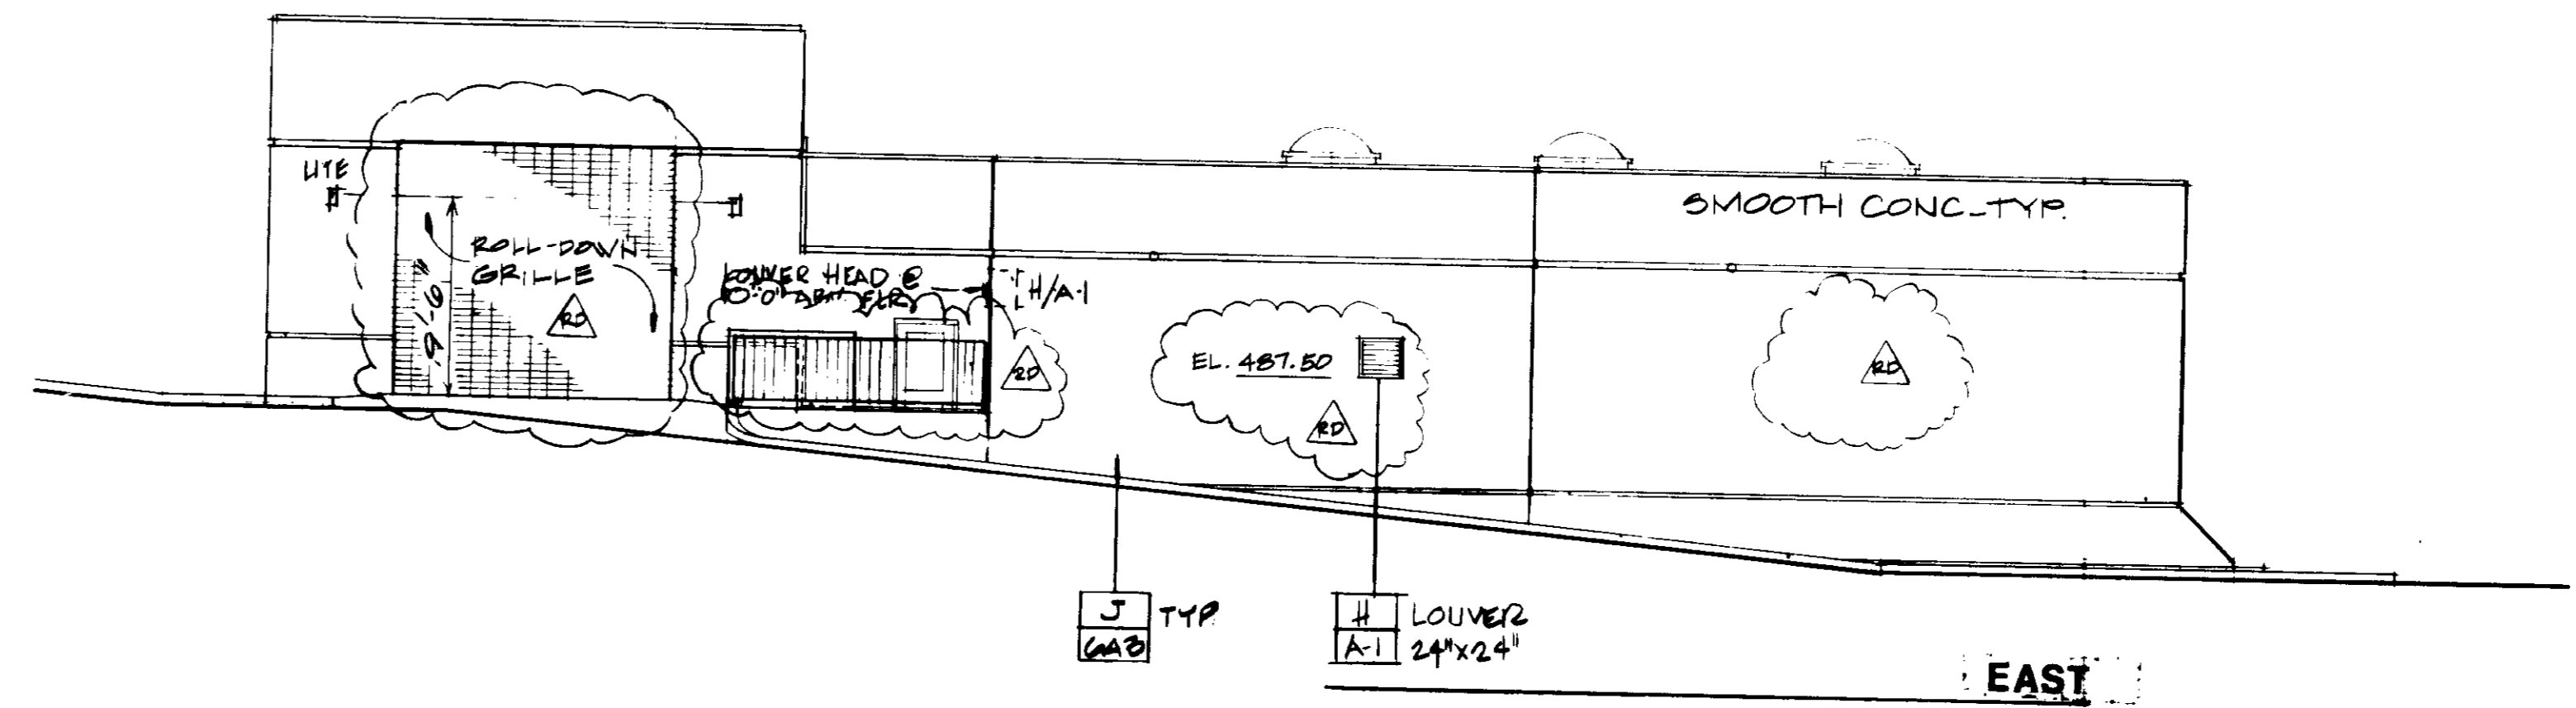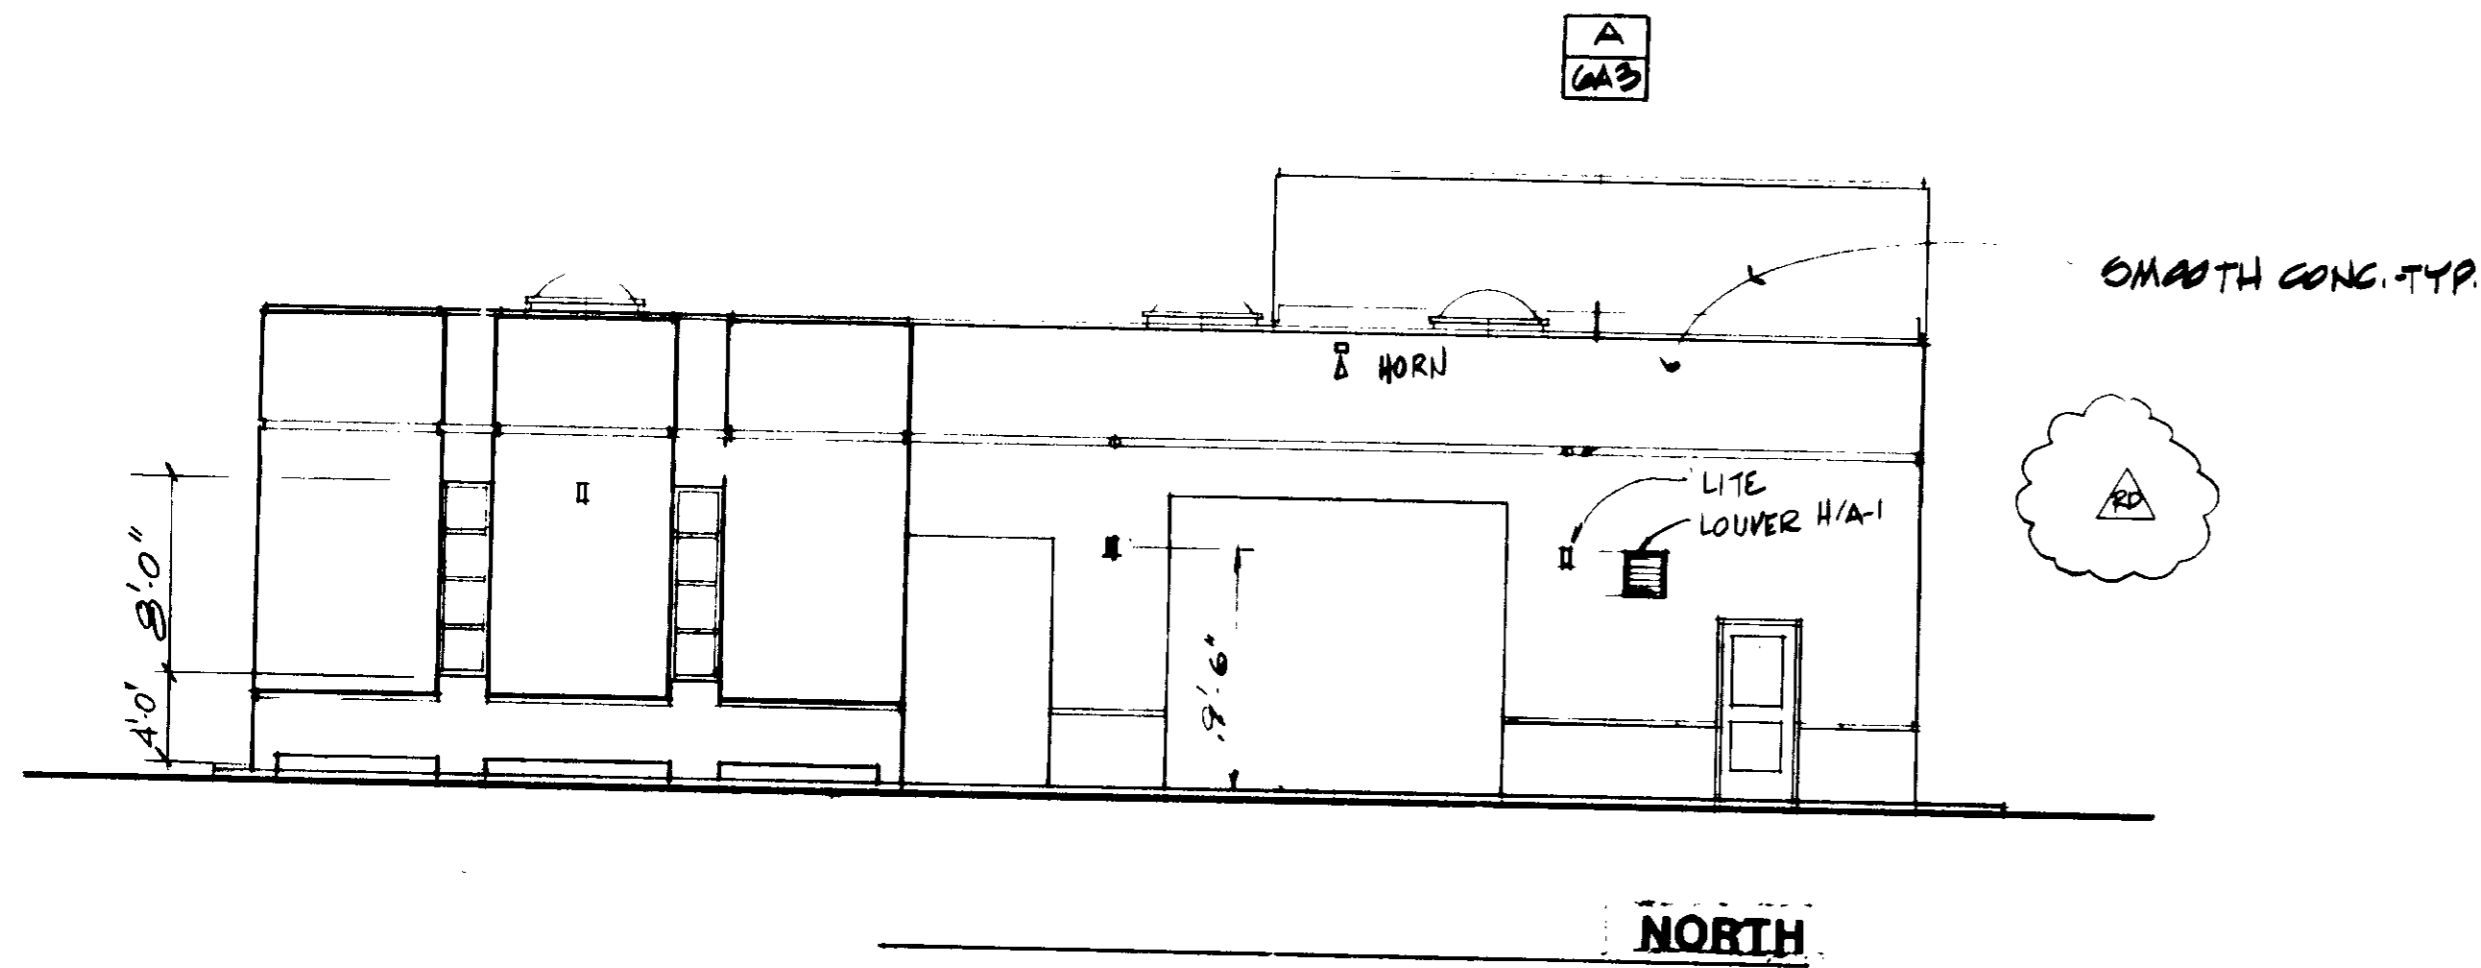

PROVIDE
1- MOP RACK
1- SOAP DISPENSOR
1- PAPER TOWEL DISPENSOR

310-0070
JOB NO.
QENT. NO.

6667
FRAM
NO.

SCALE:
1/8" = 1'-0"

DESIGNED H/K
DRAWN H/K
CHECKED W/B

SUBMITTED
PROJECT ENGINEER
RECOMMENDED
DATE

27304
3/19/81

27638
3/23/81

JAMES M. MONTGOMERY CONSULTING ENGINEERS, INC.
355 EAST WALNUT STREET, PASADENA, CALIFORNIA 91101



DISTRICT APPROVAL ON TITLE PAGE


03546
RECORD DRAWING

LAS VIRGENES MWD/TRIUNFO CSD
TAPIA WRF - FILTRATION/DISINFECTION ADDITION
PHASE II
CHEMICAL BUILDING - ELEVATIONS AND SECTIONS




SHEET
6A-2
OF 66 SHEETS


REV	DATE	BY	DESCRIPTION

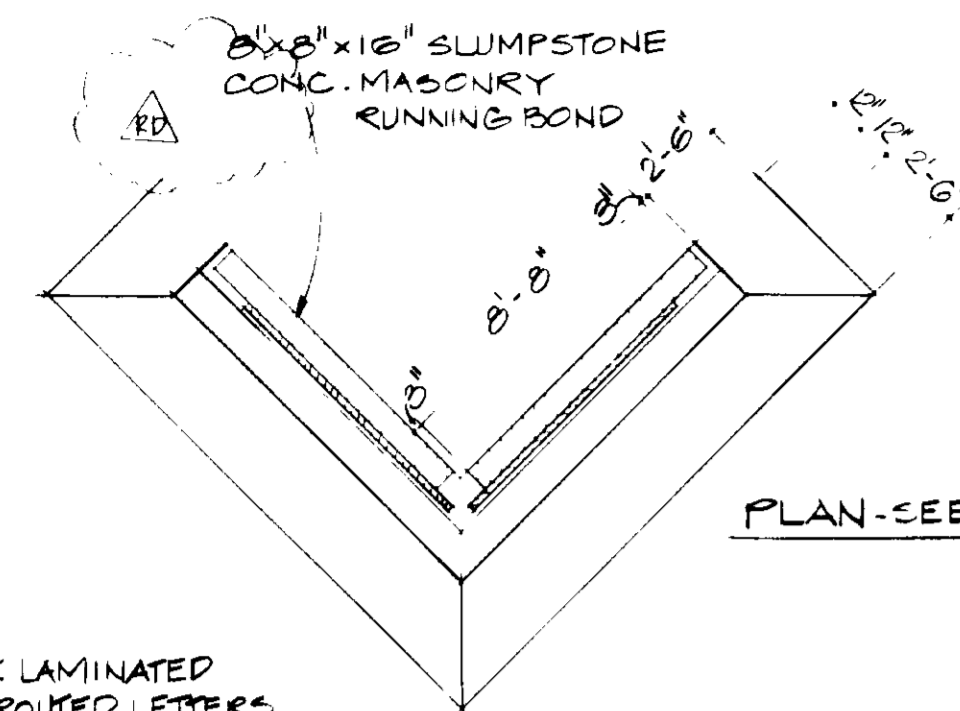

PLAN - SEE SITE PLAN AND C-1 FOR LOCATION

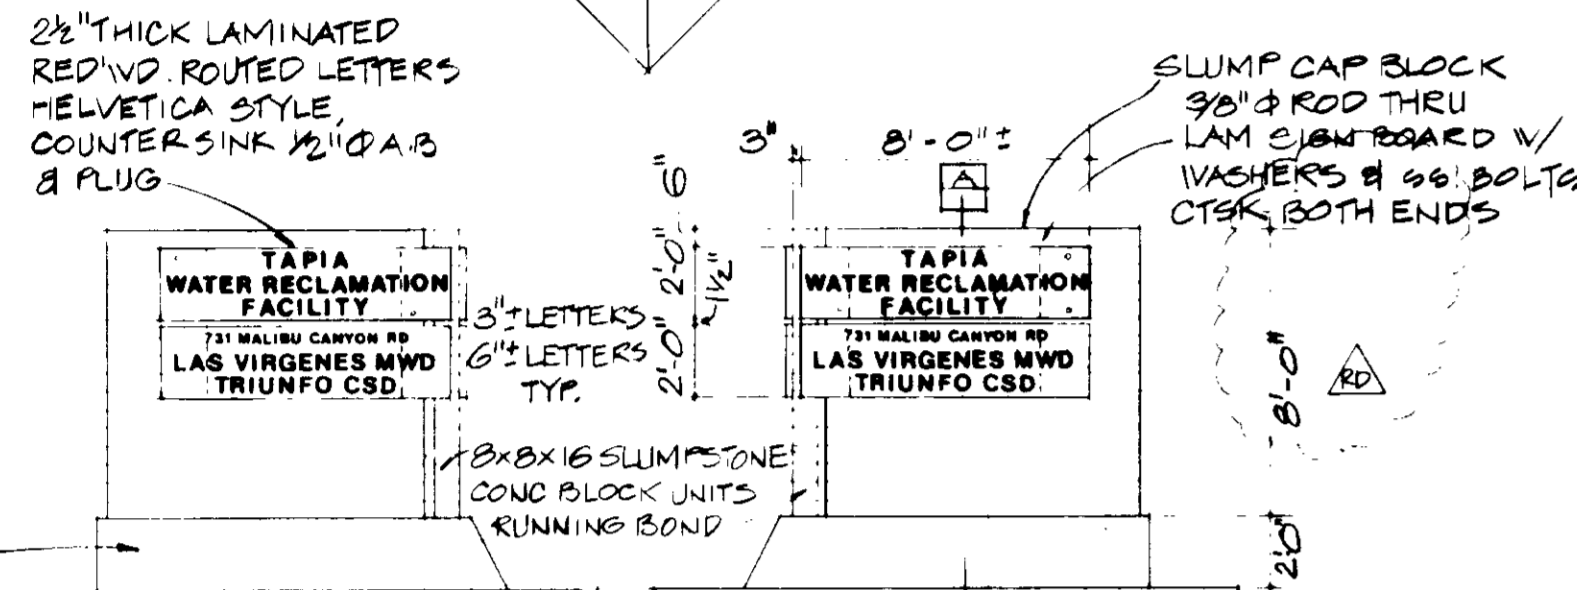

PLANT SIGN

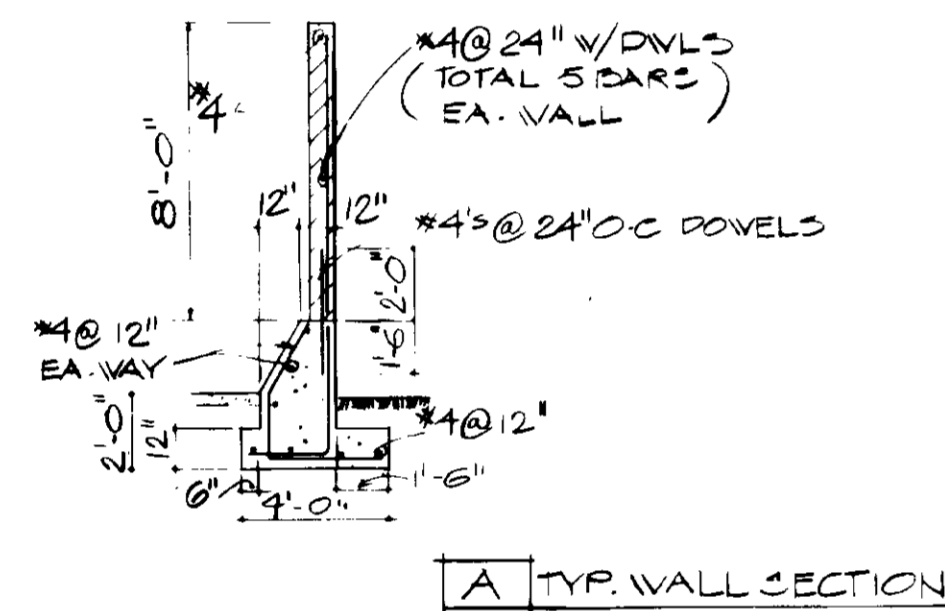

A TYP. WALL SECTION

PLANT SIGN

I

DAMP PROOFING

J

TYP. PROJECTING & FIXED WINDOW




G

TYP. HM. DOOR & FRAME

D

TYP. FURRED WALL & SUSP. CEILING

B

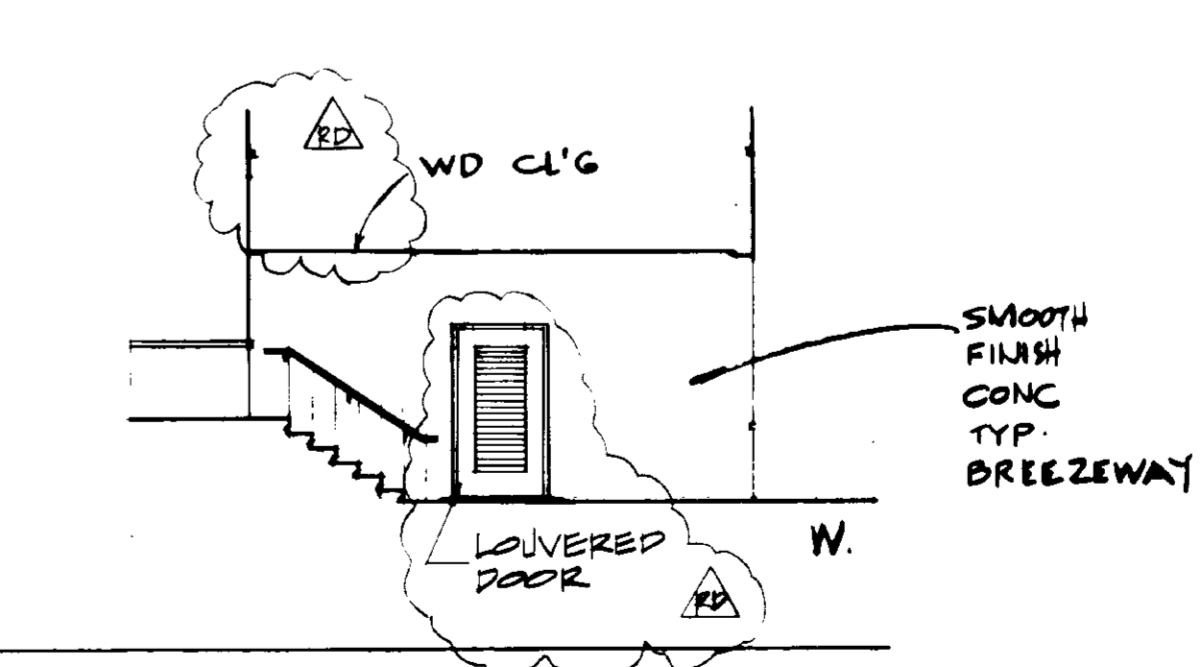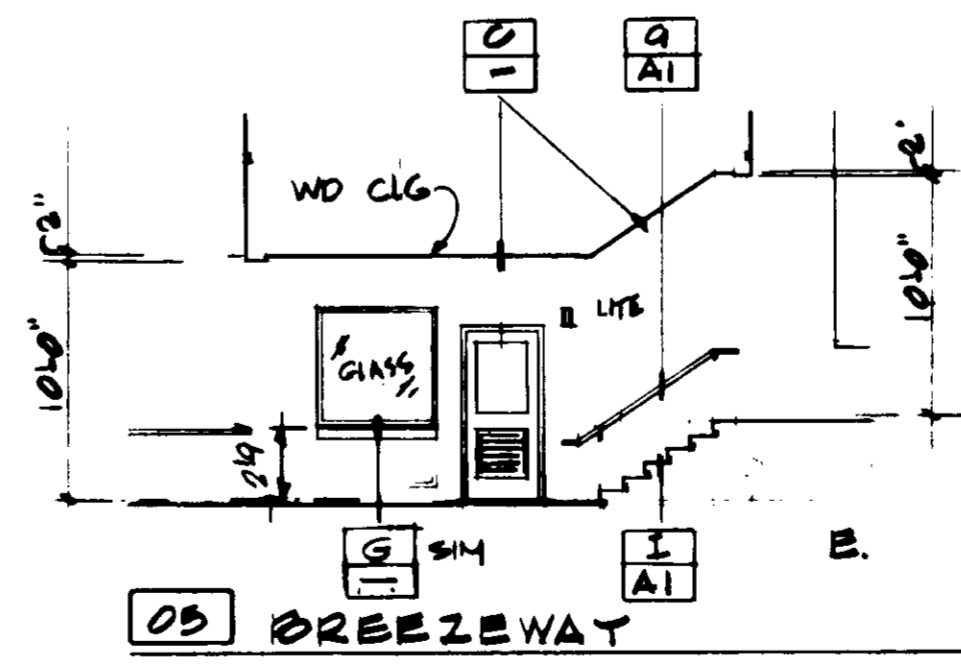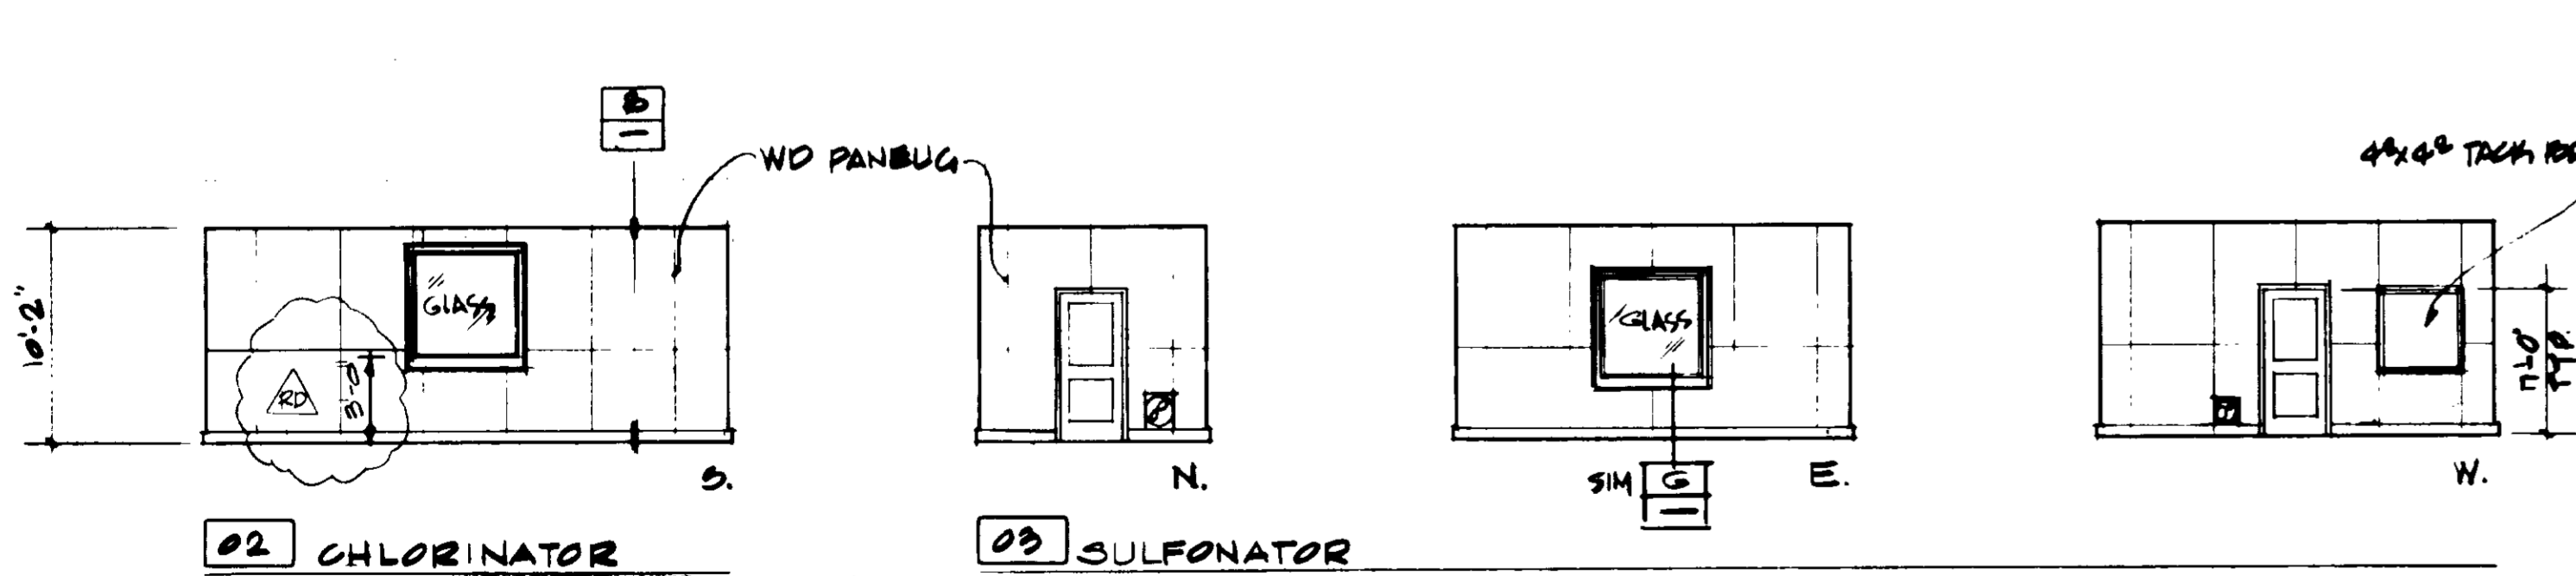

03547

INTERIOR ELEVATIONS
RECORD DRAWING



RD/MB/HDU	RECORD DRAWINGS
DATE	DESCRIPTION


SCALE:	DESIGNED:	H/K
1/8" = 1'-0"	DRAWN:	H/K
OR AS NOTED	CHECKED:	LHB

SUBMITTED	27304	8/19/81
PROJECT ENGINEER	R.C.E. NO.	DATE
RECOMMENDED BY	27638	8/20/81
JAMES M. MONTGOMERY CONSULTING ENGINEERS, INC.	R.C.E. NO.	DATE

JAMES M. MONTGOMERY CONSULTING ENGINEERS, INC.
355 EAST WALNUT STREET, PASADENA, CALIFORNIA 91101

DISTRICT APPROVAL ON TITLE PAGE

LAS VIRGENES MWD/TRIUNFO CSD	SHEET
TAPIA WRF - FILTRATION/DISINFECTION ADDITION	6A-3
PHASE II	CHEMICAL BUILDING - INTERIOR ELEVATIONS AND DETAILS
	OF 66 SHEETS

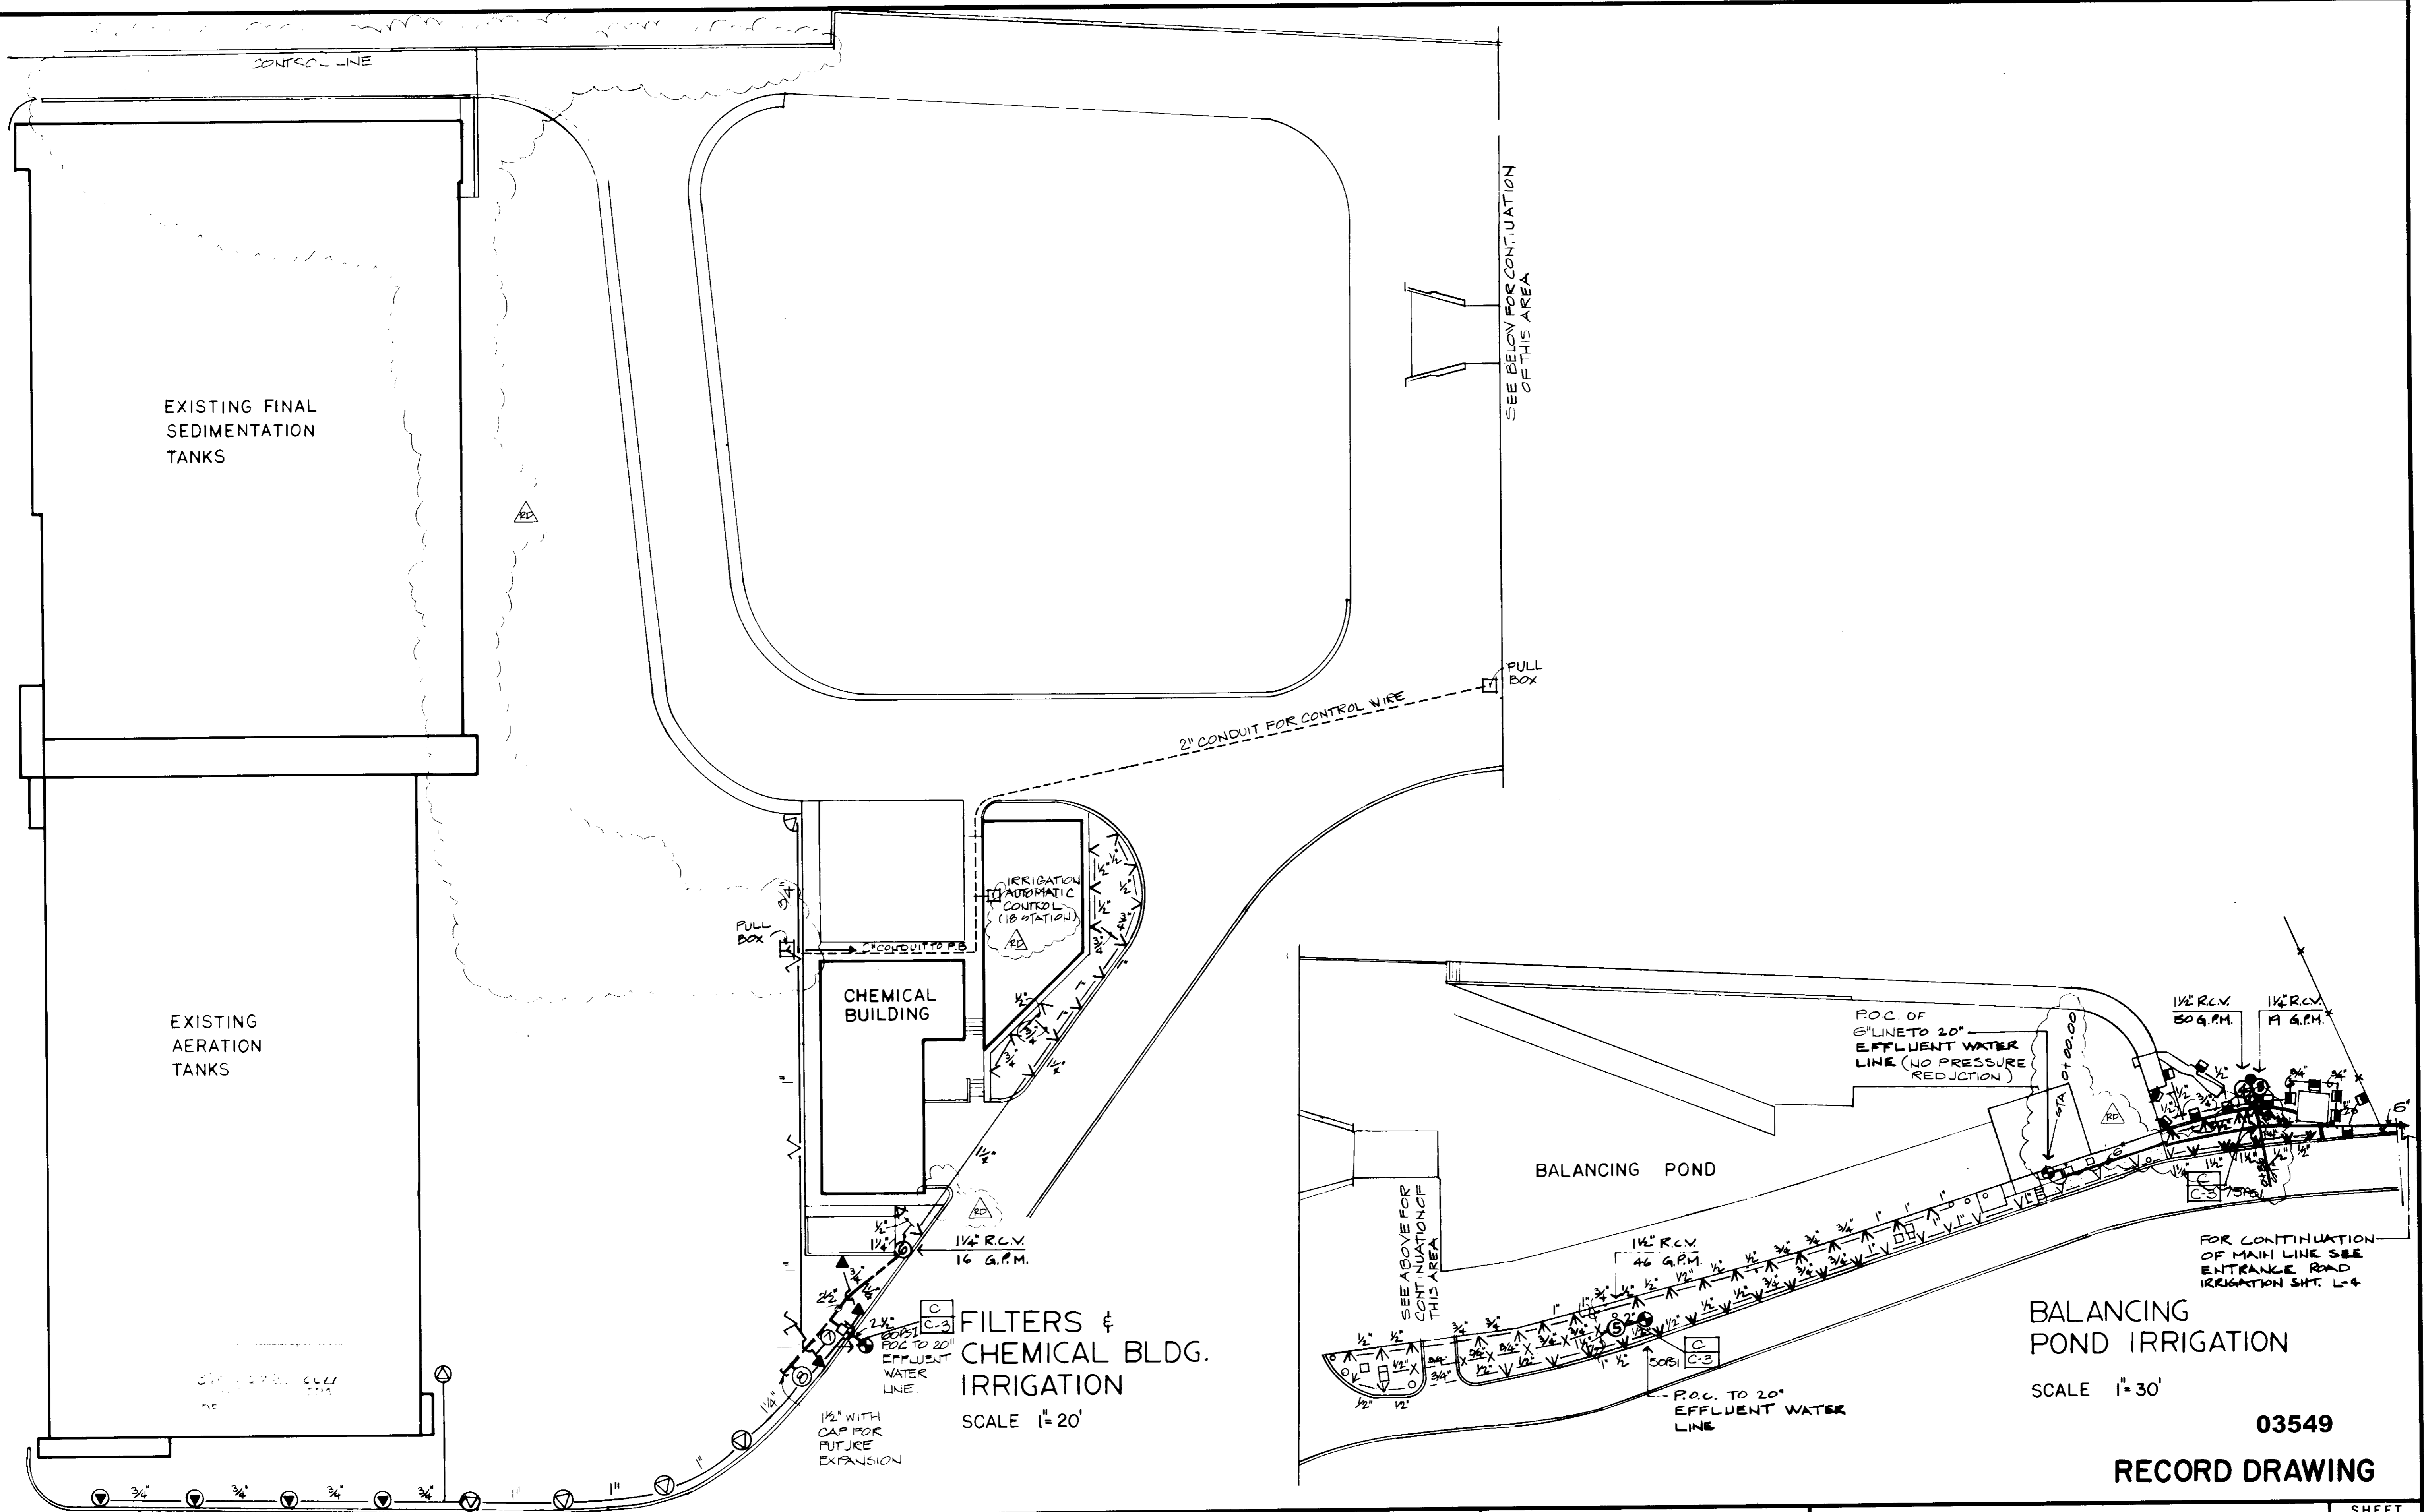

FILTERS & CHEMICAL BLDG. IRRIGATION
SCALE 1"=20'

BALANCING POND IRRIGATION
SCALE 1"=30'

03549

RECORD DRAWING

RD	DATE	BY	DESCRIPTION

SCALE:
AS SHOWN

DESIGNED **EPT**
DRAWN **EPT**
CHECKED **EPT**

SUBMITTED
PROJECT ENGINEER
RECOMMENDED
JAMES M. MONTGOMERY CONSULTING ENGINEERS, INC.








JAMES M. MONTGOMERY CONSULTING ENGINEERS, INC.
355 EAST WALNUT STREET, PASADENA, CALIFORNIA 91101




DISTRICT APPROVAL ON TITLE PAGE

LAS VIRGENES MWD/TRIUNFO GSD
TAMPA WRF - FILTRATION/DISINFECTION ADDITION
PHASE II
IRRIGATION PLAN

SHEET
L-2
OF 00 SHEETS

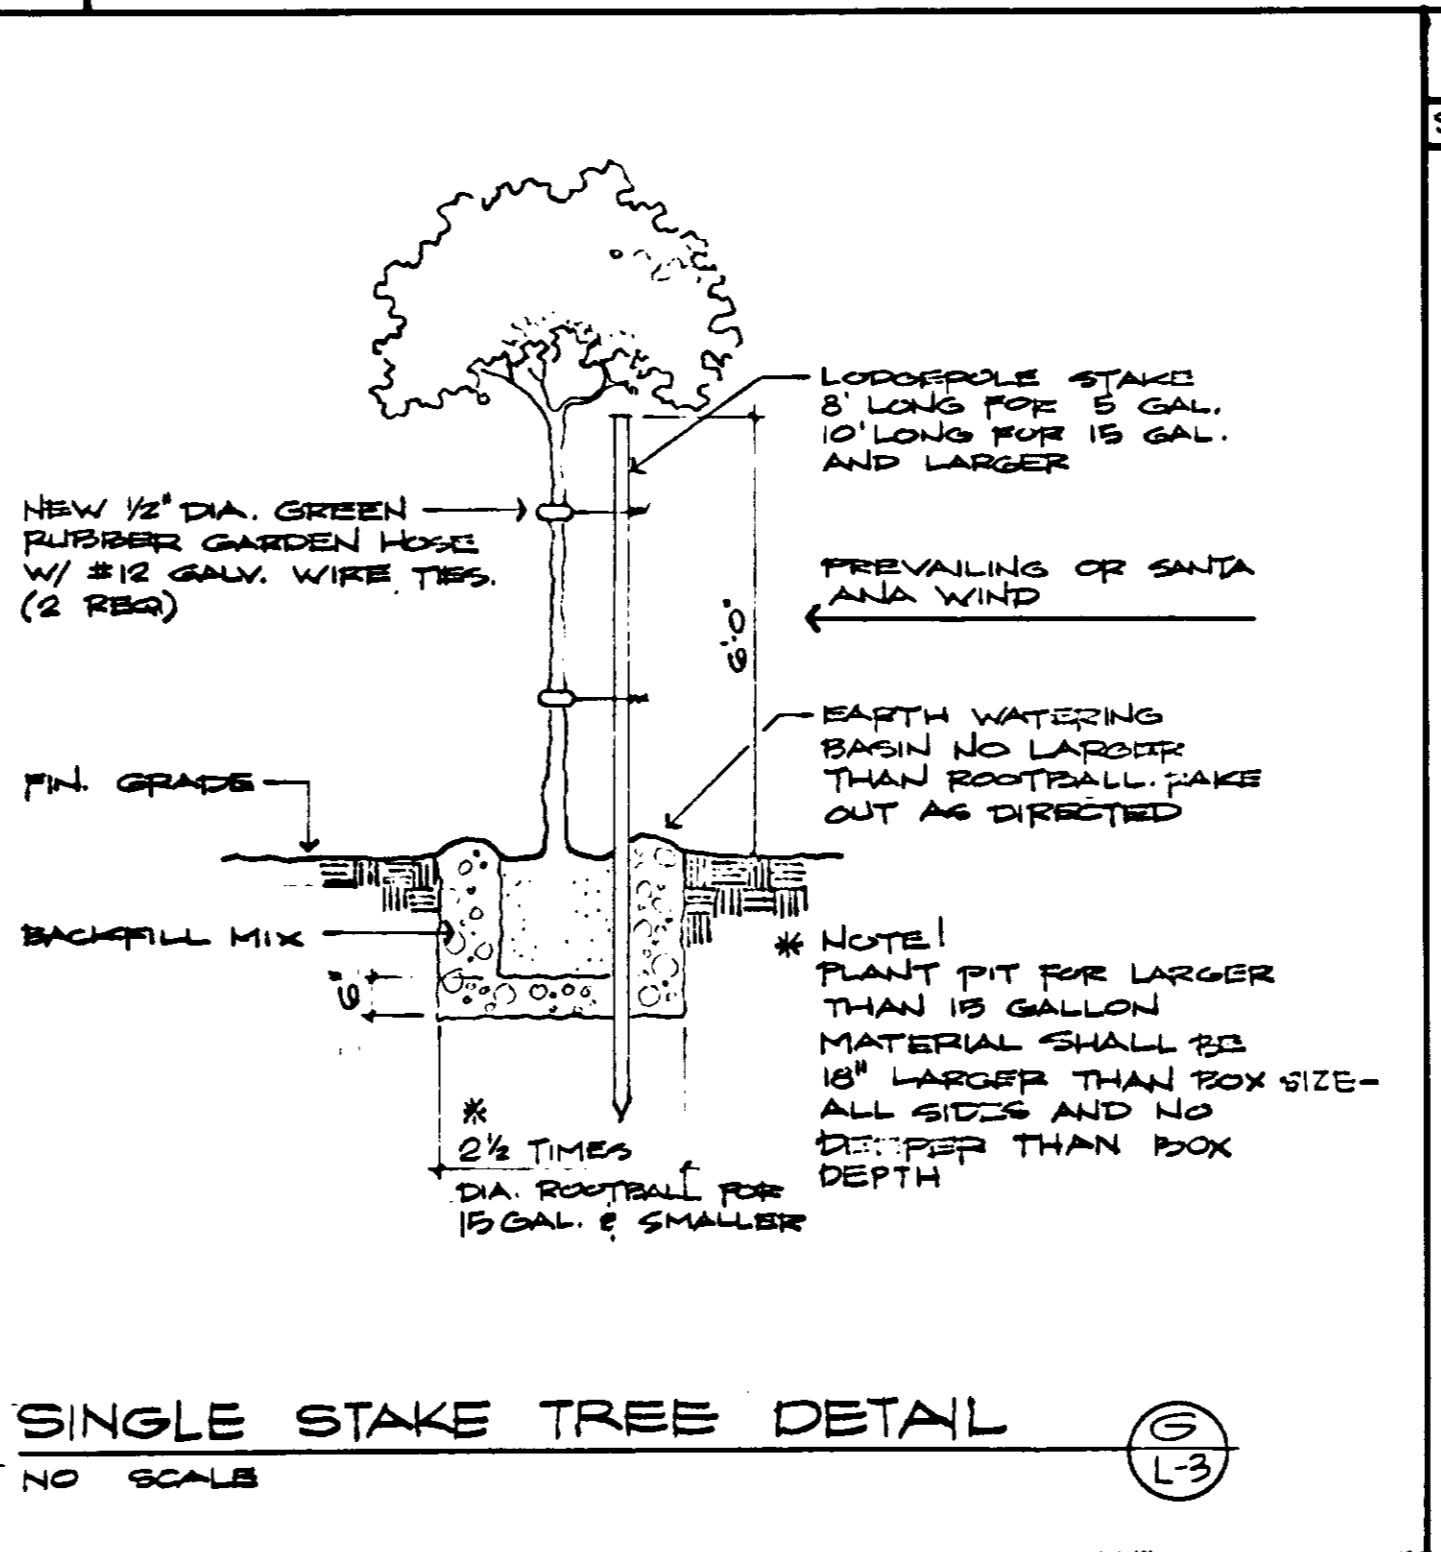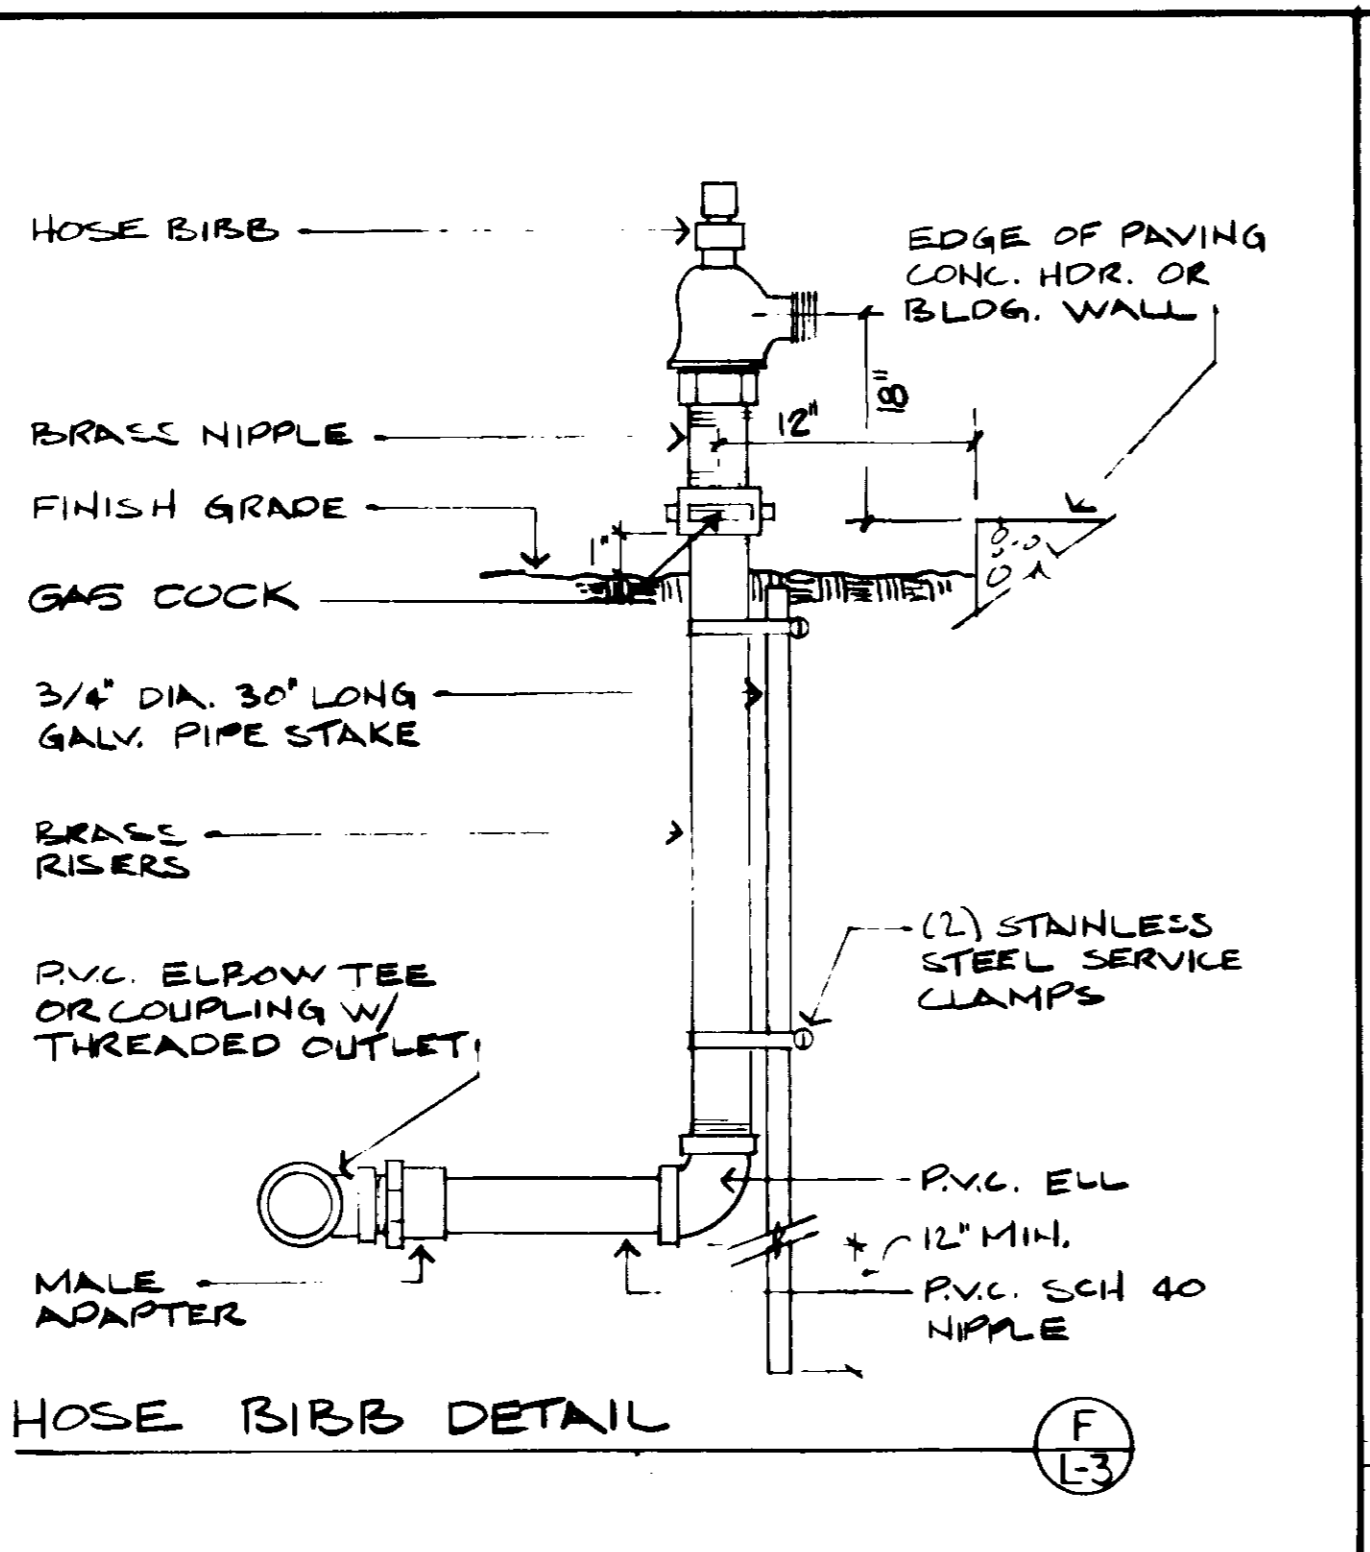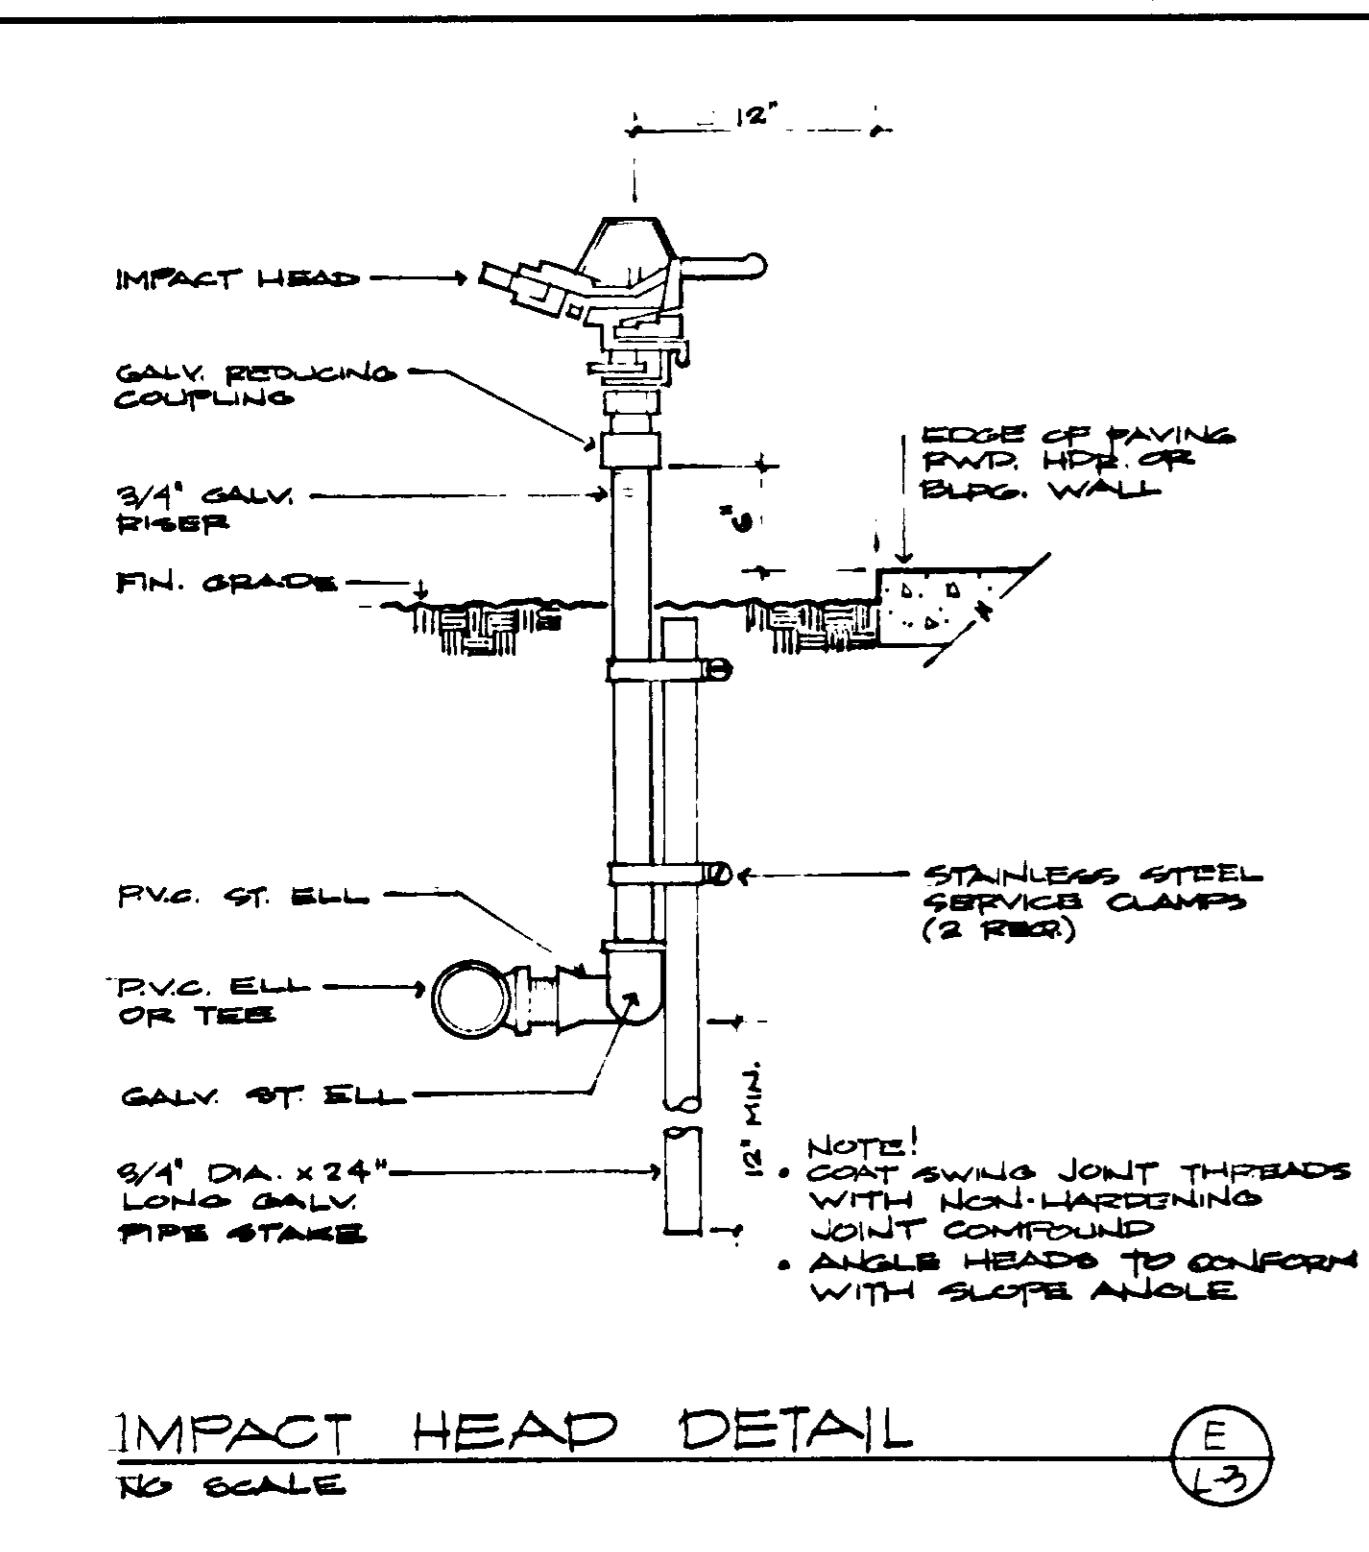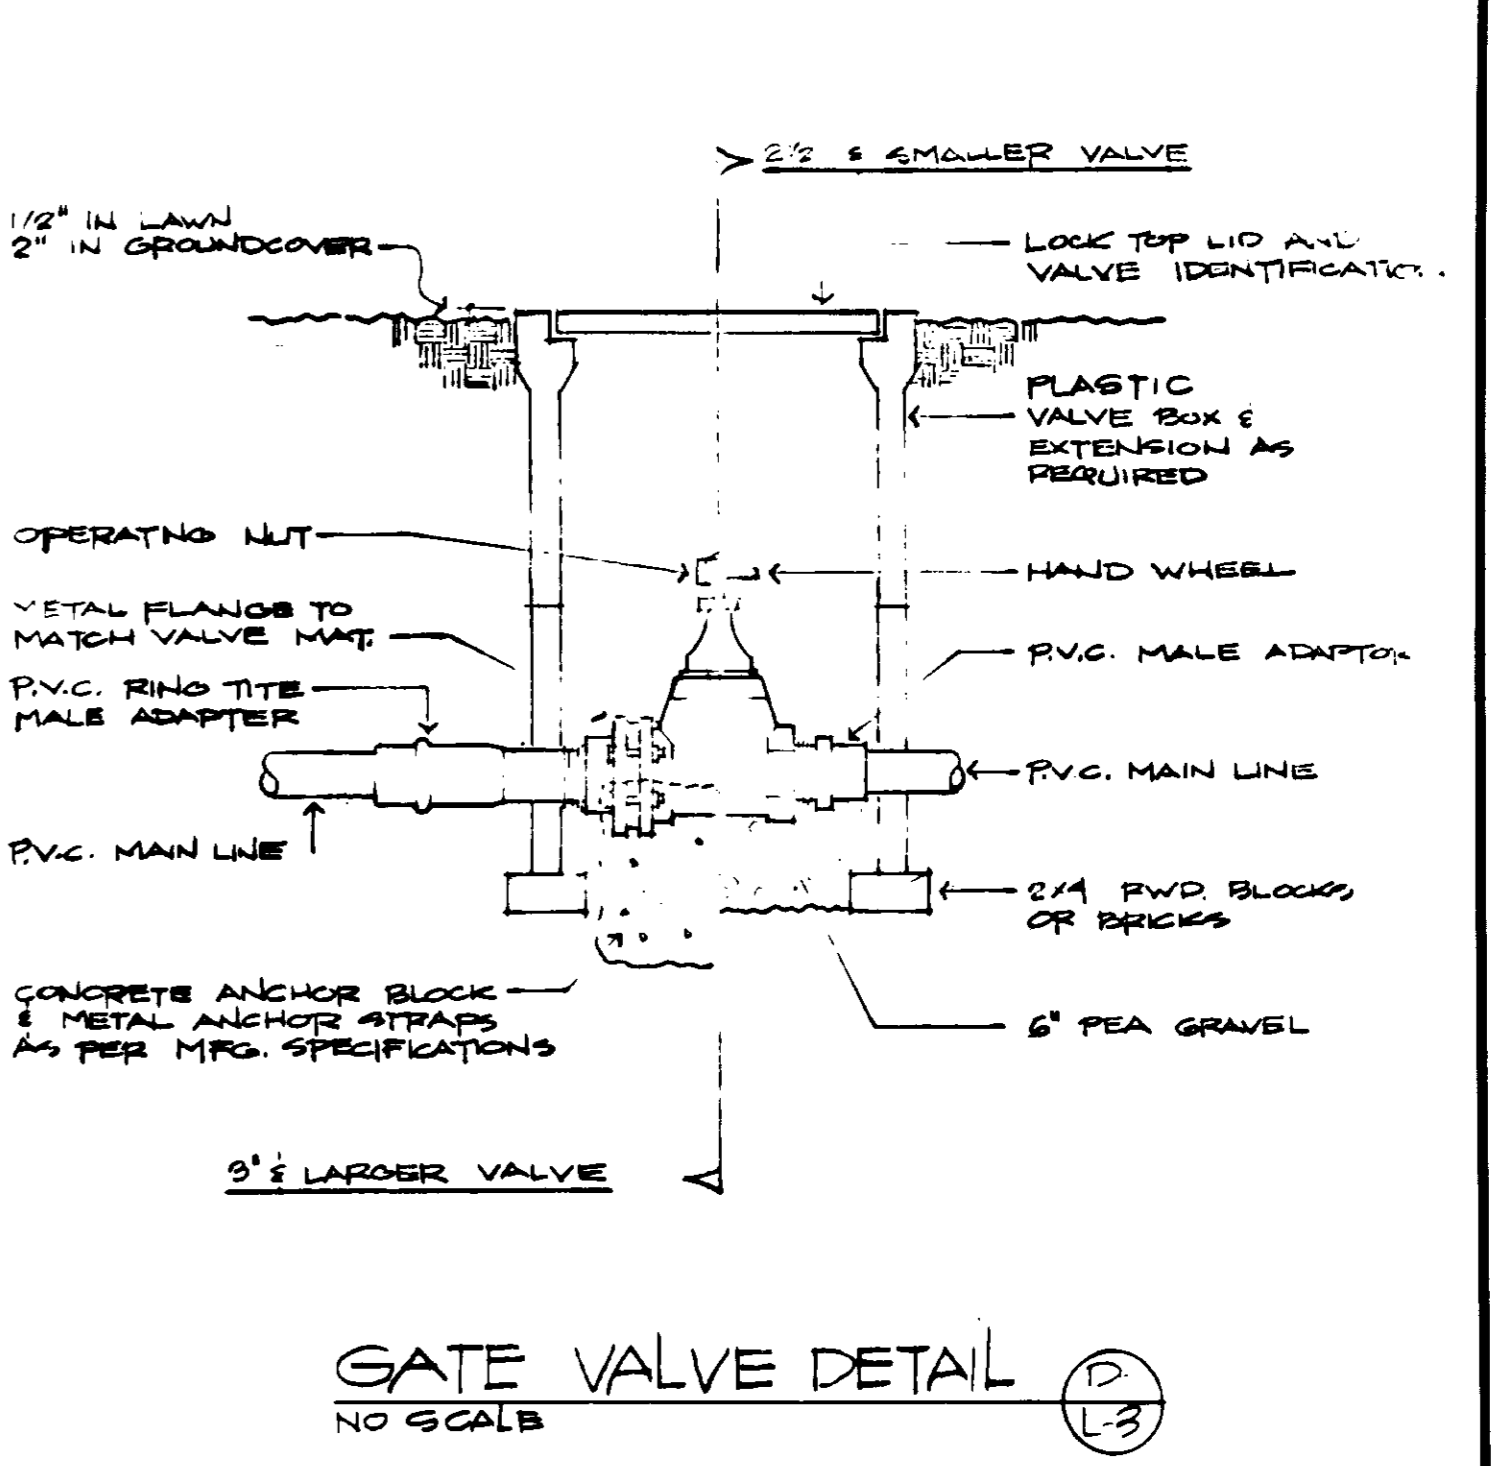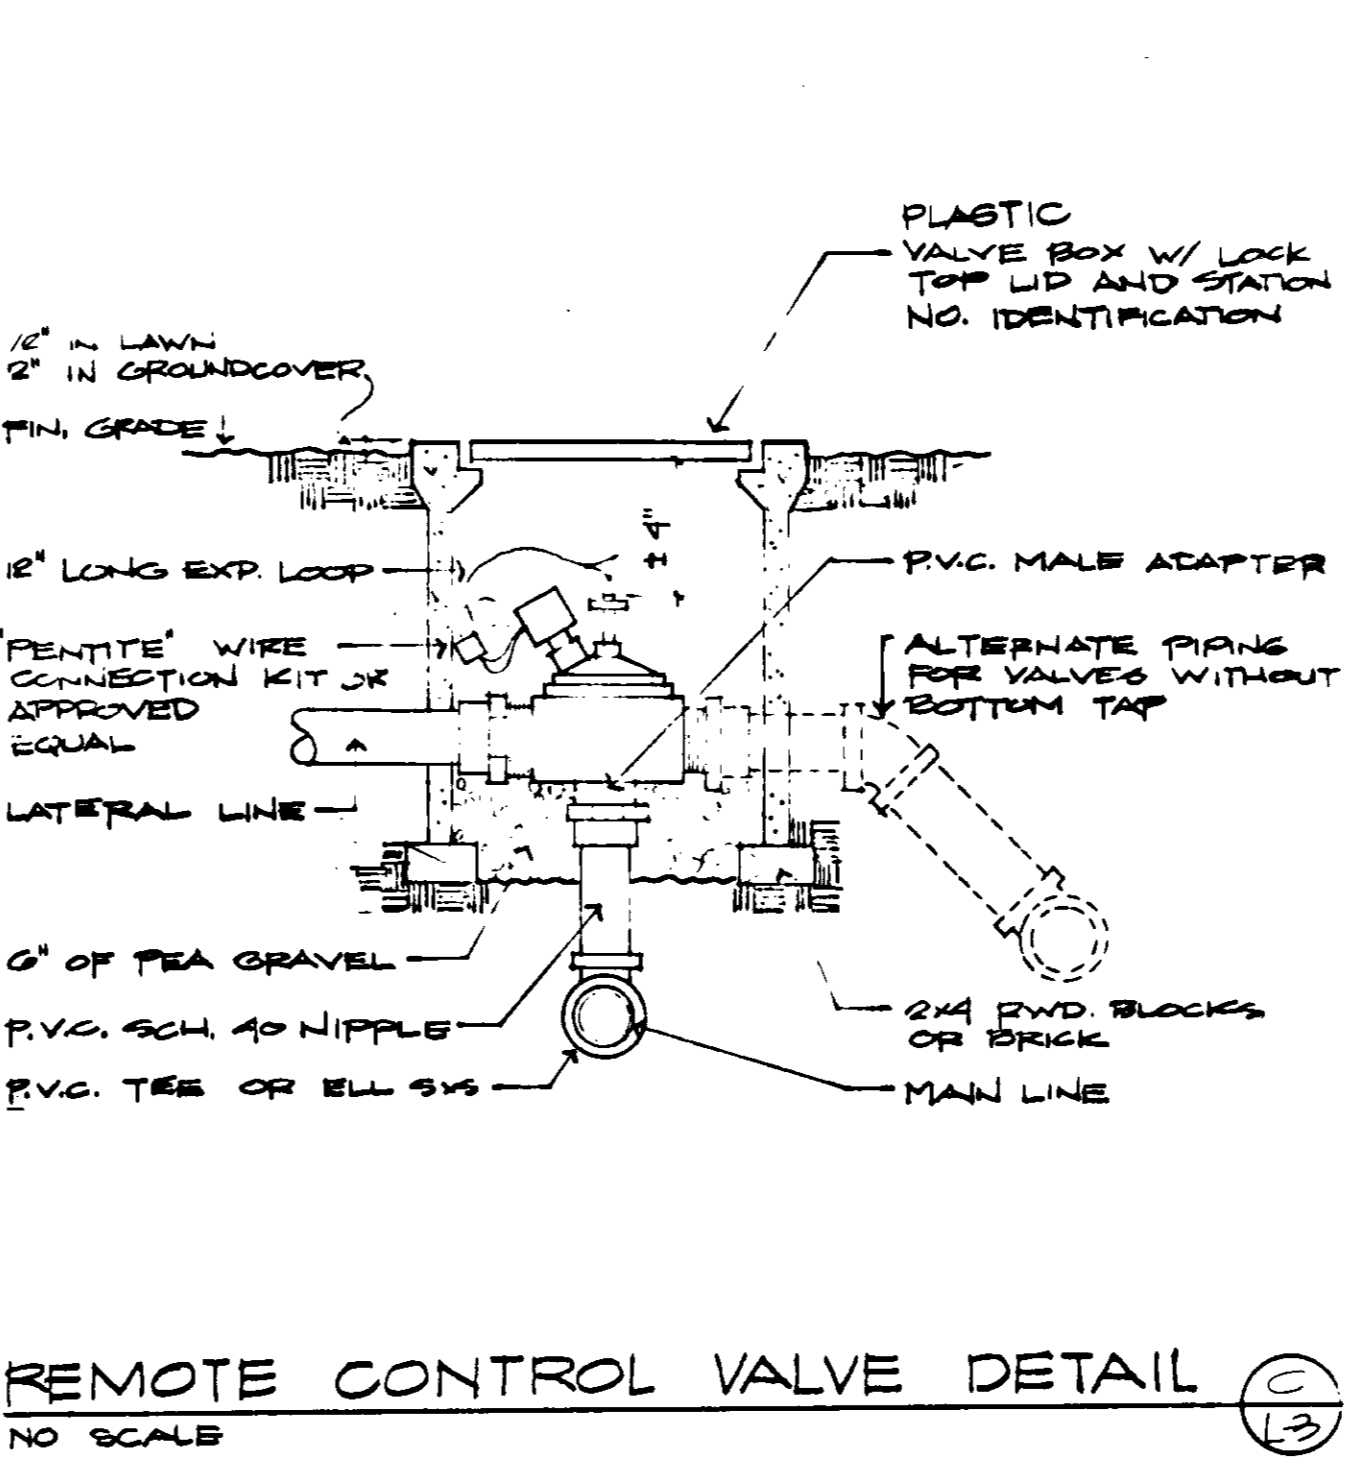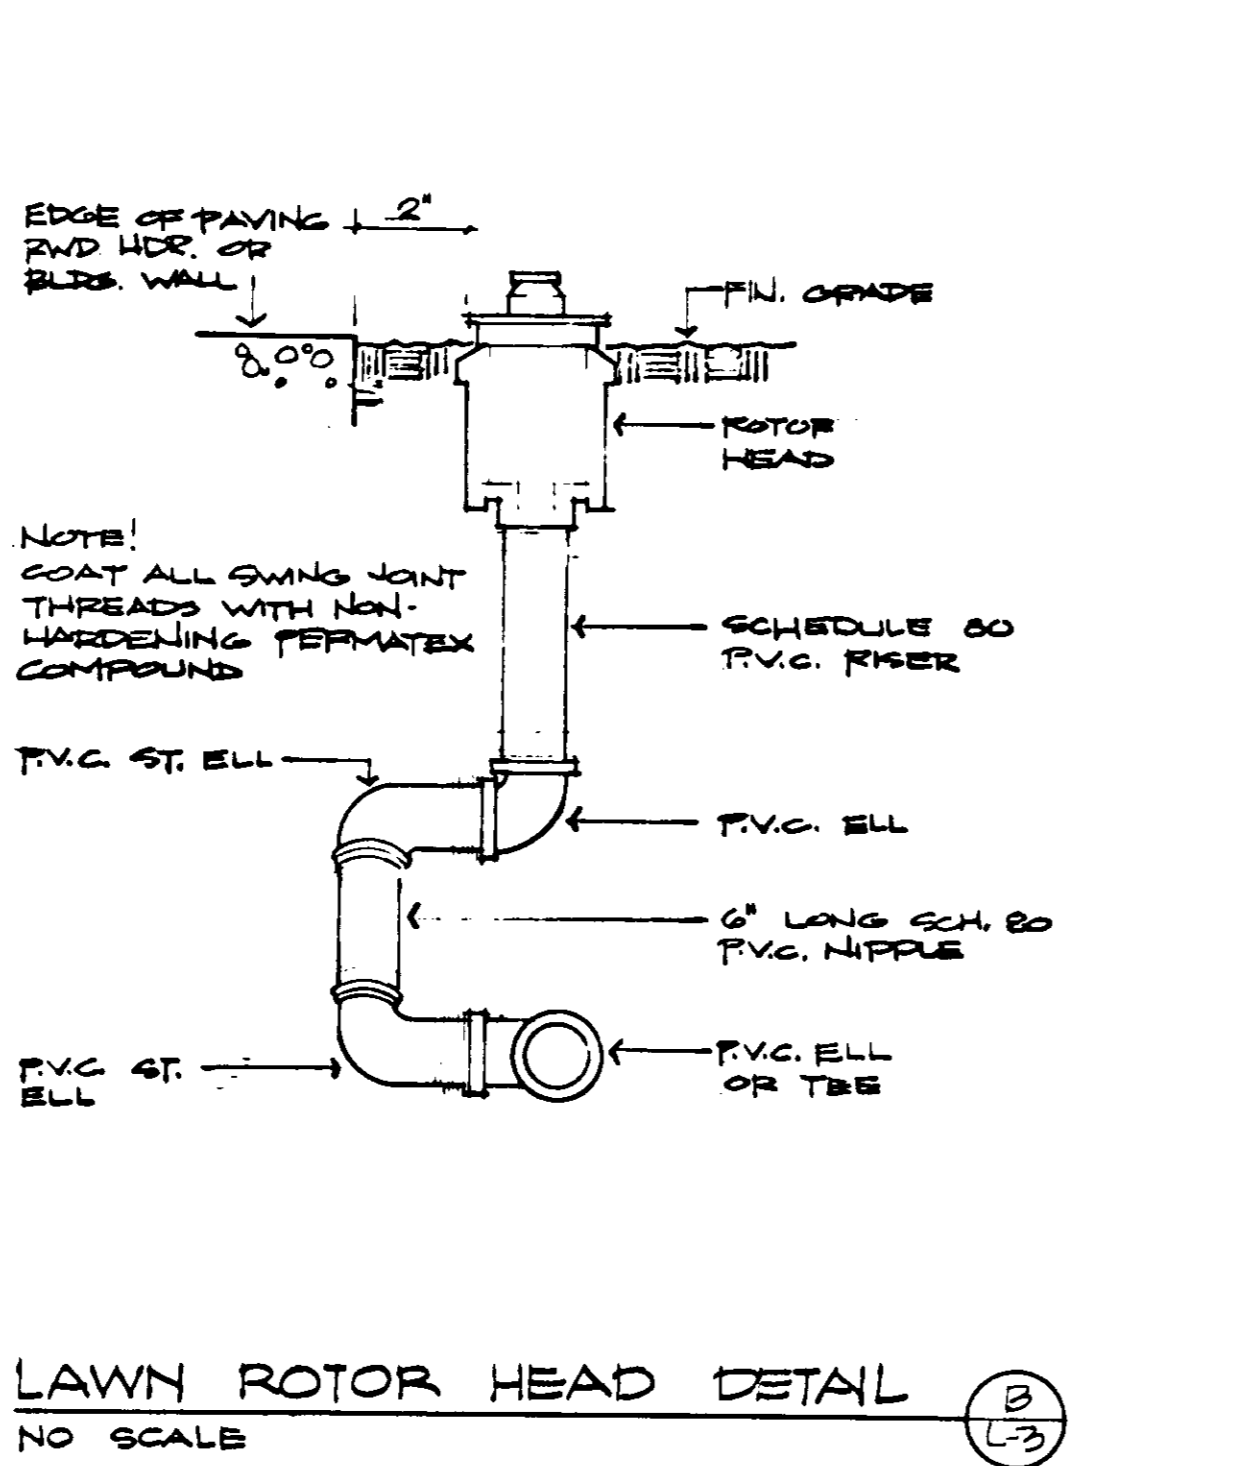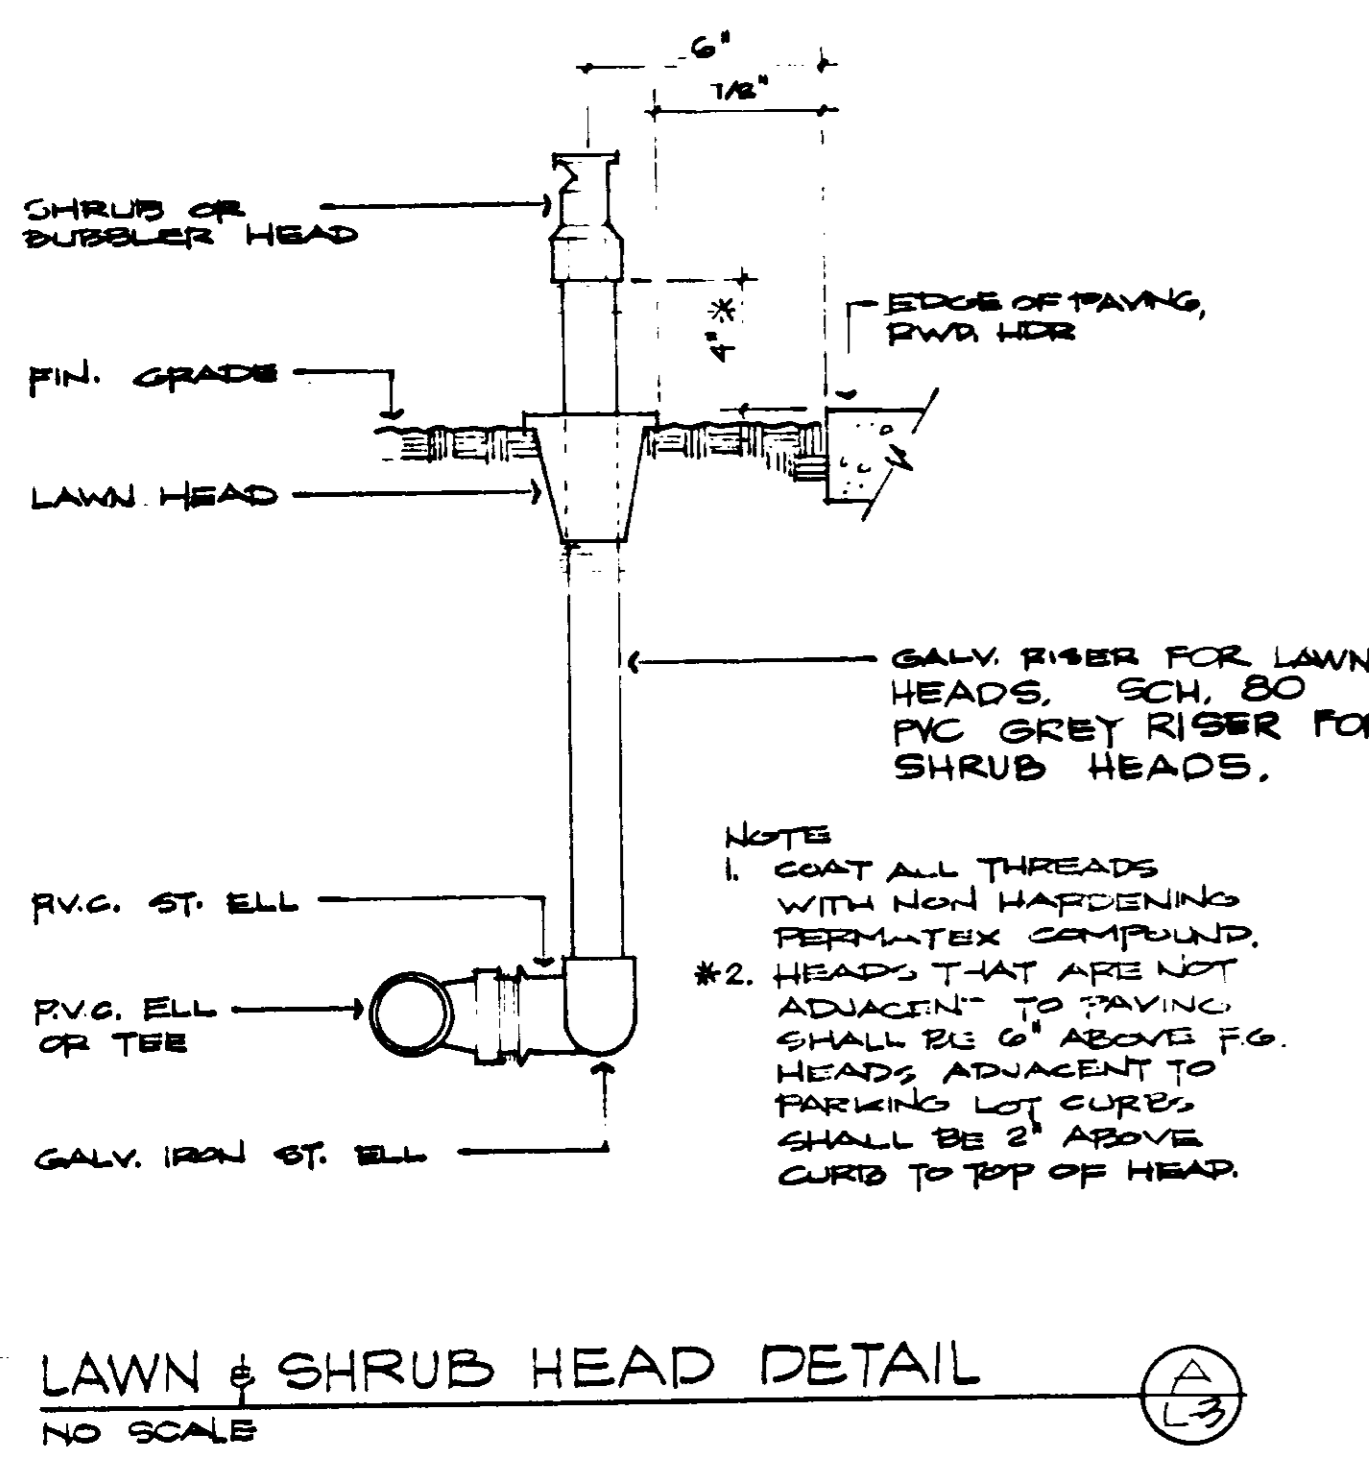


IRRIGATION		LEGEND				
SYMBOL	MANUFACTURER #	QTY. NO. & DESCRIPTION *	PSI	GPM	RND.	REF.
X	TORO	336-00-06 FULL ROTOR	60	11.6	47'	(B)
V	"	328-00-06 PART "	60	5.8	47'	(L-3)
V	"	329-00-06 " "	60	6.3	47'	
V	"	327-00-06 " "	60	5.3	47'	
V	"	324-00-06 " "	60	2.9	47'	
X	TORO	308-00-01 " "	50	1.4	18'	
V	TORO	308-10-03 PART ROTOR	50	3.3	30'	(A)
V	TORO	304-10-03 PART ROTOR	50	1.8	30'	(L-3)
V	"	309-10-02 PART ROTOR	50	1.8	24'	
V	"	316-10-02 FULL ROTOR	50	3.4	24'	
V	TORO	304-10-01 PART "	50	.72	18'	
V	"	304-10-03 PART "	50	1.5	30'	
V	TORO	307-10-01 PART "	50	1.4	24'	
V	TORO	336-00-05 FULL ROTOR	60	7.4	41'	(B)
V	"	328-00-05 PART ROTOR	60	3.7	41'	(L-3)
V	"	324-00-05 " "	60	1.9	41'	
X	RAIN-O-MAT	310F FULL LAWN SPRAY	15	2.0	10'	(A)
V	"	310H HALF " "	15	1.0	10'	(L-3)
V	"	310Q QTR. " "	15	.8	10'	
V	RAIN-O-MAT	320H HALF LAWN SPRAY	15	1.7	12 1/2'	
V	"	320Q QTR. " "	15	1.6	12 1/2'	
V	RAIN-O-MAT	303SH HALF FLAT SPRAY	10	.75	6'	
V	RAIN-O-MAT	310SH HALF SHRUB SPRAY	15	1.0	10'	
V	"	310SQ QTR. " "	15	.8	10'	
V	RAIN-O-MAT	320SH HALF " "	20	1.7	12 1/2'	
V	"	320SQ QTR. " "	20	1.6	12 1/2'	
V	RAINBIRD	35 PJ-TNT SPECIAL	45	6.8	48'	(E)
V	RAINBIRD	EPA SERIES ELECTRIC REMOTE CONTROL VALVE				(C)
V	HOSE BIBB - 3/4" x 3/4"					(L-3)
V	RAINBIRD MODEL RC-1860 CONTROLLER (PEDESTAL MOUNT)					(F)
V	GATE VALVE (LINE SIDE)					(D)
V	LATERAL LINE SCH 40 PVC					(L-3)
V	MAIN LINE SCH 40 PVC					

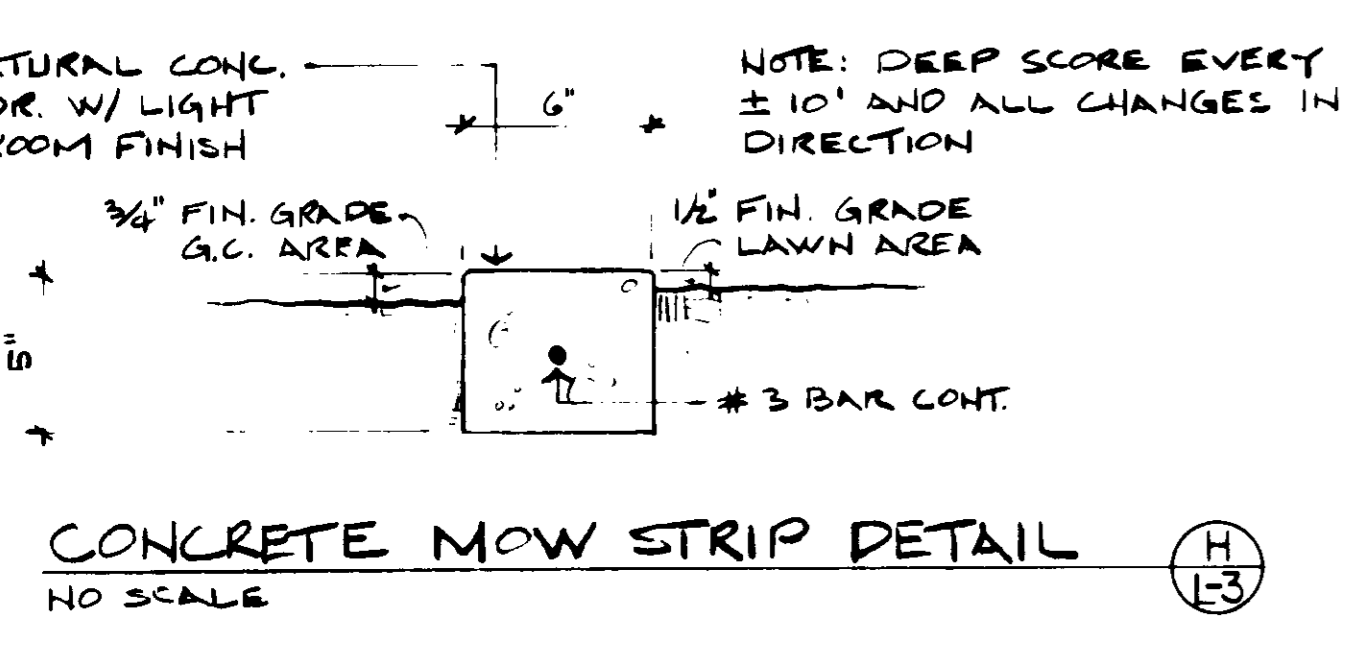

NOTE: INSTALL VALCON ANTI-DRAIN-VALVES ON ALL SPRINKLER HEAD RISERS. MODEL ADV 5000 ON 1/2" RISERS + MODEL ADV 5100 ON 3/4" RISERS
* SEE SPECIFICATION FOR EQUAL MFG. # NUMBERS


03550
RECORD DRAWING

SCALE: NTS		DESIGNED: EPT	DRAWN: EPT	CHECKED: EPT	SUBMITTED: Robert C Smith 27304 8/19/31	PROJECT ENGINEER: R.C.E. NO. DATE	JAMES M. MONTGOMERY CONSULTING ENGINEERS, INC. 555 EAST WALNUT STREET, PASADENA, CALIFORNIA 9101	DISTRICT APPROVAL ON TITLE PAGE	LAS VIRGENES MWD/TRIUNFO CSD		SHEET L-3 OF 66 SHEETS
REV DATE BY DESCRIPTION					RECOMMENDED: 27-33 8/20/31	PROJECT ENGINEER: R.C.E. NO. DATE			PHASE II	TAPIA WRF - FILTRATION/DISINFECTION ADDITION	

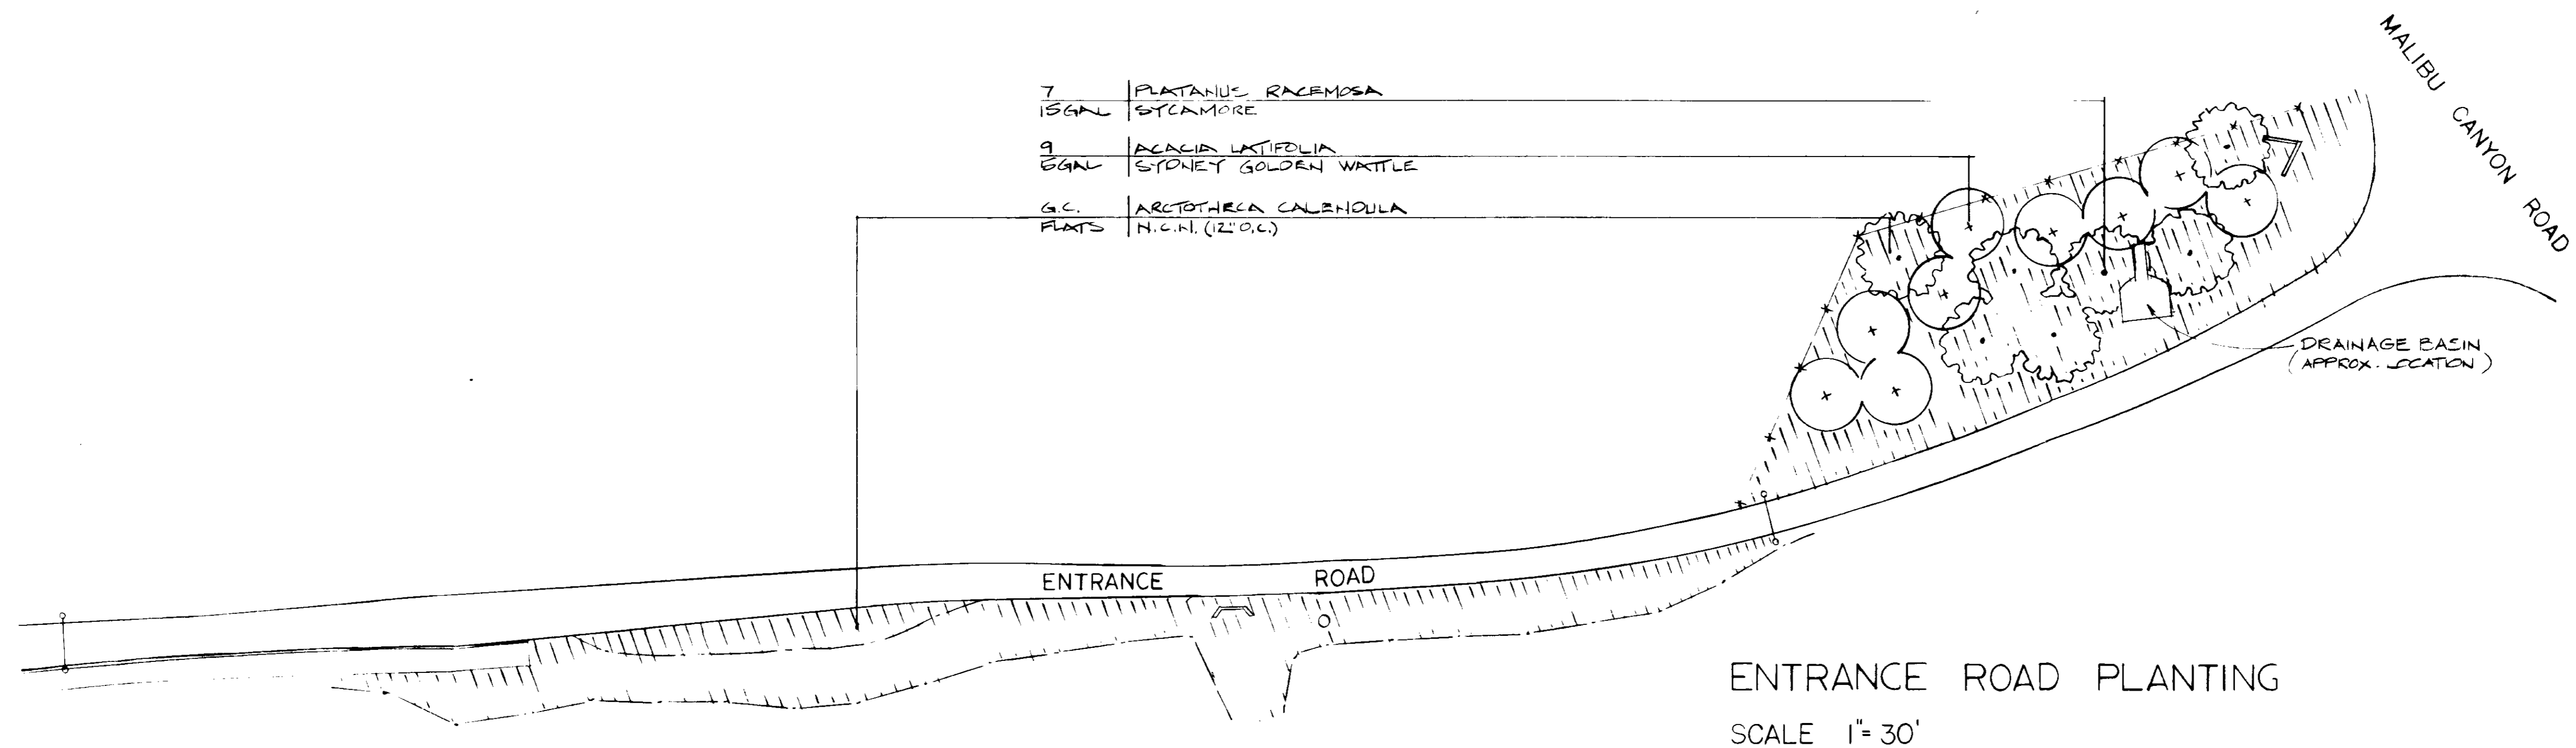

ENTRANCE ROAD PLANTING
SCALE 1" = 30'

NOTE: CONTRACTOR TO CUT PLUG AND ABANDON TWO EXISTING 4" RECLAIMED WATER LINES, WHICH PREVIOUSLY SERVED PEPPERDINE UNIVERSITY, FROM OLD EFFLUENT PUMPING STATION TO THE END OF MALIBU CANYON ROAD. THESE TWO PIPES ARE LOCATED IN THE VICINITY OF THE SCHEDULED PLACEMENT OF THE NEW 6" RECLAIMED WATER LINE SHOWN BELOW. IN ADDITION, AN EXISTING 2" GAS LINE IS LOCATED NEAR THE NEW 6" RECLAIMED WATER LINE. SERVICE OF THE EXISTING 2" GAS LINE SHALL NOT BE INTERRUPTED BY CONSTRUCTION ACTIVITIES.

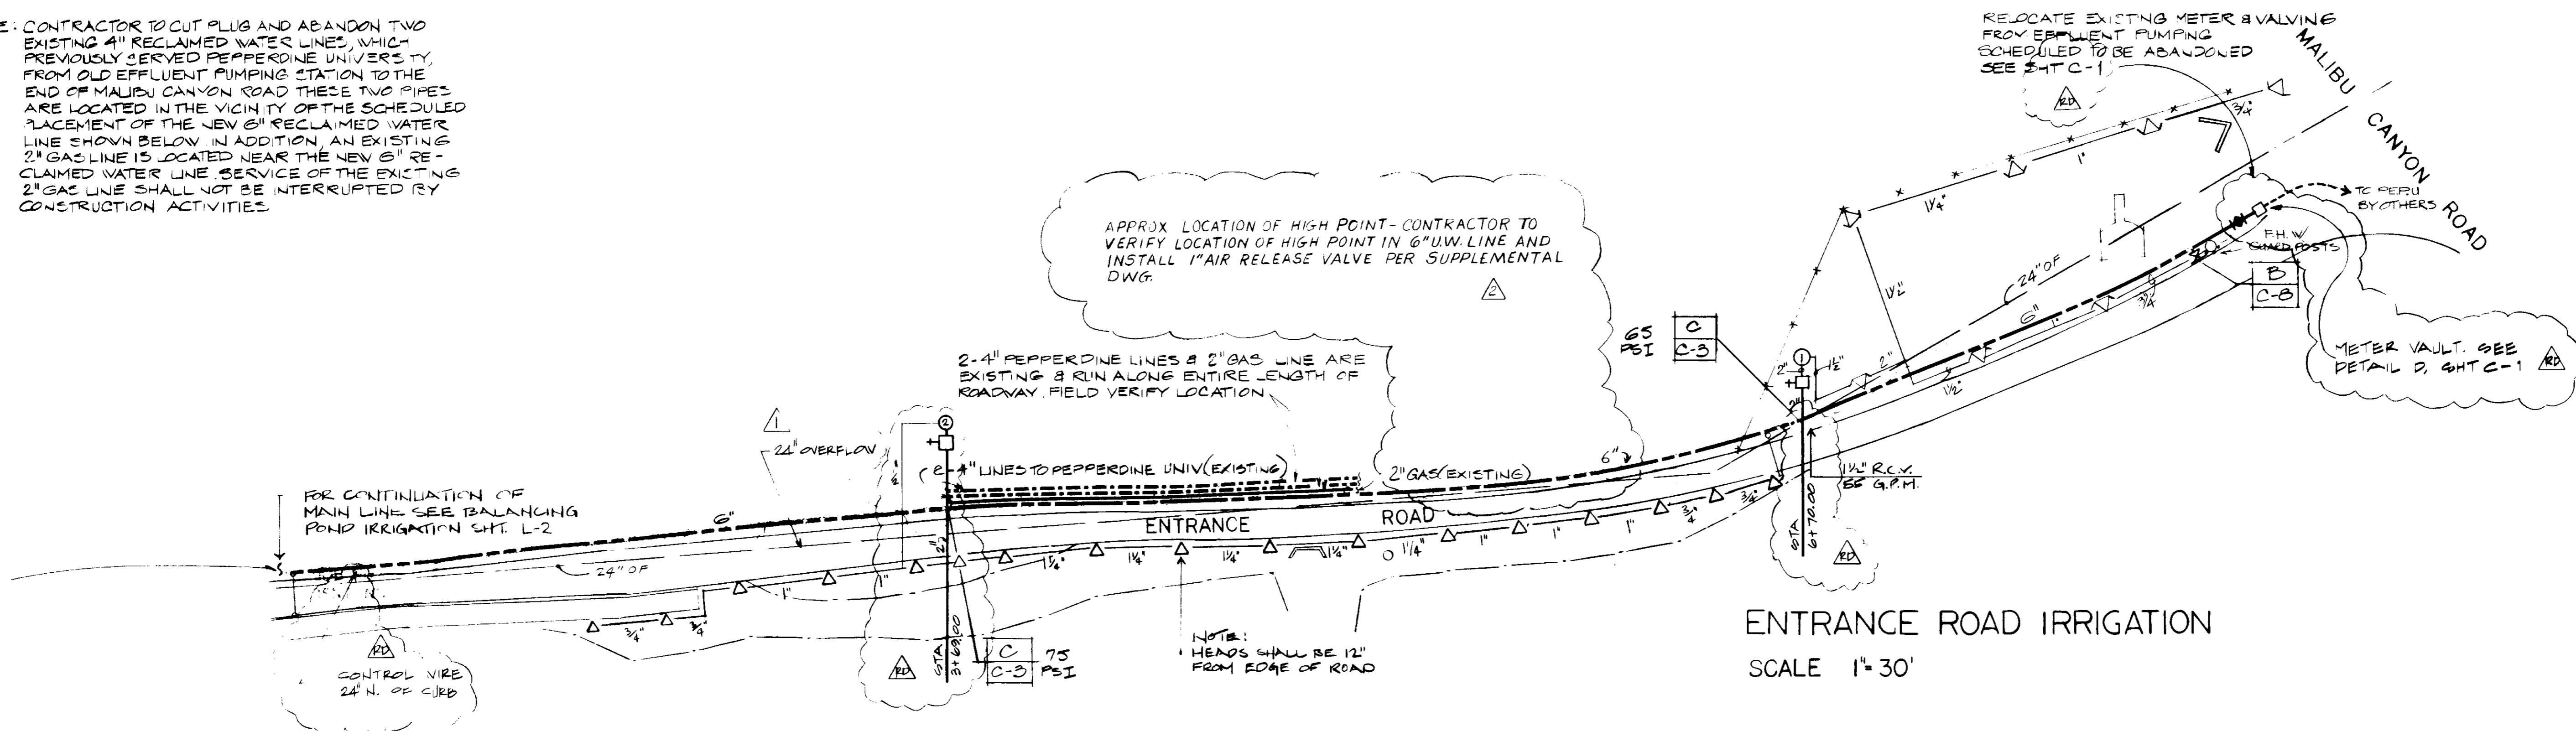

ENTRANCE ROAD IRRIGATION
SCALE 1" = 30'

03551

RECORD DRAWING

RD 41184	MDU	RECORD DRAWINGS
4-12-83	ALR	C.O.No. ADDED 1" A.V.
1-15-84	A.V.	CONSTRUCTION VERIFICATION/ADDED PIPE
REV	DATE	BY DESCRIPTION

SCALE:	DESIGNED	EPT
1" : 30'	DRAWN	EPT
	CHECKED	EPT


SUBMITTED	27304	3/19/81
PROJECT ENGINEER	R.C.E. NO.	DATE
REVISIONS	27038	3/20/81
JAMES M. MONTGOMERY CONSULTING ENGINEERS, INC.	R.C.E. NO.	DATE

JAMES M. MONTGOMERY CONSULTING ENGINEERS, INC.
555 EAST WALNUT STREET, PASADENA, CALIFORNIA 91101

DISTRICT APPROVAL ON TITLE PAGE

LAS VIRGENES MWD/TRIUNFO CSD	
TAPIA WRT FILTRATION/ DISINFECTION ADDITION	
PHASE II	ENTRANCE ROAD, PLANTING AND IRRIGATION PLAN

SHEET
L-4
OF 66 SHEETS

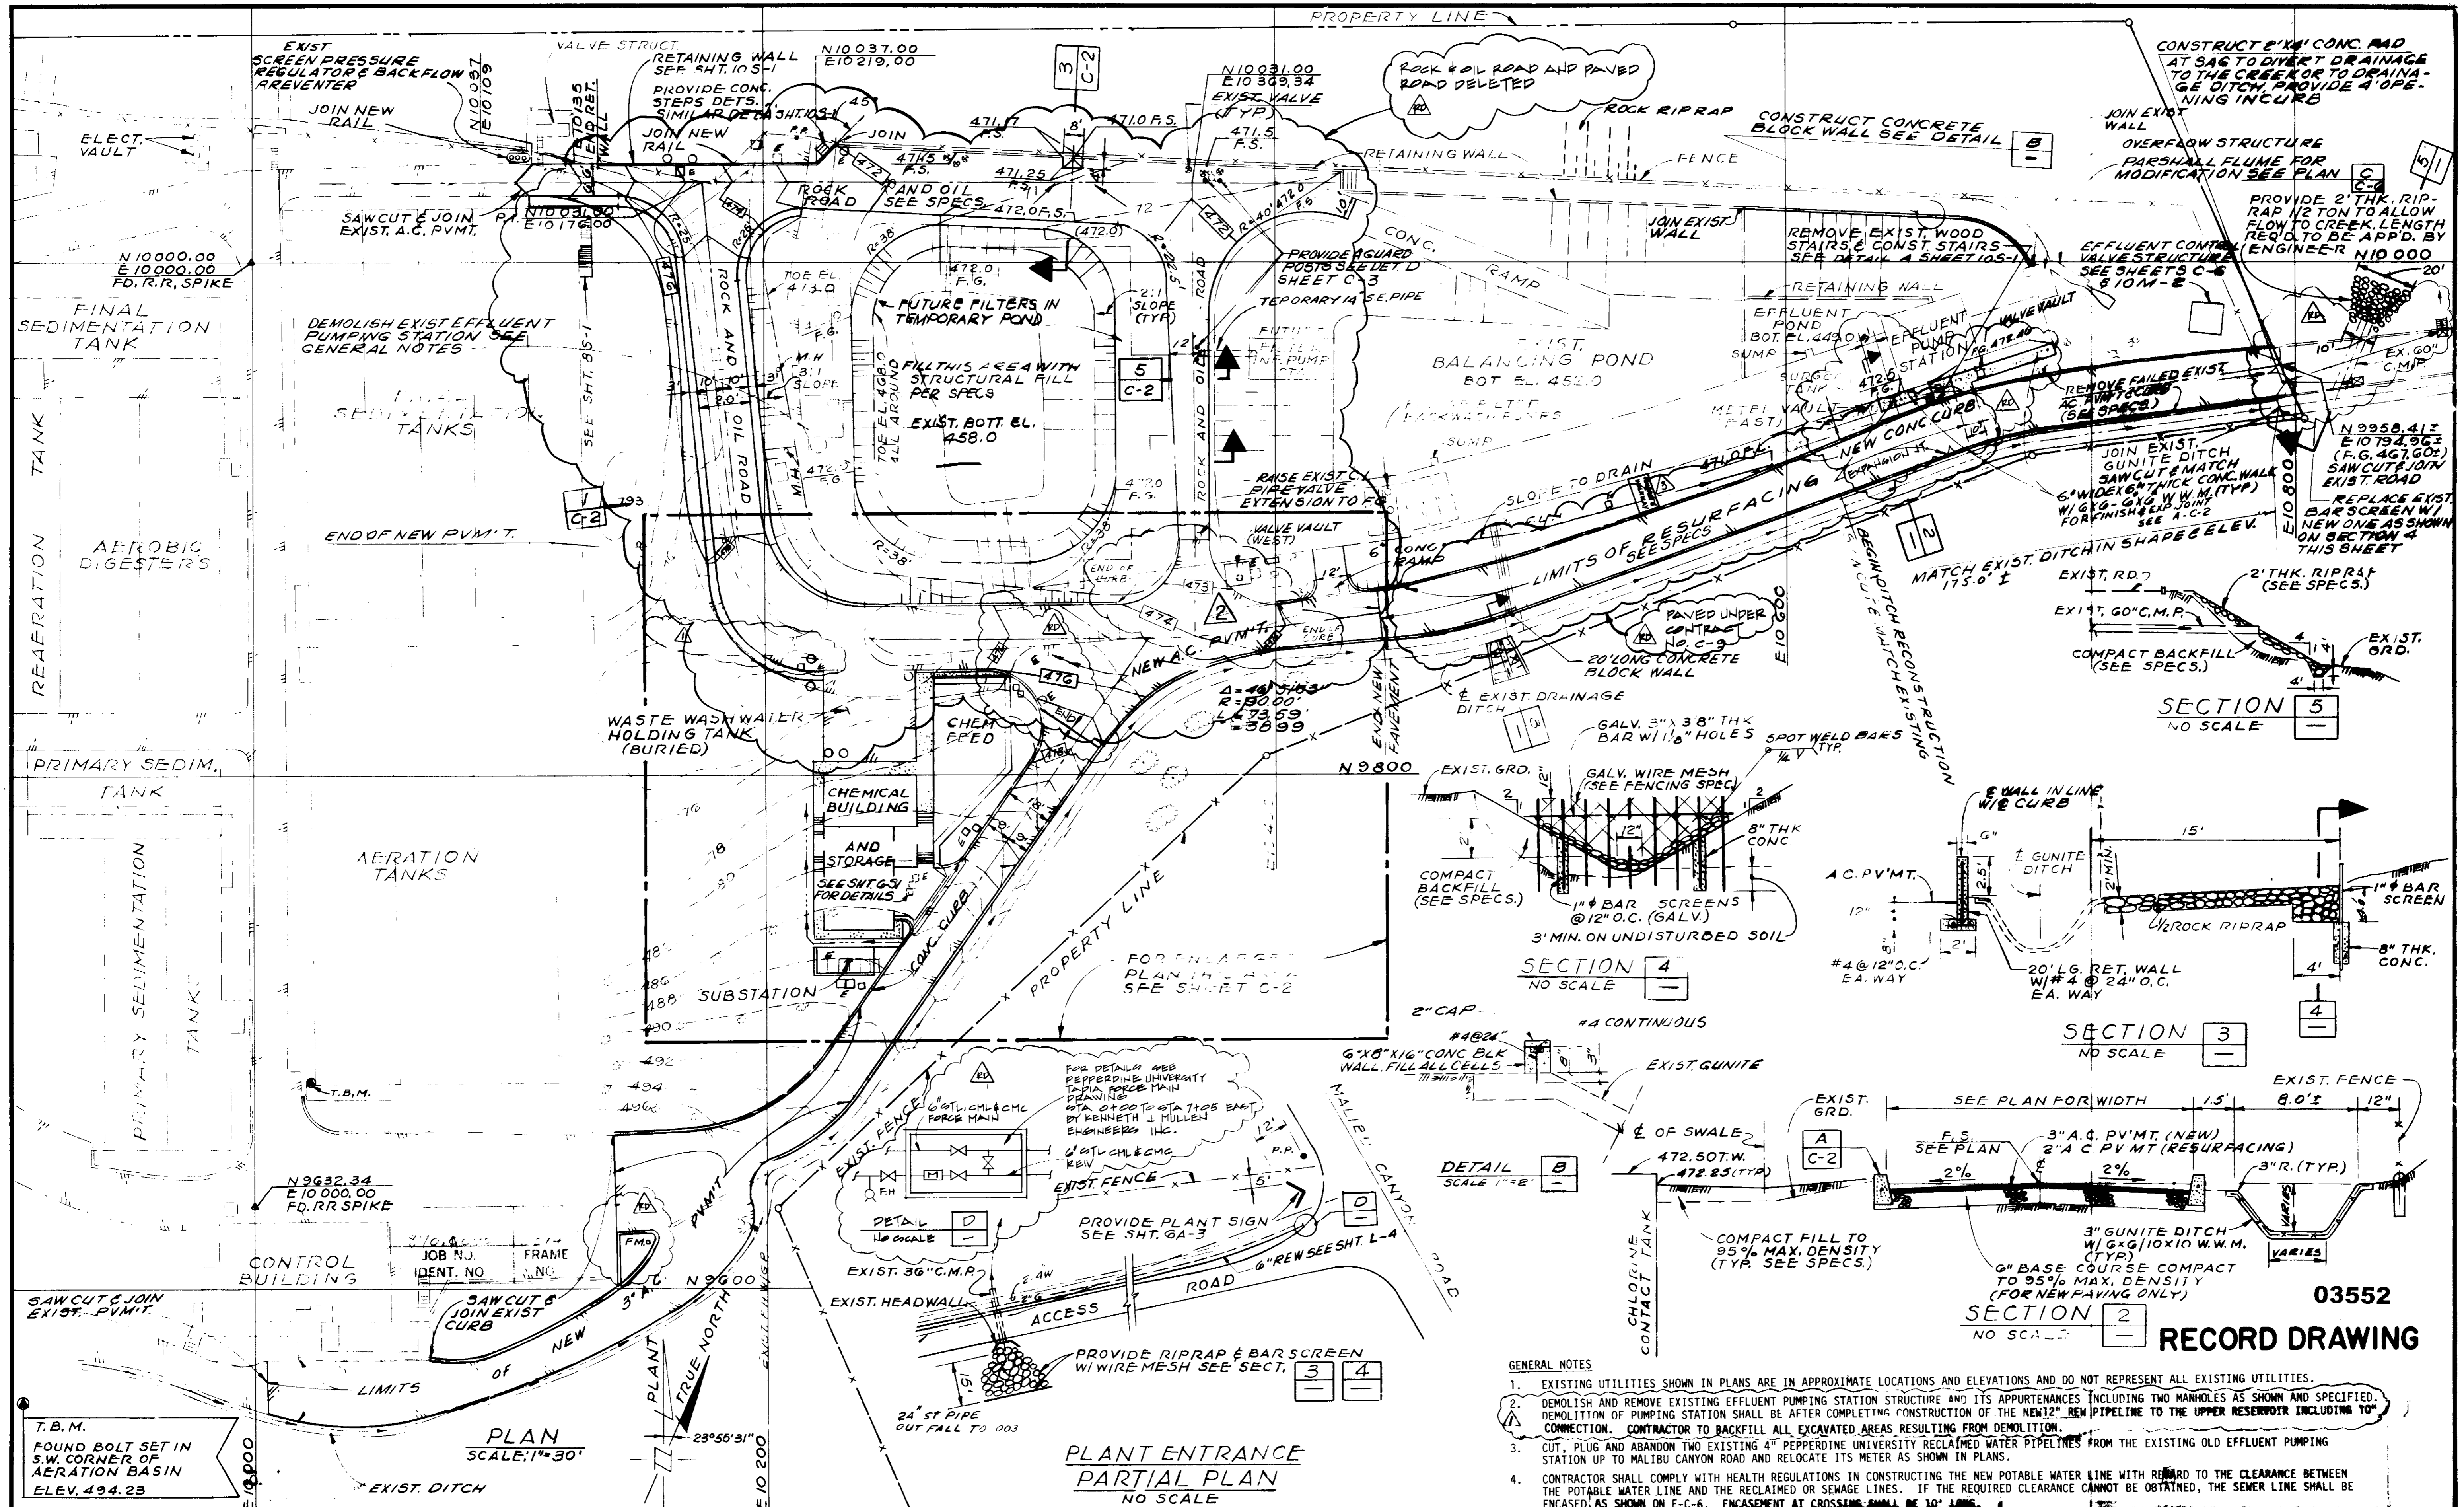

RD 14184 MPU	RECORD DRAWINGS		
DESIGNED	V. BAYANI		
DRAWN	R. GRIFFIN		
CHECKED	S. MARRAS		
REV	DATE	BY	DESCRIPTION
1	3/20/08	AS-BUILT REV - Added concrete roadway	
2	5/12/08	ALC CHANGE ORDER	
3	9/12/08	E.C. CHANGE ORDER	




SCALE:	AS SHOWN	
SUBMITTED	27324	8/19/01
ENGINEER	R.C.E. NO.	DATE
27638	8/23/01	
DATE		

JAMES M. MONTGOMERY CONSULTING ENGINEERS, INC.

555 EAST WALNUT STREET, PARADISE, CALIFORNIA 95959








DISTRICT APPROVAL ON TITLE PAGE

PHASE II	SITE GRADING AND PAVING PLAN	SHEET	C-1
LAS VEGAS MPD/THRUWAY CO		TAPPA WSP - FILTRATION/DISINFECTION ADDITION	
OF 66 SHEETS			

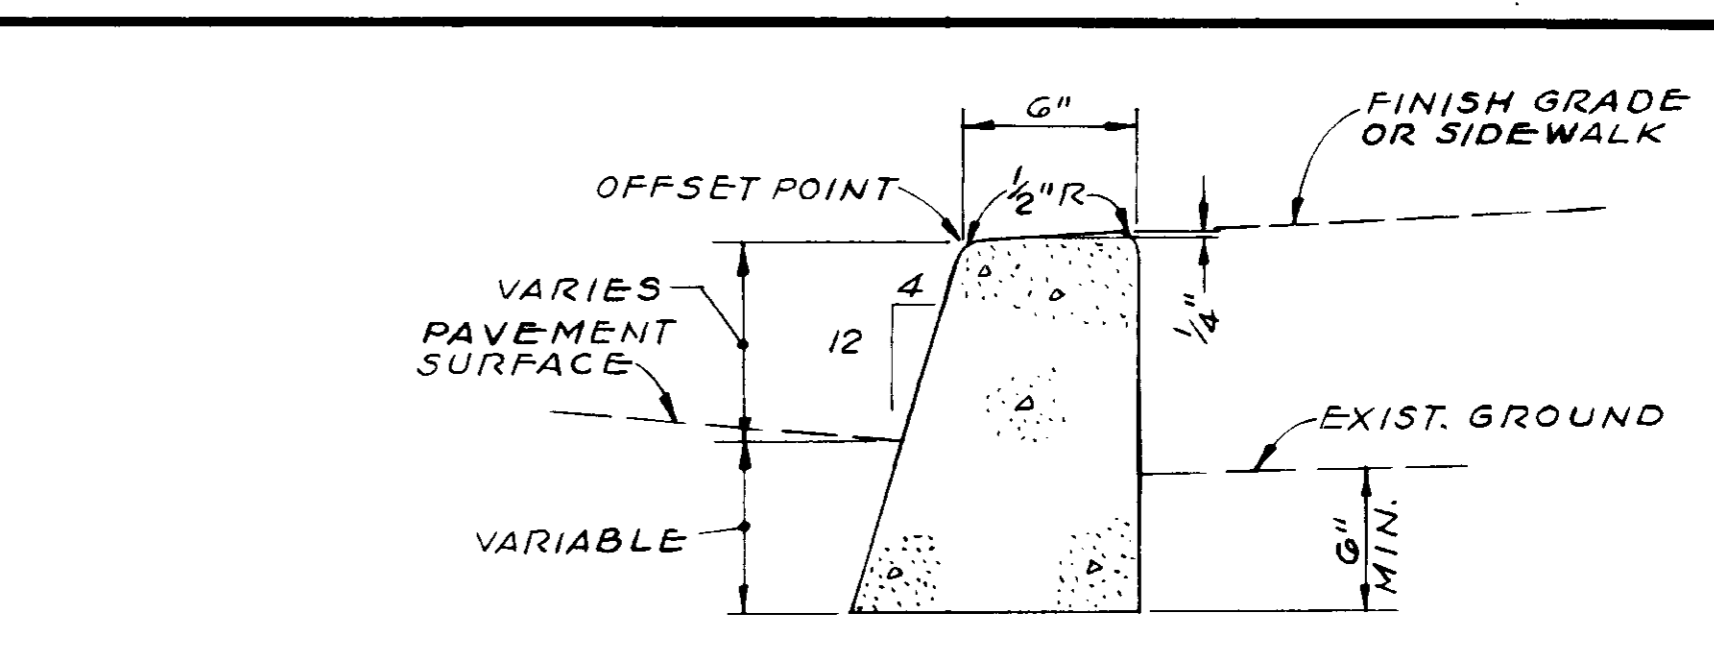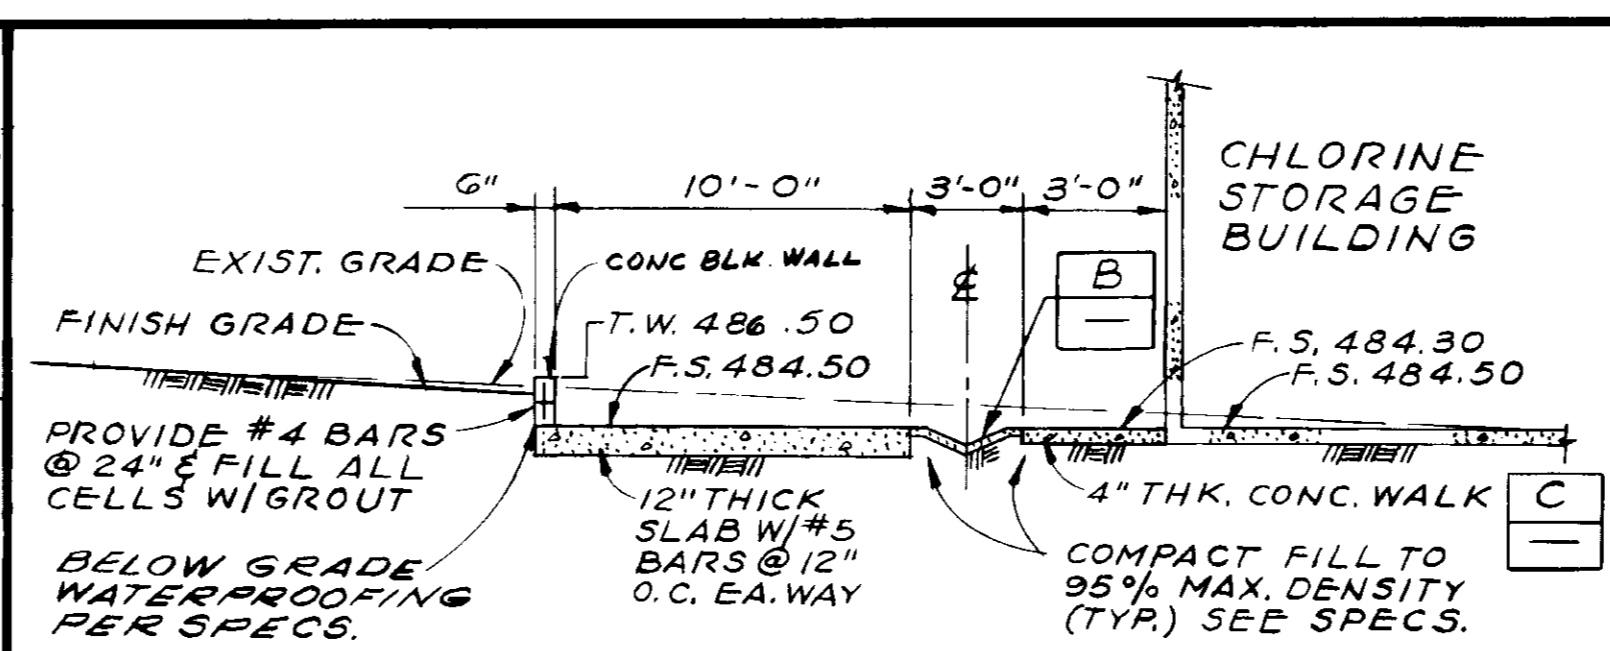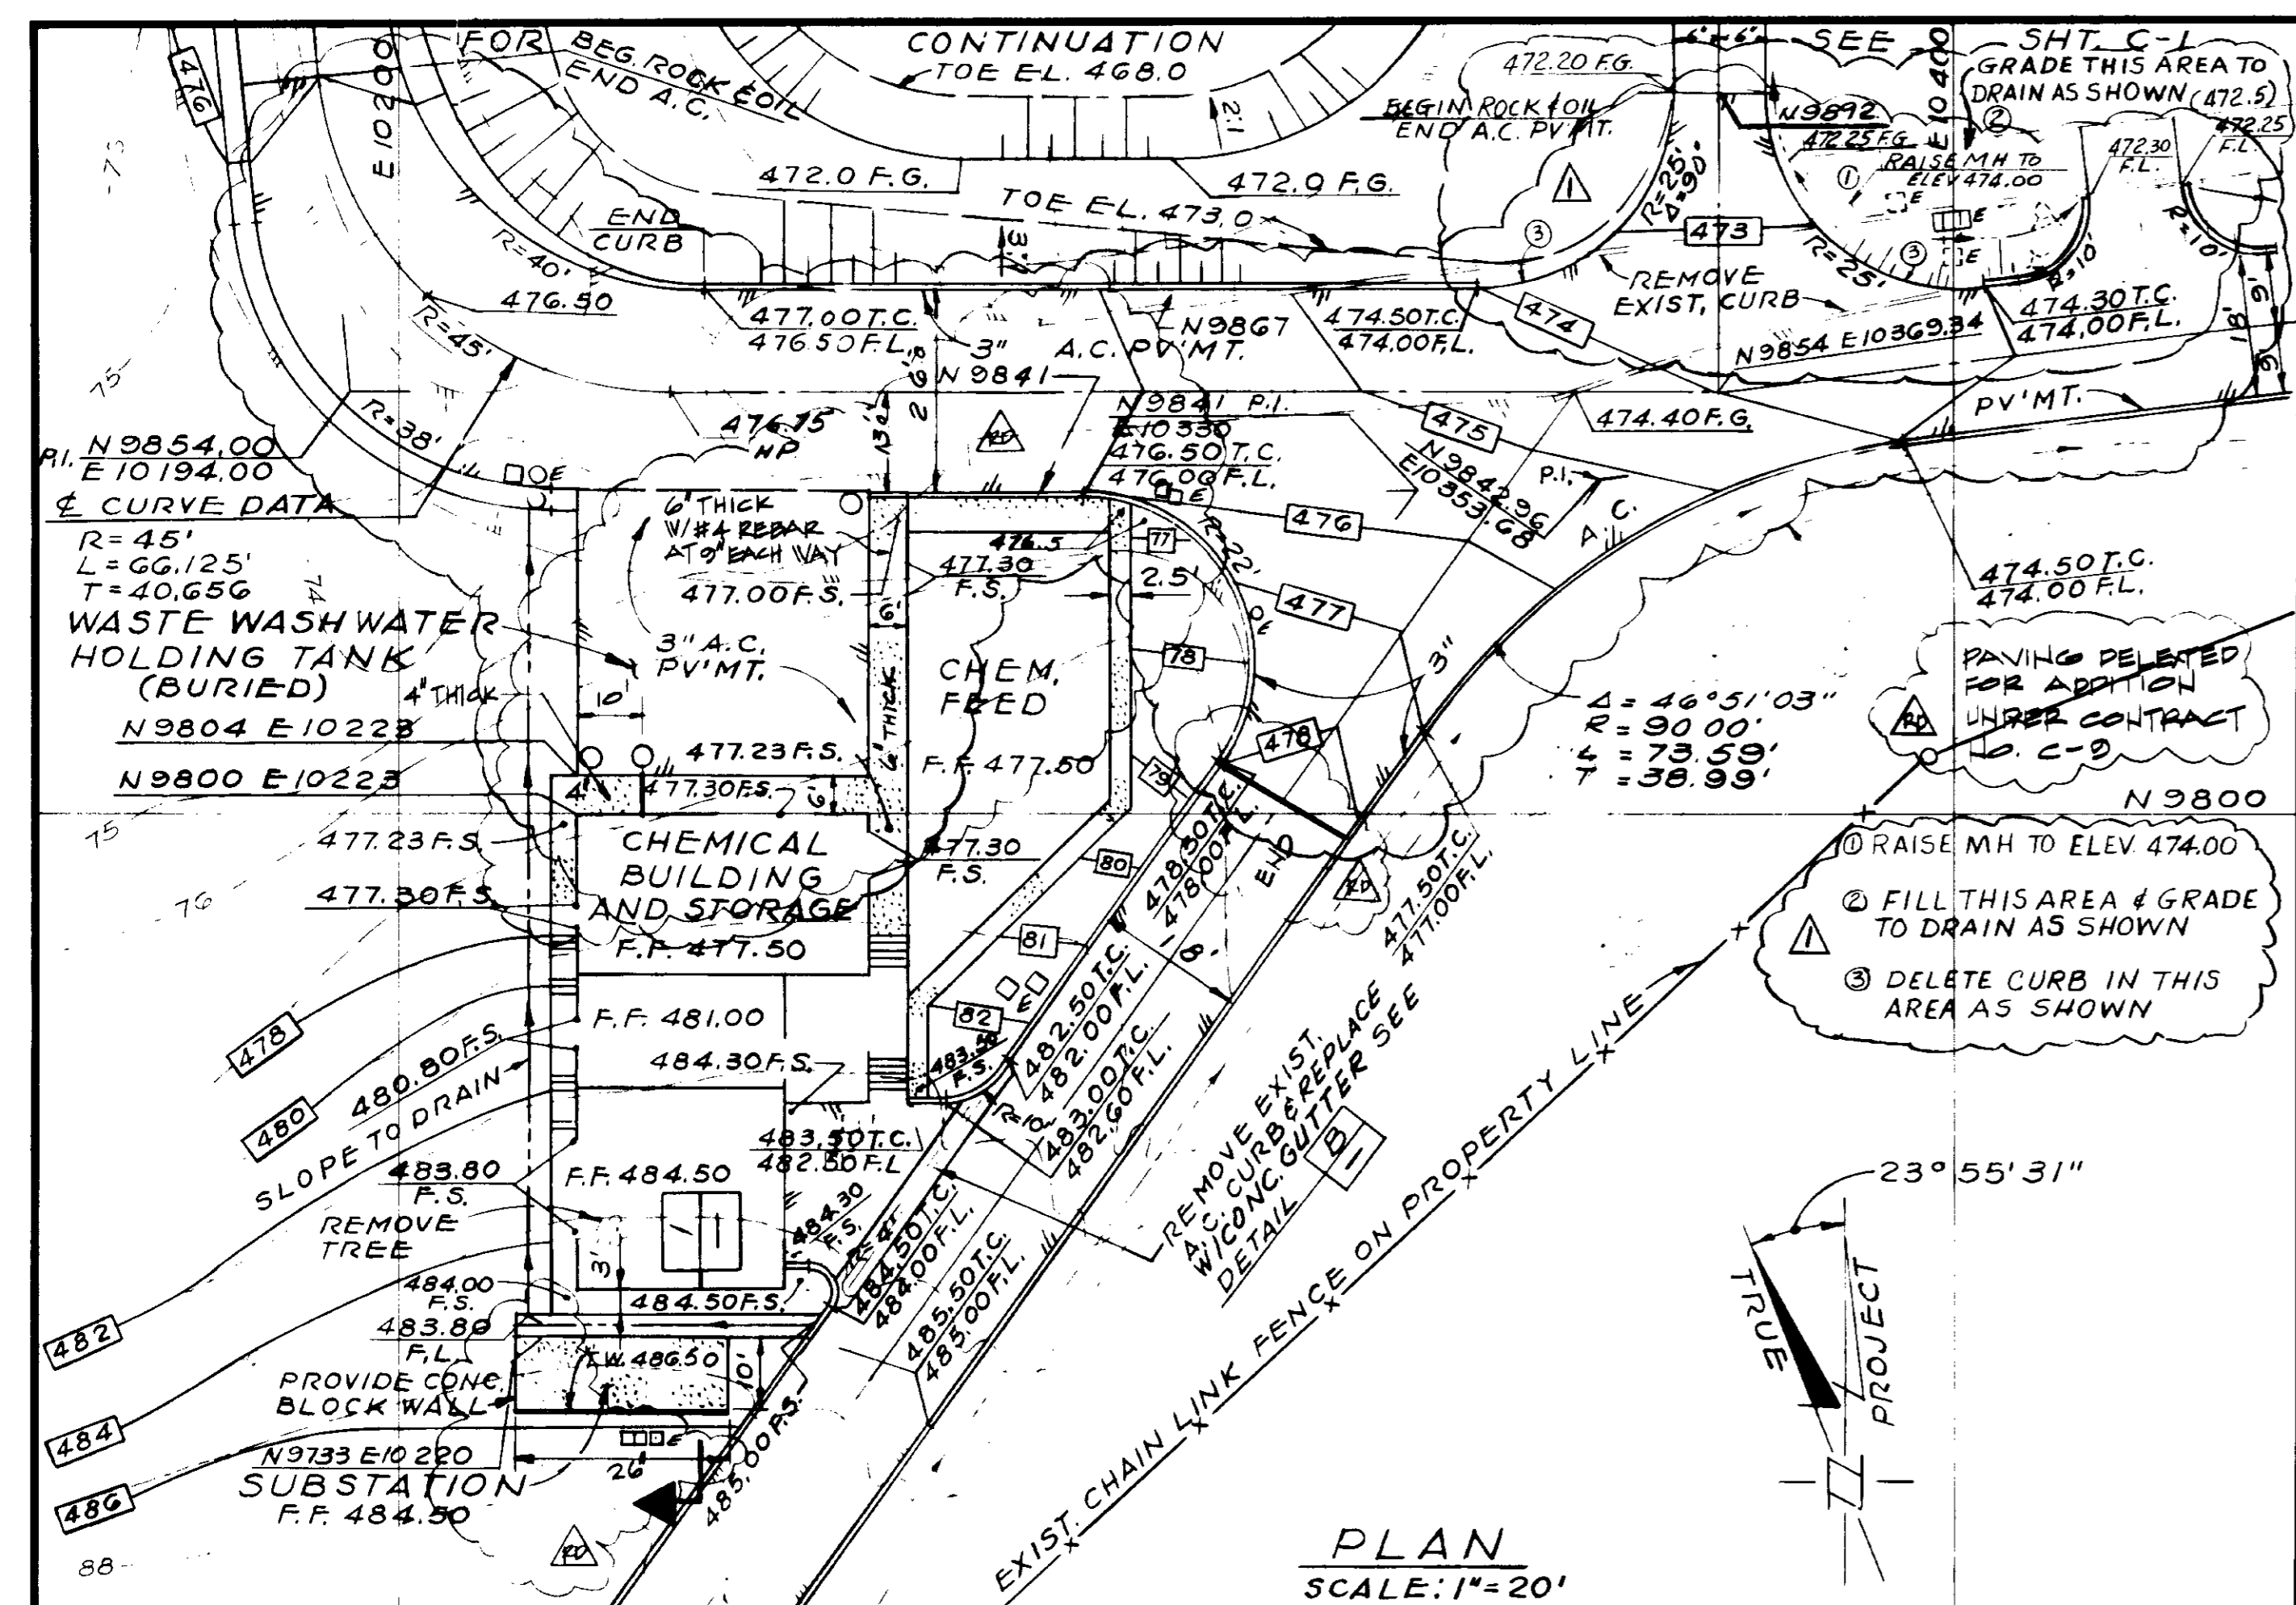

NOTES:
 1. EXPANSION JOINTS OF ONE-HALF INCH RIGID BITUMINOUS MATERIAL SHALL BE PLACED AT ALL B.C.'S AND AT MAX. 50-FOOT SPACING.
 2. ALL EXPOSED SURFACES OF CURBS SHALL BE GIVEN A MORTAR BRUSH COAT CONSISTING OF ONE PART PORTLAND CEMENT, ONE PART SAND, PER SACK OF CEMENT, THEN TROWELED SMOOTH.
 3. TYPICAL INSTRUCTIONS FOR GUTTER & SIDE WALK

NOTE
 BASE COURSE SHALL BE INSTALLED SIMILAR TO ADJACENT

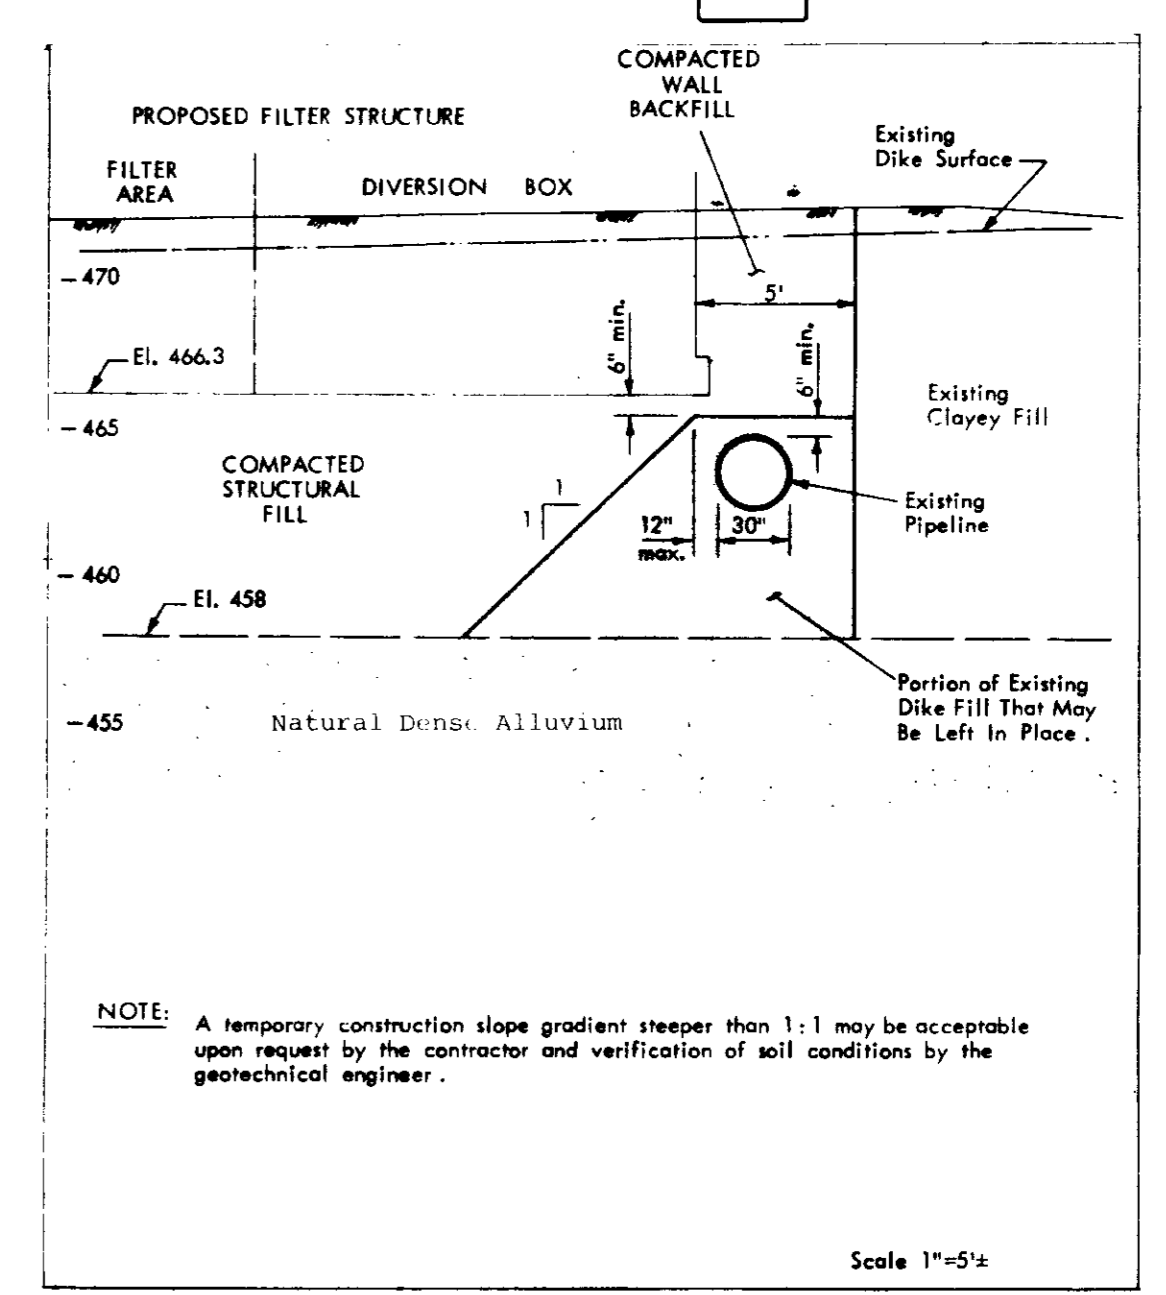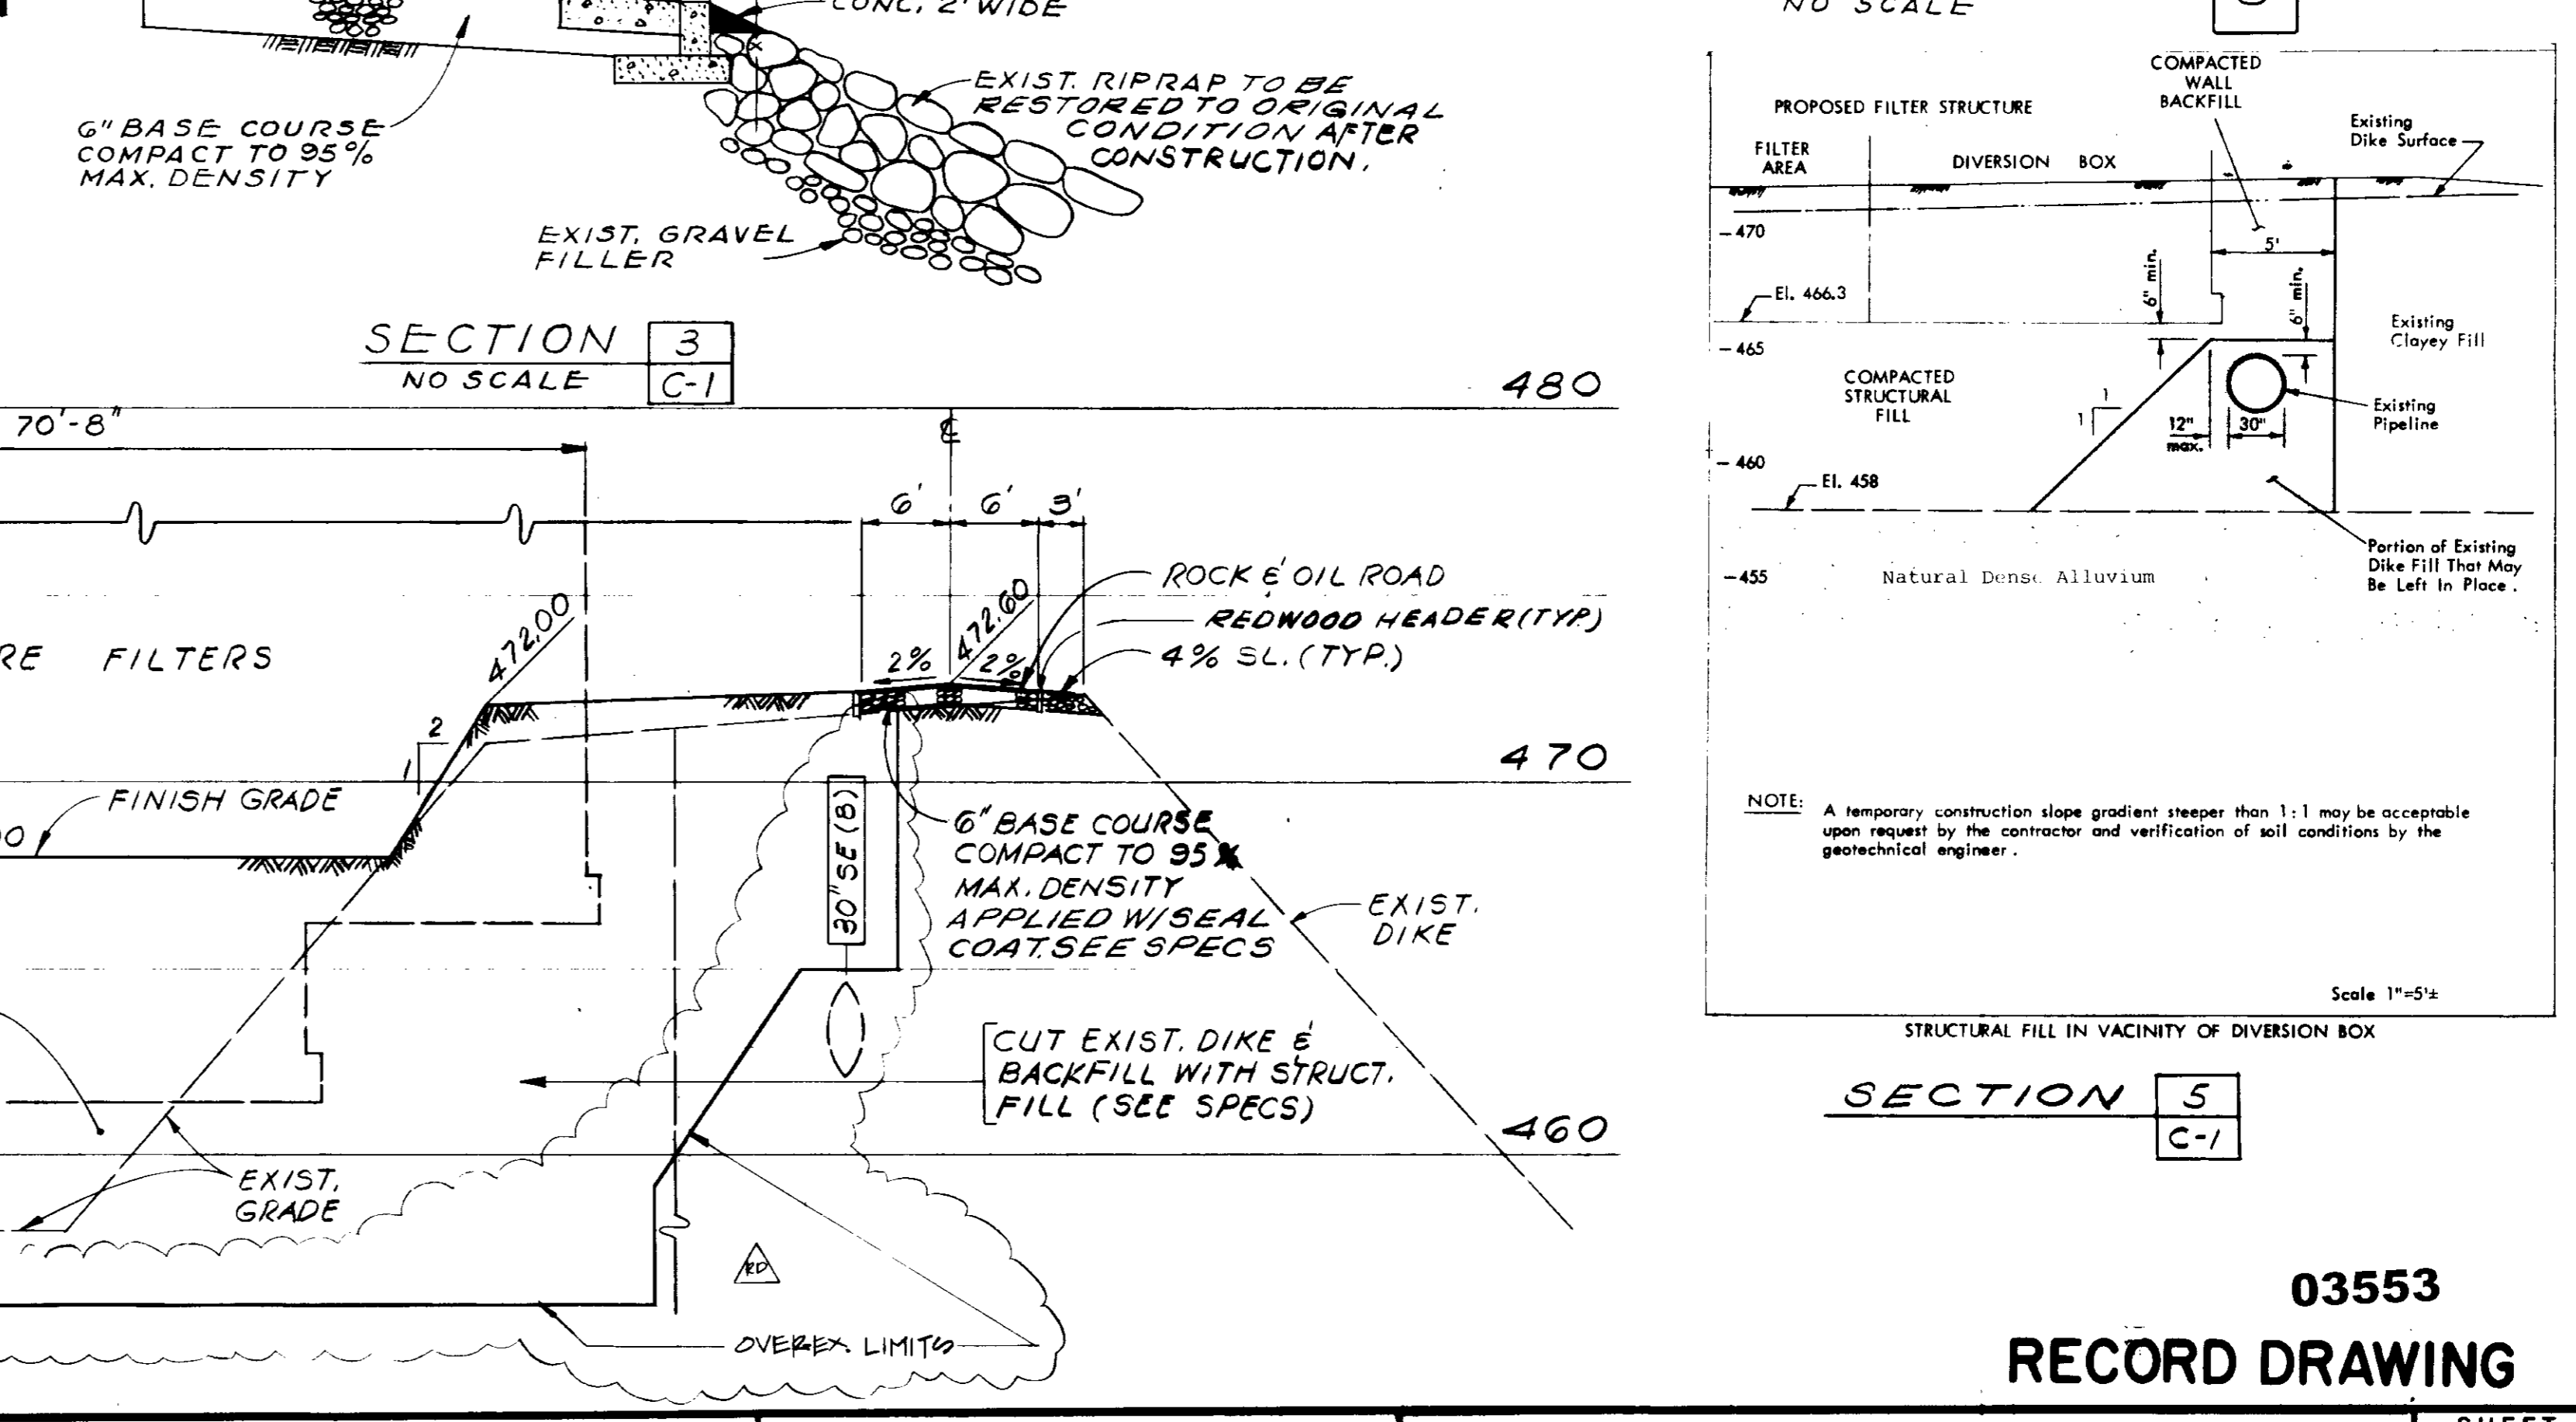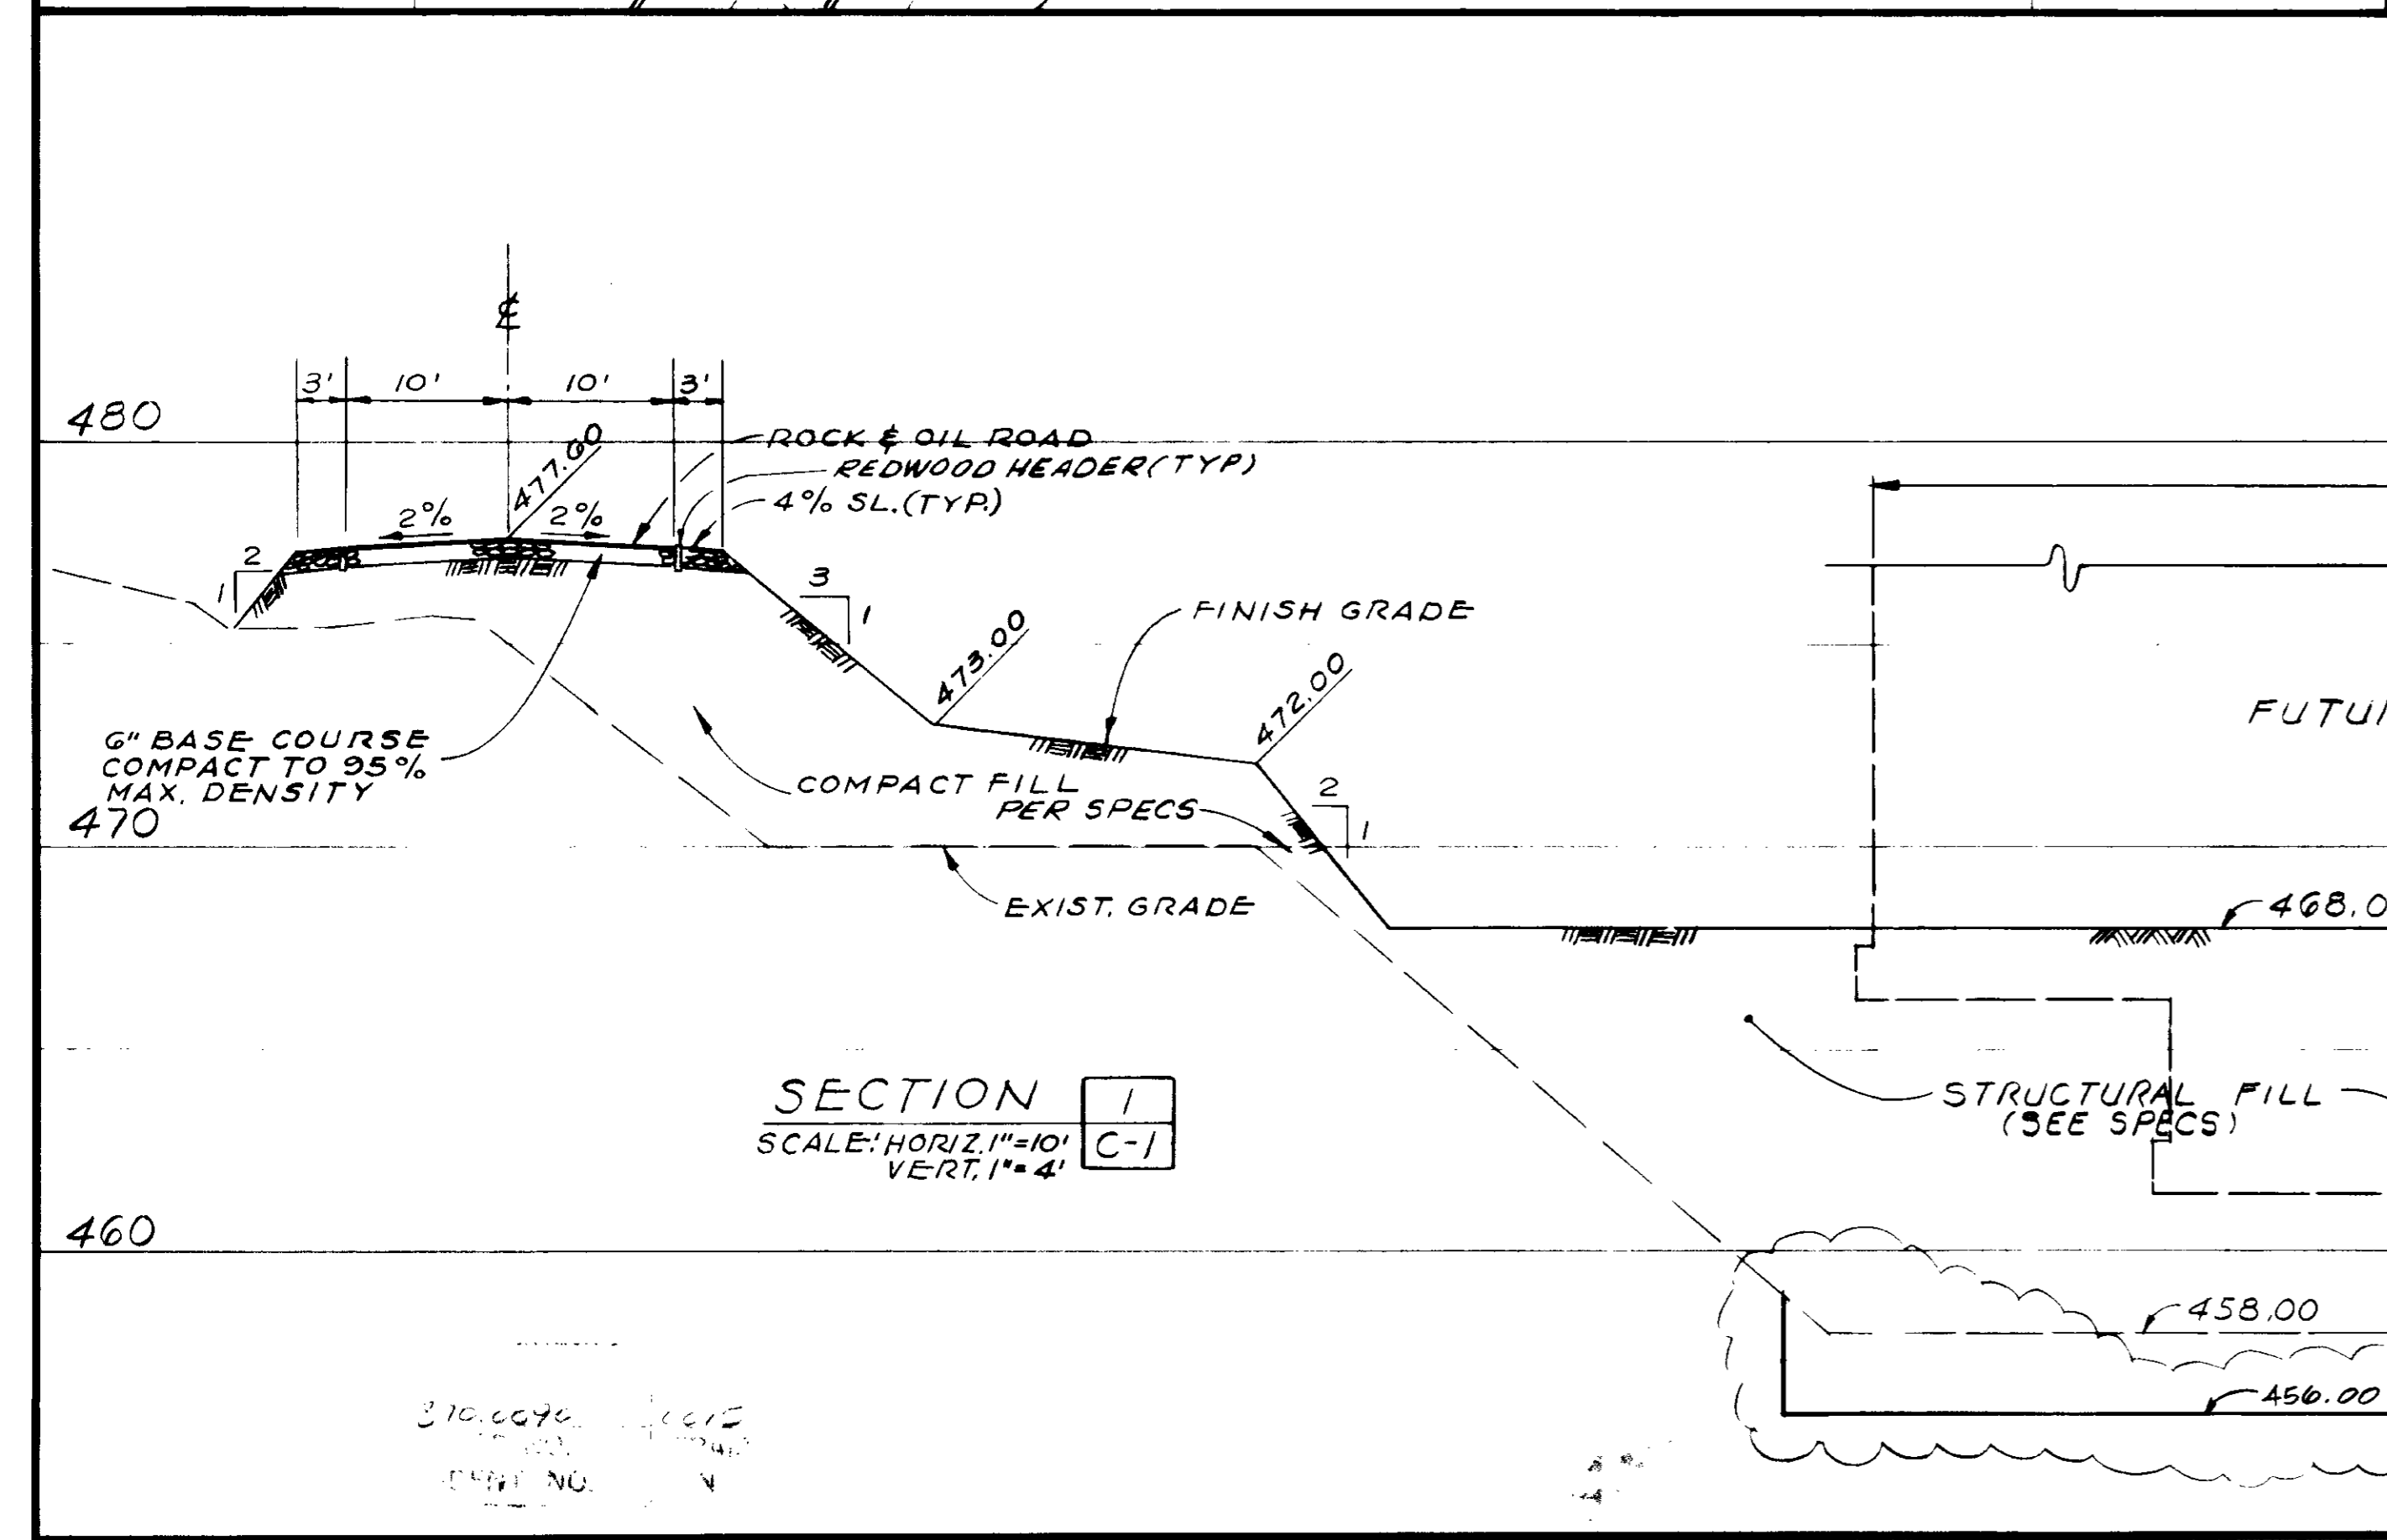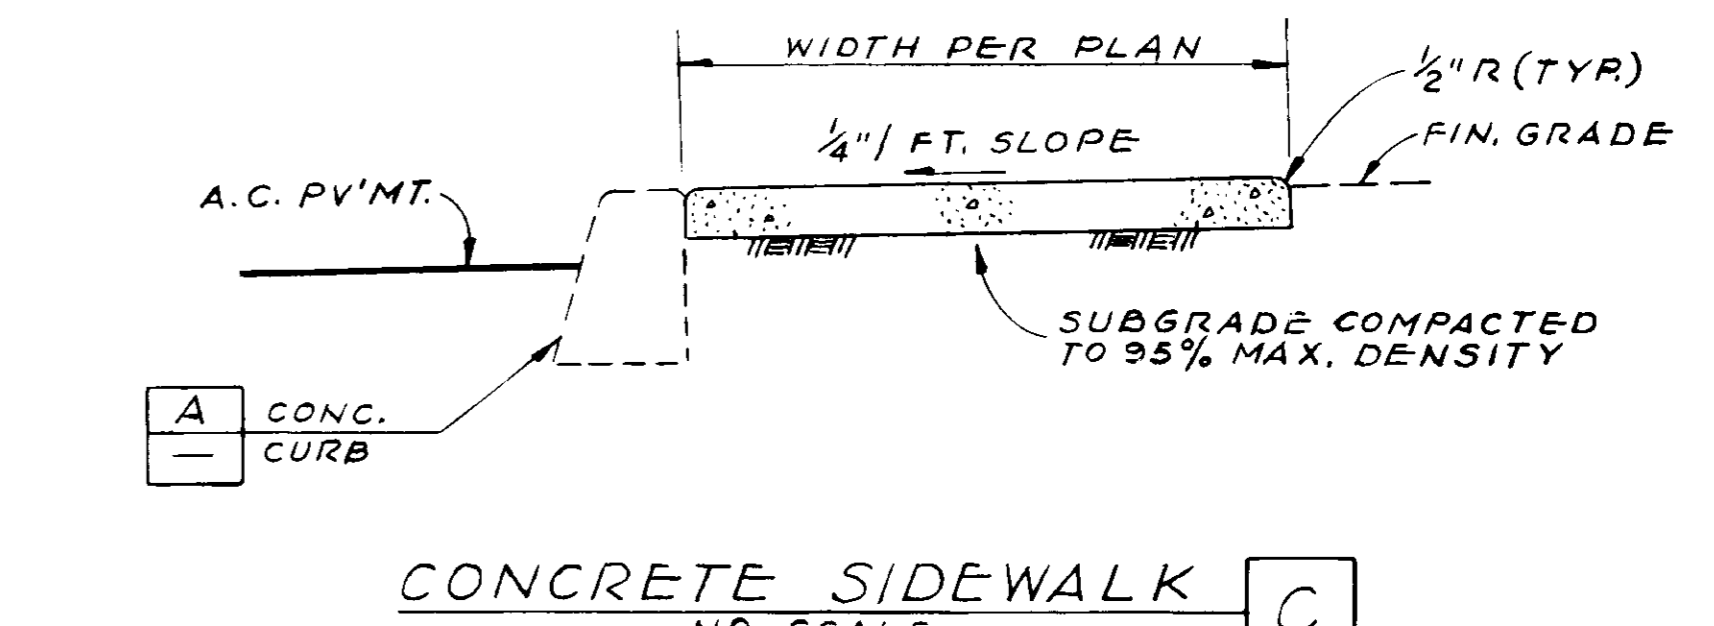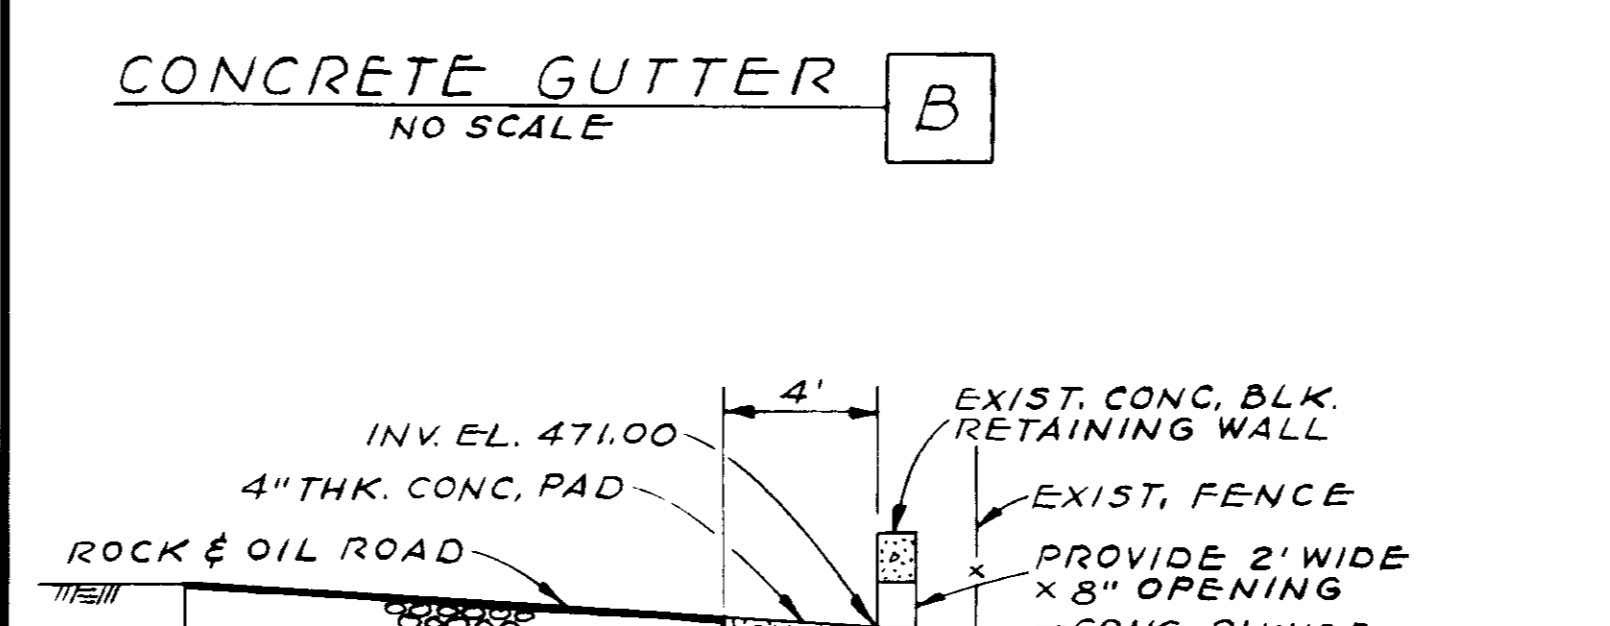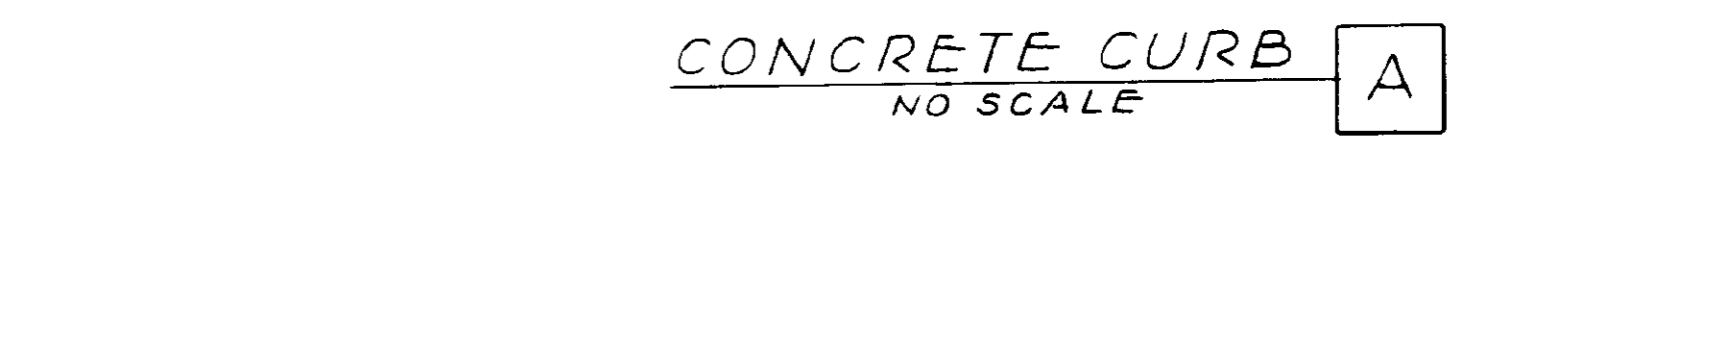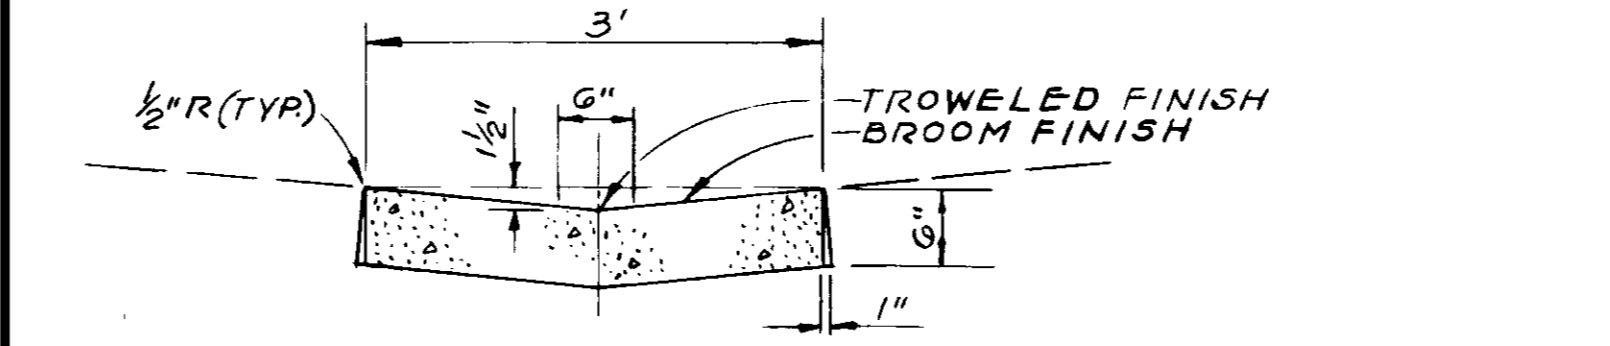

NOTE:
 A temporary construction slope gradient steeper than 1:1 may be acceptable upon request by the contractor and verification of soil conditions by the geotechnical engineer.

03553
RECORD DRAWING

REV	DATE	BY	DESCRIPTION
1	5/27/01	A.L.R.	CHANGE ORDER
2		J.M.H.	RECORD DRAWINGS


SCALE: AS SHOWN	DESIGNED: V. BAYANI	SUBMITTED: 27304 8/19/01
	DRAWN: R. GRIFFIN	R.C.E. NO. DATE
	CHECKED: S. MARCOS	RECOMMENDED: 27633 8/20/01
		R.C.E. NO. DATE

JAMES M. MONTGOMERY CONSULTING ENGINEERS, INC.
 355 EAST WALNUT STREET, PASADENA, CALIFORNIA 91101

DISTRICT APPROVAL ON TITLE PAGE

LAB VIRGENES MWD/TRIUNFO CBD
 TAPIA WRF - FILTRATION/DISINFECTION ADDITION
 PHASE II
 GRADING AND PAVING PLAN, SECTIONS AND DETAILS

SHEET
C-2
 OF 66 SHEETS

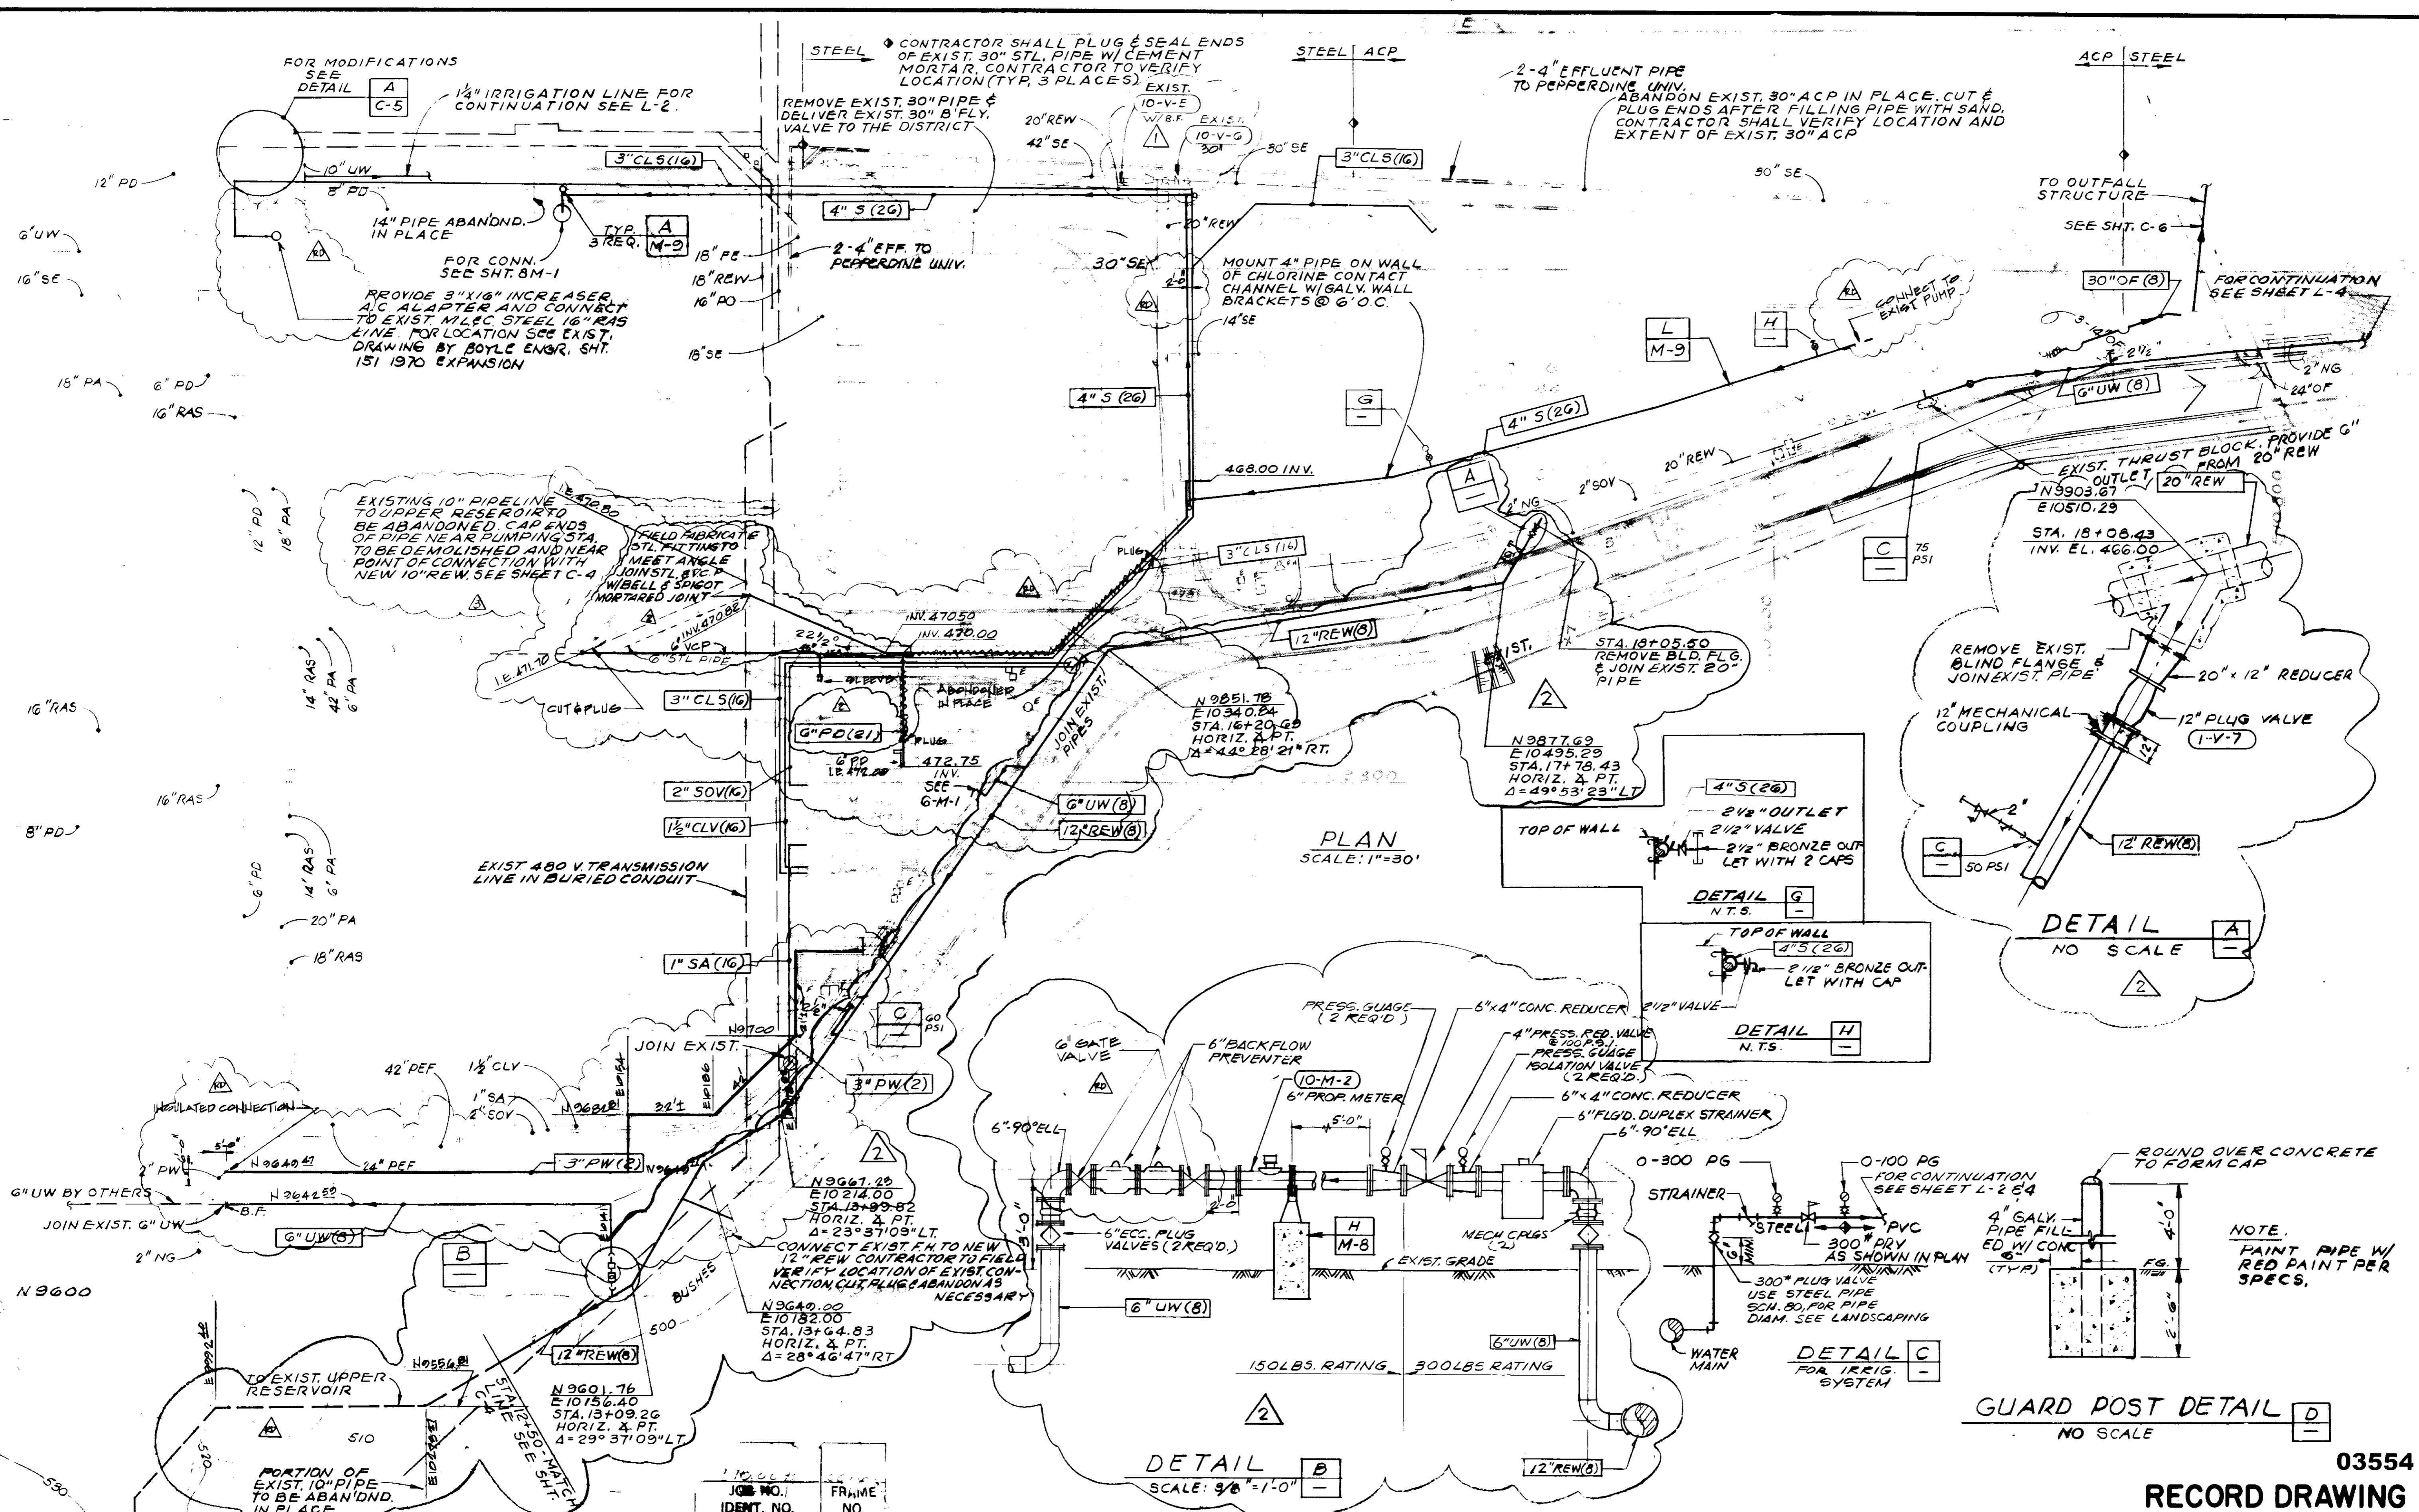

PLAN
SCALE: 1"=30'

DETAIL A
NO SCALE

DETAIL G
N.T.S.

DETAIL H
N.T.S.

DETAIL B
SCALE: 3/8"=1'-0"

DETAIL C
FOR IRRIG. SYSTEM

GUARD POST DETAIL D
NO SCALE

NOTE:
PAINT PIPE W/
RED PAINT PER
SPECS.

REV	DATE	BY	DESCRIPTION
1	3/1/91	A.V.	CONSTRUCTION CLARIFICATION
2	3/1/91	A.V.	CHANGE ORDER
3	3/1/91	R.G.	CONSTRUCTION CLARIFICATION

SCALE:	AS SHOWN
DESIGNED:	V. BAYANI
DRAWN:	A. QUINTANA
CHECKED:	S. MARRS


SUBMITTED:	27304	3/19/91
PROJECT ENGINEER:		
RECOMMENDED:	27638	3/20/91
JAMES M. MONTGOMERY CONSULTING ENGINEERS, INC.		

JAMES M. MONTGOMERY CONSULTING ENGINEERS, INC.
555 EAST WALNUT STREET, PASADENA, CALIFORNIA 91101

DISTRICT APPROVAL ON TITLE PAGE


LAB VIRGENES MWD/TRIUNFO CBD	SHEET
TAPIA WRF - FILTRATION/DISINFECTION ADDITION	C-3
PHASE II	YARD PIPING PLAN
OF 66 SHEETS	

03554
RECORD DRAWING

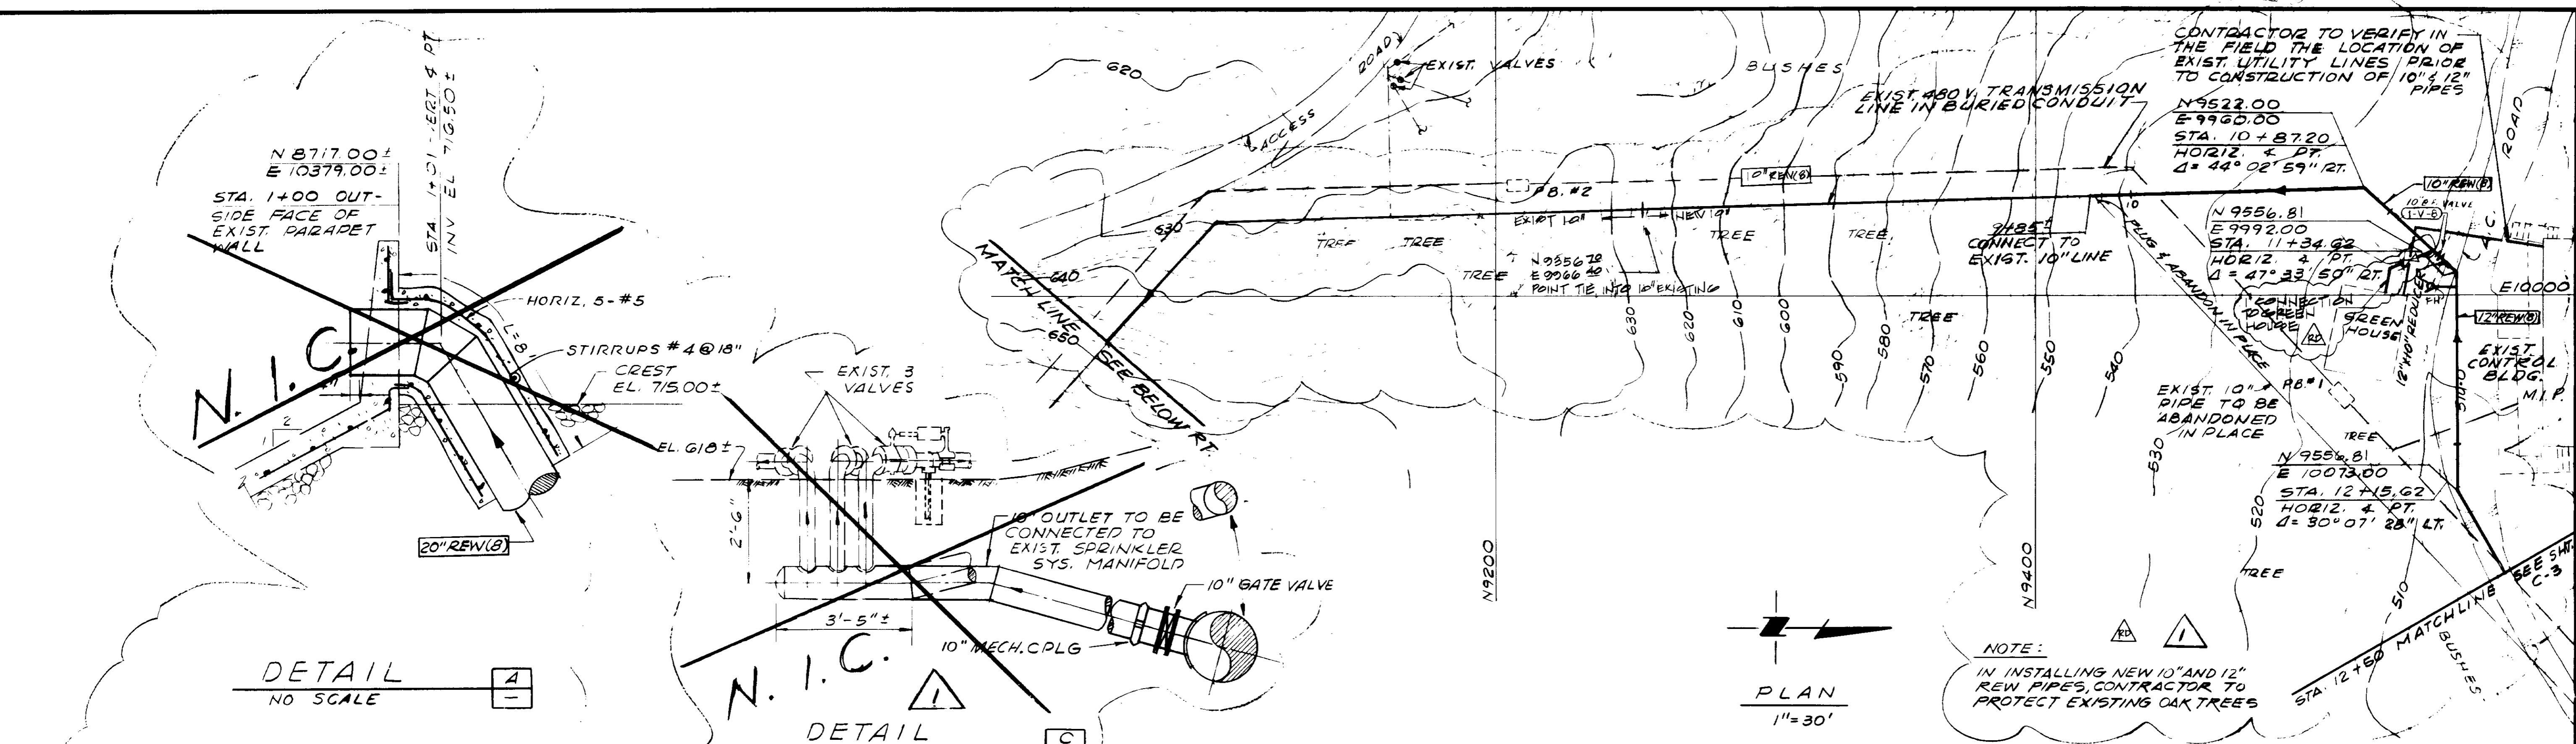

DETAIL A
NO SCALE

DETAIL C
NO SCALE

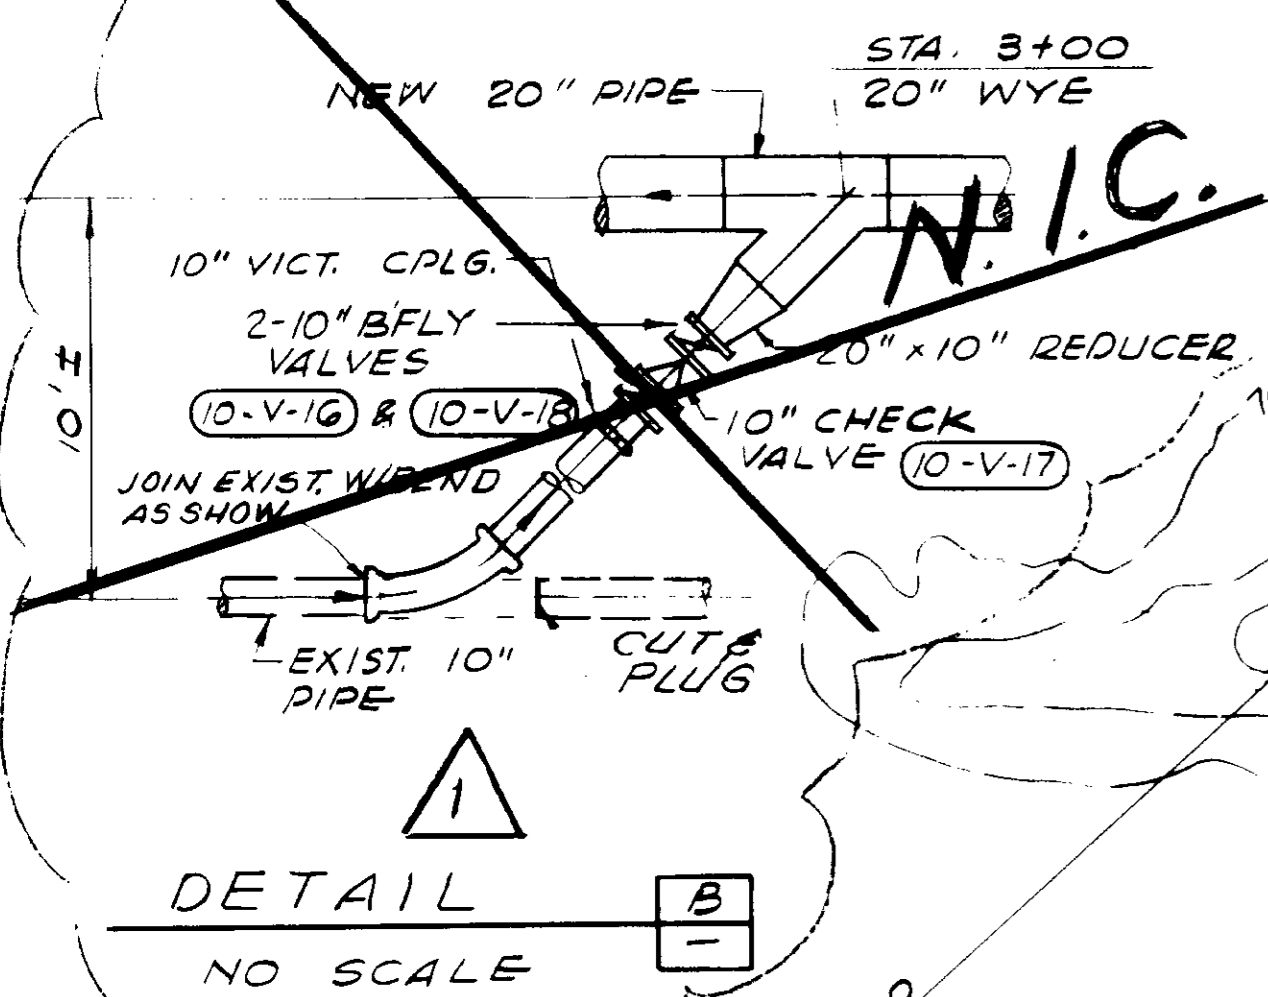

DETAIL B
NO SCALE

JOB NO. 10	FRAI. NO.
IDENT. NO.	

REV	DATE	BY	DESCRIPTION
1	3/1/81	A.V.	CHANGE ORDER
2	8/19/81	V. BAYANI	RECORD DRAWING




SCALE: AS SHOWN
DESIGNED: V. BAYANI
DRAWN: V. BAYANI
CHECKED: S. MARCO

SUBMITTED: Robert C. Siemala	27304	8/19/81
PROJECT ENGINEER	R.C.E. NO.	DATE
RECOMMENDED BY: V. BAYANI	27638	8/20/81
JAMES M. MONTGOMERY CONSULTING ENGINEERS, INC.	R.C.E. NO.	DATE

JAMES M. MONTGOMERY CONSULTING ENGINEERS, INC.
 555 EAST WALNUT STREET, PASADENA, CALIFORNIA 91101

DISTRICT APPROVAL ON TITLE PAGE

PHASE II	20" RECLAIMED WATER LINE - PLAN AND DETAILS
----------	---

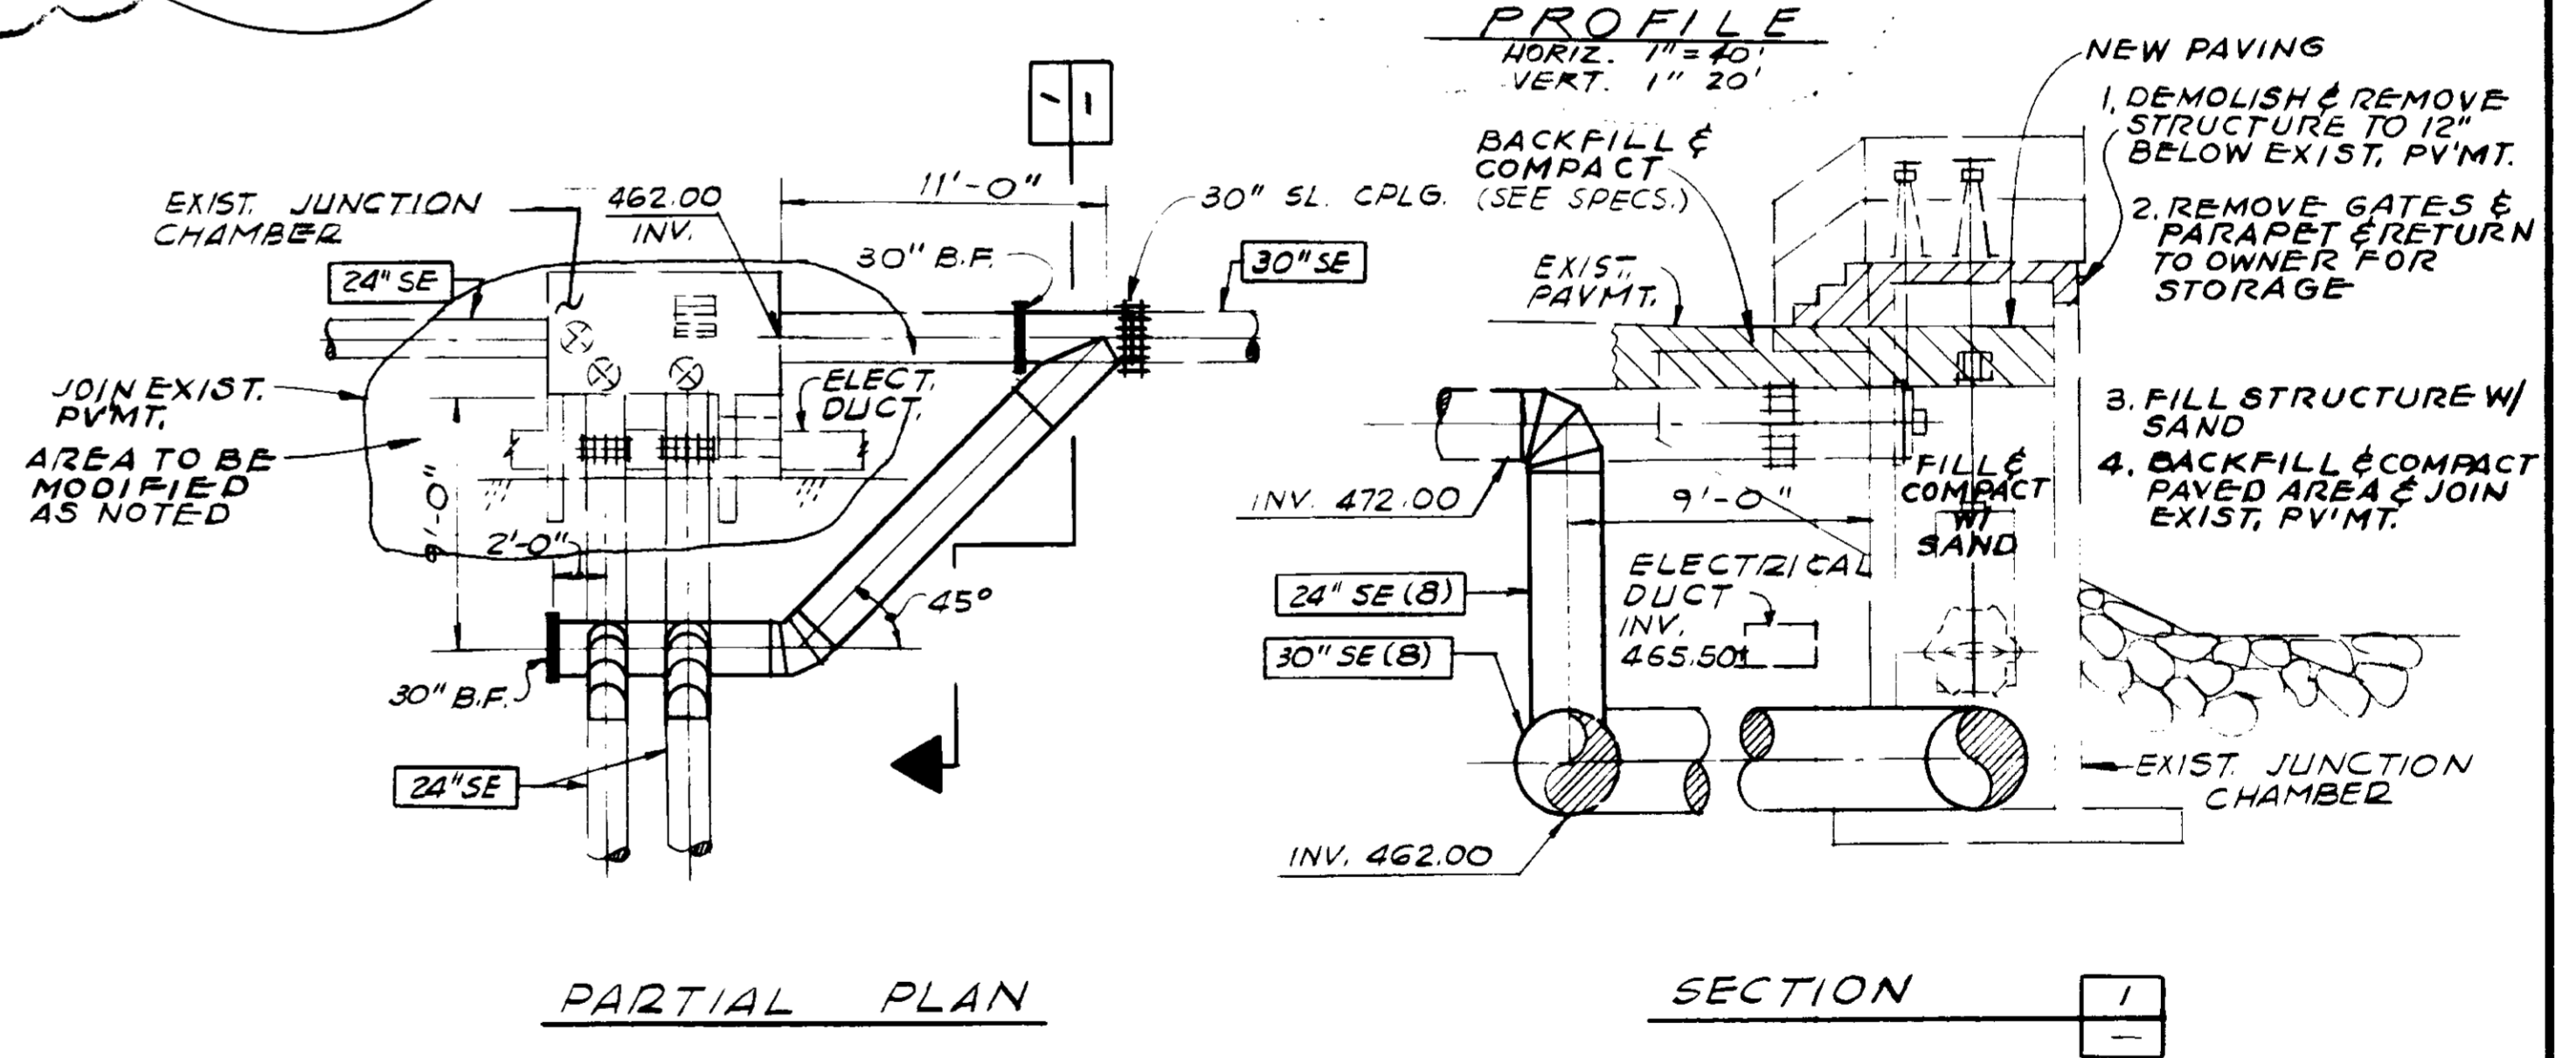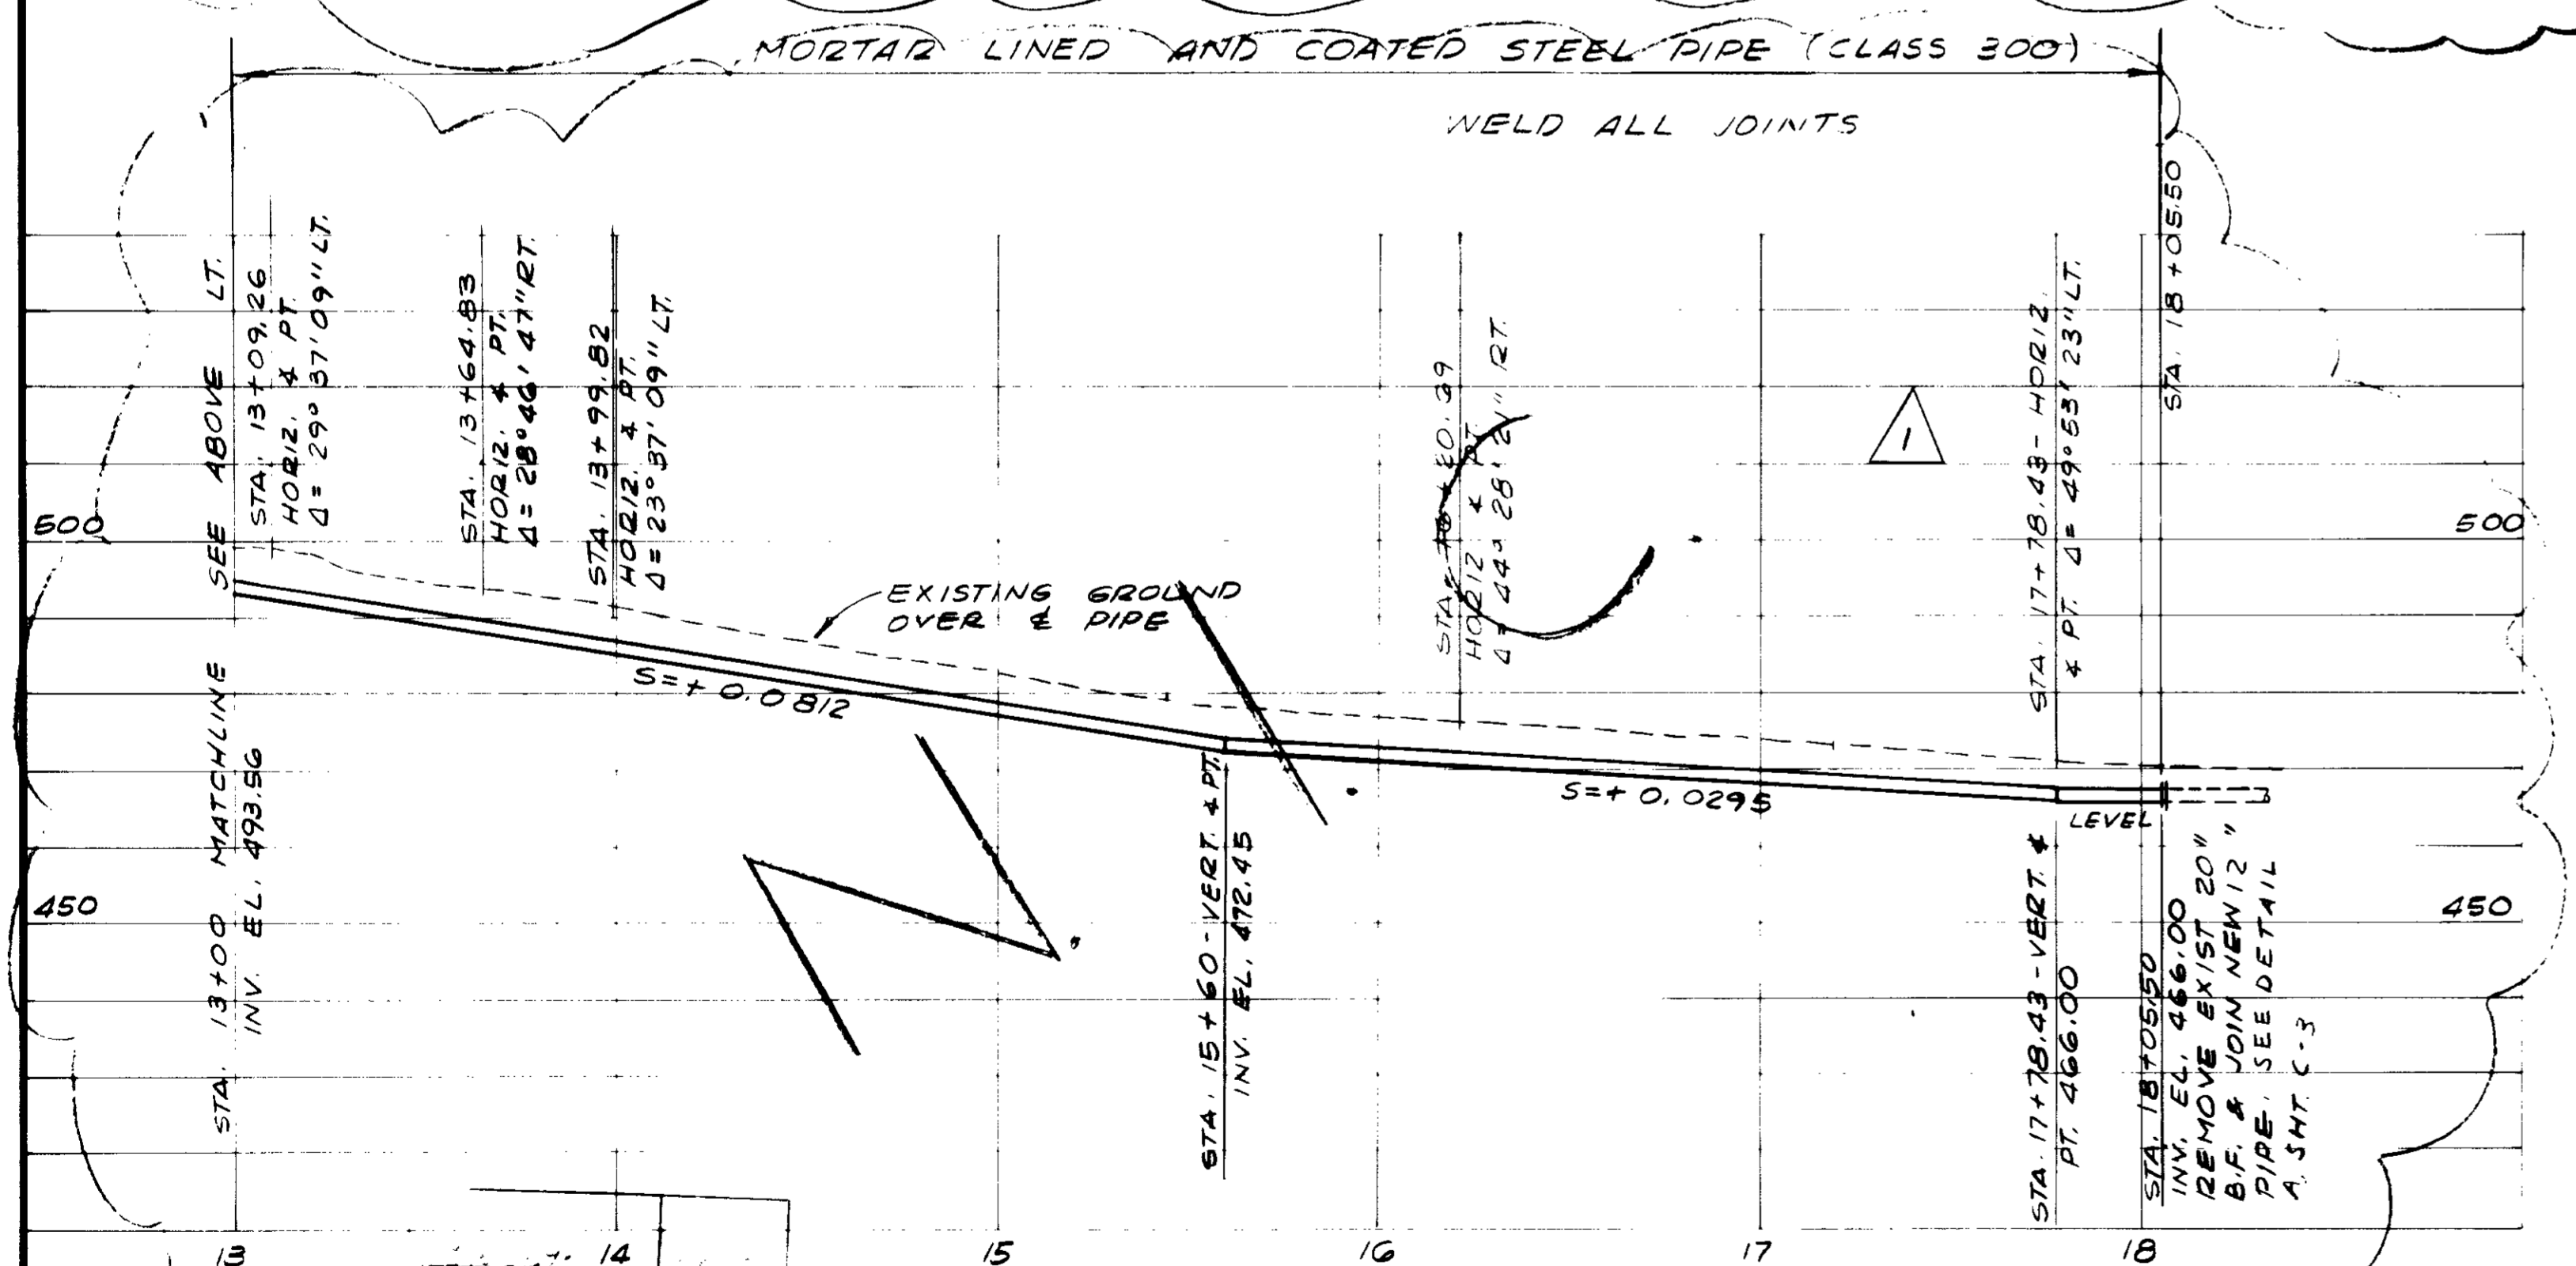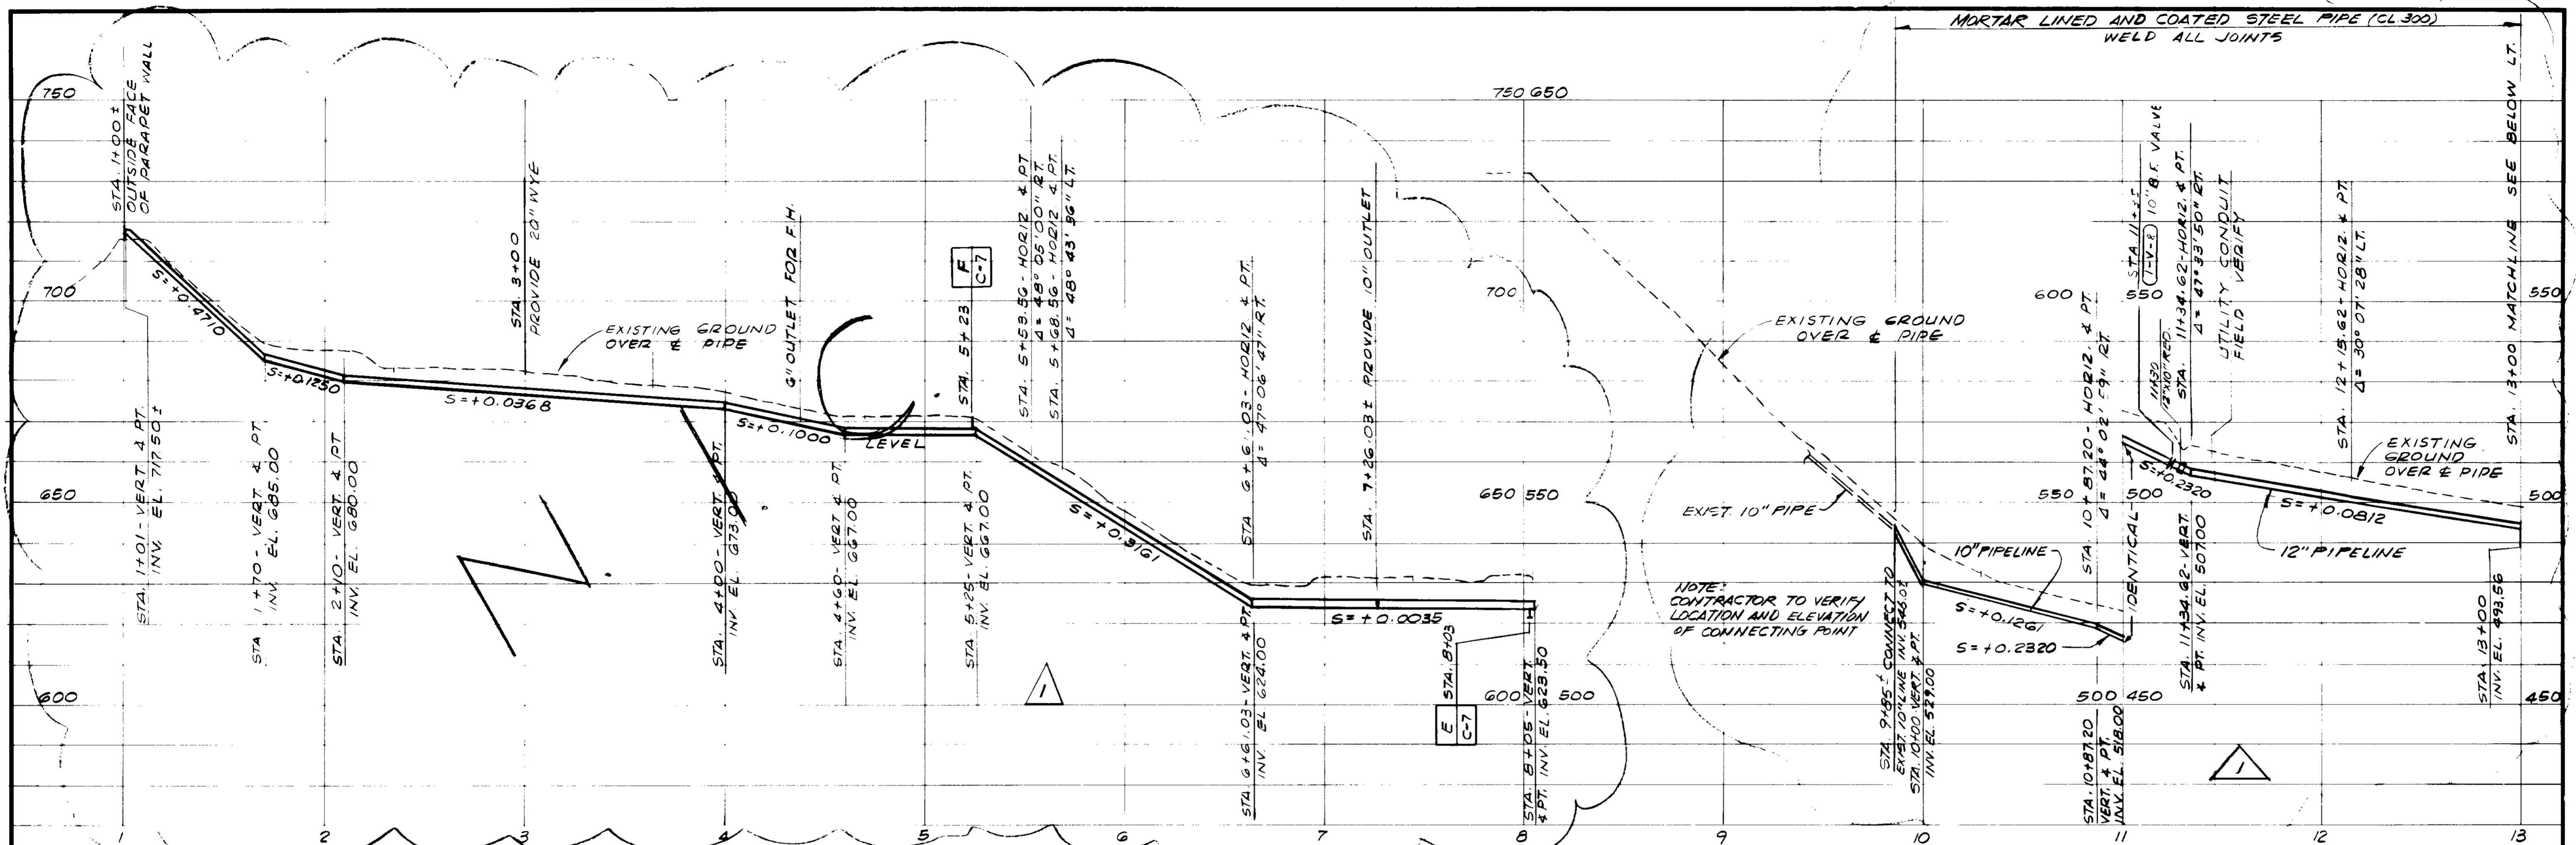

NOTE:
SEE SPECS. FOR SUGGESTED SEQUENCE OF WORK

JOB NO./ IDENT. NO.	FRAM. NO.

PROFILE 20"REW(B)

SCALE: HORIZ. 1" = 40'
VERT. 1" = 20'

DETAIL A
NO SCALE C-3


03556
RECORD DRAWING

SCALE: AS SHOWN	DESIGNED: V. BAYANI	SUBMITTED: 27304 8/19/81
	DRAWN: V. BAYANI	PROJECT ENGINEER: [Signature]
	CHECKED: S. MARCO	RECOMMENDED: [Signature]
		DATE: 8/19/81
		R.C.E. NO. 27638
		DATE: 8/19/81
		R.C.E. NO. 27638


JAMES M. MONTGOMERY CONSULTING ENGINEERS, INC.
355 EAST WALNUT STREET, PASADENA, CALIFORNIA 91101

DISTRICT APPROVAL ON TITLE PAGE


LAS VIRGENES MWD/TRIUNFO CSD		SHEET
TAPIA WRF-FILTRATION/DISINFECTION ADDITION		C-5
PHASE II	20" RECLAIMED WATER LINE - PROFILE AND DETAILS	OF 66 SHEETS

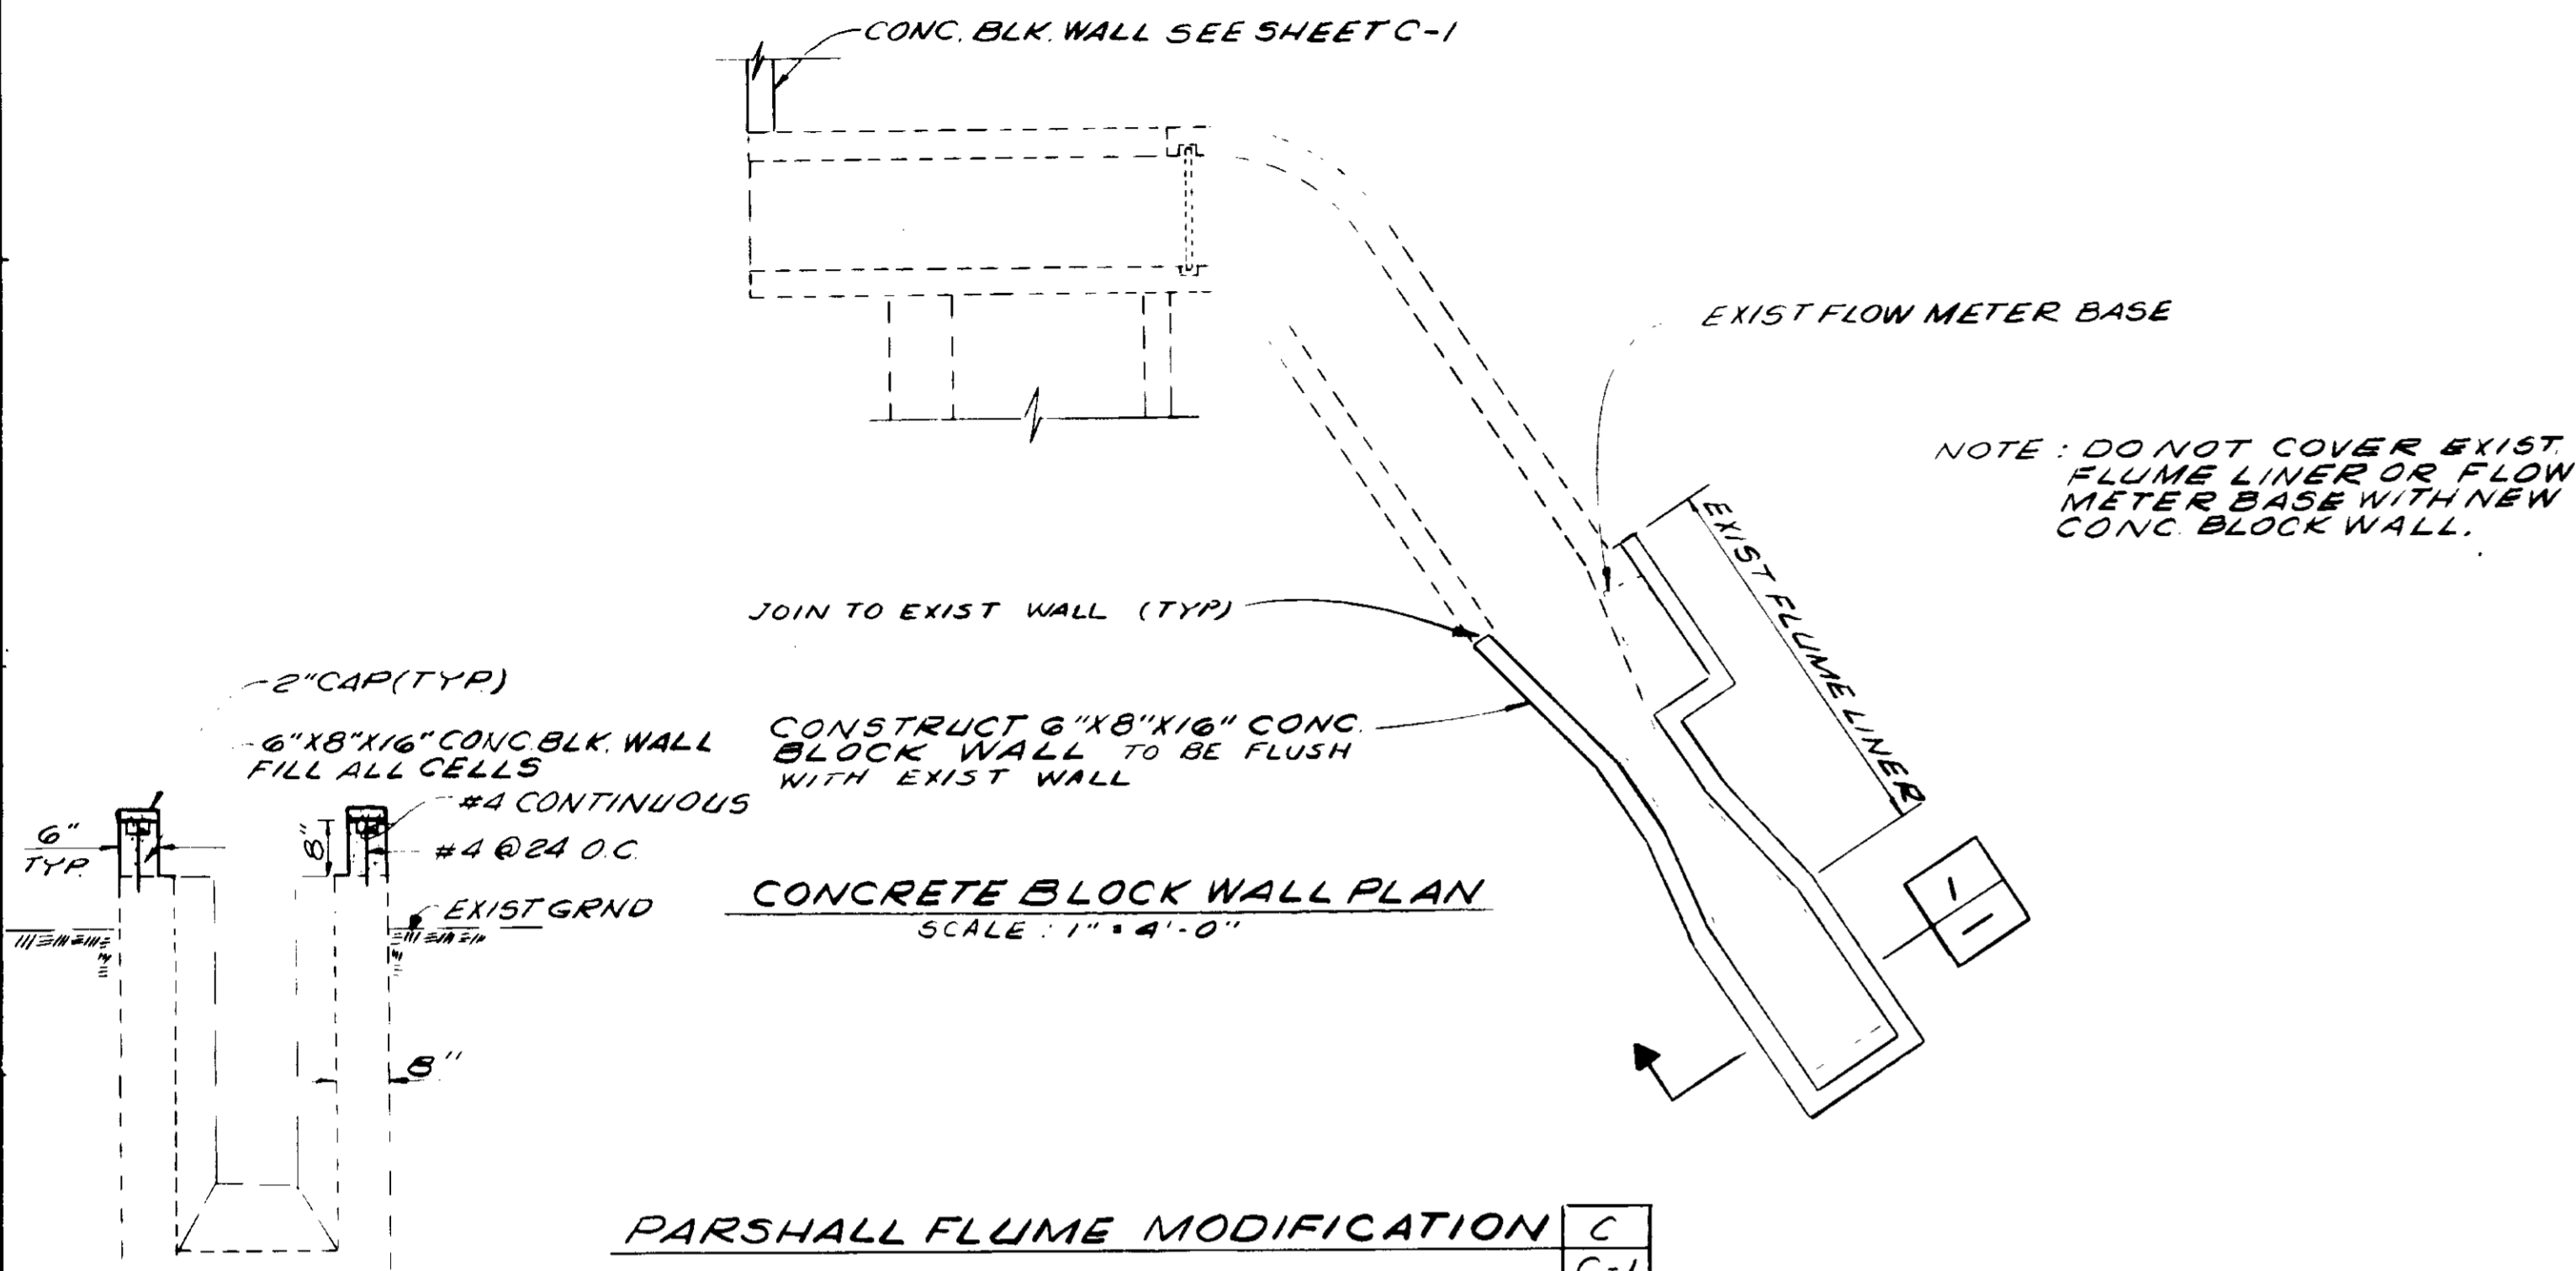


SECTION 1
SCALE: 1" = 2'-0"

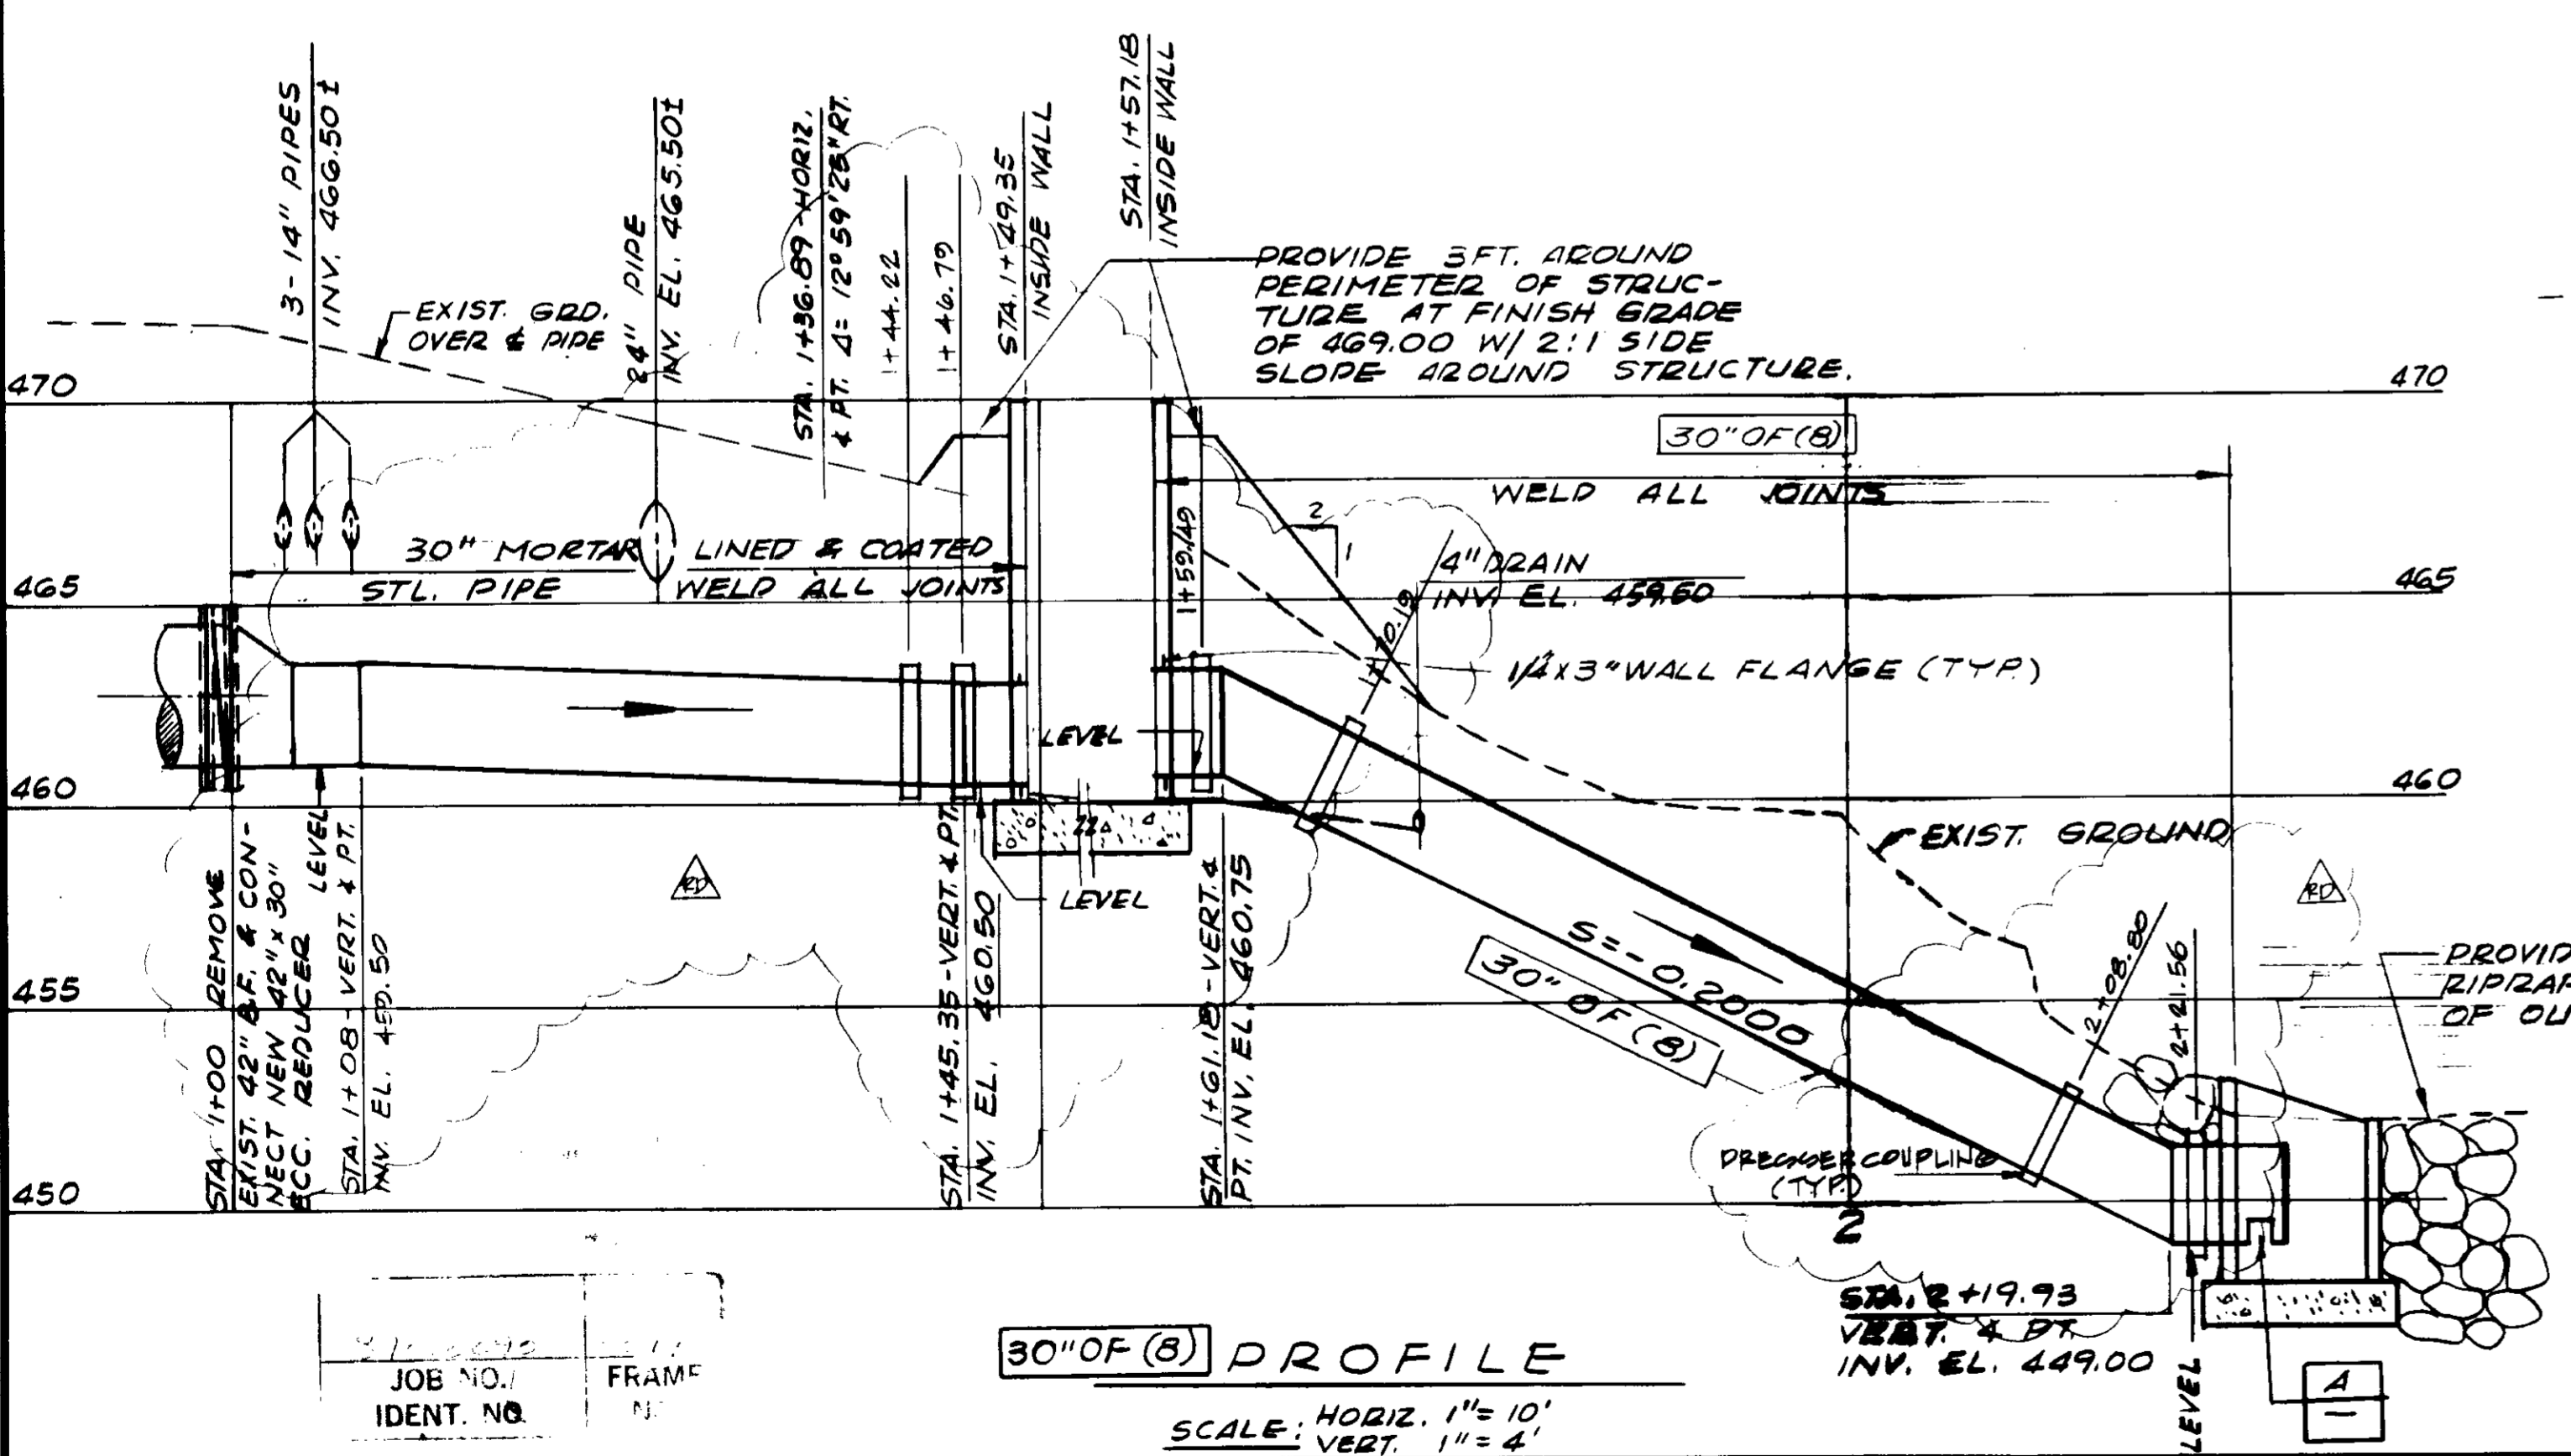


RD 14184 MOU RECORD DRAWINGS	SCALE: AS SHOWN	SUBMITTED: Robert C. Smith 27304 8/19/81
	DESIGNER: V. BAYANI	PROJECT ENGINEER: Robert C. Smith 27304 8/19/81
	DRAWN: V. BAYANI	RECOMMENDER: [Signature] 27638 8/20/81
	CHECKED: S. [Signature]	JAMES M. MONTGOMERY CONSULTING ENGINEERS, INC. R.C.E. NO. 88VE
REV DATE BY DESCRIPTION		

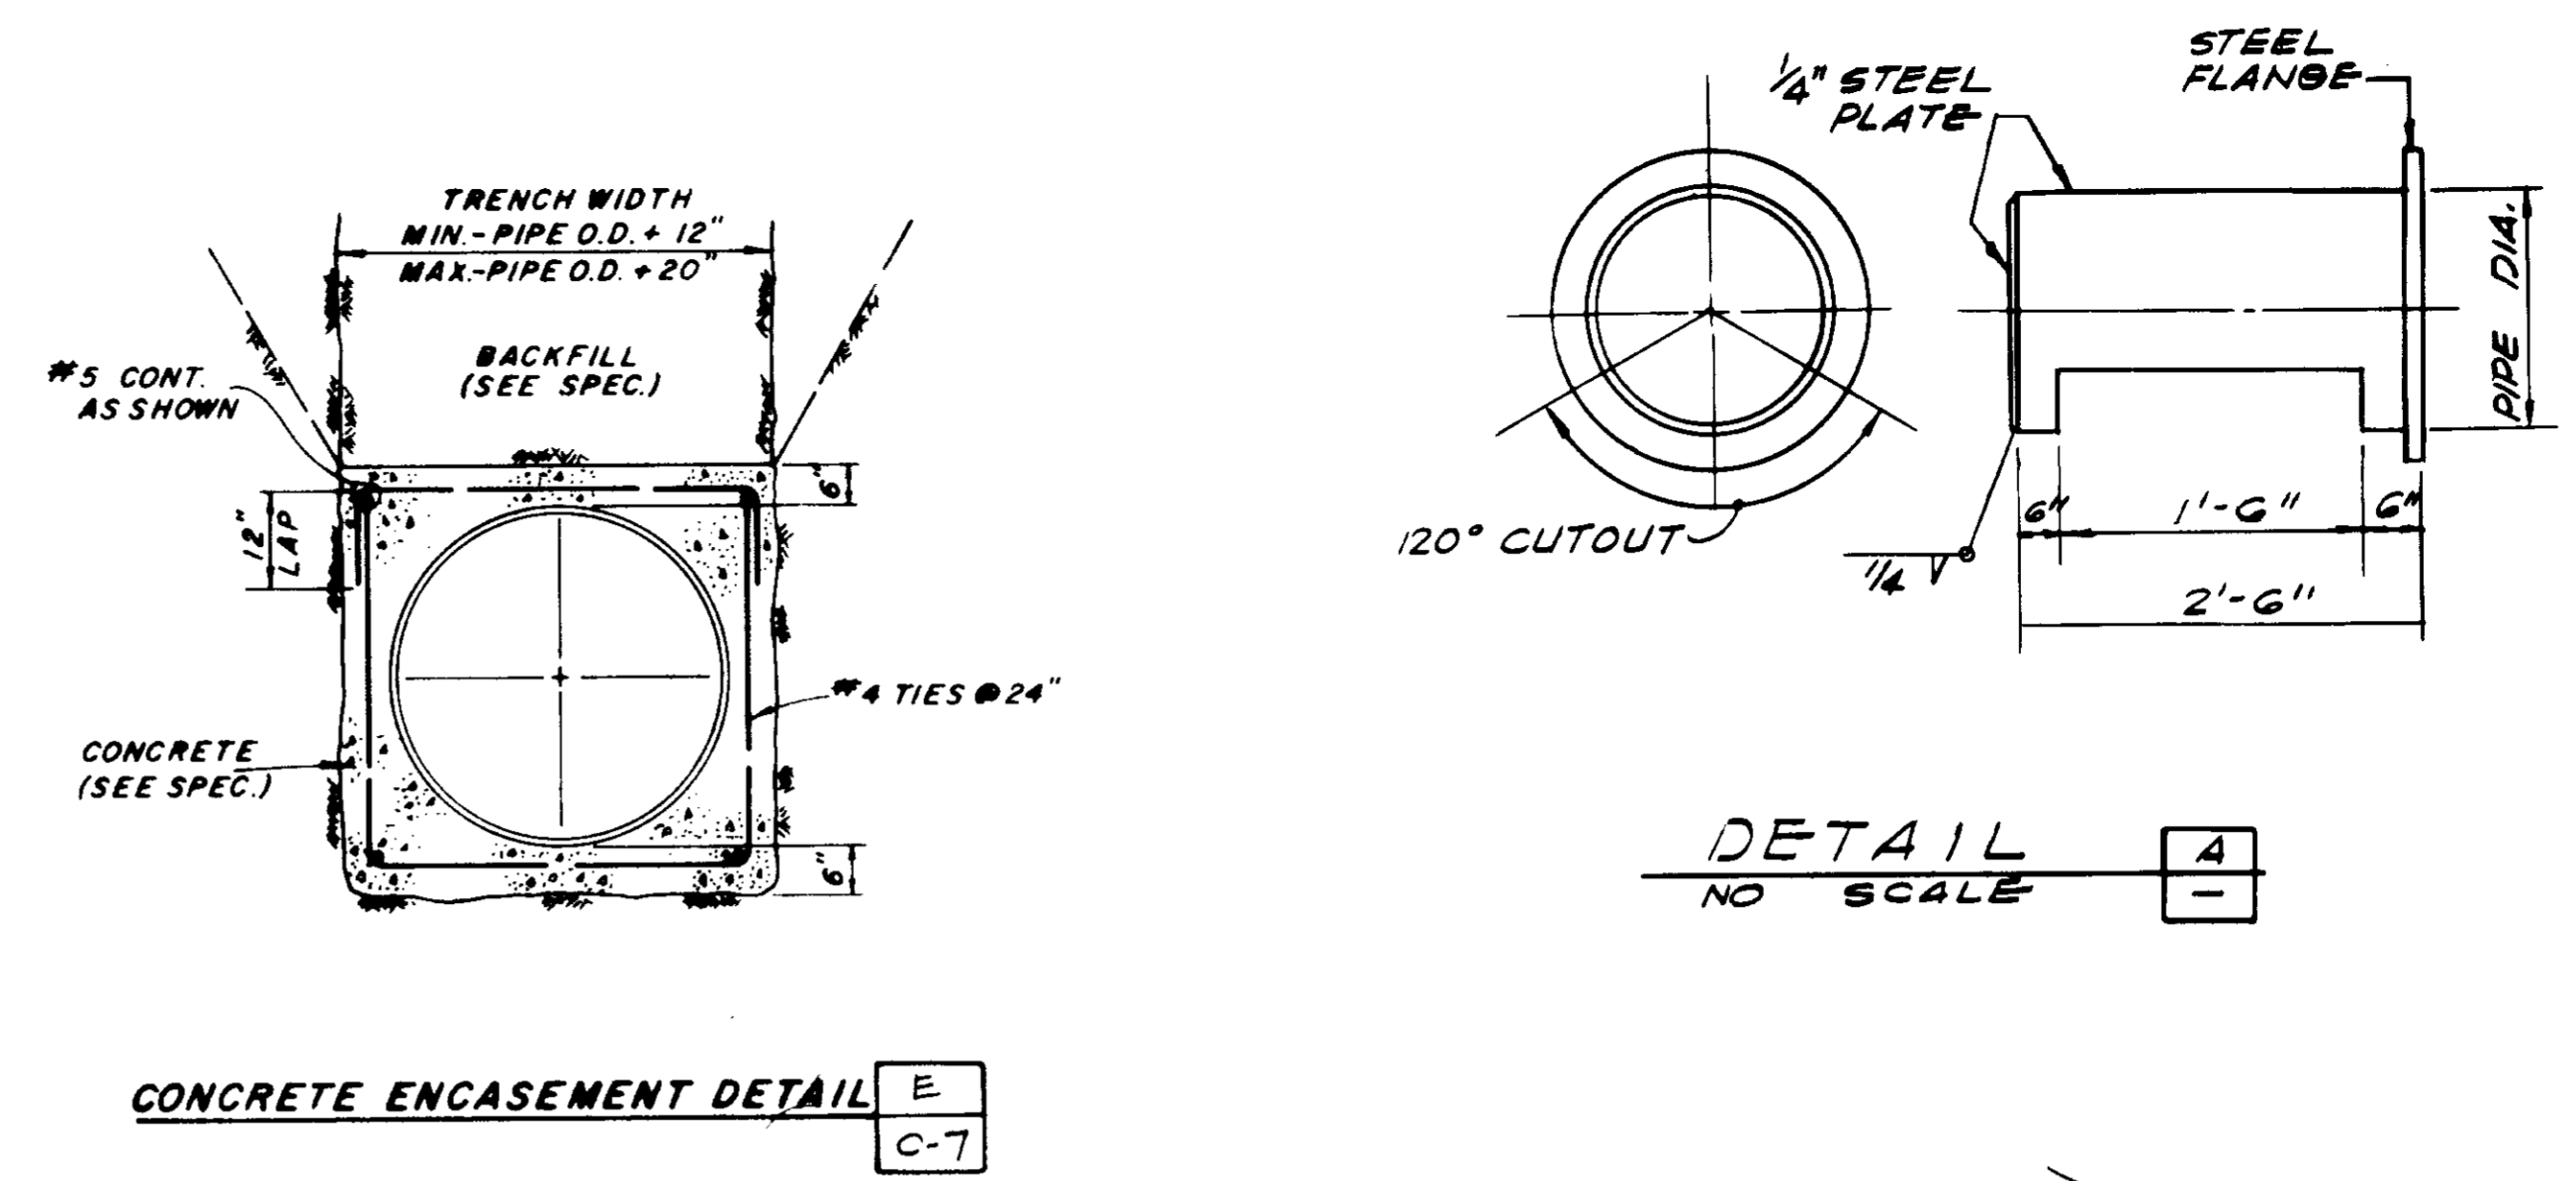

CONCRETE ENCASEMENT DETAIL E
C-7

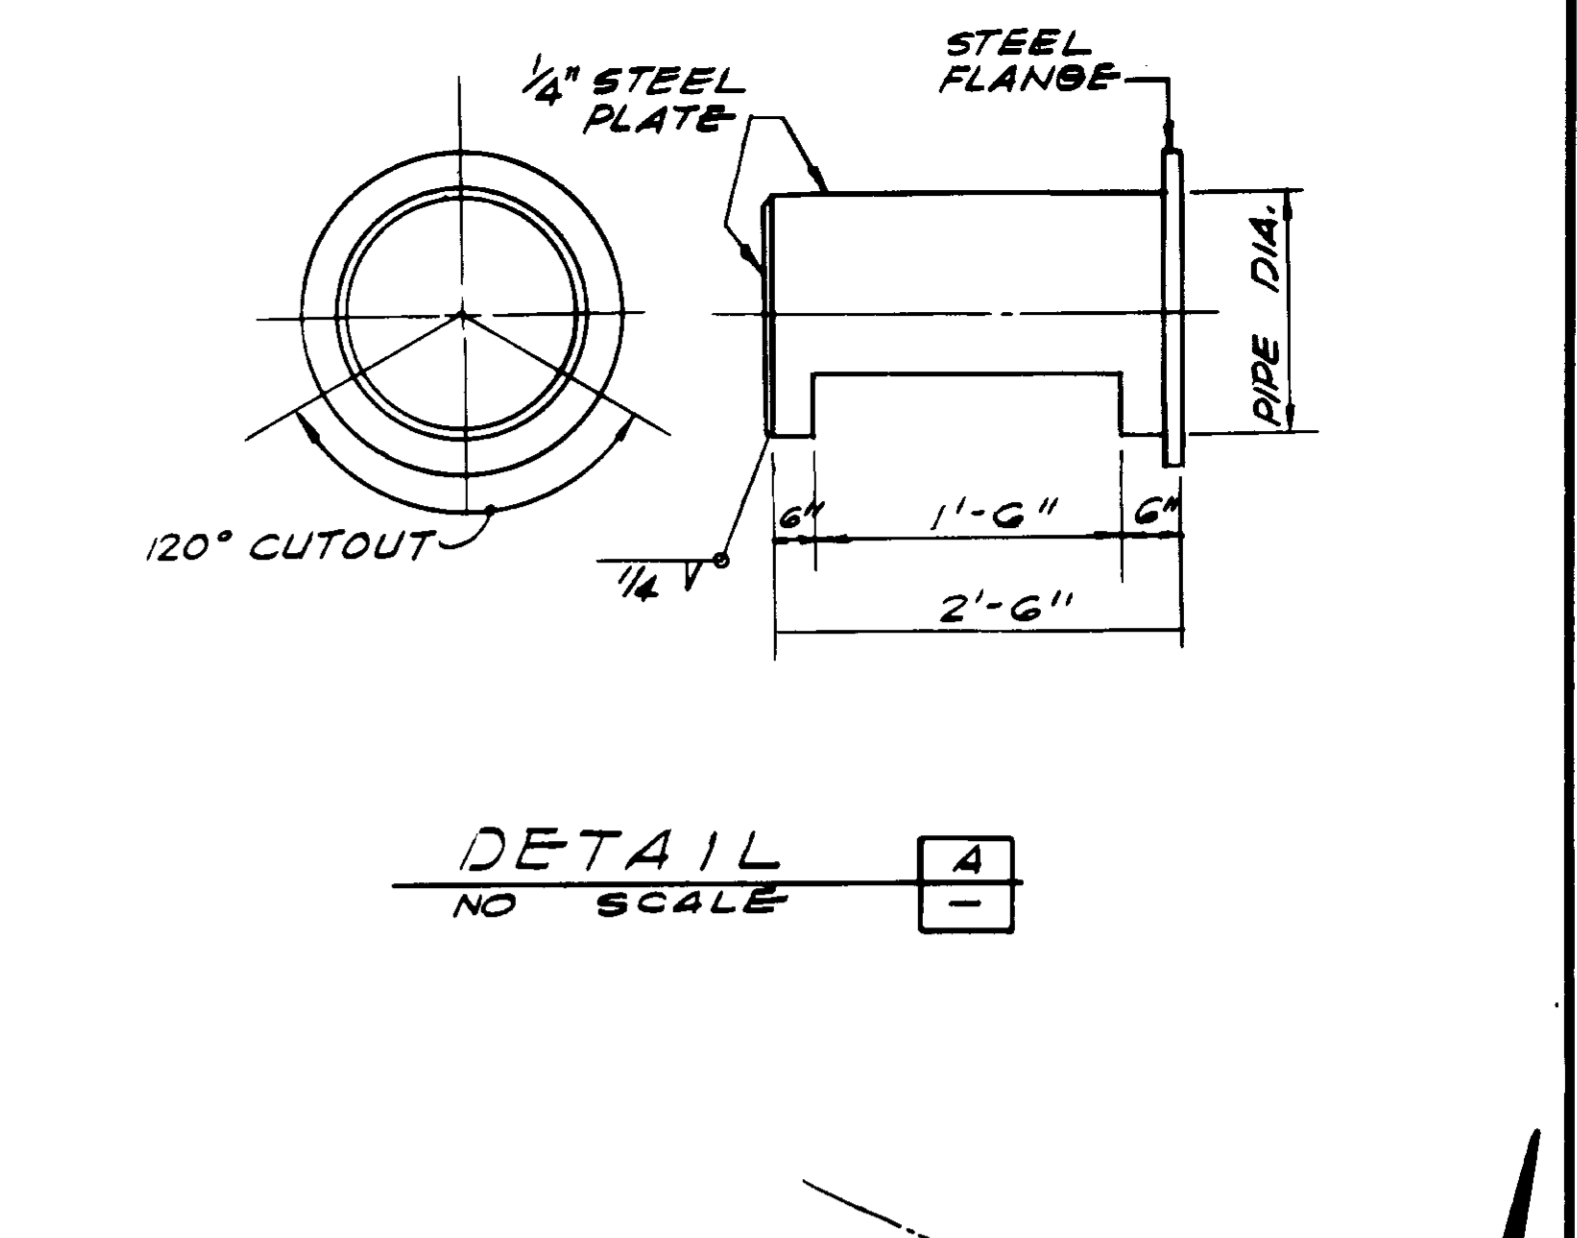


DETAIL A
NO SCALE

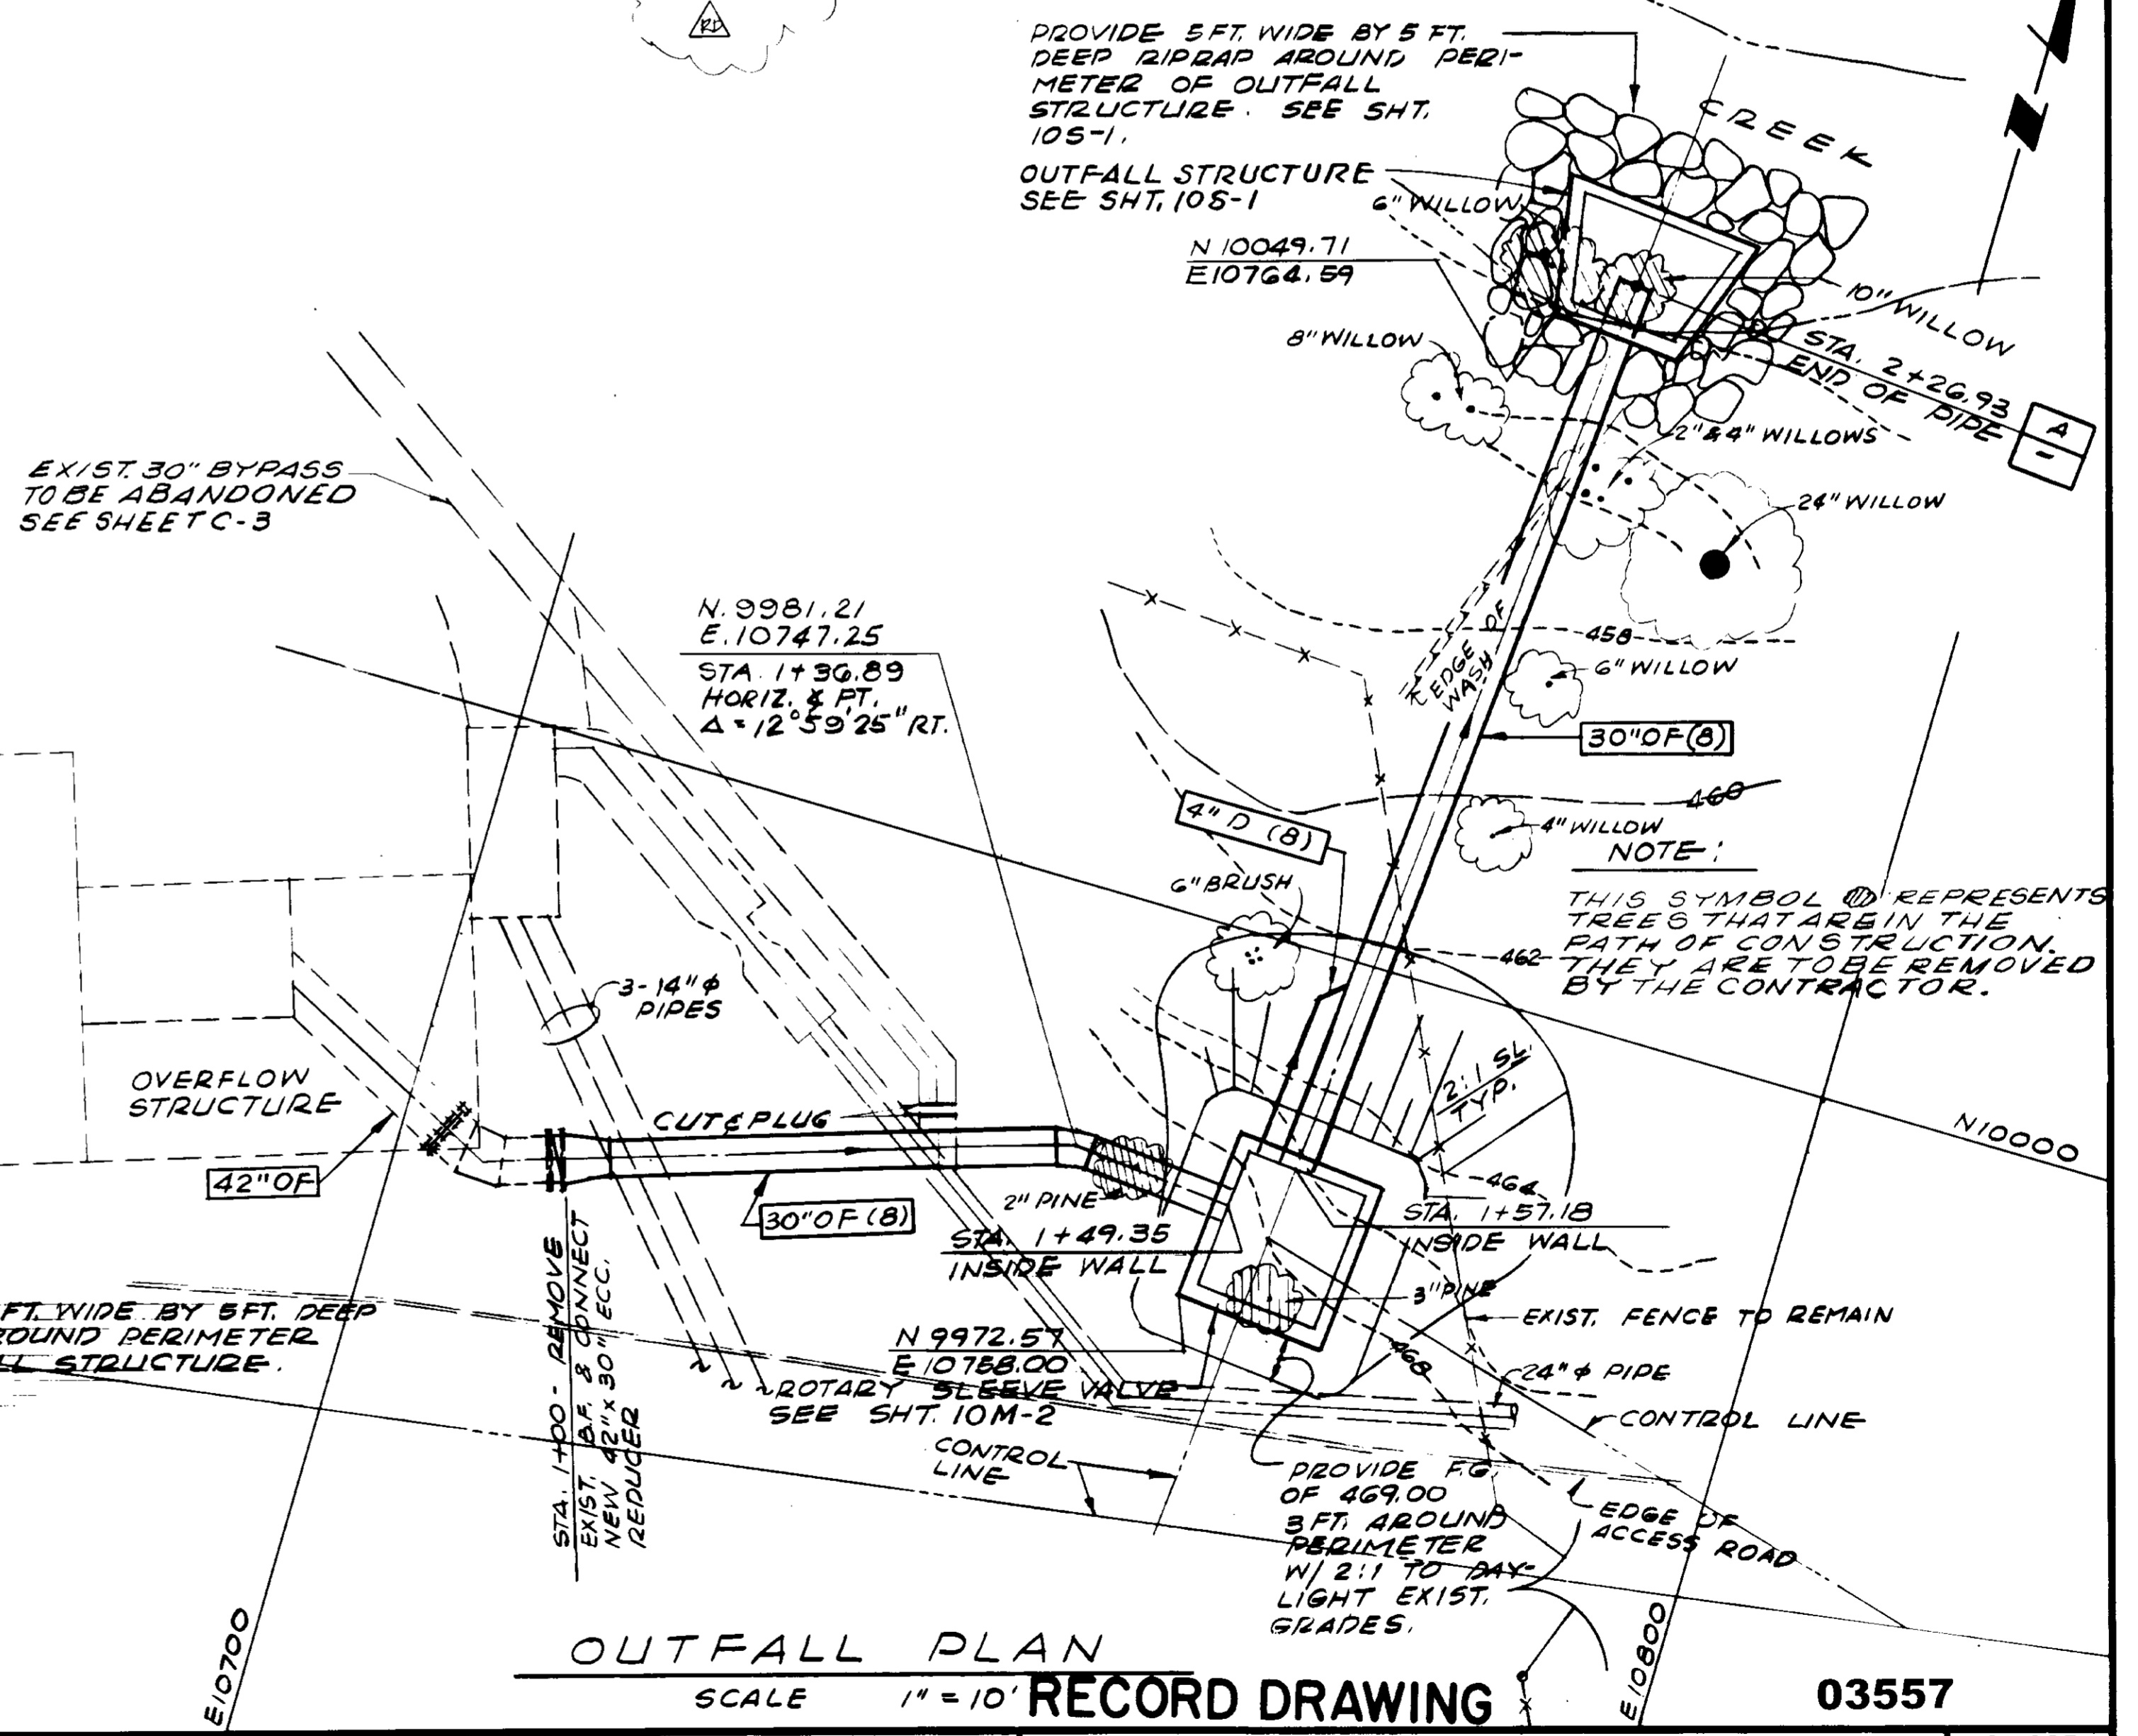

OUTFALL PLAN RECORD DRAWING
SCALE 1" = 10'


JAMES M. MONTGOMERY CONSULTING ENGINEERS, INC.
355 EAST WALNUT STREET, PARADENA, CALIFORNIA 91011

DISTRICT APPROVAL ON TITLE PAGE	LAS VIRGENES MWD/TRIUNFO CSD	SHEET
	TAPIA WRF - FILTRATION / DISINFECTION ADDITION	C-6
PHASE II	DETAILS AND OUTFALL STRUCTURE PLAN AND PIPING PROFILE	OF 56 SHEETS


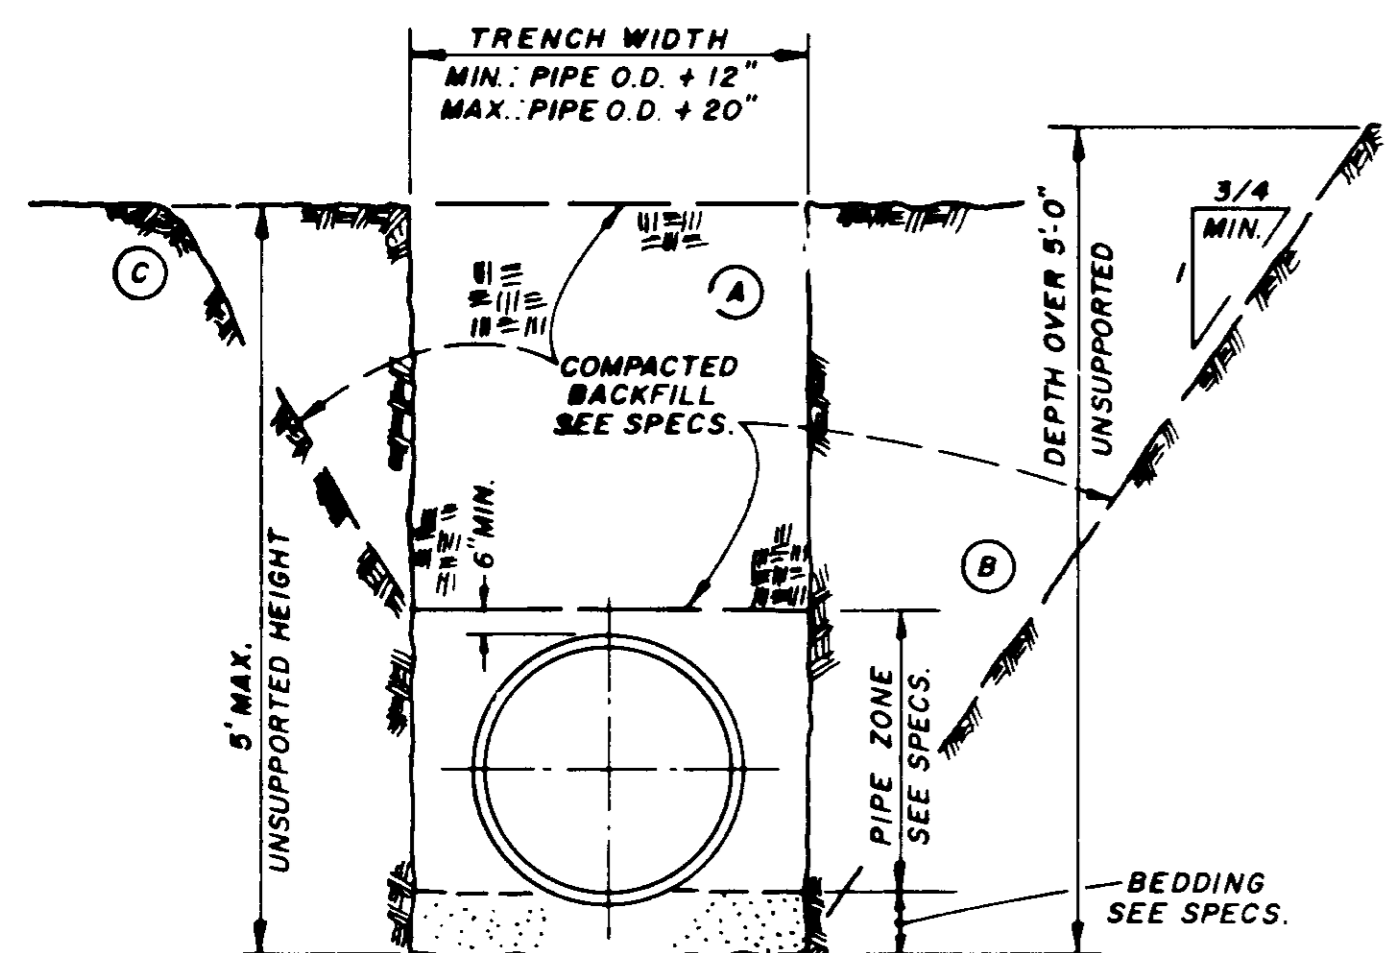


1. ALTERNATIVE TRENCH SECTIONS (A, B and C) ARE FOR USE ONLY WHERE STABLE, COMPACT SOIL CONDITIONS EXIST.
- A. Vertical trench walls-Section (A)**
- For depths up to 5 feet, no trench support is required.
 - For depths exceeding 5 feet, shoring or solid sheathing is required.
- B. Sloping trench walls-Section (B)**
- Sloping trench wall section shall not be used without approval of engineer, unless specifically designated on plans or in specifications.
 - Except as approved by engineer, unsupported sloping trench walls shall not be steeper than 3/4 horiz. to 1 vert.
- C. Combination of vertical and sloping trench walls-Section (C)**
- Trench depths not exceeding 5 feet shall have vertical walls in pipe zone unless otherwise approved by engineer, or where specified.
 - For trenches with combined walls and any depth exceeding 5 feet, design calculations by a registered civil engineer and approval by governing agency of support methods are required.
2. WHERE WET, UNSTABLE OR RUNNING SOIL IS ENCOUNTERED, SOLID SHEATHING IS REQUIRED FOR ALL VERTICAL TRENCH WALLS.



TYPICAL TRENCH SECTION A

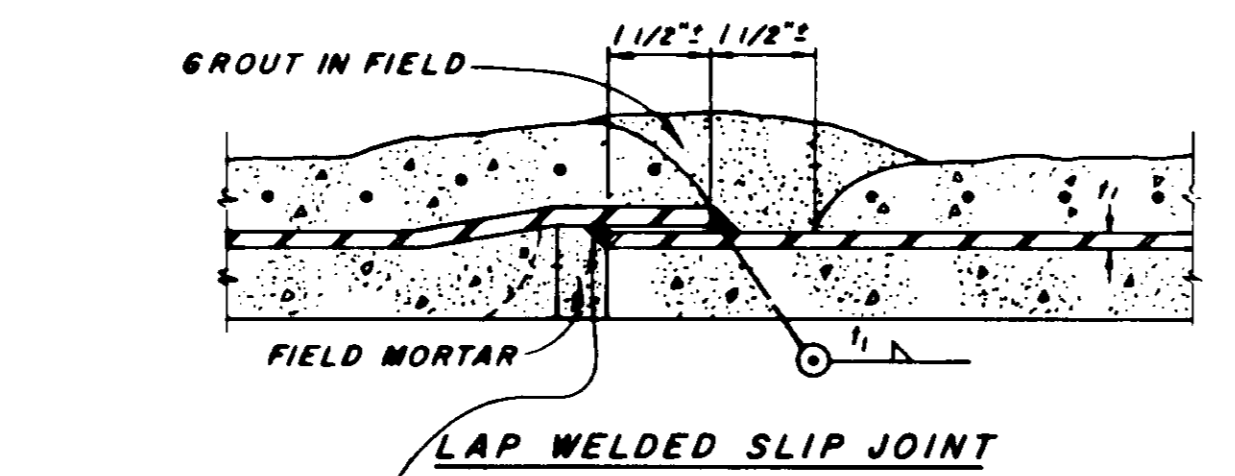



INSIDE WELD AT CONTRACTOR'S OPTION FOR 24" PIPE AND LARGER

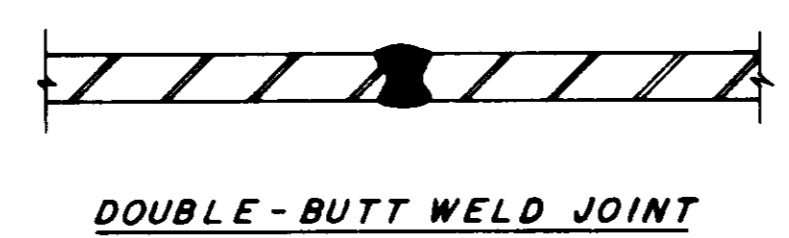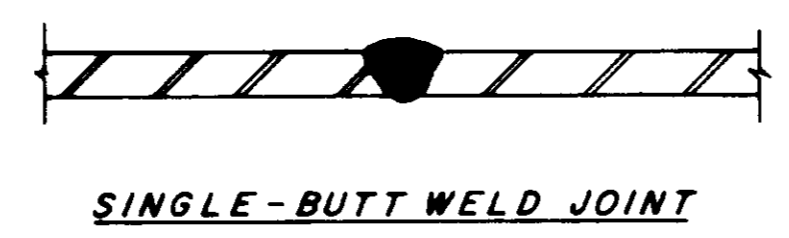

MORTAR LINED AND COATED STEEL PIPE B

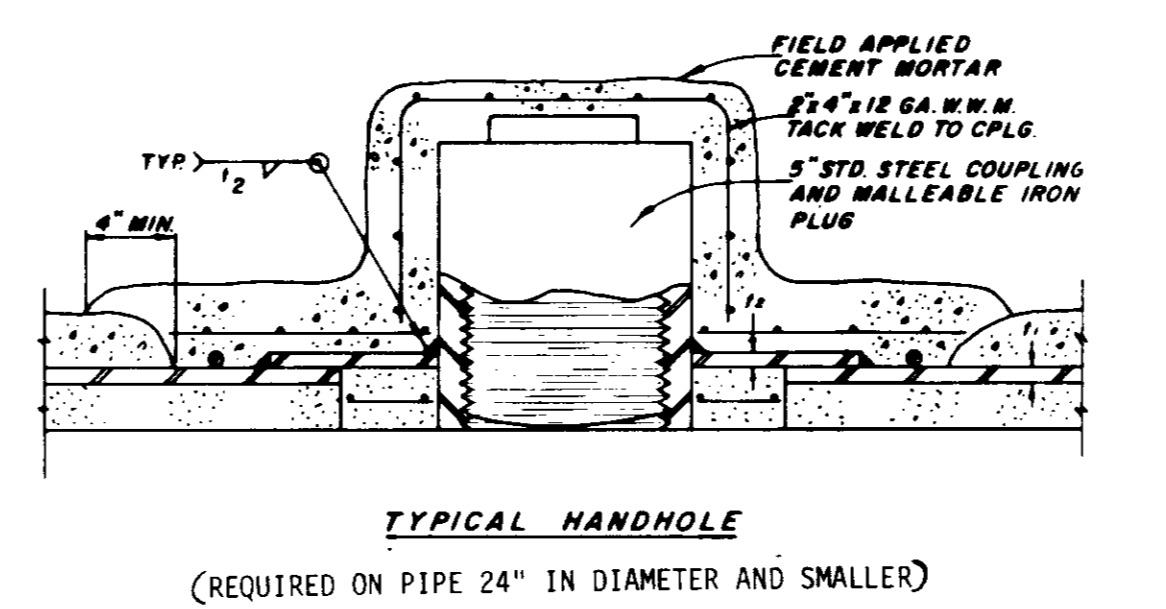
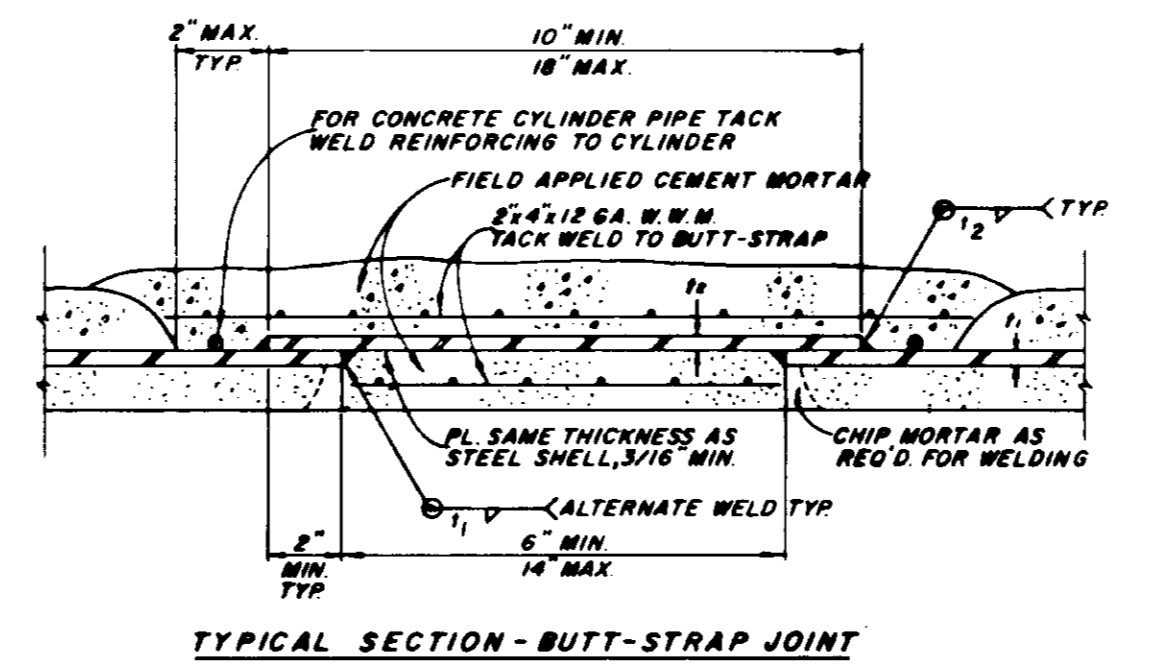


BUTT-STRAP JOINT FOR STEEL CYLINDER CONCRETE PIPE, STEEL PIPE MORTAR LINED AND COATED, AND WELDED STEEL PIPE C

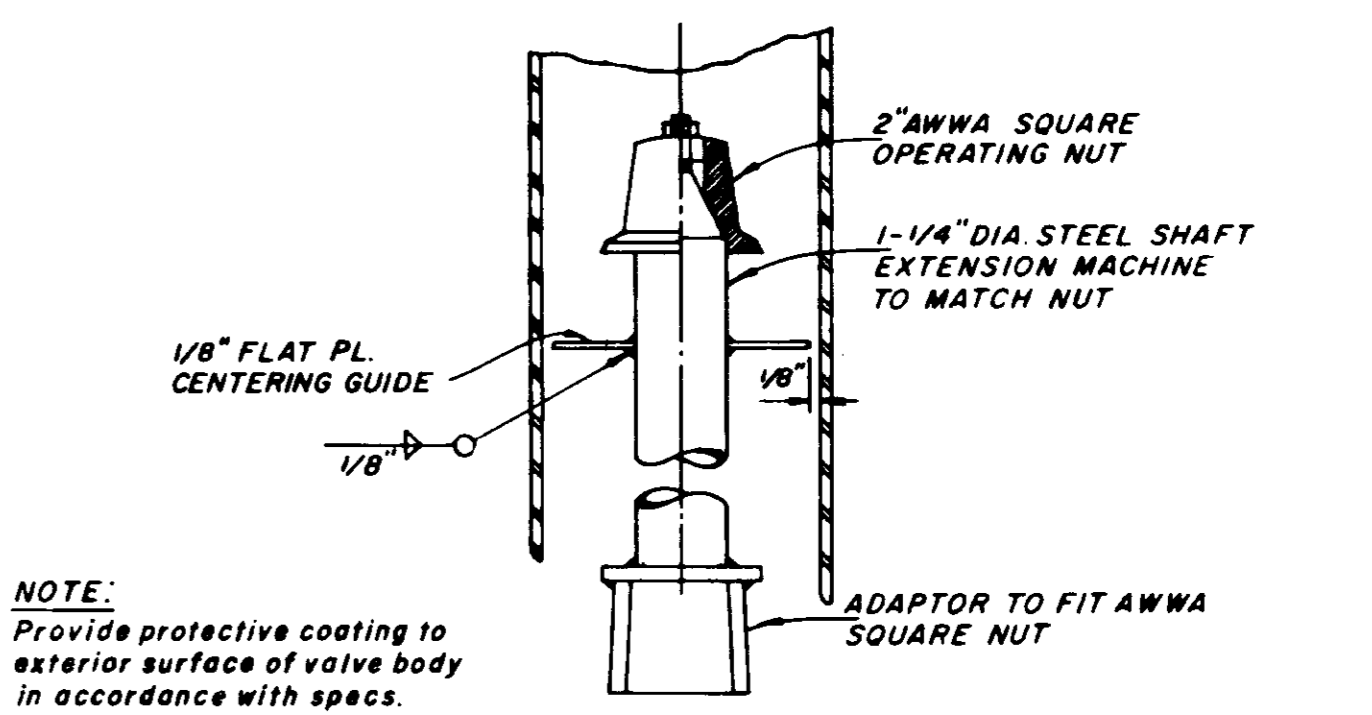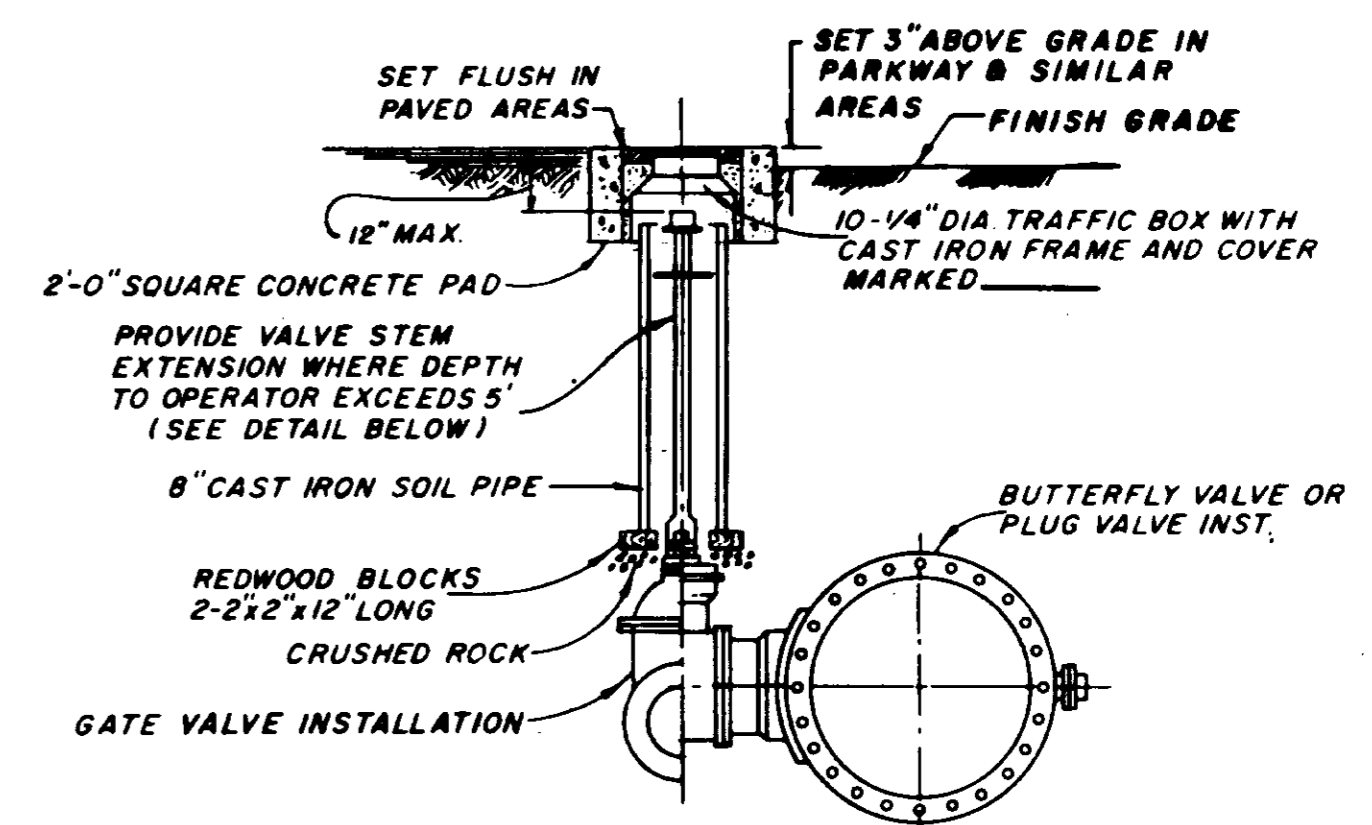


NOTE: Provide protective coating to exterior surface of valve body in accordance with specs.

BURIED VALVE INSTALLATION D

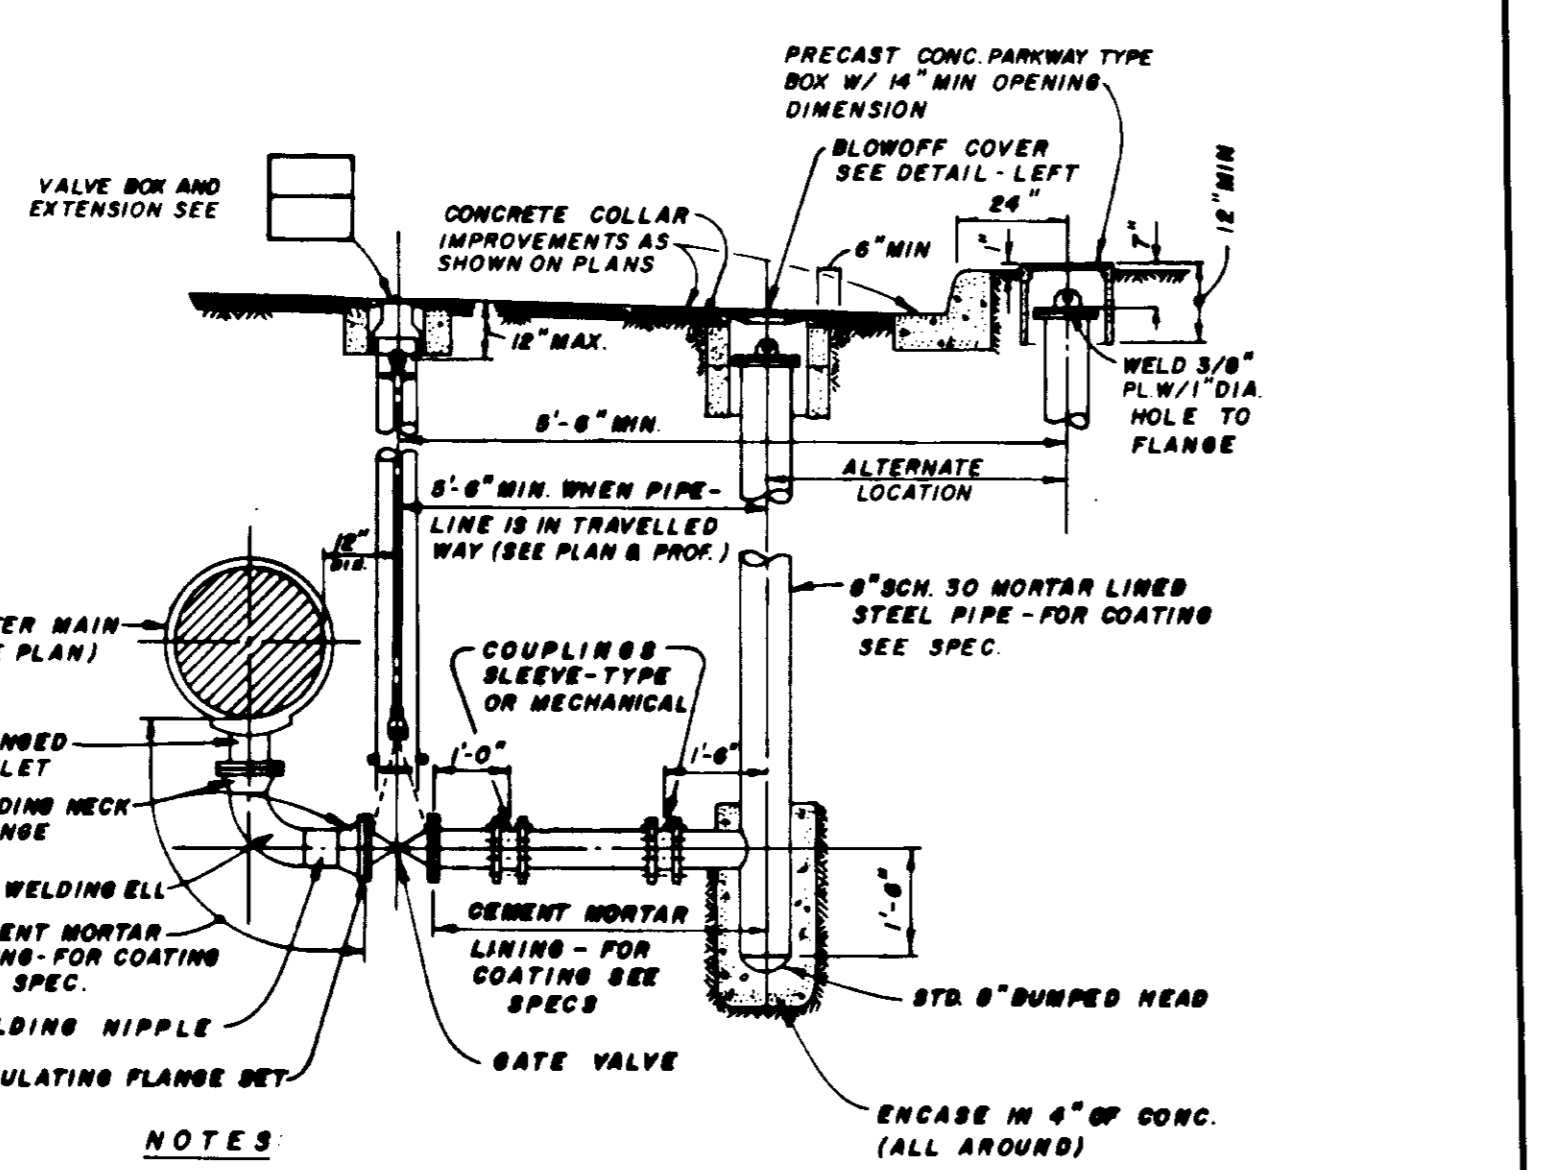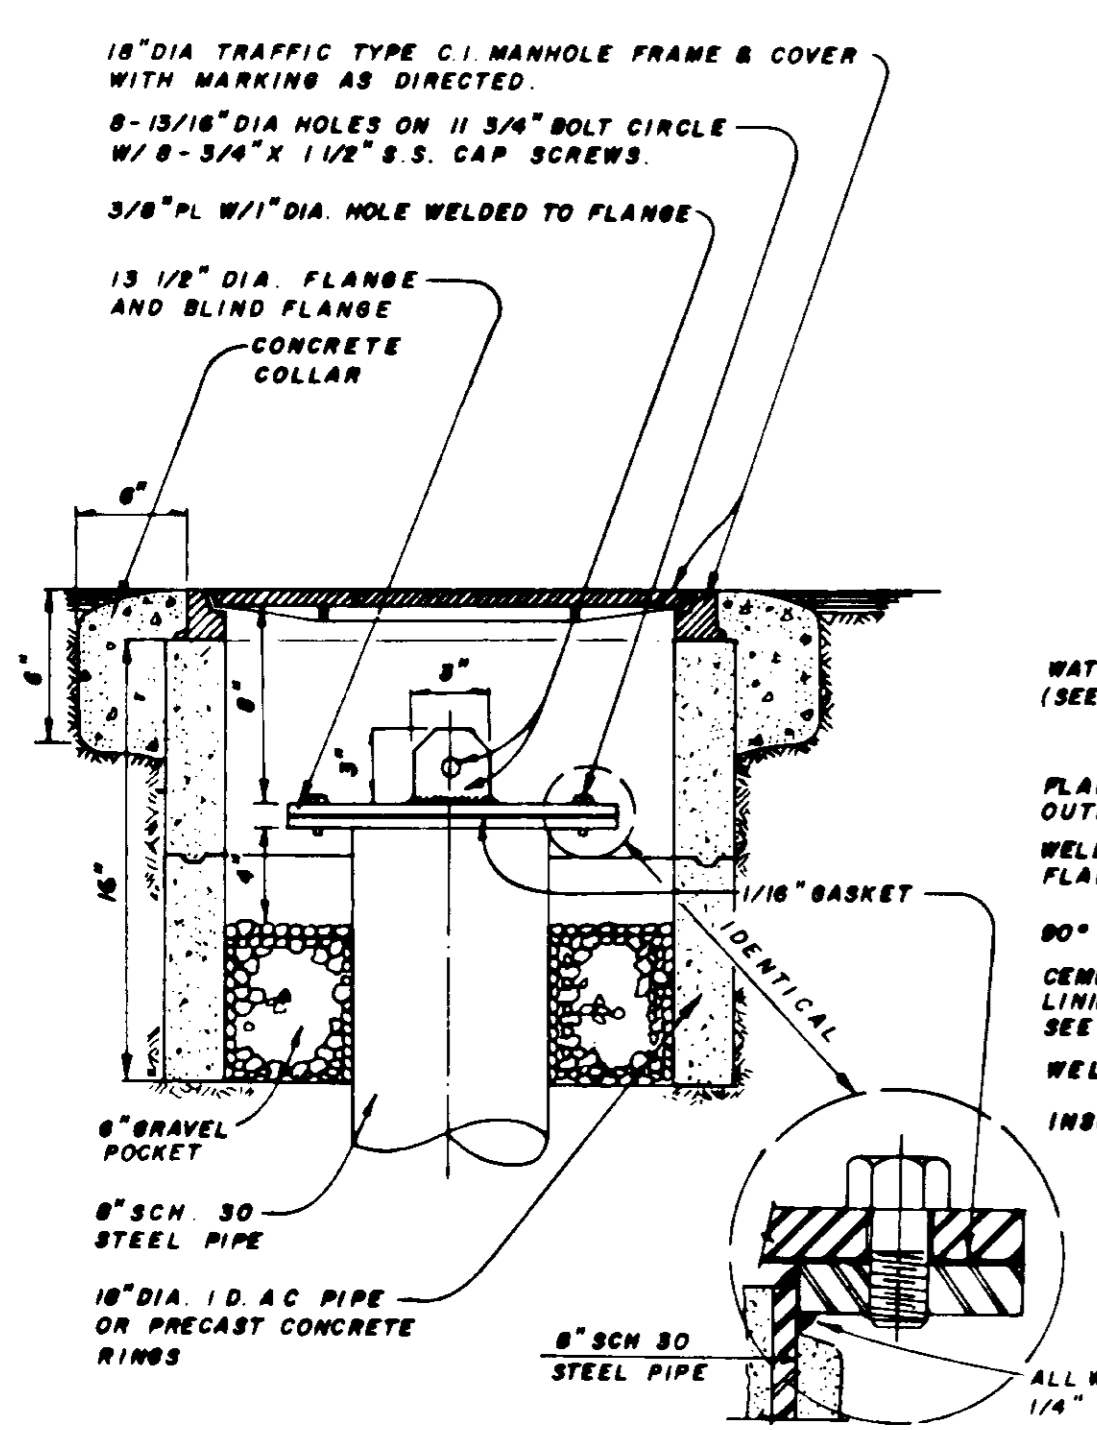


- NOTES**
- FLANGE AND BLIND FLANGE SAME CLASS AS PIPELINE.
 - CEMENT 1/16" THK FULL COVER BASKET TO FLANGE.
 - ALL EXPOSED FERROUS SURFACES OF BURIED PIPE & APPURTENANCES TO BE PROVIDED WITH PROTECTIVE COATINGS PER SPECIFICATIONS.
 - PROVIDE STAINLESS STEEL NUTS, BOLTS & WASHERS TO BURIED FLANGES & COUPLINGS EXCEPT FOR NON-METALLIC WASHERS AS PART OF INSULATING FLANGE SET.

BLOWOFF DETAILS E

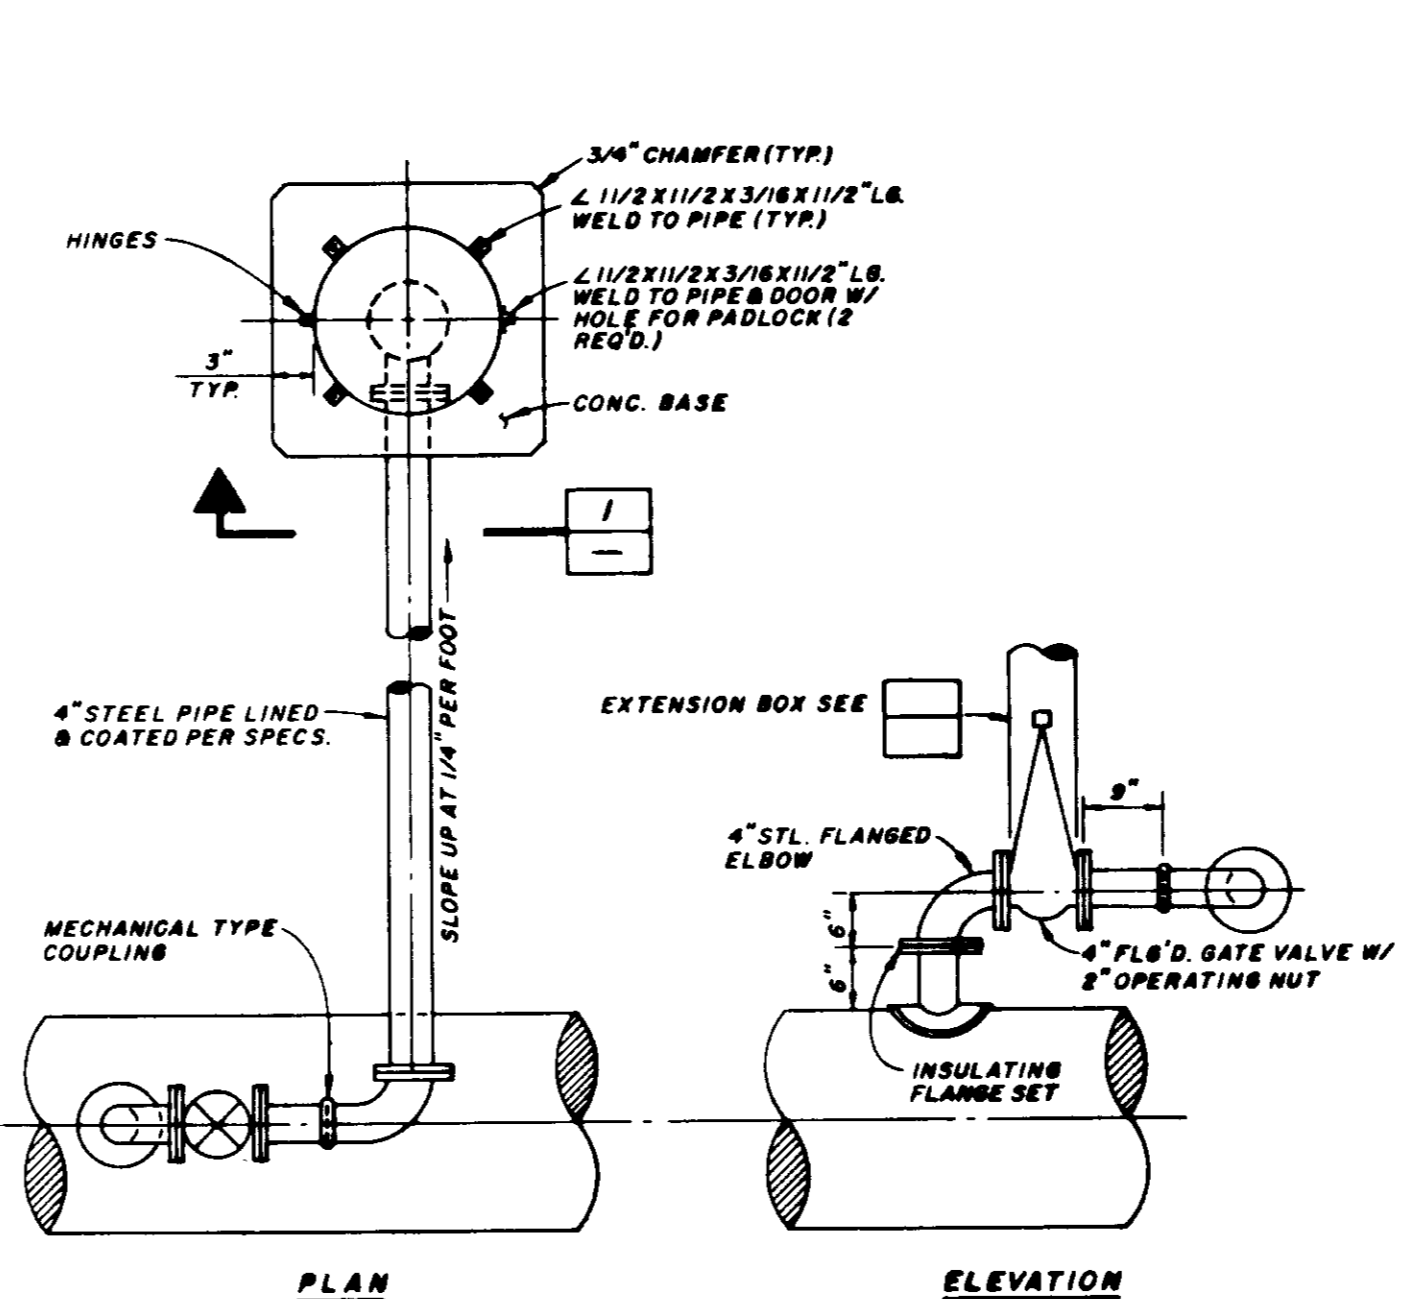

NOTE: THIS ASSEMBLY TO BE USED IN AREAS WHERE VAULT NOT REQ'D. OR WHERE MAIN PIPELINE IS TOO SHALLOW TO PERMIT USE OF VAULT.

AIR VACUUM AND AIR RELEASE VALVE ASSEMBLY F

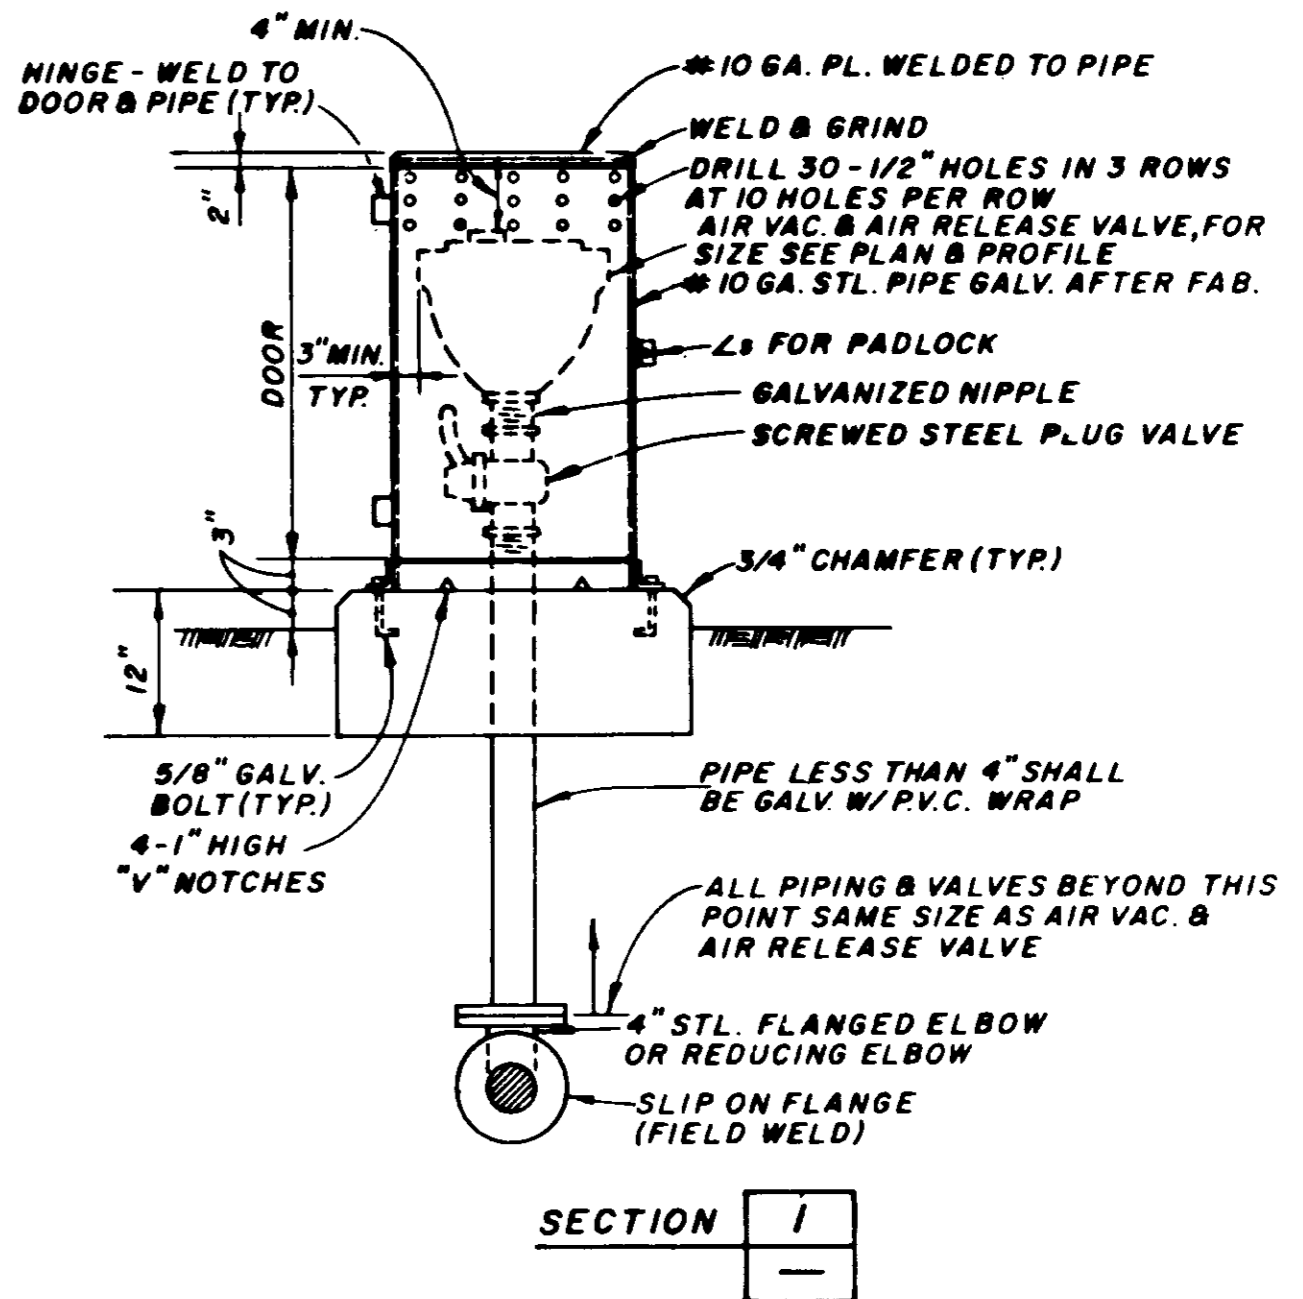

- NOTES**
- ALL FERROUS SURFACES OF PIPE AND APPURTENANCES TO BE PROVIDED WITH PROTECTIVE COATINGS PER SPEC.
 - PROVIDE STAINLESS STEEL NUTS, BOLTS & WASHERS TO BURIED FLANGES AND COUPLINGS, EXCEPT FOR NON-METALLIC WASHERS TO BE PROVIDED AS PART OF INSULATING FLANGE SET.

RECORD DRAWING

03558

REV	DATE	BY	DESCRIPTION

SCALE:	NO SCALE
DESIGNED:	J.M.M.
DRAWN:	J.M.M.
CHECKED:	S. Marco


SUBMITTED	27304	8/19/91
PROJECT ENGINEER	R.C.E. NO.	DATE
RECOMMENDED	27308	8/20/91
JAMES M. MONTGOMERY CONSULTING ENGINEERS, INC.	R.C.E. NO.	DATE

JAMES M. MONTGOMERY CONSULTING ENGINEERS, INC.
 555 EAST WALNUT STREET, PASADENA, CALIFORNIA 91101

DISTRICT APPROVAL ON TITLE PAGE

PHASE II	LAS VIRGENES MWD/TRIUNFO CSD TAPIA WRF - FILTRATION/DISINFECTION ADDITION MISCELLANEOUS YARD PIPING DETAILS - A
----------	---

SHEET
C-7
OF 56 SHEETS

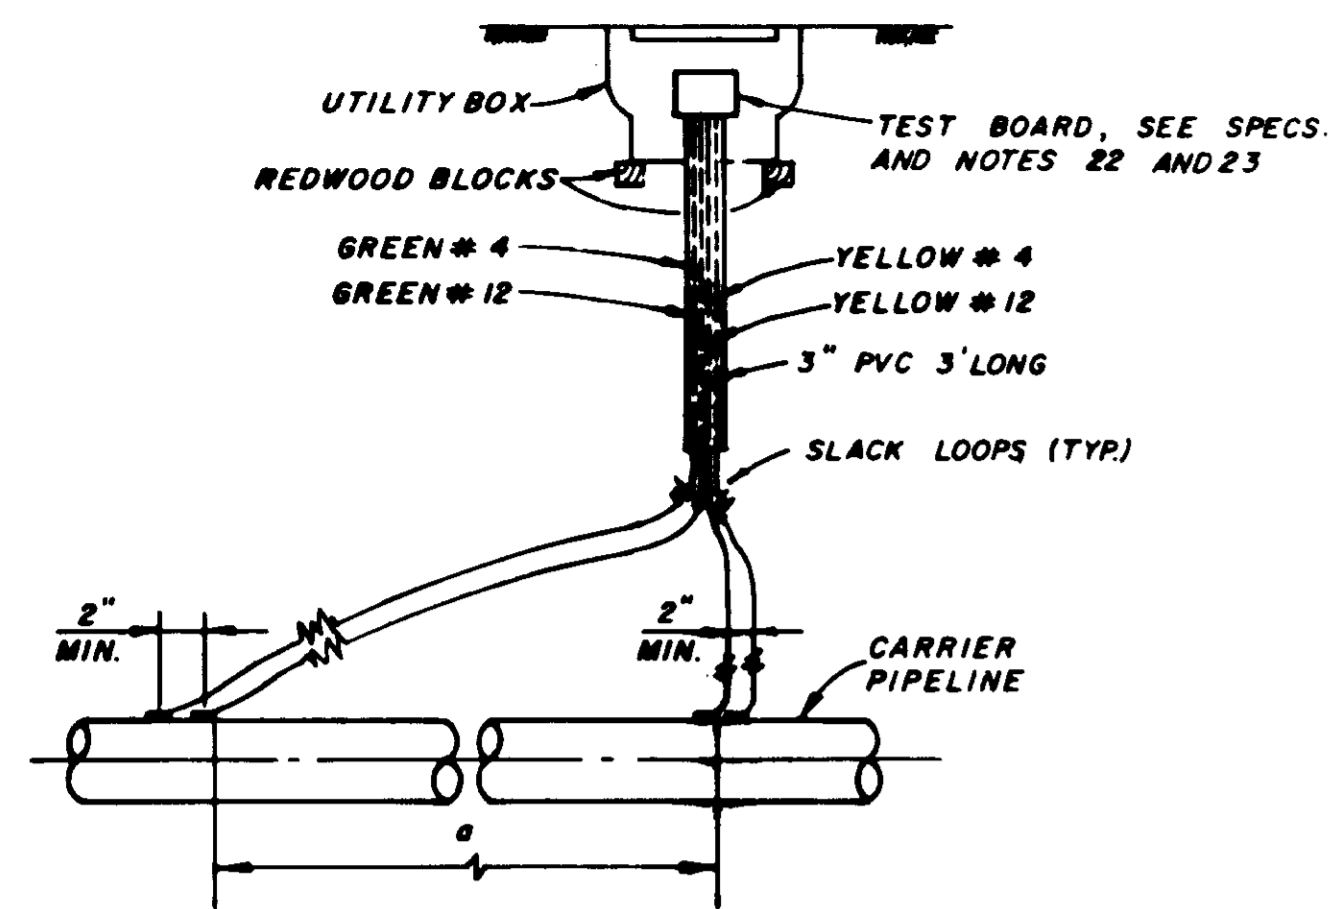


DISTANCE $a = 0$ FT. WHERE IRON OR STEEL CYLINDER WEIGHT ≤ 35 LBS./FT.
 DISTANCE $a = 20$ FT. WHERE IRON OR STEEL CYLINDER WEIGHT > 35 LBS./FT.
 RECORD ACTUAL DISTANCE "a" ON AS-BUILT DRAWINGS

NOTE:
 THIS DETAIL APPLIES TO ALL PIPE WITH BONDED JOINTS (TYPICAL WATER WORKS PIPELINE)

FOUR-WIRE ELECTROLYSIS TEST STATION FOR GENERAL POTENTIAL AND STRAY CURRENT MEASUREMENTS

A

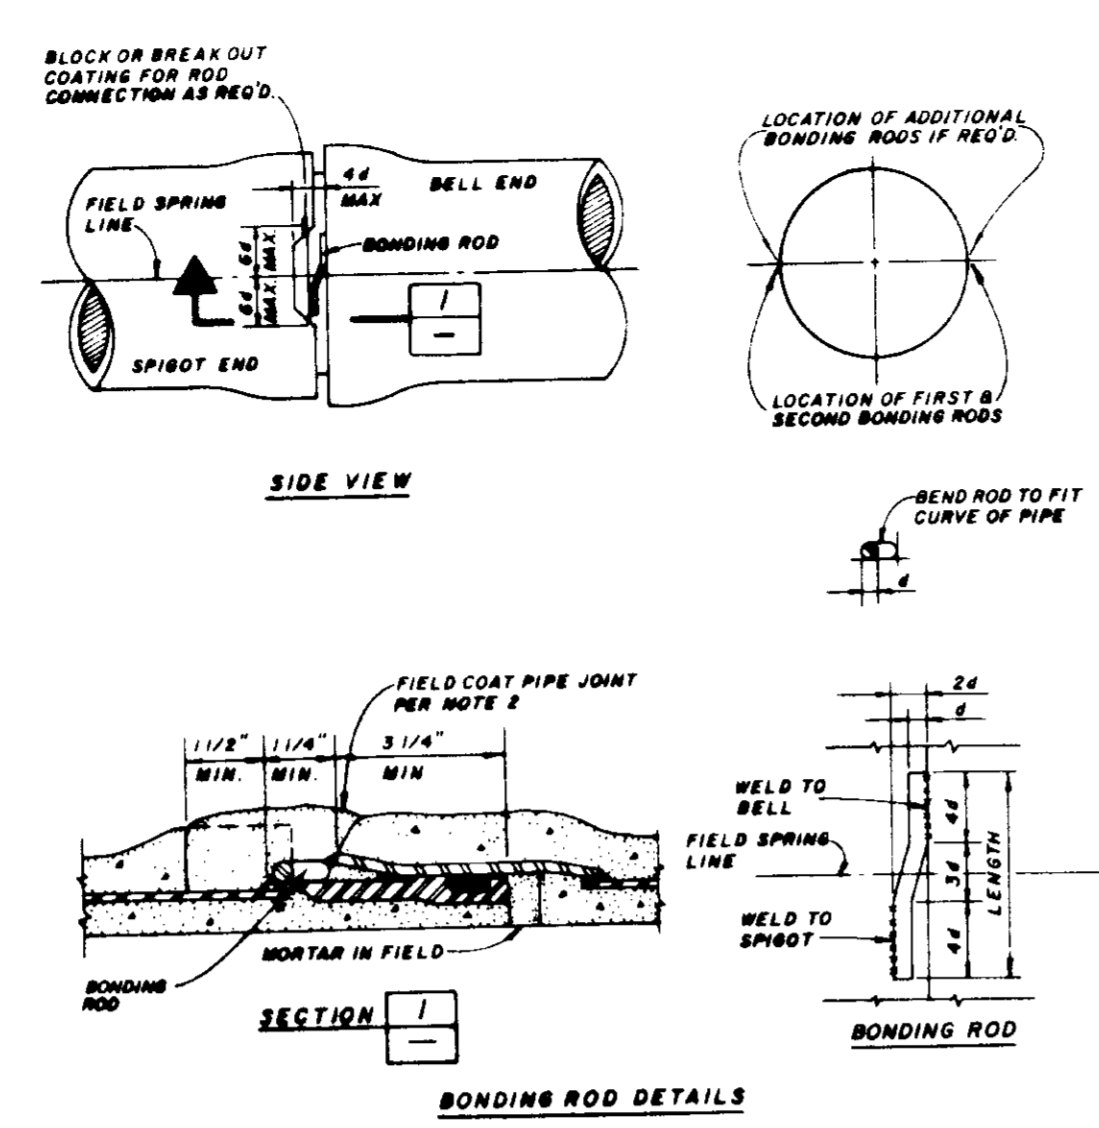


NOM PIPE DIA. (IN.) / PRESSURE	24" / 200				
CYLINDER WALL THICKNESS (IN.)					
BONDING ROD DIA. (#)	0.85				
BONDING ROD LENGTH (IN.)					
NO. OF RODS PER PIPE JOINT	1				

- NOTES:
- AT THE CONTRACTOR'S OPTION, JOINT BOND MAY BE OF THE RIGID OR FLEXIBLE TYPE, BUT NOT BOTH FOR A CONTINUOUS REACH OF PIPELINE.
 - FIELD COAT PIPE JOINTS WITH THE SAME MATERIAL AS THE PIPE COATING. COVER BONDING CABLES WITH A MINIMUM THICKNESS OF MATERIAL EQUAL TO THE SPECIFIED PIPE COATING THICKNESS.
 - FOR TESTING OF THE JOINT ELECTRICAL CONTINUITY SEE SPECIFICATION.
 - SEE STD. 986-C-346 FOR ADDITIONAL NOTES.

BURIED STEEL PIPE ELECTRICAL BONDING WITH BONDING RODS

D

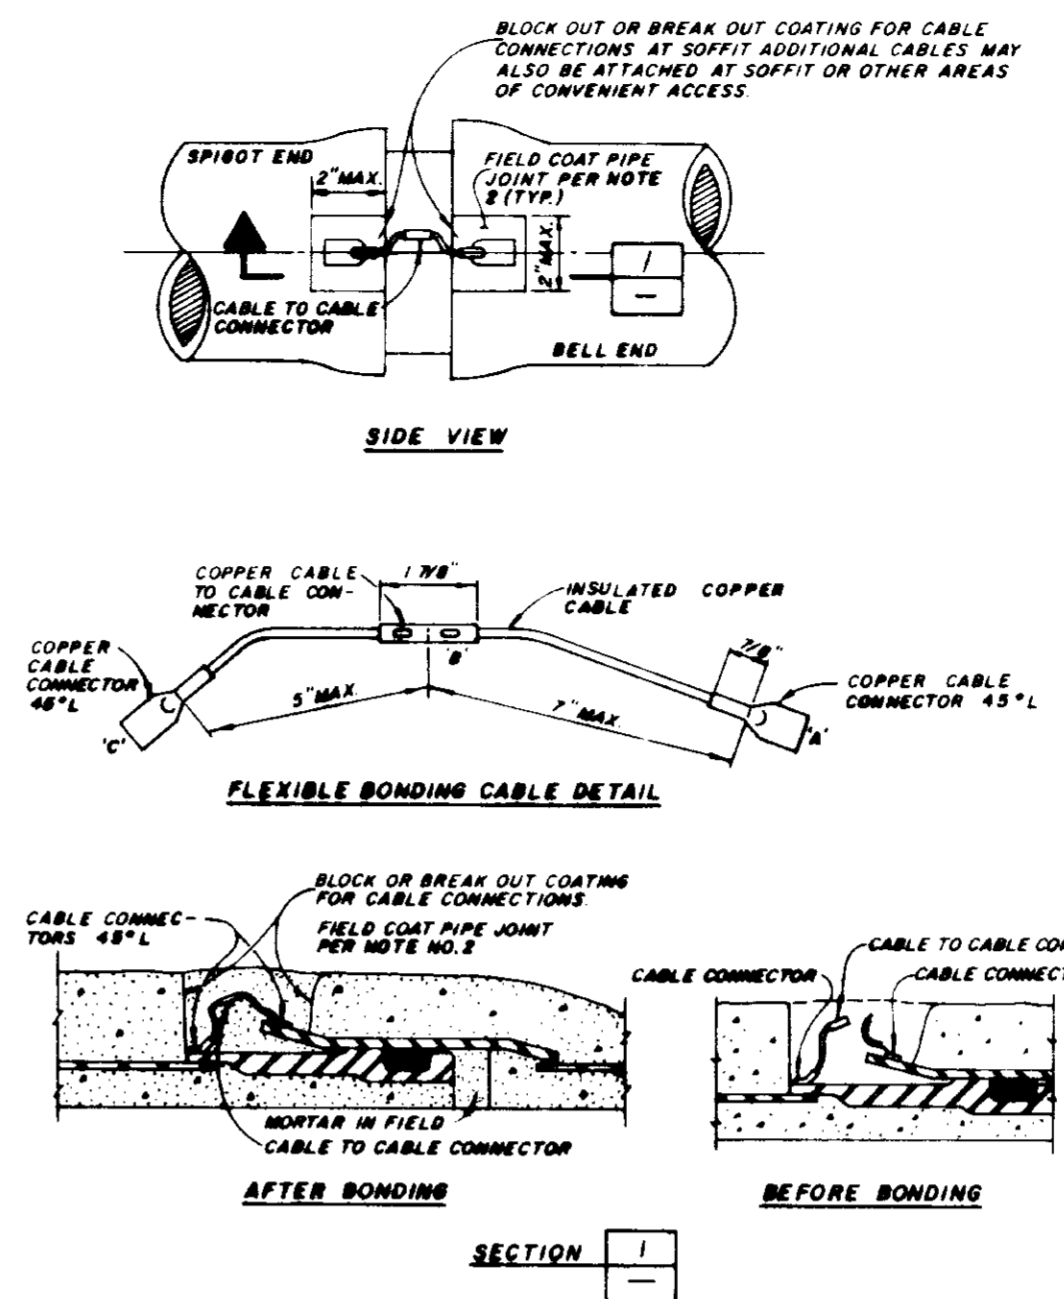


NOM PIPE DIA. (IN.) / PRESSURE	24" / 200				
CYLINDER WALL THICKNESS (IN.)					
FLEXIBLE BONDING CABLE SIZE (#)					
FLEXIBLE BONDING CABLE LOT (IN.)					
NO. OF CABLES PER PIPE JOINT	1				

- NOTES:
- AT THE CONTRACTOR'S OPTION, JOINT BOND MAY BE OF THE RIGID OR FLEXIBLE TYPE, BUT NOT BOTH FOR A CONTINUOUS REACH OF PIPELINE.
 - FIELD COAT PIPE JOINTS WITH THE SAME MATERIAL AS THE PIPE COATING. COVER BONDING CABLES WITH A MINIMUM THICKNESS OF MATERIAL EQUAL TO THE SPECIFIED PIPE COATING THICKNESS. SEE STD. 986-C-346 FOR ADDITIONAL NOTES.

- FIELD INSTALLATION PROCEDURE FOR FLEXIBLE BONDING CABLES**
- LINE 'A' BRAZED TO BELL END BY PIPE MANUFACTURER.
 - CABLE FROM 'A' TO 'B' BRAZED. BONDING BE COMPLETED BY PIPE MANUFACTURER TO BOTH 'A' + 'B'.
 - LINE 'C' BRAZED TO SPIGOT END BY PIPE MANUFACTURER.
 - CABLE FROM 'B' TO 'C' BRAZED. BONDING BE COMPLETED BY PIPE MANUFACTURER.
 - CONNECTION OF 'B' TO CABLE FROM 'C' TO BE BONDING OR COMPLETED BY FIELD.
 - AS AN ALTERNATIVE TO STEPS 1-5, CONTRACTOR MAY BREAK OUT COATING IN THE FIELD AND BRAZE OR THERMITE WELD CABLE TO BELL AND SPIGOT.
 - CABLE SHALL BE MULTISTRAND COPPER WELDING CABLE FOR MAXIMUM FLEXIBILITY.
 - 'A', 'B' AND 'C' TO BE INSULATED WITH RUBBER MASTIC ELECTRICAL INSULATING COMPOUND 1/8" THICK, GATES RUBBER OR APPROVED EQUAL.
 - AFTER COMPLETING THE FIELD JOINT AT 'B' IN THE FIELD, TOUCH UP ALL EXPOSED COPPER WITH ELECTRICAL INSULATING COMPOUND 1/8" MIN. GATES RUBBER OR APPROVED EQUAL.
 - FOLD CABLE ASSEMBLY INTO JOINT SPACE.

BURIED STEEL PIPE ELECTRICAL BONDING WITH FLEXIBLE BONDING CABLES

E

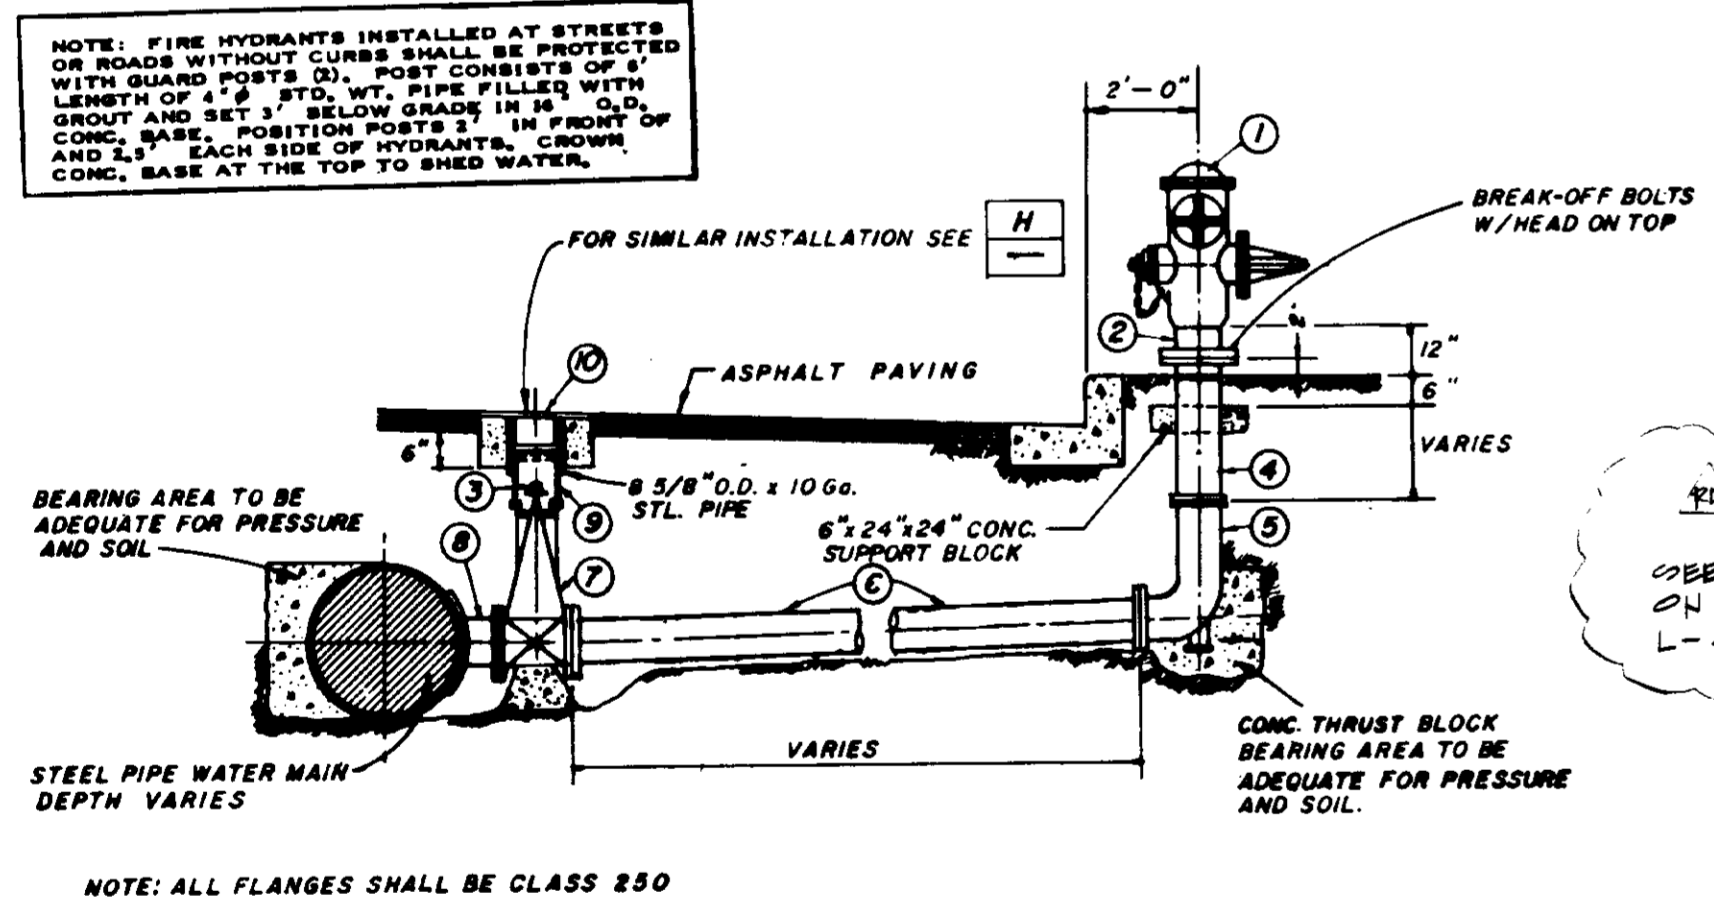

ITEM NO.	DESCRIPTION	REMARKS
1	6" SOLID BRONZE HEAD WITH 3/4" AND 1" OUTLET	JONES J-3781 OR APPROVED EQUAL W/COMPANION FLANGE (CLASS 250)
2	6" GALV. IRON PIPE	
3	OPERATING NUT EXTENSION STEM	MUELLER FIG. 1 EXTENSION STEM OR APPROVED EQUAL
4	HYDRANT SPOOL 6" - 18 GA. STEEL PIPE CMC AND CMC	LENGTH AS REQUIRED - CEM. LINED
5	HYDRANT BURY ELL - 6" X 36" CAST IRON	FLANGE BY FLANGE - CEMENT LINED
6	6 1/2" O.D. STEEL PIPE, 18 GA. W/SLIP-ON FLANGES	CM/CL PIPE - LENGTH 8' - 6" MIN.
7	6" GATE VALVE - FLANGE BY FLANGE	RICH SERIES 488 OR APPROVED EQUAL
8	6" FLANGED OUTLET	CEMENT LINED AND COATED
9	PIPE SLIP JOINT STEEL VALVE BOX ASS'Y	
10	6" CAST IRON VALVE BOX COVER	

TYPICAL FIRE HYDRANT LATERAL

B

CATHODIC PROTECTION, TESTING AND BONDING - GENERAL NOTES

- FOR LOCATION AND TYPE OF ELECTROLYSIS TEST STATION (ETS) OR SACRIFICIAL ANODE INSTALLATION. SEE PLANS.
- ALL TEST CONNECTIONS ON BURIED STEEL PIPE TO BE MADE AT EXPOSED FIELD JOINTS. WHERE TEST CONNECTIONS ARE SHOWN 2" APART, THE CONNECTIONS ARE TO BE MADE ON THE SAME SIDE OF THE JOINT. IF CONNECTIONS CANNOT BE MADE EASILY 2" APART LONGITUDINALLY, THEY MAY BE SEPARATED CIRCUMFERENTIALLY INSTEAD.
- ALL TEST CABLE CONNECTIONS ON STEEL PIPE TO BE MADE BY THERMITE WELDING OR BRAZING.
- ALL WELDED OR BRAZED CABLE CONNECTIONS TO BE INSULATED WITH FLEXIBLE DIELECTRIC MATERIAL EQUIVALENT TO BITUMINOUS PIPE COATING. NO WELDING WILL BE PERMITTED ON PRESTRESSED WIRES ON STEEL CYLINDER CONCRETE PIPE.
- IN VICINITY OF UTILITY BOX AND IN VICINITY OF PIPE, PROVIDE TWO FEET OF SLACK COIL IN EACH WIRE.
- ALL UTILITY BOXES FOR ETS ARE TO BE PLACED DIRECTLY ABOVE YELLOW TEST CABLES.
- ALL EXPOSED COPPER (TEST LEADS, BONDS, ETC.) SHALL BE FULLY INSULATED WITH A FLEXIBLE DIELECTRIC MATERIAL EQUIVALENT TO BITUMINOUS PIPE COATING. CEMENT MORTAR AND EPOXY ARE NOT ACCEPTABLE. REMAINDER OF COATING TO BE PLACED OVER THE BITUMINOUS PIPE COATING SHALL BE SAME AS ON ADJACENT PIPE SECTIONS.
- ALL CABLE DIMENSIONS ARE AWG (AMERICAN WIRE GAGE).
- THE OUTER WIRES SHALL BE NO. 4, THE INNER WIRES SHALL BE NO. 12. IF THE CARRIER PIPE DIAMETER IS LESS THAN 12", A NO. 8 WIRE SHALL BE SUBSTITUTED FOR THE NO. 4.
- ALL TEST LEADS AND BONDING CABLES SHALL BE COPPER AND SHALL BE INSULATED WITH 600-VOLT CLASS INSULATION WITH MOISTURE AND ROT RESISTANT CHARACTERISTICS EQUIVALENT TO PVC, PE OR NEOPRENE.
- ALL TEST LEADS AND BONDING CABLES ARE SINGLE CONDUCTOR (1/C), STRANDED WELDING CABLE FOR SIZES NO. 6 AND LARGER, STRANDED OR SOLID FOR SIZES NO. 8 AND SMALLER.
- TEST LEADS SHALL NOT BE SPLICED.
- CABLE COLOR CODING SCHEME:
 - YELLOW AND GREEN TEST CABLES ARE ON CARRIER LINE.
 - YELLOW IS USED TO DESIGNATE SOUTH OR WEST AND GREEN TO DESIGNATE NORTH OR EAST ON THE CARRIER PIPE.
 - RED DESIGNATES A FOREIGN LINE.

- THE BANANA JACK OR MALE TERMINAL SHALL BE THE SAME COLOR AS THE TEST CABLE (I.E., YELLOW, GREEN OR RED) TO WHICH IT IS CONNECTED.
- EACH TERMINAL IN TEST BOARD SHALL BE IDENTIFIED ON THE TERMINAL STRIP BY PERMANENT MARKING.
- A ZINC RIBBON SPIRAL OF 20' LINEAL LENGTH SHALL BE INSTALLED IN A CIRCULAR PATTERN AROUND ALL ETS LOCATED IN AREAS WHERE THE PIPELINE RUNS PARALLEL TO HIGH VOLTAGE AC TRANSMISSION LINES, AT THE DISCRETION OF THE ENGINEER.
- A MARKER POST SHALL BE ERECTED FOR EACH ETS LOCATED BELOW GROUND IN A UTILITY BOX IN AN UNIMPROVED AREA. LOCATION SHALL BE AS DIRECTED BY ENGINEER. MARKER POST SHALL BE A 4-IN. DIA. STEEL PIPE PROJECTING 4 FT ABOVE GRADE AND BURIED 2 FT IN GROUND WITH BURIED PORTION ENCASED IN CONCRETE. PIPE SHALL BE FILLED AND CAPPED WITH CONCRETE.
- ALL BURIED ETS SHALL BE ENCLOSED IN AN UTILITY BOX WHICH SHALL BE MIN. 8-IN. DIA. CAST IRON OR CONCRETE WITH CAST IRON COVER.
- ALL UTILITY BOXES SHALL BE LOCATED AT THE STATIONS SHOWN ON THE PLANS. THEY SHALL BE PLACED IN AREAS OF MINIMUM TRAFFIC HAZARD AS DIRECTED BY THE ENGINEER, SUCH AS IN PARKWAYS, SHOULDERS, OR BEHIND CURBS.
- IN SECURE AREAS SUCH AS IN VAULTS, BUILDINGS, OR FENCED YARDS, THE ETS MAY BE FLANGE MOUNTED, WALL MOUNTED, OR POLE MOUNTED AS DIRECTED BY THE ENGINEER.
- FEMALE BANANA PLUGS SHALL BE USED ON ALL TERMINAL TEST BOARDS WHERE AC OR DC VOLTAGES ARE AN ELECTROCUTION HAZARDS (e.g. FAULT CURRENTS OR INDUCED AC FROM PARALLELING AC TRANSMISSION LINES.)
- MALE TERMINALS SHALL BE USED ON ALL TERMINAL TEST BOARDS WHERE THERE IS NO ELECTROCUTION HAZARD.

BURIED STEEL PIPE ELECTRICAL BONDING WITH FLEXIBLE BONDING CABLES

C

RECORD DRAWING 03559

RD #1184100	RECORD DRAWINGS
SCALE:	NO SCALE
DESIGNED	J.M.M.
DRAWN	J.M.M.
CHECKED	S. Marc...
REV	DATE
BY	DESCRIPTION


SUBMITTED	27304	8/19/81
PROJECT ENGINEER	R.C.E. NO.	DATE
RECOMMENDED	27639	8/30/81
DATE	R.C.E. NO.	DATE

JAMES M. MONTGOMERY CONSULTING ENGINEERS, INC.

555 EAST WALNUT STREET, PASADENA, CALIFORNIA 91101

DISTRICT APPROVAL ON TITLE PAGE

LAS VIRGENES MWD/TRIUNFO CSD	SHEET
TAPIA WRF - FILTRATION/DISINFECTION ADDITION	C-8
PHASE 11	MISCELLANEOUS YARD PIPING DETAILS - B
	OF 86 SHEETS

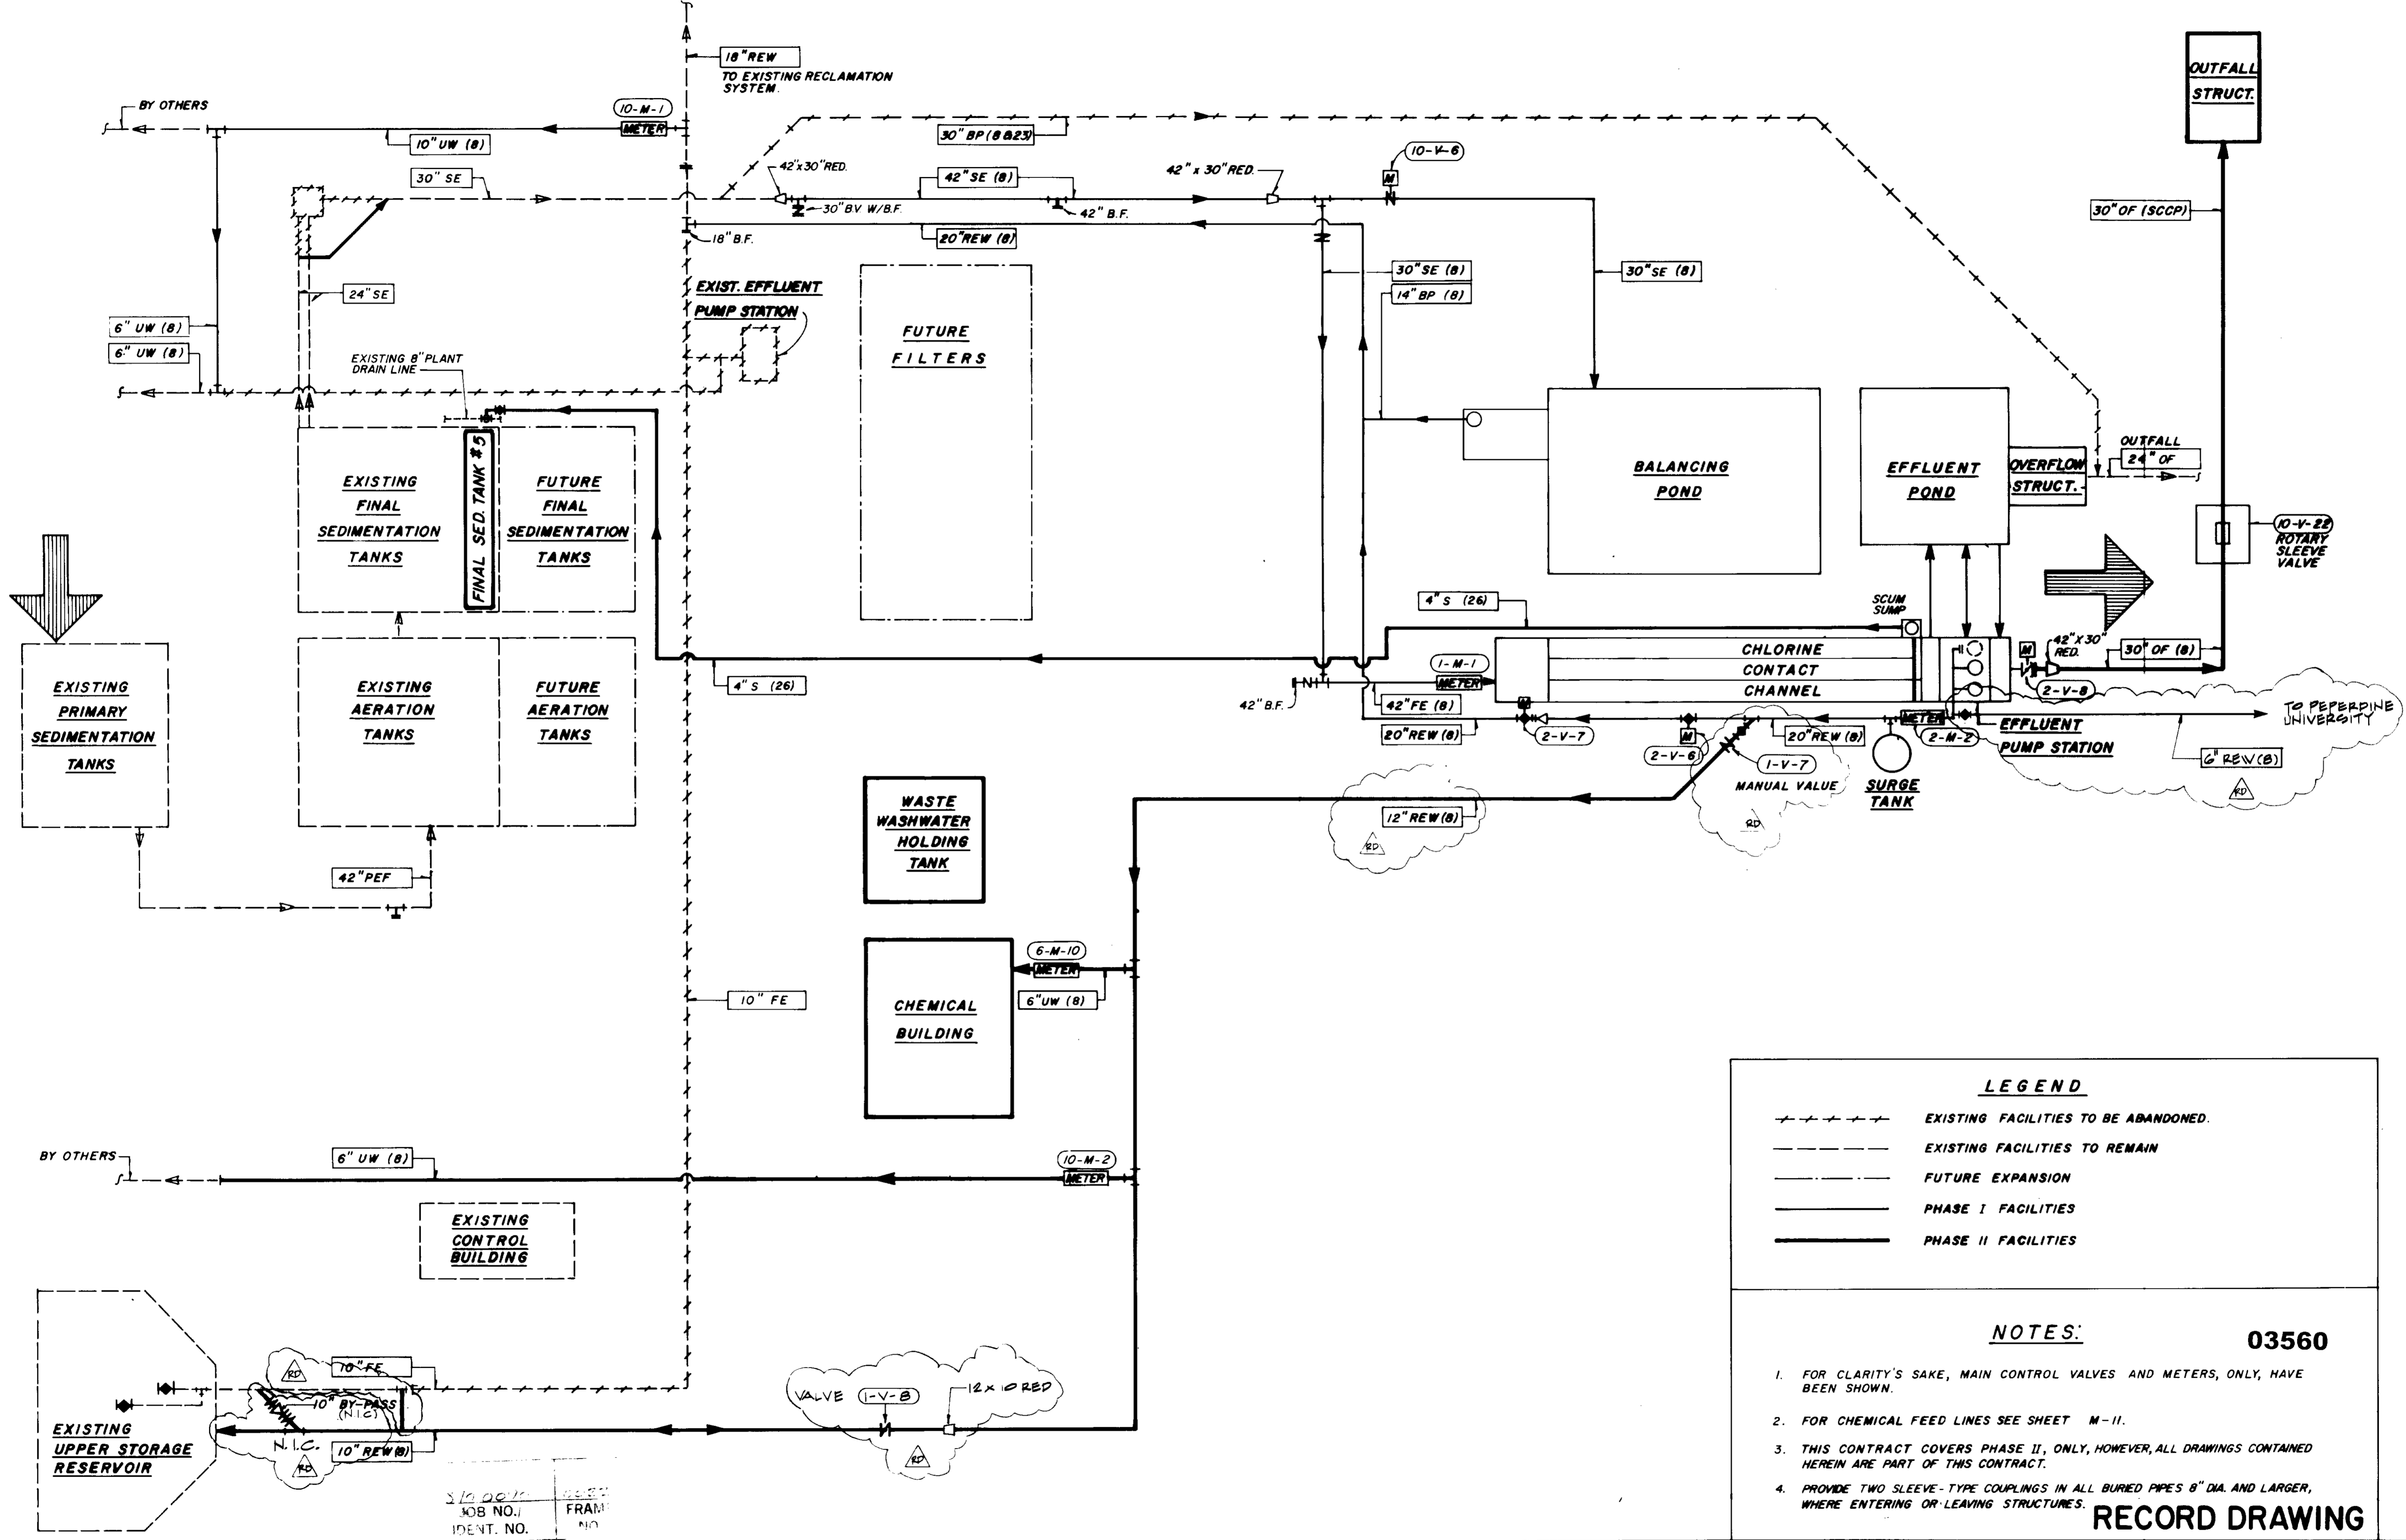

LEGEND

--- EXISTING FACILITIES TO BE ABANDONED.

- · - · - EXISTING FACILITIES TO REMAIN

····· FUTURE EXPANSION

———— PHASE I FACILITIES

———— PHASE II FACILITIES

NOTES: 03560

- FOR CLARITY'S SAKE, MAIN CONTROL VALVES AND METERS, ONLY, HAVE BEEN SHOWN.
- FOR CHEMICAL FEED LINES SEE SHEET M-11.
- THIS CONTRACT COVERS PHASE II, ONLY, HOWEVER, ALL DRAWINGS CONTAINED HEREIN ARE PART OF THIS CONTRACT.
- PROVIDE TWO SLEEVE-TYPE COUPLINGS IN ALL BURIED PIPES 8" DIA. AND LARGER, WHERE ENTERING OR LEAVING STRUCTURES.

RECORD DRAWING

RD/41104/HDP/	RECORD DRAWINGS		
2/26/81/JMH			
REV	DATE	BY	DESCRIPTION

SCALE: NONE

DESIGNED: J. Mont
DRAWN: R. Sauer
CHECKED: J. Mont

SUBMITTED: 27304 3/19/81
 DESIGNED: J. Mont
 DRAWN: R. Sauer
 CHECKED: J. Mont

JOB NO.: 17633
 IDENT. NO.: 3/22/81

JAMES M. MONTGOMERY CONSULTING ENGINEERS, INC.

355 EAST WALNUT STREET, PASADENA, CALIFORNIA 91101

DISTRICT APPROVAL ON TITLE PAGE

LAB VIRGENES MWD/TRIUNFO CBD
 TAPIA WRF - FILTRATION/DISINFECTION ADDITION

PHASE II PROCESS FLOW DIAGRAM

SHEET M-1
 OF 66 SHEETS

PUMP SCHEDULE						
PUMP NO.	LOCATION	SERVICE	FLOW GPM	TDH FT	HP MIN	TYPE AND REMARKS
1-P-3	CHLORINE CONTACT CHANNEL	FILTER BACKWASH	3,000	20		VERTICAL MIXED FLOW OR TURBINE W/ SUCTION STRAINER
1-P-4	CHLORINE CONTACT CHANNEL	FILTER BACKWASH	3,000	20		VERTICAL MIXED FLOW OR TURBINE W/ SUCTION STRAINER
1-P-5	CHLORINE CONTACT CHANNEL	FILTER BACKWASH	3,000	20		VERTICAL MIXED FLOW OR TURBINE W/ SUCTION STRAINER
4-P-1	FILTER INFLUENT	FLASH MIXING	500	21	5	VERTICAL TURBINE
4-P-2	FILTER INFLUENT	CHANNEL AGITATION	1890	33	20	VERTICAL TURBINE
4-P-3	FILTER PIPE GALLERY	DRAINAGE	100	22	1	SUMP PUMP, SUBMERSIBLE
4-P-4	FILTER PIPE GALLERY	DRAINAGE	100	22	1	SUMP PUMP, SUBMERSIBLE
5-P-1	BALANCING POND	FILTER INFLUENT	6,100	32		VERTICAL MIXED FLOW W/ SUCTION STRAINER
5-P-2	BALANCING POND	FILTER INFLUENT	6,100	32		VERTICAL MIXED FLOW W/ SUCTION STRAINER
6-P-1	NOT USED					
6-P-2	NOT USED					
6-P-3	CHEMICAL BLDG.	CATIONIC POLYMER	10	20	-	DRUM PUMP
6-P-4	CHEMICAL BLDG.	AN-IONIC POLYMER	10	20	-	DRUM PUMP
6-P-5	CHEMICAL BLDG.	AN-IONIC POLYMER	35	115	2	TRANSFER PUMP
7-P-1	S OF FILTERS	WASTE WASHWATER	500	37	7.5	VERTICAL TURBINE W/ SUCTION STRAINER
7-P-2	S OF FILTERS	WASTE WASHWATER	500	37	7.5	VERTICAL TURBINE W/ SUCTION STRAINER
7-P-3	S OF FILTERS	WASTE WASHWATER	500	37	7.5	VERTICAL TURBINE W/ SUCTION STRAINER
1-P-6	CHLORINE CONTACT CHANNEL	SCUM	100	20	1	SUBMERSIBLE SUMP PUMP
5-P-3	BALANCING POND	SECONDARY EFFLUENT BY-PASS	1500/5000	8-15	25	VERTICAL TURBINE

CHLORINATOR AND CHEMICAL FEEDER SCHEDULE						
FEEDER NO.	LOCATION	SERVICE	TYPE	HP AND ELECTRICAL SUPPLY	CAPACITY	REMARKS
6-FD-1	CHEMICAL BLDG. AND STORAGE	CHLORINE	V-NOTCH	75 WATTS	2,000 LBS/DAY	ULTIMATELY 4,000 LBS/DAY
6-FD-2	CHEMICAL BLDG. AND STORAGE	CHLORINE	V-NOTCH	75 WATTS	2,000 LBS/DAY	ULTIMATELY 4,000 LBS/DAY
6-FD-3	CHEMICAL BLDG. AND STORAGE	CHLORINE	V-NOTCH	75 WATTS	2,000 LBS/DAY	ULTIMATELY 4,000 LBS/DAY
6-FD-4	CHEMICAL BLDG. AND STORAGE	SULFUR DIOXIDE	V-NOTCH	30 WATTS	2,000 LBS/DAY	ULTIMATELY 1,425 LBS/DAY
6-FD-5	CHEMICAL BLDG. AND STORAGE	SULFUR DIOXIDE	V-NOTCH	30 WATTS	940 LBS/DAY	ULTIMATELY 1,425 LBS/DAY
6-FD-6	CHEMICAL BLDG. AND STORAGE	LIQUID ALUM	HYD. DIAPH. PUMP	1/2 HP	26 GPH AT 50 PSI	
6-FD-7	CHEMICAL BLDG. AND STORAGE	LIQUID ALUM	HYD. DIAPH. PUMP	1/2 HP	26 GPH AT 50 PSI	
6-FD-8	CHEMICAL BLDG. AND STORAGE	CATIONIC POLYMER	HYD. DIAPH. PUMP	1/2 HP	13 GPH AT 50 PSI	
6-FD-9	CHEMICAL BLDG. AND STORAGE	CATIONIC POLYMER	HYD. DIAPH. PUMP	1/2 HP	13 GPH AT 50 PSI	
6-FD-10	CHEMICAL BLDG. AND STORAGE	NON-IONIC POLYMER	HYD. DIAPH. PUMP	1/2 HP	50 GPH AT 50 PSI	
6-FD-11	CHEMICAL BLDG. AND STORAGE	NON-IONIC POLYMER	HYD. DIAPH. PUMP	1/2 HP	50 GPH AT 50 PSI	
6-FD-12	CHEMICAL BLDG. AND STORAGE	NON-IONIC POLYMER	HELIX FEEDER	1/4 HP	27 LBS/DAY	

TANK SCHEDULE						
TANK NO.	LOCATION	SERVICE	CAPACITY GAL.	SIZE INCHES DIA X SHELL	MATERIAL	REMARKS
6-T-1	CHEMICAL BLDG.	CHLORINE STORAGE	3,500	78 X 168	STEEL	300 PSI WORK'G
6-T-2	CHEMICAL BLDG.	CHLORINE STORAGE	3,500	78 X 168	STEEL	300 PSI WORK'G
6-T-3	CHEMICAL BLDG.	SULFUR DIOXIDE STORAGE	1,350	60 X 108	STEEL	300 PSI WORK'G
6-T-4	CHEMICAL BLDG.	SULFUR DIOXIDE STORAGE	1,350	60 X 108	STEEL	300 PSI WORK'G
6-T-5	CHEMICAL BLDG.	CATIONIC POLYMER	350	48 X 48	FIBERGLASS	W/SPLIT COVER AND MIXER PAD
6-T-6	CHEMICAL BLDG.	ANIONIC POLYMER AGING	350	48 X 48	FIBERGLASS	OPEN TOP W/MIXER PAD
6-T-7	CHEMICAL BLDG.	ANIONIC POLYMER FEED	350	48 X 48	FIBERGLASS	OPEN TOP
6-T-8	CHEMICAL BLDG.	COMPR. AIR	80	27 X 86	STEEL	150 PSI WORK'G W/ COMPRESSOR 6-ME-13
7-T-1	WWW HOLDING TANK	ALUM STORAGE	7,500	96 X 240	STEEL, PVC-LINED	W/VENT AND AIR DIFFUSER
4-T-1	FILTER PIPE GALLERY	COMPRESSED AIR	30	18 X 40	STEEL	VERTICAL, 150 PSI

NOT INCLUDED IN CONTRACT

03562
RECORD DRAWING

REV	DATE	BY	DESCRIPTION
3	3/30/89	JCS	REVISED CAPACITY-SULFUR DIOXIDE FEEDER 6-FD-4

SCALE:	NONE
DESIGNED	G M
DRAWN	G M
CHECKED	JCS
SUBMITTED	2/23/84
PROJECT ENGINEER	R.C.E. NO. DATE
RECOMMENDED	12/4/86
JAMES M. MONTGOMERY CONSULTING ENGINEERS, INC.	R.C.E. NO. DATE

JAMES M. MONTGOMERY CONSULTING ENGINEERS, INC.
355 EAST WALNUT STREET, PASADENA, CALIFORNIA 91101

DISTRICT APPROVAL ON TITLE PAGE

LAS VIRGENES MWD/TRIUNFO CSD	
TAPIA WRF - FILTRATION/DISINFECTION ADDITION	
PHASE II	PUMP, FEEDER, AND TANK SCHEDULES

SHEET
M-3
OF 66 SHEETS

VALVE SCHEDULE (FOR VALVES 8-INCHES AND LARGER)

VALVE NO.	LOCATION	SERVICE	TYPE OF VALVE	SIZE IN.	CLASS PSI	OPERATOR	REMARKS
1-V-1	BACKWASH PUMP STATION	FILTER BACKWASH	SILENT CHECK	14	125	IN-LINE SPRING	1-P-3 DISCHARGE
1-V-2	BACKWASH PUMP STATION	FILTER BACKWASH	SILENT CHECK	14	125	IN-LINE SPRING	1-P-4 DISCHARGE
1-V-3	BACKWASH PUMP STATION	FILTER BACKWASH	SILENT CHECK	14	125	IN-LINE SPRING	1-P-5 DISCHARGE
1-V-4	BACKWASH PUMP STATION	FILTER BACKWASH	BUTTER-FLY	14	150	MANUAL GEAR	1-P-3 DISCHARGE
1-V-5	BACKWASH PUMP STATION	FILTER BACKWASH	BUTTER-FLY	14	150	MANUAL GEAR	1-P-4 DISCHARGE
1-V-6	BACKWASH PUMP STATION	FILTER BACKWASH	BUTTER-FLY	14	150	MANUAL GEAR	1-P-5 DISCHARGE
1-V-7	5' OF CHLORINE CONTACT TANK	FINAL EFFLUENT	LUBE PLUG	1	300	MANUAL W. EXTENSION BONNET	LINE TO RESERVOIR. BURIED
1-V-8	SOUTH OF CONTROL BLDG	FINAL EFFLUENT	BUTTER-FLY	1	300	MANUAL W. EXTENSION BONNET	LINE TO RESERVOIR. BURIED
4-V-1	FILTER INFLUENT	FILTER INFLUENT	BUTTER-FLY	42	25	REPLACE MAN. OPER. W/ELECT. (EXTENDED TO ABOVE GROUND) C-2	MOVE EXISTING BURIED VALVE NO 10-V-5 C-2
4-V-2	FILTER PIPE GALLERY	BACKWASH	LUBE PLUG V	24	150	ELECTRIC	W/MECH. STOPS
4-V-3	FILTERS	CHANNEL AGITATION	BUTTER-FLY	10	150	MANUAL	4-P-2 DISCHARGE
4-V-101	FILTER NO. 1	INFLUENT	BUTTER-FLY	18	150	ELECTR. W/EXTN. BONNET	-
4-V-102	FILTER NO. 1	EFFLUENT	BUTTER-FLY	14	150	ELECTRIC	-
4-V-103	FILTER NO. 1	BACKWASH	BUTTER-FLY	24	25	ELECTRIC	-
4-V-104	FILTER NO. 1	AIR SCOUR	BUTTER-FLY	8	150	ELECTRIC	-
4-V-105	FILTER NO. 1	WWW DRAIN	BUTTER-FLY	18	150	ELECTR. W/EXTN. BURIED BONNET	-
4-V-201 THRU 4-V-205	FILTER NO. 2	-	BUTTER-FLY	-	-	ELECTRIC	SAME AS FILTER NO. 1
4-V-301 THRU 4-V-305	FILTER NO. 3	-	BUTTER-FLY	-	-	ELECTRIC	SAME AS FILTER NO. 1
4-V-401 THRU 4-V-405	FILTER NO. 4	-	BUTTER-FLY	-	-	ELECTRIC	SAME AS FILTER NO. 1
4-V-501 THRU 4-V-505	FILTER NO. 5	-	BUTTER-FLY	-	-	ELECTRIC	SAME AS FILTER NO. 1
4-V-601 THRU 4-V-605	FILTER NO. 6	-	BUTTER-FLY	-	-	ELECTRIC	SAME AS FILTER NO. 1
4-V-701 THRU 4-V-705	FILTER NO. 7	-	BUTTER-FLY	-	-	ELECTRIC	SAME AS FILTER NO. 1
4-V-801 THRU 4-V-801	FILTER NO. 8	-	BUTTER-FLY	-	-	ELECTRIC	SAME AS FILTER NO. 1
5-V-1	FILTER INFL. PUMP STATION	FILTER INFLUENT	SILENT CHECK	18	125	IN-LINE SPRING	5-P-1 DISCHARGE
5-V-2	FILTER INFL. PUMP STATION	FILTER INFLUENT	SILENT CHECK	18	125	IN-LINE SPRING	5-P-2 DISCHARGE
5-V-3	FILTER INFL. PUMP STATION	FILTER INFLUENT	BUTTER-FLY	18	150	MANUAL	5-P-1 DISCHARGE
5-V-4	FILTER INFL. PUMP STATION	FILTER INFLUENT	BUTTER-FLY	18	150	MANUAL	5-P-2 DISCHARGE
5-V-5	FILTER INFL. PUMP STATION	FILTER INFLUENT	LUBE PLUG V	24	150	ELECTRIC	THROTTLING
7-V-1	WWW TANK	BACKWASH RECOVERY	SWING CHECK	8	125	LEVER AND SPR'G	-
7-V-2	WWW TANK	BACKWASH RECOVERY	BUTTER-FLY	8	150	MANUAL	-
7-V-3	WWW TANK	BACKWASH RECOVERY	BUTTER-FLY	8	150	MANUAL	-
7-V-4	WWW TANK	BACKWASH RECOVERY	BUTTER-FLY	8	150	MANUAL	-
7-V-5	WWW TANK	BACKWASH RECOVERY	BUTTER-FLY	8	150	MANUAL	-
7-V-6	WWW TANK	BACKWASH RECOVERY	BUTTER-FLY	8	150	MANUAL	-
9-V-1	PIPE GALLERY NO. 3	AIR SCOUR	BUTTER-FLY	10	150	MANUAL, CHAIN DRIVE	-
10-V-6	N OF EXIST. POND	SECONDARY EFFLUENT	BUTTER-FLY	30	25	REPLACE MAN. OPER. W ELECT (EXTN. BONNET)	-
10-V-14	EXISTING RESERVOIR	OUTLET	LUBE PLUG	10	200	MANUAL OPER. W EXTN. STEM	SUBMERGED SERVICE
10-V-15	EXISTING RESERVOIR	OUTLET	LUBE PLUG	10	200	MANUAL OPER. W EXTN. STEM	SUBMERGED SERVICE
10-V-16	EXISTING RESERVOIR	OUTLET	BUTTER-FLY	10	150	SQUARE NUT	BURIED
10-V-17	EXISTING RESERVOIR	OUTLET	SILENT CHECK	10	125	IN-LINE SPRING	IN BOX
10-V-18	EXISTING RESERVOIR	OUTLET	BUTTER-FLY	10	150	SQUARE NUT	BURIED
10-V-19	(NOT USED)						
10-V-20	S' OF AERATION TANKS	WWW	BUTTER-FLY	12	150	SQUARE NUT	BURIED
10-V-21	AT BARMINUTOR	WWW	BUTTER-FLY	12	150	HANDWHEEL	-

GATE SCHEDULE

GATE NO.	LOCATION	SERVICE	SIZE IN.	SEATING HEAD FT.	UN-SEATING HEAD FT.	OPERATOR	REMARKS
4-G-1	DIVERSION BOX	FILTER INFLUENT	42 DIA.	6	6	HAND CRANK AND FL. STAND	FLUSH BOTTOM
4-G-2	EFFLUENT BOX	FILTER EFFLUENT	24 X 24	20	7	HAND CRANK AND FL. STAND	FLUSH BOTTOM
4-G-3	DIVERSION BOX	ADJUSTABLE WEIR	132 X 48	2	-	MANUAL-W/FLOOR STAND	FABRICATED ALUMINUM OR FIBER-GLASS
4-G-4	DIVERSION BOX	ADJUSTABLE WEIR	132 X 48	2	-	MANUAL-W/FLOOR STAND	FABRICATED ALUMINUM OR FIBER-GLASS
4-G-5	DIVERSION BOX	ADJUSTABLE WEIR	84 X 48	2	-	MANUAL-W/FLOOR STAND	FABRICATED ALUMINUM OR FIBER-GLASS
8-G-1	FINAL SED. TANK	INLET	24 DIA.	4	4	NEW HANDWHEEL W/FLOOR STAND	GATE EXISTING
8-G-2	FINAL SED. TANK	SCUM	12 X 12	1	1	HANDWHEEL AND STAND	DOWNWARD OPENING
8-G-3	FINAL SED. TANK	RAS	30 X 30	2	2	HANDWHEEL	ALUMINUM V-NOTCH GATE AND BOX, SELF-CONTAINED
8-G-4	FINAL SED. TANK	RAS	30 X 30	2	2	HANDWHEEL	ALUMINUM V-NOTCH GATE AND BOX, SELF-CONTAINED

VALVE SCHEDULE CONCLUDED

VALVE NO.	LOCATION	SERVICE	TYPE OF VALVE	SIZE IN.	CLASS PSI	OPERATOR	REMARKS
10-V-22	E' OF EFFLUENT PUMP STATION	EFFLUENT THROTTLING	ROTARY SLEEVE	30	-	FLOAT	FABRICATED STEEL VALVE

FAN SCHEDULE

FAN NO.	LOCATION	SERVICE	TYPE OF FAN	CFM	SP INCHES	HP	REMARKS
4-F-1	FILTER PIPE GALLERY	VENTILATION	PROPELLER	827	1/4	1/12	W/WEATHER LOUVER, SCREEN AND SAFTY GUARD
6-F-1	CHLORINATOR ROOM	EXHAUST	PROPELLER	1635	1/2	1/3	W/BACKDRAFT DAMPER AND SAFTY GUARD
6-F-2	SULFONATOR ROOM	EXHAUST	PROPELLER	1635	1/2	1/3	W/BACKDRAFT DAMPER AND SAFTY GUARD
6-F-3	ELECTRICAL ROOM	COOLING	ROOF EXHAUSTER	796	3.8	1/4	W/BACKDRAFT DAMPER, CURB, AND REGISTER
6-F-4	CHEM. FEEDER ROOM	EXHAUST	ROOF EXHAUSTER	1861	1/2	1/2	W/BACKDRAFT DAMPER, CURB, AND REGISTER

NOT INCLUDED IN CONTRACT

03563
RECORD DRAWING

RD 10/14/2011
SCALE: NONE
DESIGNED BY: JMM
DRAWN BY: JMM
CHECKED BY: JMM

SUBMITTED: 10/14/2011
PROJECT ENGINEER: JAMES M. MONTGOMERY
RECOMMENDED: JAMES M. MONTGOMERY
DATE: 10/14/2011

JAMES M. MONTGOMERY CONSULTING ENGINEERS, INC.
555 EAST WALNUT STREET, PASADENA, CALIFORNIA 91101

DISTRICT APPROVAL ON TITLE PAGE

LAS VIRGENES MWD/ TRIUNFO CSD
TAPIA WRF - FILTRATION/ DISINFECTION ADDITION
PHASE II
VALVE, GATE, AND FAN SCHEDULES

SHEET: M-4
OF 66 SHEETS

MISCELLANEOUS MECHANICAL EQUIPMENT SCHEDULE						
EQUIP. NO.	LOCATION	SERVICE	TYPE	HP (MIN)	CAPACITY	REMARKS
4-ME-1	FILTER PIPE GALLERY	HEATING	ELECTR. UNIT HEATER	7.5 KW	25,590 BTU/HR	W/THERMOSTAT
4-ME-2	FILTER INFLUENT PIPE GALLERY	FILTER INFLUENT	TURBIDIMETER	60W	-	-
4-ME-3	FILTER PIPE GALLERY	FILTER NO. 1 EFFLUENT	TURBIDIMETER	60W	-	-
4-ME-4	FILTER PIPE GALLERY	FILTER NO. 2 EFFLUENT	TURBIDIMETER	60W	-	-
4-ME-5	FILTER PIPE GALLERY	FILTER NO. 3 EFFLUENT	TURBIDIMETER	60W	-	-
4-ME-6	FILTER PIPE GALLERY	FILTER NO. 4 EFFLUENT	TURBIDIMETER	60W	-	-
4-ME-7	FILTER PIPE GALLERY	FILTER NO. 5 EFFLUENT	TURBIDIMETER	60W	-	-
4-ME-8	"	FILTER NO. 6 EFFLUENT	"	60W	-	-
4-ME-9	"	FILTER NO. 7 EFFLUENT	"	60W	-	-
4-ME-10	"	FILTER NO. 8 EFFLUENT	"	60W	-	-
4-ME-11	"	FILTER EFFLUENT	"	60W	-	-
6-ME-1	CHEMICAL BLDG. AND STORAGE	CHLORINE EVAPORATOR	ELECTRIC	2-6 KW	8,000 LB/DAY	-
6-ME-2	CHEMICAL BLDG. AND STORAGE	CHLORINE EVAPORATOR	ELECTRIC	2-6 KW	8,000 LB/DAY	-
6-ME-3	CHEMICAL BLDG. AND STORAGE	CHLORINE RES. ANALYZER	AMPEROMETRIC	-	0-20 PPM	-
6-ME-4	CHEMICAL BLDG. AND STORAGE	CHLORINE RES. ANALYZER	AMPEROMETRIC	-	0-20 PPM	△
6-ME-5	CHEMICAL BLDG. AND STORAGE	CHLORINE TANK SCALE	HYDRAULIC LOAD CELL	-	MIN. 30 TONS	-
6-ME-6	CHEMICAL BLDG. AND STORAGE	CHLORINE TANK SCALE	HYDRAULIC LOAD CELL	-	MIN. 30 TONS	-
6-ME-7	CHEMICAL BLDG. AND STORAGE	SULFUR DIOXIDE EVAPORATOR	ELECTRIC	2-6 KW	4,000 LB/DAY	-
6-ME-8	CHEMICAL BLDG. AND STORAGE	SULFUR DIOXIDE EVAPORATOR	ELECTRIC	2-6 KW	4,000 LB/DAY	-
6-ME-9	CHEMICAL BLDG. AND STORAGE	SULFUR DIOXIDE TANK SCALE	HYDRAULIC LOAD CELL	-	MIN. 12 TONS	-
6-ME-10	CHEMICAL BLDG. AND STORAGE	SULFUR DIOXIDE TANK SCALE	HYDRALIC LOAD CELL	-	MIN. 12 TONS	-
6-ME-11	CHEMICAL BLDG. AND STORAGE	CAT-IONIC POLYMER MIXER	PROPELLER	1/3	350 GAL. TANK	350 RPM MAX.
6-ME-12	CHEMICAL BLDG. AND STORAGE	NON-IONIC POLYMER MIXER	PROPELLER	1/3	350 GAL. TANK	350 RPM MAX W/POLYPAK
6-ME-13	CHEMICAL BLDG. AND STORAGE	AIR COMPRESSOR	RECIPROCATING	5	18 CFM AT 125 PSI ACT.	W/80 GAL. RECEIVER 6-T-6
6-ME-14	CHEMICAL BLDG. AND STORAGE	CHLORINE LEAK DETECTOR	ELECTRO-CHEMICAL	-	-	-
6-ME-15	CHEMICAL BLDG. AND STORAGE	SULFUR DIOXIDE LEAK DETECTOR	ELECTRO-CHEMICAL	-	-	-
6-ME-16	CHLORINATOR ROOM	HEATING	ELECTRIC UNIT HEATER	3 KW	-	W/WALL THERMOSTAT
6-ME-17	SULFONATOR ROOM	HEATING	ELECTRIC UNIT HEATER	3 KW	-	W/WALL THERMOSTAT
6-ME-18	ELECTRICAL ROOM	HEATING	ELECTRIC UNIT HEATER	3 KW	-	W/WALL THERMOSTAT
6-ME-19	CHEM. FEEDER ROOM	HEATING	UNIT HEATER	7 KW	-	W/WALL THERMOSTAT
6-ME-20	CHEM. FEEDER ROOM	AIR DRYER		-	10 SCFM	
6-ME-21	CHLORINATOR ROOM	CHLORINE	INJECTOR	-	60 GPM AT 10 PSI B.P.	INJECTOR TO BE CHANGED TO 3" (125 GPM) IN FUTURE
6-ME-22	CHLORINATOR ROOM	CHLORINE	INJECTOR	-	75 GPM AT 10 PSI B.P.	INJECTOR TO BE CHANGED TO 3" (125 GPM) IN FUTURE
6-ME-23	CHEMICAL BLDG. AND STORAGE	DRUM HANDLING	DRUM TRUCK	-	1500 LB	PORTABLE
8-ME-1	FINAL SEDI-MENTATION TANK NO. 5	SLUDGE COLLEC-TION	FLIGHT-TYPE COLLECTOR	-	TANK SIZE 150'-0" X 20'-0"	W/PROVISION FOR FUT. TANK NO. 6

METER SCHEDULE						
METER NO.	LOCATION	TYPE	SERVICE	PIPE SIZE IN.	FLOW RANGE GPM	REMARKS
4-M-1	FILTER DIVERSION BOX	VERTICAL OPEN FLOW PROPELLER	FILTER INFLUENT	42 3/8" MTR	1,500-15,000 20,000 ULT.	36" INSERT IN 42" PIPE
4-M-2	FILTER DIVERSION BOX	VERTICAL OPEN FLOW PROPELLER	FILTER INFLUENT	24	2,000-12,000	
4-M-3	FILTER INFLUENT	SONIC METER	FILTER INFLUENT	42 30" MTR	1,500-15,000 20,000 ULT.	REDUCE TO 30"
4-M-4	FILTER PIPE GALLERY	SHORT VENTURI	FILTERED EFFLUENT (BACKWASH)	24	2,000-6,000	
4-M-5	FILTER PIPE GALLERY	INSERT FLOW TUBE	AIR	10	300-1,500 CFM	
6-M-1	CHEMICAL BLDG.	BATCH METER	WATER	1	30	AT 6-FD-12
6-M-2	CHEMICAL BLDG.	BATCH METER	WATER	1	30	AT 6-T-5
6-M-3	CHEMICAL BLDG.	ROTAMETER	WATER	1-1/2	25	AT 6-FD-12
6-M-4	CHEMICAL BLDG.	ROTAMETER	PEC SOLUTION	3/4	10	
6-M-5	CHEMICAL BLDG.	ROTAMETER	PEC SOLUTION	3/4	10	
6-M-6	CHEMICAL BLDG.	ROTAMETER	ALUM SOLUTION	1	10	
6-M-7	CHEMICAL BLDG.	ROTAMETER	ALUM SOLUTION	1	10	
6-M-10	CHEMICAL BLDG.	PROPELLER	UTILITY WATER	6	100-900	W/ELECTR. HEAD
6-M-11	EXISTING	ROTAMETER	PEC/LA	3/4	10	
6-M-12	AERATION TANKS	ROTAMETER	PEC/LA	3/4	10	
6-M-13	TANKS	ROTAMETER	PEC/LA	3/4	10	
7-M-1	WWW TANK	MAG. METER	FILTER BACKWASH WASTE	6	200-1,500	
10-M-2	S OF CHEM. BLDG.	PROPELLER	FILTERED EFFL'T	6	100-900	W/ELECTR. HEAD

03564

NOT INCLUDED IN CONTRACT

RECORD DRAWING

SHEET

LAS VIRGENES MWD/TRIUNFO CSD
TAPIA WRF - FILTRATION/DISINFECTION ADDITION

M-5

OF 66 SHEETS

20 4/11/24	MPJ	RECORD DRAWING
11 3/30/89	TCB	REVISION 6-ME-4 CAPACITY
REV	DATE	BY
		DESCRIPTION

SCALE:	NONE
DESIGNED	G M
DRAWN	G M
CHECKED	JCS


SUBMITTED	2-20-24	3/10/24
PROJECT ENGINEER	R.C.E. NO.	DATE
RECOMMENDED	3/20/24	3/20/24
JAMES M. MONTGOMERY CONSULTING ENGINEERS, INC.	R.C.E. NO.	DATE

JAMES M. MONTGOMERY CONSULTING ENGINEERS, INC.


355 EAST WALNUT STREET, PASADENA, CALIFORNIA 91101

DISTRICT APPROVAL ON TITLE PAGE


PHASE II	MISCELLANEOUS MECHANICAL EQUIPMENT AND METER SCHEDULES
----------	--

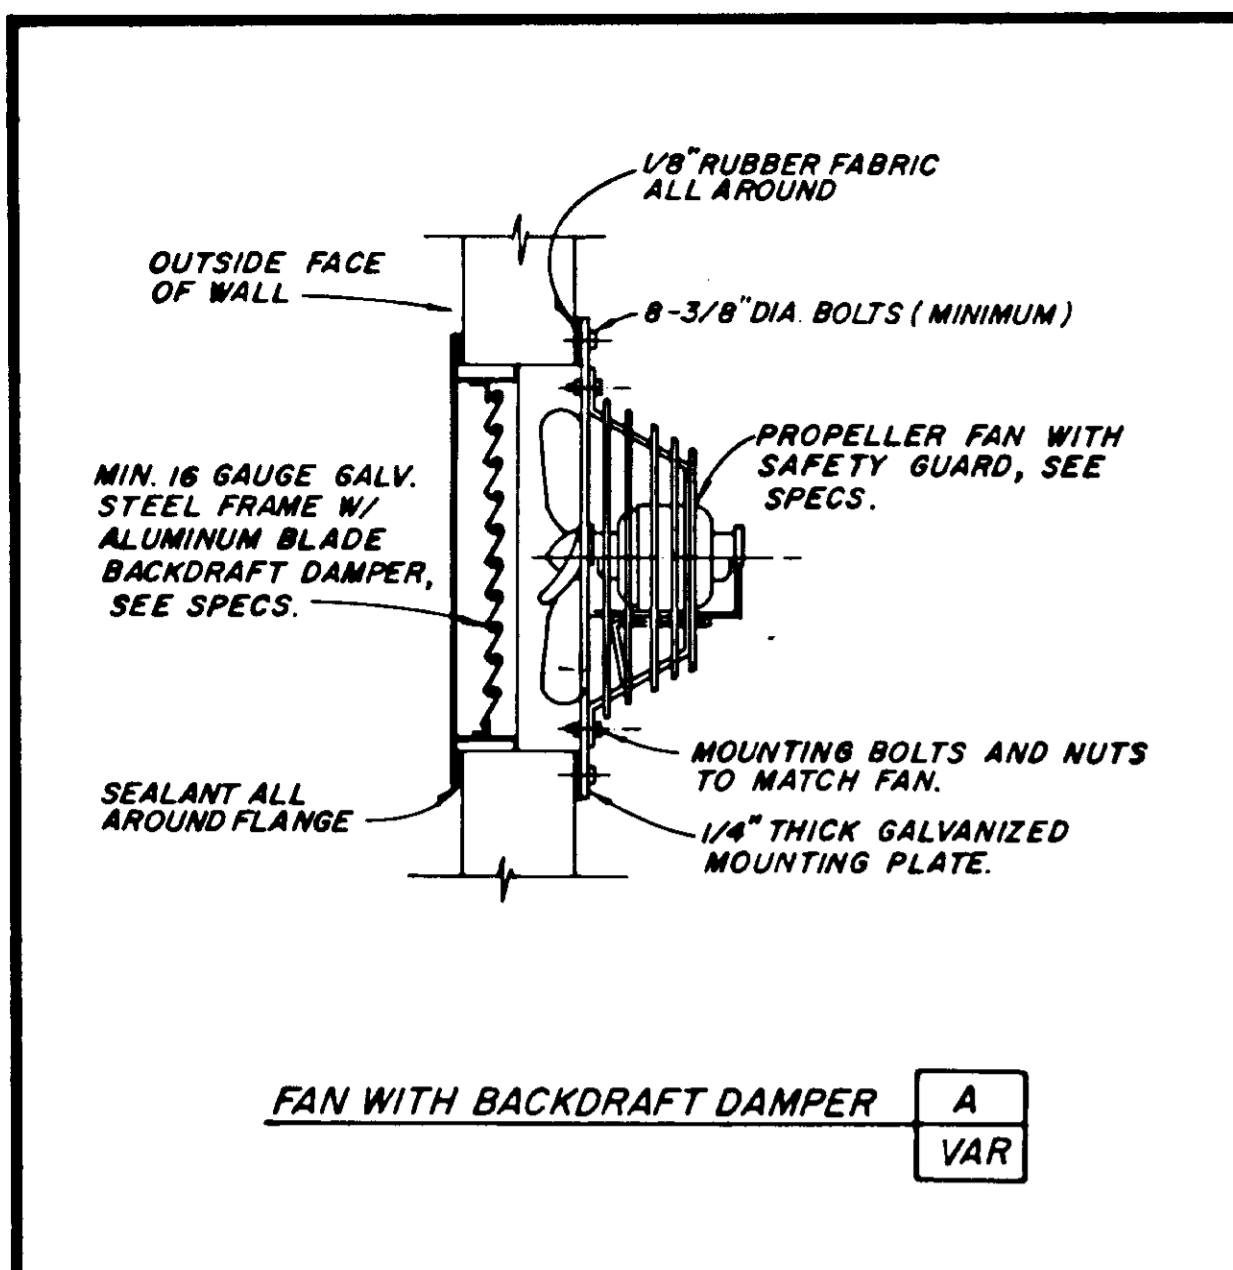


FAN WITH BACKDRAFT DAMPER **A**
VAR

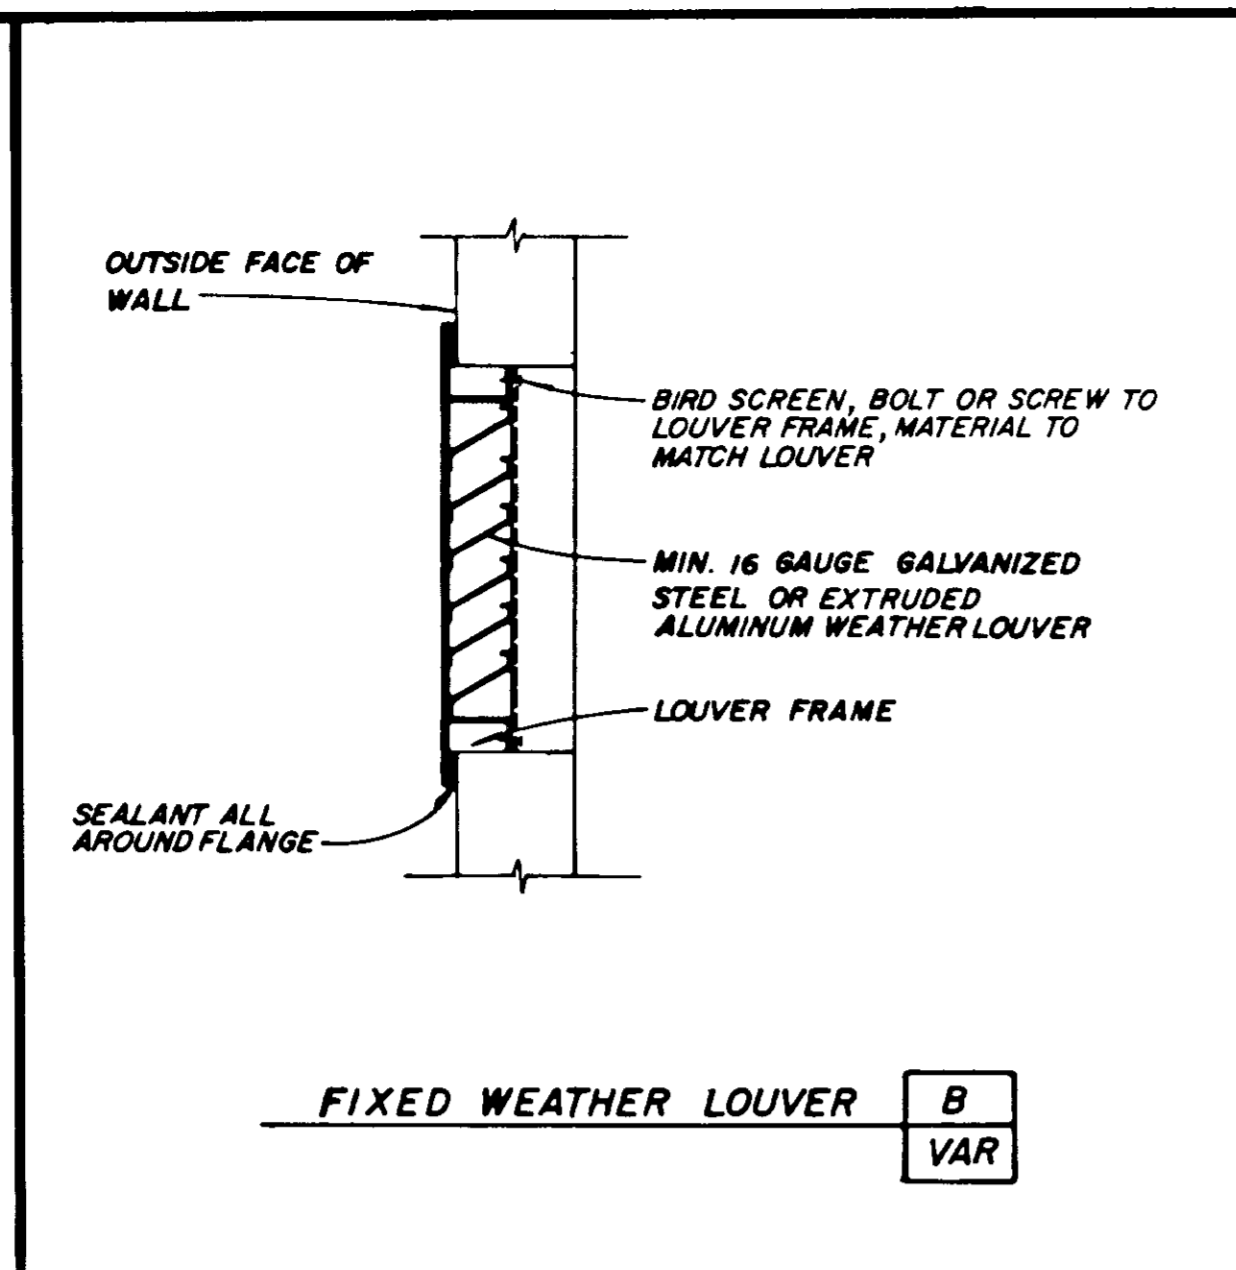


FIXED WEATHER LOUVER **B**
VAR

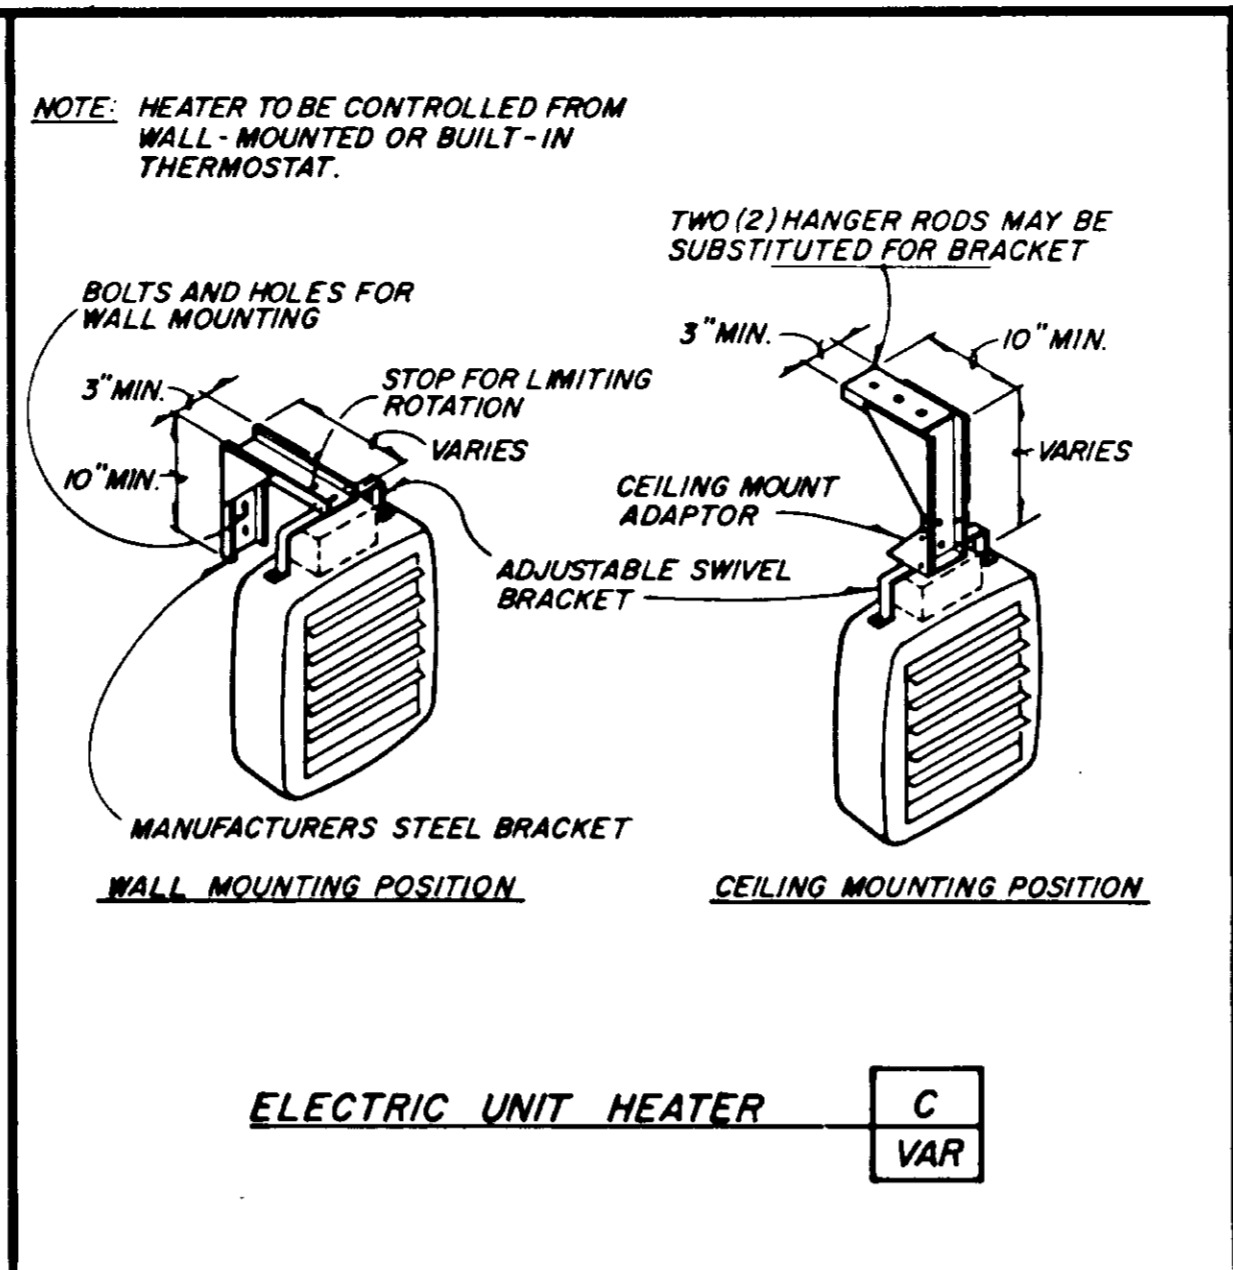


ELECTRIC UNIT HEATER **C**
VAR

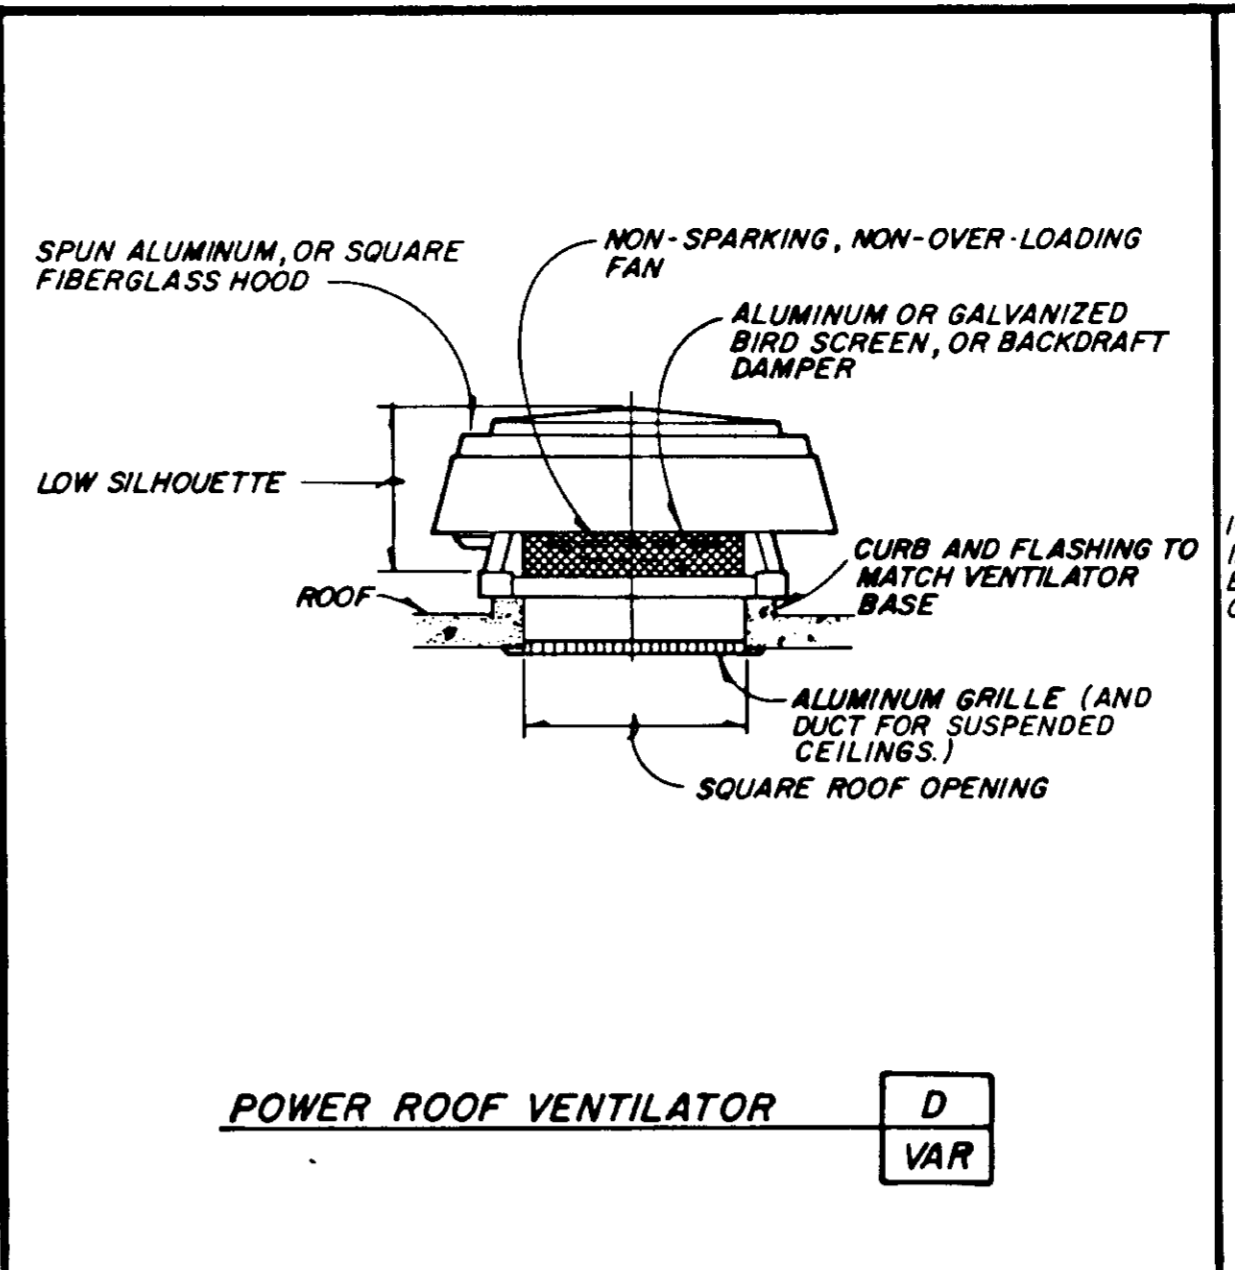


POWER ROOF VENTILATOR **D**
VAR

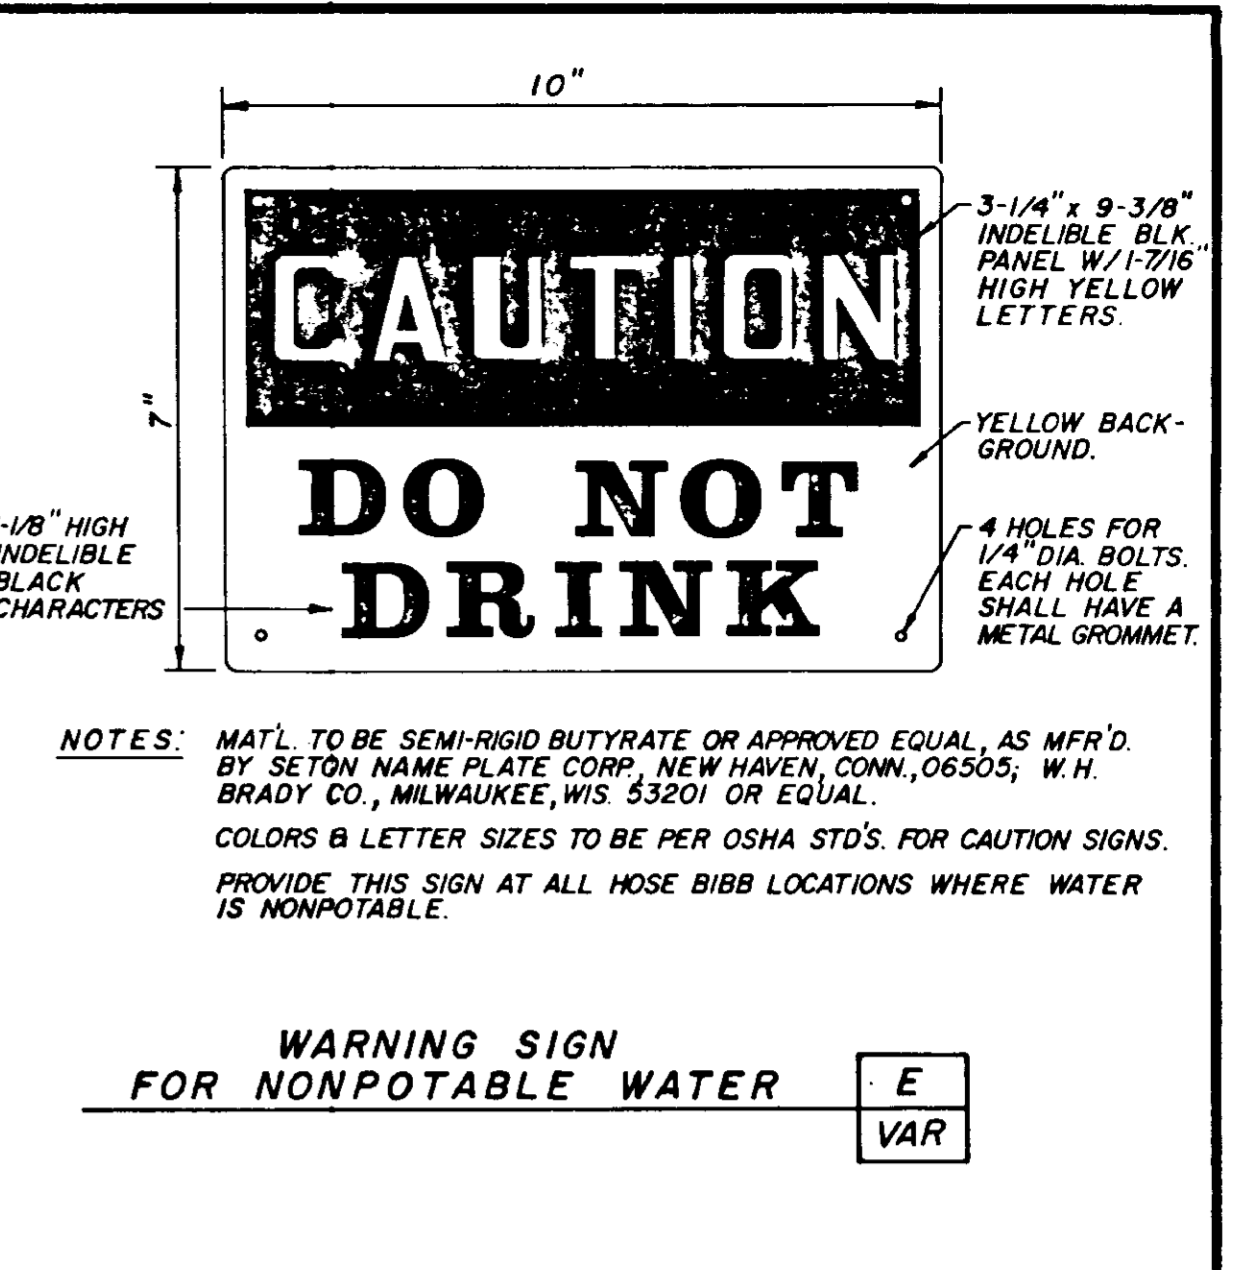


WARNING SIGN FOR NONPOTABLE WATER **E**
VAR

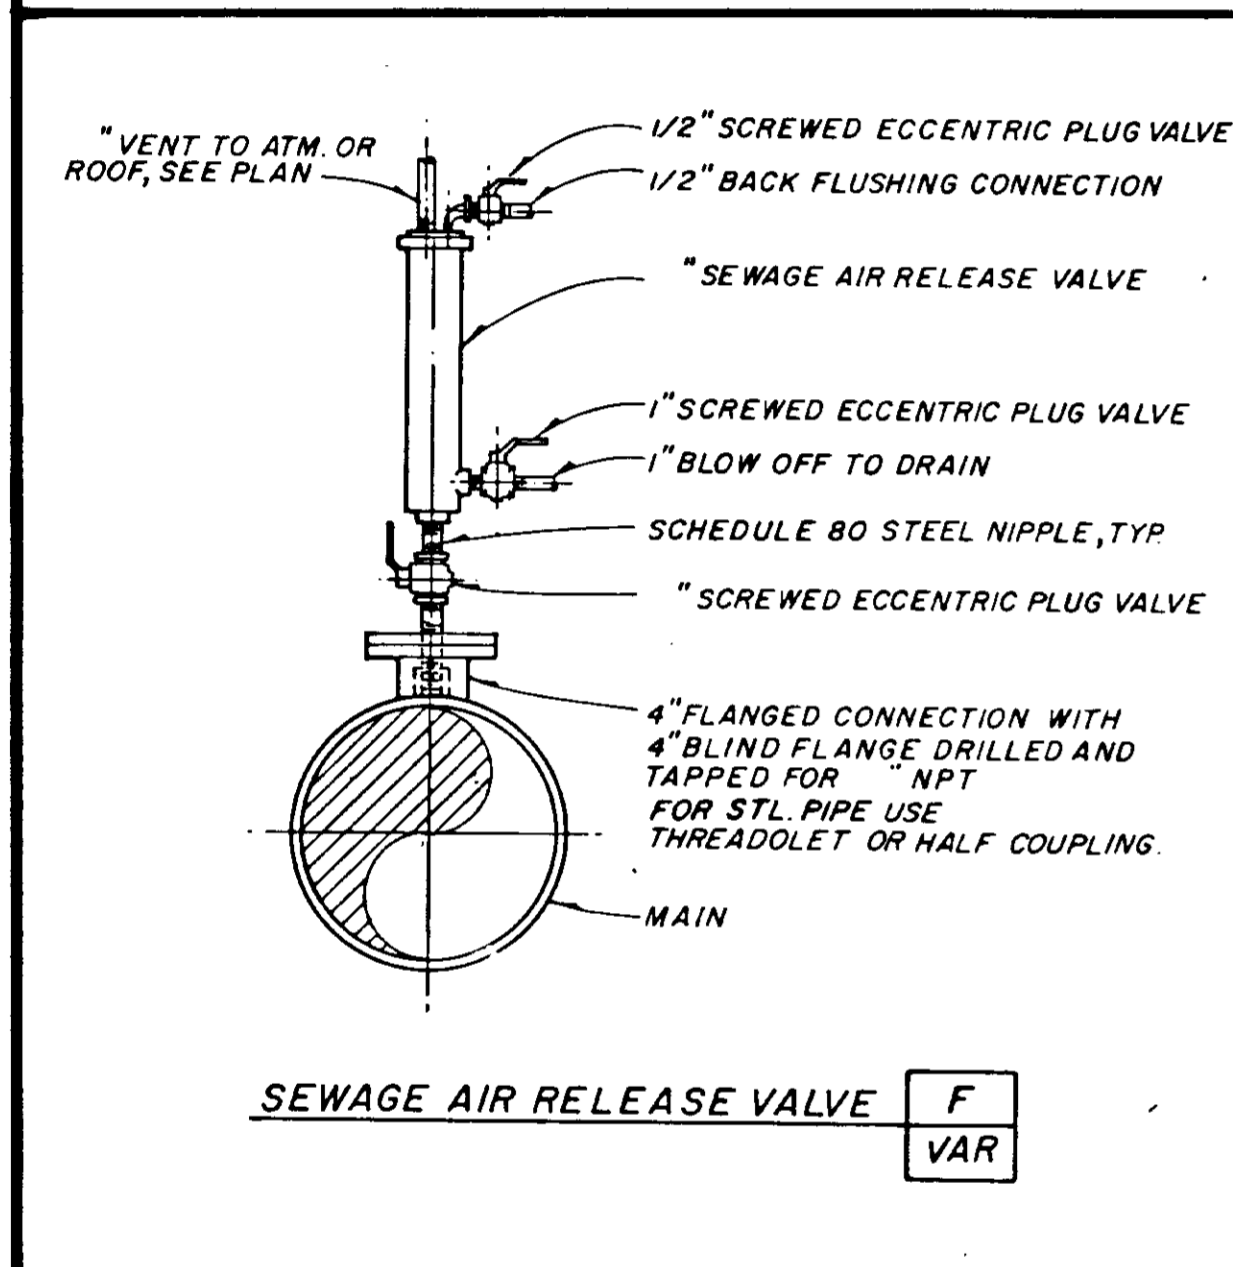


SEWAGE AIR RELEASE VALVE **F**
VAR

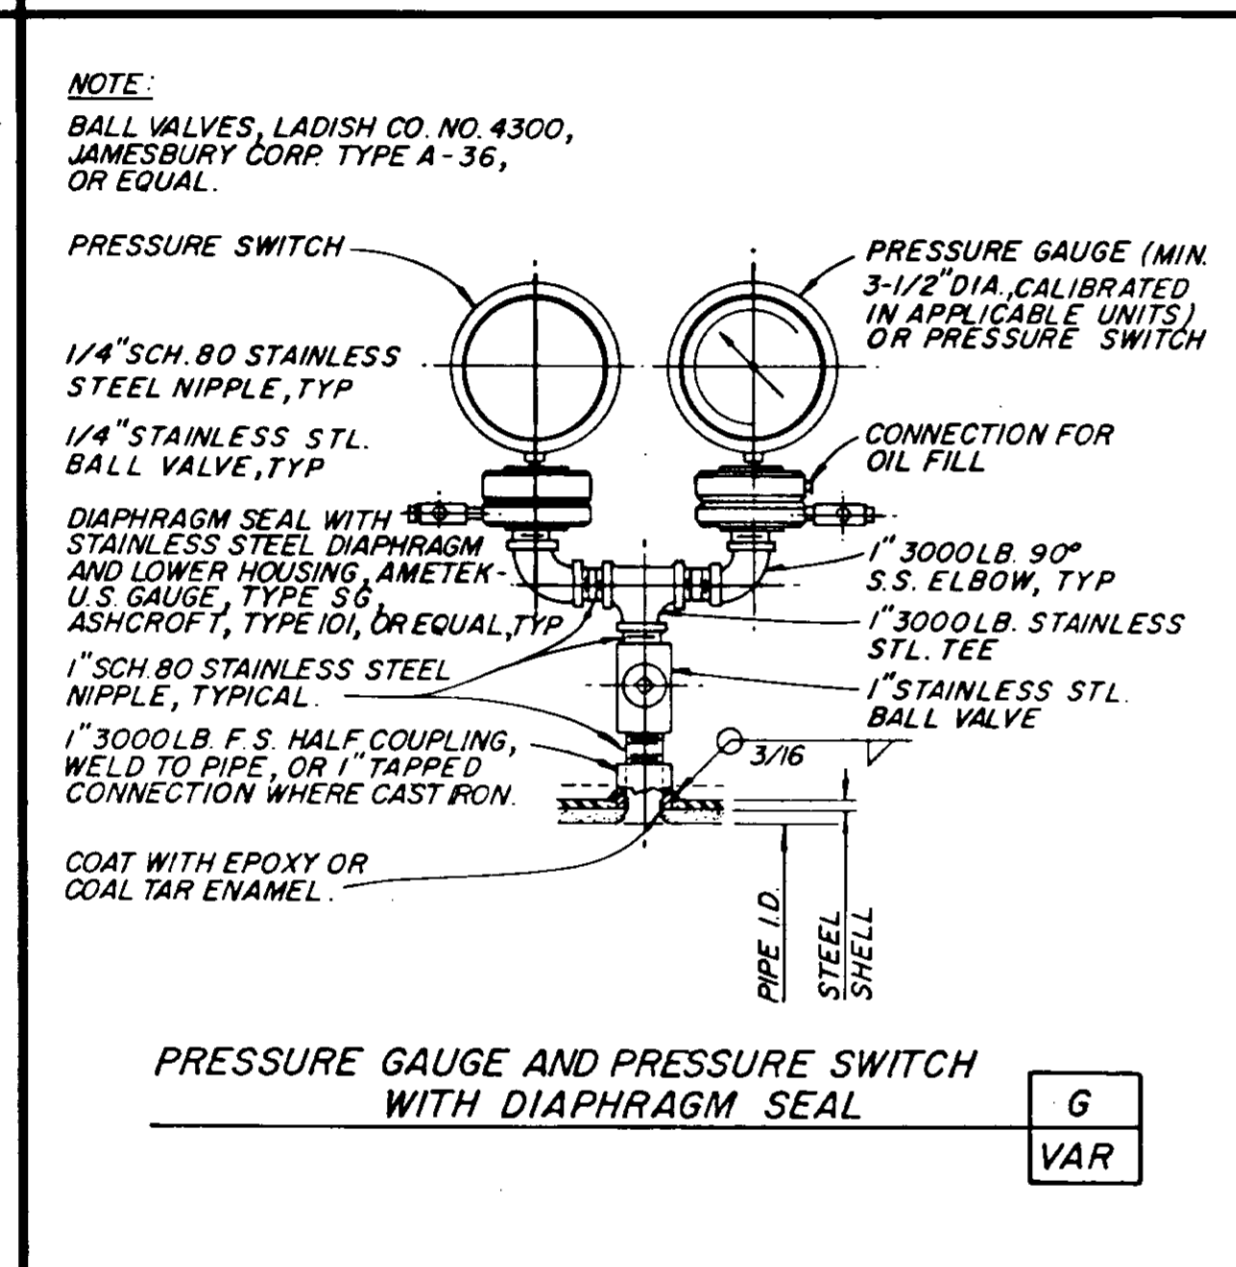

PRESSURE GAUGE AND PRESSURE SWITCH WITH DIAPHRAGM SEAL **G**
VAR

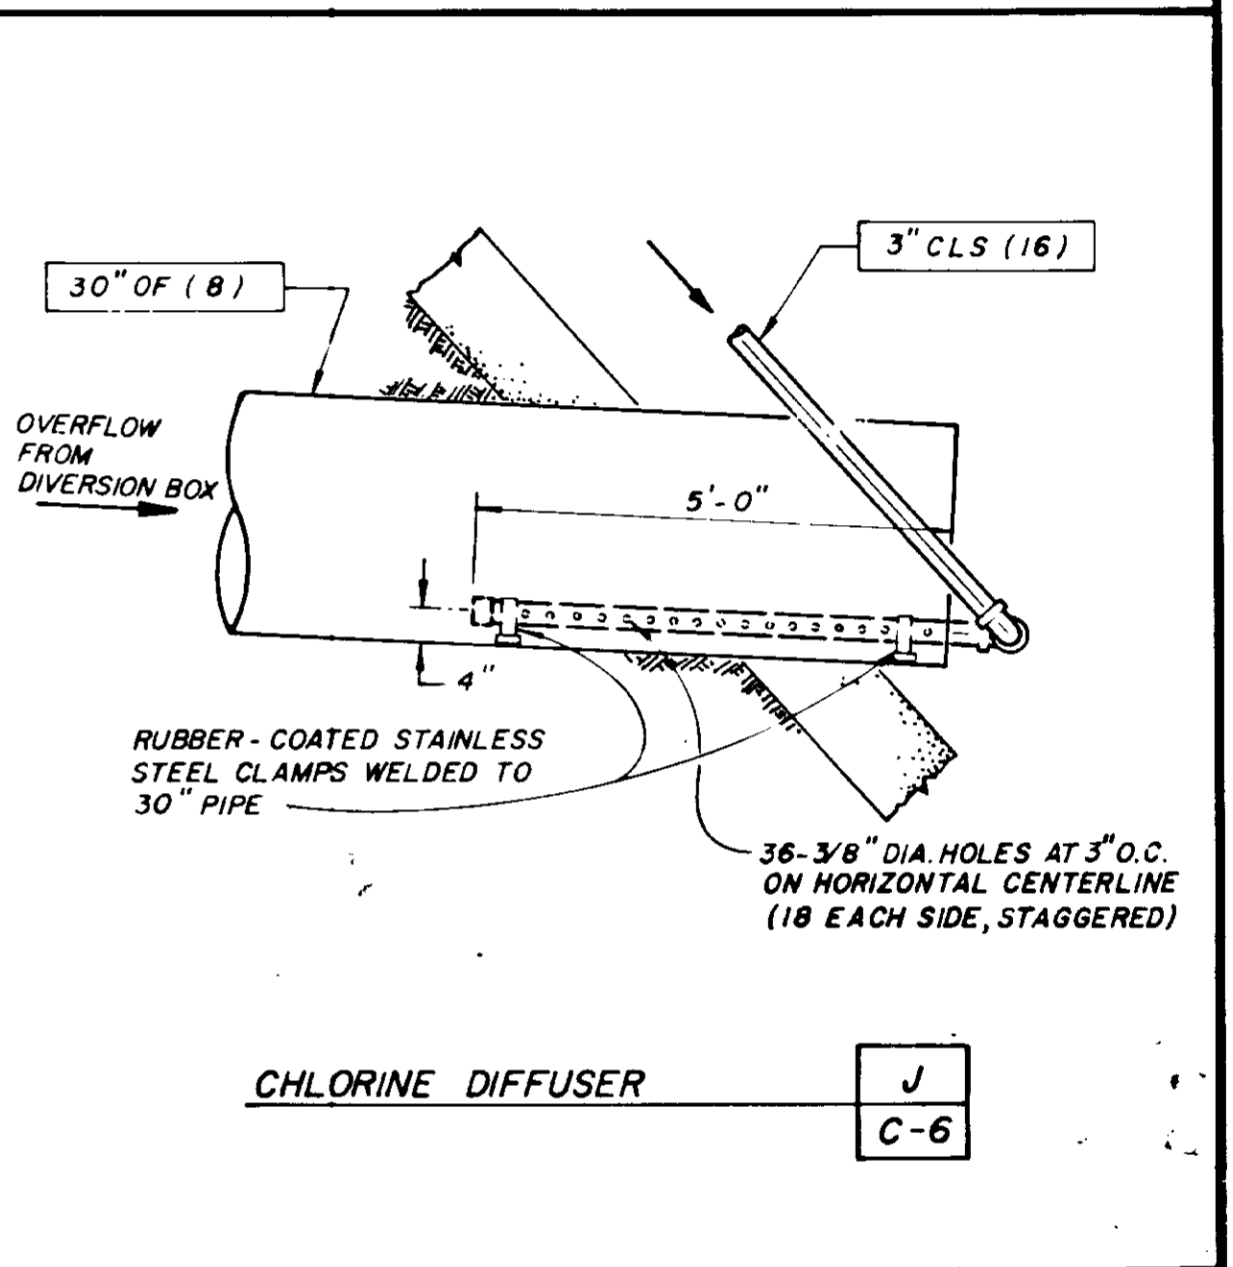

CHLORINE DIFFUSER **J**
C-6

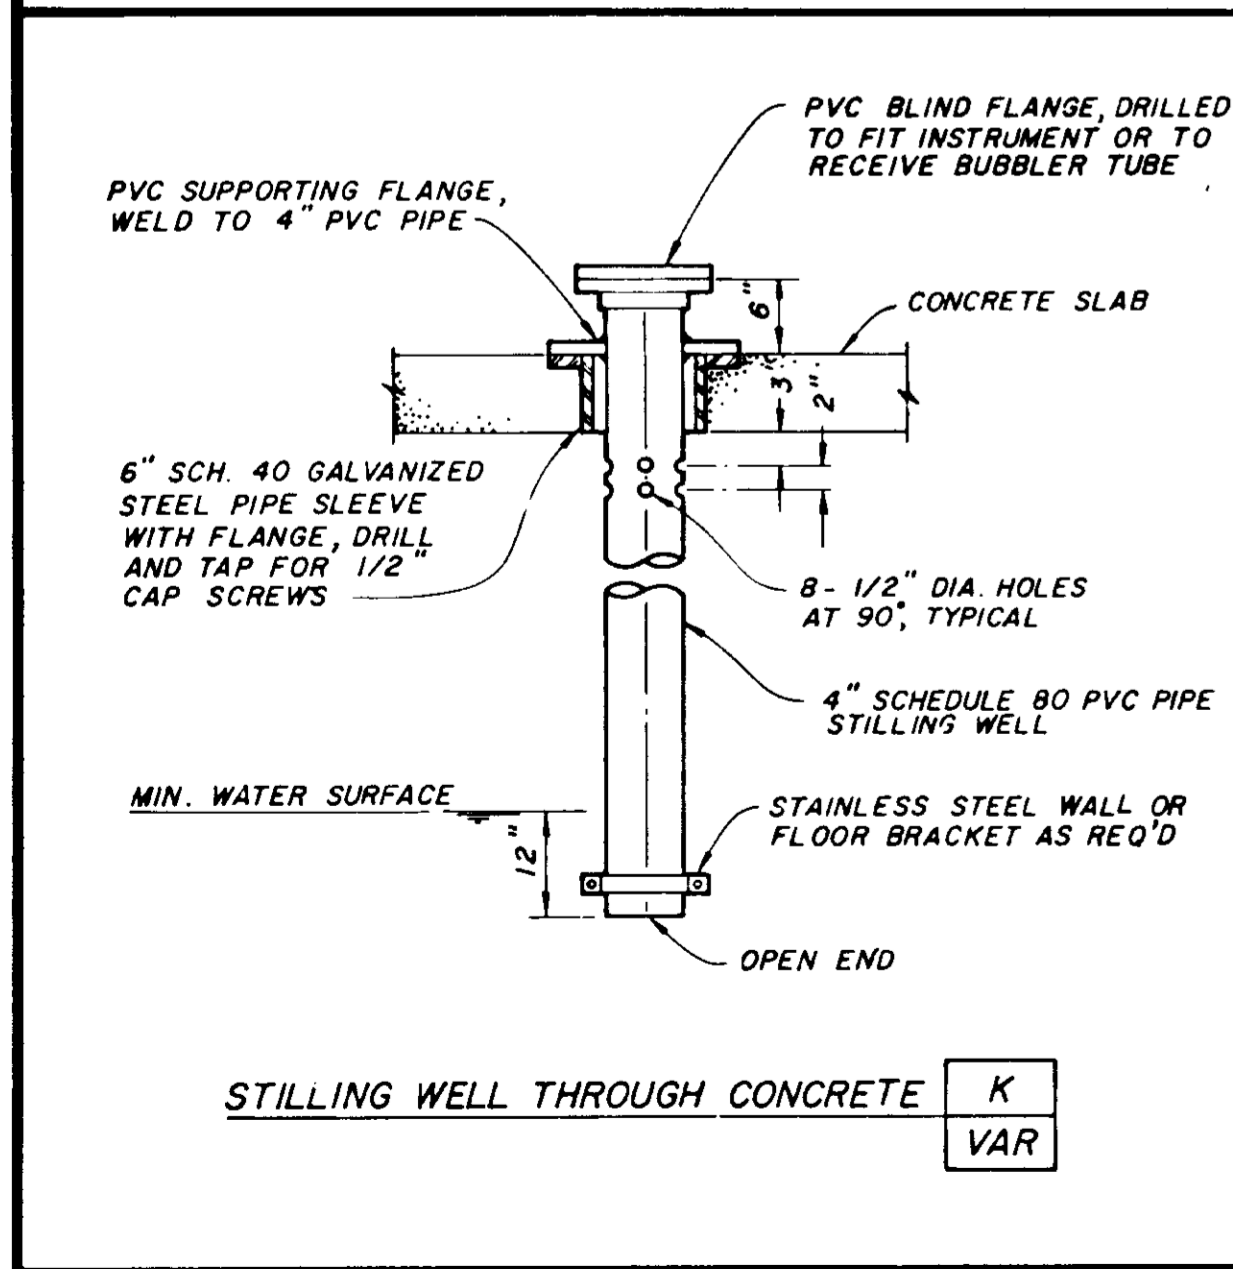

STILLING WELL THROUGH CONCRETE **K**
VAR

JOB NO.	FRAME NO.
IDENT. NO.	

JAMES M. MONTGOMERY CONSULTING ENGINEERS, INC.

555 EAST WALNUT STREET, PASADENA, CALIFORNIA 91101

DISTRICT APPROVAL ON TITLE PAGE

03565

RECORD DRAWING

LAS VIRGENES MWD/TRIUNFO CSD

TAPIA WRF - FILTRATION/DISINFECTION ADDITION

PHASE II

MISCELLANEOUS MECHANICAL DETAILS - A

SHEET **M-6** OF 66 SHEETS

REV	DATE	BY	DESCRIPTION

SCALE: NONE

DESIGNED	G.M.
DRAWN	G.M.
CHECKED	JCS

SUBMITTED	27304	8/19/81
PROJECT ENGINEER	R.C.E. NO.	DATE
RECOMMENDED	27638	8/20/81
JAMES M. MONTGOMERY CONSULTING ENGINEERS, INC.	R.C.E. NO.	DATE

JAMES M. MONTGOMERY CONSULTING ENGINEERS, INC.

DISTRICT APPROVAL ON TITLE PAGE


LAS VIRGENES MWD/TRIUNFO CSD

TAPIA WRF - FILTRATION/DISINFECTION ADDITION


PHASE II

MISCELLANEOUS MECHANICAL DETAILS - A


SHEET **M-6** OF 66 SHEETS

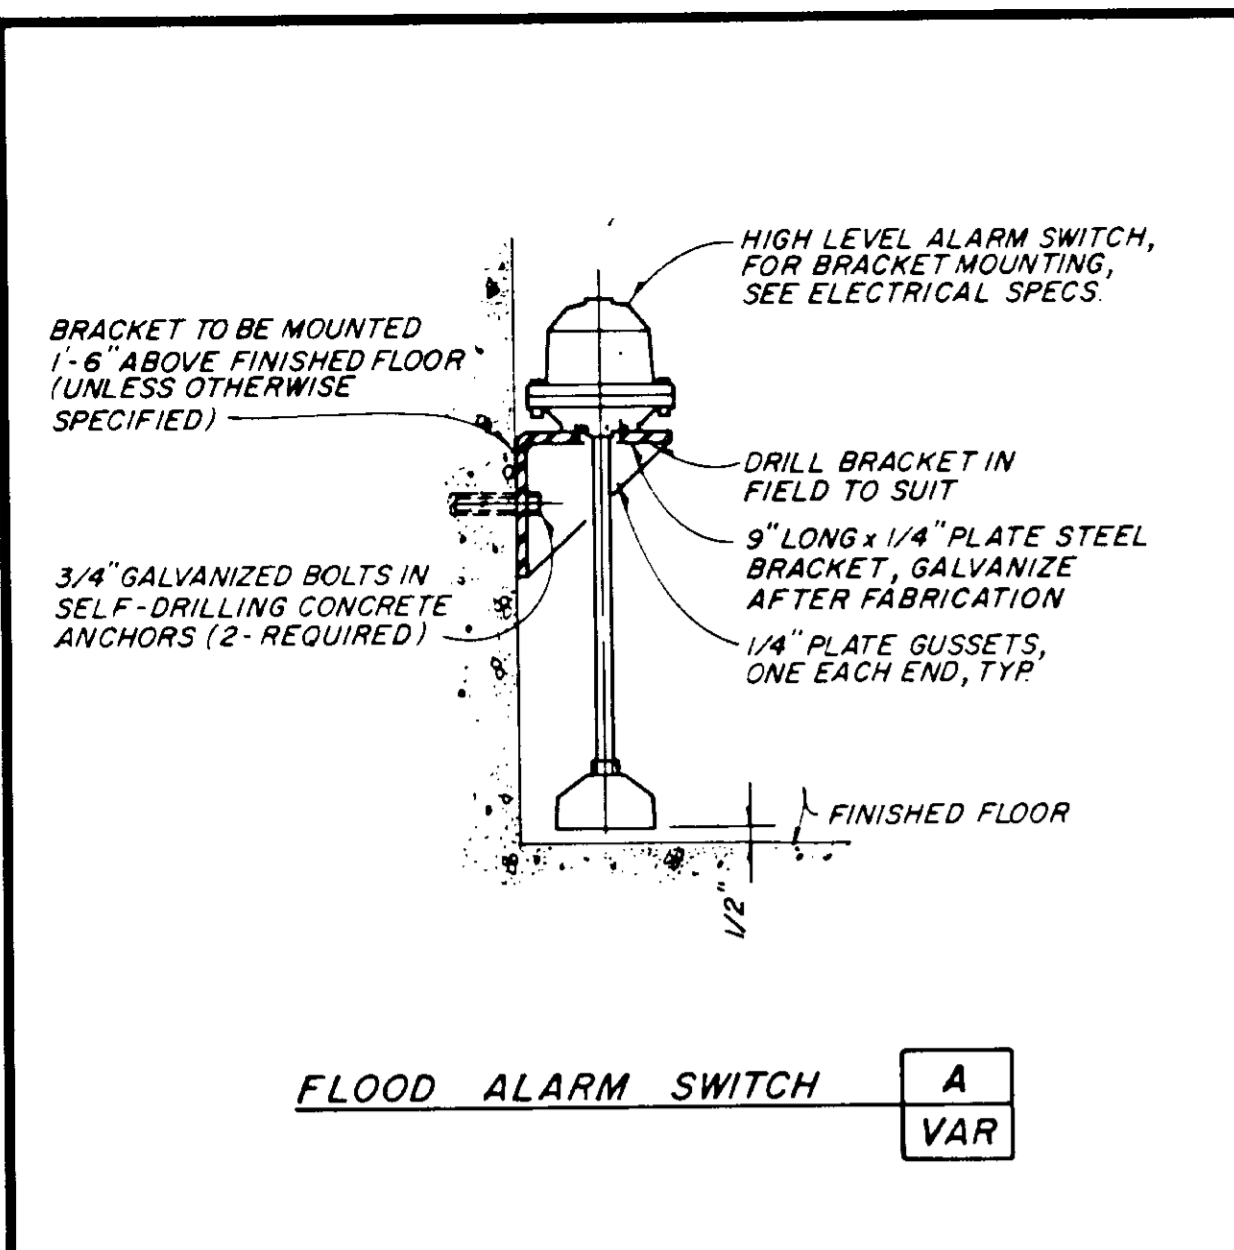


FLOOD ALARM SWITCH **A**
VAR

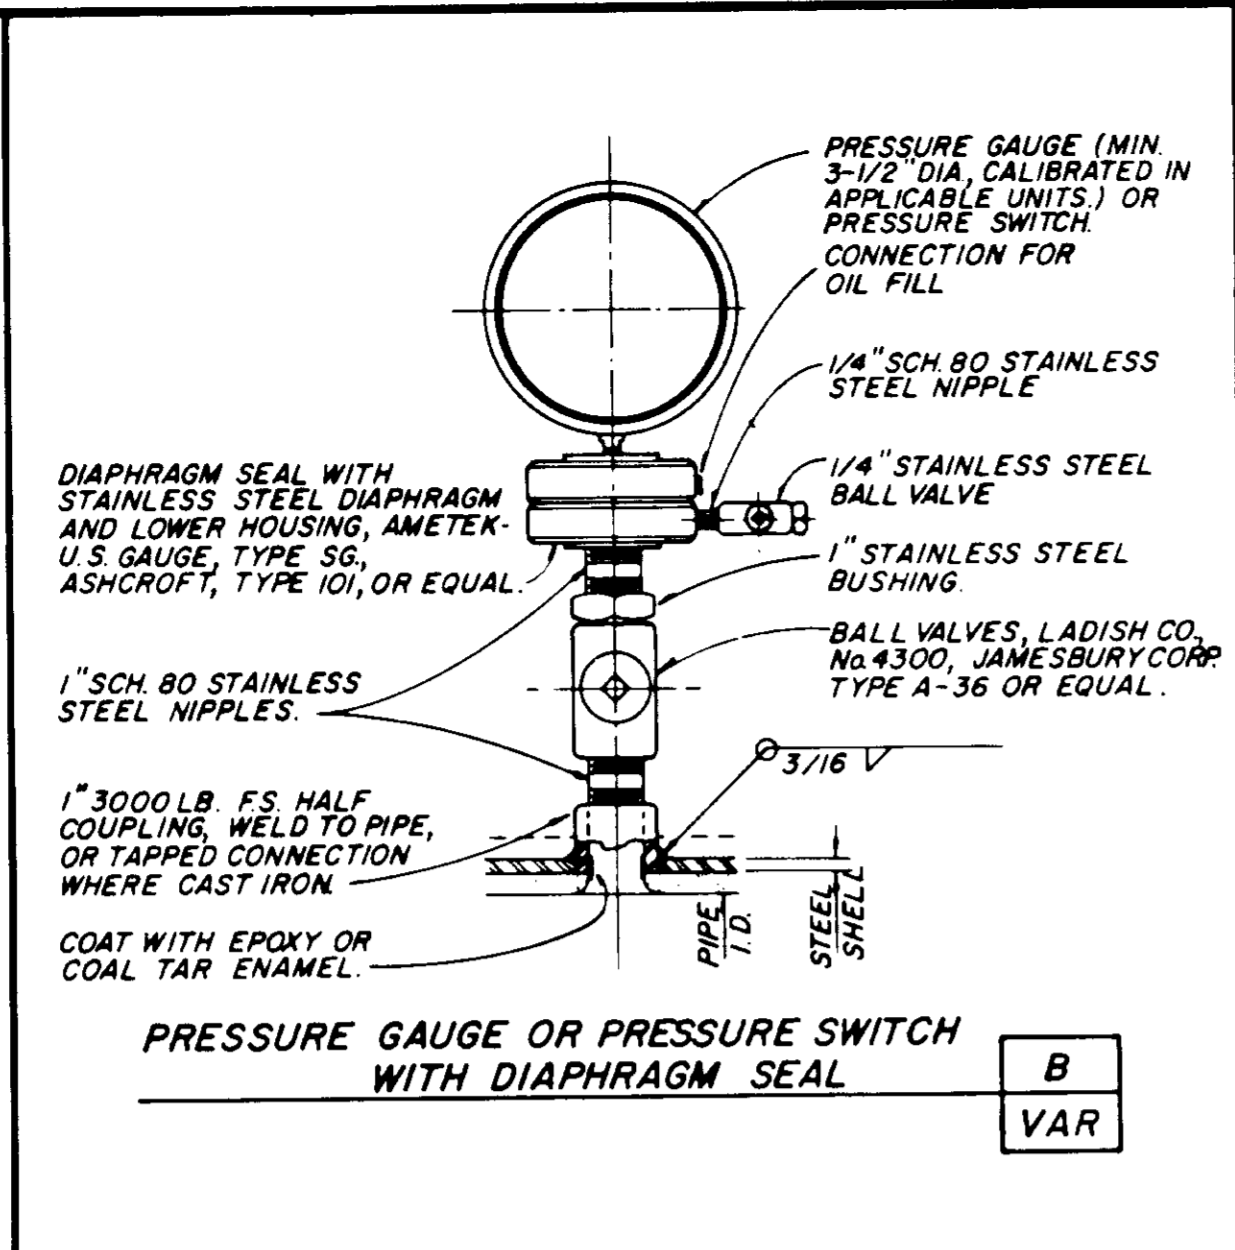


PRESSURE GAUGE OR PRESSURE SWITCH WITH DIAPHRAGM SEAL **B**
VAR

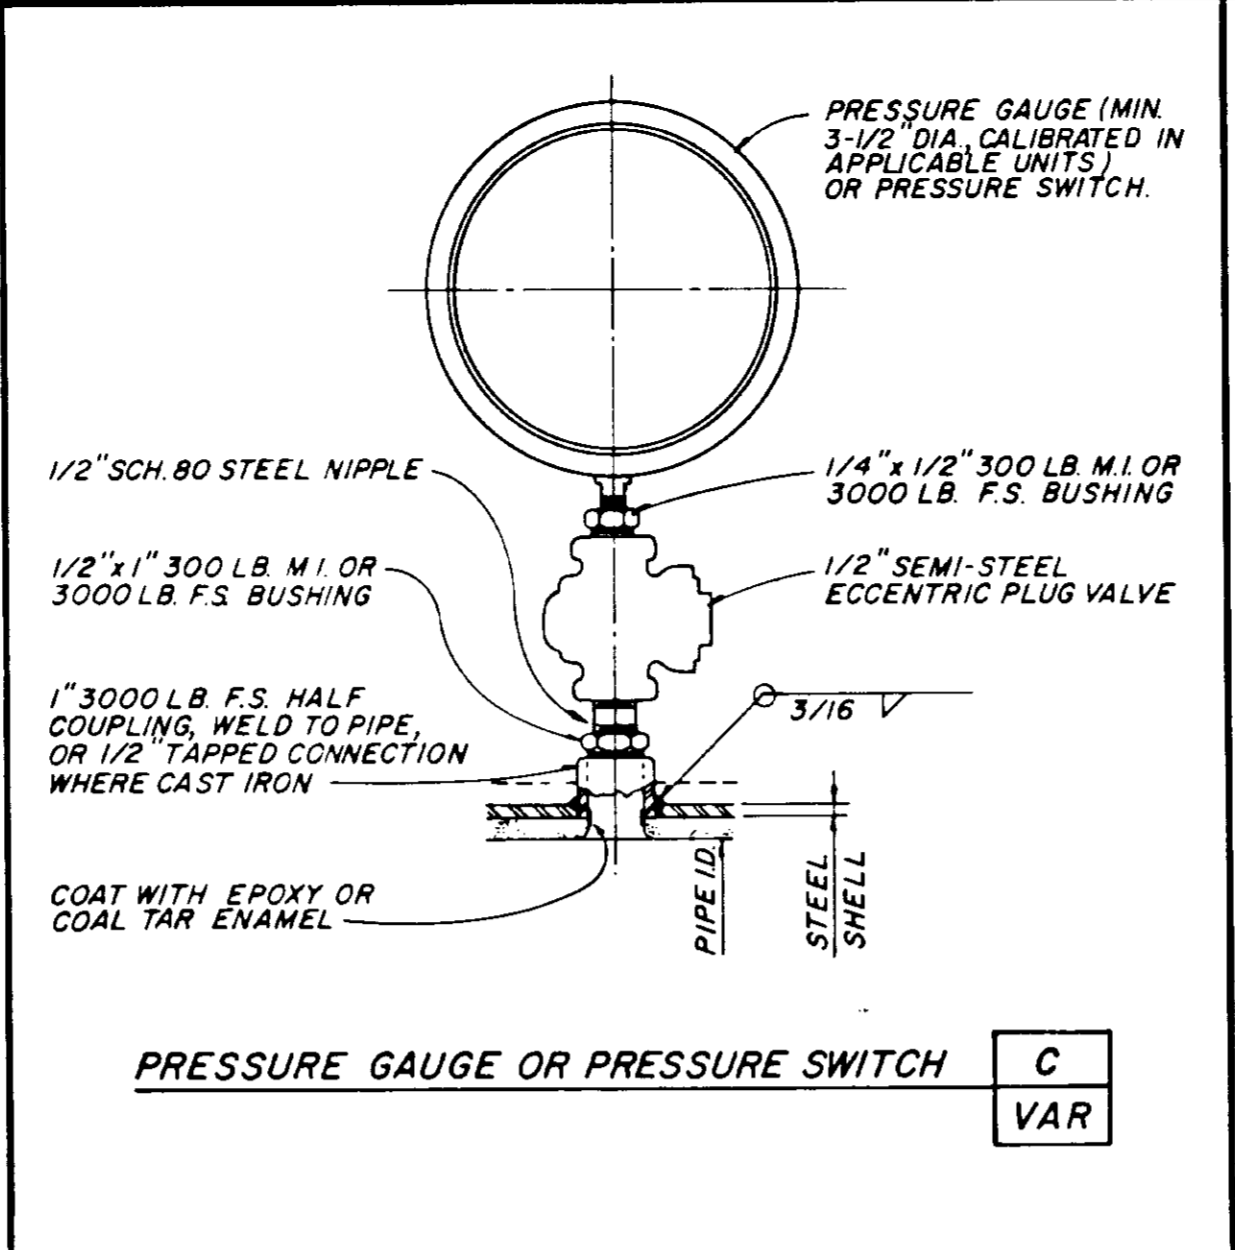


PRESSURE GAUGE OR PRESSURE SWITCH **C**
VAR

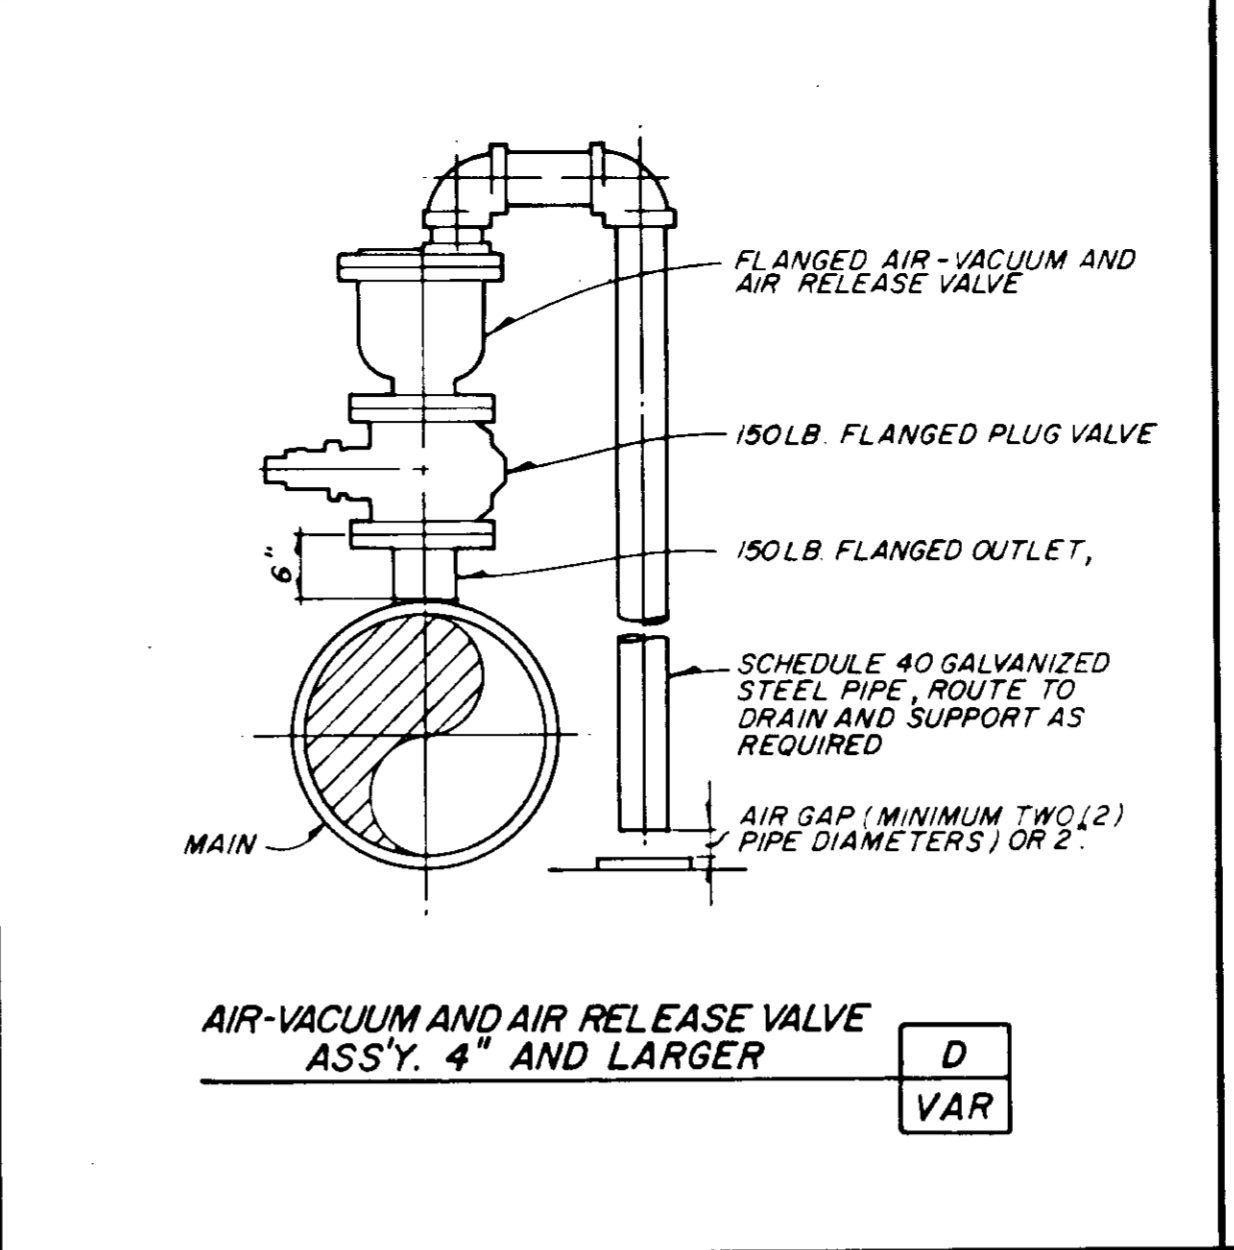


AIR-VACUUM AND AIR RELEASE VALVE ASS'Y. 4" AND LARGER **D**
VAR

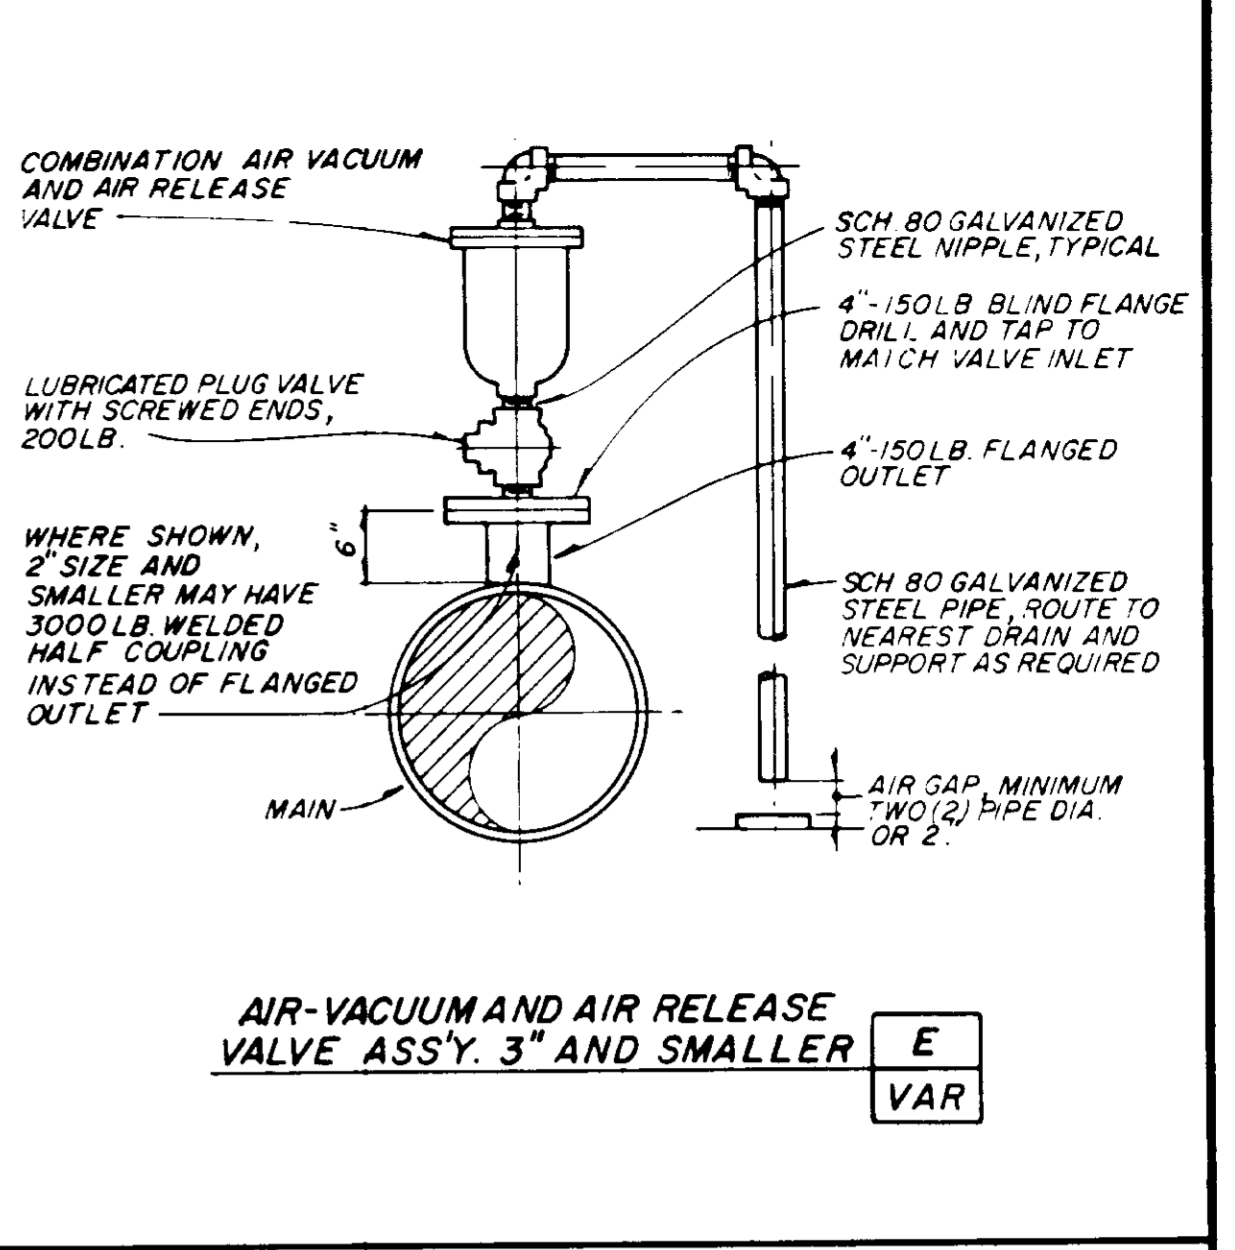


AIR-VACUUM AND AIR RELEASE VALVE ASS'Y. 3" AND SMALLER **E**
VAR

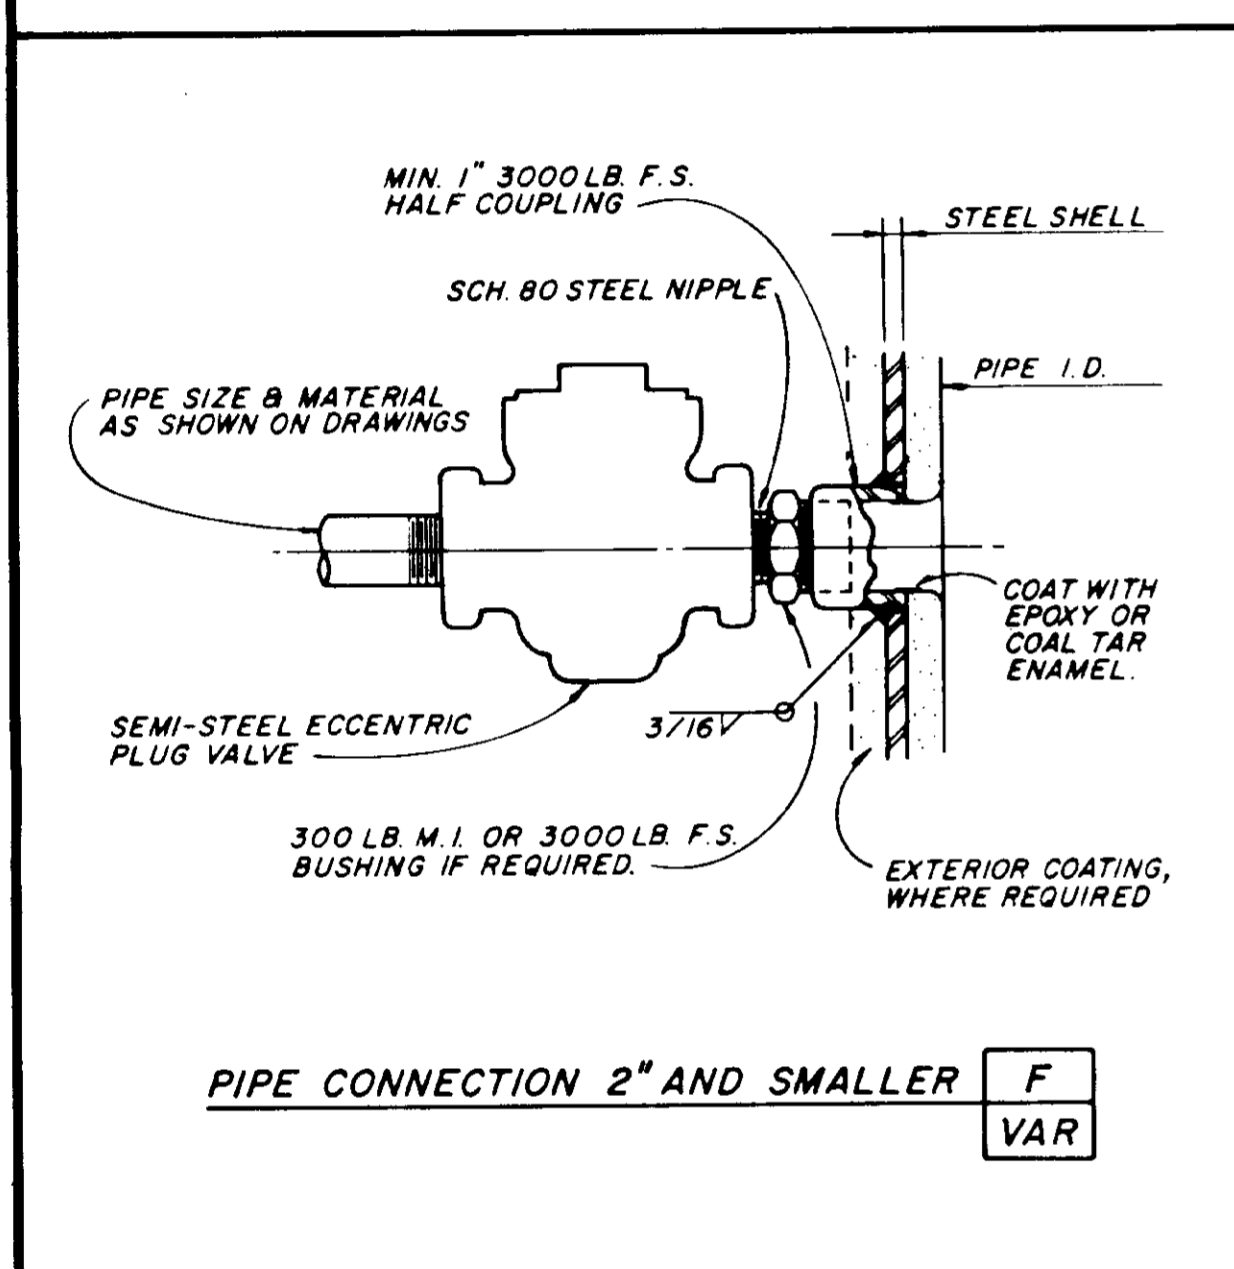


PIPE CONNECTION 2" AND SMALLER **F**
VAR

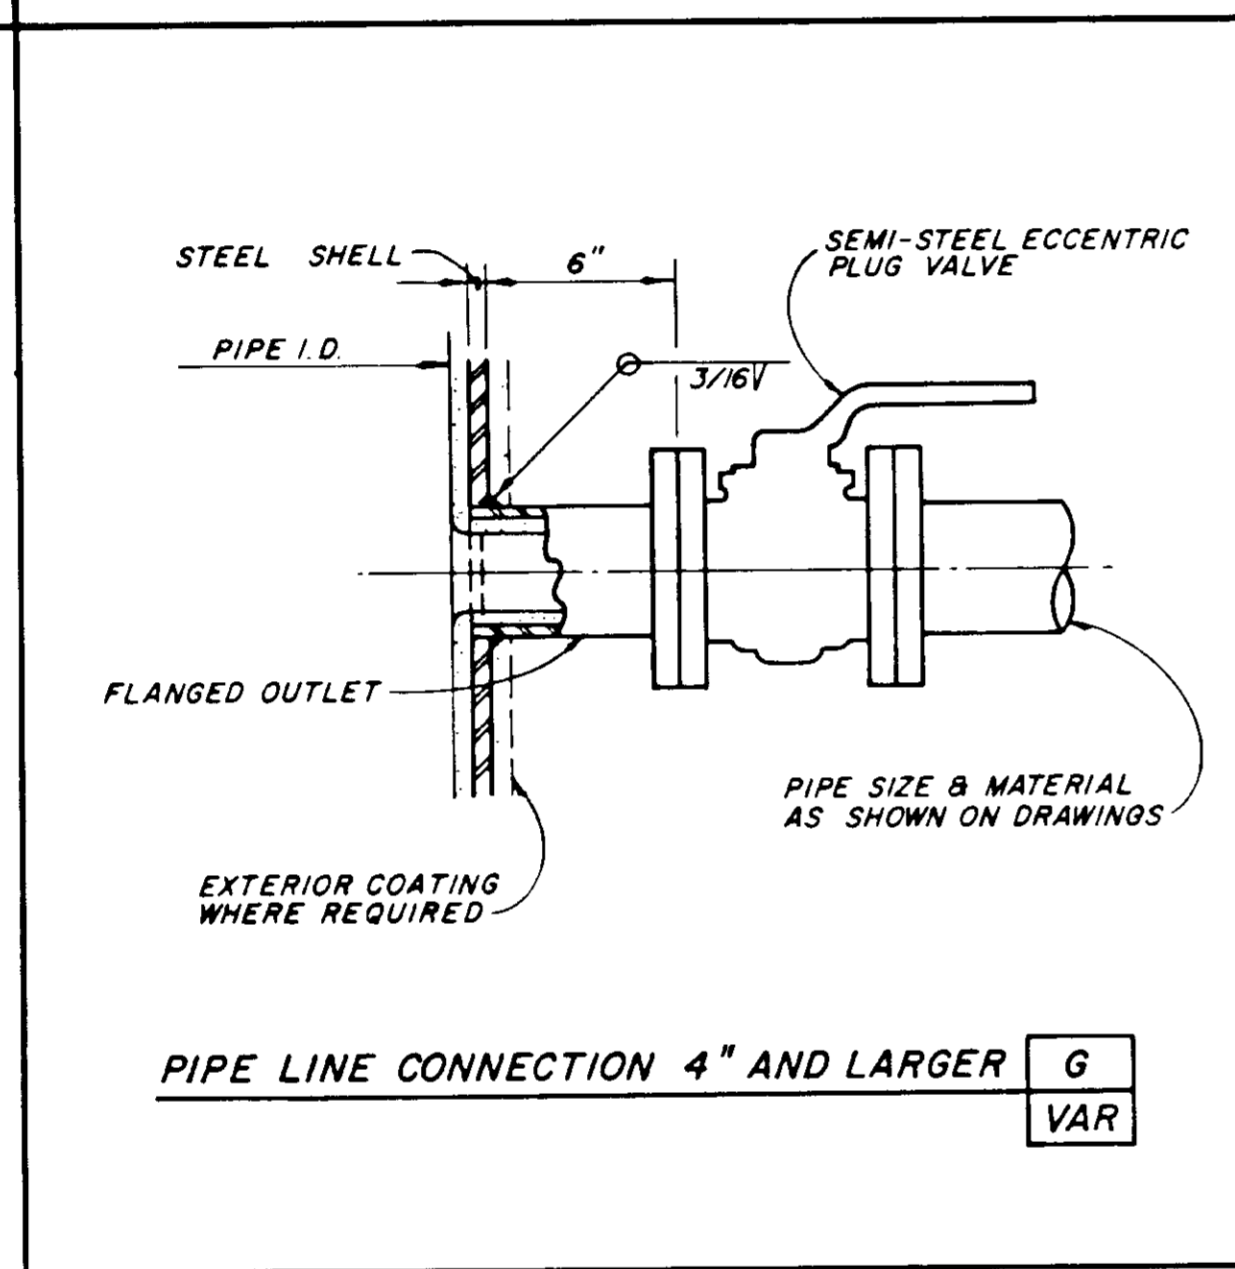


PIPE LINE CONNECTION 4" AND LARGER **G**
VAR

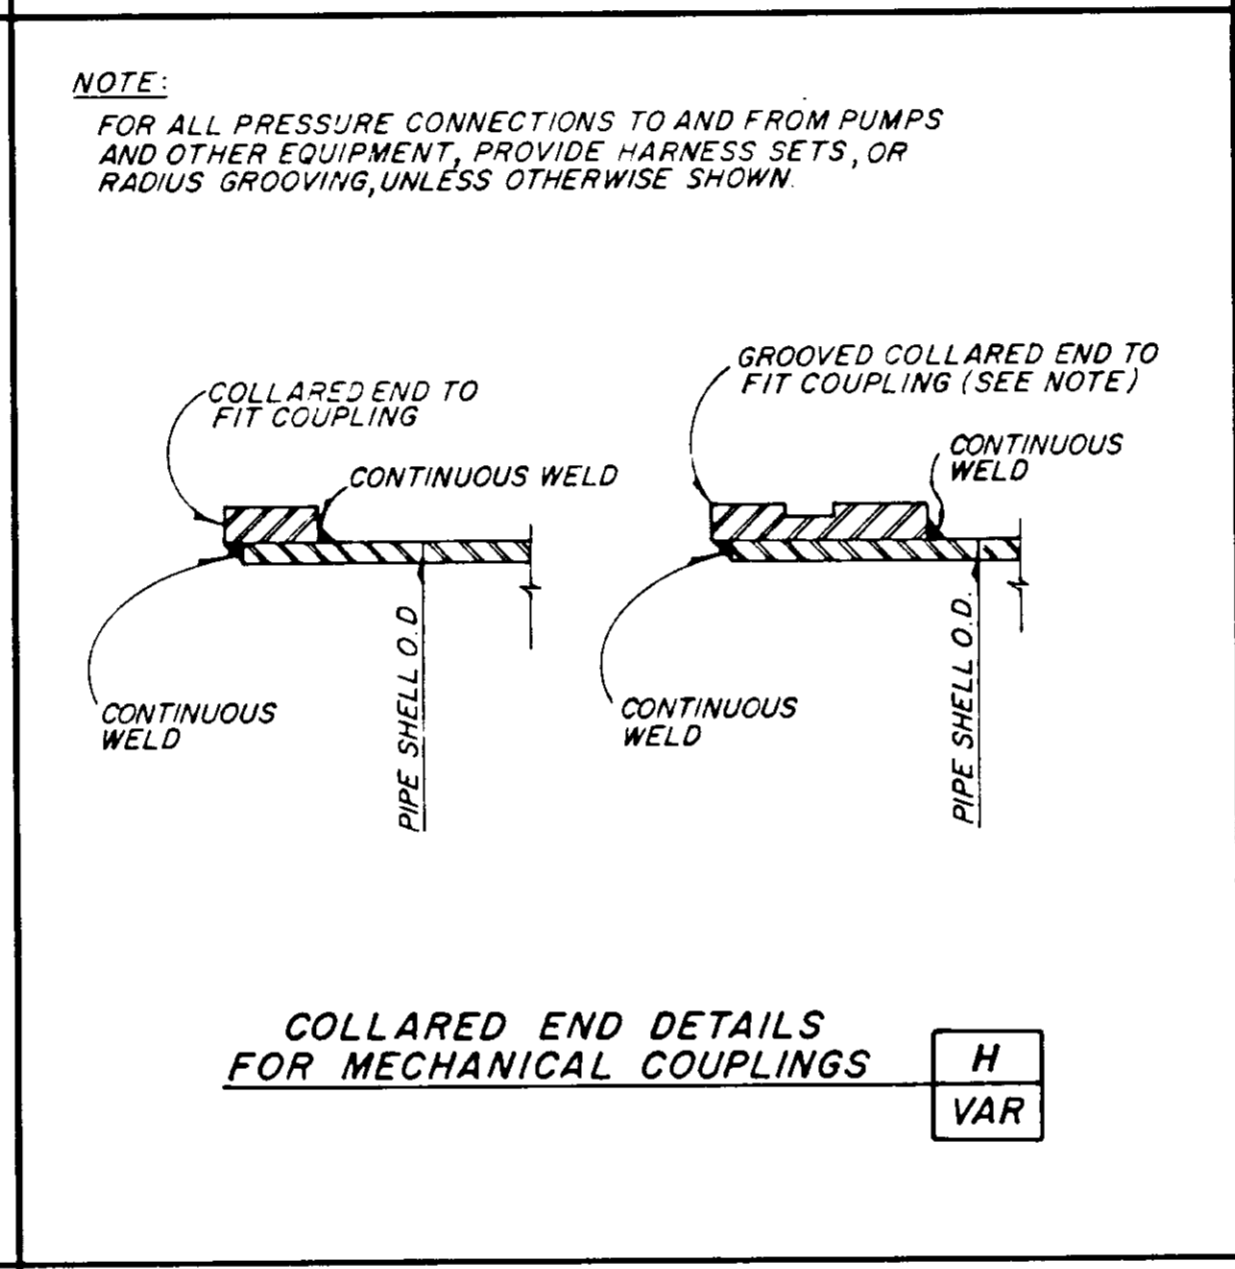


COLLARED END DETAILS FOR MECHANICAL COUPLINGS **H**
VAR

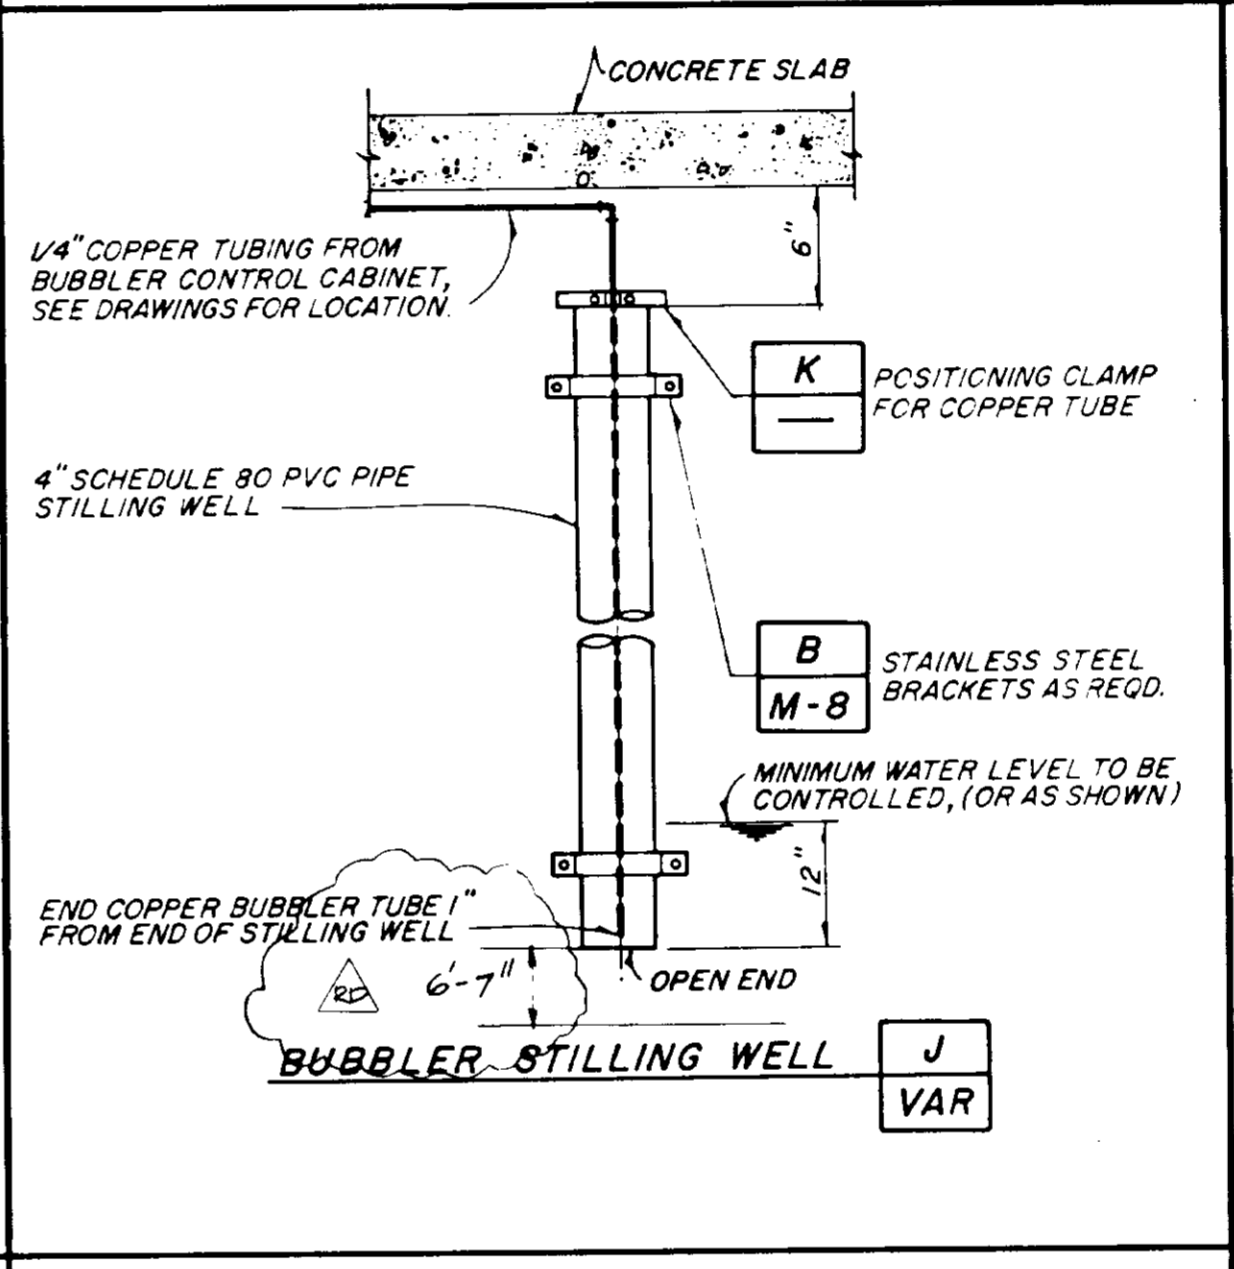


BUBBLER STILLING WELL **J**
VAR

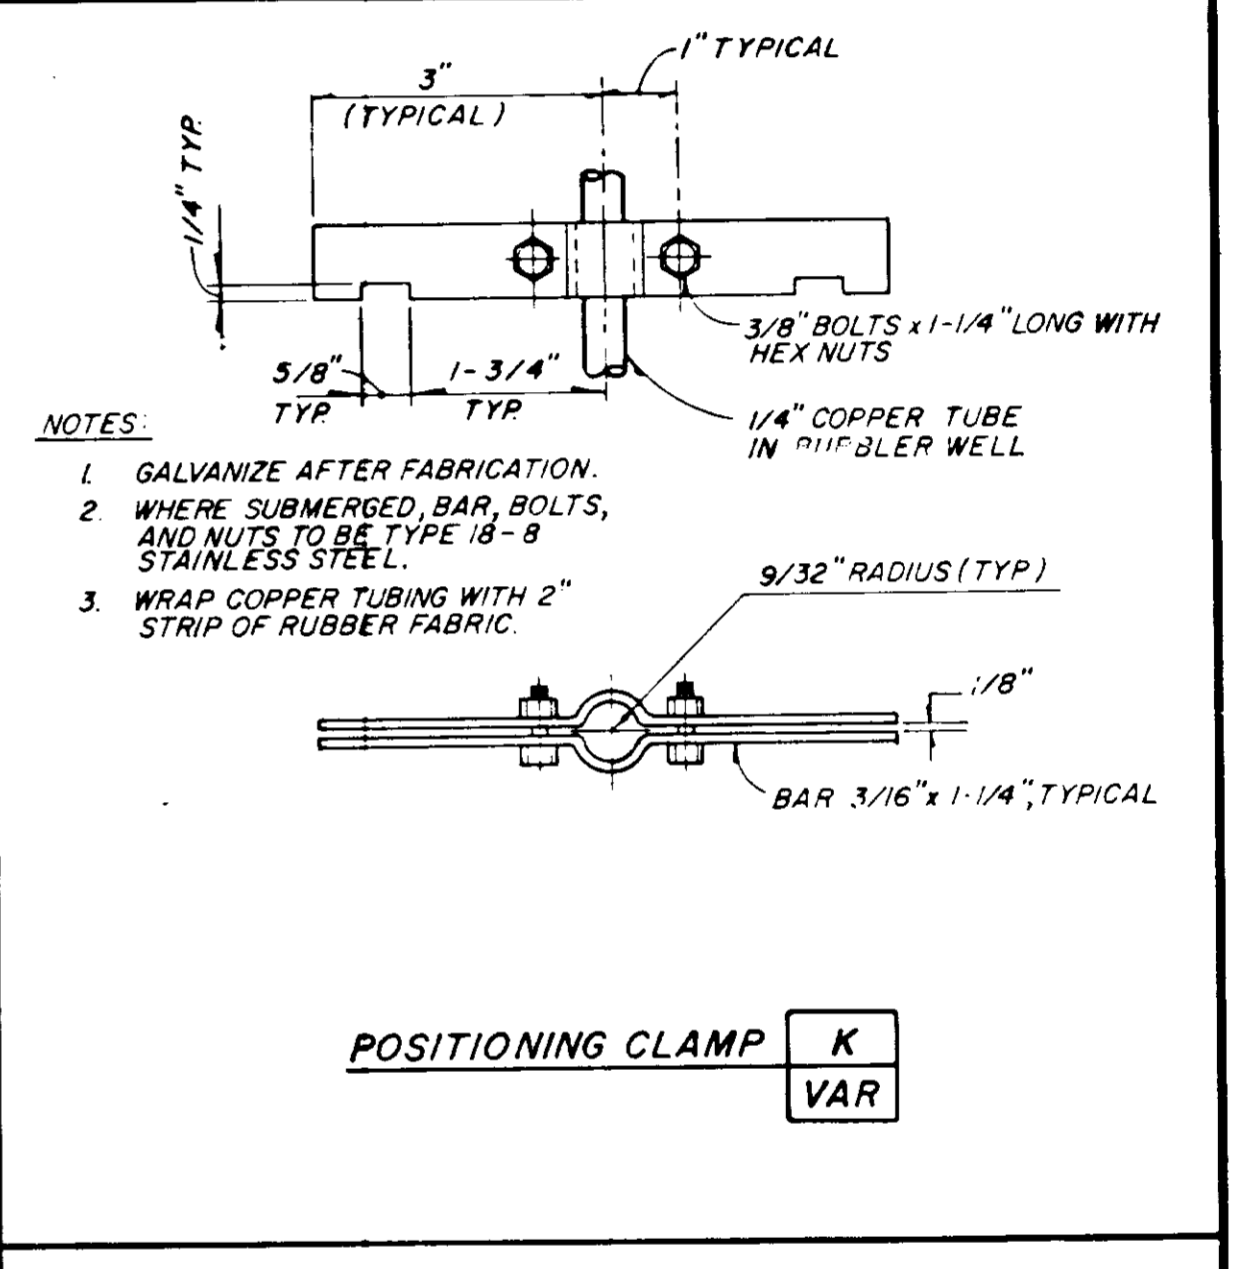


POSITIONING CLAMP **K**
VAR

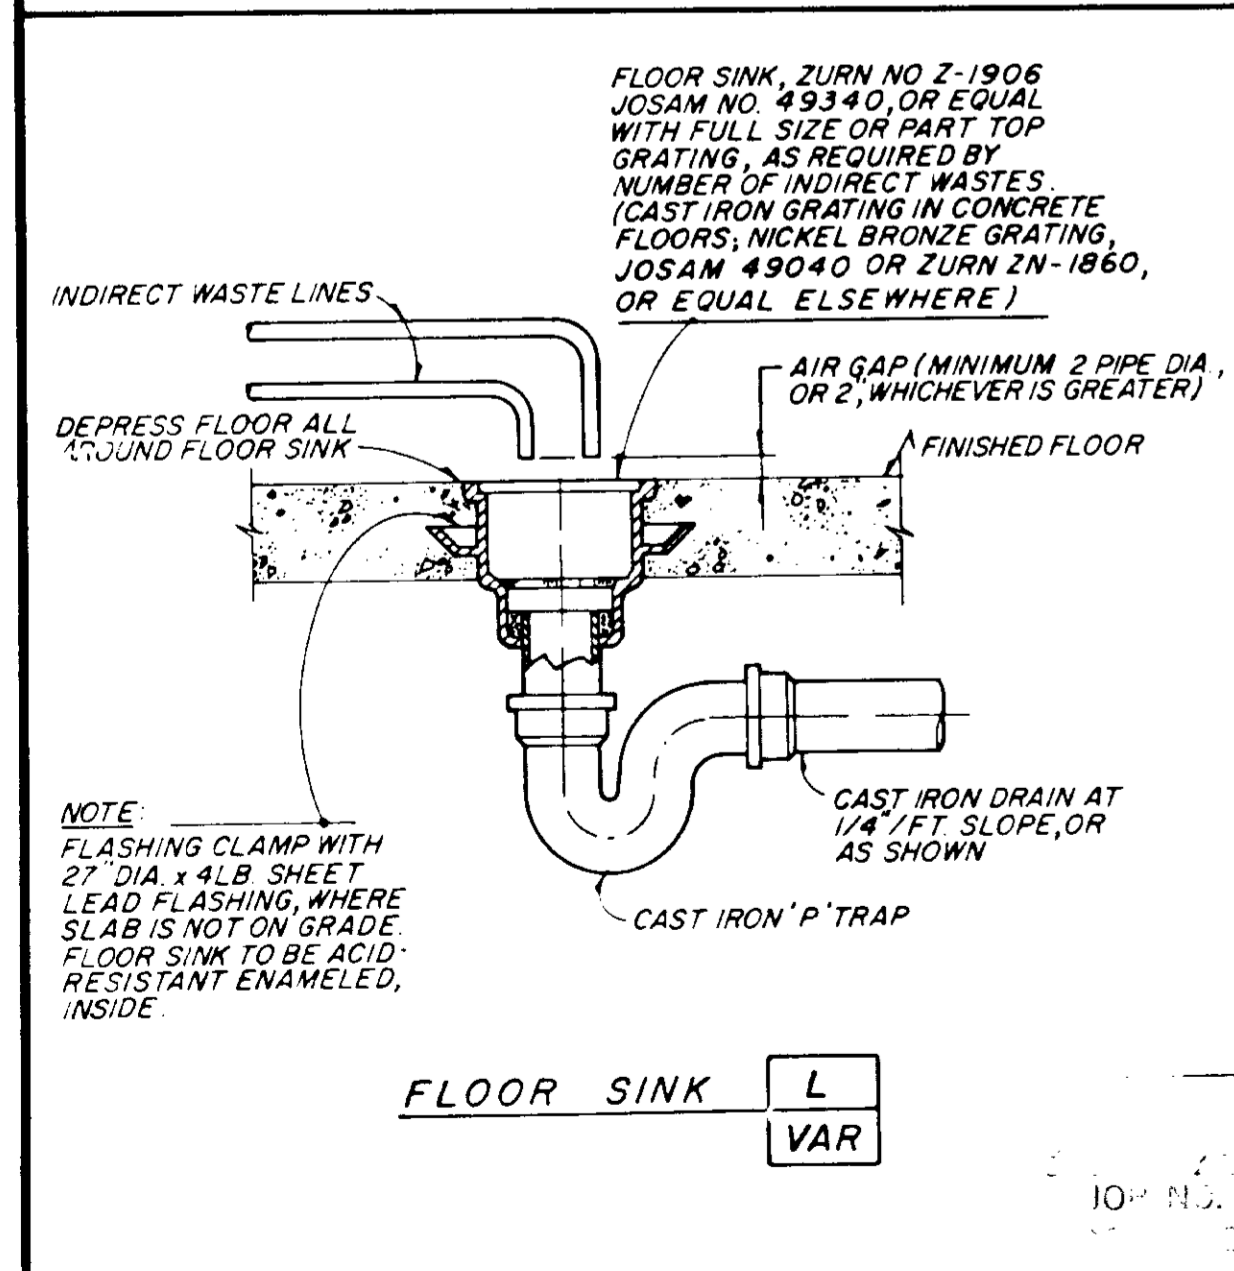


FLOOR SINK **L**
VAR

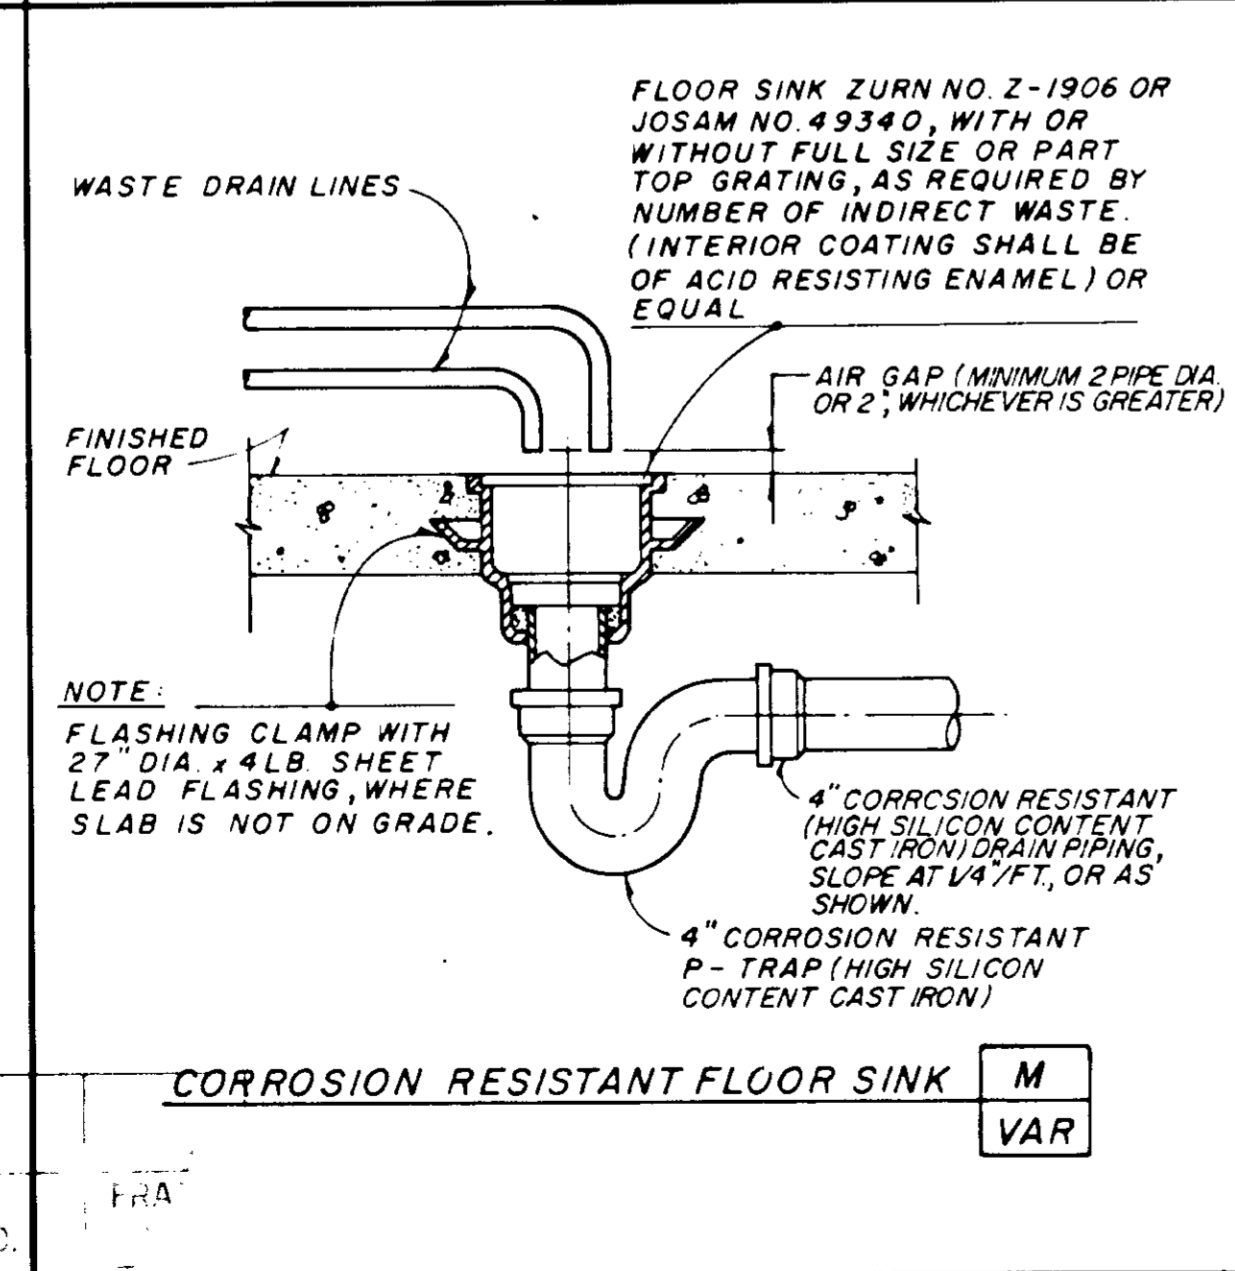


CORROSION RESISTANT FLOOR SINK **M**
VAR

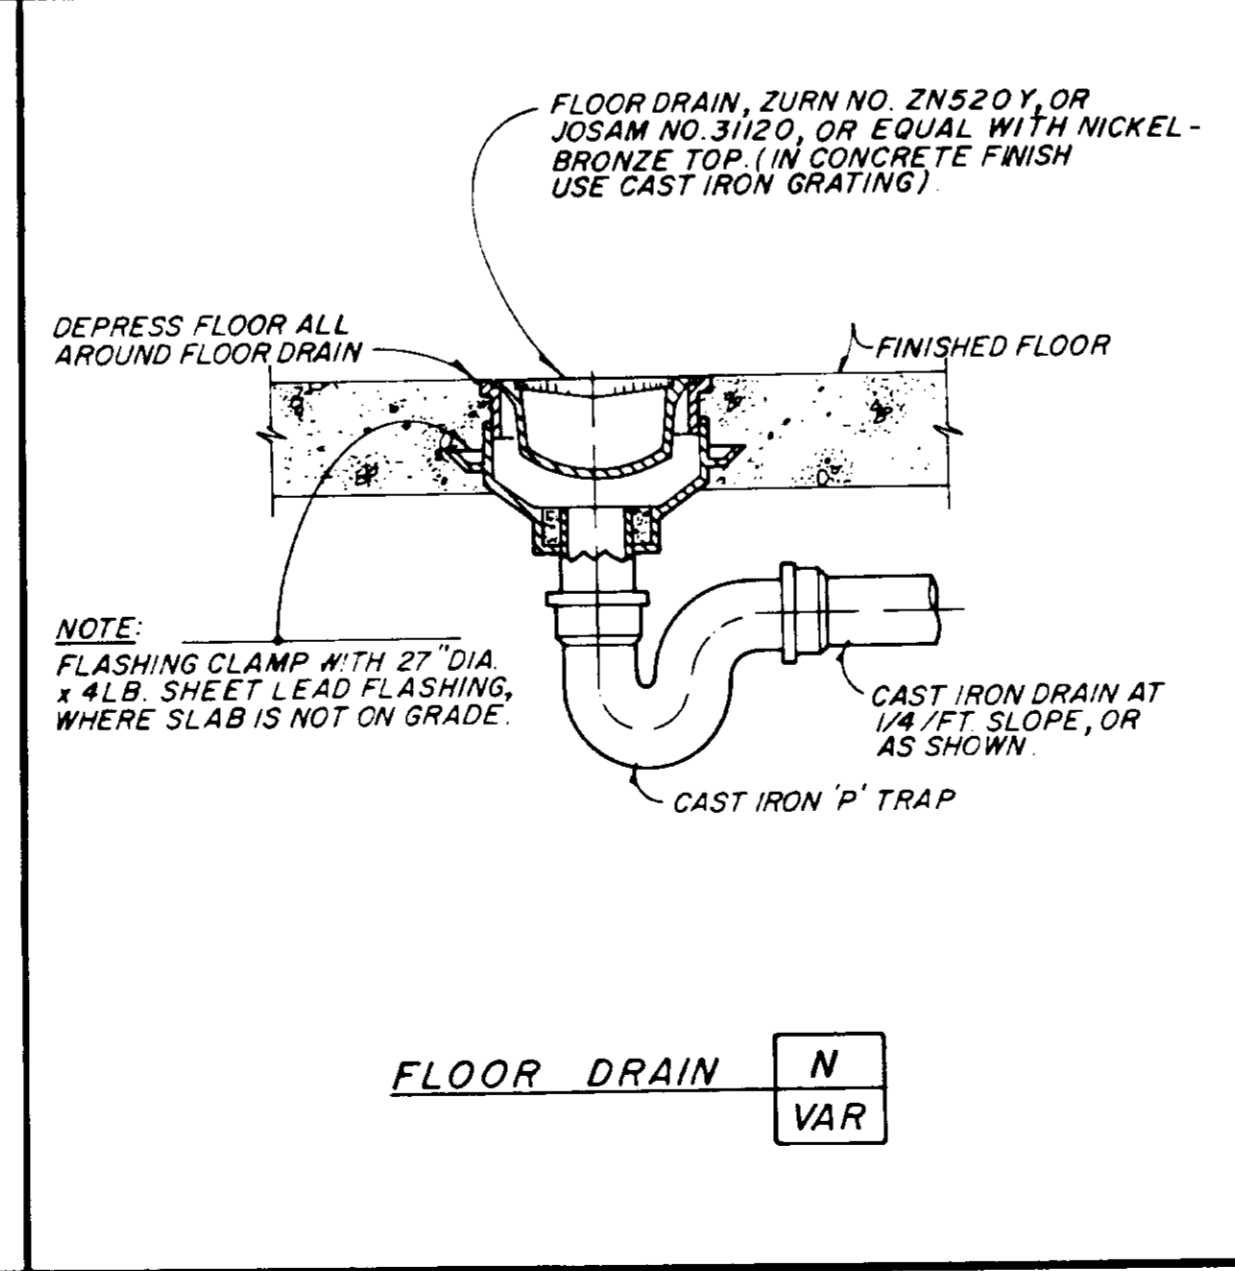

FLOOR DRAIN **N**
VAR

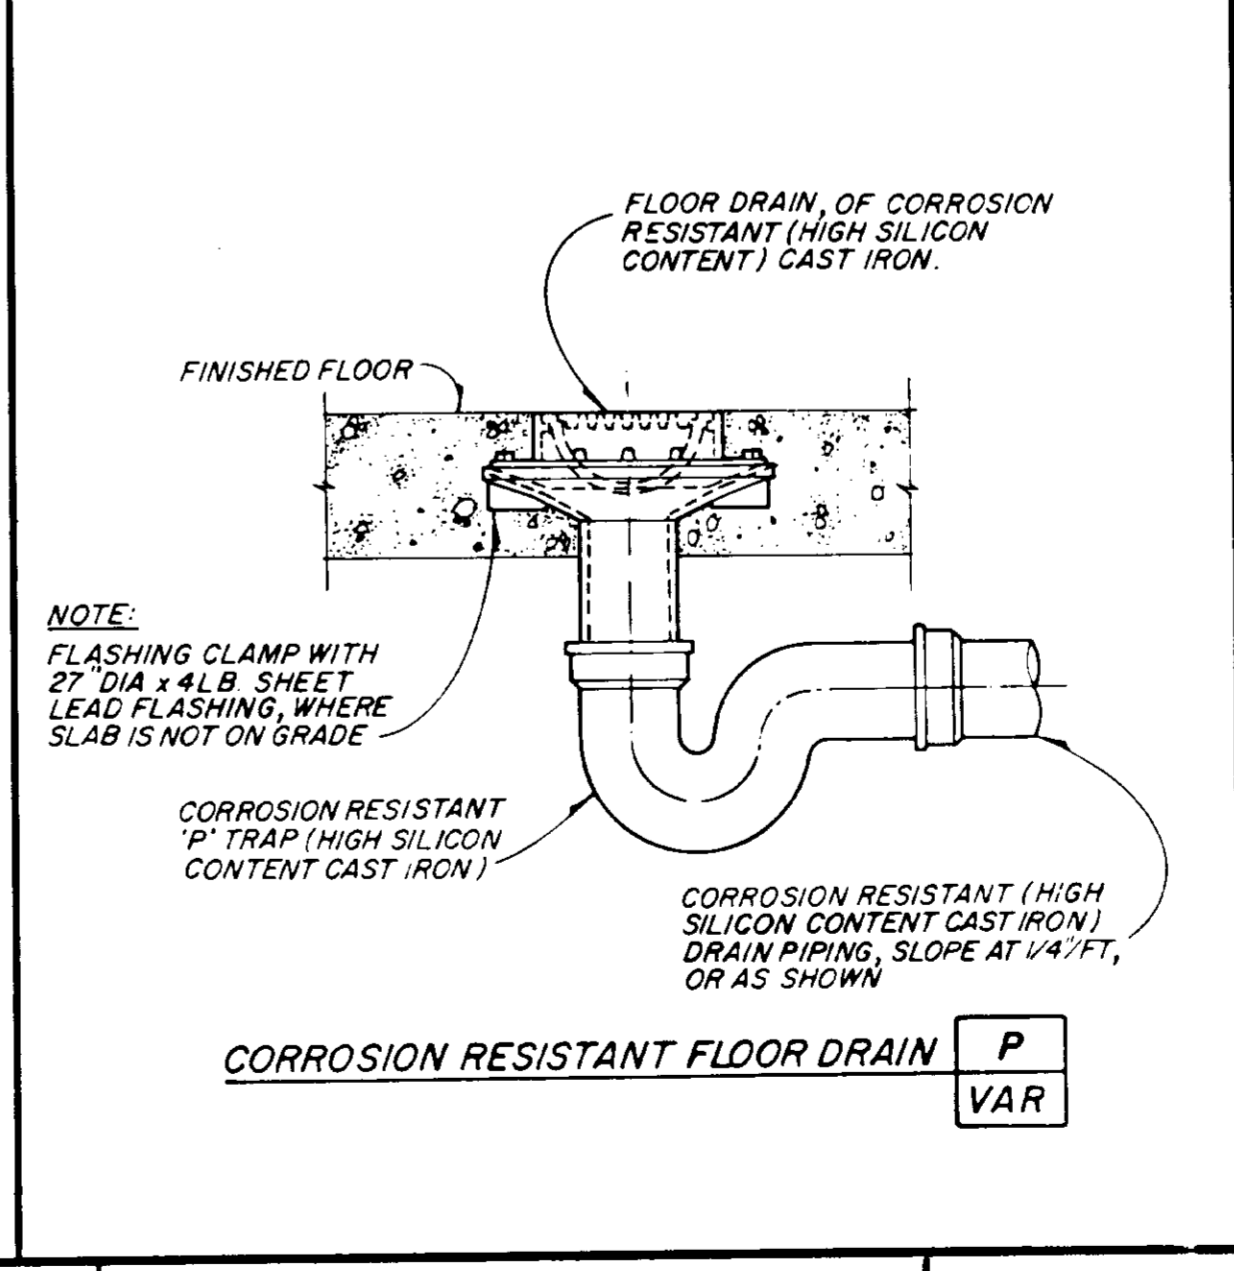

CORROSION RESISTANT FLOOR DRAIN **P**
VAR

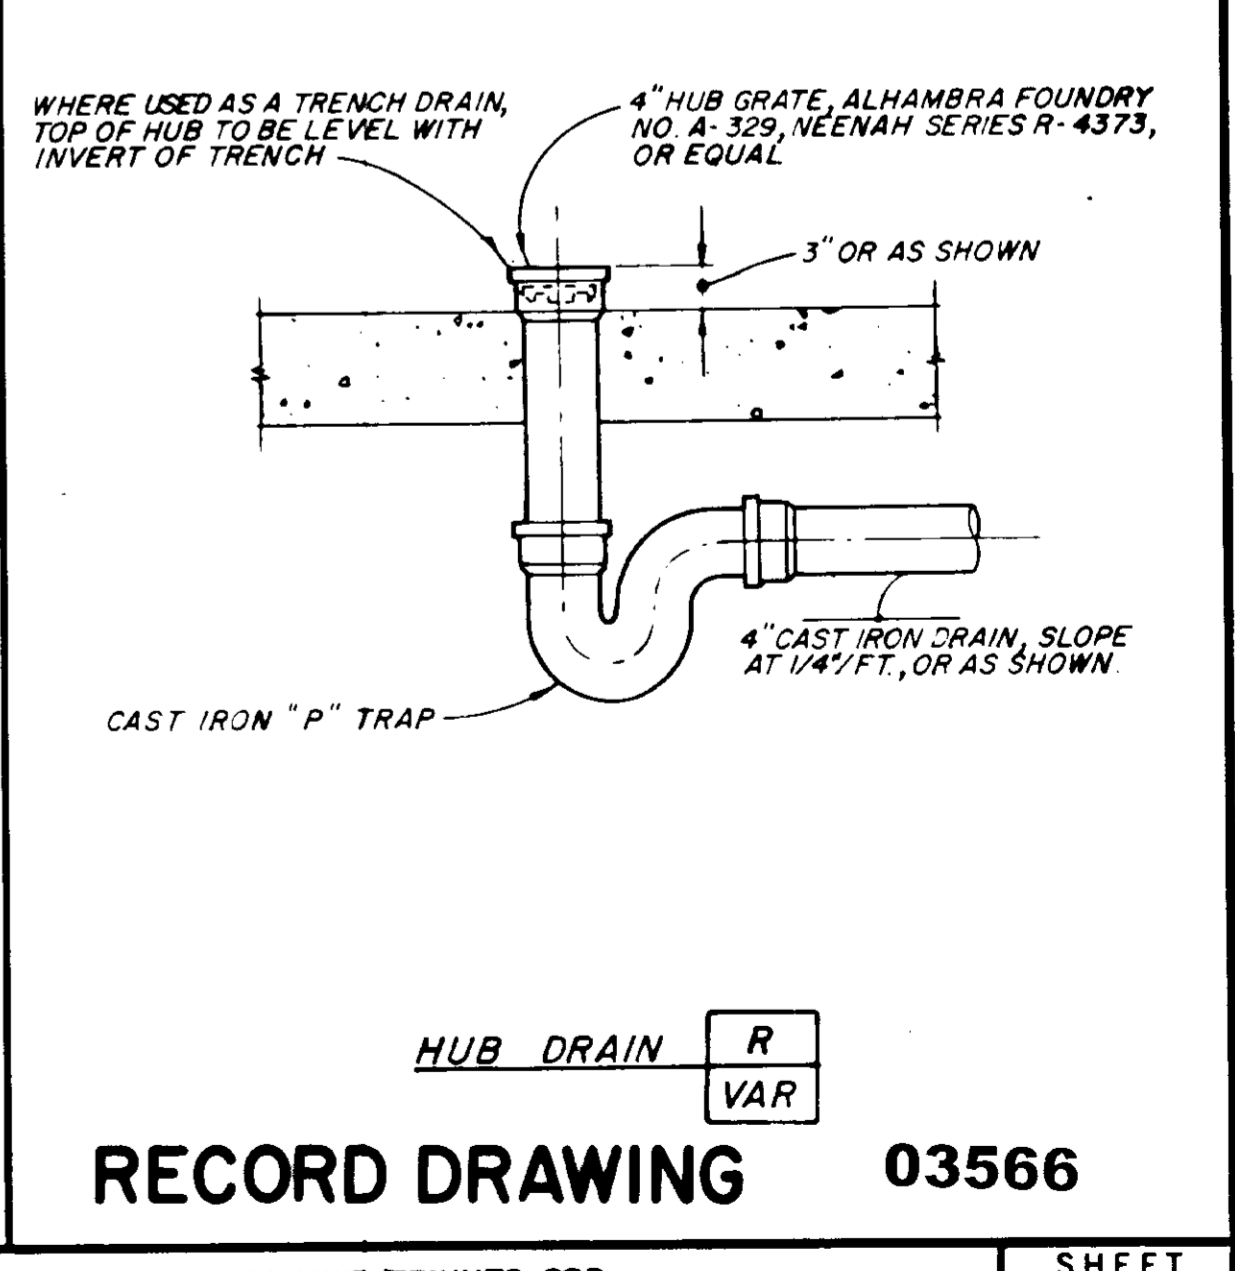

HUB DRAIN **R**
VAR

RECORD DRAWING 03566

REV	DATE	BY	DESCRIPTION

SCALE: NONE


DESIGNED	G. M.	SUBMITTED	27304	8/19/81
DRAWN	G. M.	PROJECT ENGINEER	R.C.E. NO.	DATE
CHECKED	H. M.	RECOMMENDED	27638	8/23/81
		JAMES M. MONTGOMERY CONSULTING ENGINEERS, INC.	R.C.E. NO.	DATE

JAMES M. MONTGOMERY CONSULTING ENGINEERS, INC.
355 EAST WALNUT STREET, PASADENA, CALIFORNIA 91101


DISTRICT APPROVAL ON TITLE PAGE

LAS VIRGENES MWD/TRIUNFO CSD
TAPIA WRF - FILTRATION/DISINFECTION ADDITION
PHASE II
MISCELLANEOUS MECHANICAL DETAILS - 8


SHEET M-7 OF 66 SHEETS

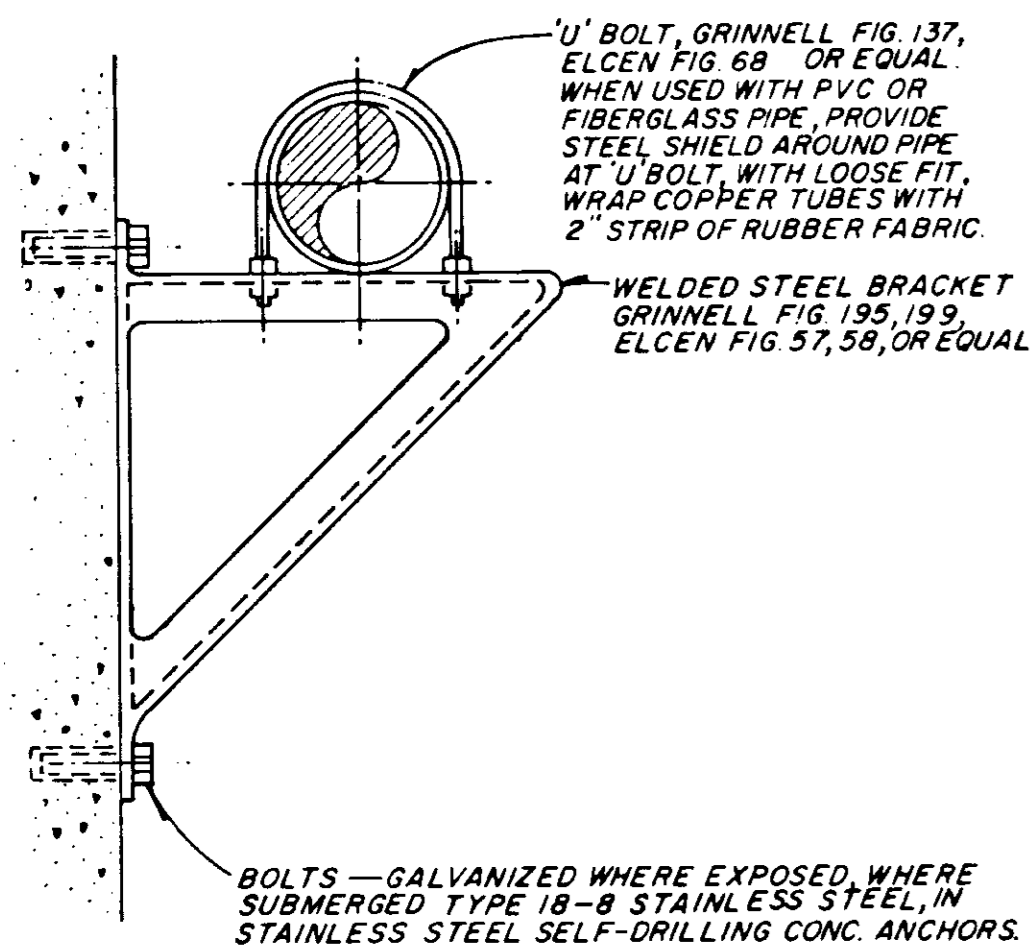


PIPE BRACKET **A**
VAR

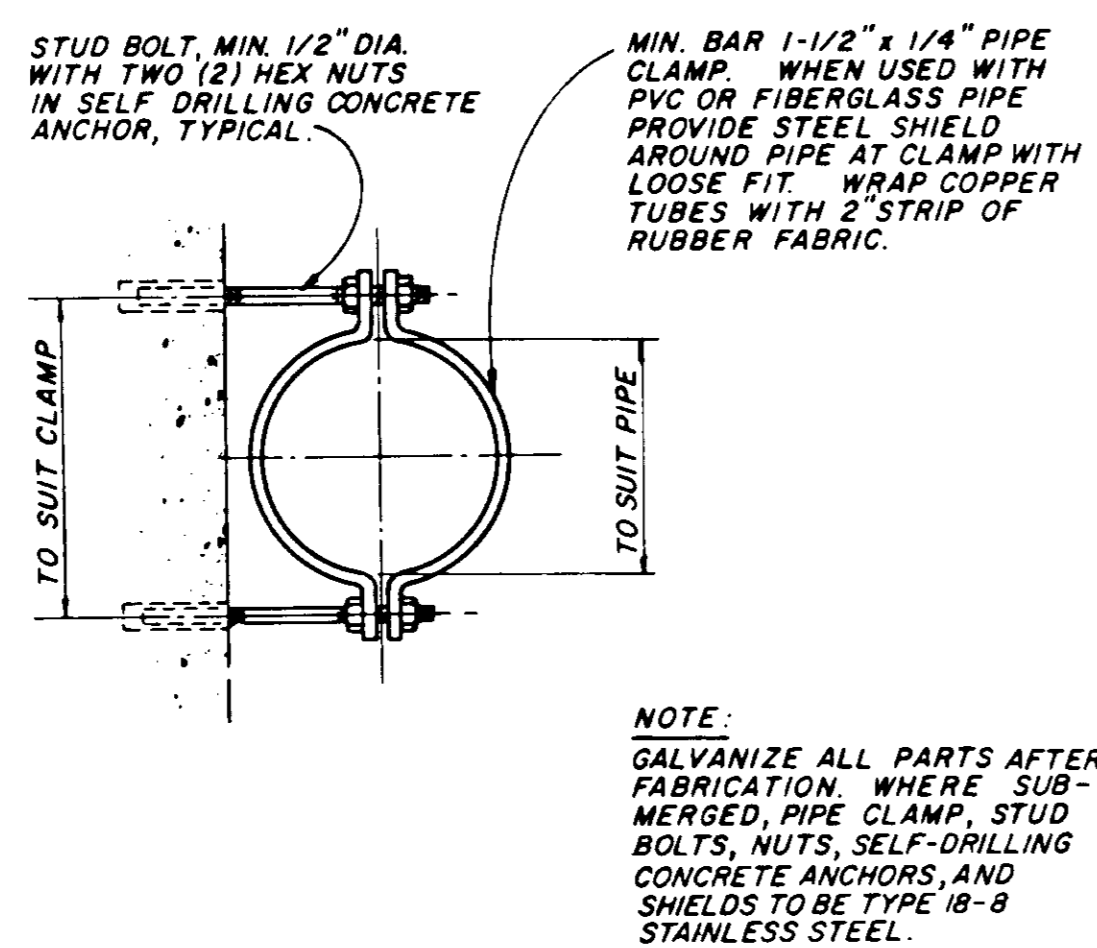

PIPE CLAMP **B**
VAR

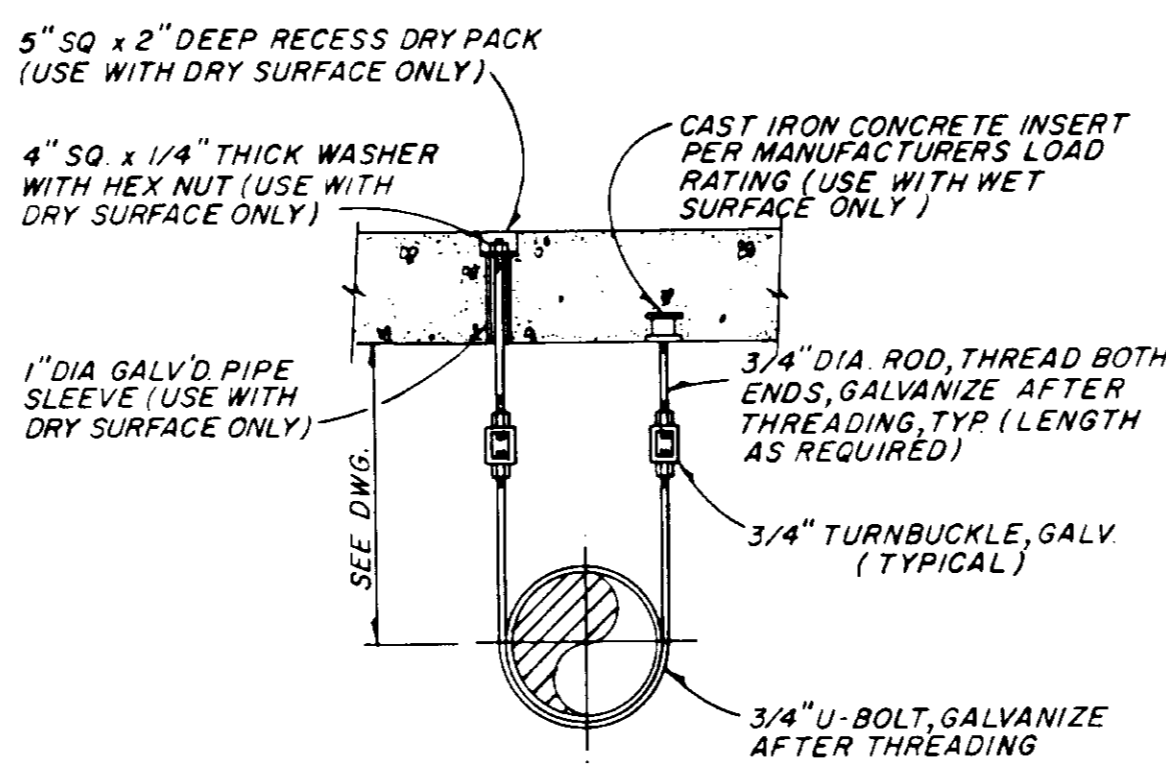


PIPE HANGER **C**
VAR

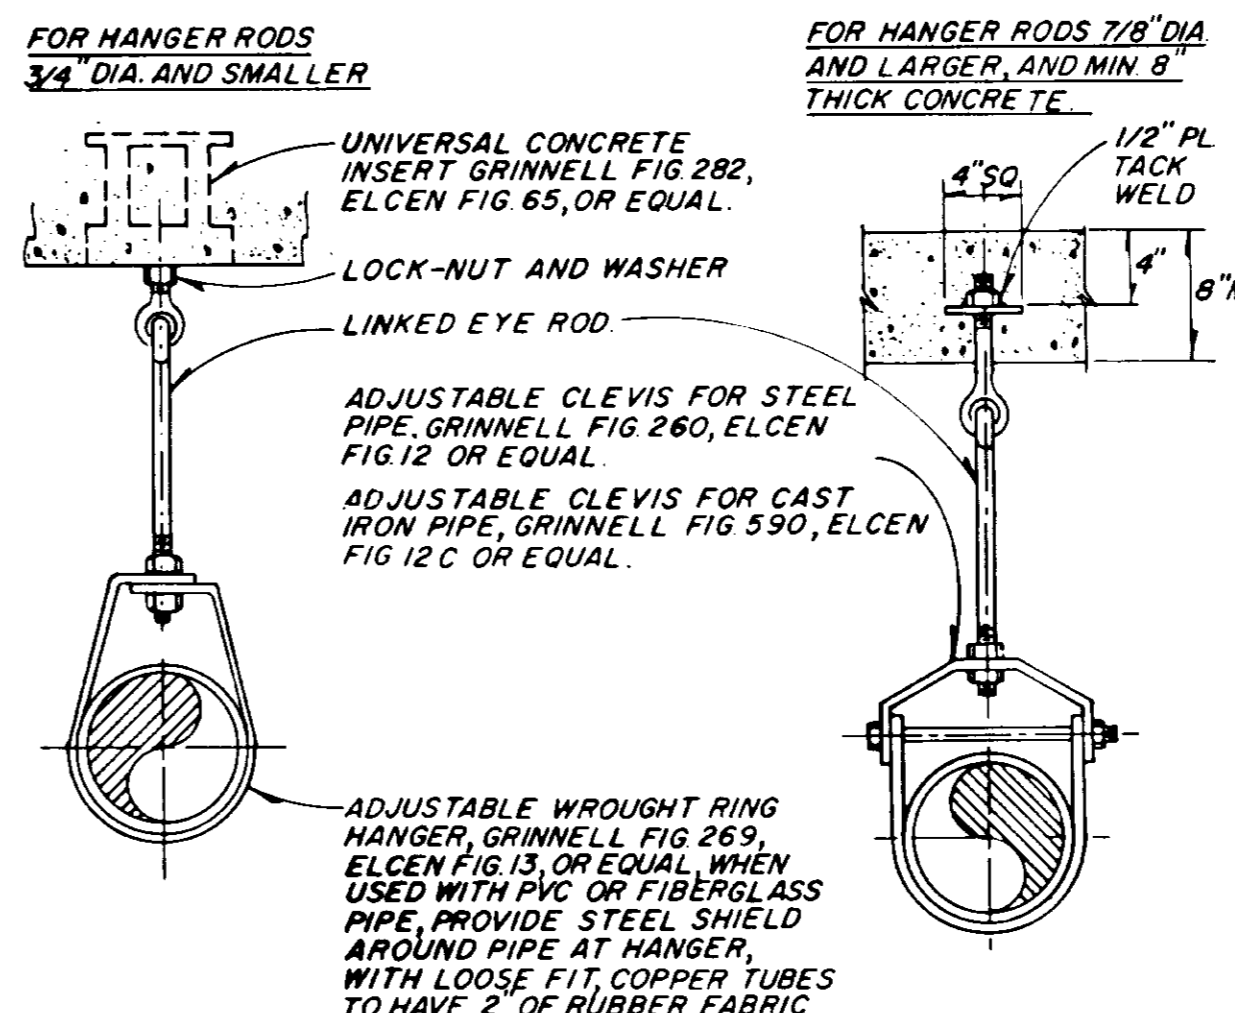


PIPE HANGER **D**
VAR

PIPE DIA (INCHES)	ROD DIA (INCHES)	MAX SUPPORT SPACING (FEET)	
		STEEL PIPE	CAST IRON PIPE
1 & SMALLER	3/8	6	5
1 1/4 TO 2	3/8	9	5
2 1/2 TO 3 1/2	1/2	12	5
4 TO 5	5/8	14	5
6, 8	3/4	16	5
10, 12	7/8	18	—
14, 16	1	20	—


NOTE: GALVANIZE ALL PARTS AFTER FABRICATION

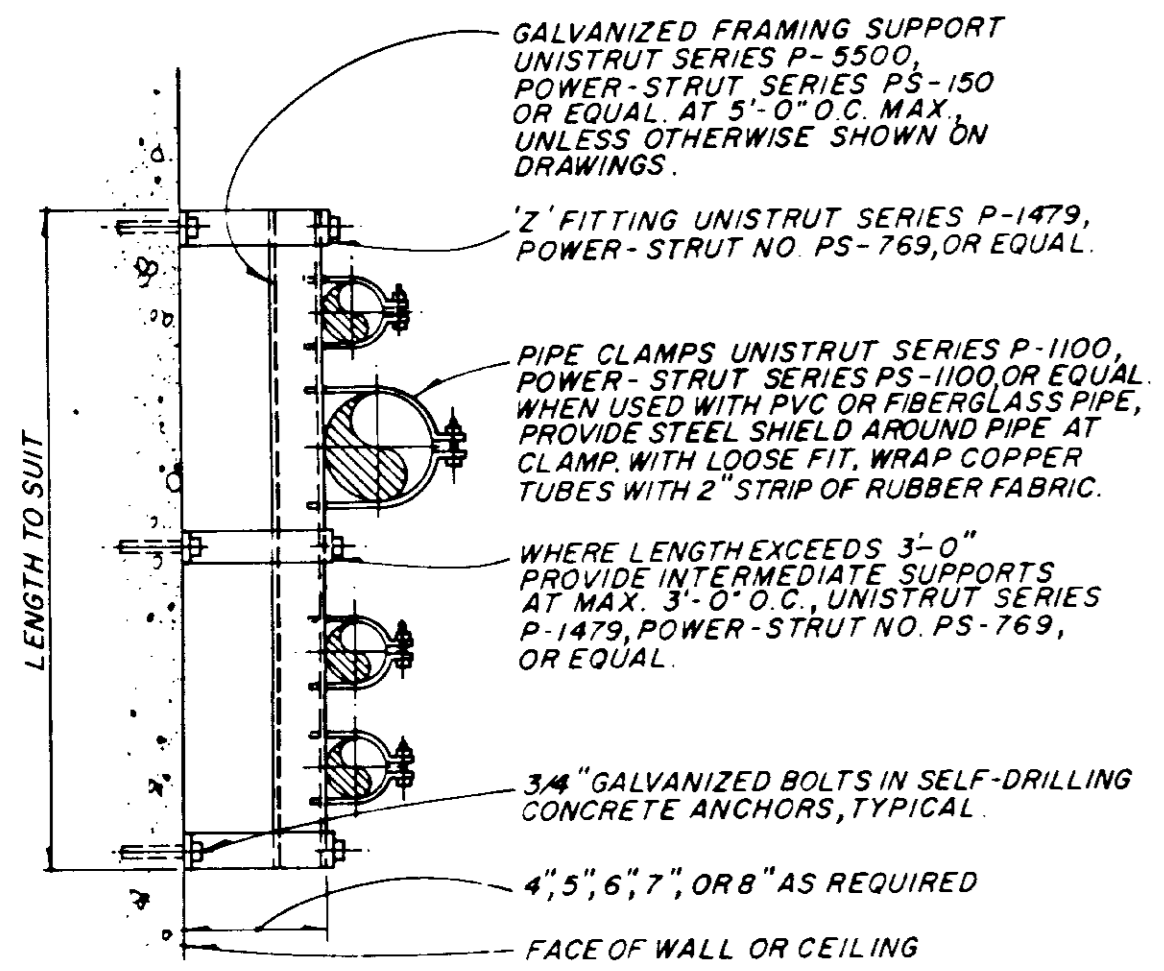


EXTENDED PIPE SUPPORT **E**
VAR

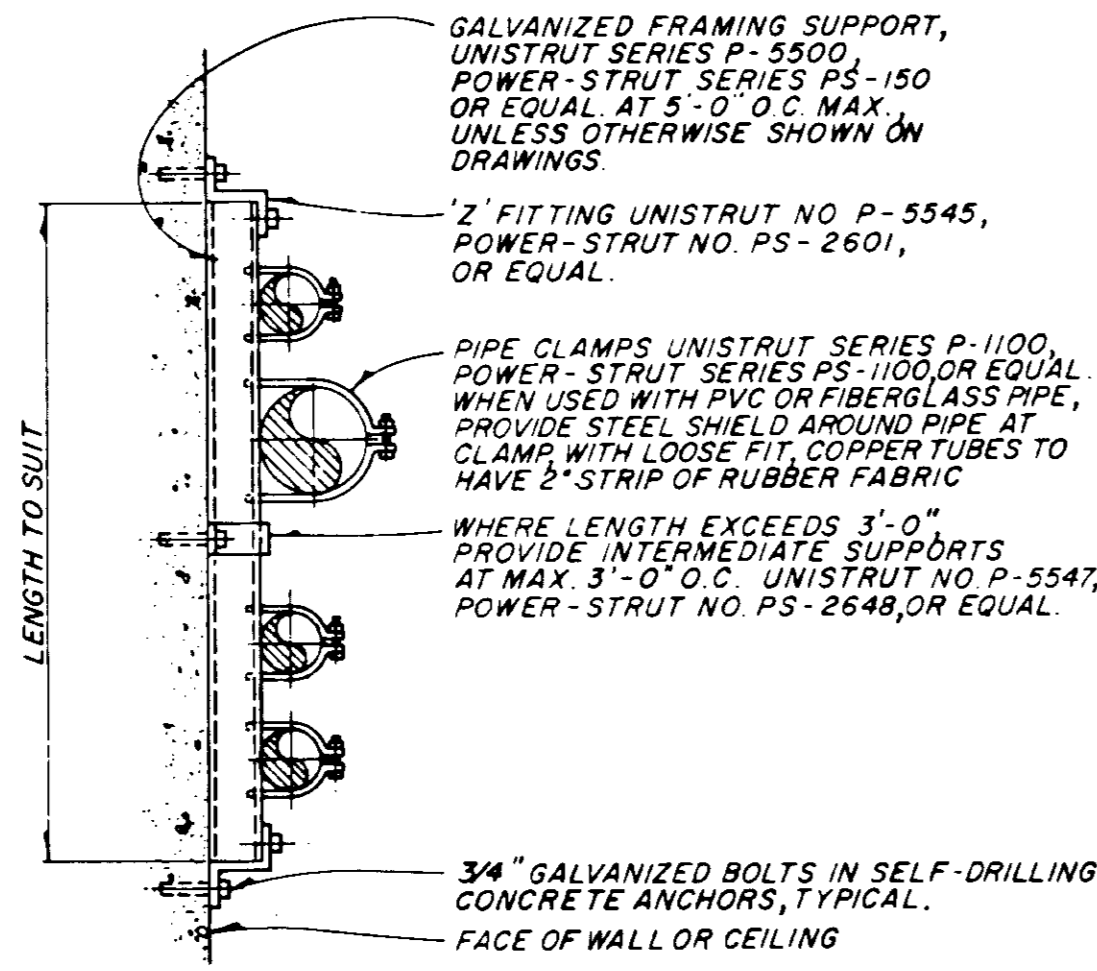

FLUSH MOUNTED PIPE SUPPORT **F**
VAR

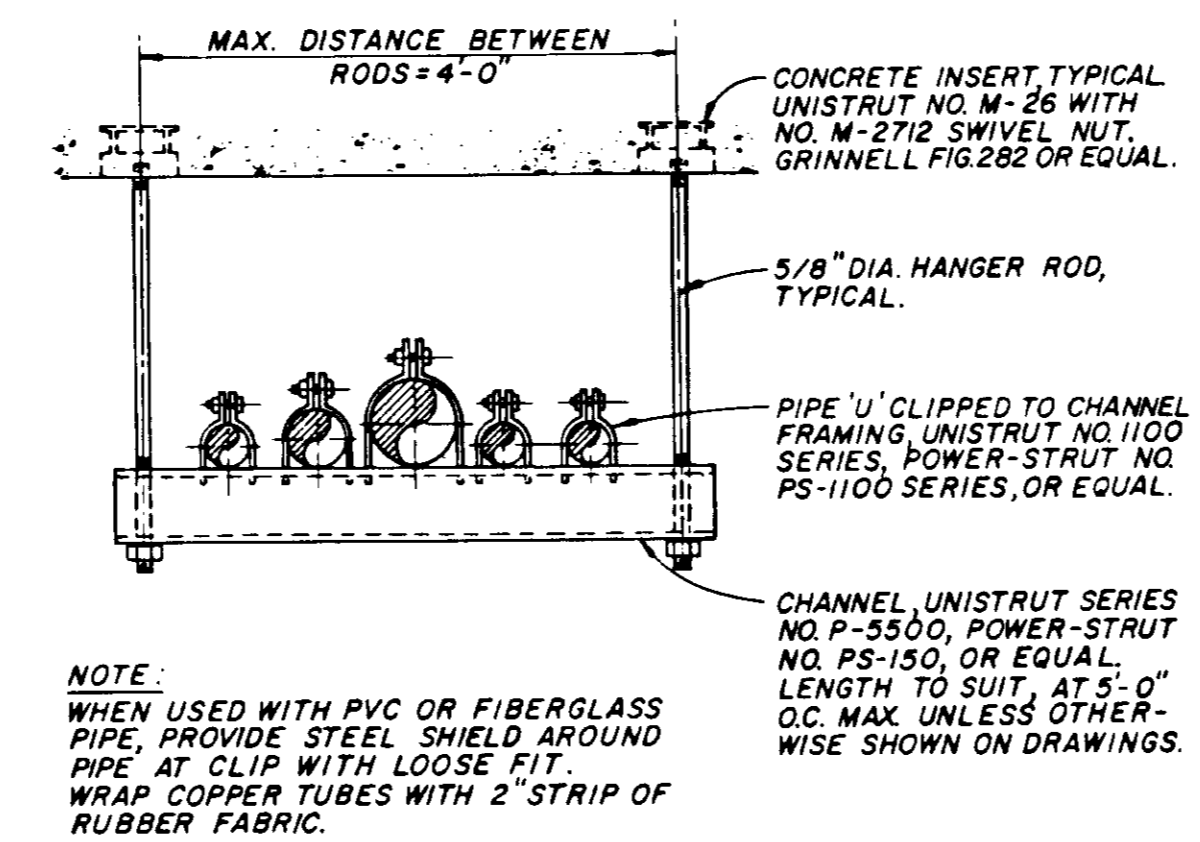


TRAPEZE PIPE HANGER **G**
VAR

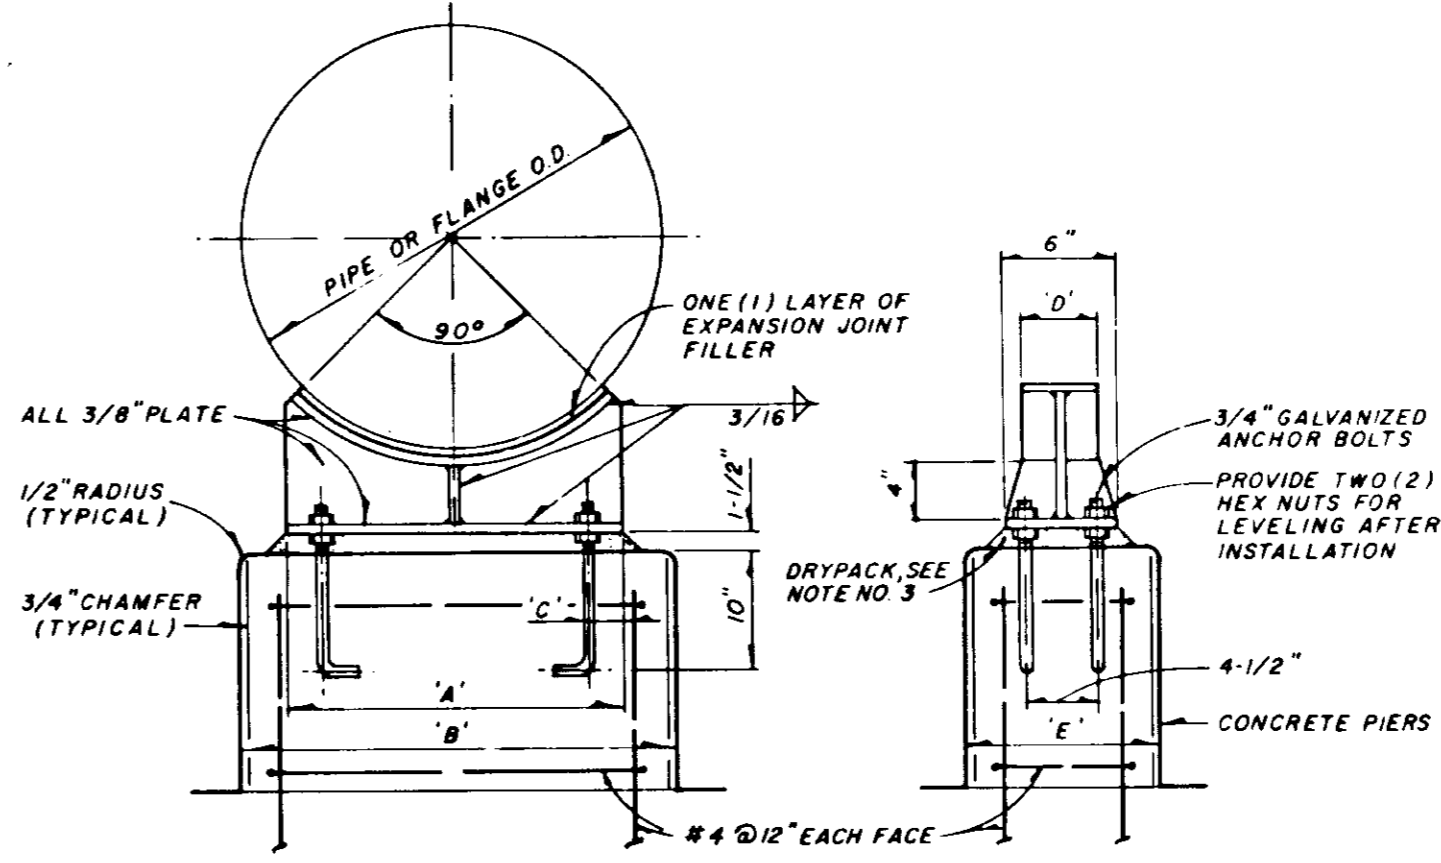


PIPE SUPPORT **H**
VAR

NOMINAL PIPE SIZE	SUPPORTING PIPE OR FLANGE				SUPPORTING PIPE FLANGE			
	C	D	E	A	B	A	B	
6	2	4	12	10	16	10	16	
8 & 10	2	4	12	10	16	14	20	
12 & 14	2	4	12	12	18	16	22	
16 & 18	2	4	12	14	20	20	26	
20 & 22	3	5	12	16	22	22	28	
24	3	5	12	18	24	24	30	
26	4	5	12	20	26	26	32	
30	4	5	12	24	30	30	36	
34	4	5	15	26	32	34	40	
36	5	6	15	28	34	36	42	
42	5	6	18	32	36	40	46	
48	6	6	18	38	42	44	50	
54	6	6	18	42	48	50	56	
60	6	6	18	46	52	54	60	

NOTES:
1 WHEN SUPPORTING ON THE SAME LINE ALTERNATIVELY PIPE AND FLANGE, CONCRETE PIERS FOR PIPE SUPPORTS SHALL ALL HAVE THE SAME DIMENSION (B) FOR FLANGE SUPPORT.
2 PIPE SUPPORTS TO BE LOCATED IN PLAN AT POINTS MARKED THUS (X)
3 DRYPACK 1-1/2" SPACE WITH CEMENT MORTAR WHERE DIFFERENTIAL SETTLEMENT IS LIKELY TO OCCUR, OMIT AS DIRECTED BY THE ENGINEER.
4 GALVANIZE AFTER FABRICATION

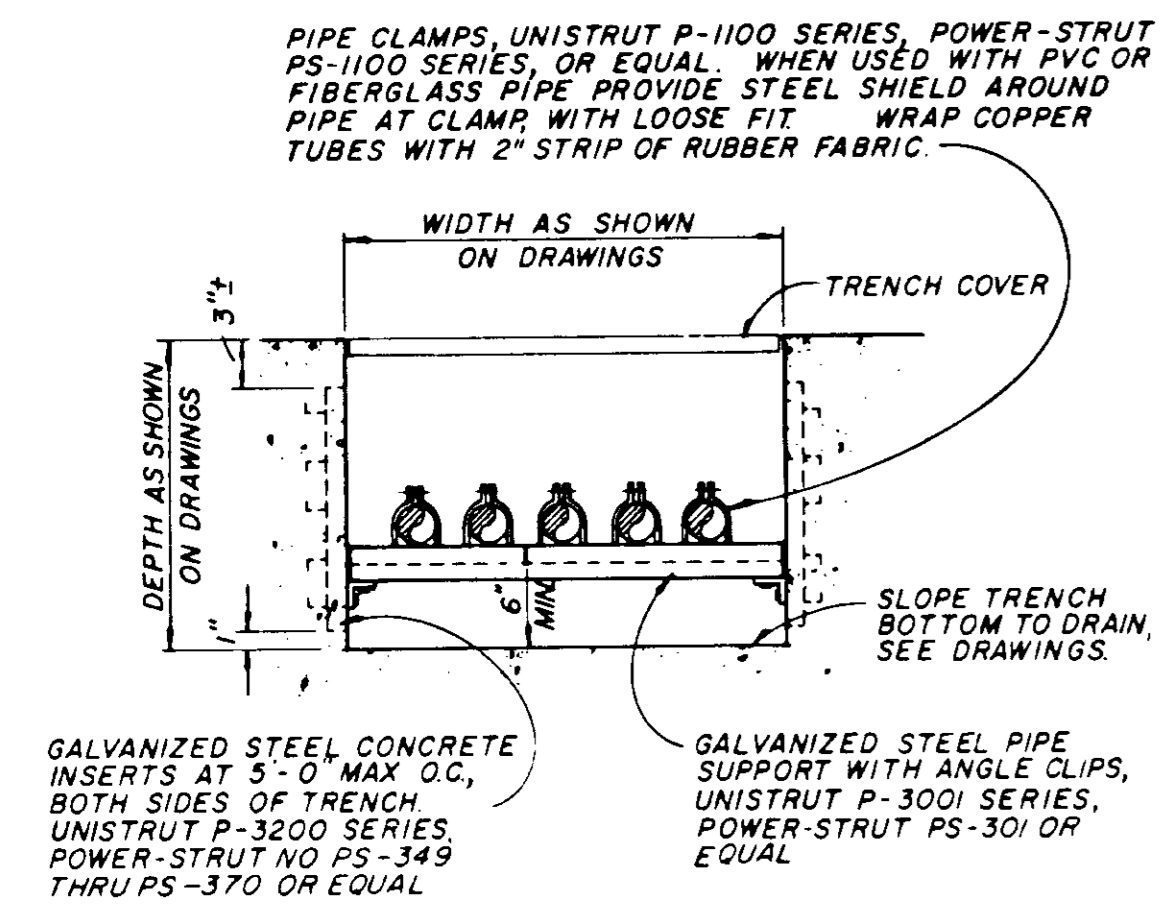


PIPE TRENCH **J**
VAR

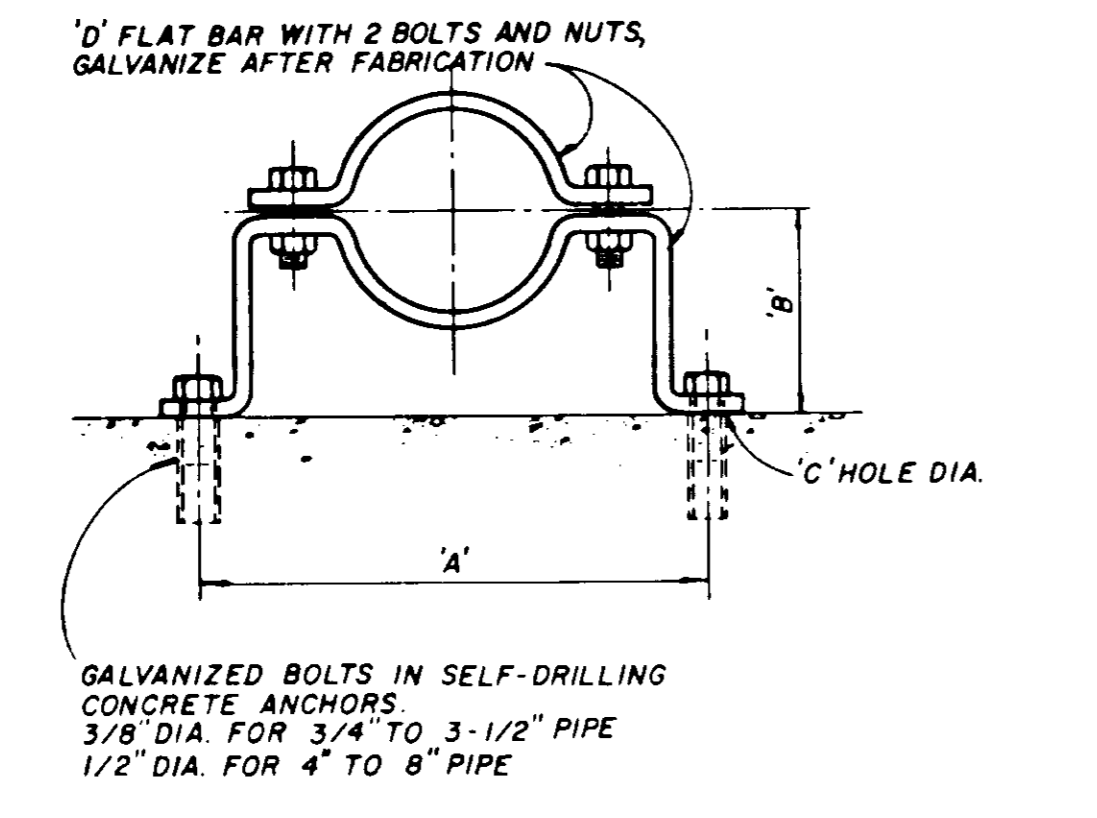

PIPE CLAMP FOR INDIVIDUAL PIPES **K**
VAR

PIPE DIA.	DIMENSIONS IN INCHES				LOAD RATING LBS.*
	'A'	'B'	'C' HOLE DIA.	'D' FLAT BAR SIZE	
3/4	5-15/16	2-1/2	7/16	3/16 x 1-1/4	300
1	6-1/4	2-5/8	7/16	3/16 x 1-1/4	300
1-1/4	6-11/16	2-3/4	7/16	3/16 x 1-1/4	300
1-1/2	6-15/16	3	7/16	3/16 x 1-1/4	300
2	8-5/16	3-3/16	7/16	1/4 x 1-1/4	500
2-1/2	8-7/8	3-7/16	7/16	1/4 x 1-1/4	500
3	9-1/8	3-3/4	7/16	1/4 x 1-1/4	500
3-1/2	10-1/16	4	7/16	1/4 x 1-1/4	500
4	10-9/16	4-1/4	9/16	1/4 x 1-1/2	600
5	11-3/4	4-3/4	9/16	1/4 x 1-1/2	600
6	14-3/8	5-5/16	9/16	3/8 x 1-1/2	850
8	16-5/8	6-5/16	9/16	3/8 x 1-1/2	850

NOTES:
WHERE SUBMERGED, PIPE CLAMP, BOLTS AND NUTS TO BE TYPE 18-8 STAINLESS STEEL.
WHEN USED WITH PVC OR FIBERGLASS PIPE PROVIDE STEEL SHIELD AROUND PIPE AT CLAMP WITH LOOSE FIT. WRAP COPPER TUBES WITH 2" STRIP OF RUBBER FABRIC.
FOR FLANGED PIPING INCREASE 'B' DIMENSION AS REQUIRED.

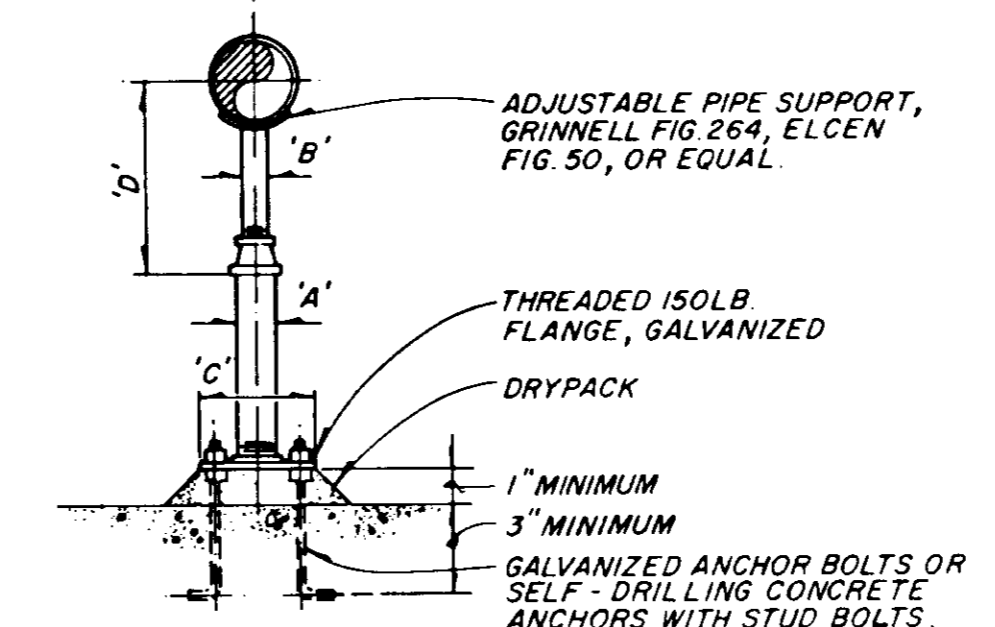

ADJUSTABLE PIPE SUPPORT **L**
VAR

PIPE SIZE	ADJUSTABLE PIPE SUPPORT APPROXIMATE DIMENSIONS IN INCHES				
	A	B	C	D MINIMUM	D MAXIMUM
2-1/2	2-1/2	1-1/2	9	8	11-1/2
3	2-1/2	1-1/2	9	8-1/4	11-3/4
3-1/2	2-1/2	1-1/2	9	8-1/2	12
4	3	2-1/2	9	10-1/4	14
6	3	2-1/2	9	11-5/8	15-1/4
8	3	2-1/2	9	13-5/8	16-1/2
10	3	2-1/2	9	14-5/8	18-1/4
12	3	2-1/2	9	15-5/8	19-3/4
14	4	3	11	18-7/8	20-3/4
16	4	3	11	19-7/8	22-1/4
18	6	3-1/2	13-1/2	21-1/4	24
20	6	3-1/2	13-1/2	23-1/4	25-1/2
24	6	4	13-1/2	26-1/2	28-1/4
30	6	4	13-1/2	29-5/8	31-1/2
32	6	4	13-1/2	30-5/8	32-3/4
36	6	4	13-1/2	32-5/8	34-3/4

JOB NO. IDENT. NO.	FRAME
SCALE: NONE	
DESIGNED: G. M.	
DRAWN: G. M.	
CHECKED: H. M.	


SUBMITTED: 27304	DATE: 9/19/81
PROJECT ENGINEER: G. M.	
RECOMMENDED: H. M.	
JAMES M. MONTGOMERY CONSULTING ENGINEERS, INC.	

JAMES M. MONTGOMERY CONSULTING ENGINEERS, INC.
355 EAST WALNUT STREET, PASADENA, CALIFORNIA 91101


DISTRICT APPROVAL ON TITLE PAGE

LAS VIRGENES MWD/TRIUNFO CSD	SHEET
TAPIA WRF - FILTRATION/DISINFECTION ADDITION	M-8
PHASE II	MISCELLANEOUS MECHANICAL DETAILS - C
	OF 66 SHEETS


RECORD DRAWING 03567

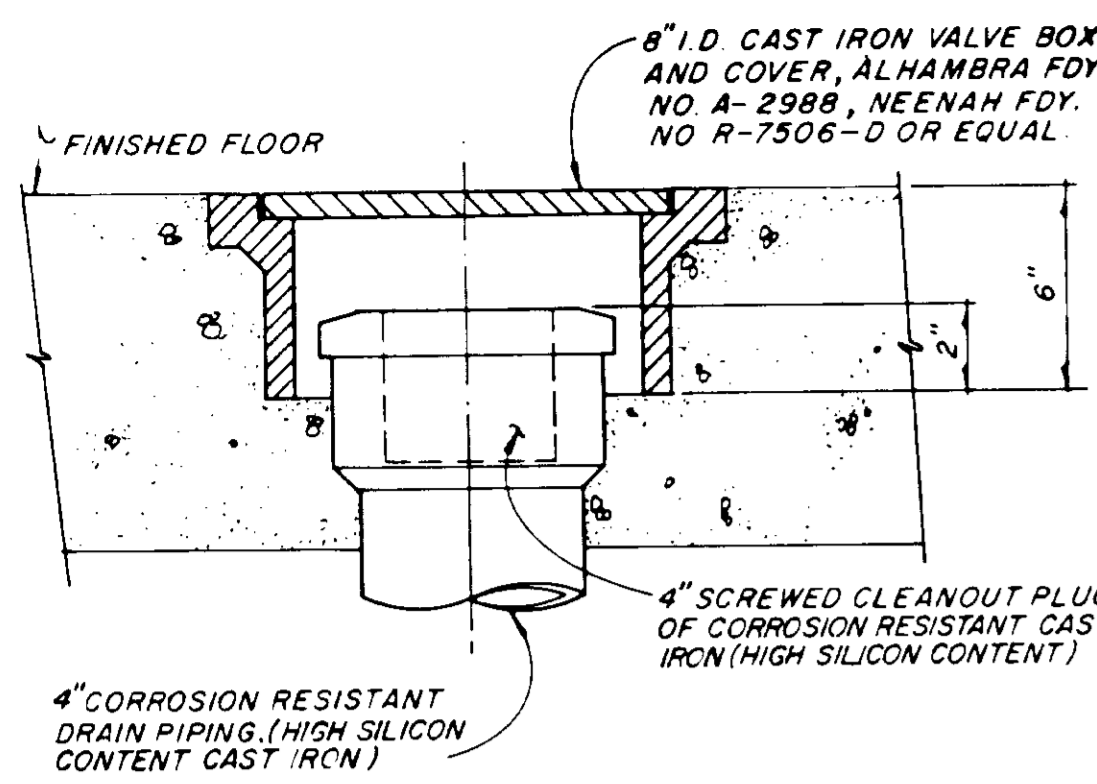


CORROSION RESISTANT CLEANOUT IN FINISHED FLOOR A
VAR

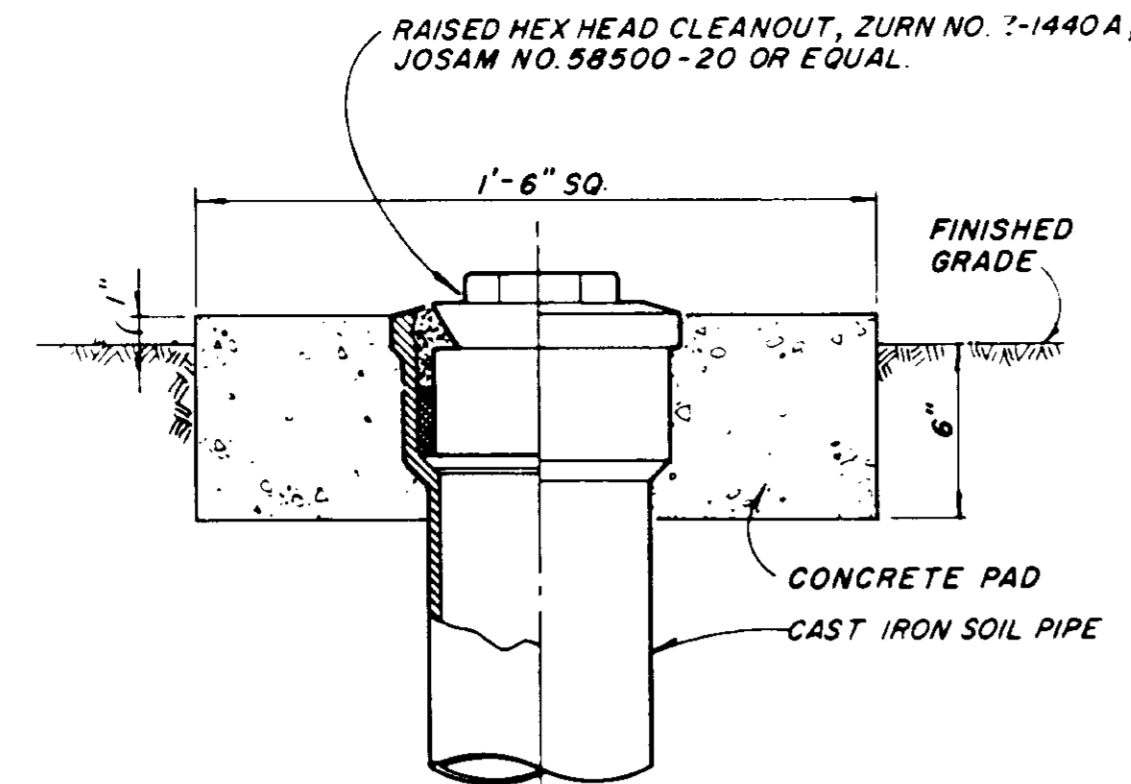


CLEANOUT TO GRADE B
VAR

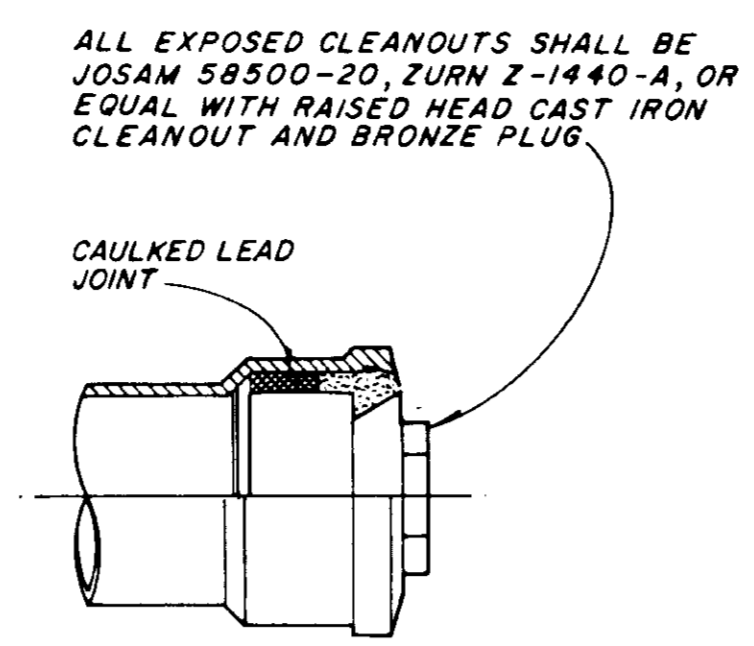

EXPOSED CLEANOUT C
VAR

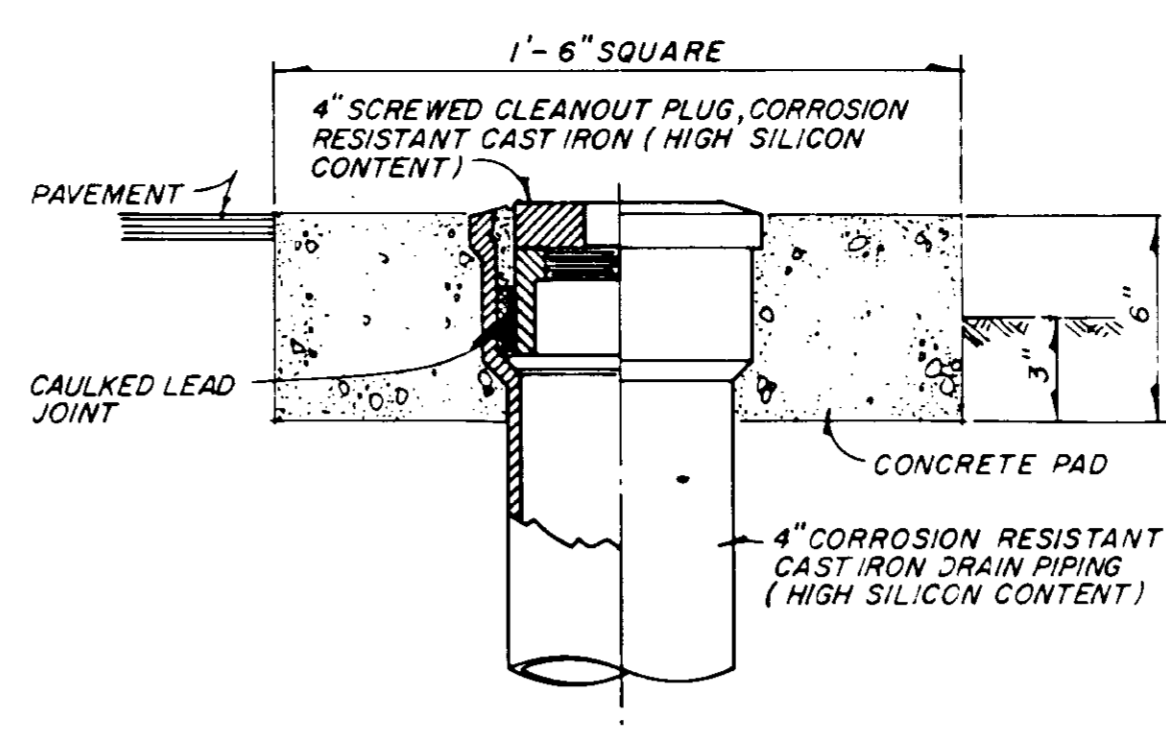


CORROSION RESISTANT CLEANOUT TO GRADE D
VAR

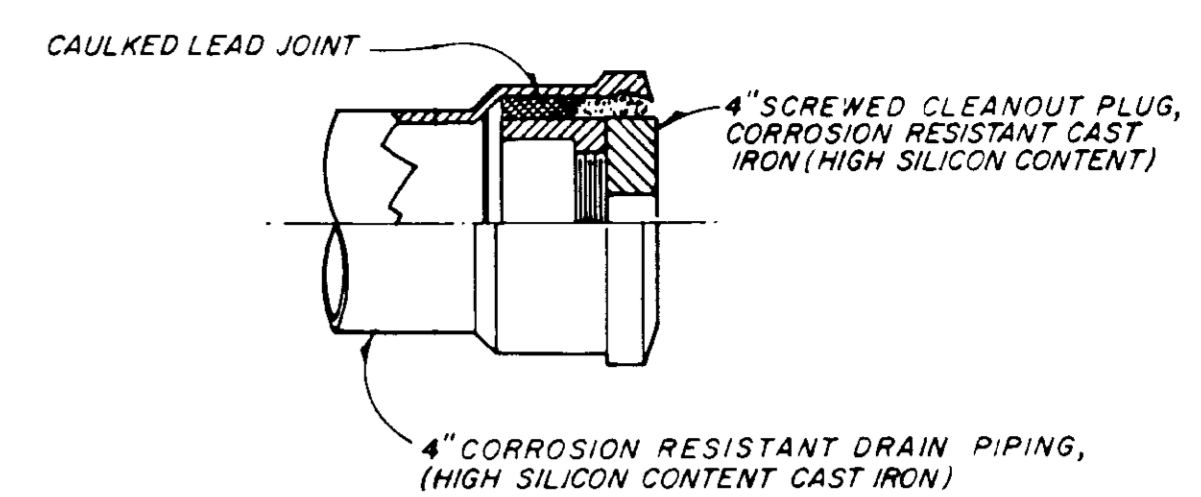


CORROSION RESISTANT CLEANOUT E
VAR


NOTE: THIS SLEEVE IS TO BE USED BETWEEN DRY SPACES, ONLY.

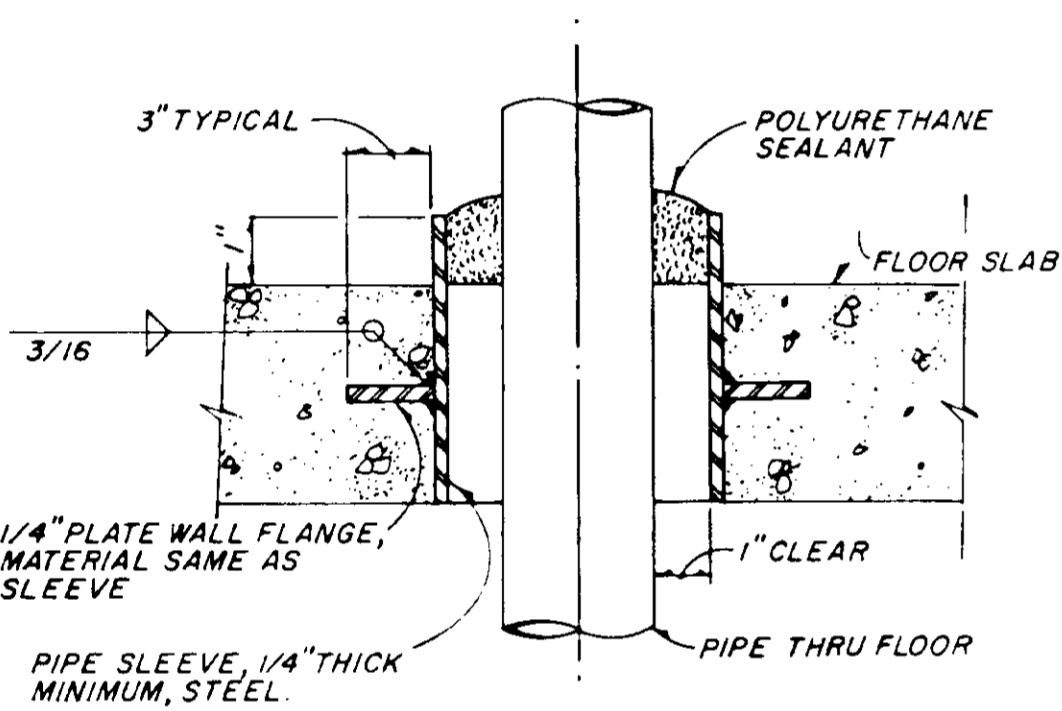


FLOOR PIPE SLEEVE F
VAR

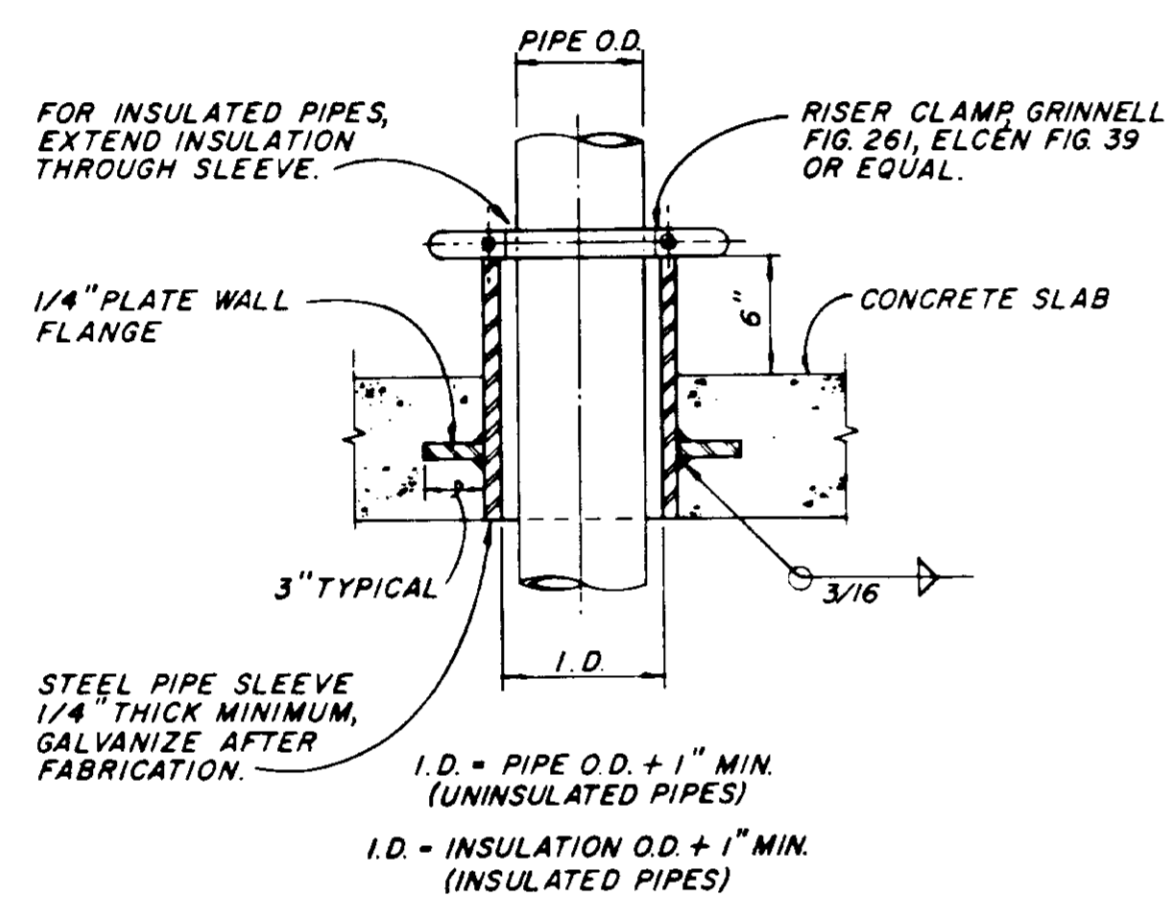


VERTICAL PIPE SUPPORT SLEEVE G
VAR

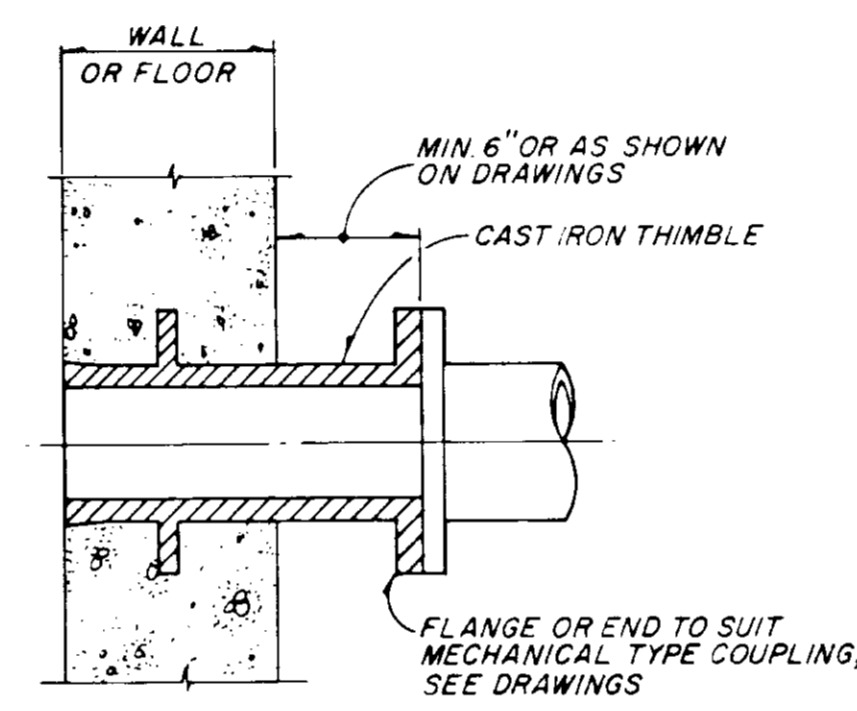


FLANGED (OR GROOVED) AND SPIGOT CAST IRON THIMBLE H
VAR

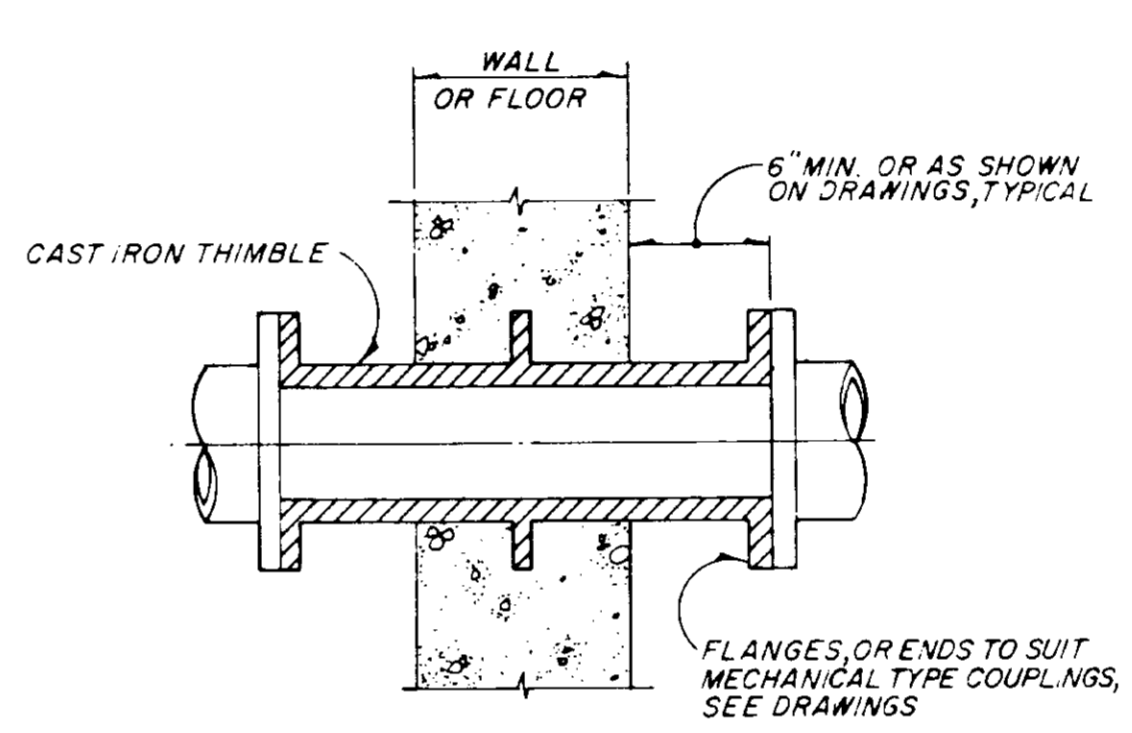


FLANGED OR GROOVED CAST IRON THIMBLE J
VAR

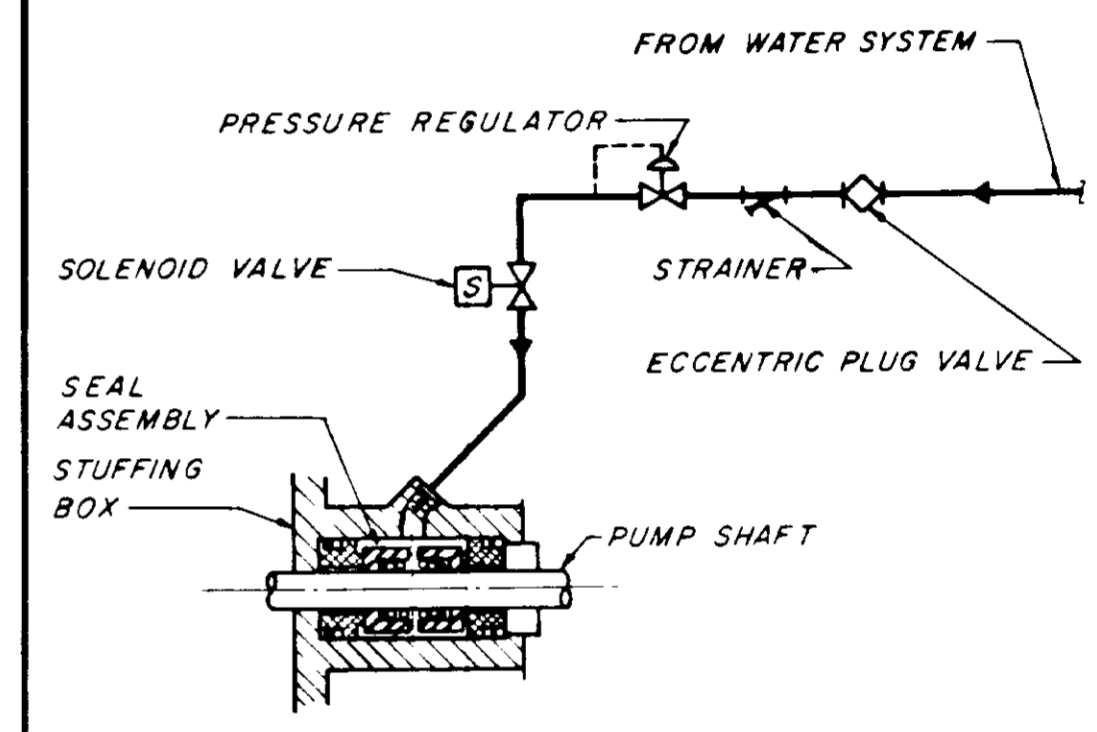


WATER FLUSHED PUMP SEAL K
VAR

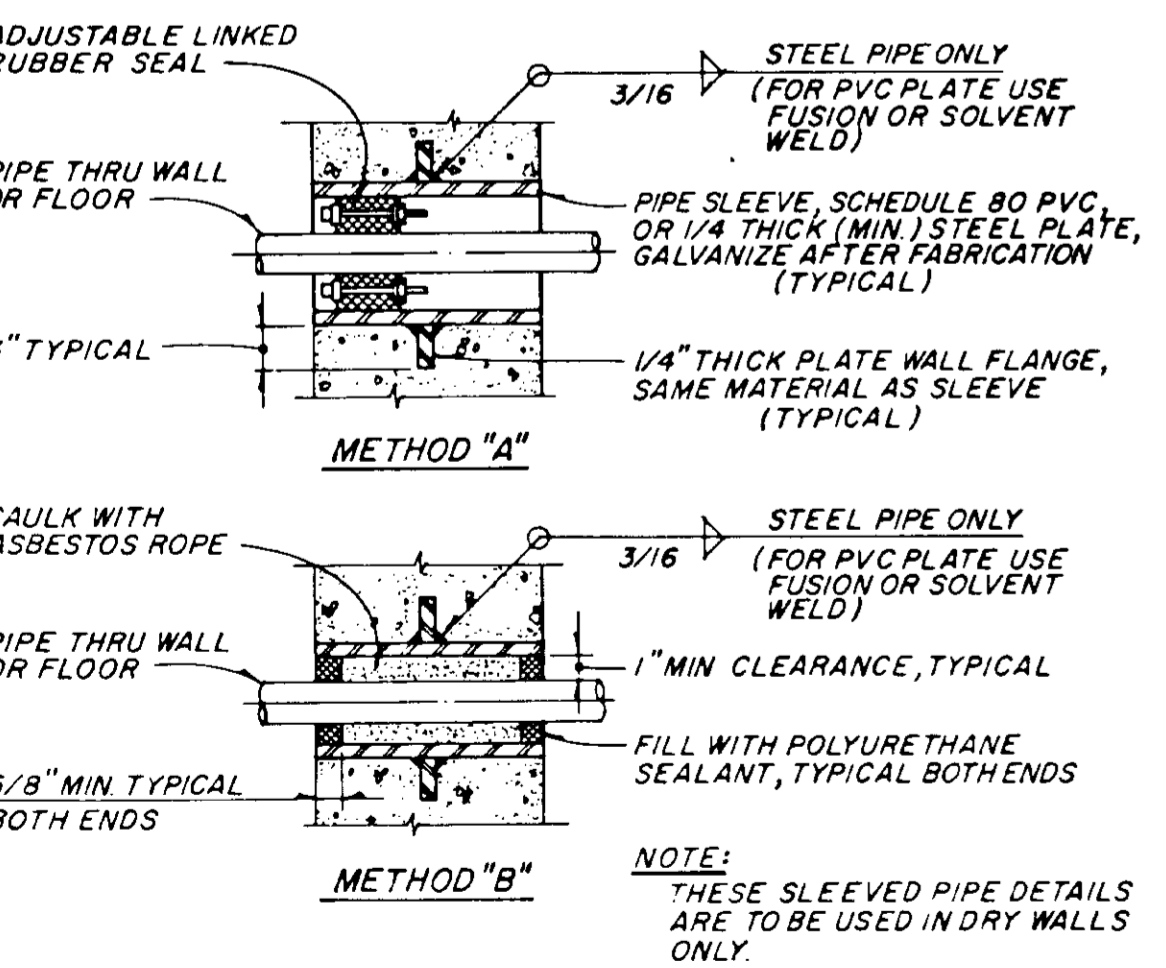

SLEEVED PIPE OPENING L
VAR

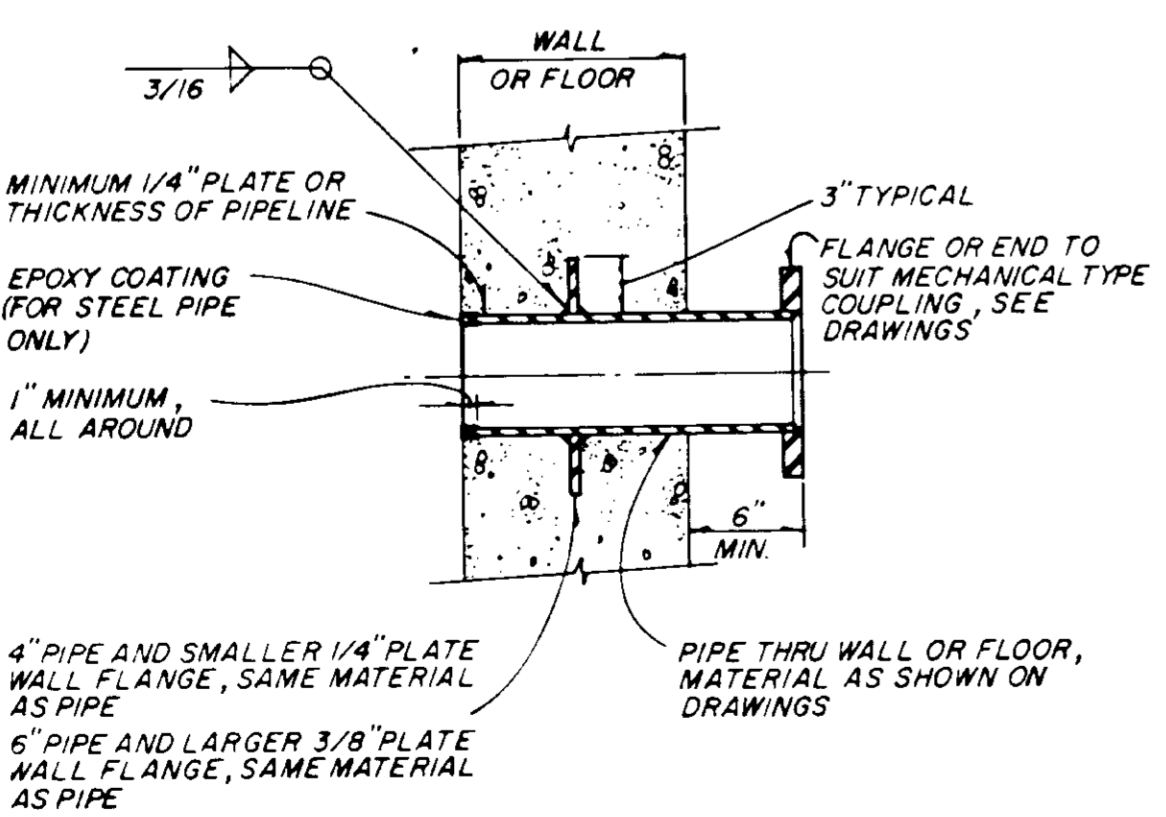


FABRICATED PIPE THIMBLE M
VAR

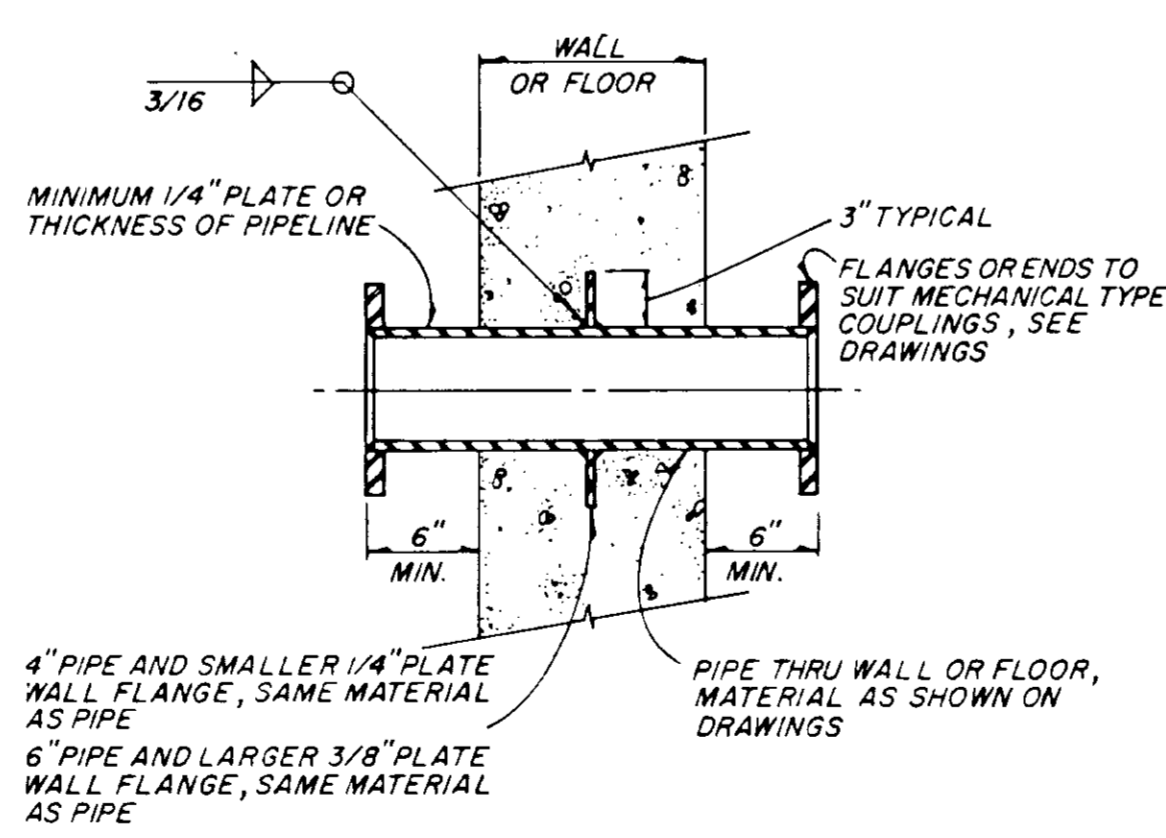


FABRICATED PIPE THIMBLE N
VAR

NOTE: WHERE VALVE BOX IS NOT IN PAVEMENT, COVER TO PROJECT 3" ABOVE GRADE.

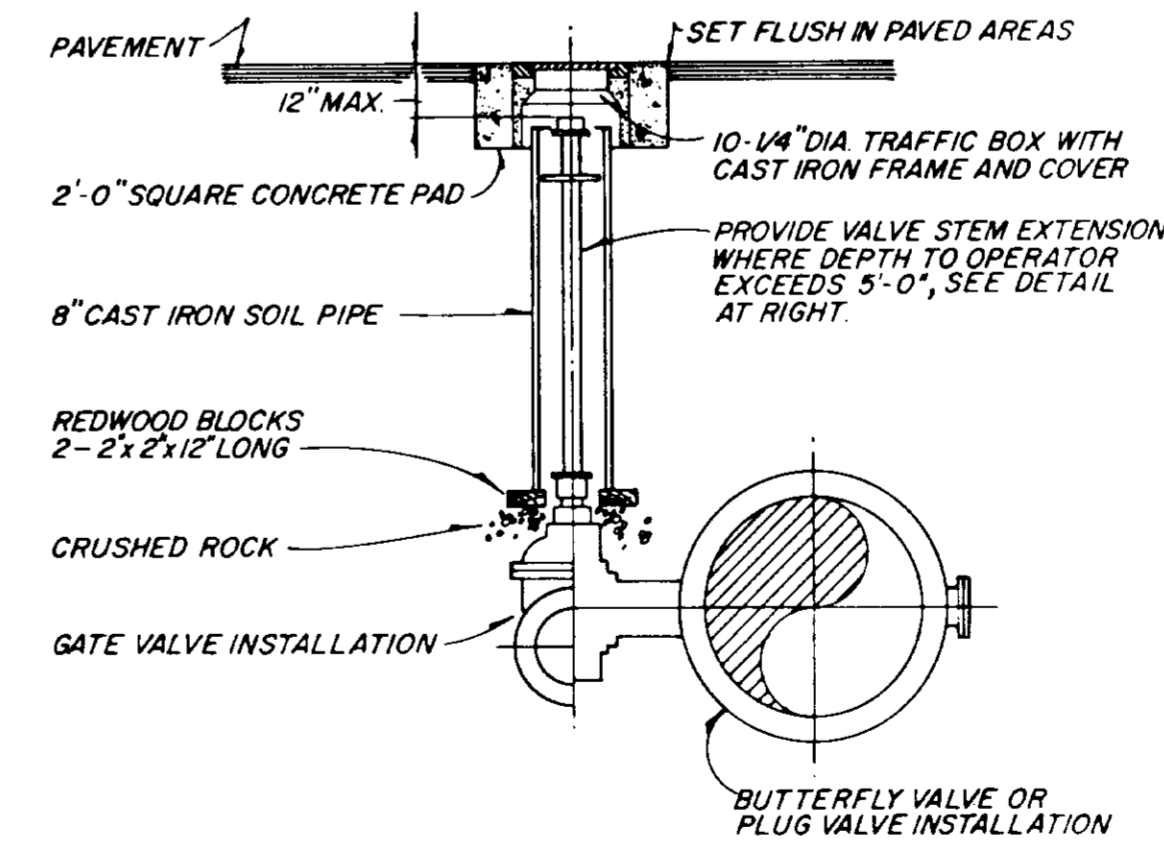

BURIED VALVE P
VAR

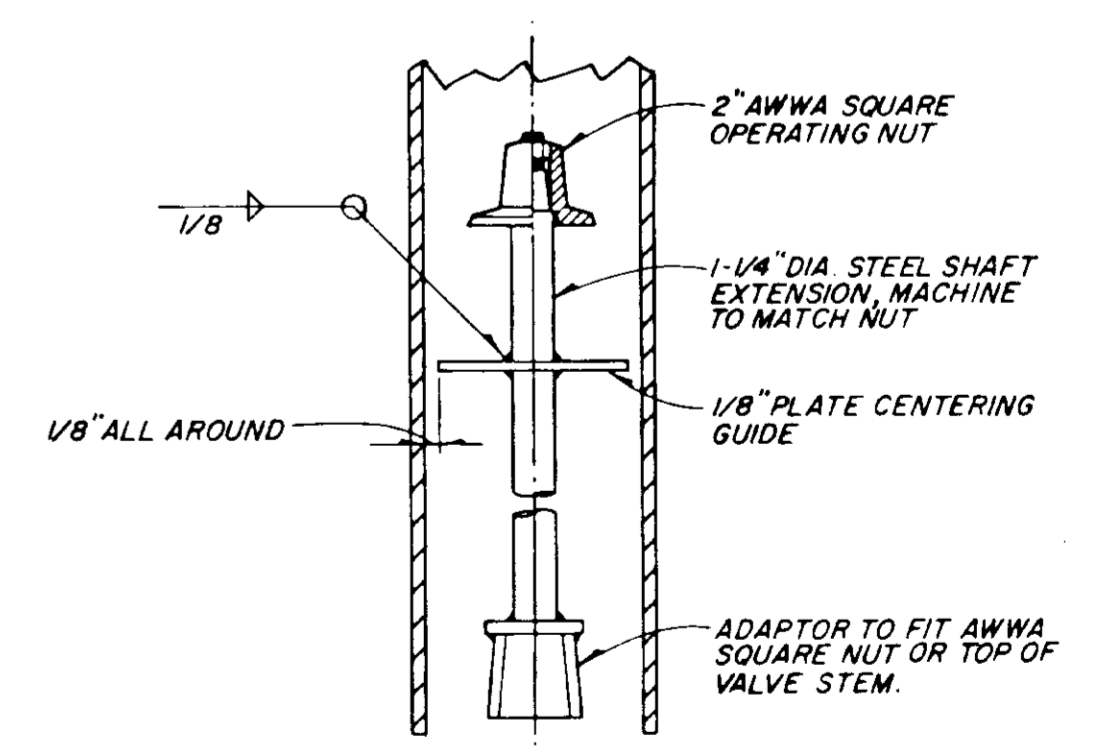

03568

RECORD DRAWING


REVISION	DATE	BY	DESCRIPTION

SCALE: NONE

DESIGNED	G. M.
DRAWN	G. M.
CHECKED	H. M.

SUBMITTED	27304	8/19/81
PROJECT ENGINEER	R.C.E. NO.	DATE
RECOMMENDED	27638	8/20/81
JAMES M. MONTGOMERY CONSULTING ENGINEERS, INC.	R.C.E. NO.	DATE









JAMES M. MONTGOMERY CONSULTING ENGINEERS, INC.

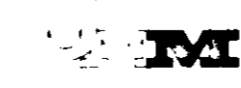

DISTRICT APPROVAL ON TITLE PAGE

LAS VIRGENES MWD/TRIUNFO CSD	
TAPIA WRF - FILTRATION/DISINFECTION ADDITION	
PHASE II	MISCELLANEOUS MECHANICAL DETAILS - D

SHEET **M-9**
OF 66 SHEETS

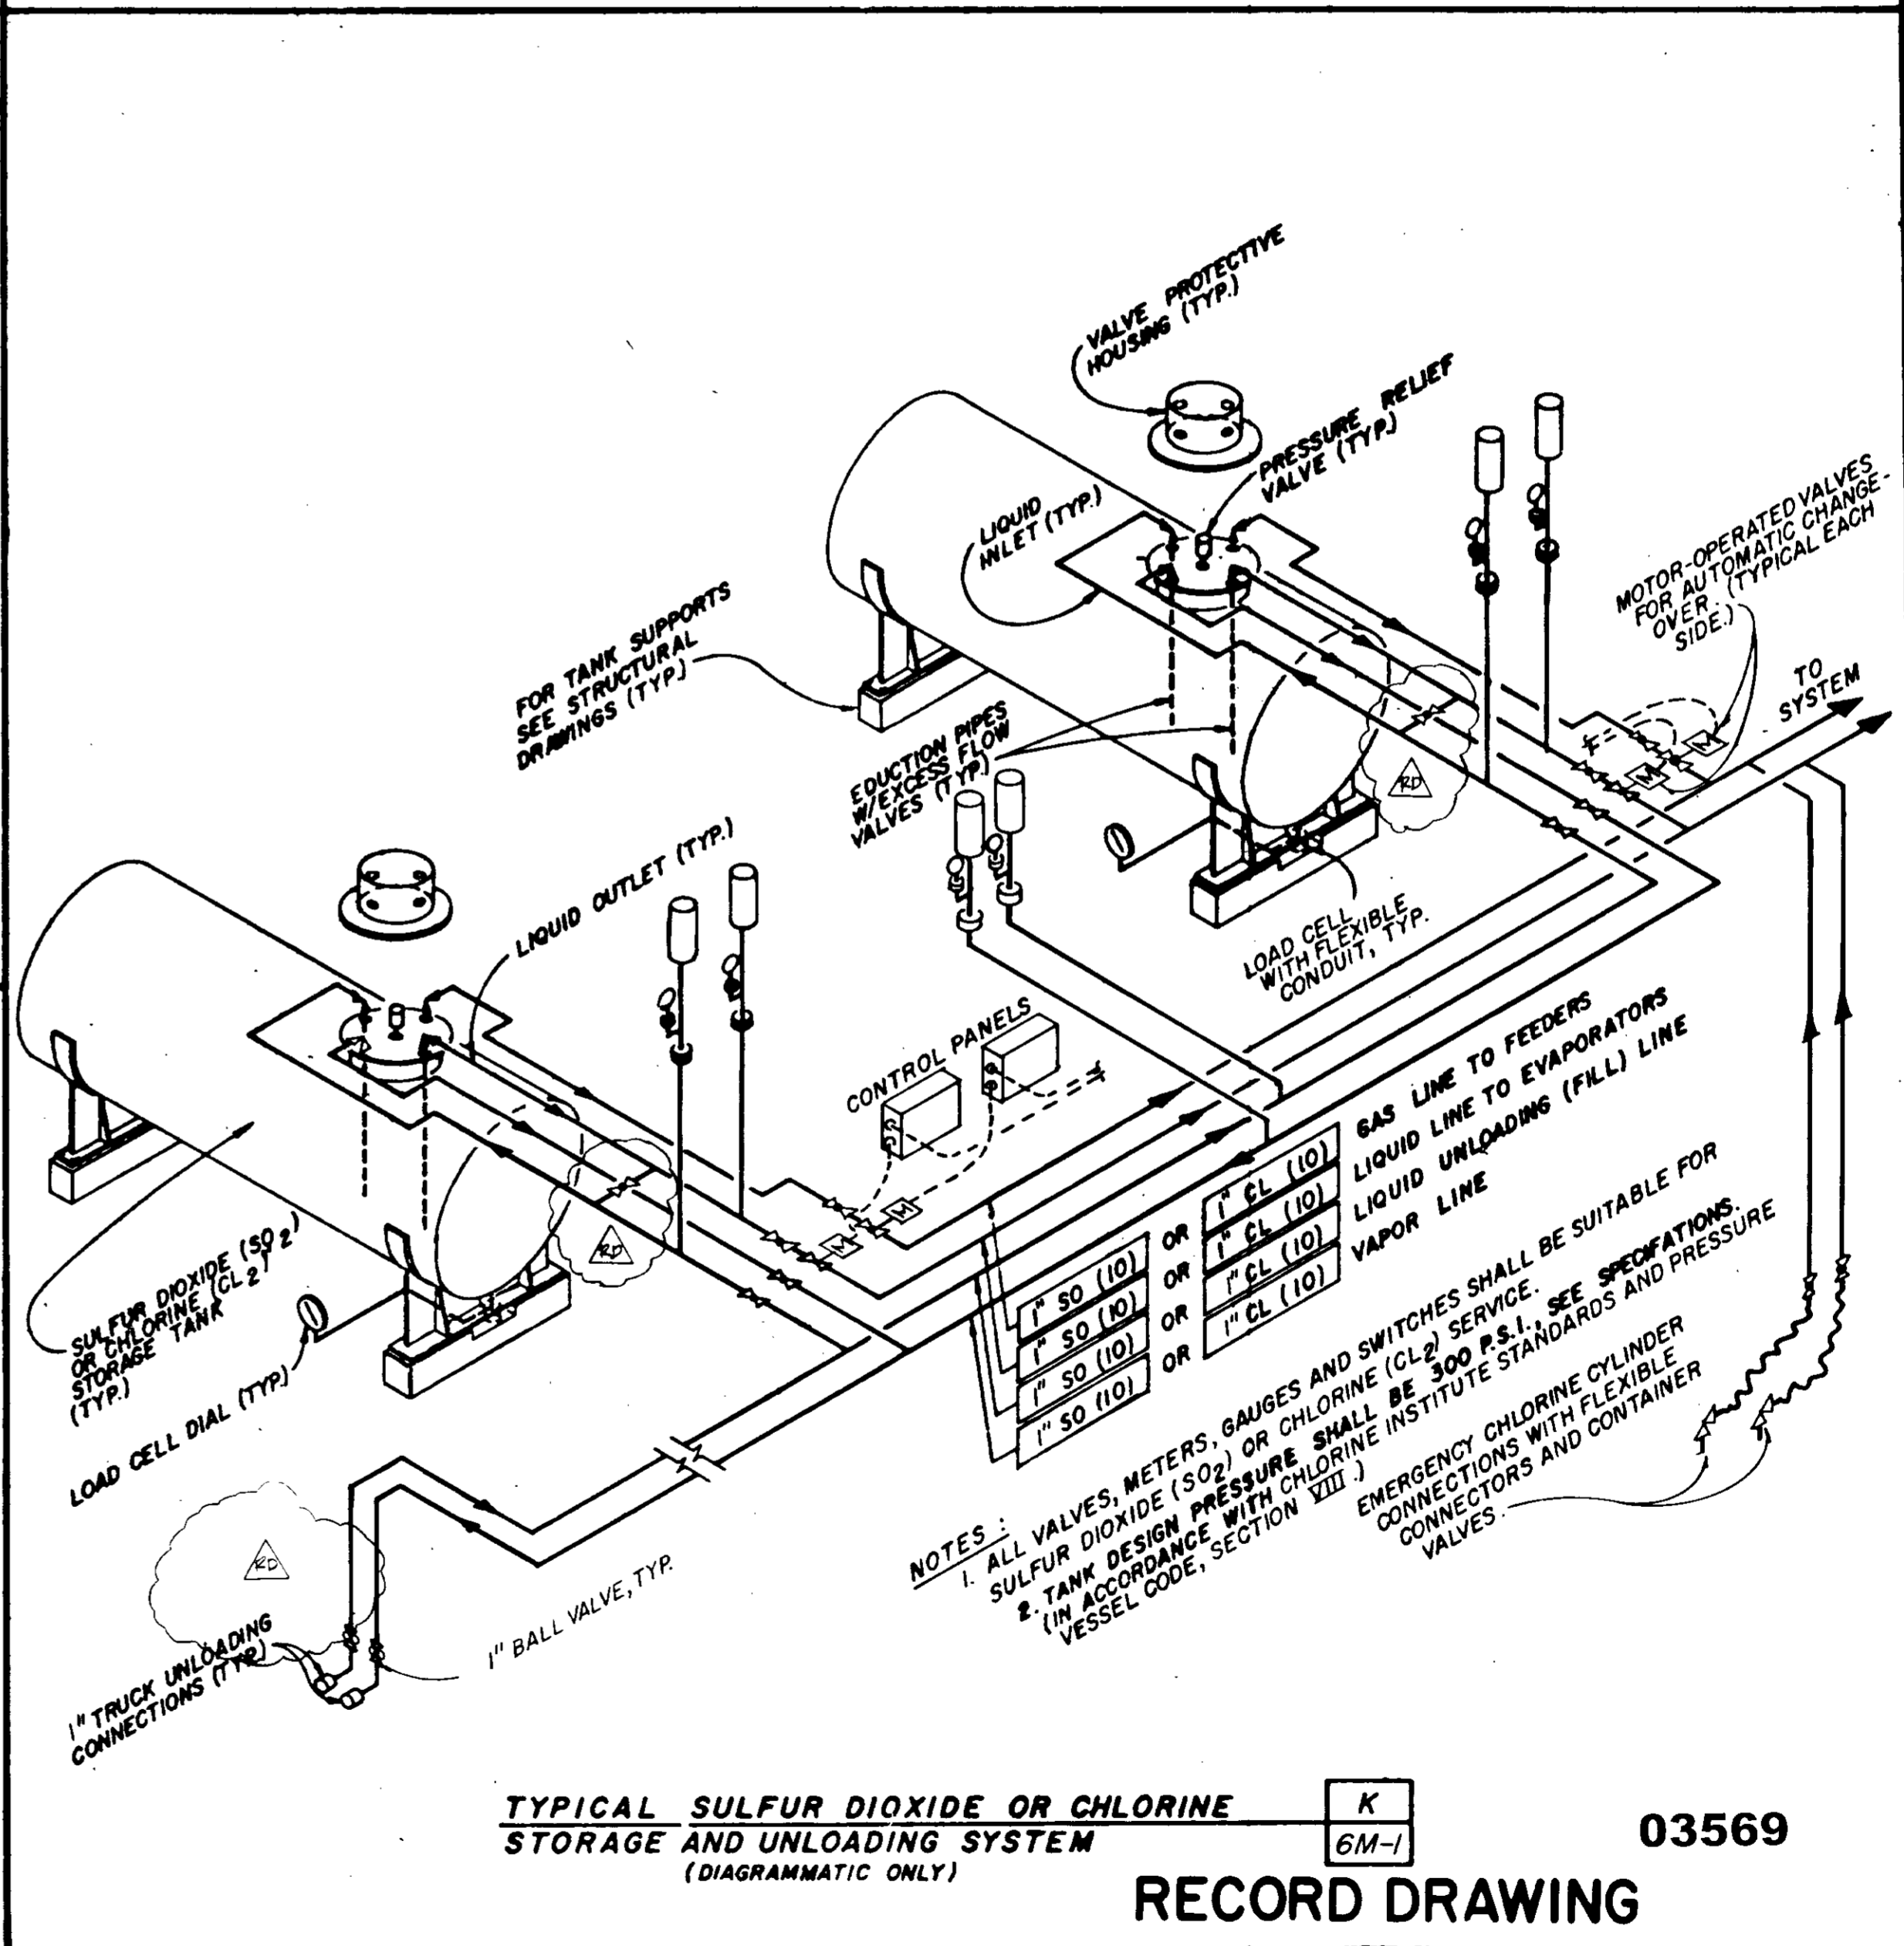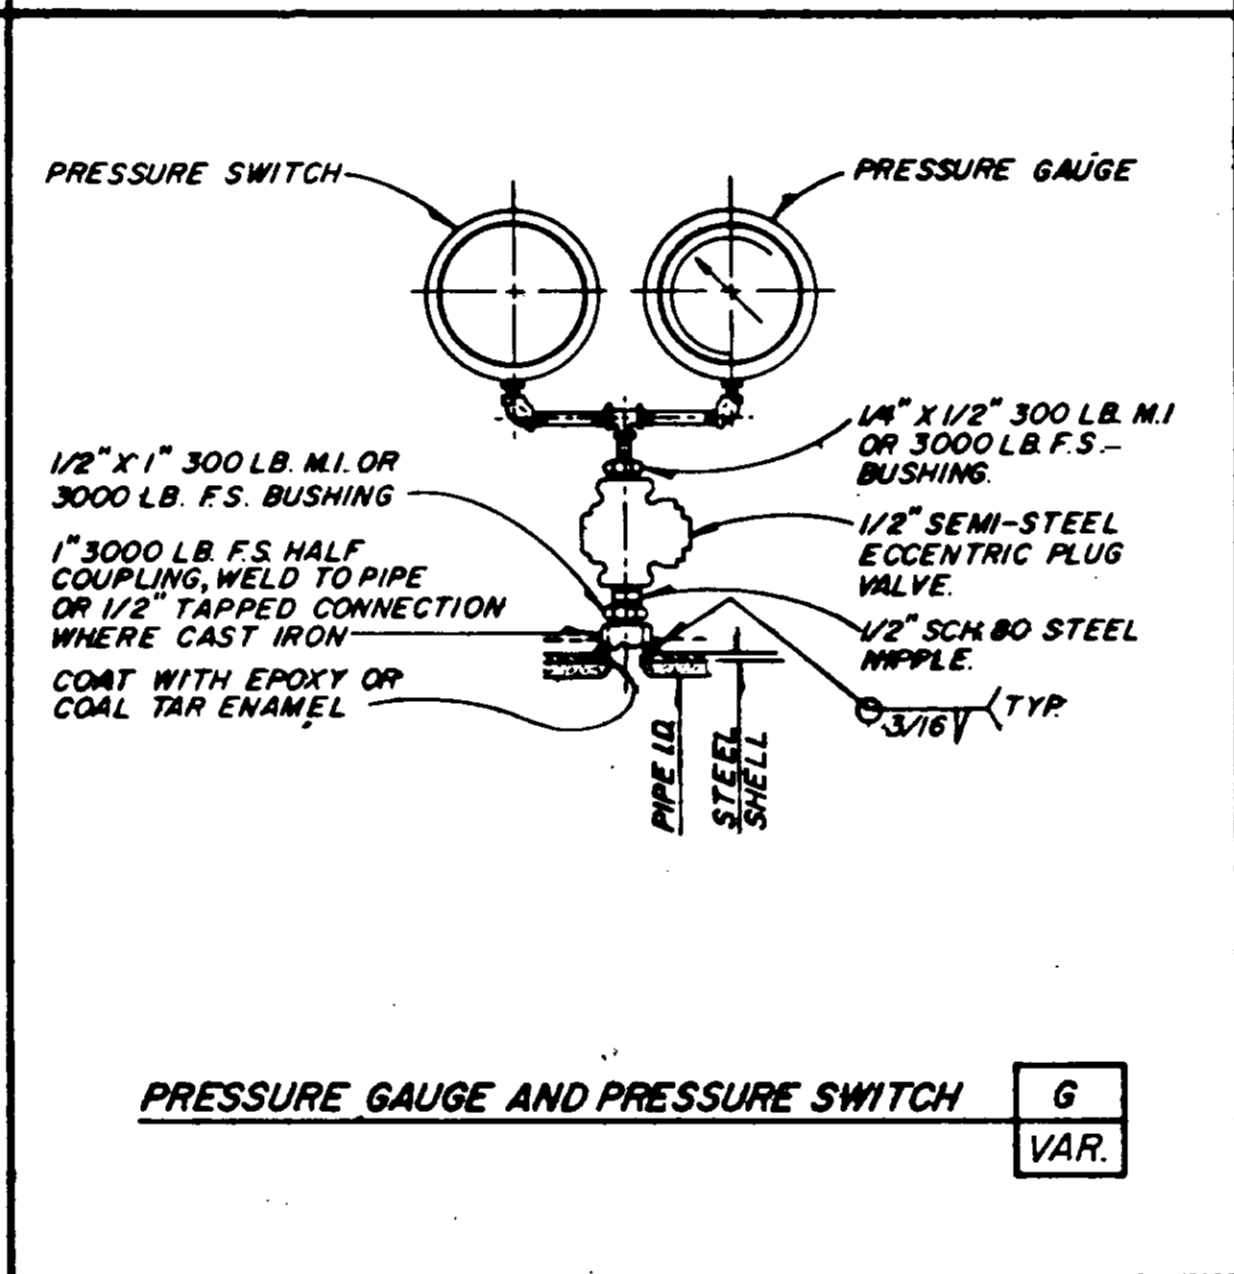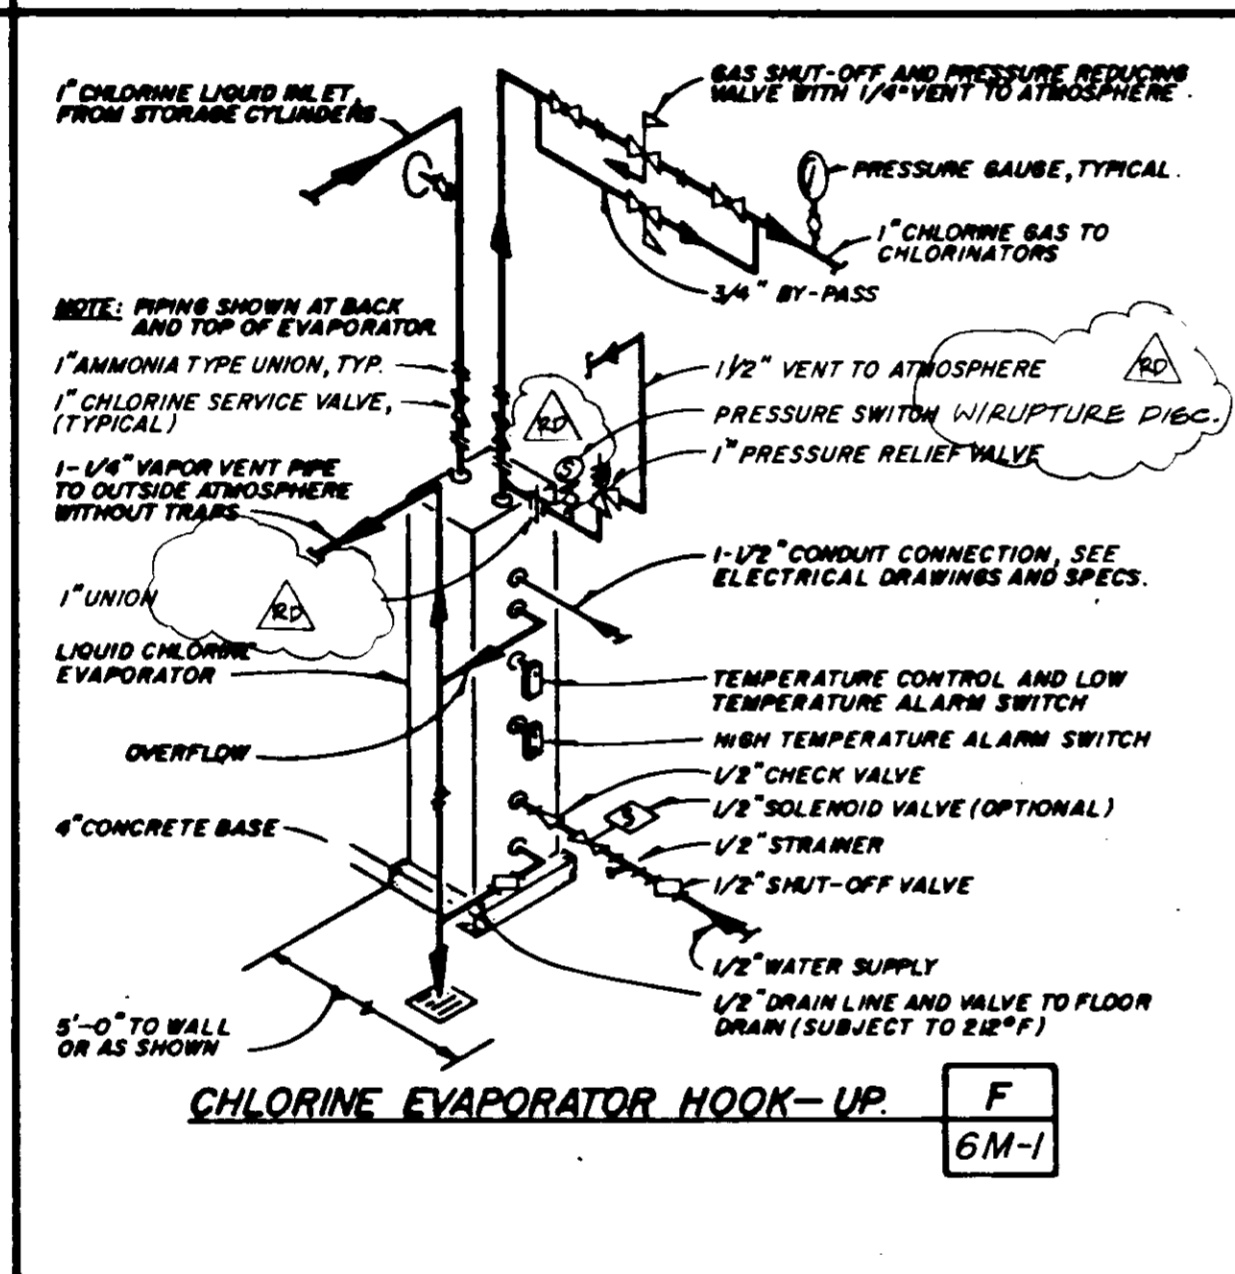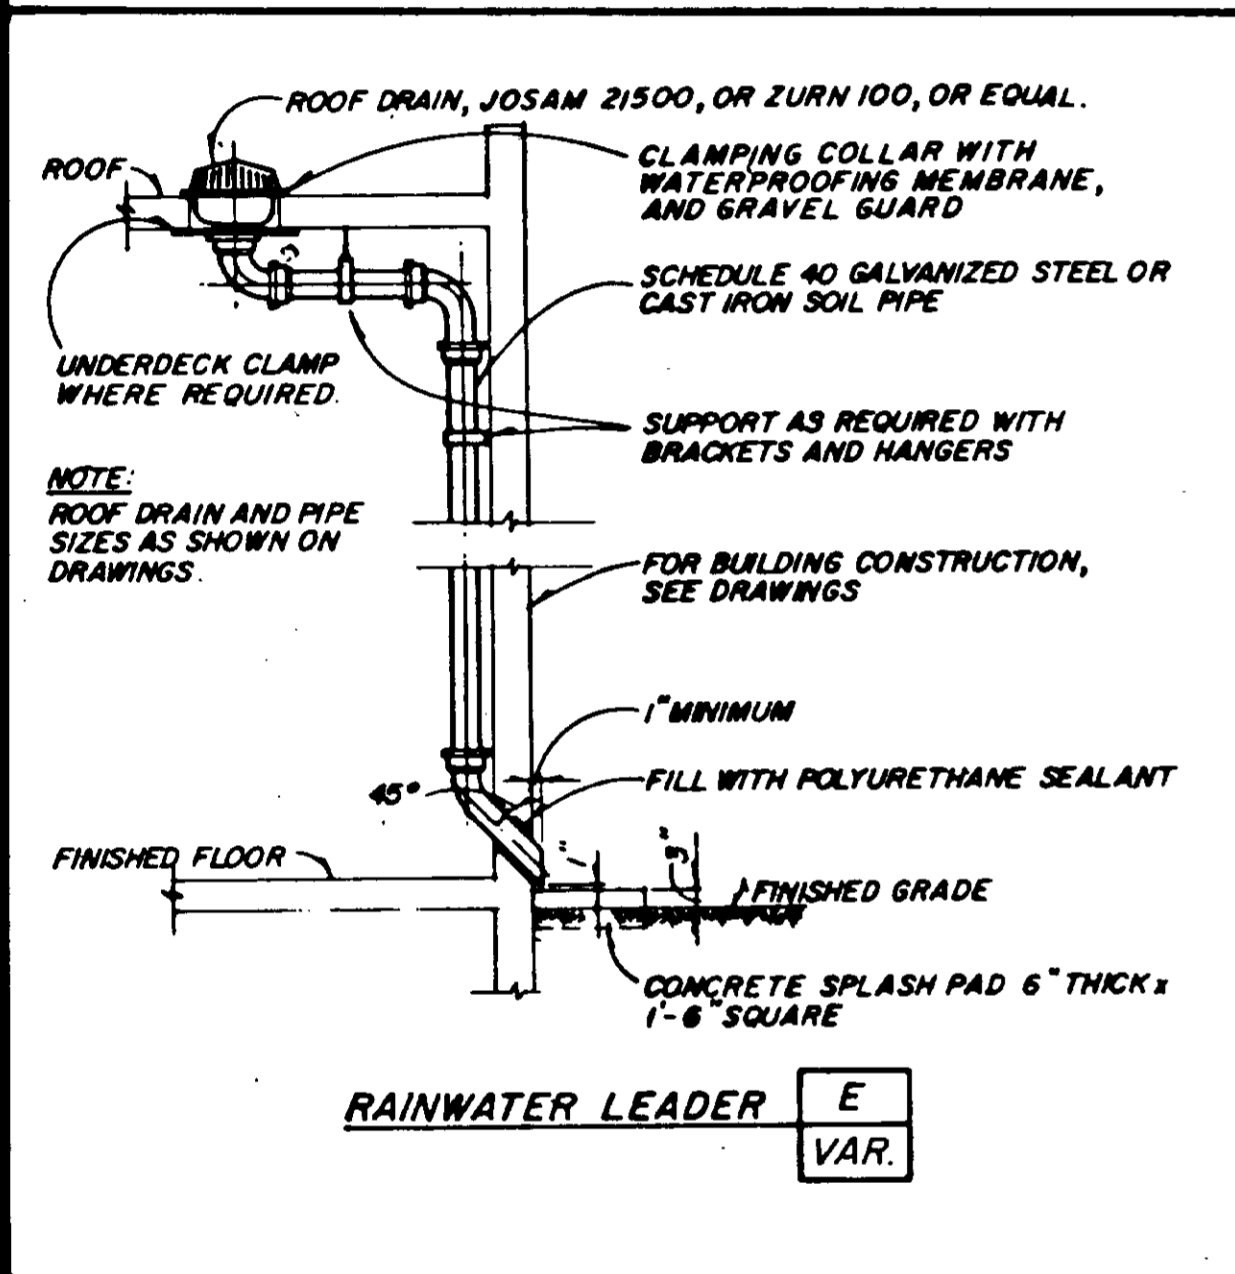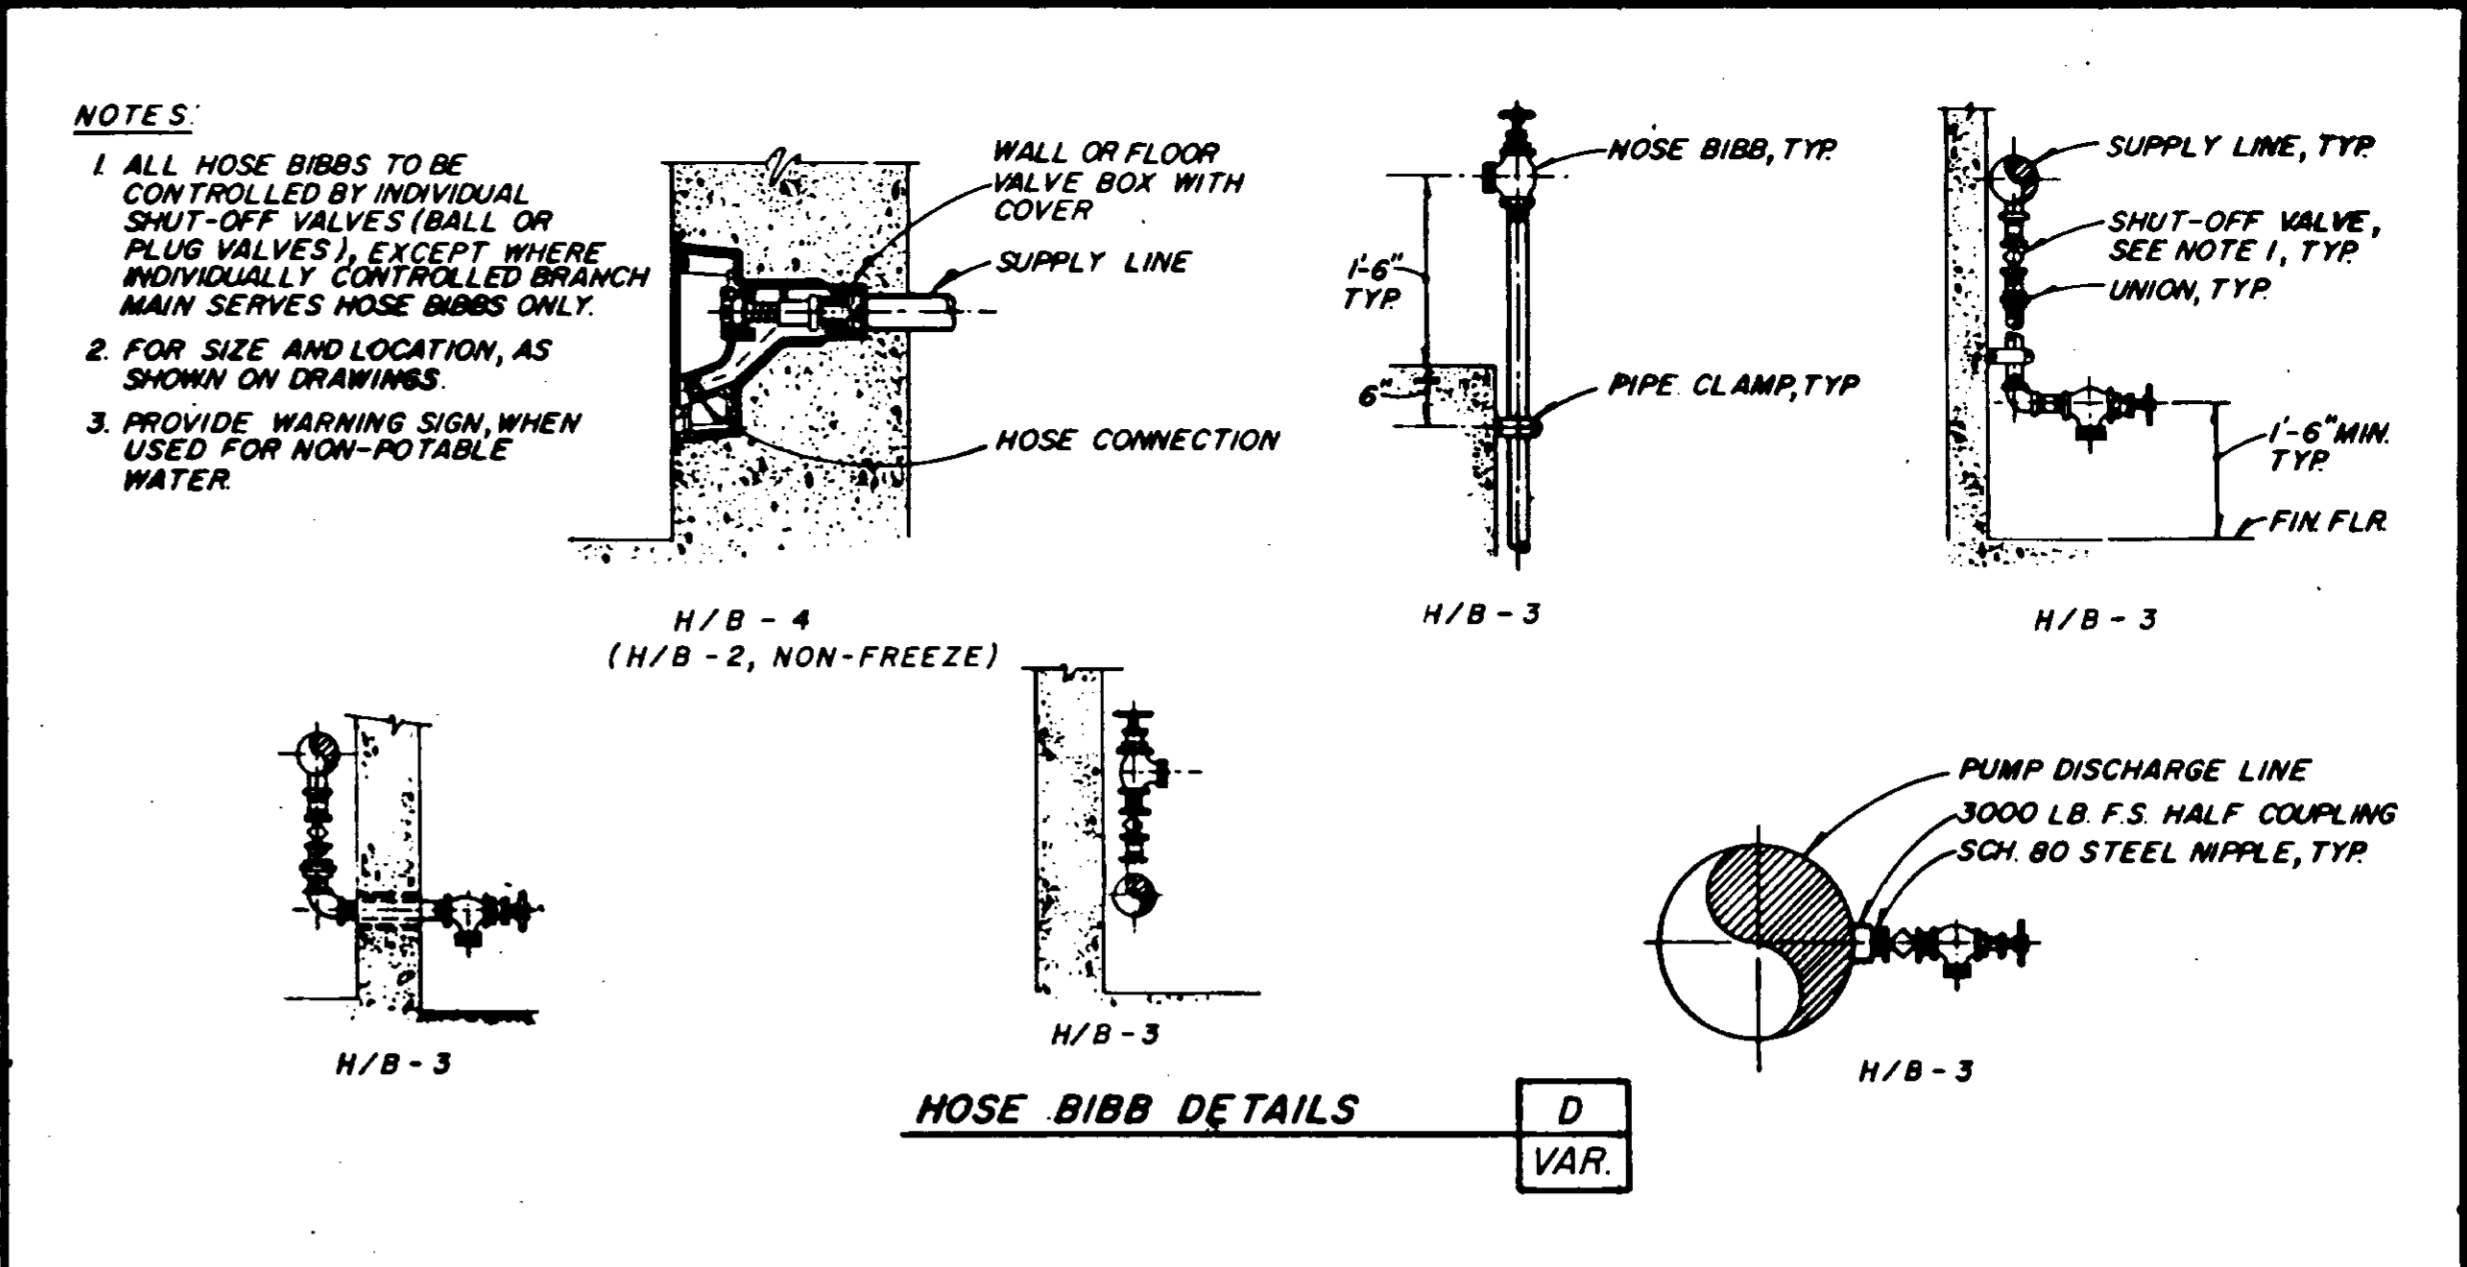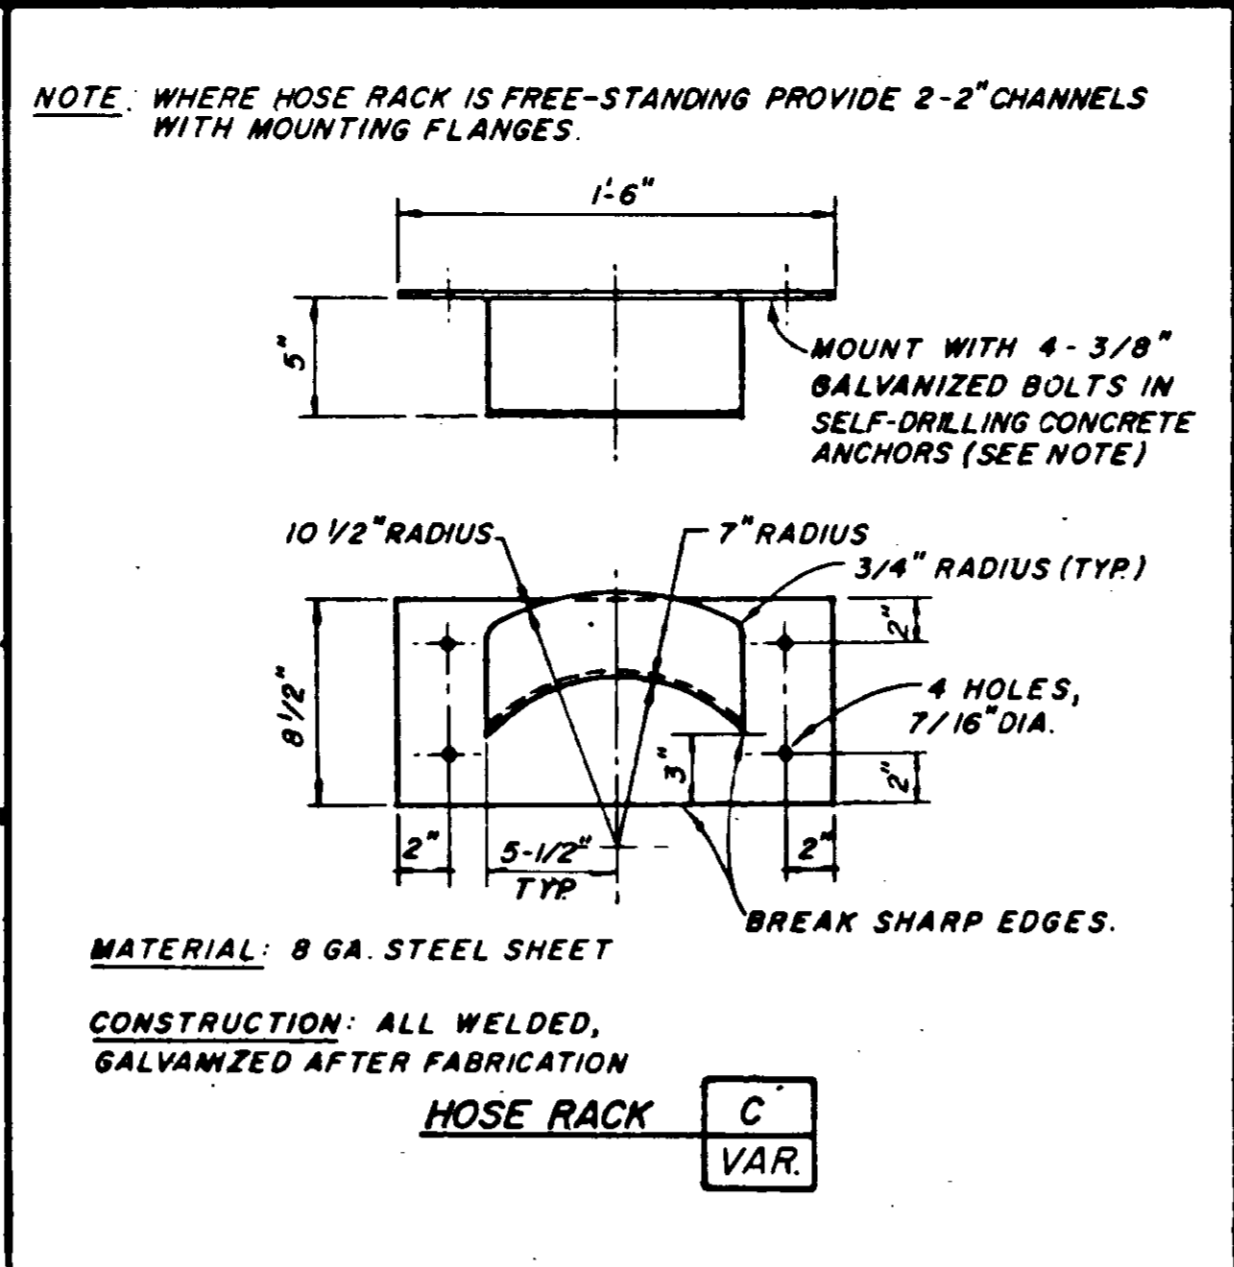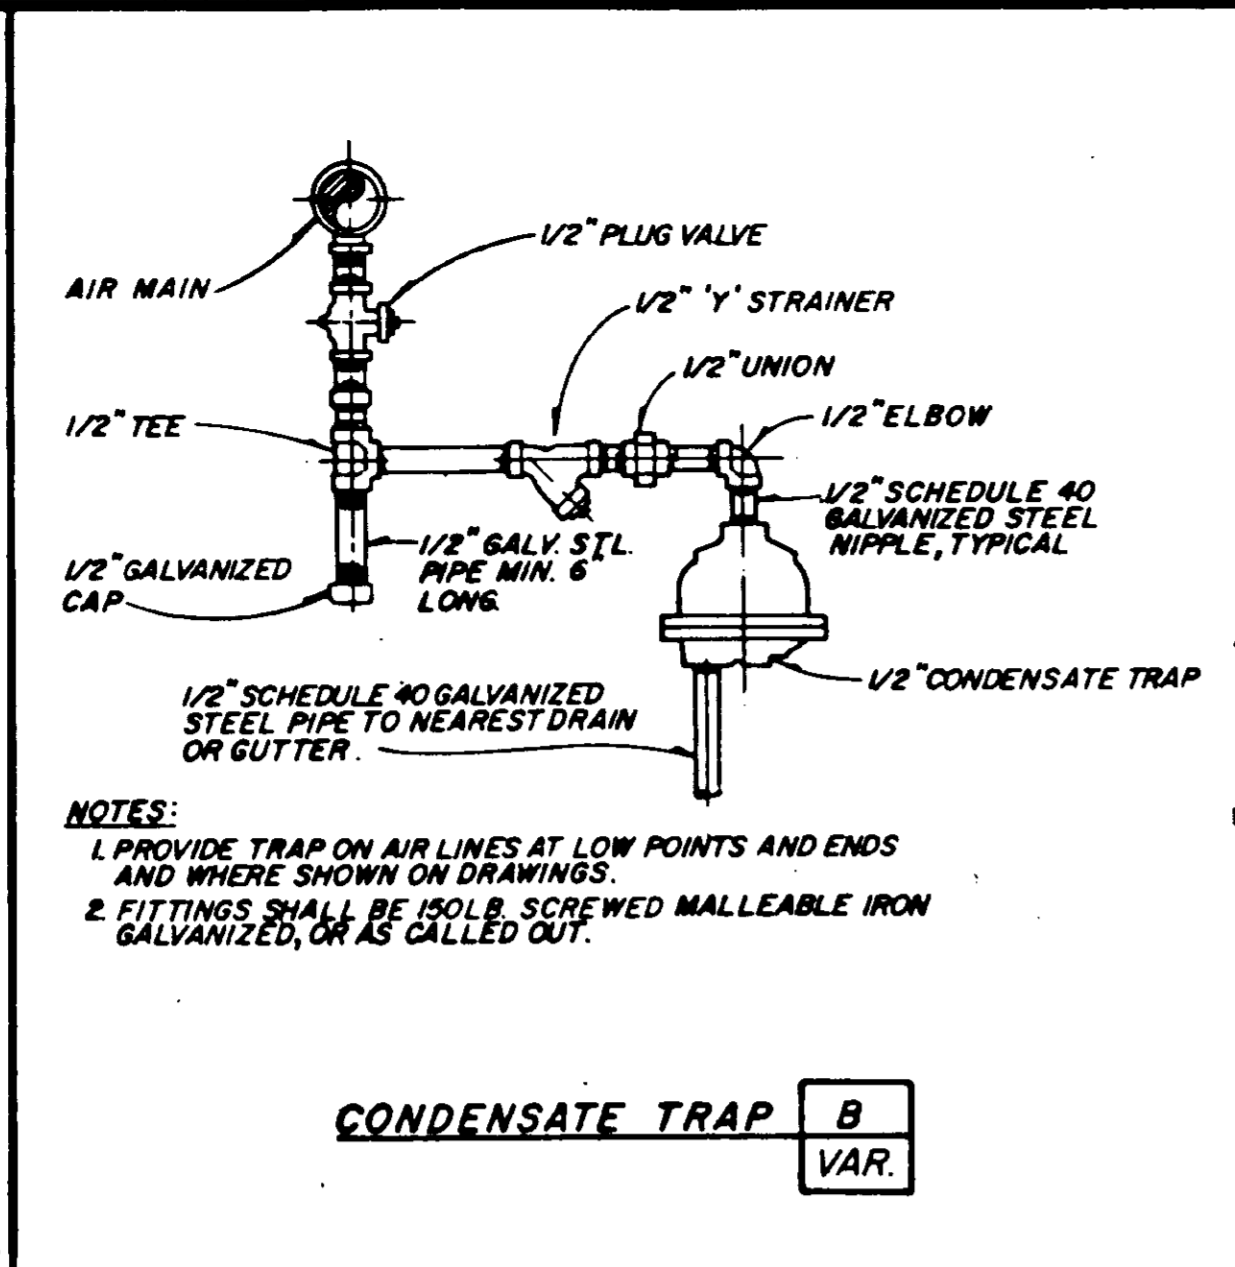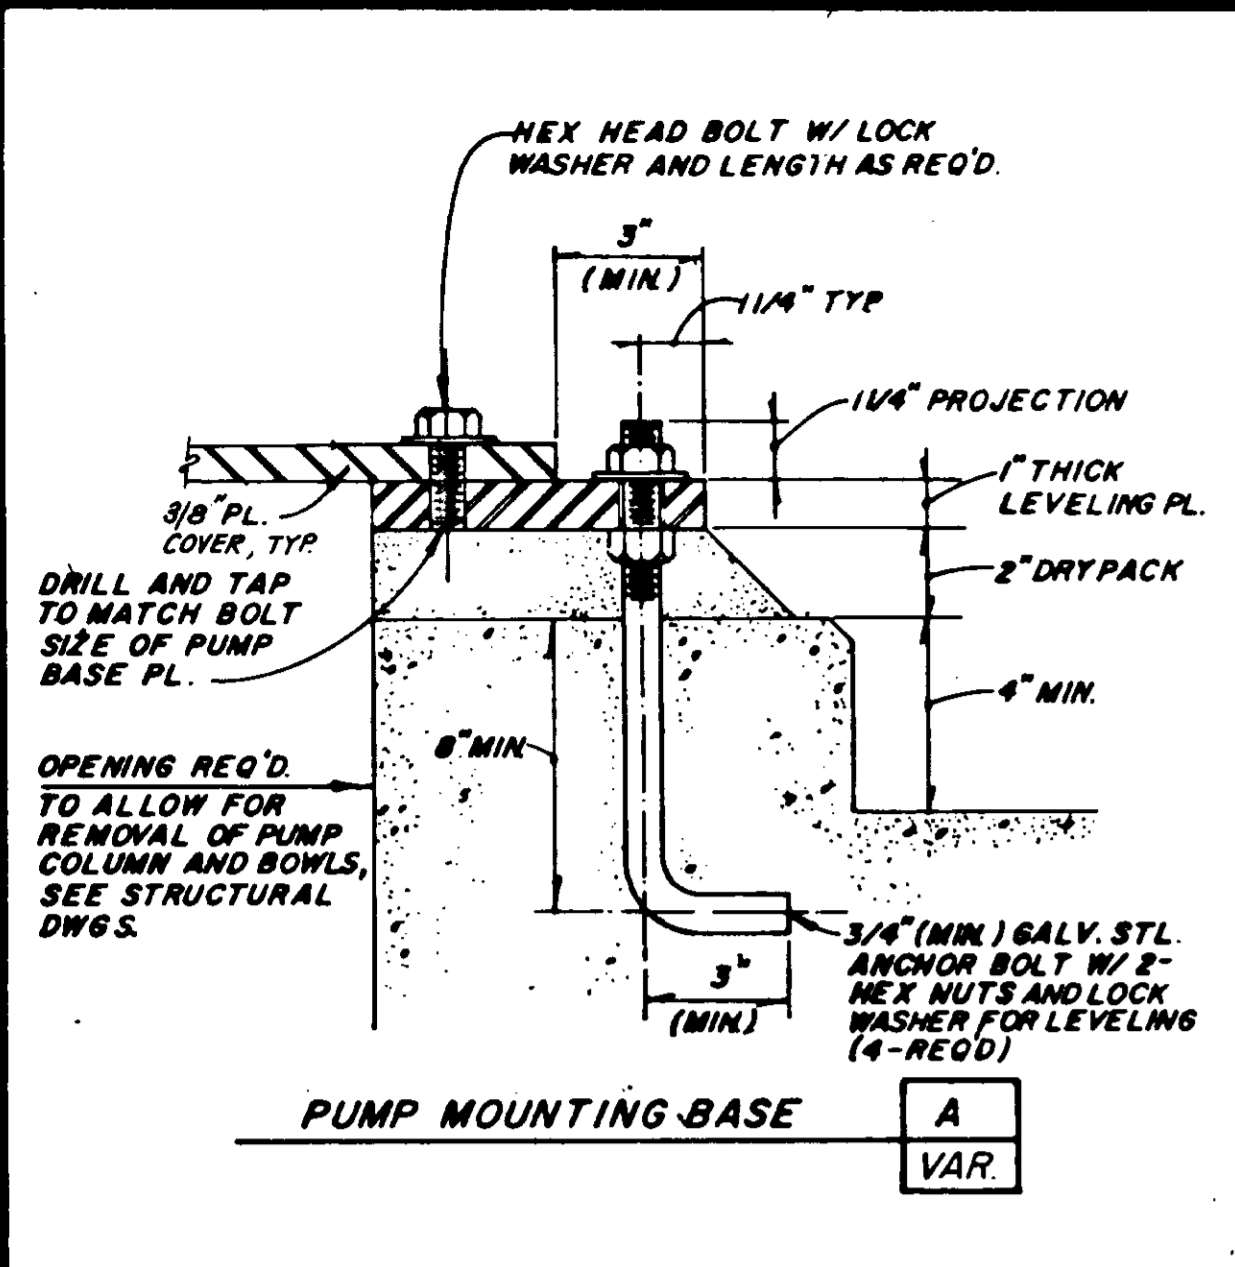

REVISIONS	DATE	BY	DESCRIPTION

SCALE: NONE	DESIGNED: G.M.	SUBMITTED: 27304 8/19/01
	DRAWN: G.M.	PROJECT ENGINEER: R.C.E. NO. DATE
	CHECKED: JCS	RECOMMENDED: 27308 8/20/01
		JAMES M. MONTGOMERY CONSULTING ENGINEERS, INC.

JAMES M. MONTGOMERY CONSULTING ENGINEERS, INC.
 355 EAST WALNUT STREET, PASADENA, CALIFORNIA 91101



DISTRICT APPROVAL ON TITLE PAGE

LAS VIRGENES MWD/TRIUNFO CSD
 TAPIA WRF - FILTRATION/DISINFECTION ADDITION
 PHASE II
 MISCELLANEOUS MECHANICAL DETAILS - E

SHEET
 M-10
 OF 66 SHEETS

03569

RECORD DRAWING

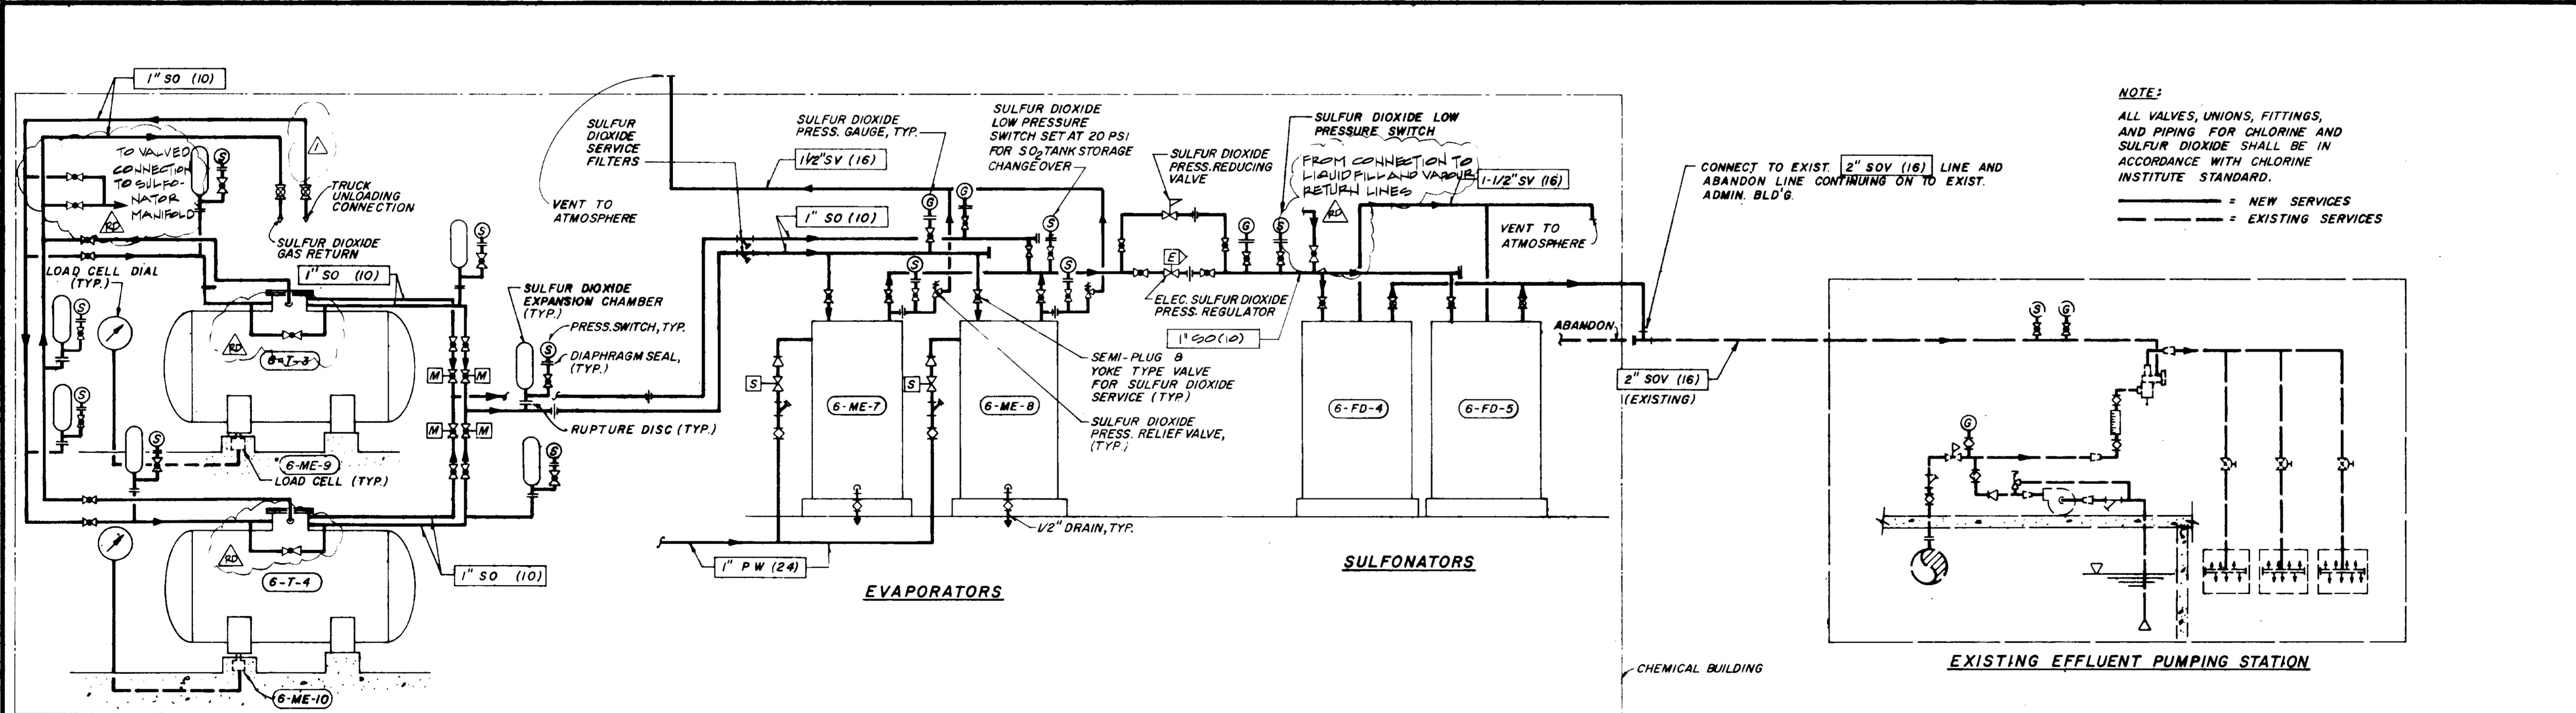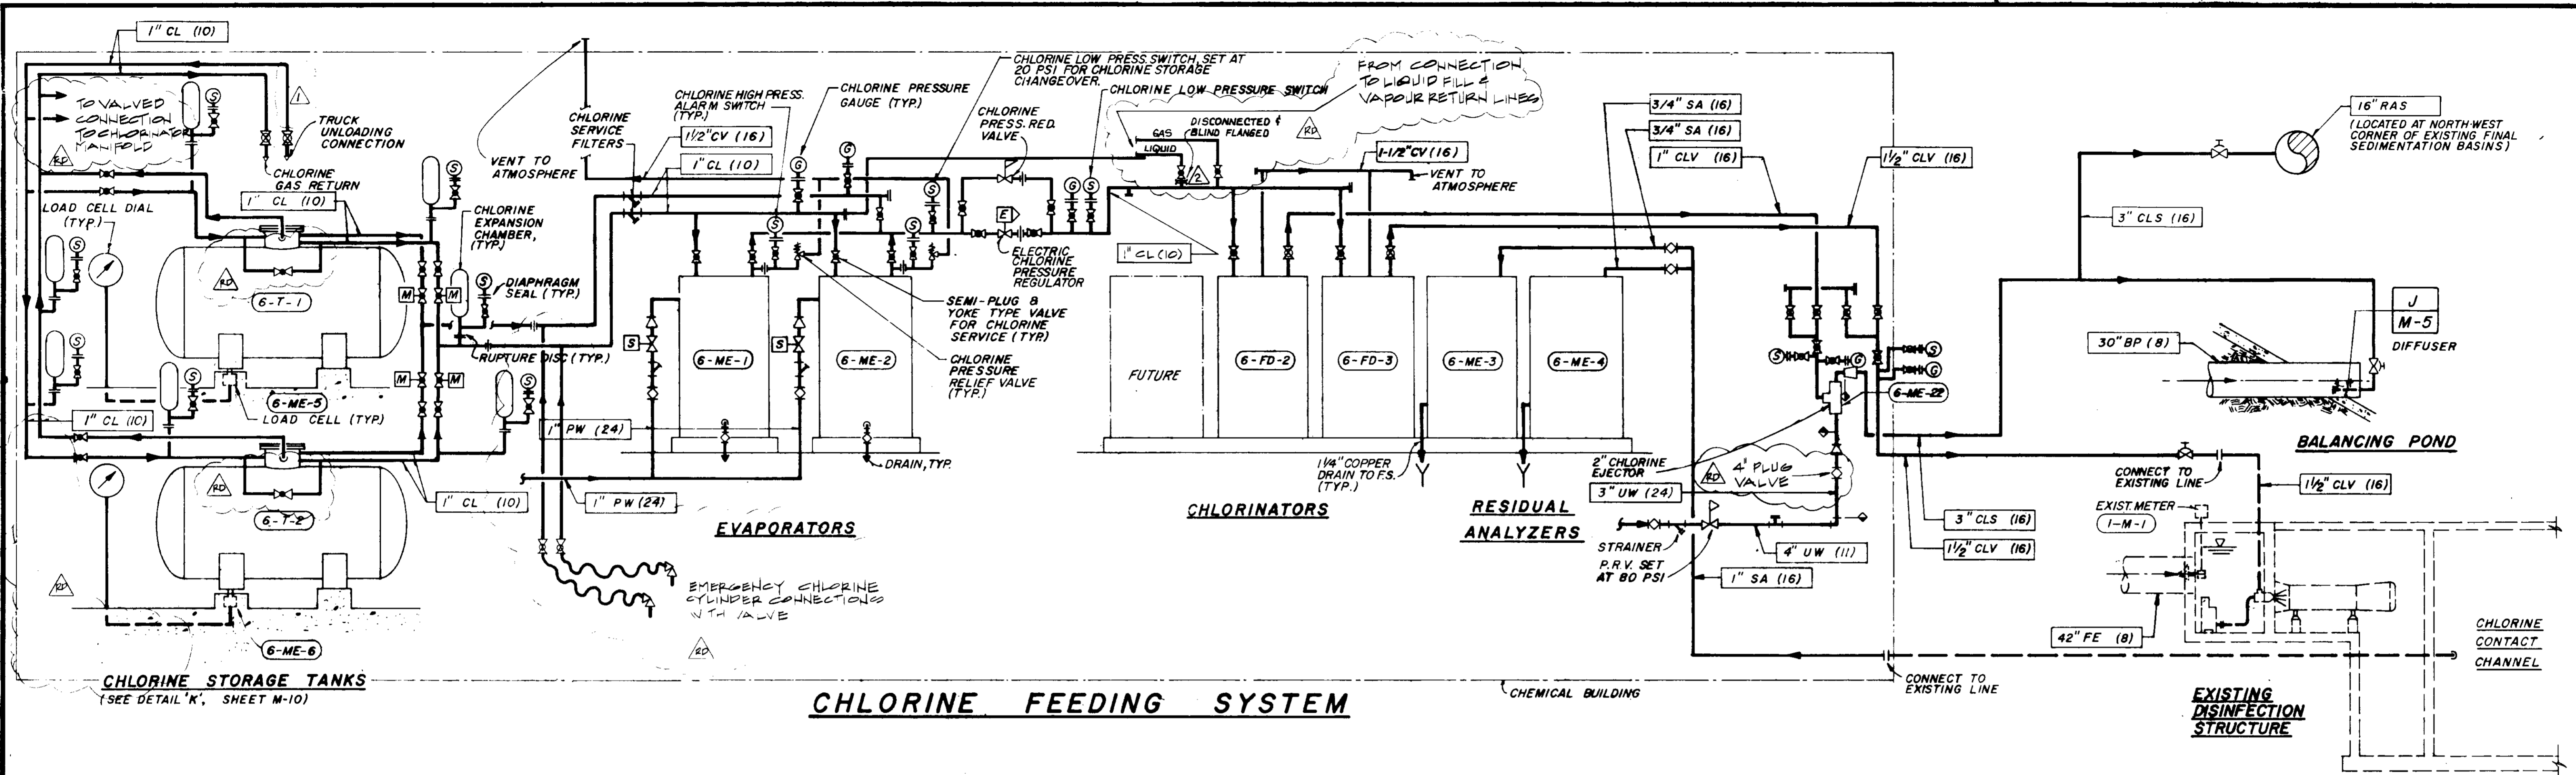

NOTE:
 ALL VALVES, UNIONS, FITTINGS,
 AND PIPING FOR CHLORINE AND
 SULFUR DIOXIDE SHALL BE IN
 ACCORDANCE WITH CHLORINE
 INSTITUTE STANDARD.
 — = NEW SERVICES
 - - - = EXISTING SERVICES

SULFUR DIOXIDE STORAGE TANKS
 (SEE DETAIL 'K', SHEET M-10)

REV	DATE	BY	DESCRIPTION
3-30-89	MMH	AS-BUILT REVISIONS	
4-14-89	MMH	RECORD DRAWINGS	
4-14-89	MDJ	DELETED ROTAMETERS	
7/8/82	TV		

SCALE:
 NONE

DESIGNED C.S.	SUBMITTED	27304	8/19/81
DRAWN M. C. Tolson	PROJECT ENGINEER	R.C.E. NO.	DATE
CHECKED C.S.	RECOMMENDED	27633	8/20/81
	JAMES M. MONTGOMERY CONSULTING ENGINEERS, INC.	R.C.E. NO.	DATE

JAMES M. MONTGOMERY CONSULTING ENGINEERS, INC.


355 EAST WALNUT STREET, PARADISE, CALIFORNIA 95969

DISTRICT APPROVAL ON TITLE PAGE

03570

RECORD DRAWING

LAS VIRGENES MWD/ TRUINFO CSD		SHEET
TAPIA WRF - FILTRATION/DISINFECTION ADDITION		M-11
PHASE II	CHLORINATION AND DECHLORINATION SCHEMATICS	OF 66 SHEETS

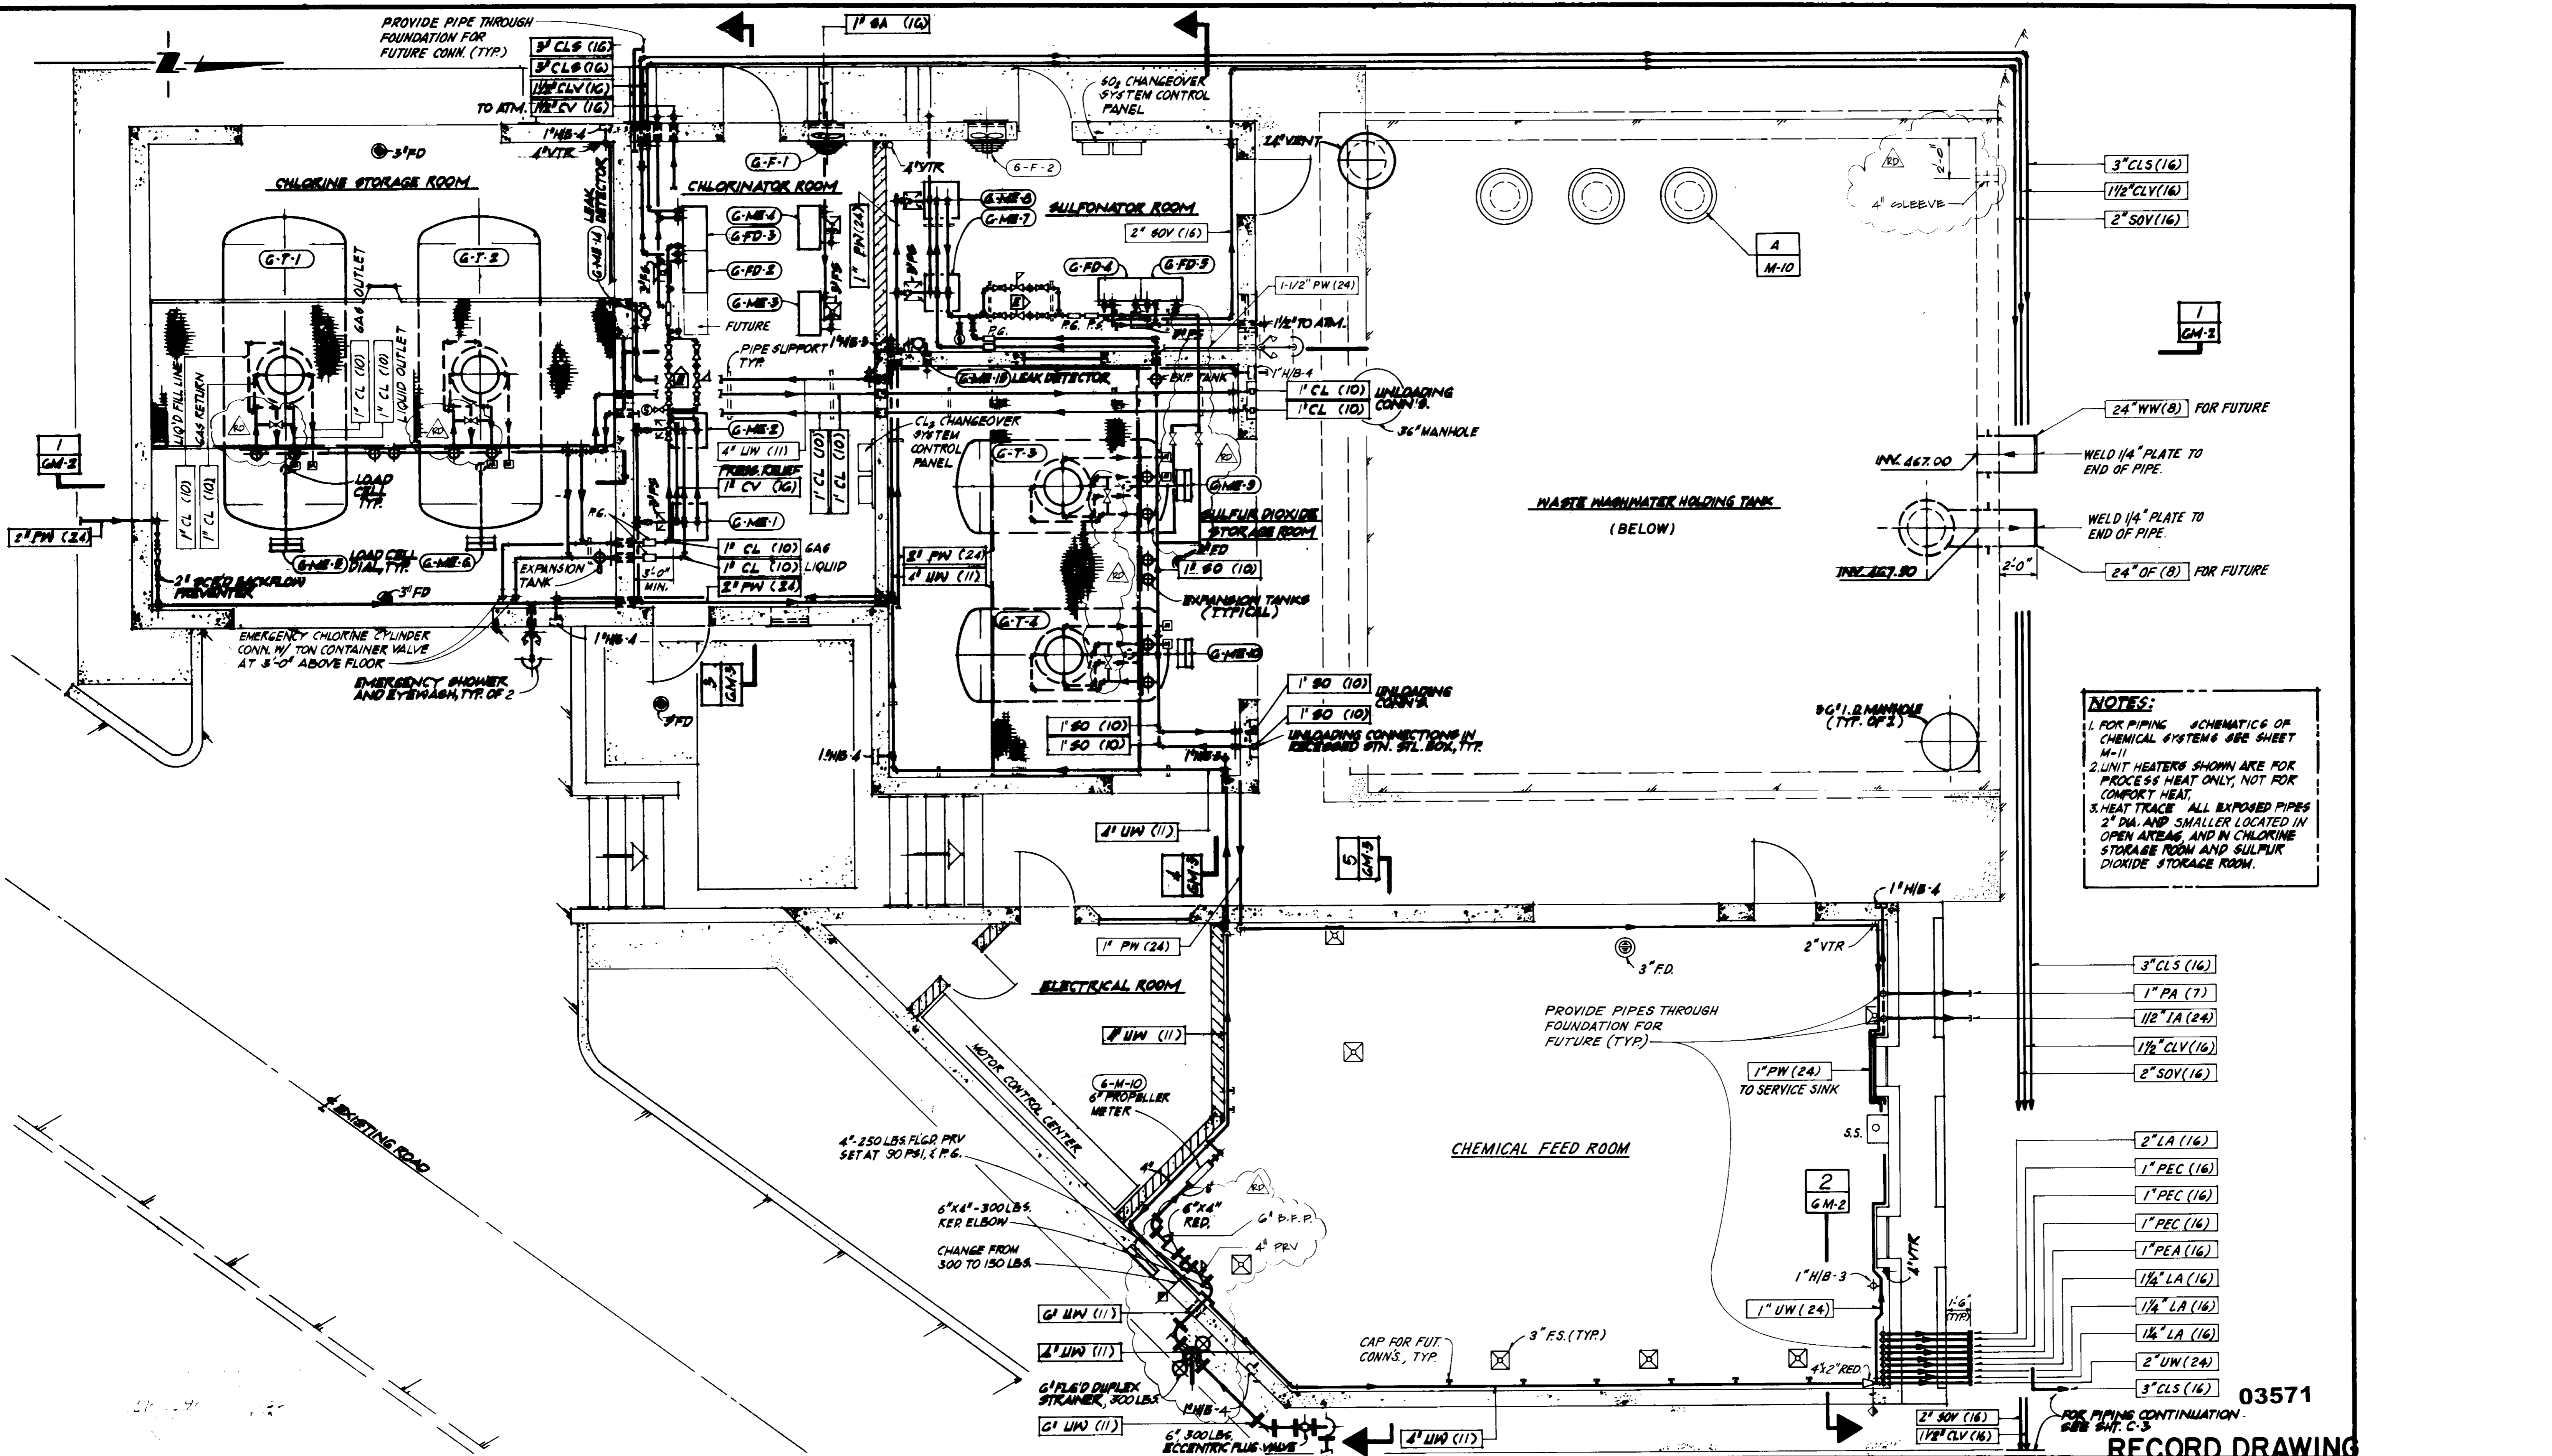

NOTES:

1. FOR PIPING SCHEMATIC OF CHEMICAL SYSTEMS SEE SHEET M-11
2. UNIT HEATERS SHOWN ARE FOR PROCESS HEAT ONLY, NOT FOR COMFORT HEAT.
3. HEAT TRACE ALL EXPOSED PIPES 2" DIA. AND SMALLER LOCATED IN OPEN AREAS, AND IN CHLORINE STORAGE ROOM AND SULFUR DIOXIDE STORAGE ROOM.

- 3" CLS (16)
- 1" PA (7)
- 1/2" IA (24)
- 1/2" CLV (16)
- 2" SOV (16)
- 2" LA (16)
- 1" PEC (16)
- 1" PEC (16)
- 1" PEC (16)
- 1" PEA (16)
- 1/2" LA (16)
- 1/4" LA (16)
- 1/2" LA (16)
- 2" UW (24)
- 3" CLS (16)

03571

RECORD DRAWING

RD. (MBA) (MDU)	RECORD DRAWINGS
DATE	DESCRIPTION

SCALE: 1/4" = 1'-0"

DESIGNED	C.S.
DRAWN	R.G.
CHECKED	J. [Signature]

SUBMITTED	[Signature]	27504	8/19/81
PROJECT ENGINEER		R.C.E. NO.	DATE
RECOMMENDED	[Signature]	27633	9/20/81
JAMES M. MONTGOMERY CONSULTING ENGINEERS, INC.		R.C.E. NO.	DATE


JAMES M. MONTGOMERY CONSULTING ENGINEERS, INC.

355 EAST WALNUT STREET, PASADENA, CALIFORNIA 91101


DISTRICT APPROVAL ON TITLE PAGE

LAS VEGAS NV/TEMPE AZ CSD	
TAPIA WRF - FILTRATION/DISINFECTION ADDITION	
PHASE II	CHEMICAL BUILDING AND STORAGE - PIPING PLAN


SHEET 6M-1 OF 66 SHEETS

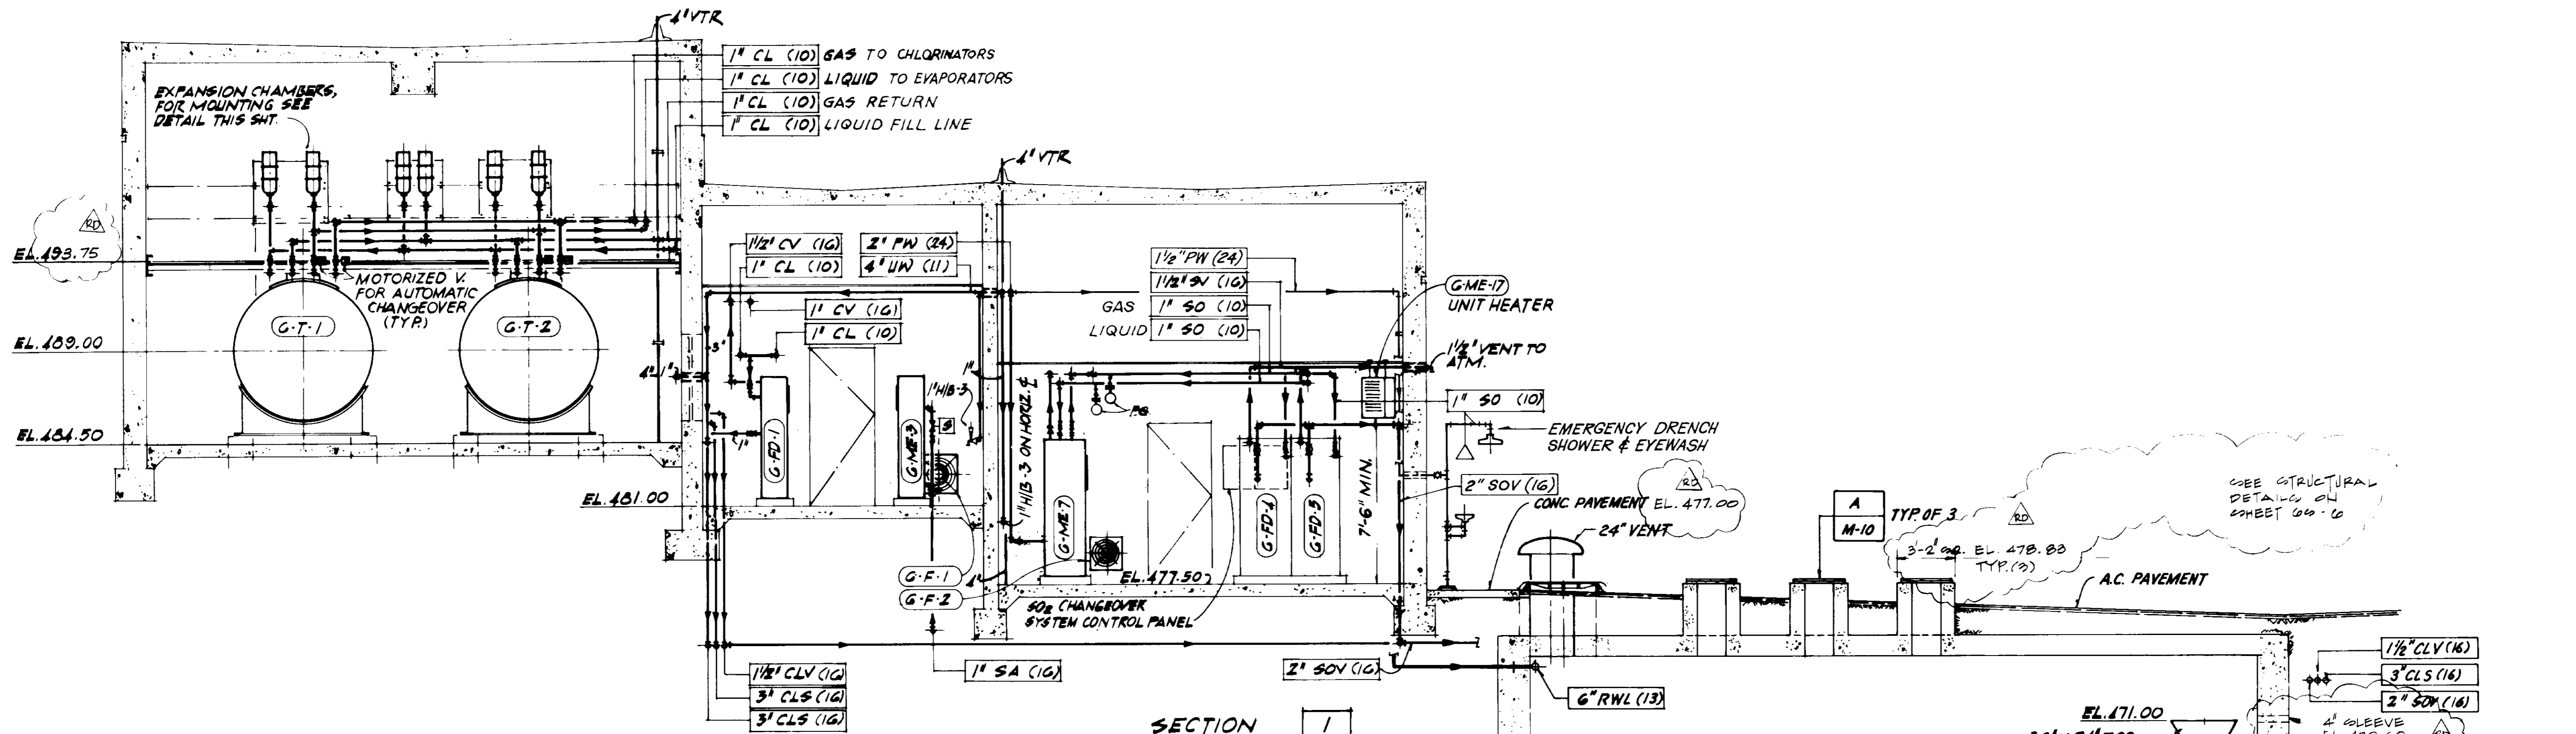

SECTION 1
SCALE = 1/4" = 1'-0"
GM-1

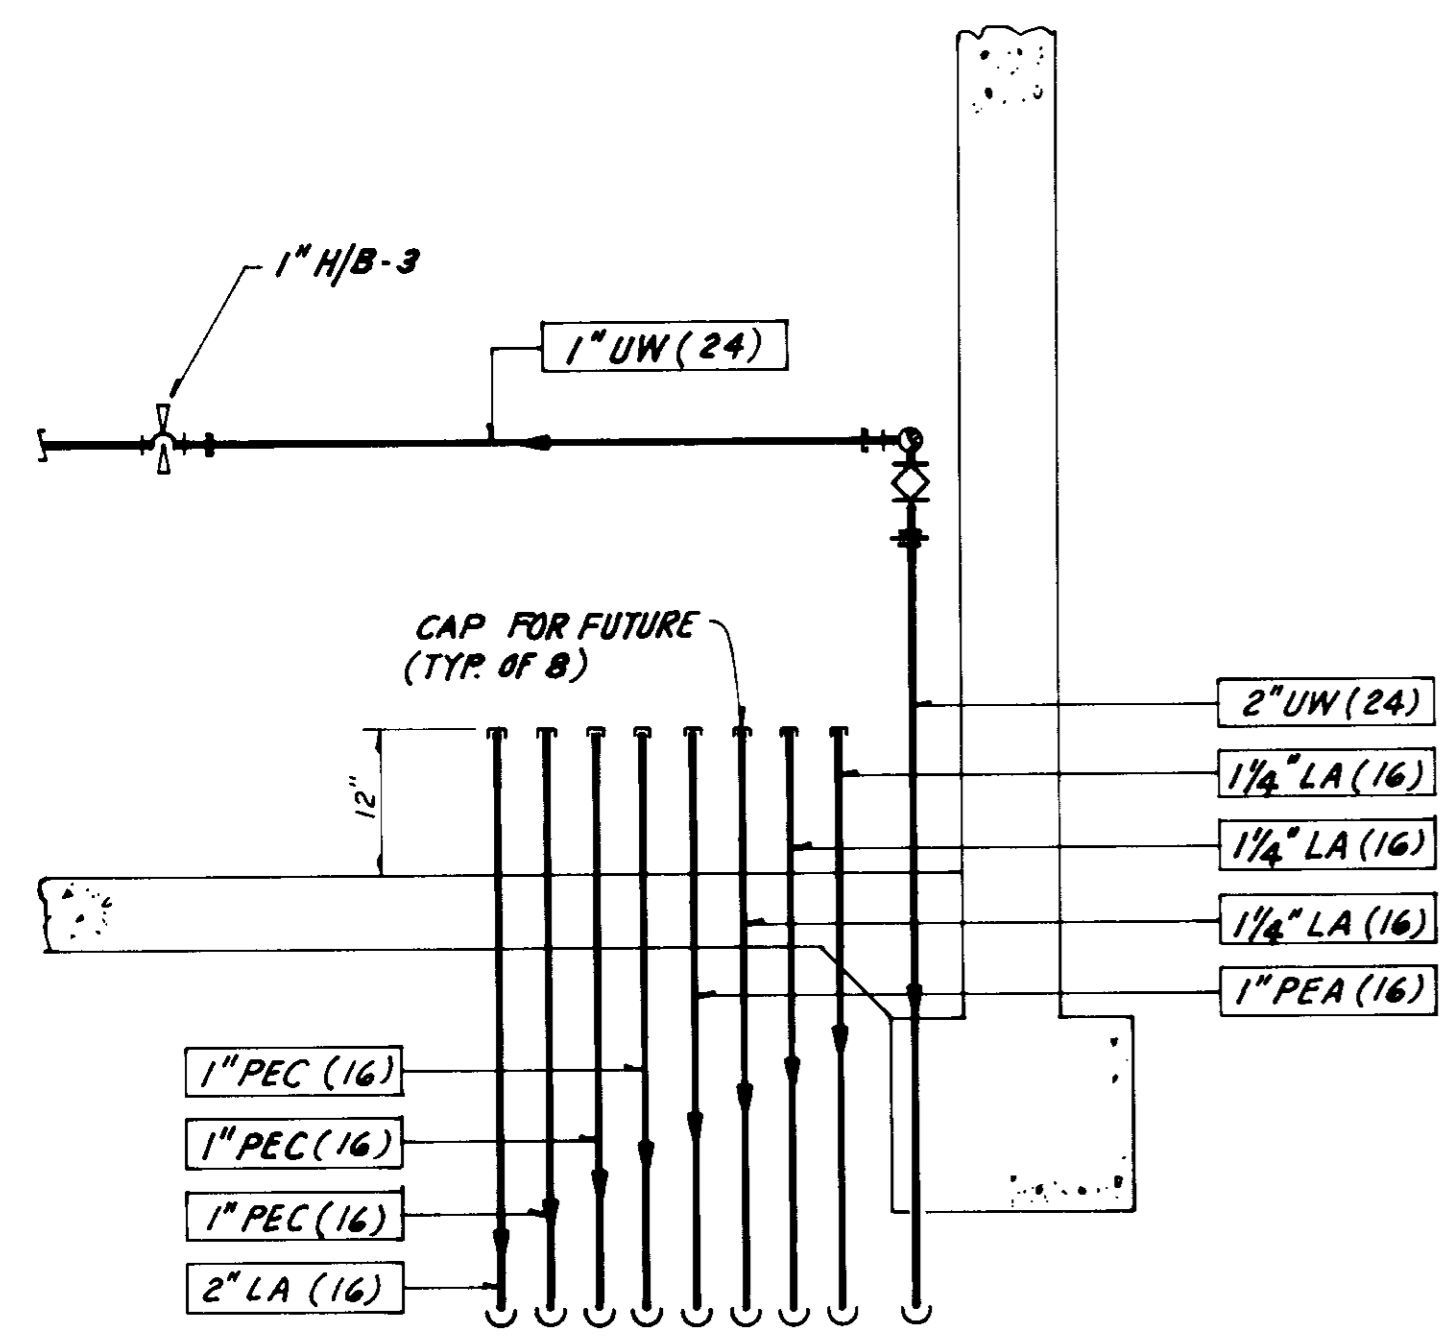


SECTION 2
3/4" = 1'-0"
GM-1

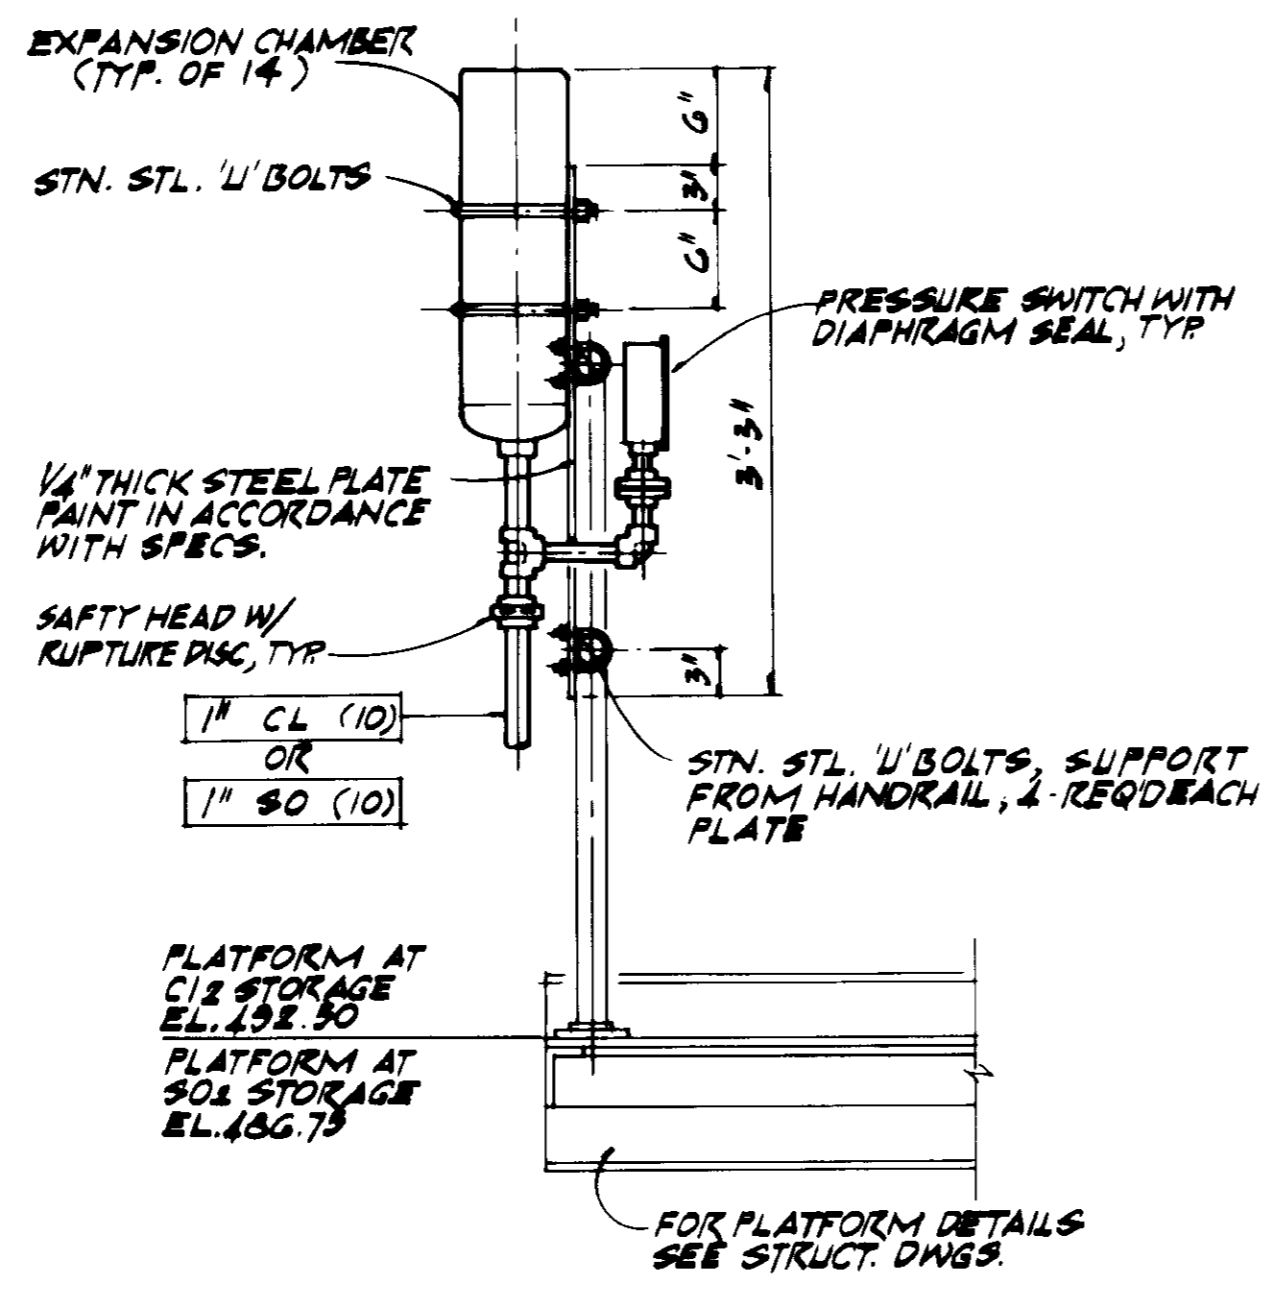


EXPANSION CHAMBER MOUNTING DETAIL
SCALE = 1" = 1'-0"

03572
RECORD DRAWING


RD 11/1/81 MDU	RECORD DRAWINGS	SCALE: AS NOTED	DESIGNED C. SENON	SUBMITTED Project Engineer 27304 R.C.E. NO.	9/19/81 DATE	DISTRICT APPROVAL ON TITLE PAGE	LAB VIRGENES MWD/TRIUNFO CSD	SHEET
			DRAWN R.L.G.	RECOMMENDED 27633 R.C.E. NO.	9/23/81 DATE		TAPIA WRF - FILTRATION/DISINFECTION ADDITION	6M-2
REV	DATE	BY	DESCRIPTION	JAMES M. MONTGOMERY CONSULTING ENGINEERS, INC. 355 EAST WALNUT STREET, PASADENA, CALIFORNIA 91101		PHASE II	CHEMICAL BUILDING AND STORAGE - PIPING SECTIONS, SHEET A	OF 66 SHEETS

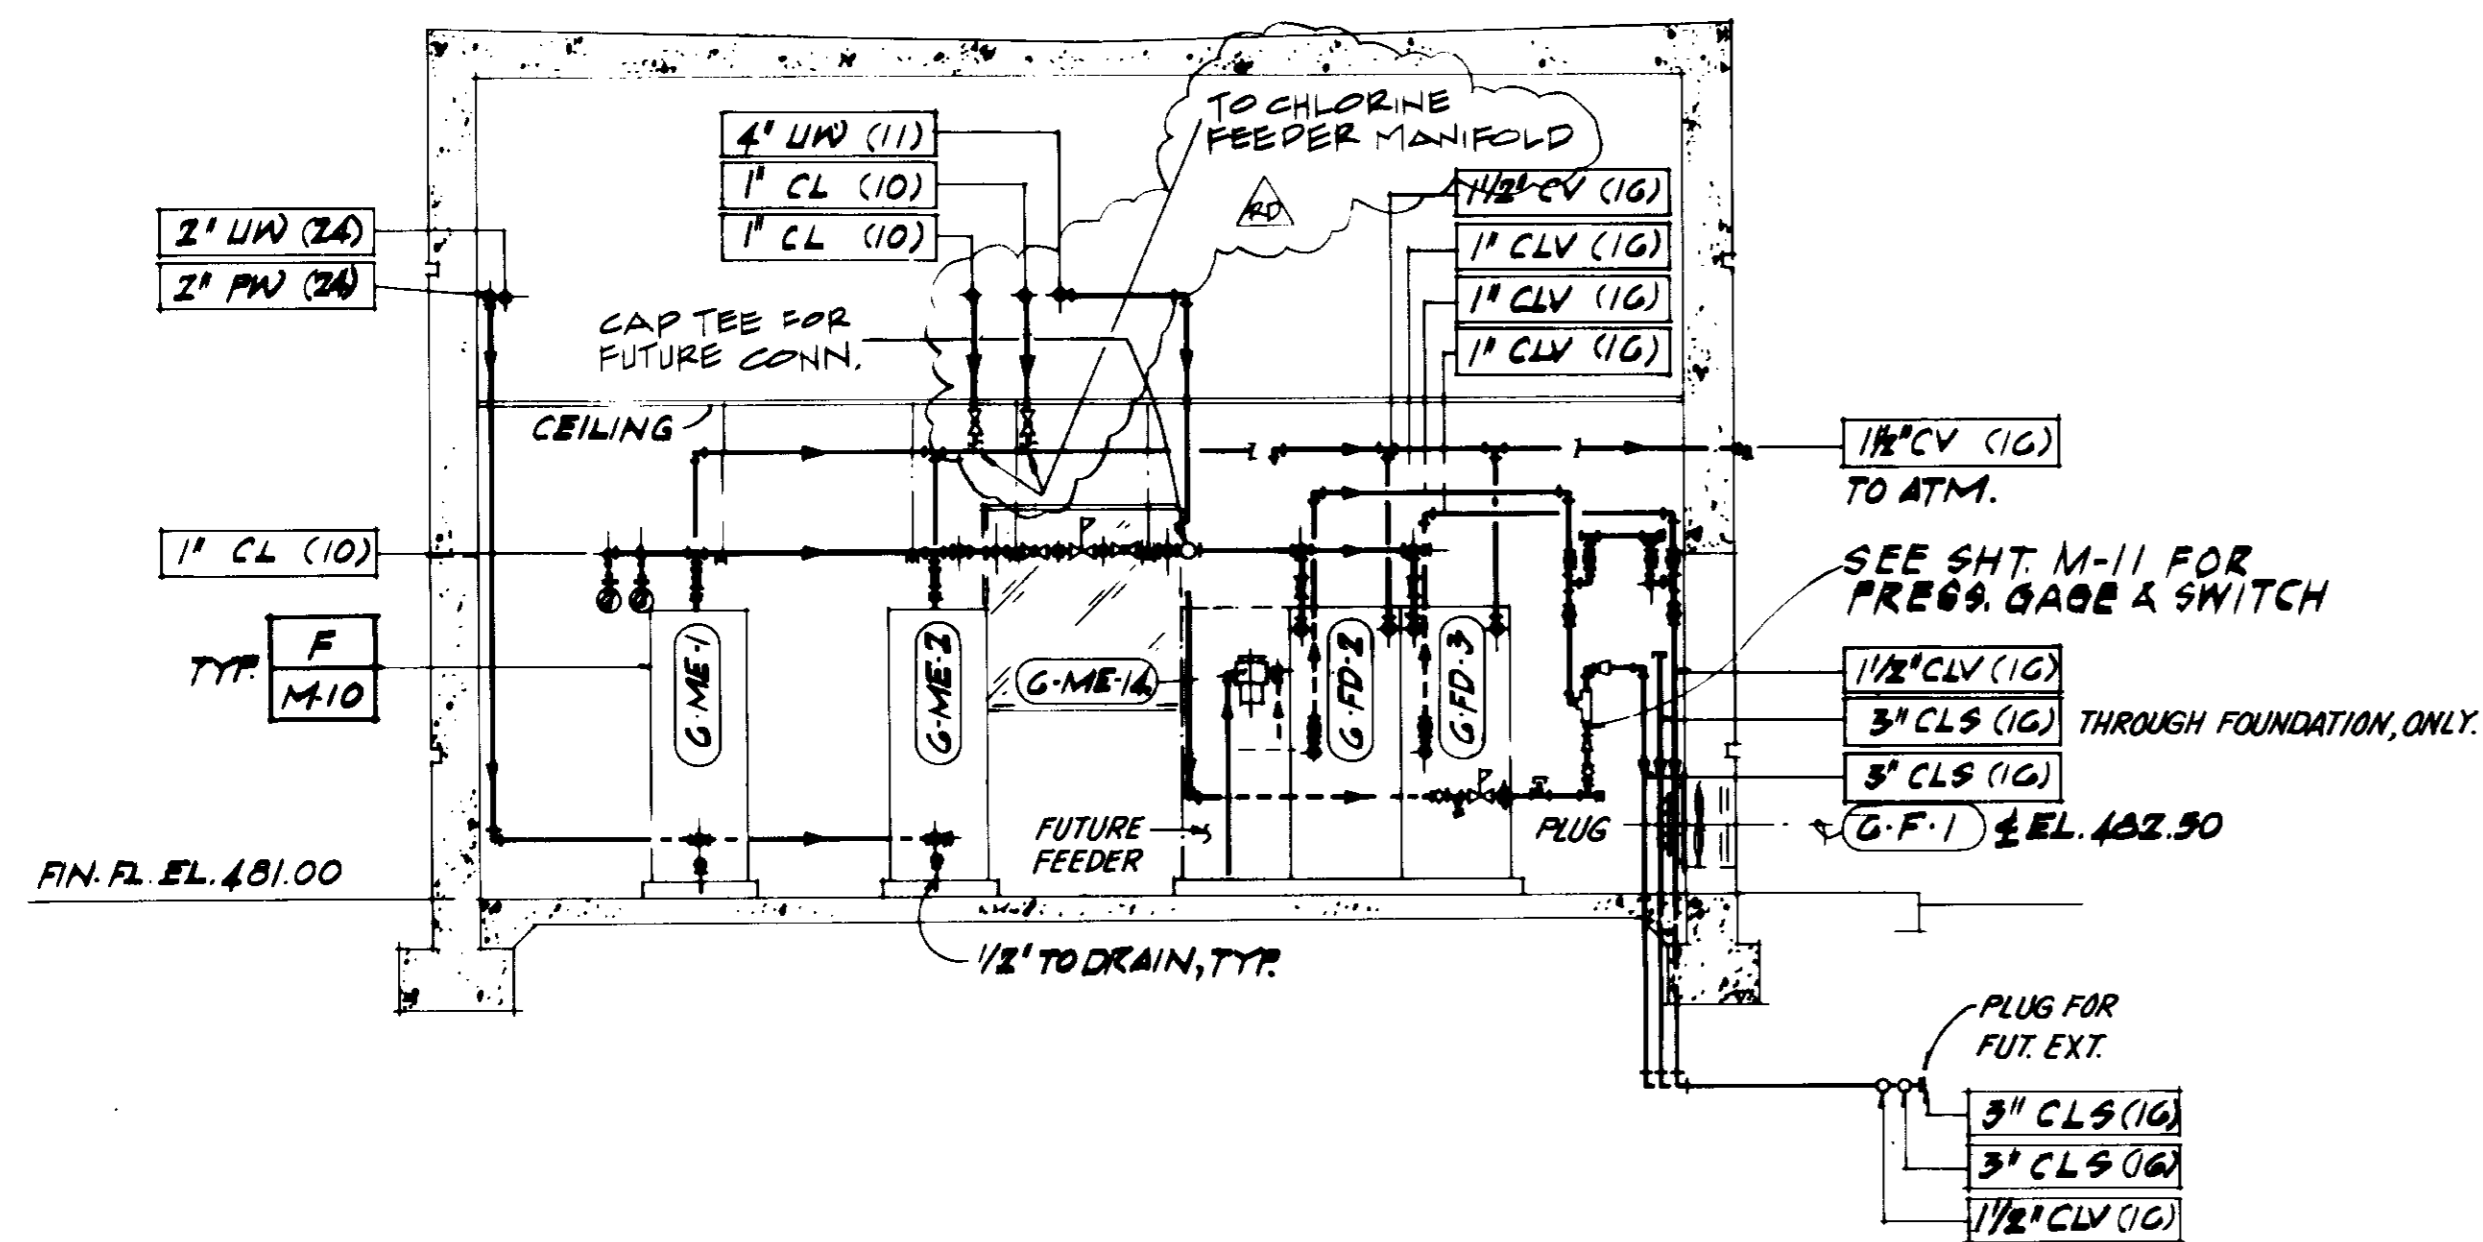

SECTION 3
SCALE = 1/4" = 1'-0"
GM-1

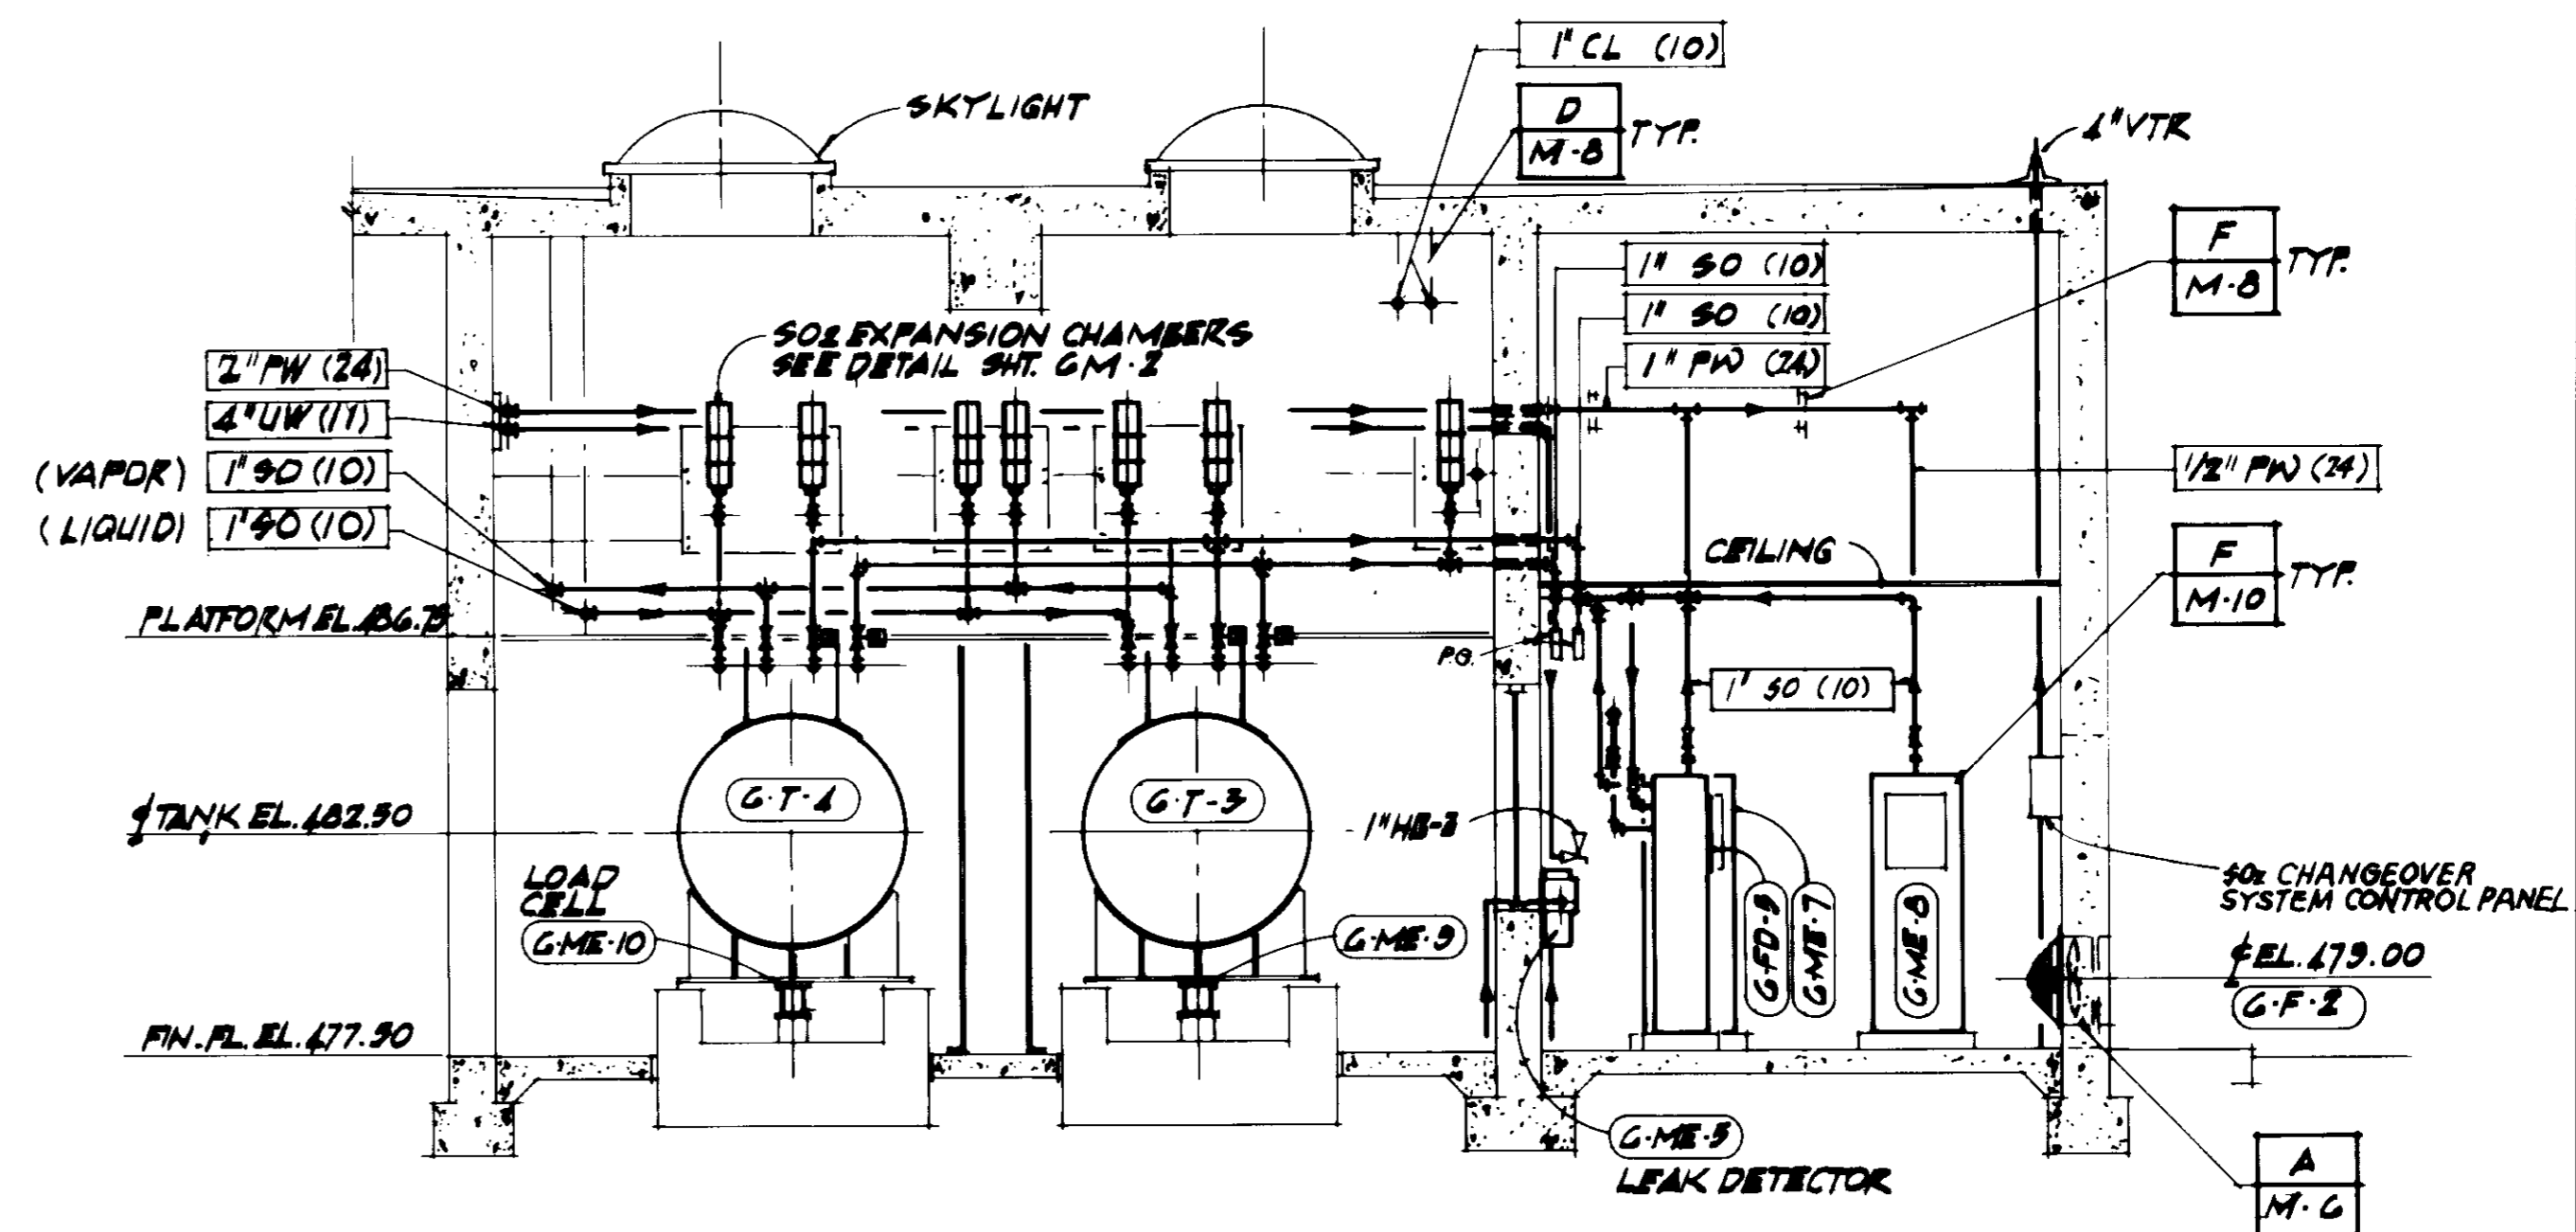

SECTION 4
SCALE = 1/4" = 1'-0"
GM-1

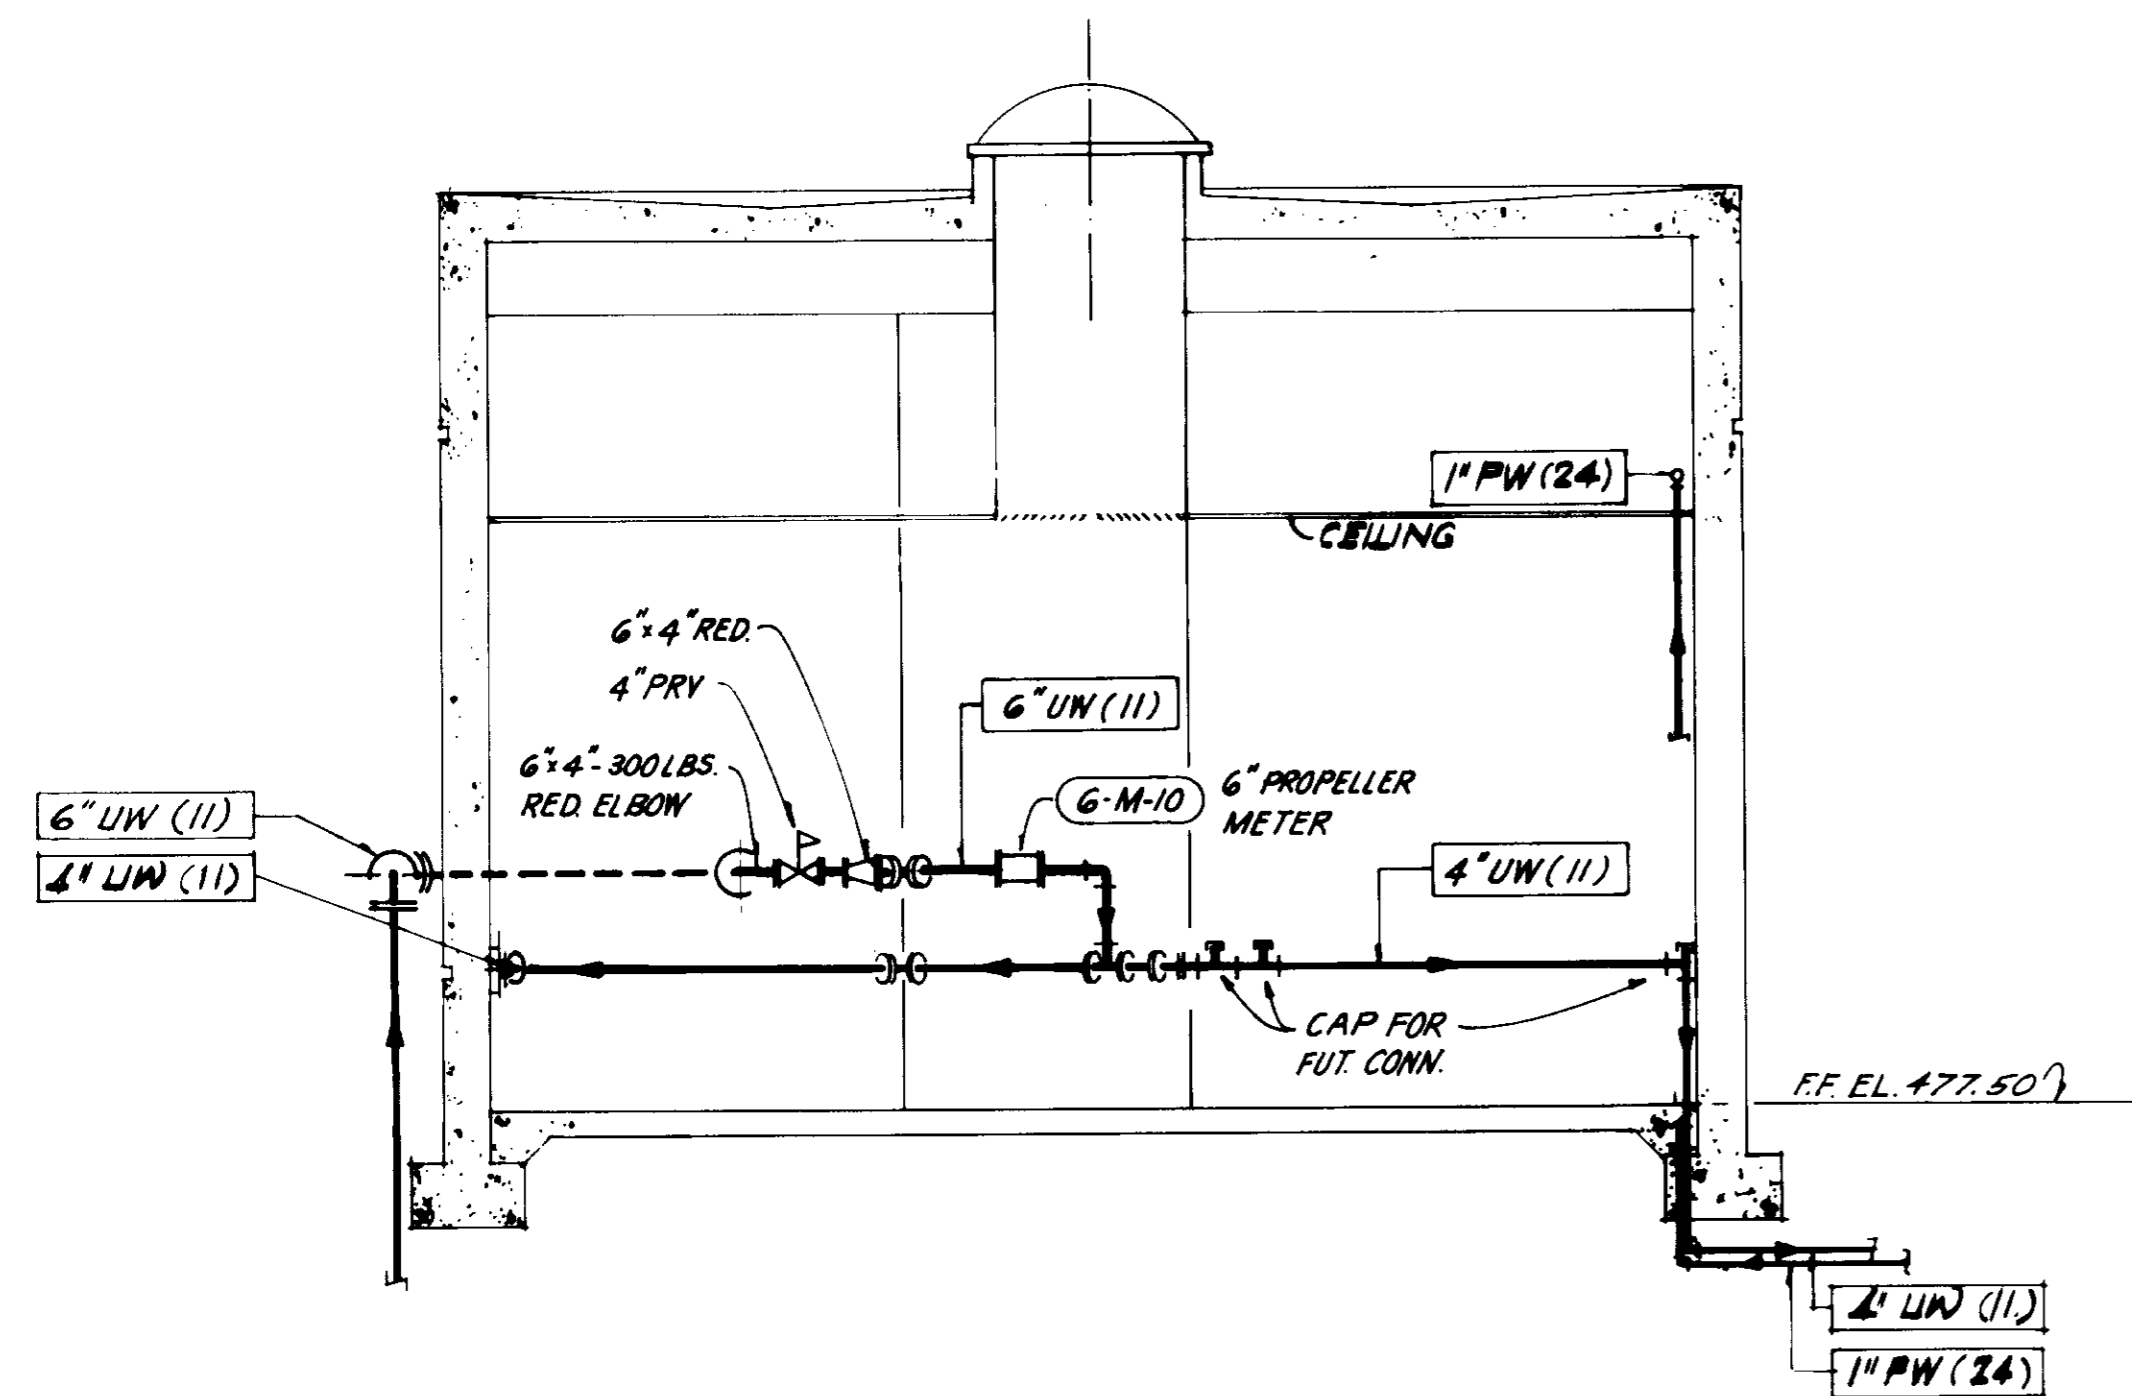

SECTION 5
SCALE = 1/4" = 1'-0"
GM-1

03573

RECORD DRAWING

RD	MILLER MDU	RECORD DRAWINGS
REV	DATE	BY

SCALE:
AS NOTED

DESIGNED R.L.G.
DRAWN R.L.G.
CHECKED C.S.



SUBMITTED
PROJECT ENGINEER
RECOMMENDED BY
JAMES M. MONTGOMERY CONSULTING ENGINEERS, INC.

27304 8/19/81
DATE
27032 8/20/81
DATE
JAMES M. MONTGOMERY CONSULTING ENGINEERS, INC.
355 EAST WALNUT STREET, PASADENA, CALIFORNIA 91001

DISTRICT APPROVAL ON TITLE PAGE

LAB VIRGENES MWD/TRIUNFO CSD
TAPIA WRF - FILTRATION/DISINFECTION ADDITION
PHASE II
CHEMICAL BUILDING AND STORAGE - PIPING SECTIONS, SHEET 8

SHEET
GM-3
OF 66 SHEETS

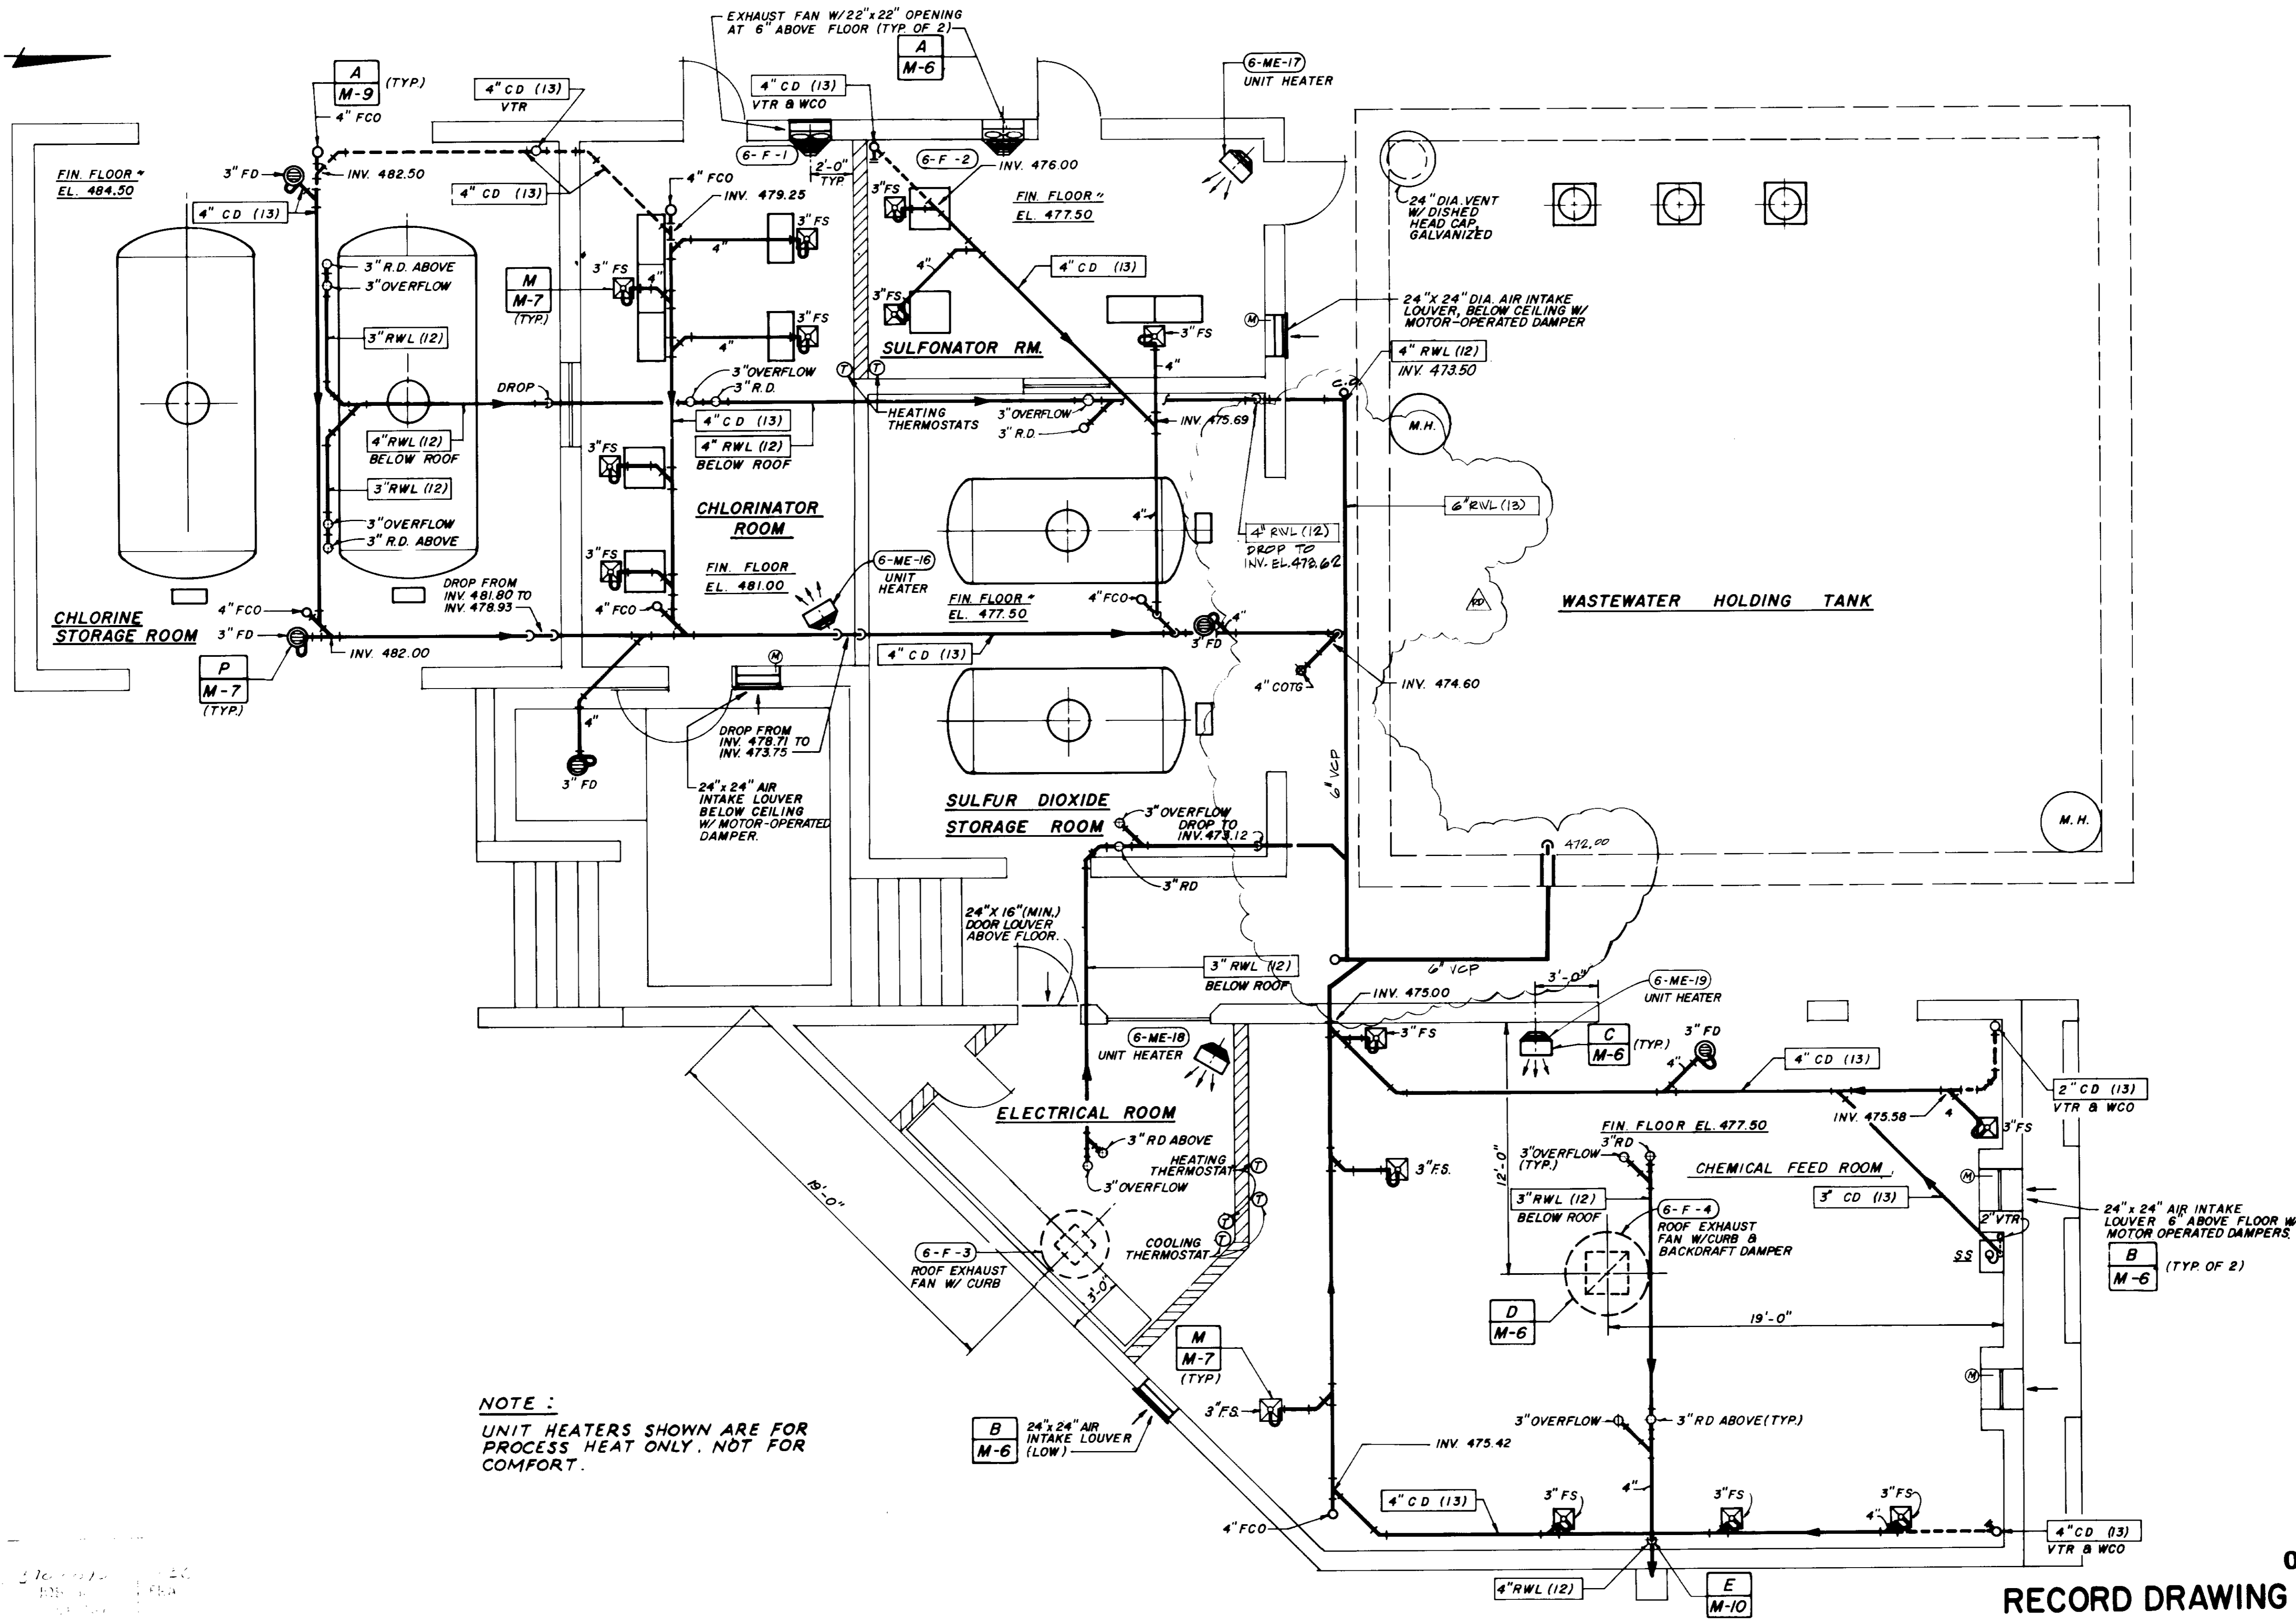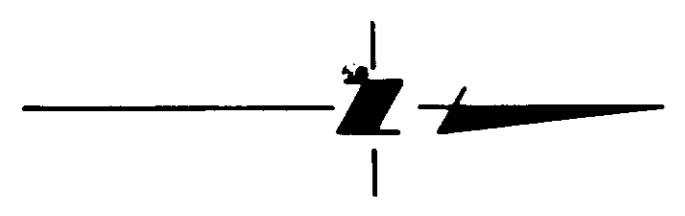

NOTE :
 UNIT HEATERS SHOWN ARE FOR
 PROCESS HEAT ONLY. NOT FOR
 COMFORT.

03574

RECORD DRAWING

REV	DATE	BY	DESCRIPTION

SCALE:
 1/4" = 1'-0"



DESIGNED	<i>J. Mont...</i>	SUBMITTED	<i>J. Mont...</i>	27304	8/13/81
DRAWN	<i>M. S. C...</i>	PROJECT ENGINEER		R.C.E. NO.	DATE
CHECKED	<i>J. Mont...</i>	RECORDED	<i>J. Mont...</i>	27633	8/20/81
		JAMES M. MONTGOMERY CONSULTING ENGINEERS, INC.		R.C.E. NO.	DATE

JAMES M. MONTGOMERY CONSULTING ENGINEERS, INC.
 555 EAST WALNUT STREET, PASADENA, CALIFORNIA 91101





DISTRICT APPROVAL ON TITLE PAGE

LAS VIRGENES MWD/TRIUNFO CSD	
TAPIA WRF - FILTRATION/DISINFECTION ADDITION	
PHASE II	CHEMICAL BUILDING AND STORAGE - HEATING, VENTILATING, AND DRAINAGE

SHEET
6M-4
 OF 66 SHEETS


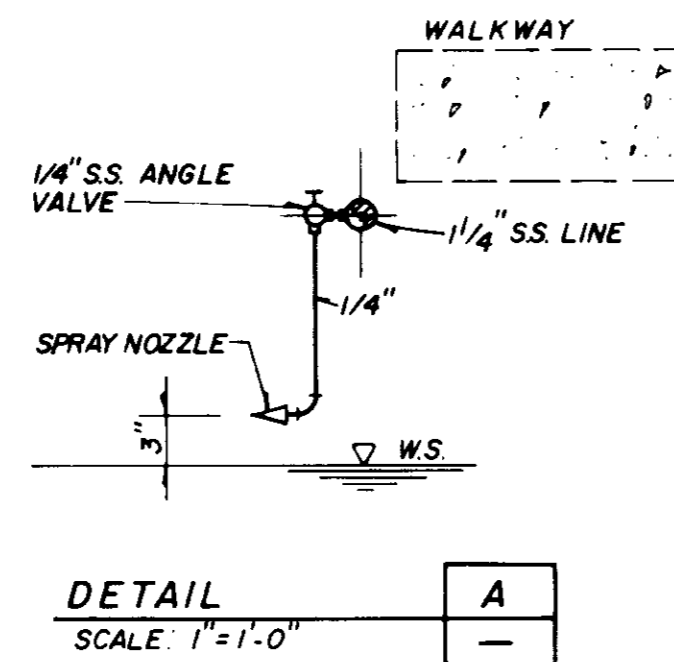
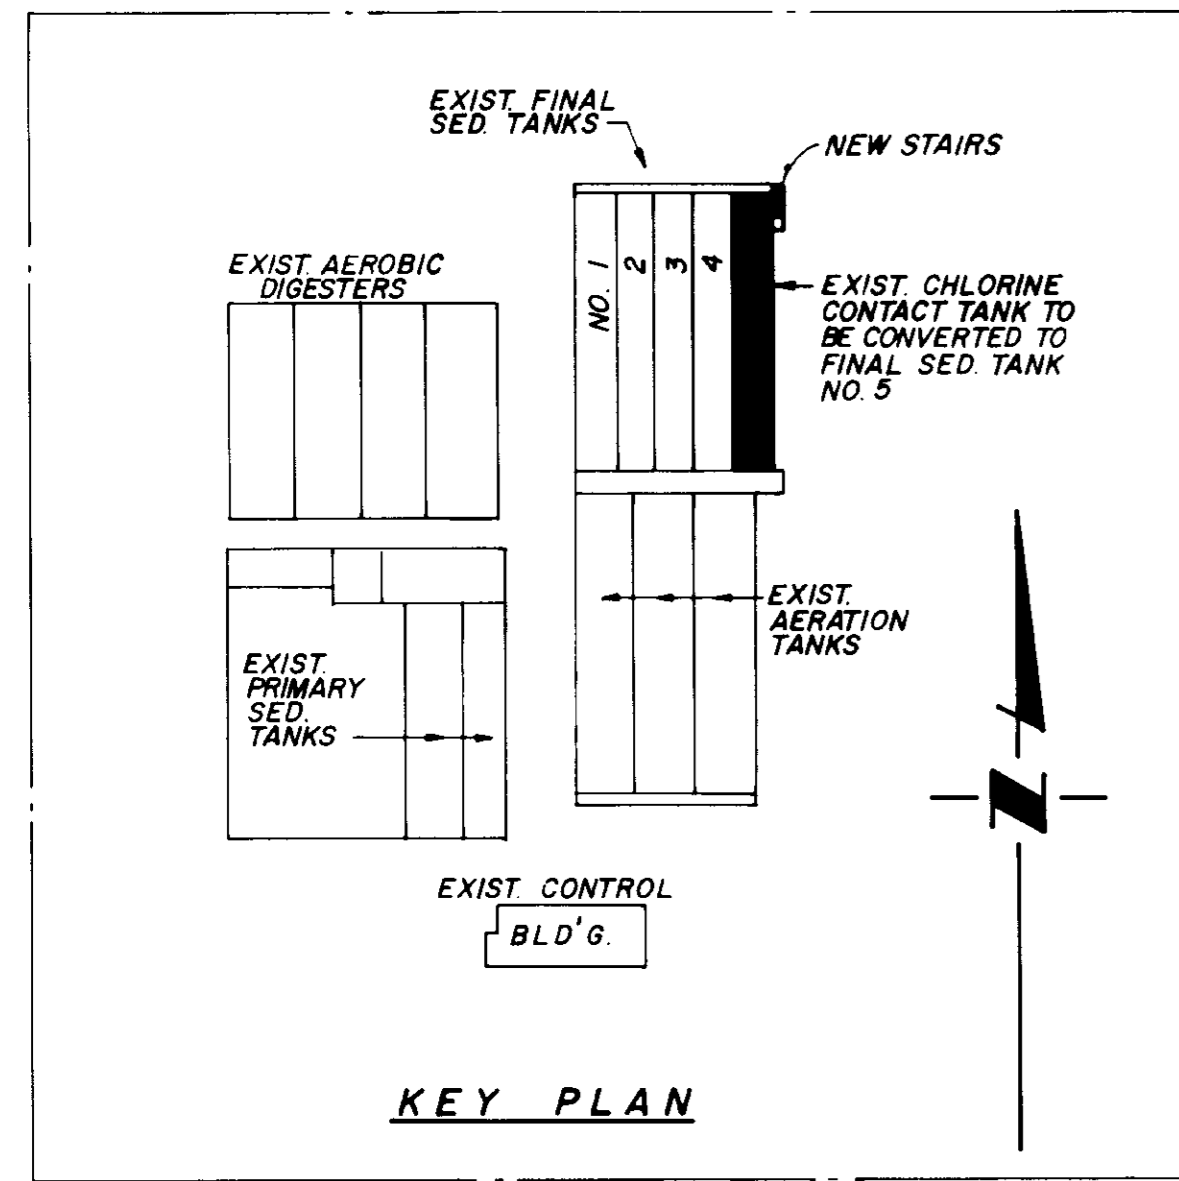


4 - 1/4" S.S. ANGLE VALVES WITH 1/4" S.S. PIPE AND SPRAY NOZZLE (SEE DETAIL 'A' ABOVE)

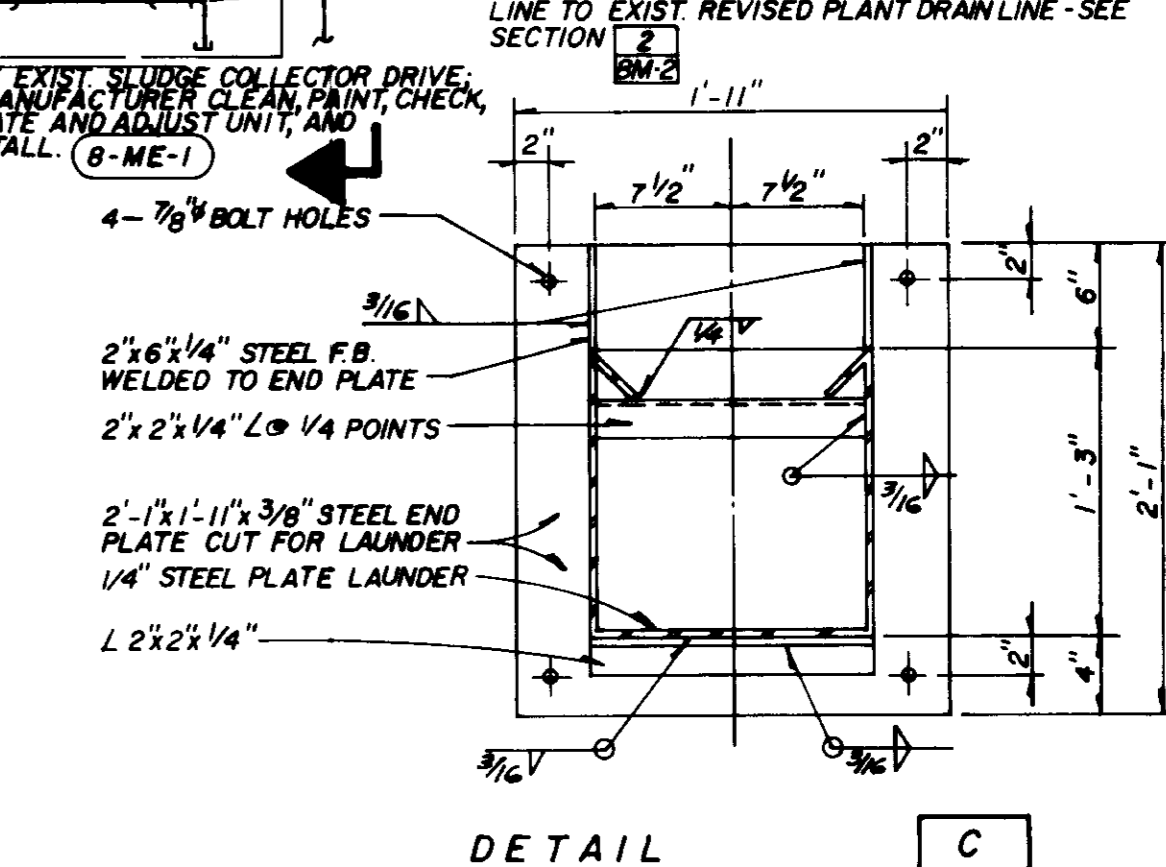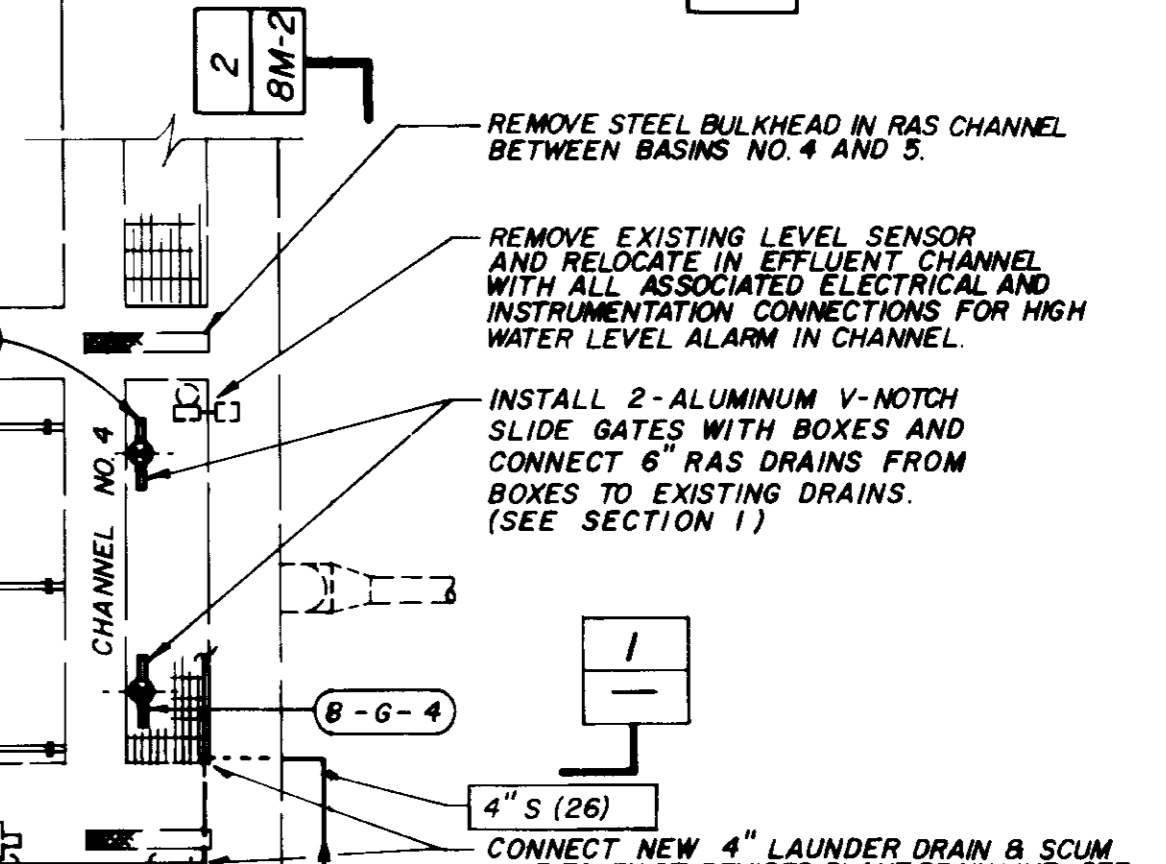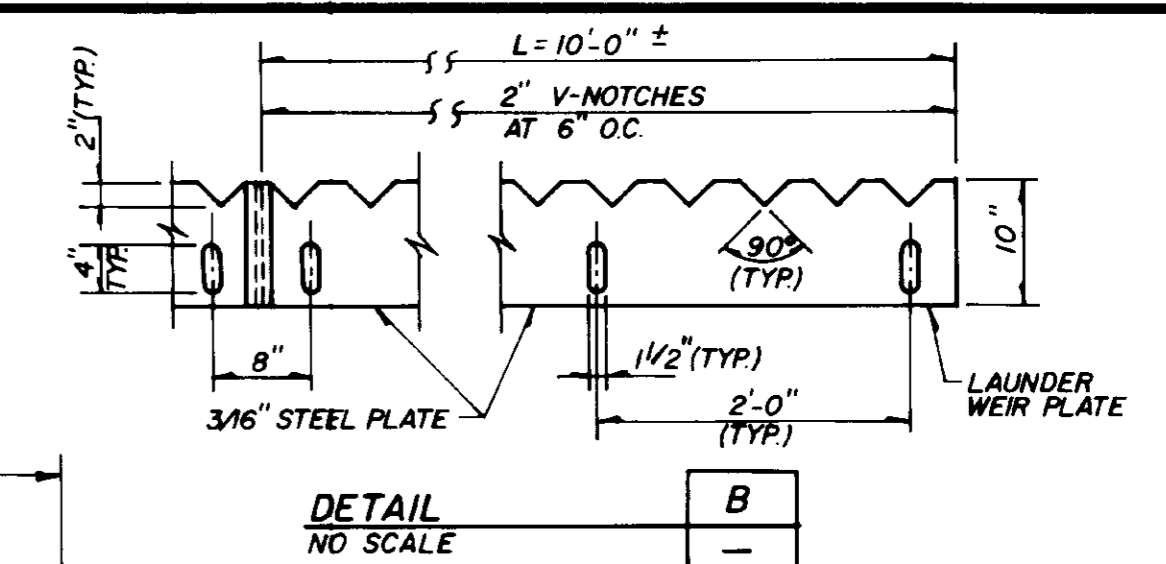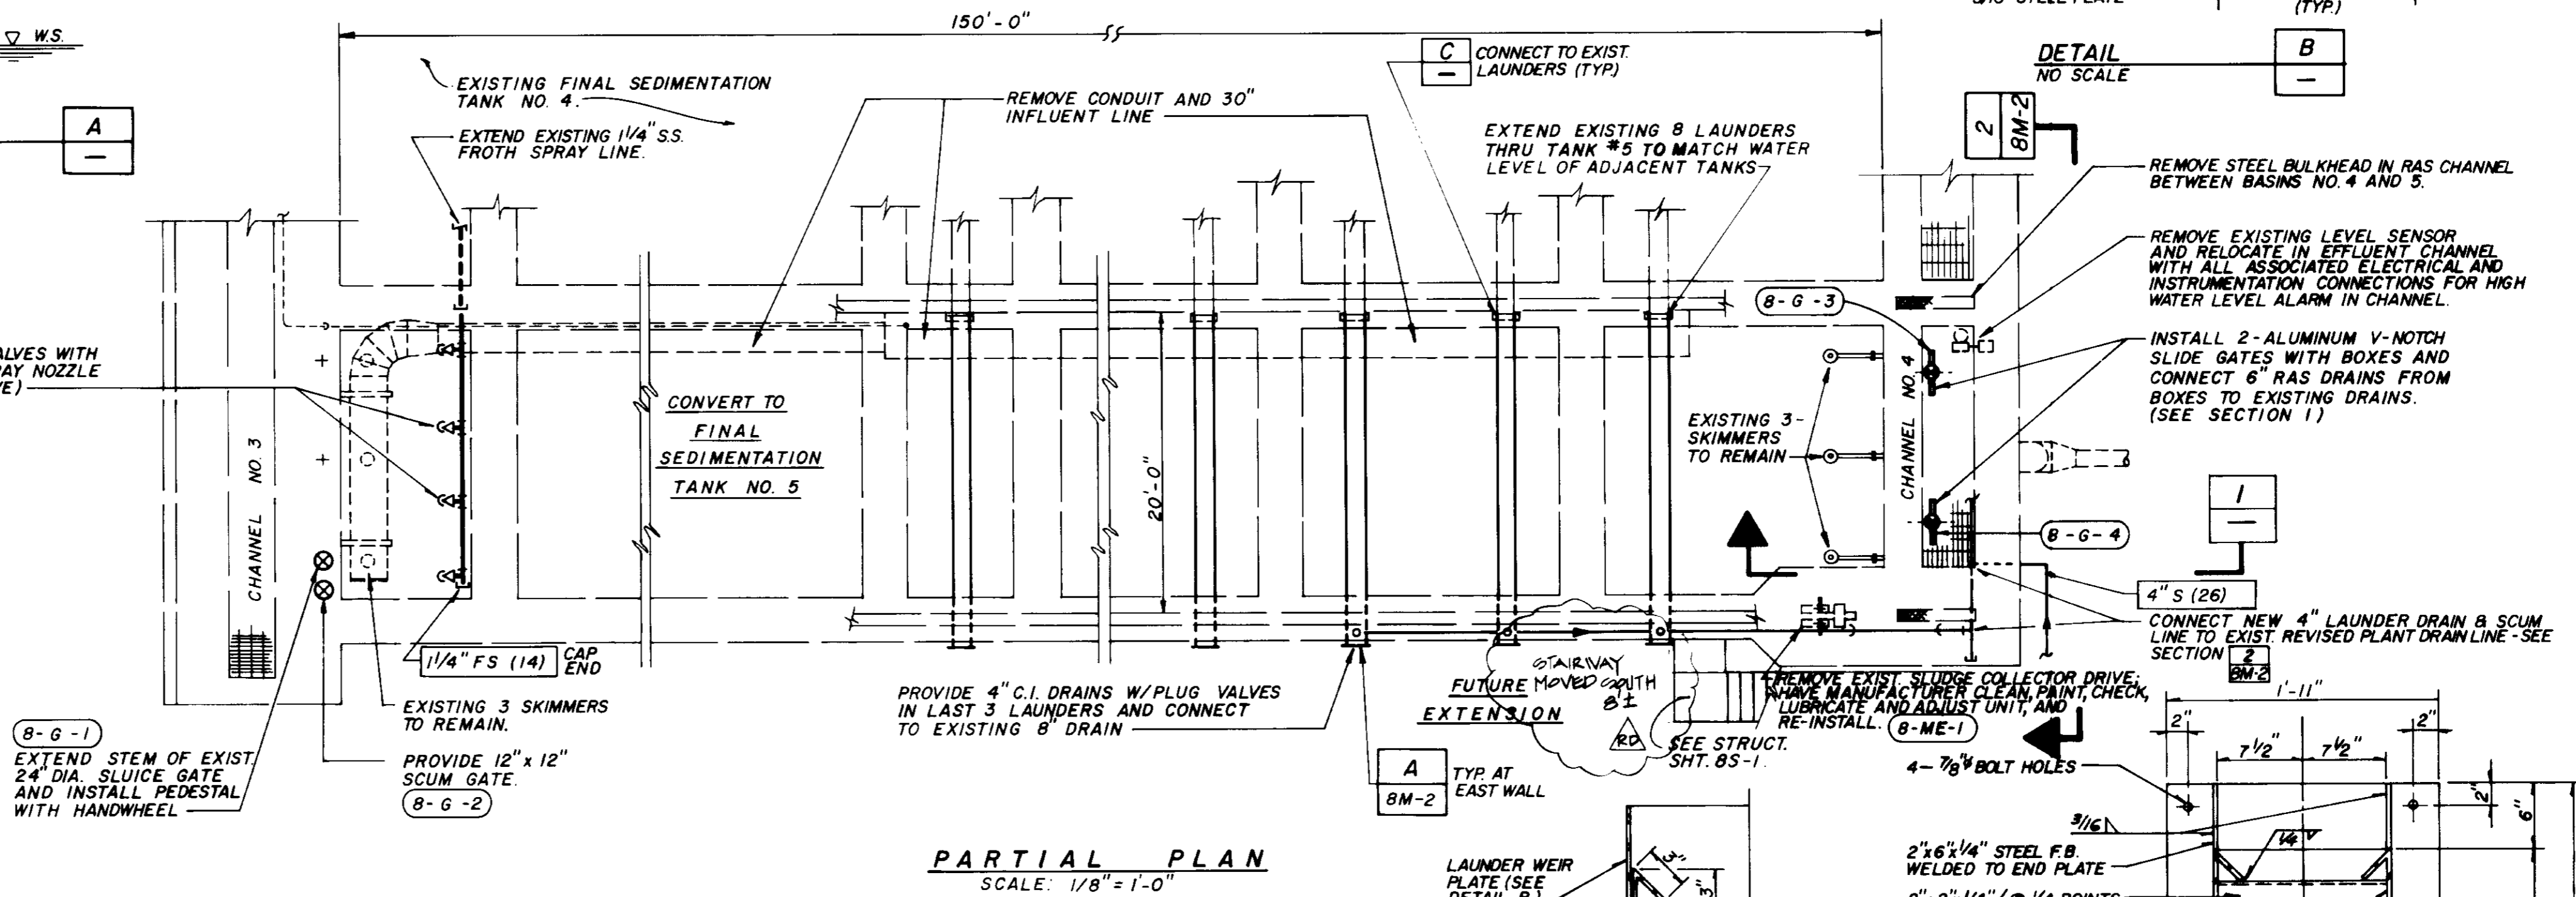

FURNISH AND INSTALL TWO ALUMINUM V-NOTCH METERING GATES W/HANDWHEEL OPERATORS, FLANGED TO ALUMINUM BOXES IN CHANNEL. SEE SHEET 8M-2.

INSTALL 3/8\"/>

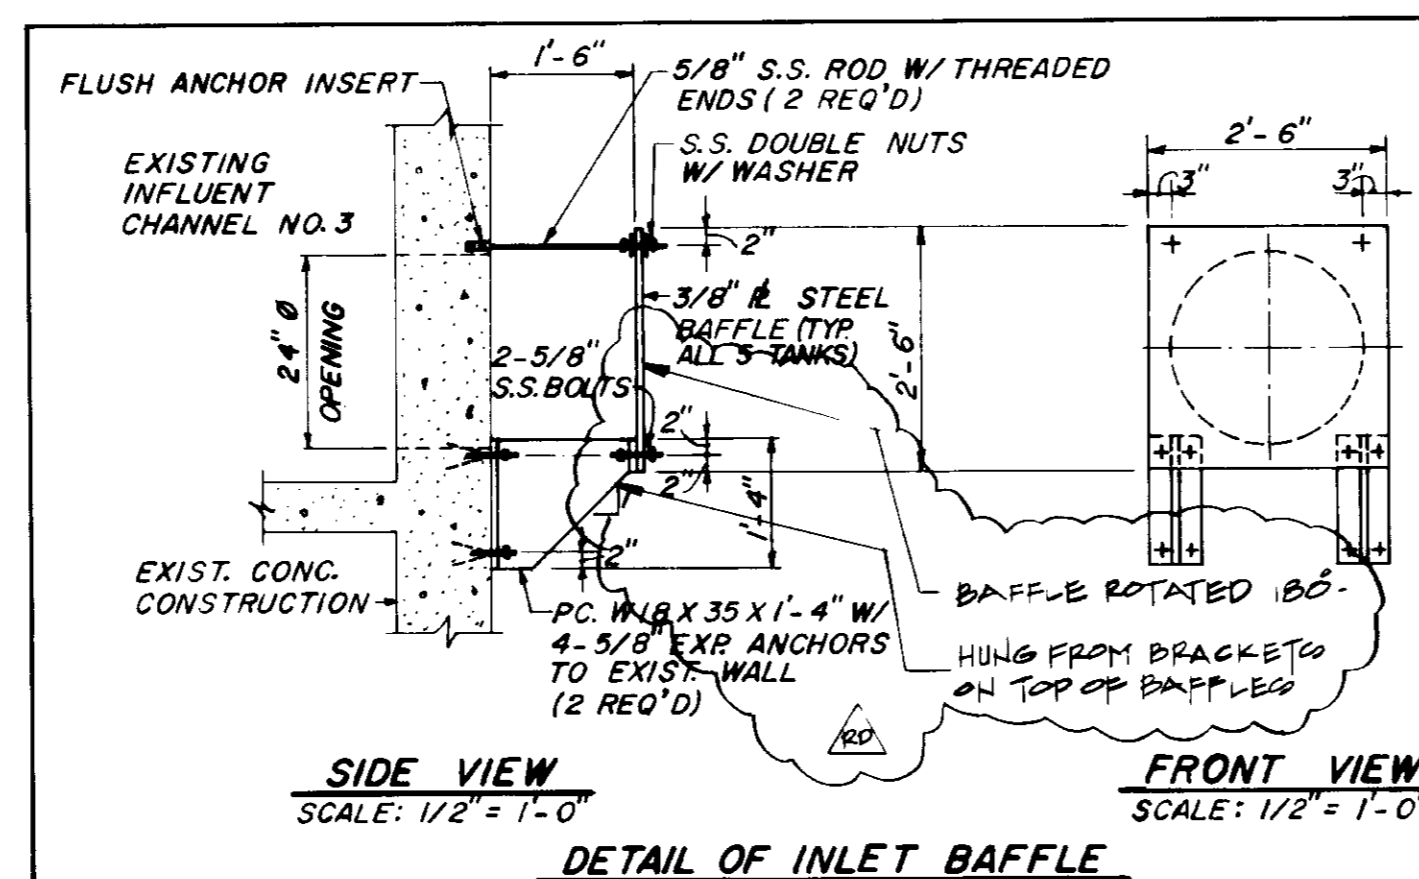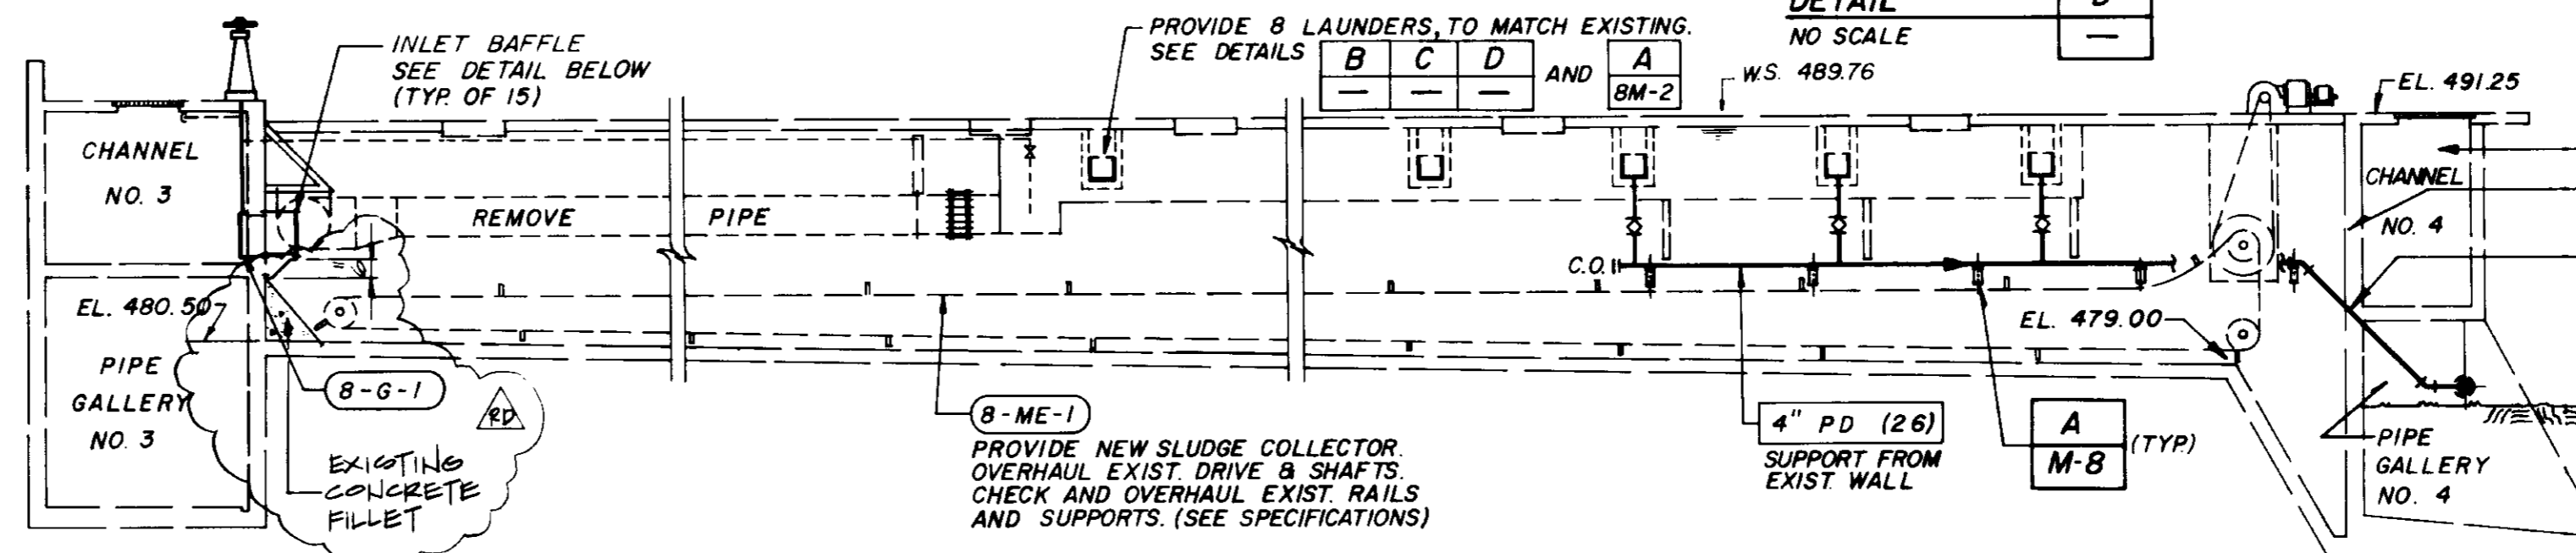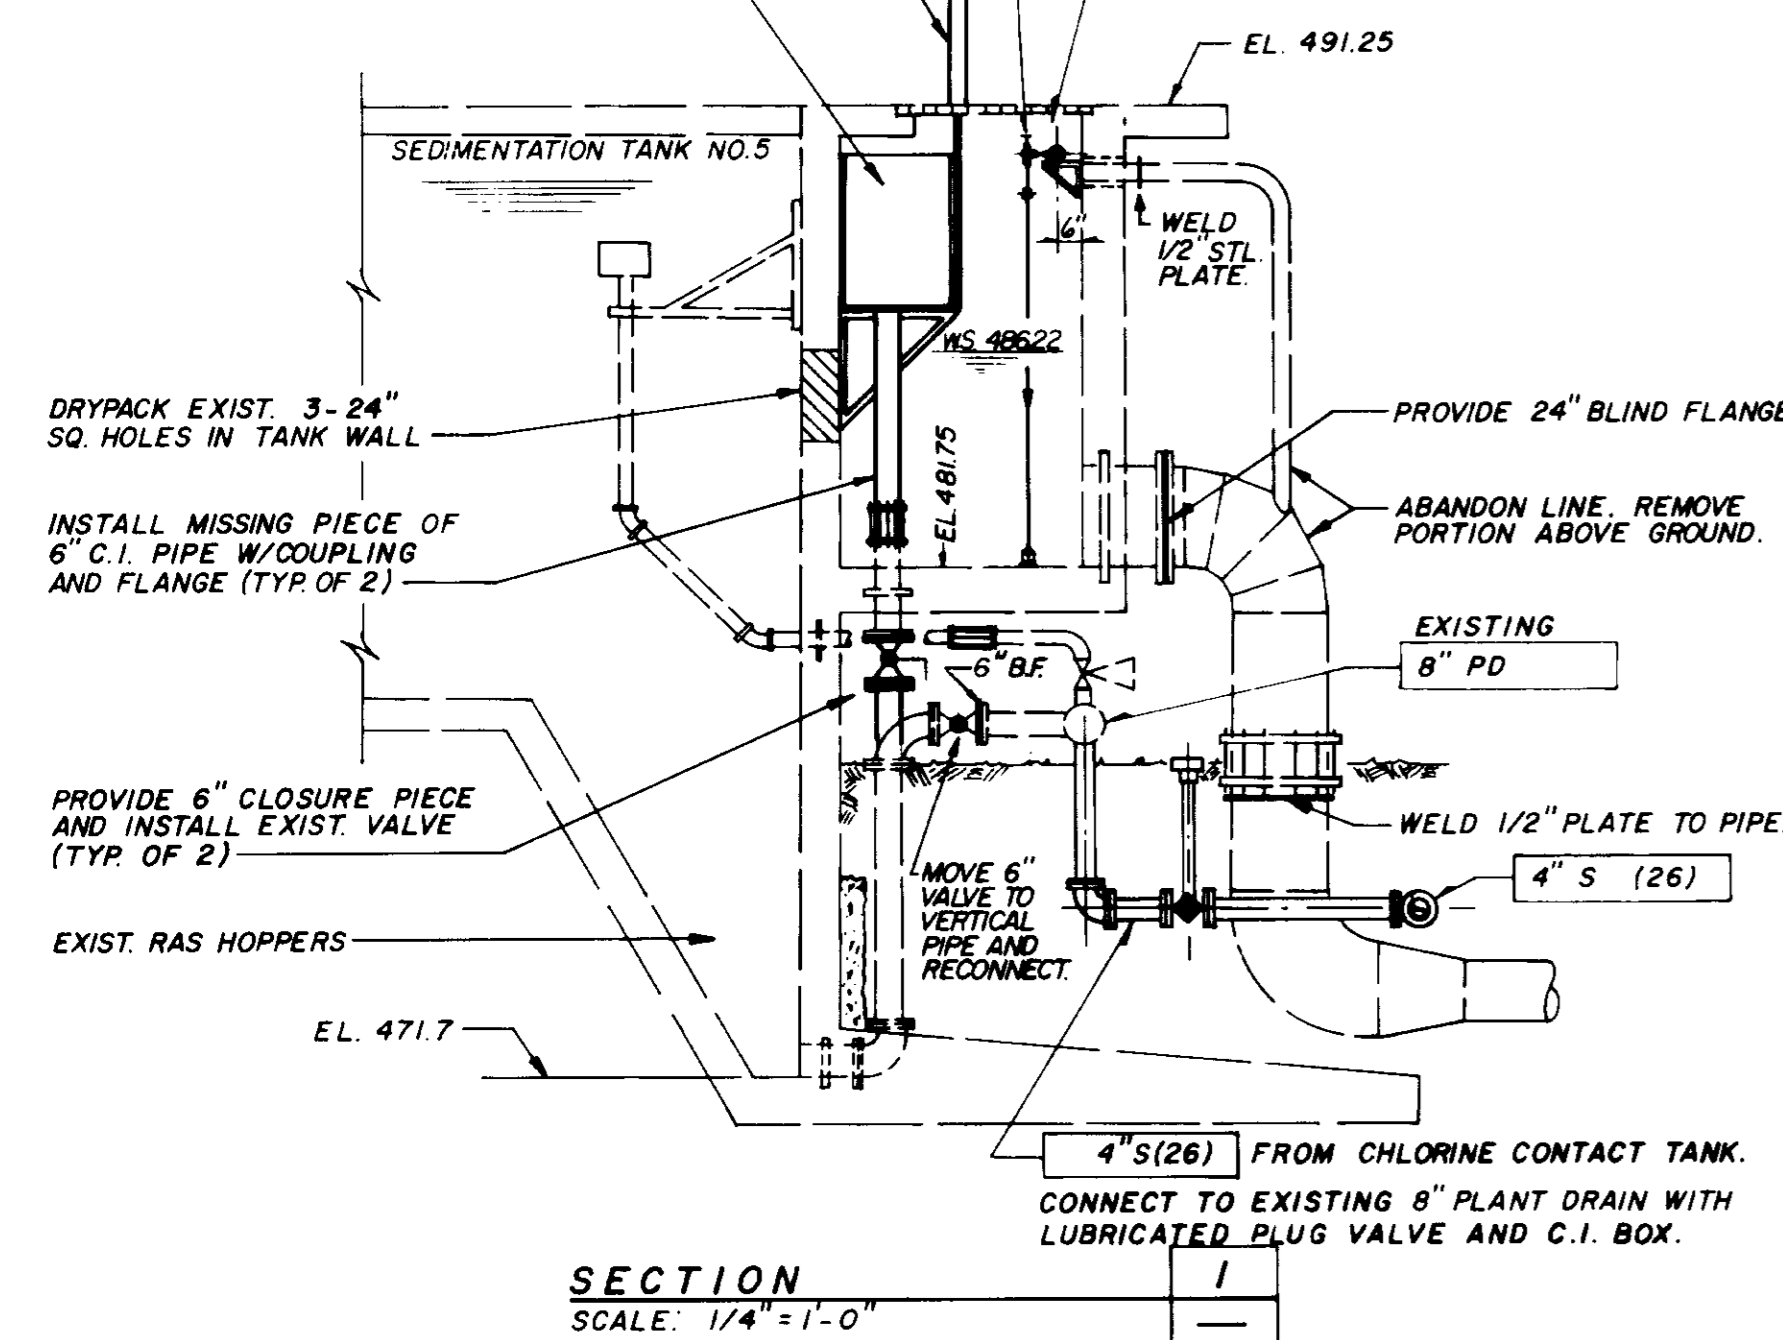

NOTE:
 1. ALL STEEL PARTS SHALL BE GALVANIZED AFTER FABRICATION
 2. ALL BOLTS, NUTS, WASHERS, ANCHORS & INSERTS FOR CONNECTIONS TO EXIST. CONC. WALL SHALL BE STAINLESS STEEL
 3. PROVIDE 3 NEW INLET BAFFLES FOR EACH OF 5 FINAL SEDIMENTATION TANKS, AS DETAILED.

NOTES:
 1. THE EXISTING CHLORINE CONTACT TANK SHALL BE CONVERTED TO A FINAL SEDIMENTATION TANK NO. 5 - REMOVE ALL UNNECESSARY EQUIPMENT AND PIPING AND SEAL OPENINGS. MATCH ALL EQUIPMENT OF EXISTING FINAL SEDIMENTATION TANKS #1-4.
 2. PRIOR TO CONVERSION OF TANK NO. 5, ALL WORK AT JUNCTION STRUCTURE NW OF FINAL SEDIMENTATION TANK NO.1 MUST BE COMPLETED. (SEE CIVIL DRAWINGS)

RECORD DRAWING 03575

RD	4/1/84	MOU	RECORD DRAWING
REV	DATE	BY	DESCRIPTION

SCALE:	AS NOTED
DESIGNED	J. McCutchen
DRAWN	J. McCutchen
CHECKED	J. McCutchen










SUBMITTED	27304	8/19/81
PROJECT ENGINEER	R.C.E. NO.	DATE
RECOMMENDED	27638	8/22/81
REGISTERED PROFESSIONAL ENGINEER	R.C.E. NO.	DATE

JAMES M. MONTGOMERY CONSULTING ENGINEERS, INC.
 355 EAST WALNUT STREET, PASADENA, CALIFORNIA 91101

DISTRICT APPROVAL ON TITLE PAGE

PHASE II	EXISTING CHLORINE CONTACT CHANNEL CONVERSION - PLAN AND SECTIONS
----------	--

SHEET	8M-1
OF 66 SHEETS	

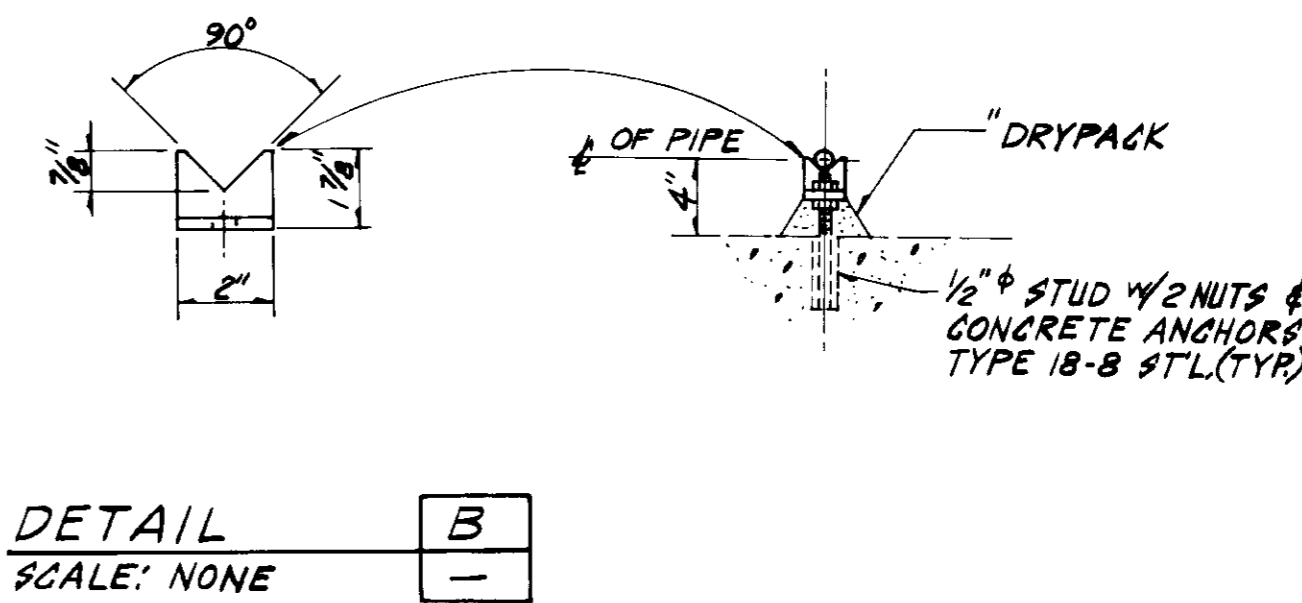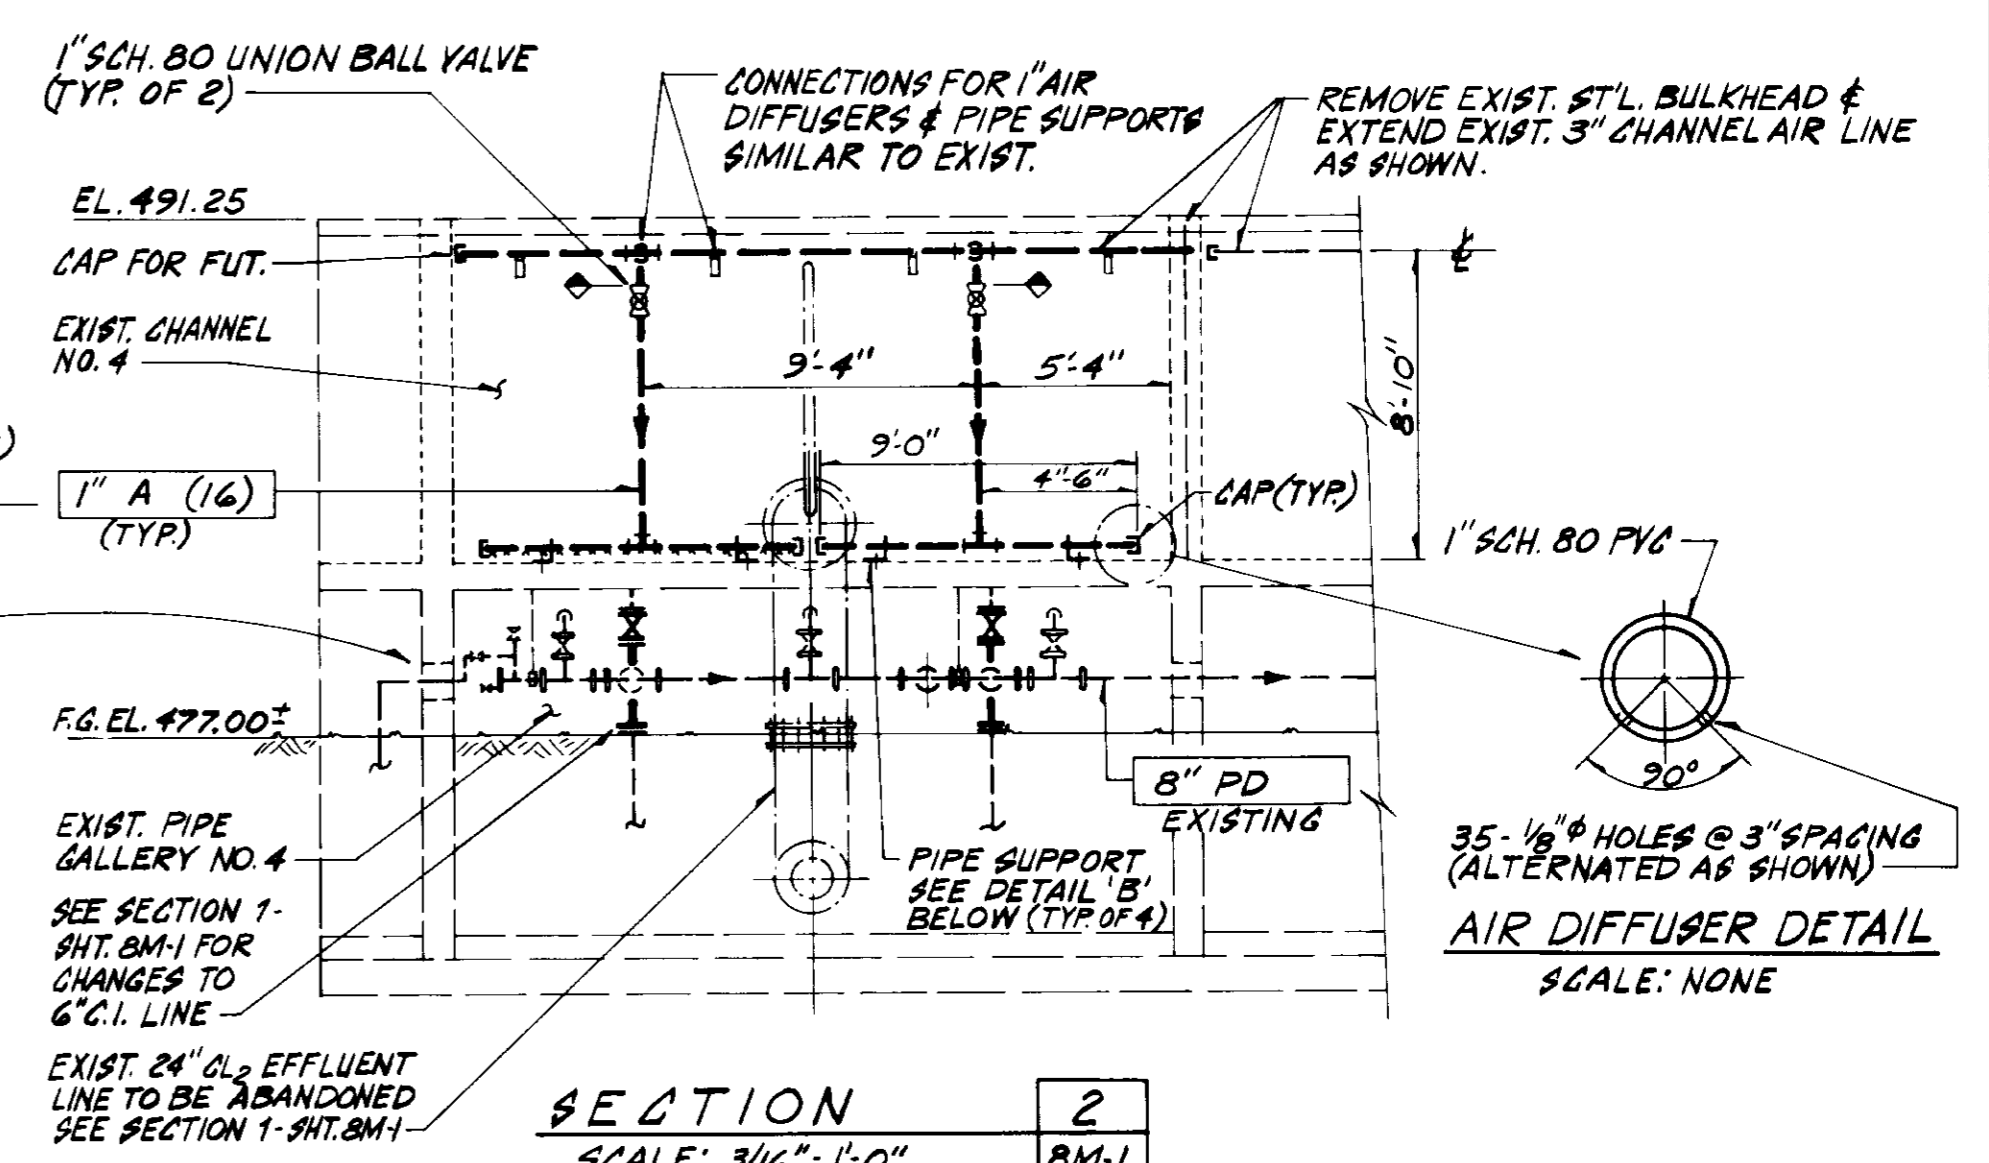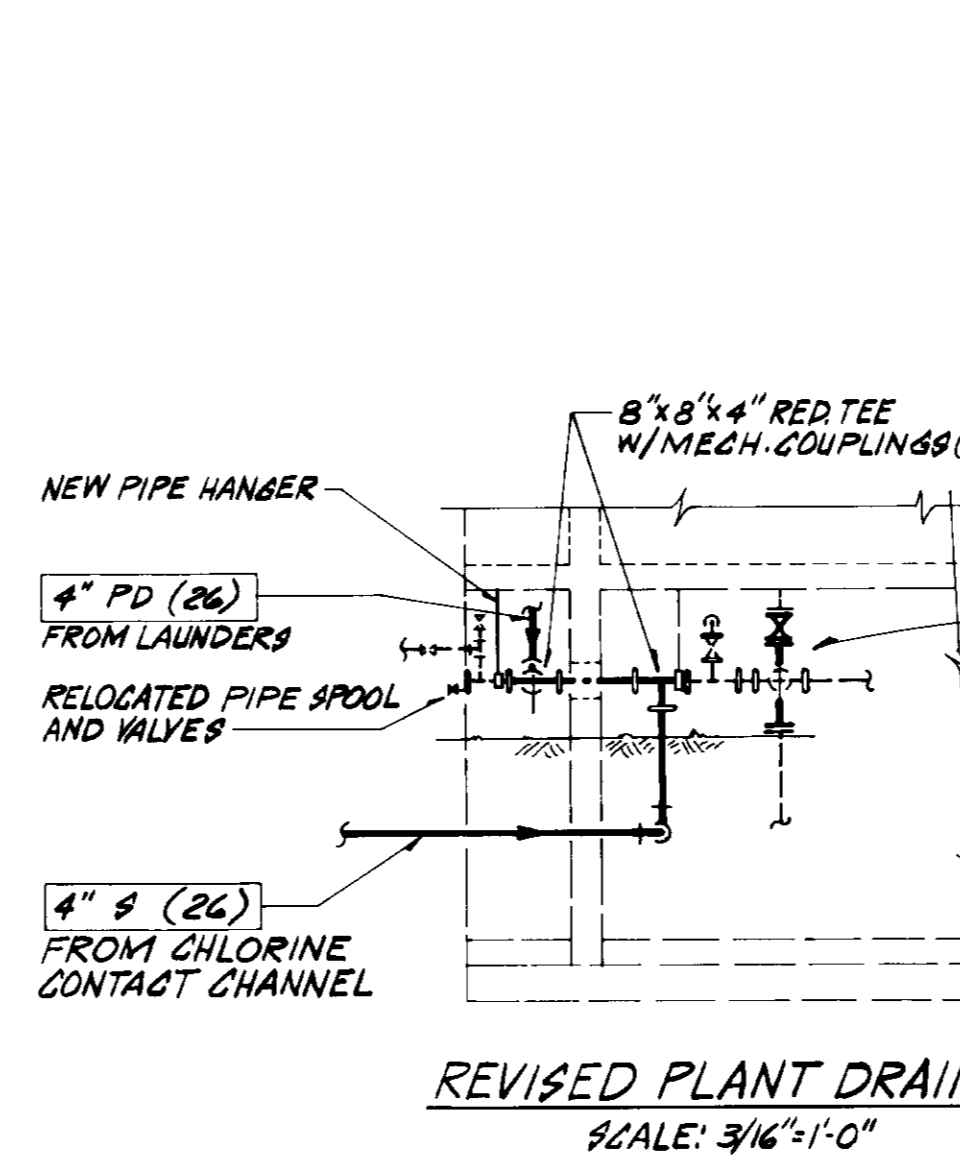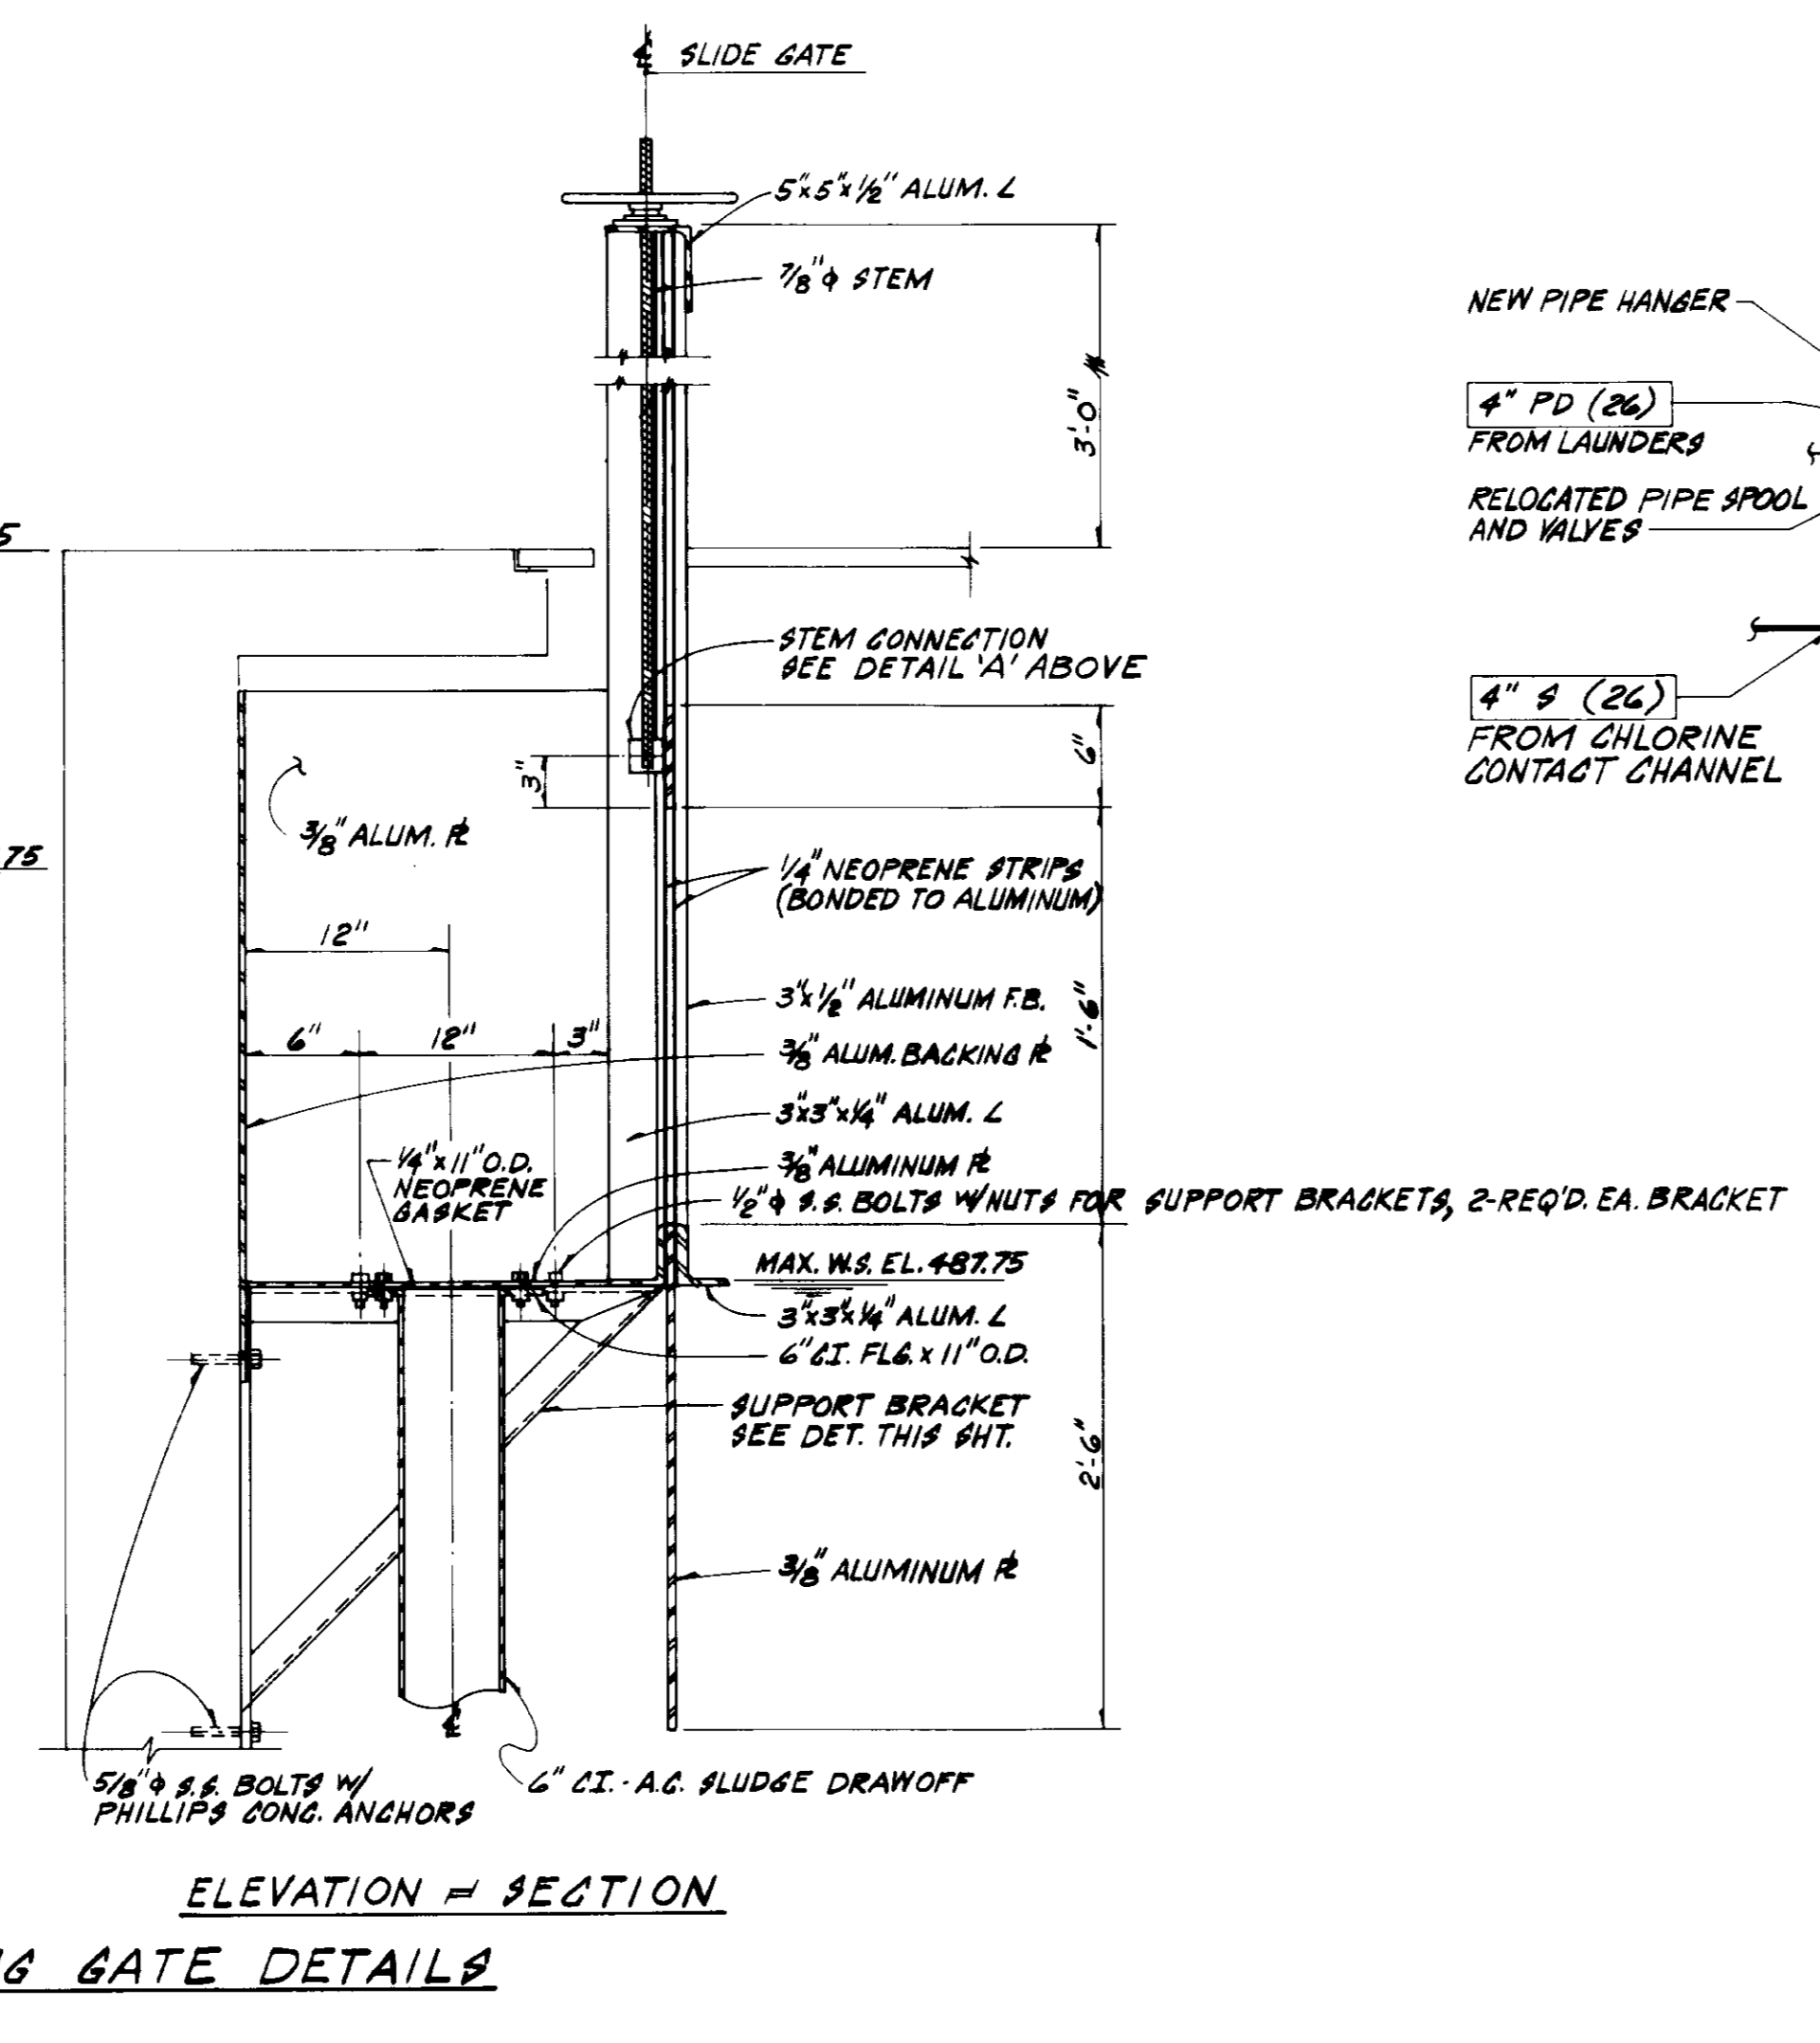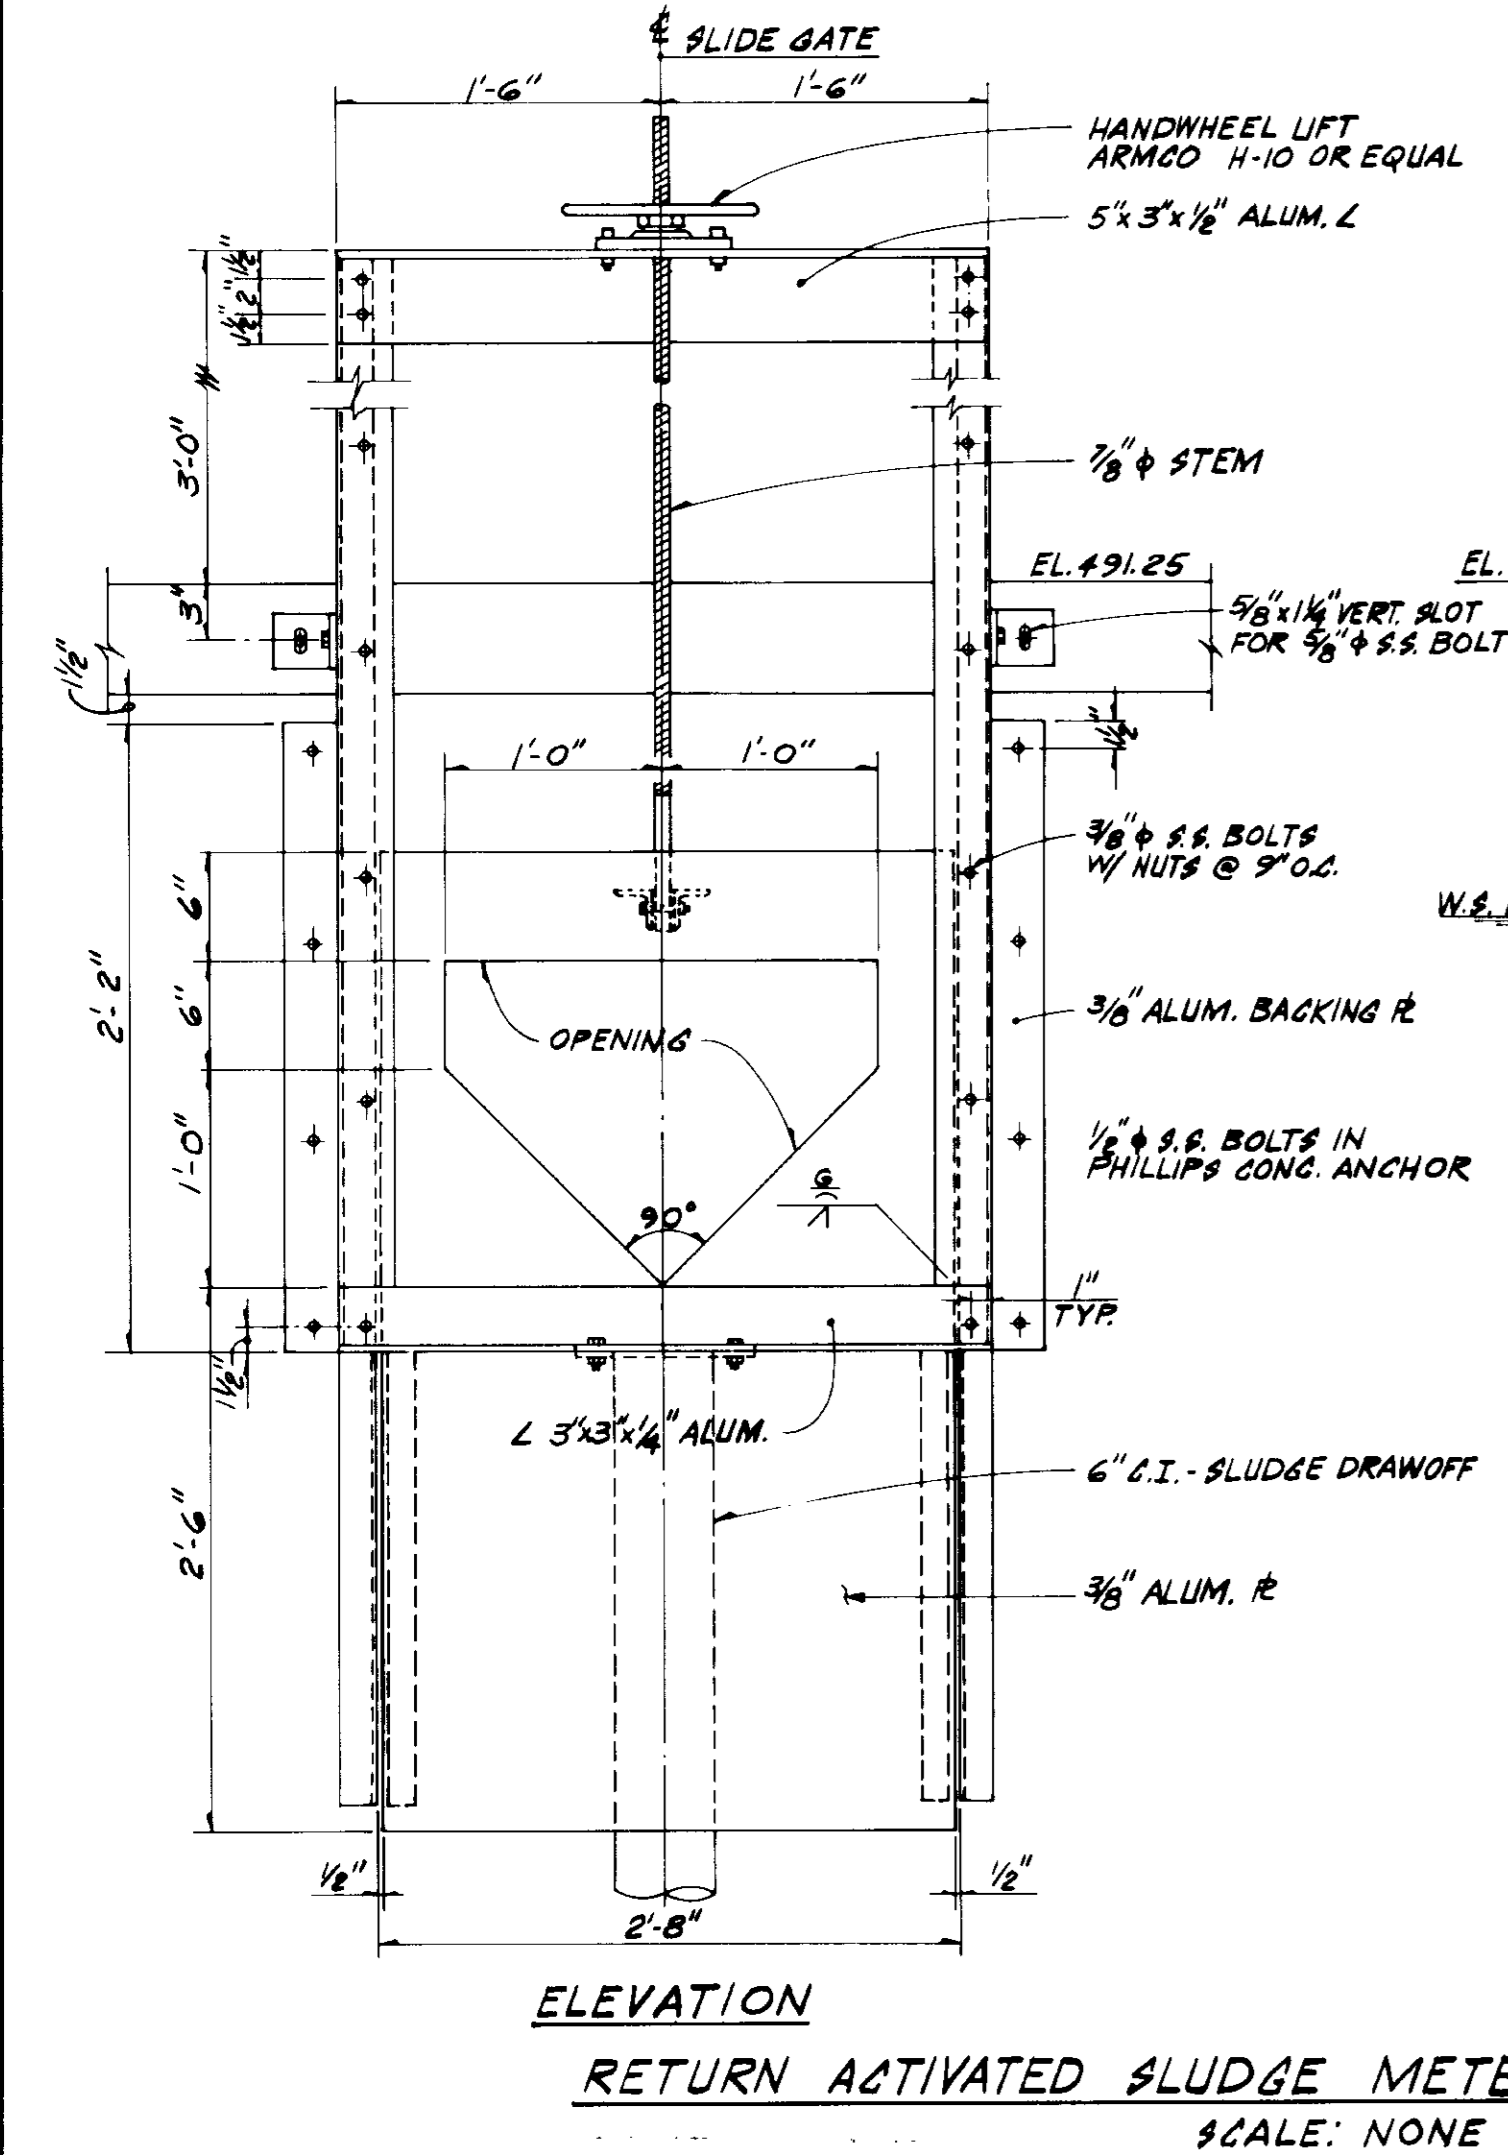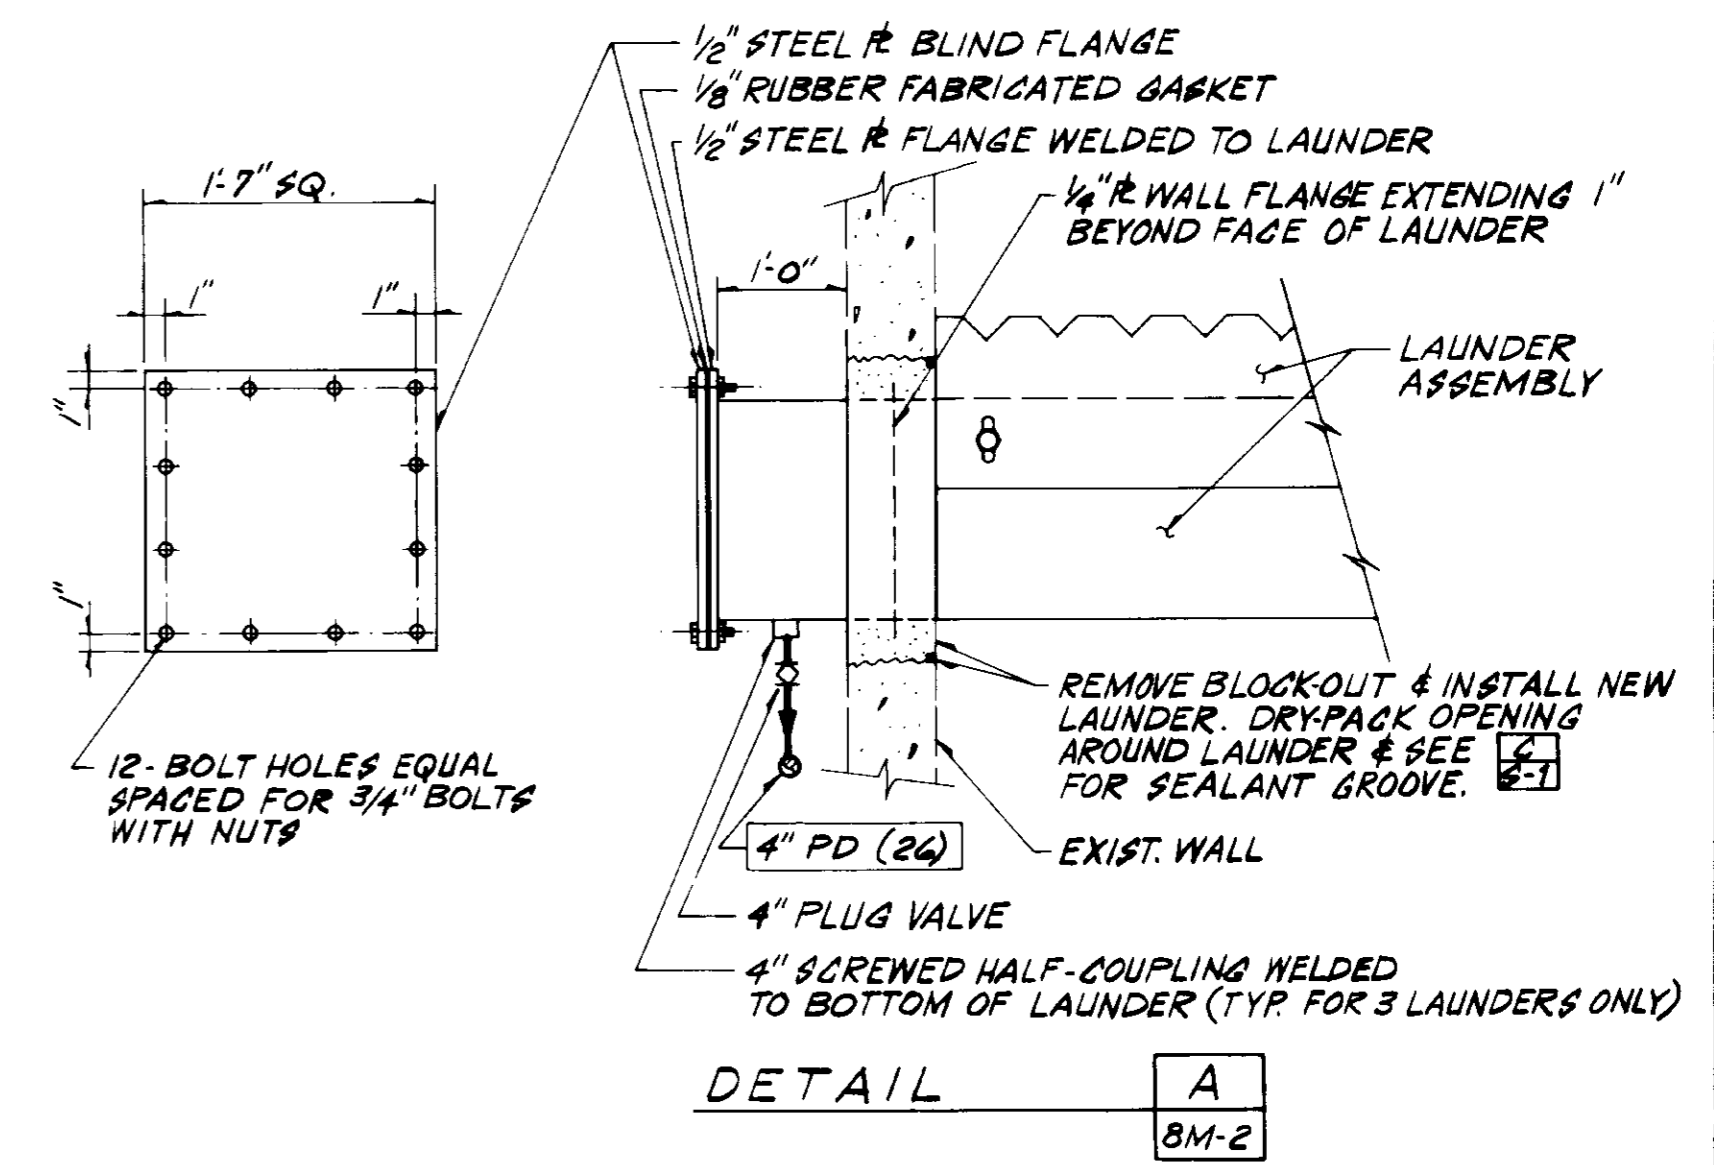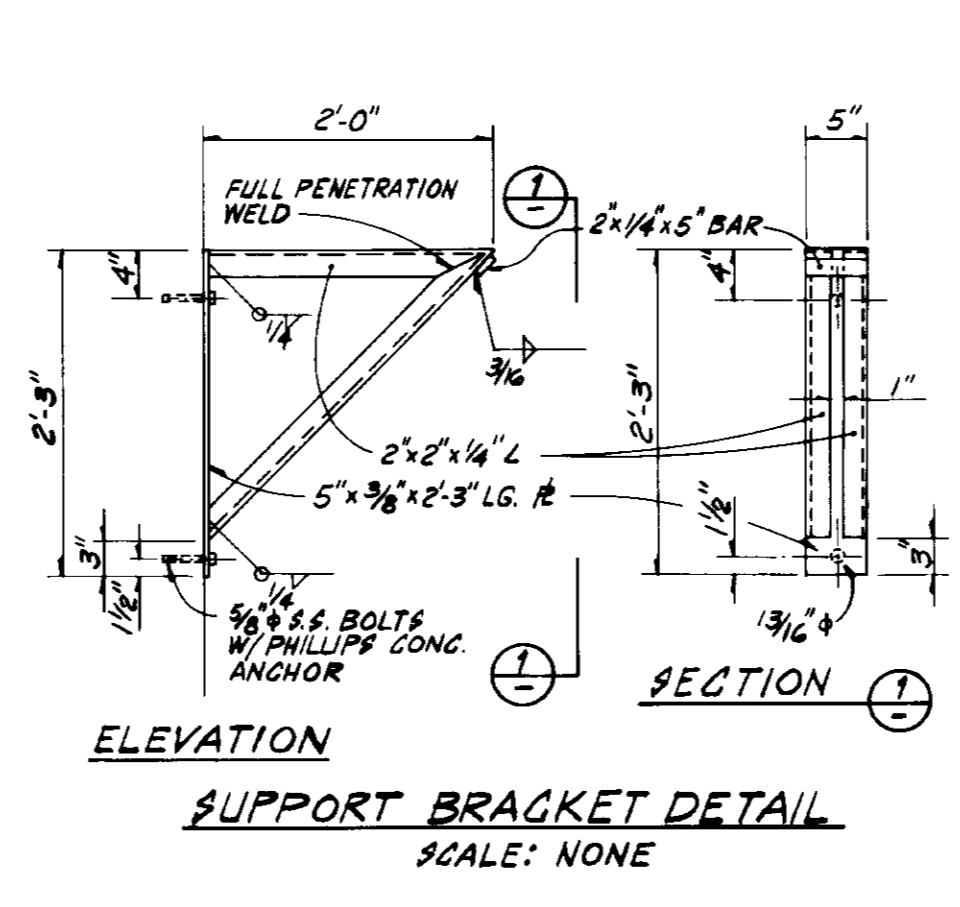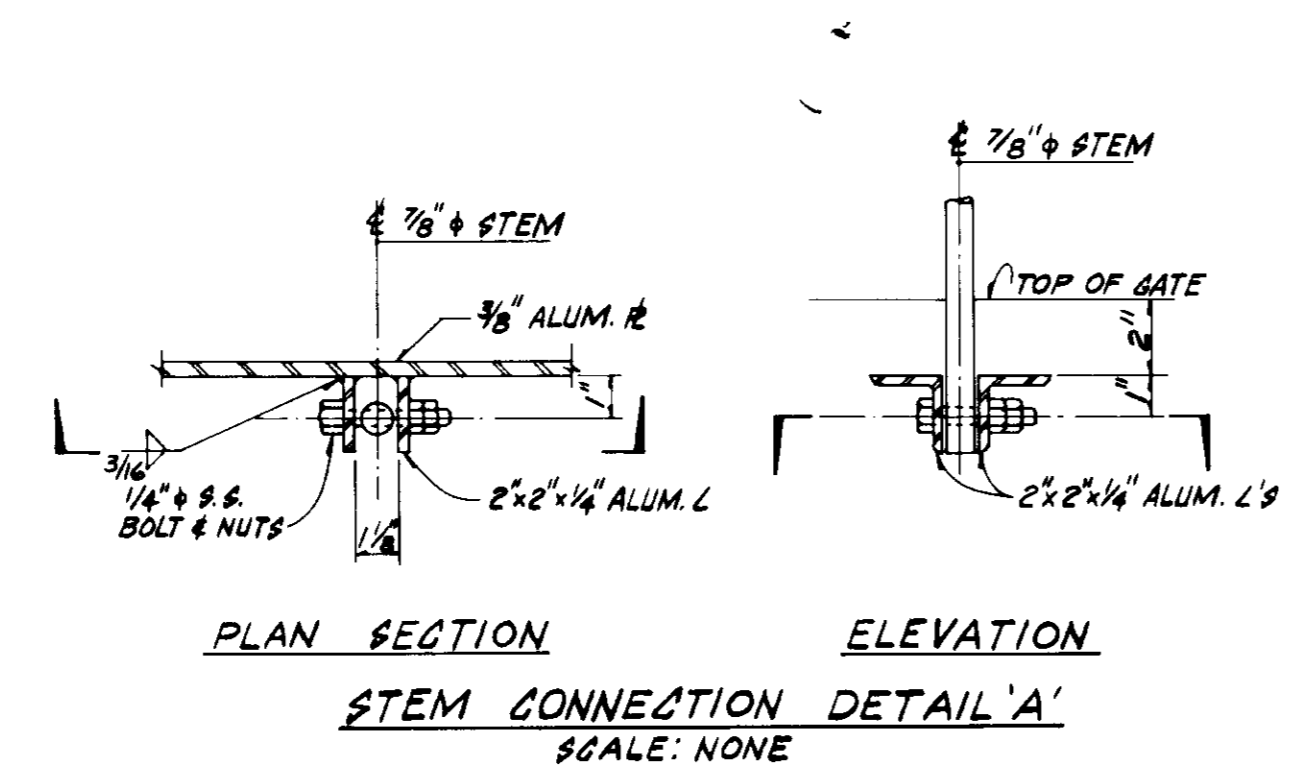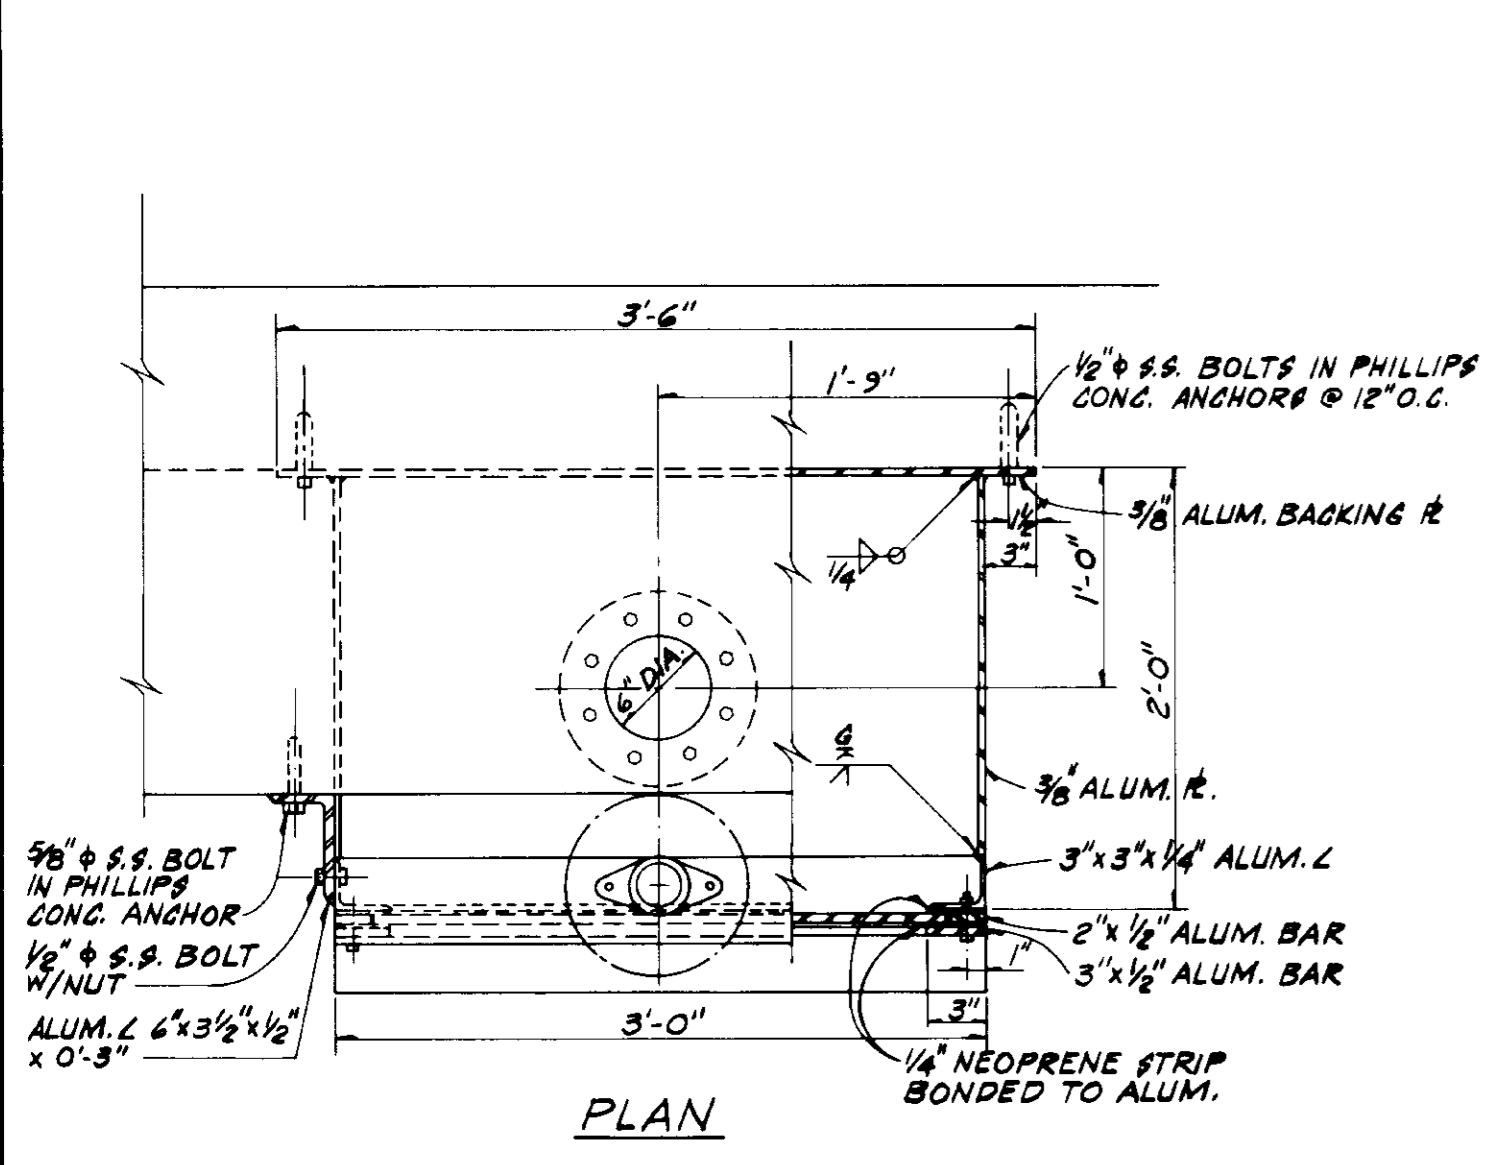

03576

RECORD DRAWING

REV	DATE	BY	DESCRIPTION

SCALE: AS NOTED
DESIGNED: <i>J. M. Montgomery</i>
DRAWN: <i>J. M. Montgomery</i>
CHECKED: <i>J. M. Montgomery</i>


SUBMITTED: <i>J. M. Montgomery</i> 27304 8/19/81
PROJECT ENGINEER: <i>J. M. Montgomery</i>
RECOMMENDED: <i>J. M. Montgomery</i> 27638 8/20/81
RECOMMENDED BY: <i>J. M. Montgomery</i>

JAMES M. MONTGOMERY CONSULTING ENGINEERS, INC.
555 EAST WALNUT STREET, PASADENA, CALIFORNIA 91101


DISTRICT APPROVAL ON TITLE PAGE

PHASE II	LAS VIRGENES MWD/TRIUNFO CSD TAPIA WRF - FILTRATION/DISINFECTION ADDITION
EXISTING CHLORINE CONTACT CHANNEL CONVERSION - SECTIONS AND DETAILS	8M-2


SHEET 8M-2 OF 66 SHEETS

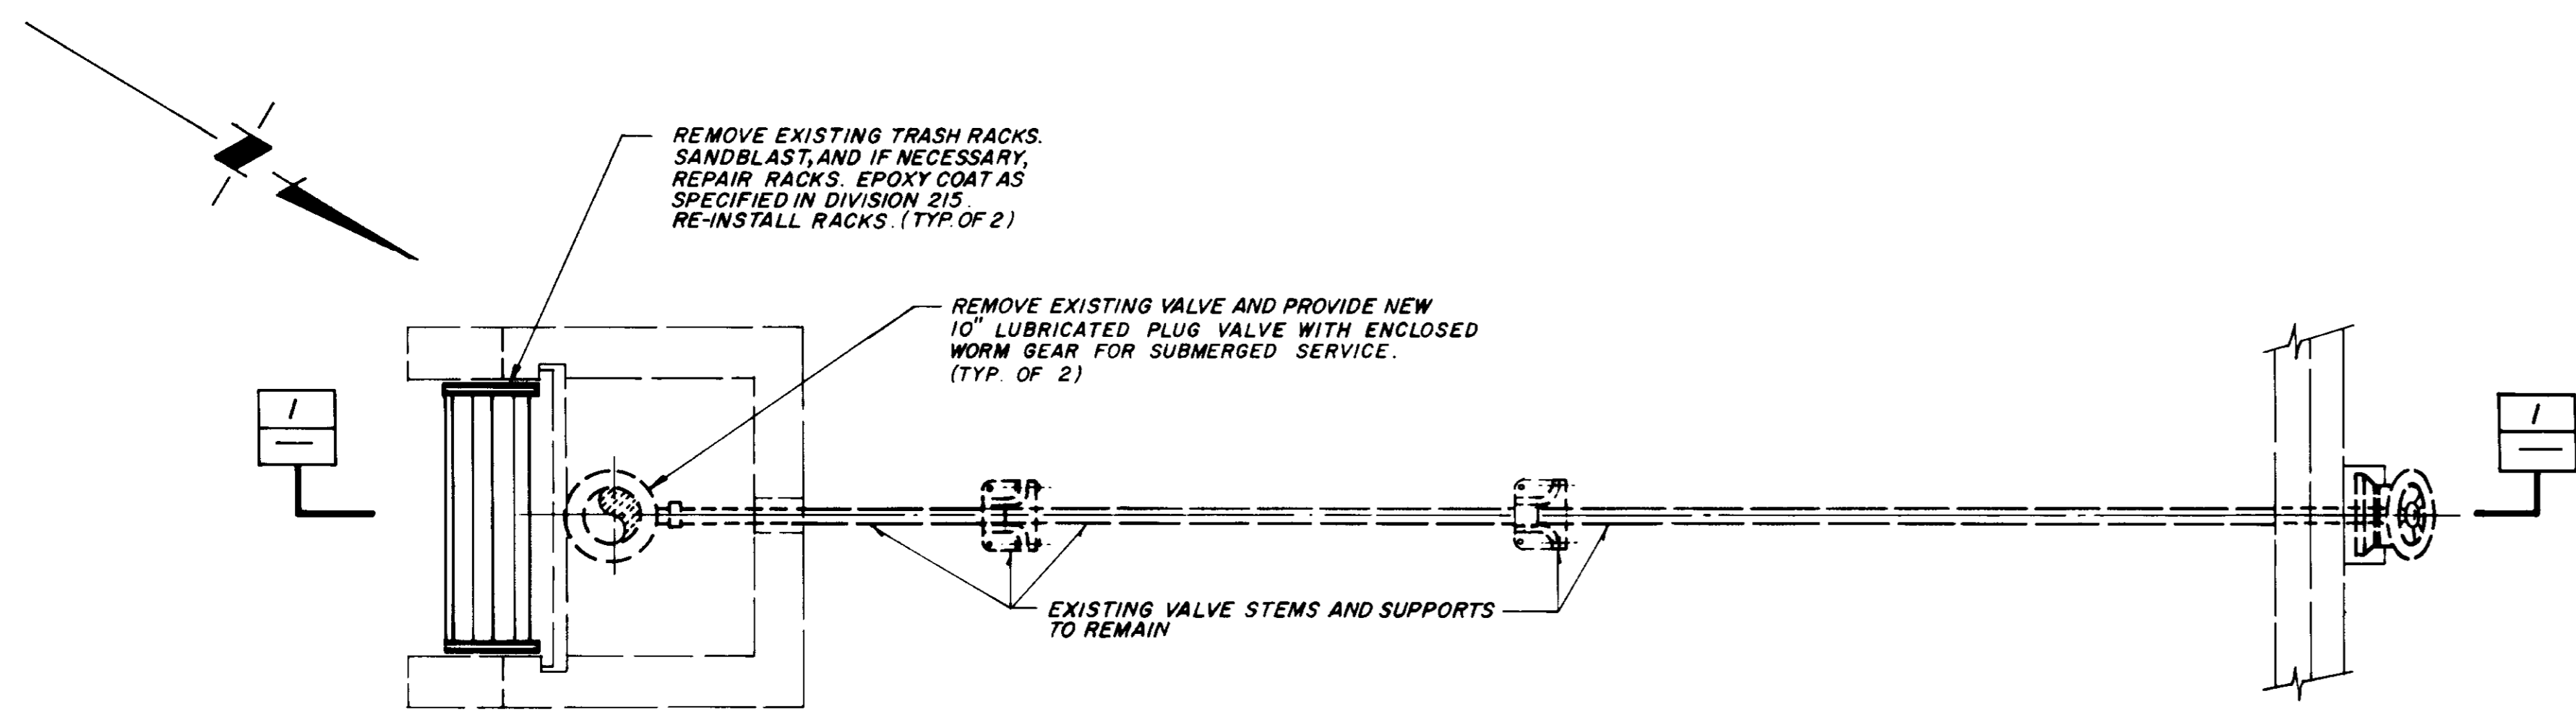


PLAN
RESERVOIR OUTLET (TYP. OF 2)

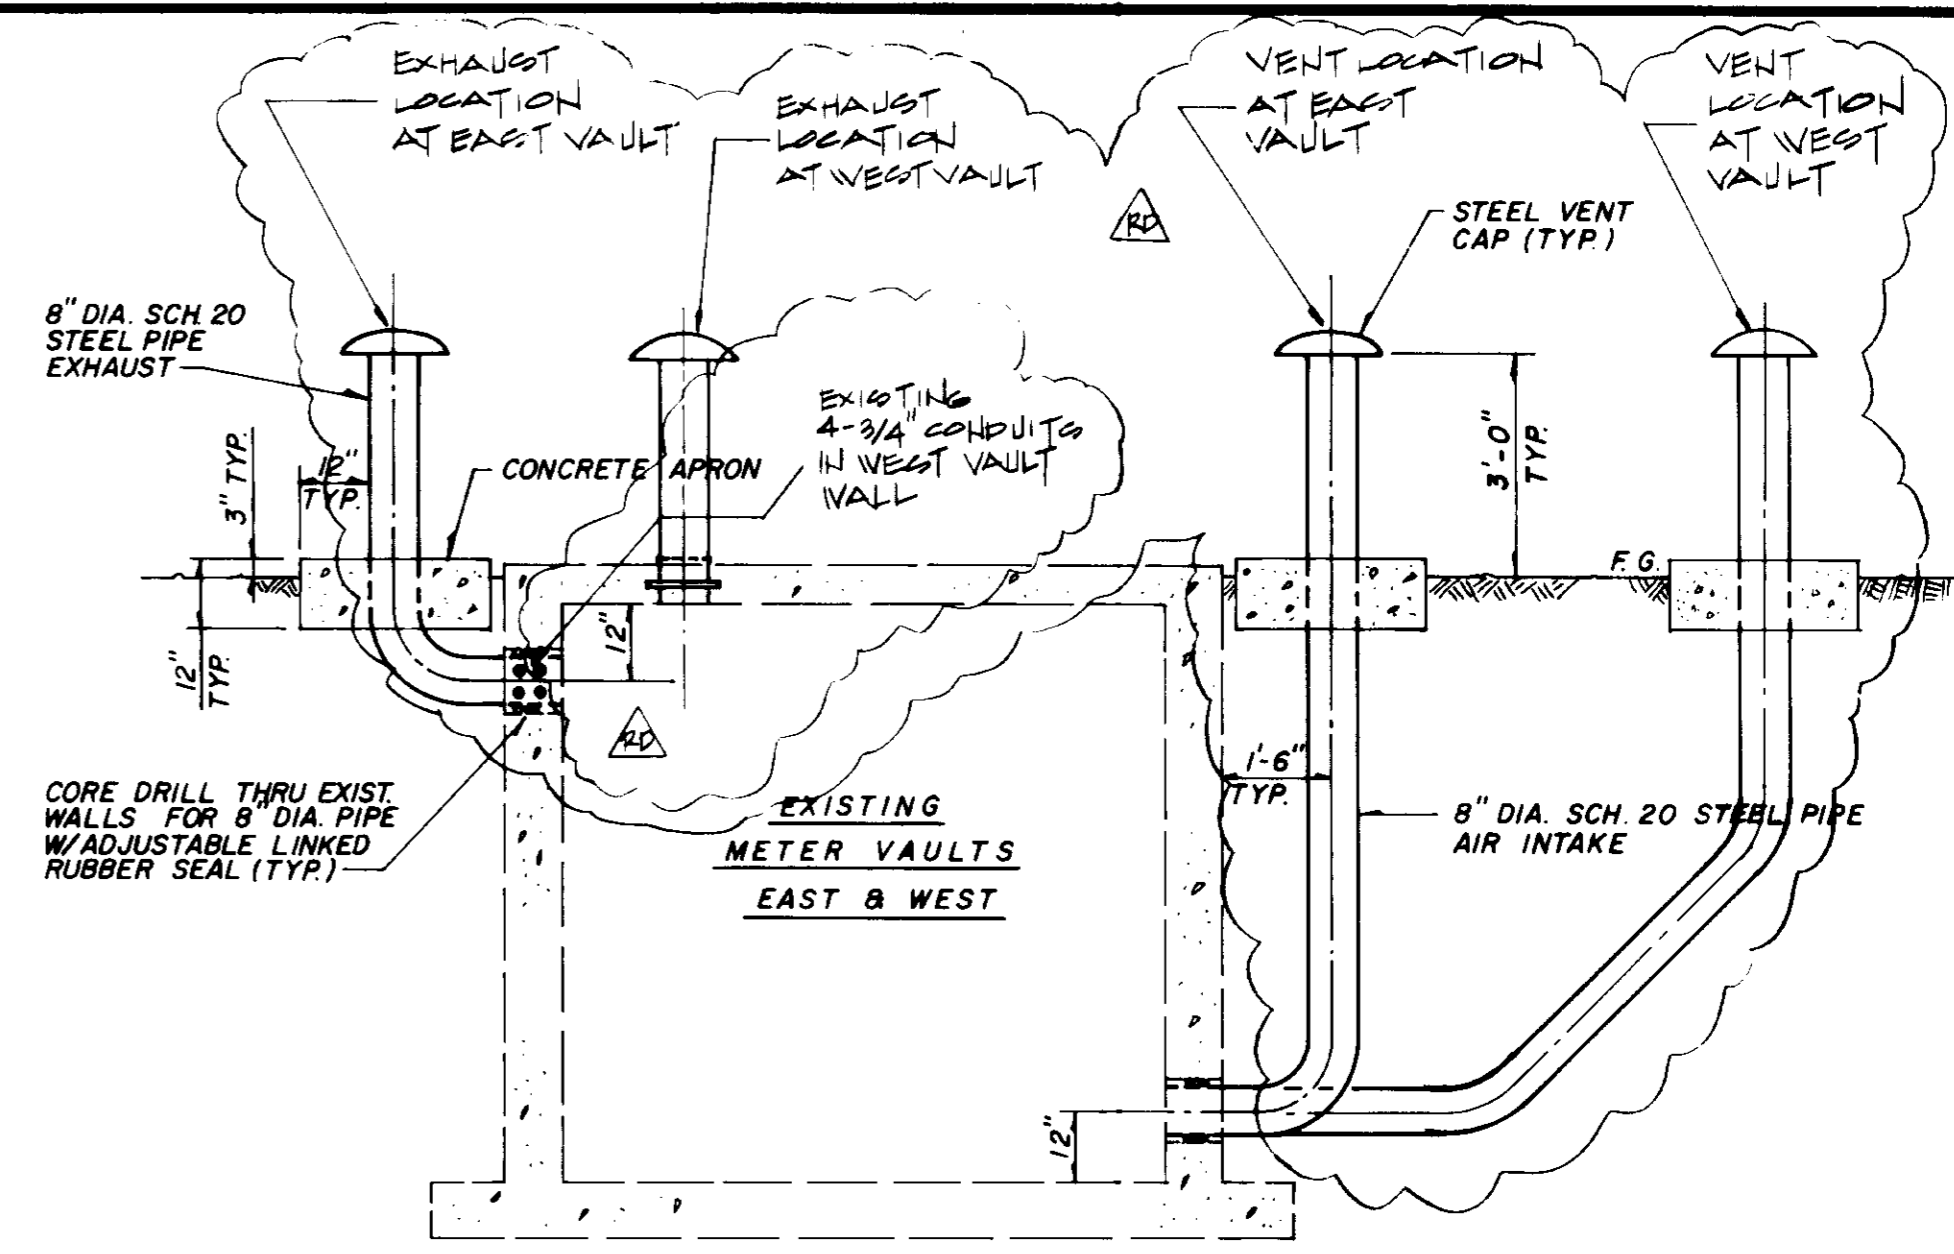

SECTION 2
SCALE # NONE

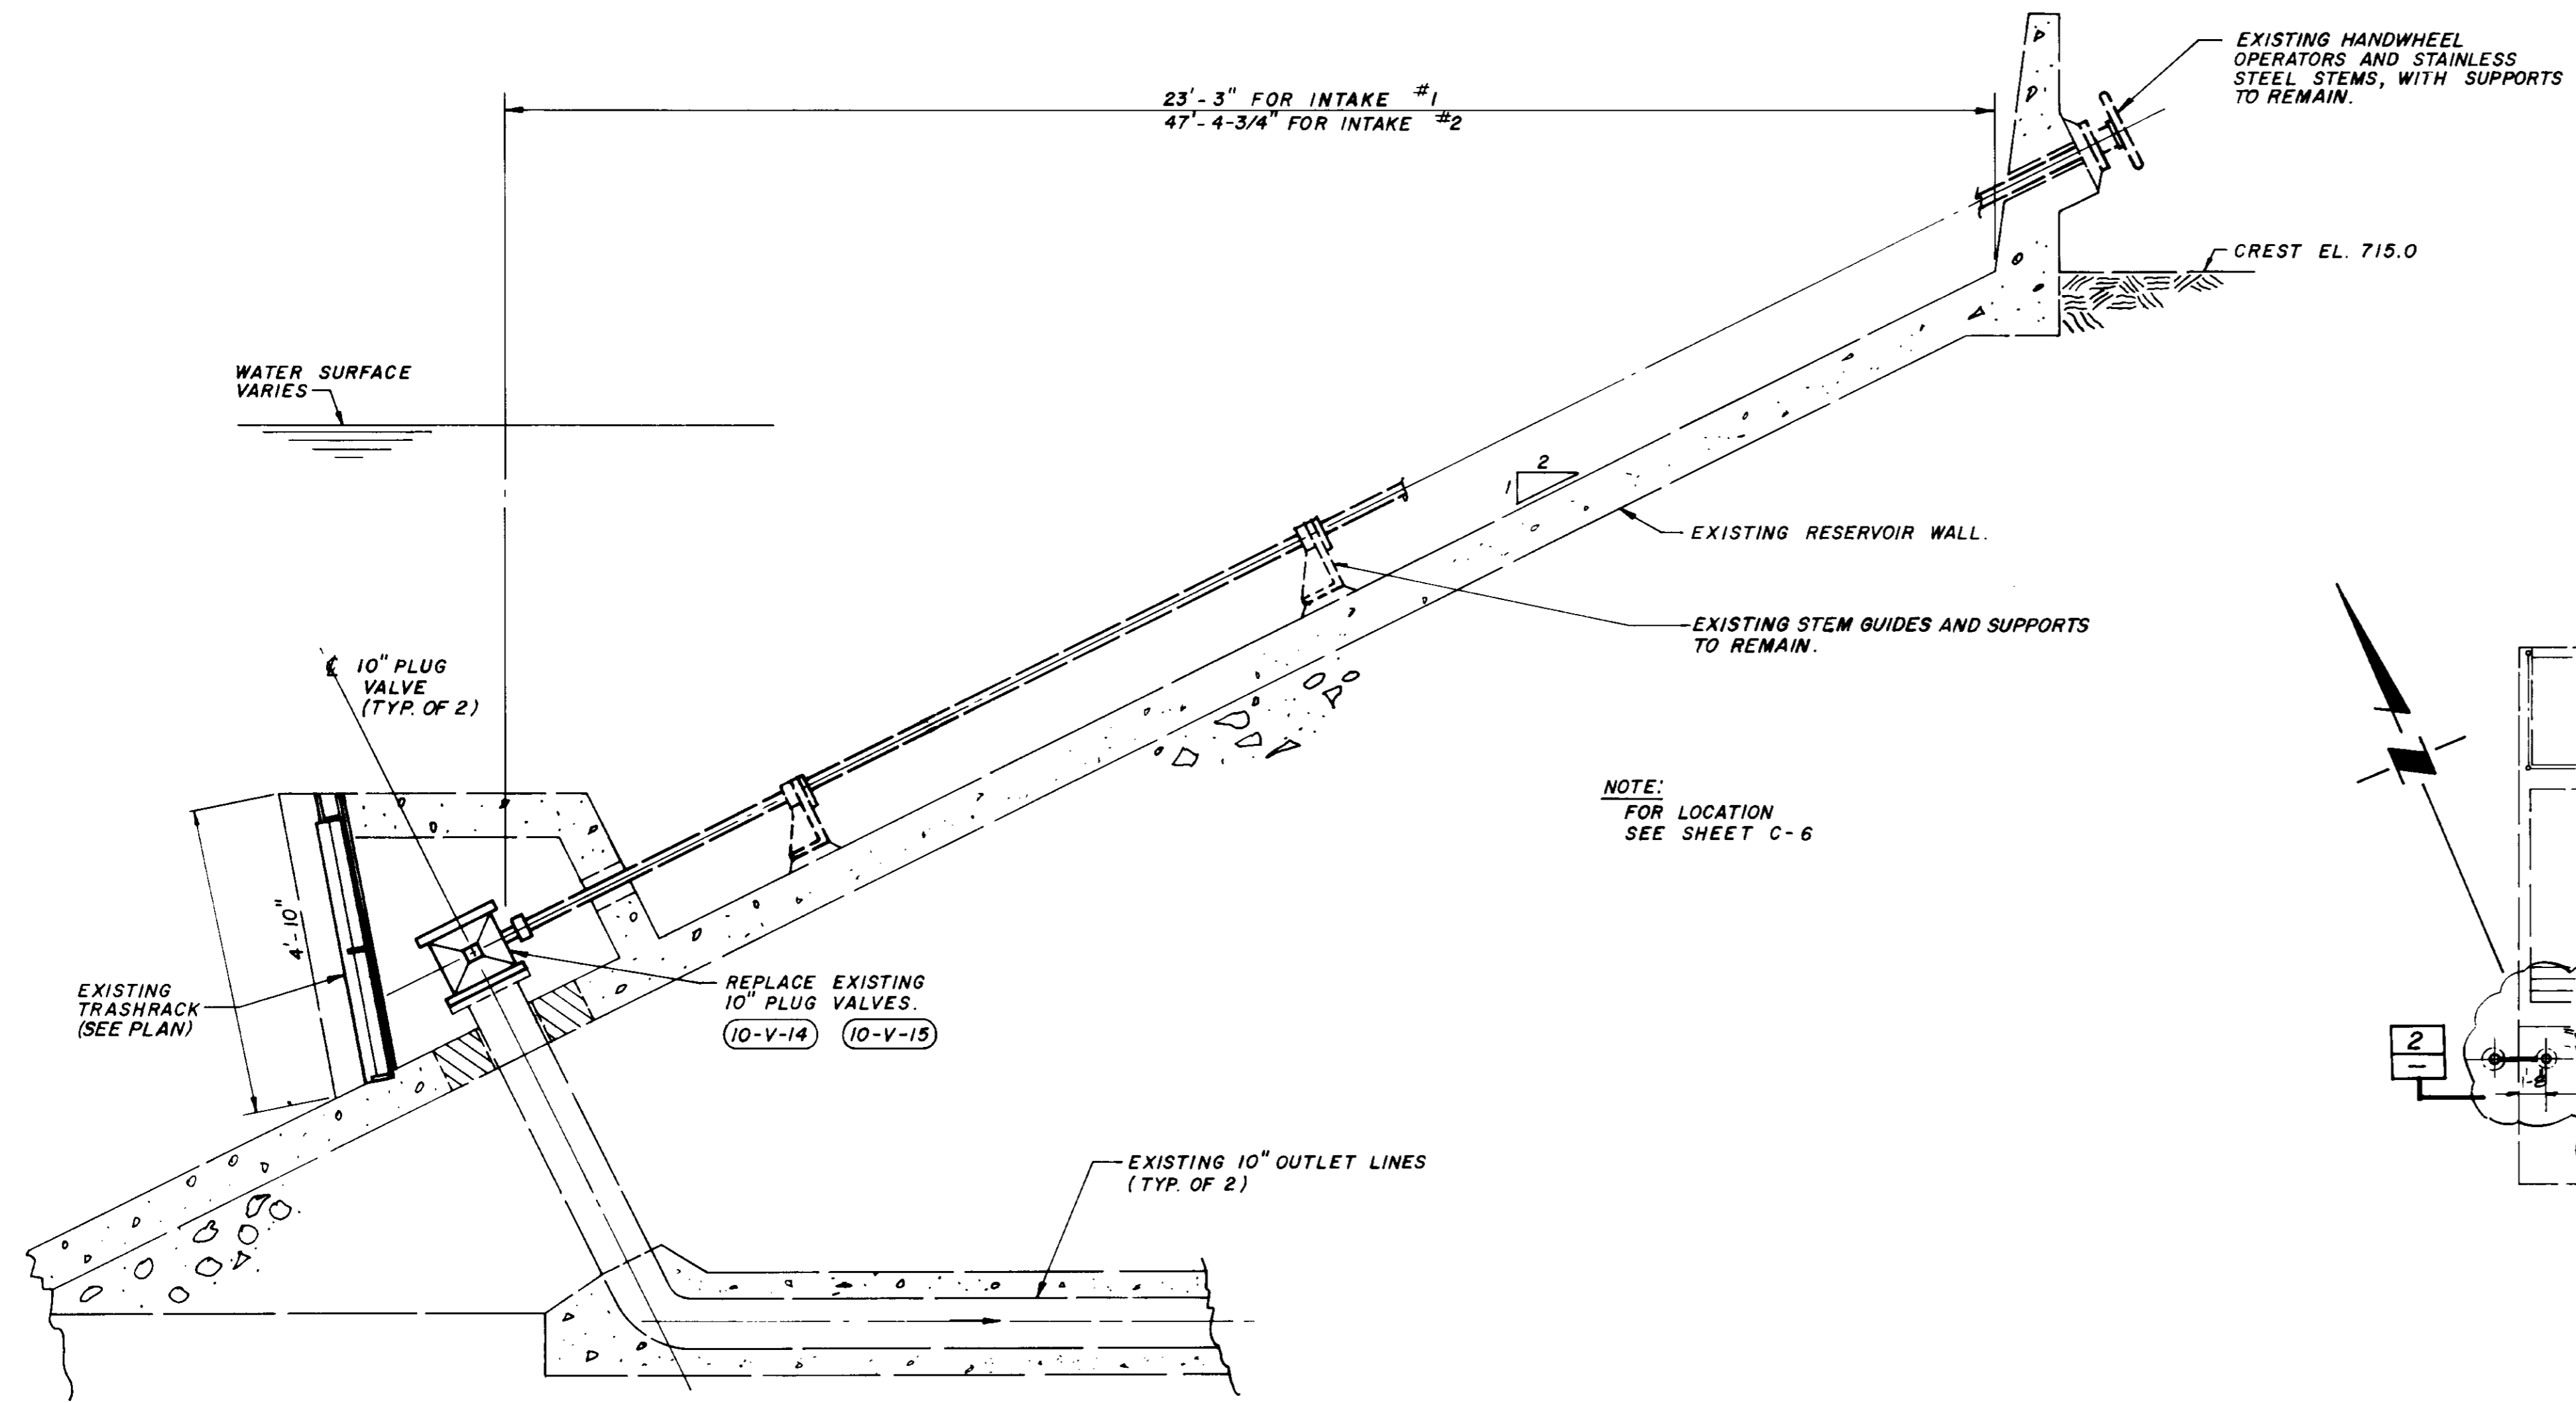

SECTION 1

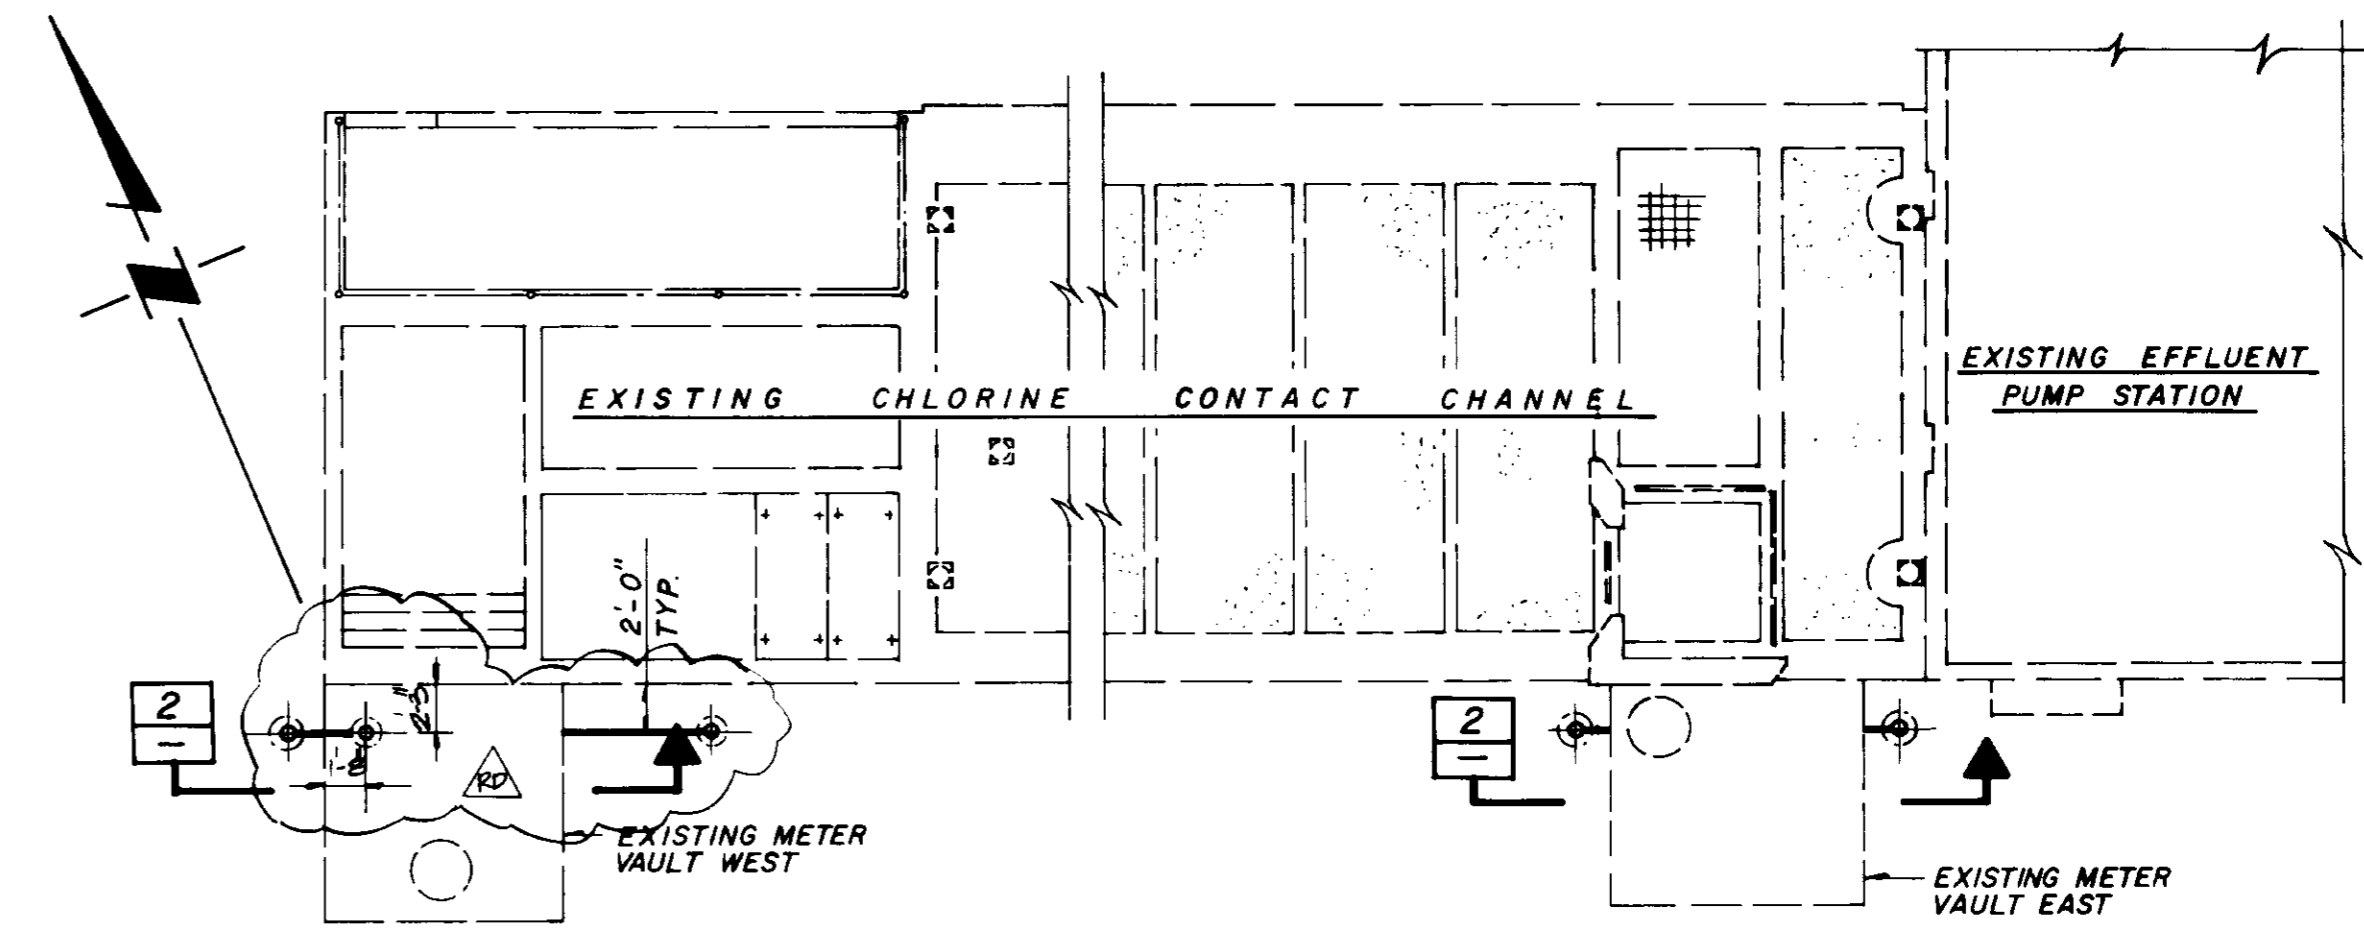

PLAN
VENTS FOR METER VAULTS
SCALE # 1/8" = 1'-0"

03577

RECORD DRAWING

RD	4/11/01	MDU	RECORD DRAWING
REV	DATE	BY	DESCRIPTION

SCALE:
1/2" = 1'-0"
& NOTED

DESIGNED	G.M.	SUBMITTED	27304	8/19/01
DRAWN	G.M.	PROJECT ENGINEER	R.C.E. NO.	DATE
CHECKED	J.C.S.	RECOMMENDED BY	27638	8/23/01
			R.C.E. NO.	DATE


JAMES M. MONTGOMERY CONSULTING ENGINEERS, INC.
555 EAST WALNUT STREET, PASADENA, CALIFORNIA 91101

DISTRICT APPROVAL ON TITLE PAGE

LAS VIRGENES MWD/TRIUNFO CSD	
TAPIA WRF - FILTRATION/DISINFECTION ADDITION	
PHASE II	MISCELLANEOUS MODIFICATIONS - RESERVOIR OUTLETS

SHEET
10M-1
OF 66 SHEETS

1-5-B1

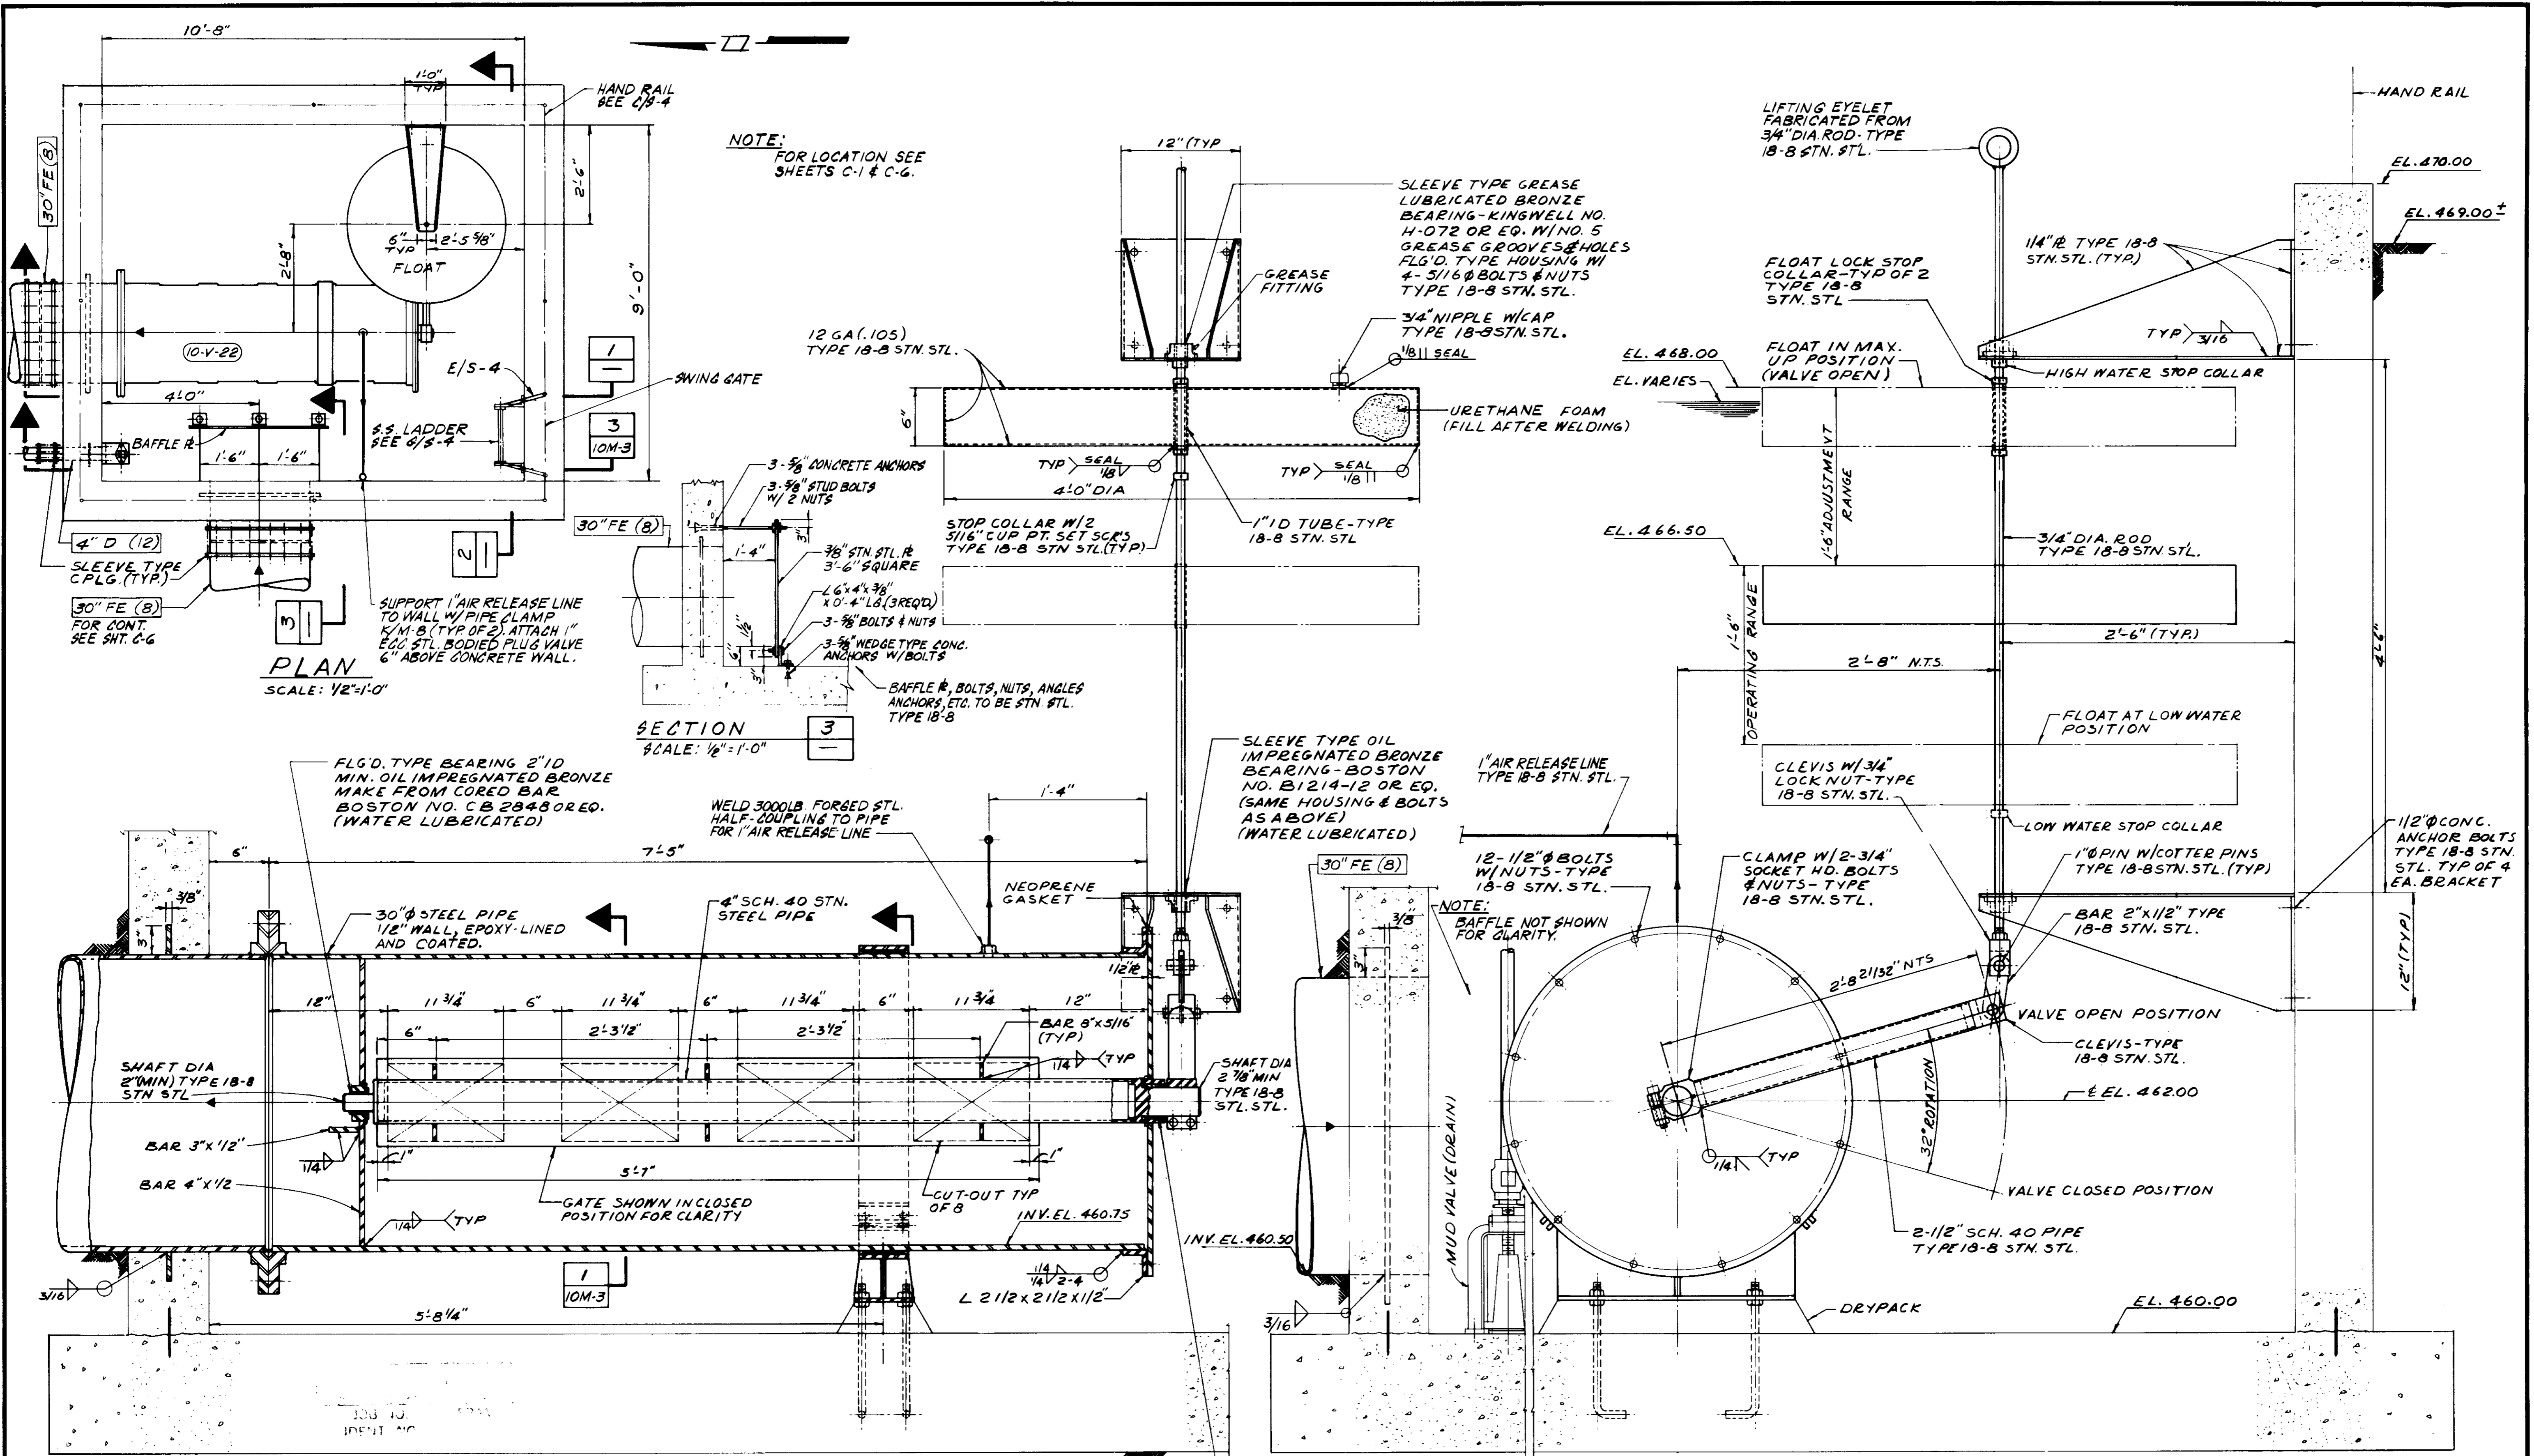

03578

RECORD DRAWING

REV	DATE	BY	DESCRIPTION

SCALE:	AS NOTED
DESIGNED:	<i>Paul Powell</i>
DRAWN:	<i>Paul Powell</i>
CHECKED:	<i>J. [Signature]</i>
SUBMITTED:	<i>Robert C. [Signature]</i>
PROJECT ENGINEER:	27304 8/19/01
DATE:	R.C.E. NO.
RECOMMENDED:	<i>[Signature]</i>
DATE:	27638 9/20/01
R.C.E. NO.:	

JAMES M. MONTGOMERY CONSULTING ENGINEERS, INC.


355 EAST WALNUT STREET, PASADENA, CALIFORNIA 91101

DISTRICT APPROVAL ON TITLE PAGE


PHASE II	EFFLUENT CONTROL VALVE STRUCTURE
----------	----------------------------------

SHEET	10M-2
OF 66 SHEETS	


1-5-81

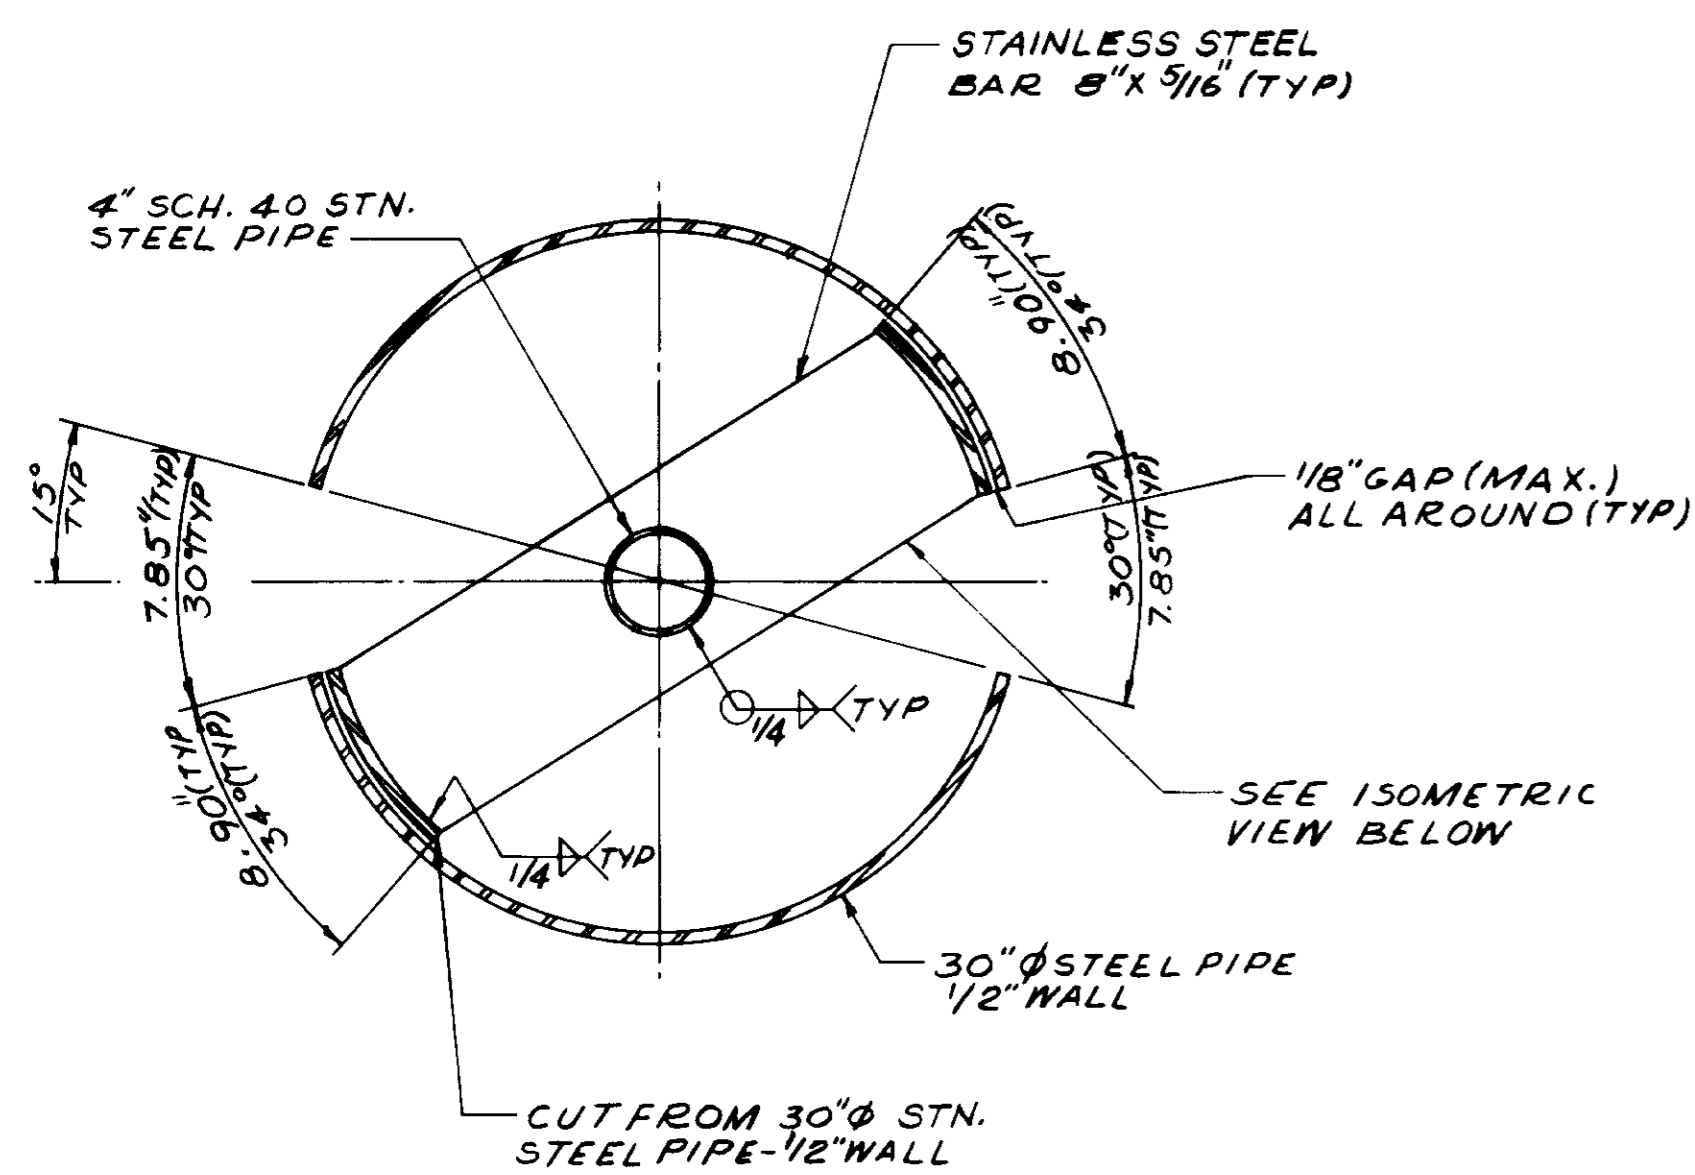


SECTION 1
SCALE: 1/2" = 1'-0" TYP

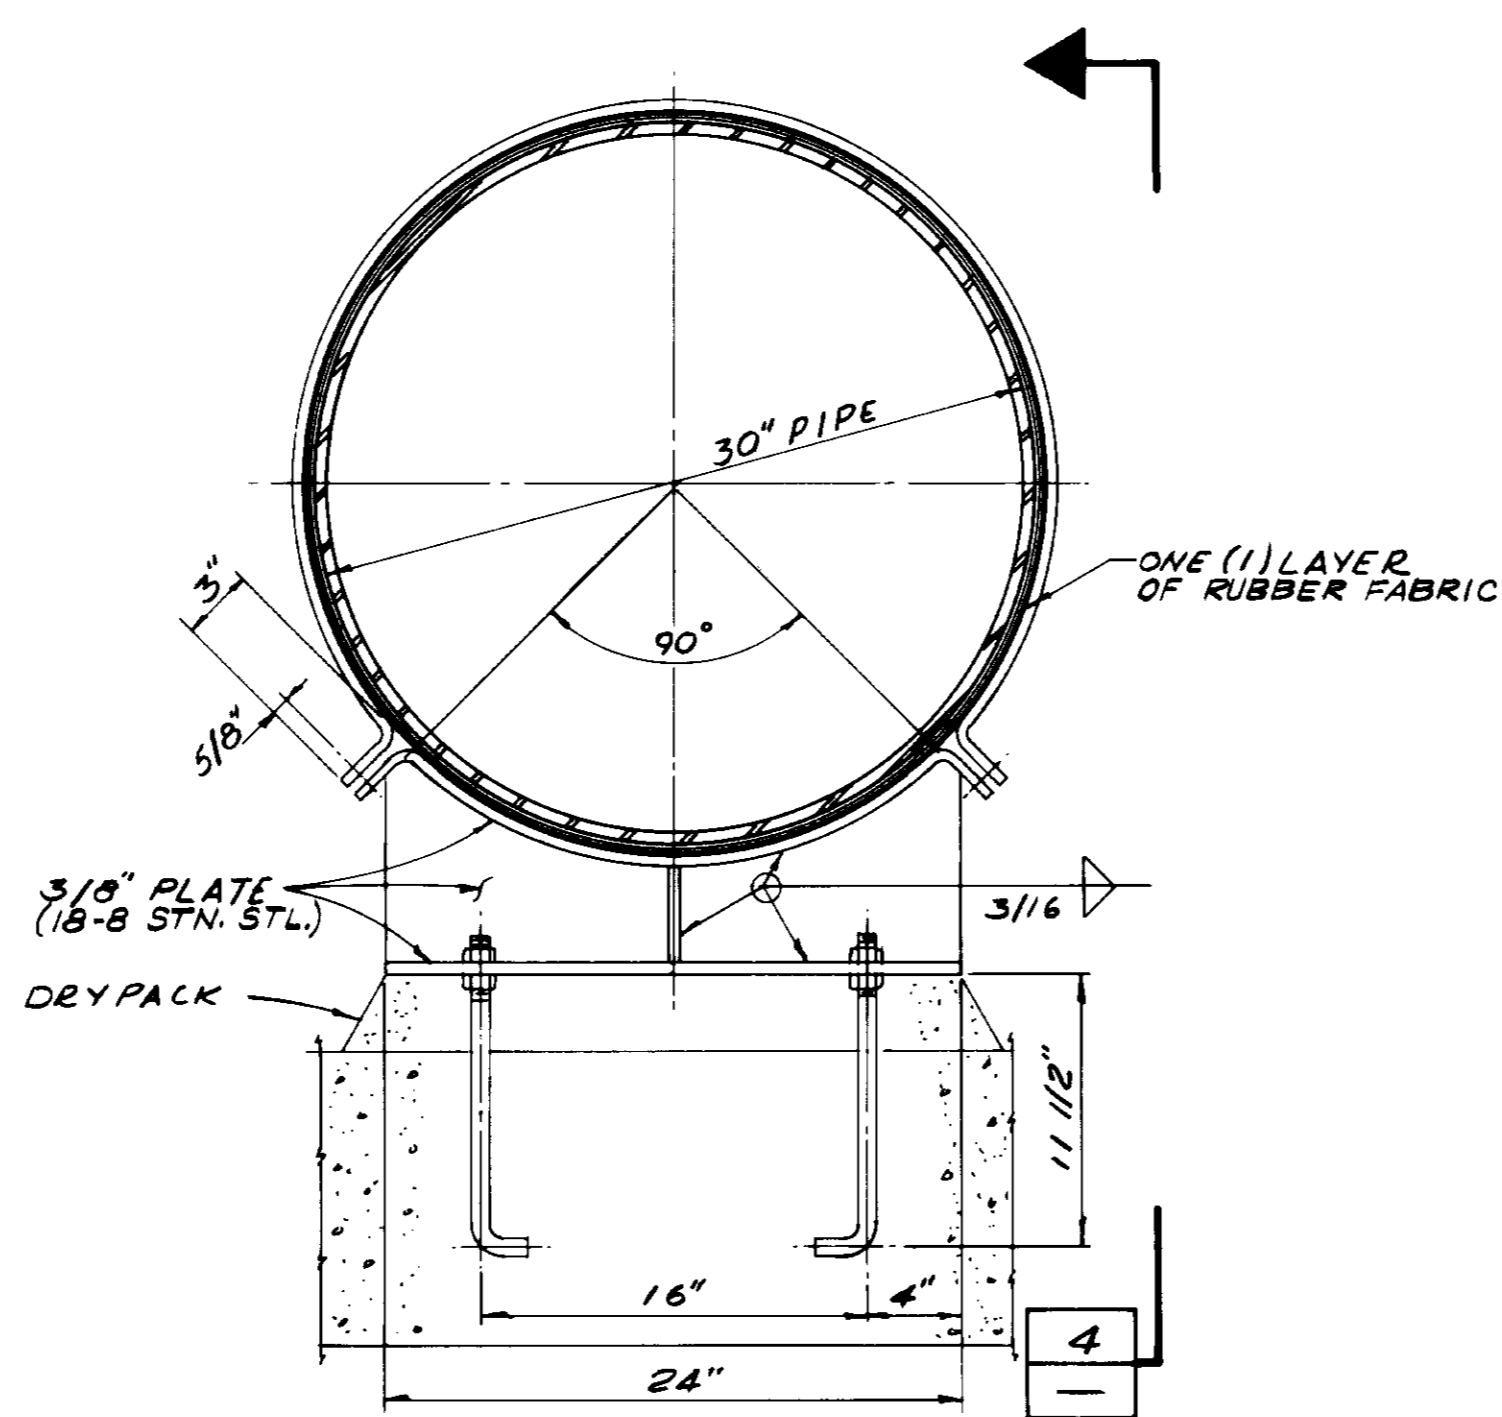


SECTION 2
SCALE: 1/2" = 1'-0" TYP

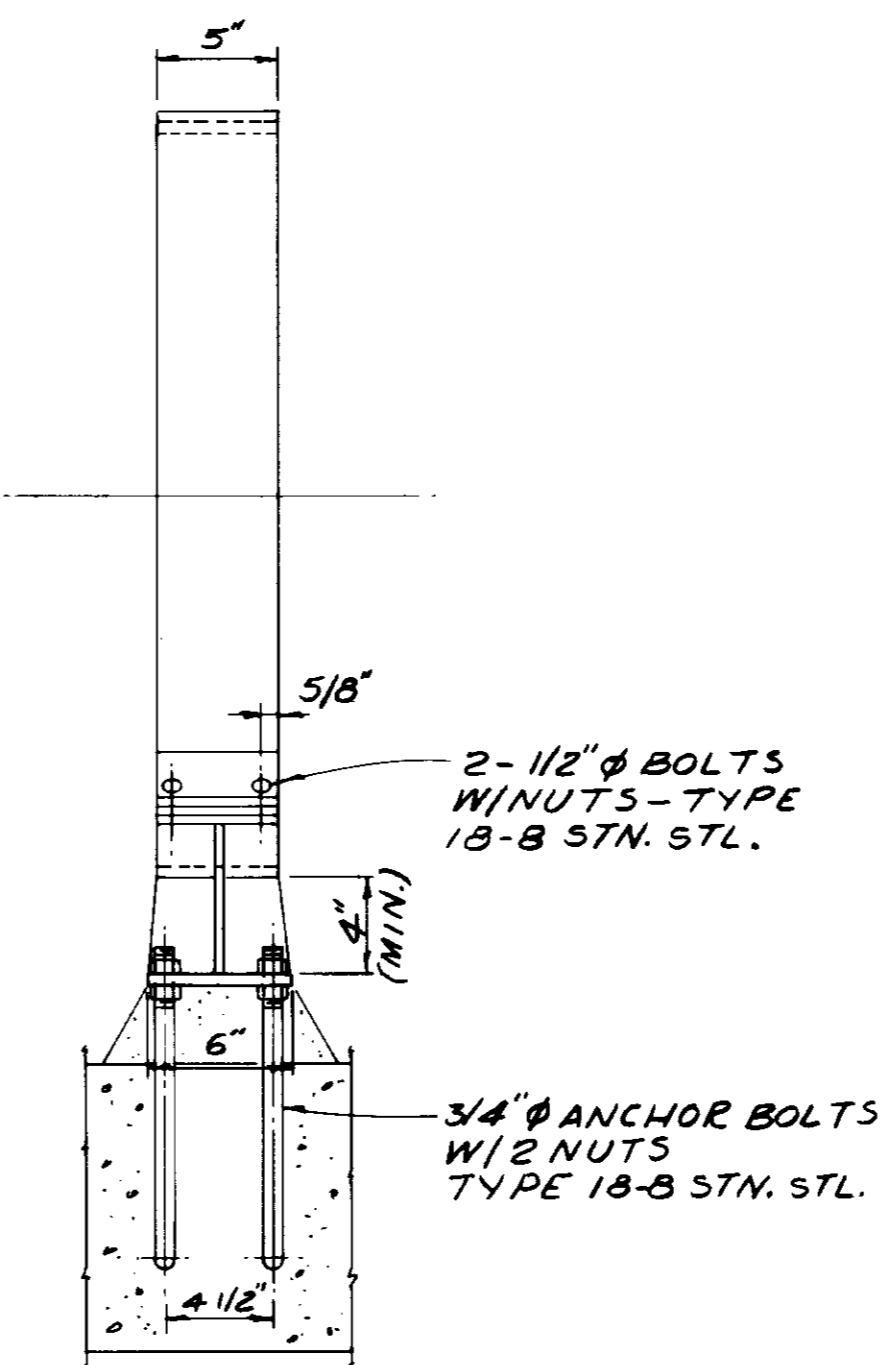


VIEW 4
SCALE: 1/2" = 1'-0" TYP

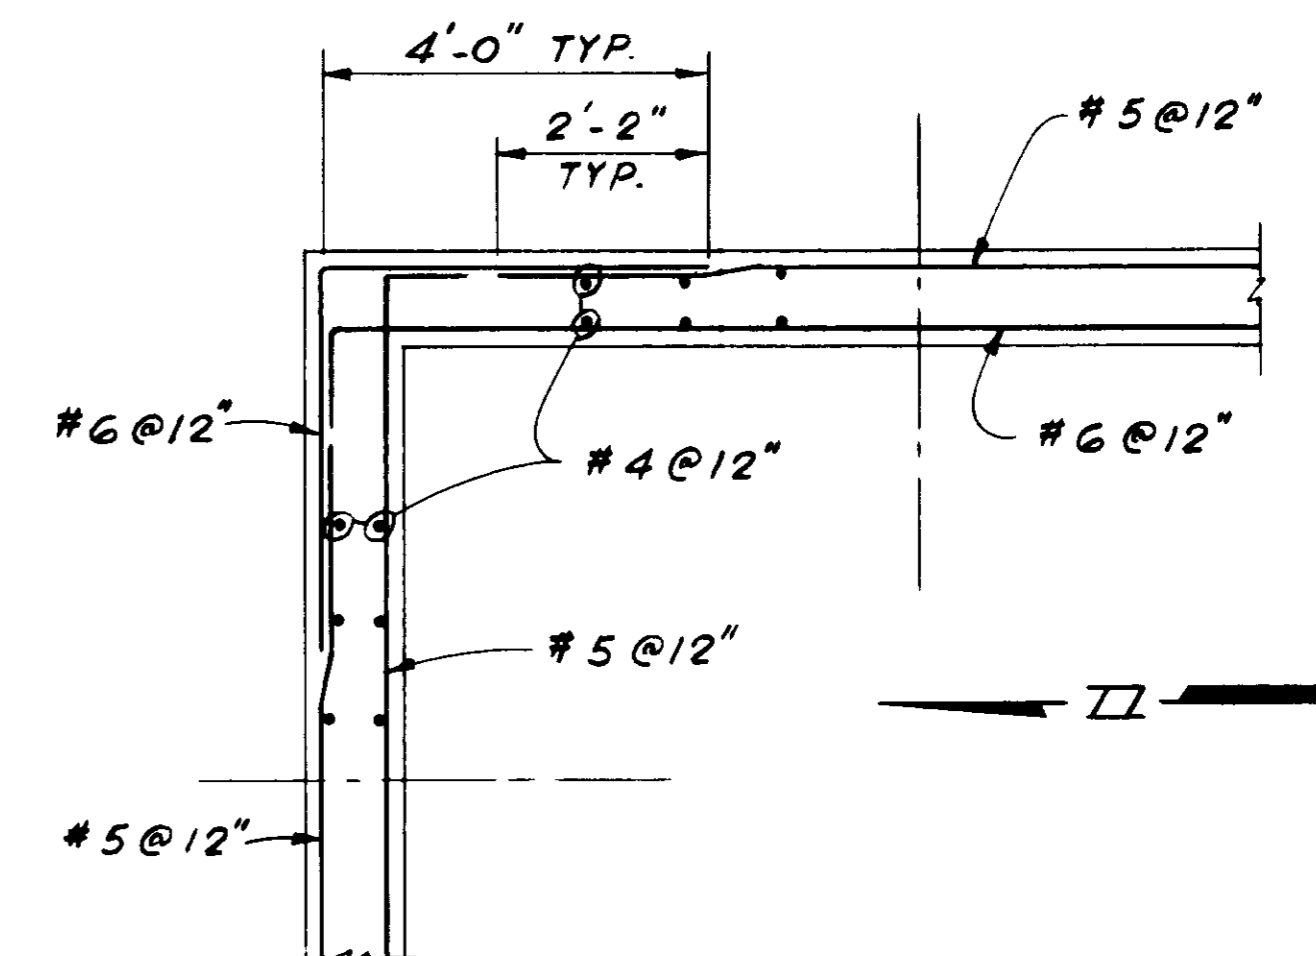

WALL PLAN
SCALE: 1/2" = 1'-0" TYP

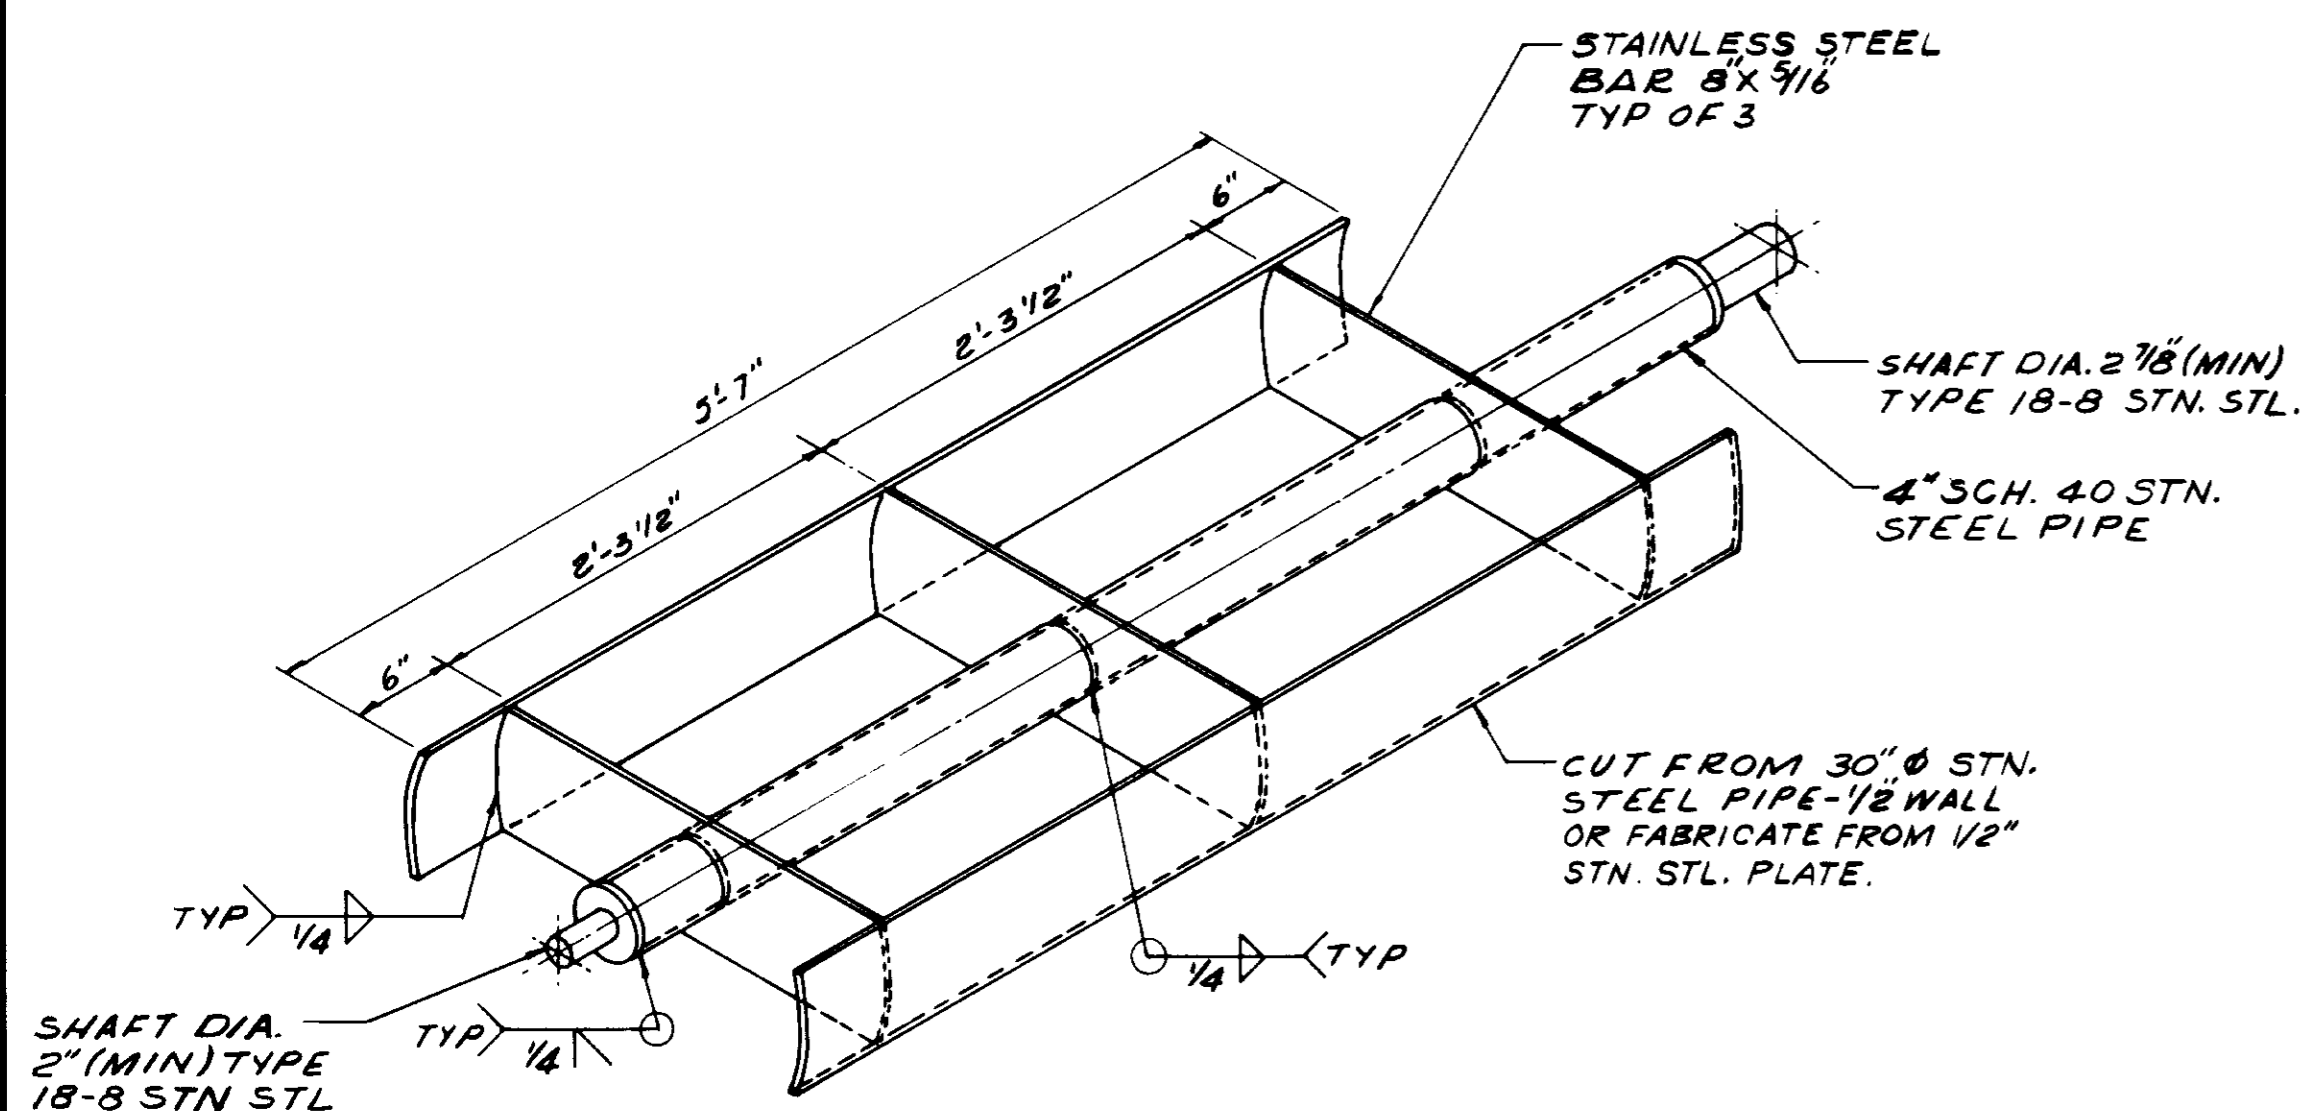


GATE IN ISOMETRIC VIEW
SCALE: NONE

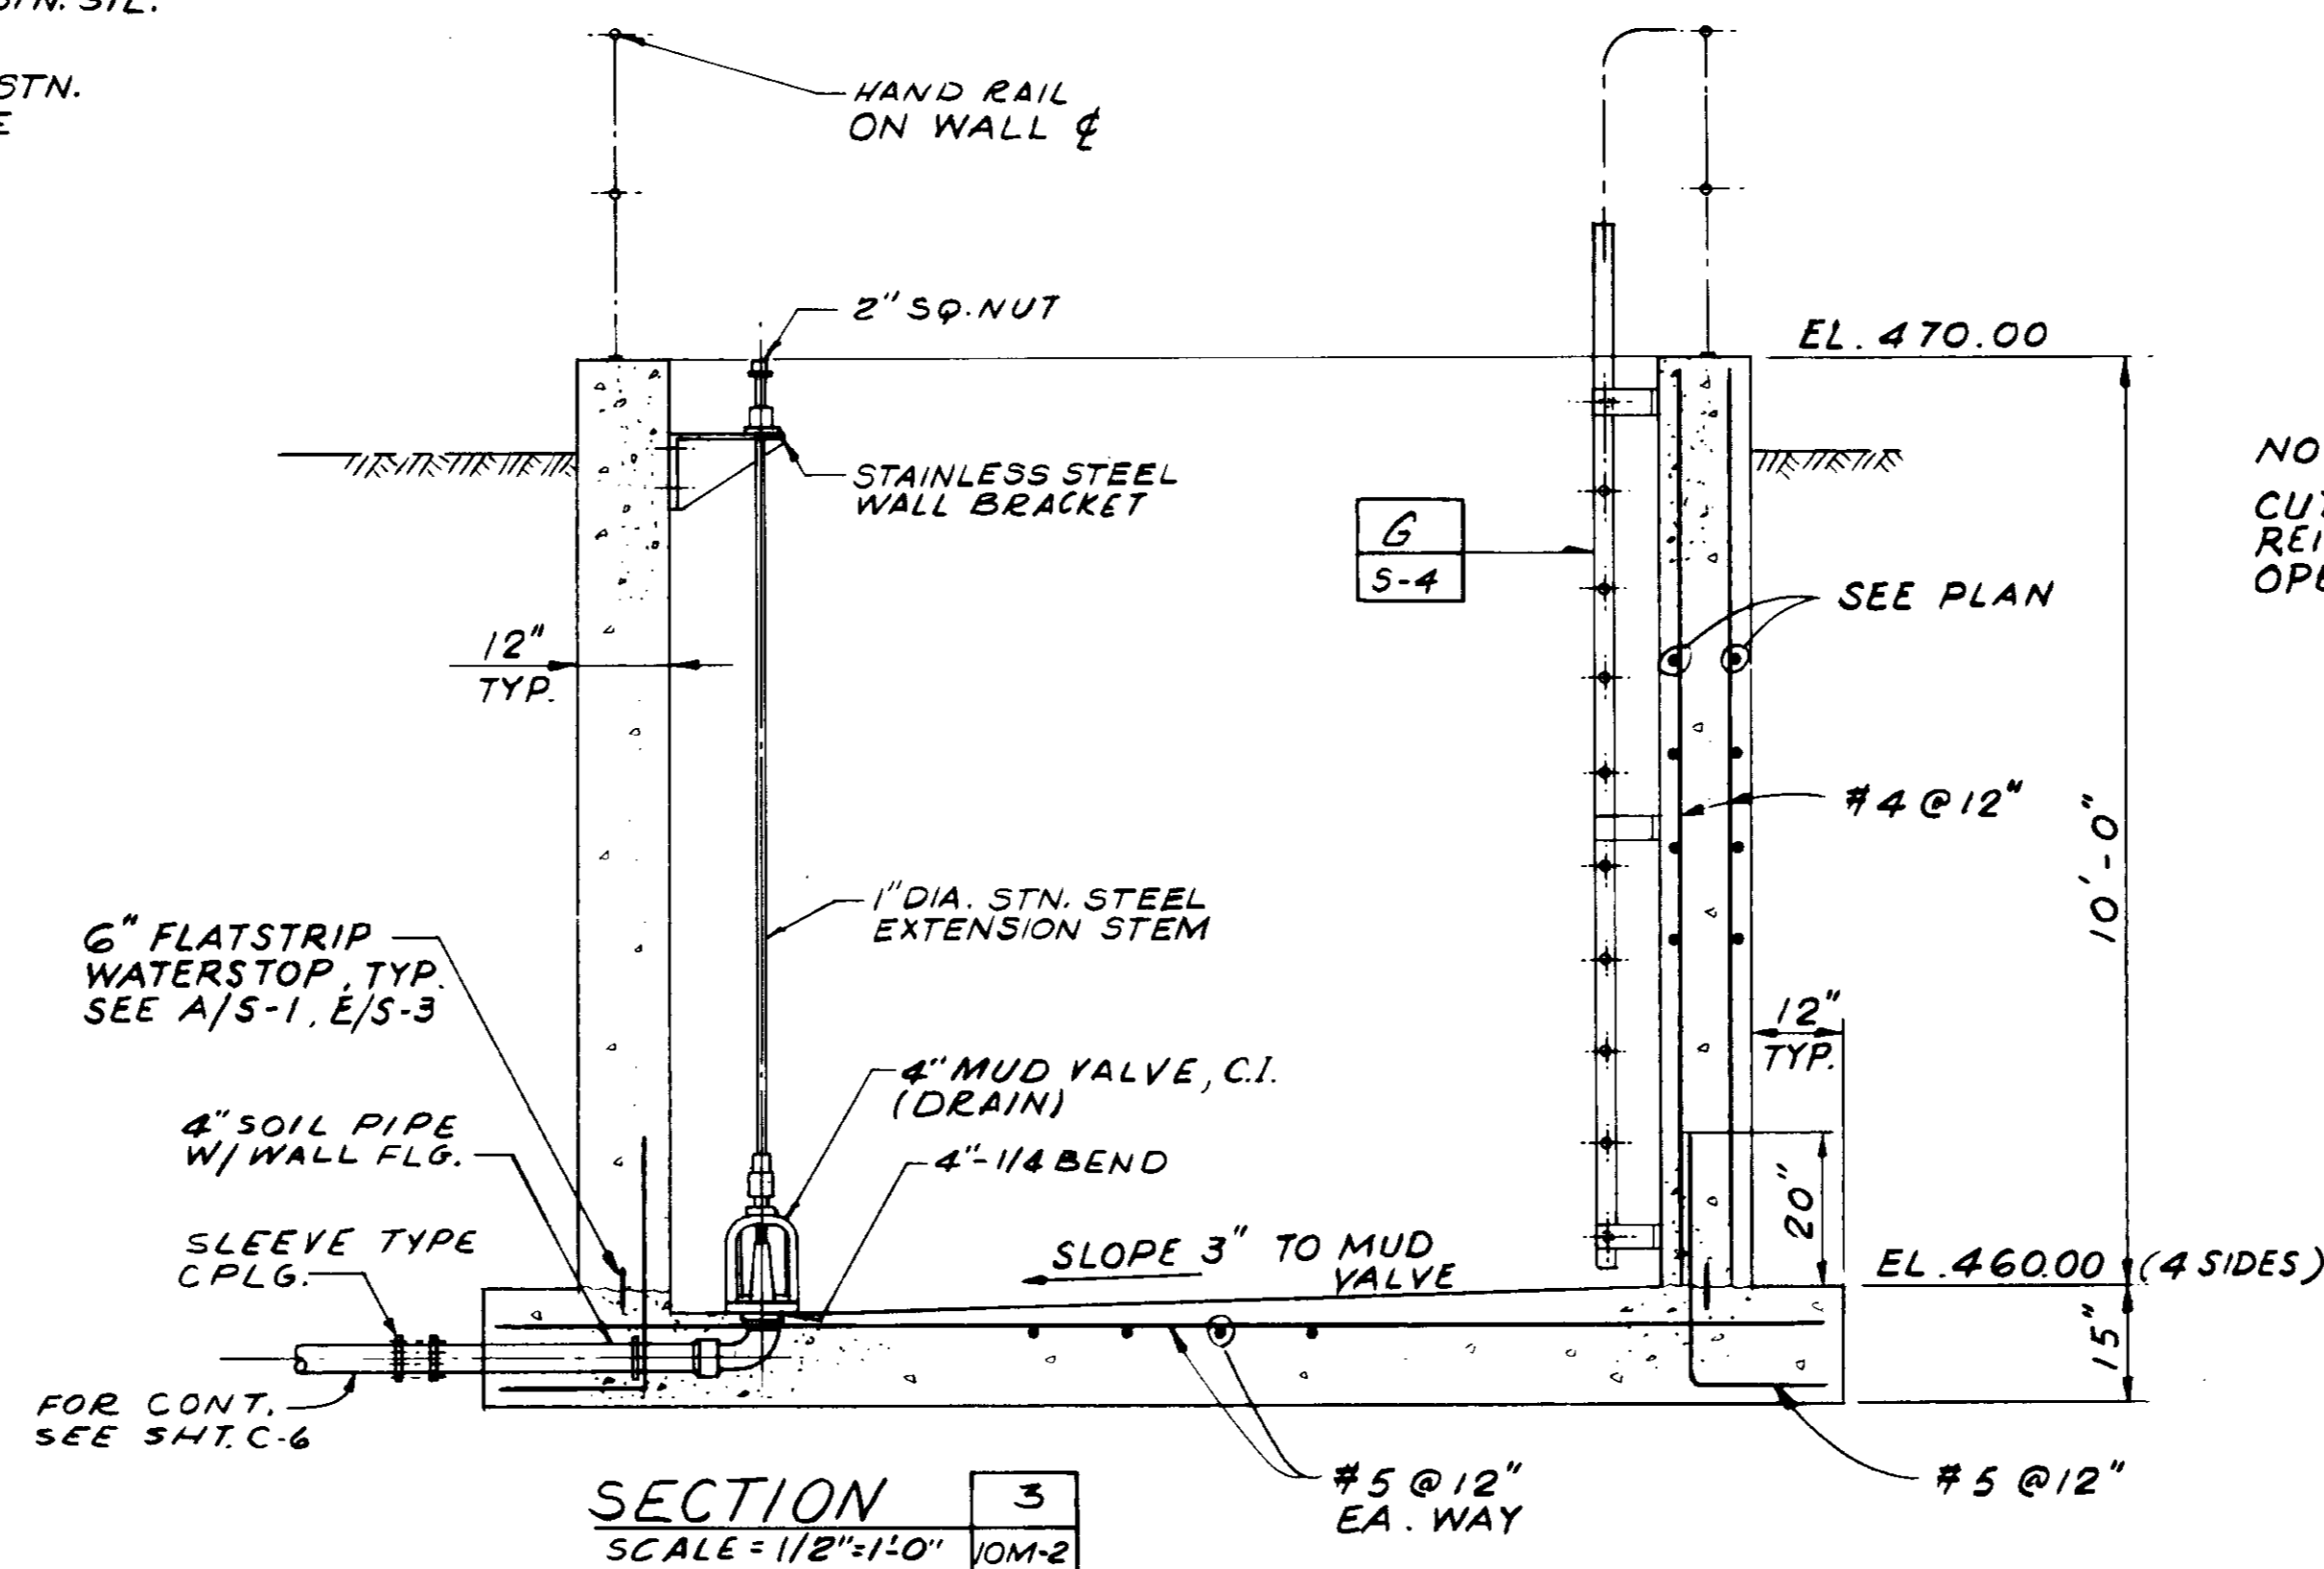

SECTION 3
SCALE: 1/2" = 1'-0" TYP

NOTE:
CUT NORMAL REINF. AT PIPE OPENING

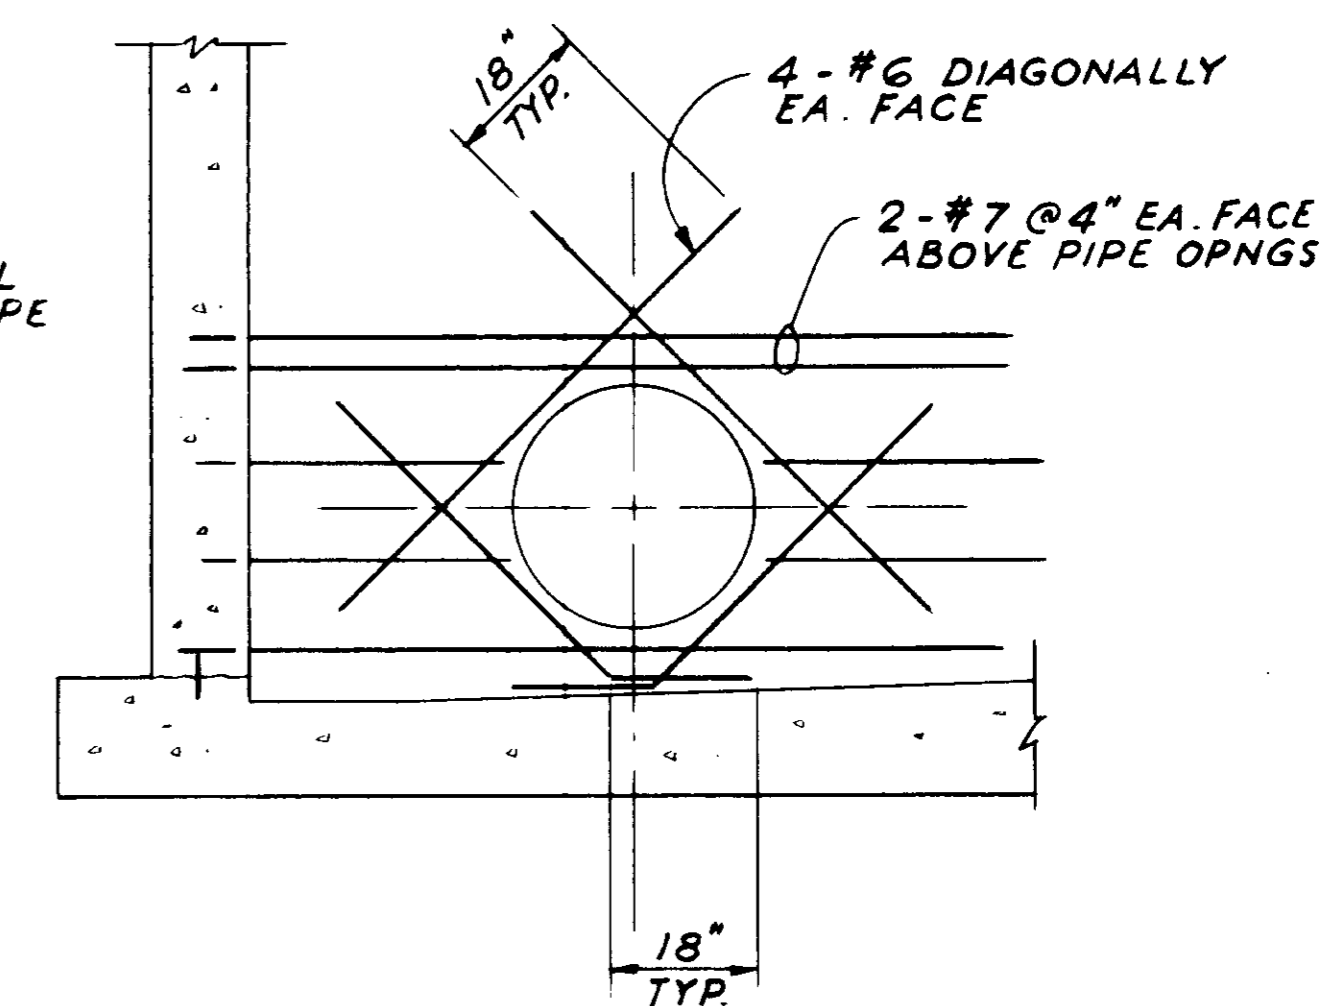

REINF. @ PIPE OPENING K
SCALE: 1/2" = 1'-0" TYP

REV	DATE	BY	DESCRIPTION

SCALE:	AS NOTED
DESIGNED:	<i>Paul Russell</i>
DRAWN:	<i>Paul Russell</i>
CHECKED:	<i>J. Brand</i>

SUBMITTED	<i>Robert C. Smith</i>	27304	8/19/01
PROJECT ENGINEER		R.C.E. NO.	DATE
RECOMMENDED	<i>G. (H.S.)</i>	27633	8/20/01
JAMES M. MONTGOMERY CONSULTING ENGINEERS, INC.		R.C.E. NO.	DATE

JAMES M. MONTGOMERY CONSULTING ENGINEERS, INC.
555 EAST WALNUT STREET, PASADENA, CALIFORNIA 91101

DISTRICT APPROVAL ON TITLE PAGE

PHASE II	LAS VIRGENES MWD/TRIUNFO CSD TAPIA WRF - FILTRATION/DISINFECTION ADDITION EFFLUENT CONTROL VALVE STRUCTURE
----------	--

SHEET
IOM-3
OF 66 SHEETS

1-5-01

03579

RECORD DRAWING

GENERAL NOTES

GENERAL

STRUCTURAL DIMENSIONS CONTROLLED BY OR RELATED TO MECHANICAL OR ELECTRICAL EQUIPMENT SHALL BE VERIFIED BY THE CONTRACTOR PRIOR TO CONSTRUCTION. MECHANICAL AND ELECTRICAL EQUIPMENT SUPPORTS, ANCHORAGES, OPENINGS, RECESSES AND REVEALS NOT SHOWN ON THE STRUCTURAL DRAWINGS BUT REQUIRED BY OTHER CONTRACT DRAWINGS, SHALL BE PROVIDED FOR PRIOR TO PLACING CONCRETE. STRUCTURAL DRAWINGS SHALL BE USED IN COORDINATION WITH MECHANICAL ELECTRICAL, ARCHITECTURAL, CIVIL DRAWINGS AND SHOP DRAWINGS PROVIDED BY MANUFACTURERS OF EQUIPMENT. STRUCTURES HAVE BEEN DESIGNED FOR OPERATIONAL LOADS ON THE COMPLETED STRUCTURES. DURING CONSTRUCTION, THE STRUCTURES SHALL BE PROTECTED BY BRACING AND BALANCING WHEREVER EXCESSIVE CONSTRUCTION LOADS MAY OCCUR. ALL CONSTRUCTION JOINTS REQUIRED FOR CONSTRUCTION BUT NOT SHOWN ON THE DRAWINGS SHALL HAVE A 6" FLATSTRIP WATERSTOPS IF IN MEMBERS IN CONTACT WITH WATER.

STRUCTURAL

DESIGN IN ACCORDANCE WITH THE 1976 EDITION OF THE UNIFORM BUILDING CODE. DESIGN FOR FOUNDATIONS IS BASED ON THE RECOMMENDATIONS OF "GEOTECHNICAL INVESTIGATION TERTIARY ADDITIONS, TAPIA WRF" BY CONVERSE, WARD, DAVIS, DIXON, GEOTECHNICAL CONSULTANTS, 126 WEST DEL MAR BLVD., PASADENA, CALIF. ORNIA 91105. DATED FEBRUARY 6, 1979.

STRUCTURAL STEEL

STEEL CONSTRUCTION SHALL CONFORM TO THE SPECIFICATIONS AND STANDARDS AS CONTAINED IN THE LATEST EDITION OF THE AISC STEEL CONSTRUCTION MANUAL. ALL STRUCTURAL SHAPES, BARS, PLATES AND SHEETS SHALL BE OF STEEL MEETING ASTM-A-36 SPECIFICATIONS.

CONCRETE

ALL STRUCTURAL CONCRETE SHALL DEVELOP A COMPRESSIVE STRENGTH OF 4,000 PSI MINIMUM IN 28 DAYS. REINFORCEMENT STEEL SHALL BE DEFORMED BARS CONFORMING TO THE REQUIREMENTS OF THE SPECIFICATIONS FOR DEFORMED BILLET-STEEL BARS FOR CONCRETE REQUIREMENT. ASTM DESIGNATION A-615, GRADE 60. COVER FOR REINFORCING BARS SHALL BE AS FOLLOWS:
 FOR CONCRETE PLACED AGAINST EARTH.....3"
 FOR SURFACES IN CONTACT WITH WATER.....2"
 FORMED SURFACES IN CONTACT WITH EARTH.....2"
 FOR UNDERSIDE OF SLABS OVER WATER IN ENCLOSED CONDUITS, BEAMS AND COLUMNS NOT IN CONTACT WITH EARTH OR WATER.....1 1/2"
 SURFACES EXPOSED TO AIR AND ALL INTERIOR SURFACES IN PIPE GALLERIES OR DRY ROOMS.....1"
 UNLESS OTHERWISE SHOWN, ASIDE FROM NORMAL ACCESSORIES USED TO HOLD REINFORCING BARS FIRMLY IN POSITION, THE FOLLOWING SHALL BE ADDED:
 A) IN SLABS NO. 5 RISER BARS AT 36 INCHES O.C. MAXIMUM TO SUPPORT TOP REINFORCING BARS.
 B) IN WALLS WITH 2 CURTAINS NO. 3 U OR Z SHAPE SPACERS AT 6 FEET O.C. EACH WAY.

METAL CLIPS OR SUPPORTS SHALL NOT BE PLACED IN CONTACT WITH THE FORMS OR THE SUBGRADE. CONCRETE BLOCKS (OR DOBBIES) SUPPORTING BARS ON SUBGRADE SHALL BE IN SUFFICIENT NUMBERS TO SUPPORT THE BARS WITHOUT SETTLEMENT, BUT IN NO CASE SUCH SUPPORT SHALL BE CONTINUOUS. DOWELS SHALL BE WIRED OR OTHERWISE HELD IN POSITION. THEY SHALL NOT BE SHOVED INTO FRESHLY PLACED CONCRETE. UNLESS OTHERWISE NOTED OR SHOWN ON DRAWINGS, ALL BAR SPLICES SHALL BE LAPPED AT LEAST 32 BAR DIAMETERS. LOCATE TWO 3/4 GALV. RICHMOND ROCKET, HOHMANN AND BARNARD, OR EQUAL INSERTS, STRADDLING CENTER LINE OF EQUIPMENT, OVER ALL PUMPS, METERS OR OTHER MECHANICAL UNITS OF MORE THAN 100 POUNDS FOR INSERTING LIFTING EYES. IF NOT OTHERWISE SHOWN ON DRAWINGS. REINFORCEMENT BARS AND ACCESSORIES SHALL NOT BE IN CONTACT WITH ANY PIPE, PIPE FLANGE OR METAL PARTS EMBEDDED IN CONCRETE, A MINIMUM OF 2 INCHES CLEARANCE SHALL BE PROVIDED AT ALL TIMES.

ALUMINUM






ALUMINUM CONSTRUCTION SHALL BE IN ACCORDANCE WITH AMERICAN SOCIETY OF CIVIL ENGINEERS SPECIFICATIONS FOR STRUCTURES OF ALUMINUM ALLOY 6061-T6. ALUMINUM SURFACES SHALL BE PREVENTED FROM COMING IN DIRECT CONTACT WITH CONCRETE OR WITH METALS NOT COMPATIBLE WITH ALUMINUM, USING METHODS DESCRIBED IN THE SPECIFICATIONS.

STAINLESS STEEL

UNLESS OTHERWISE SHOWN OR SPECIFIED, STAINLESS STEEL SHALL BE TYPE 18-8.

TESTING HYDRAULIC STRUCTURES

WHEN FILLING THE STRUCTURES WITH WATER, FOR THE TEST REQUIRED IN THE SPECIFICATIONS, ALL VARIOUS BASINS LOCATED WITHIN THE SAME STRUCTURE SHALL BE FILLED SIMULTANEOUSLY AT THE SAME RATE IN ORDER TO KEEP THE SAME LEVEL IN EACH BASIN.

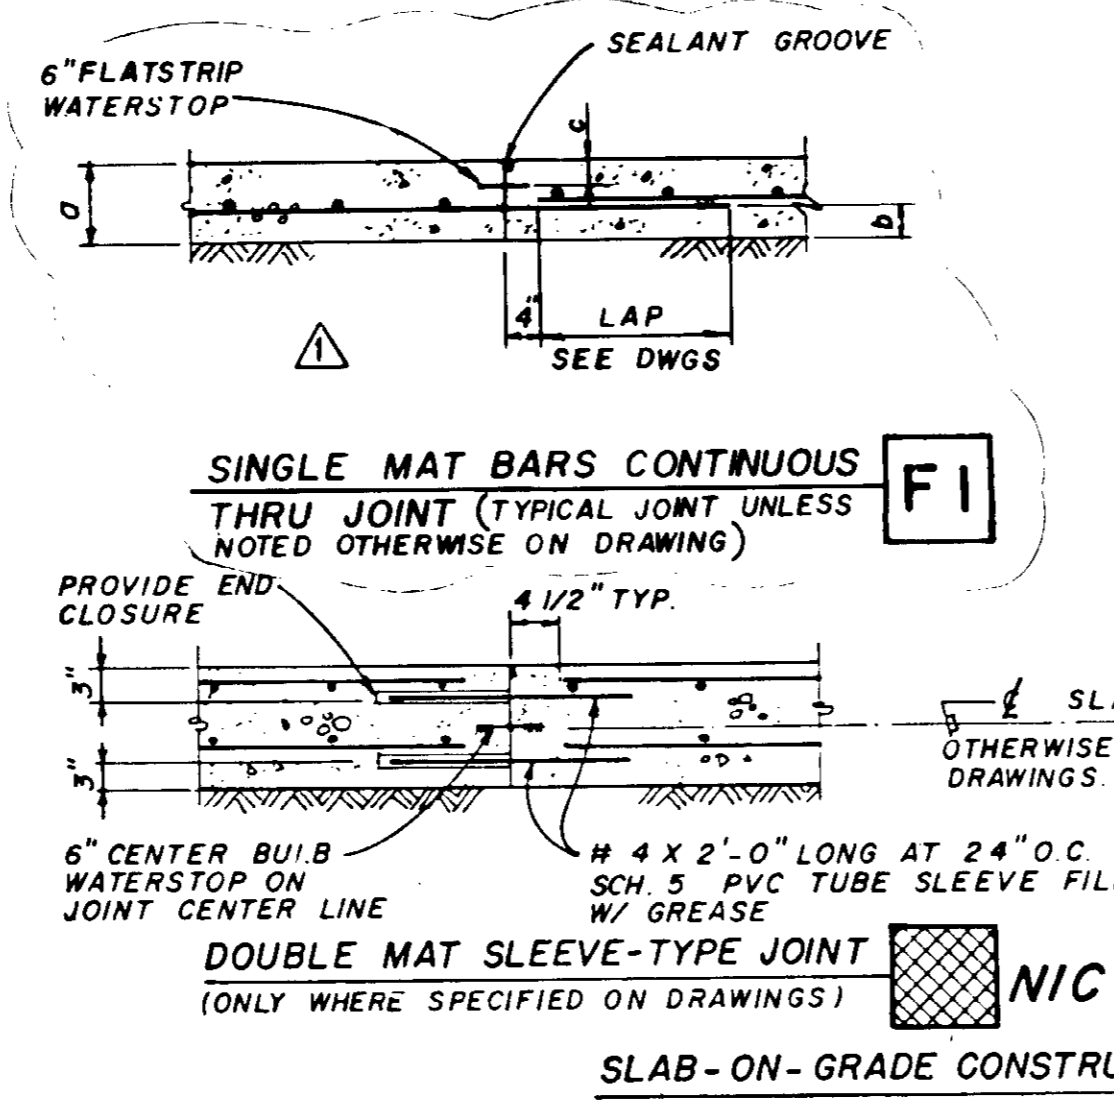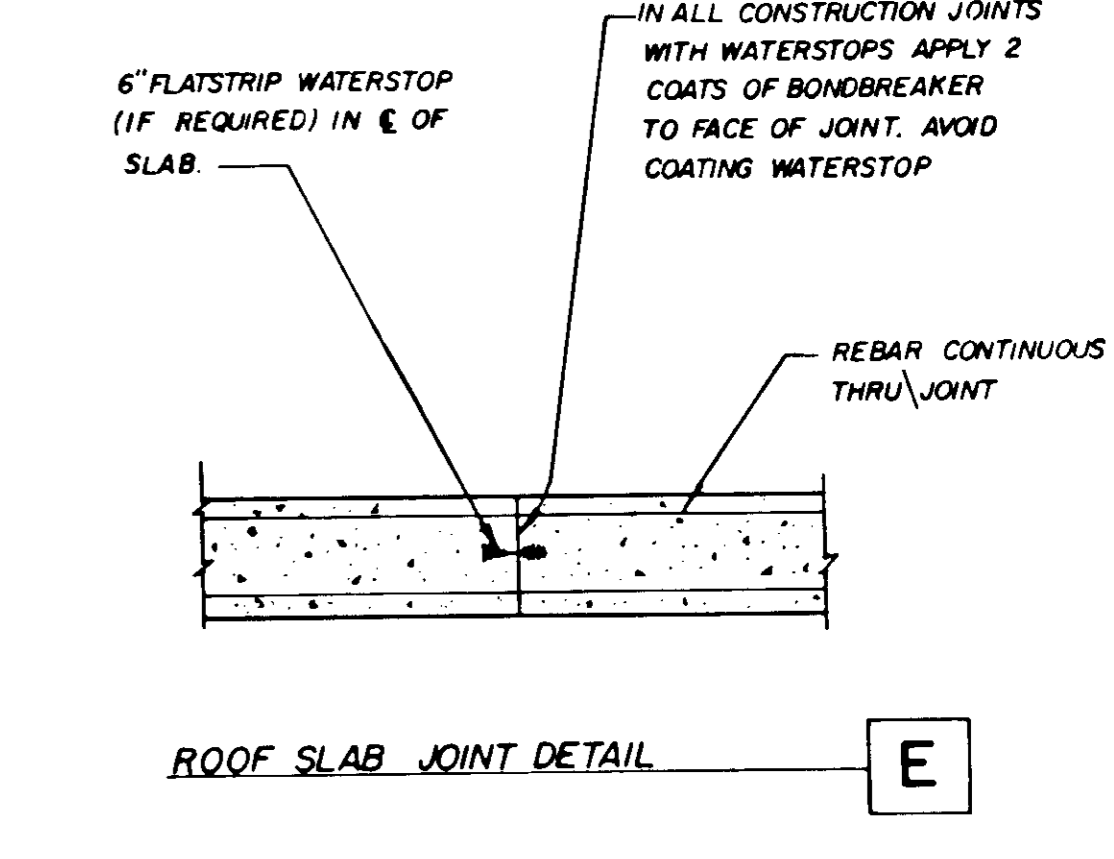
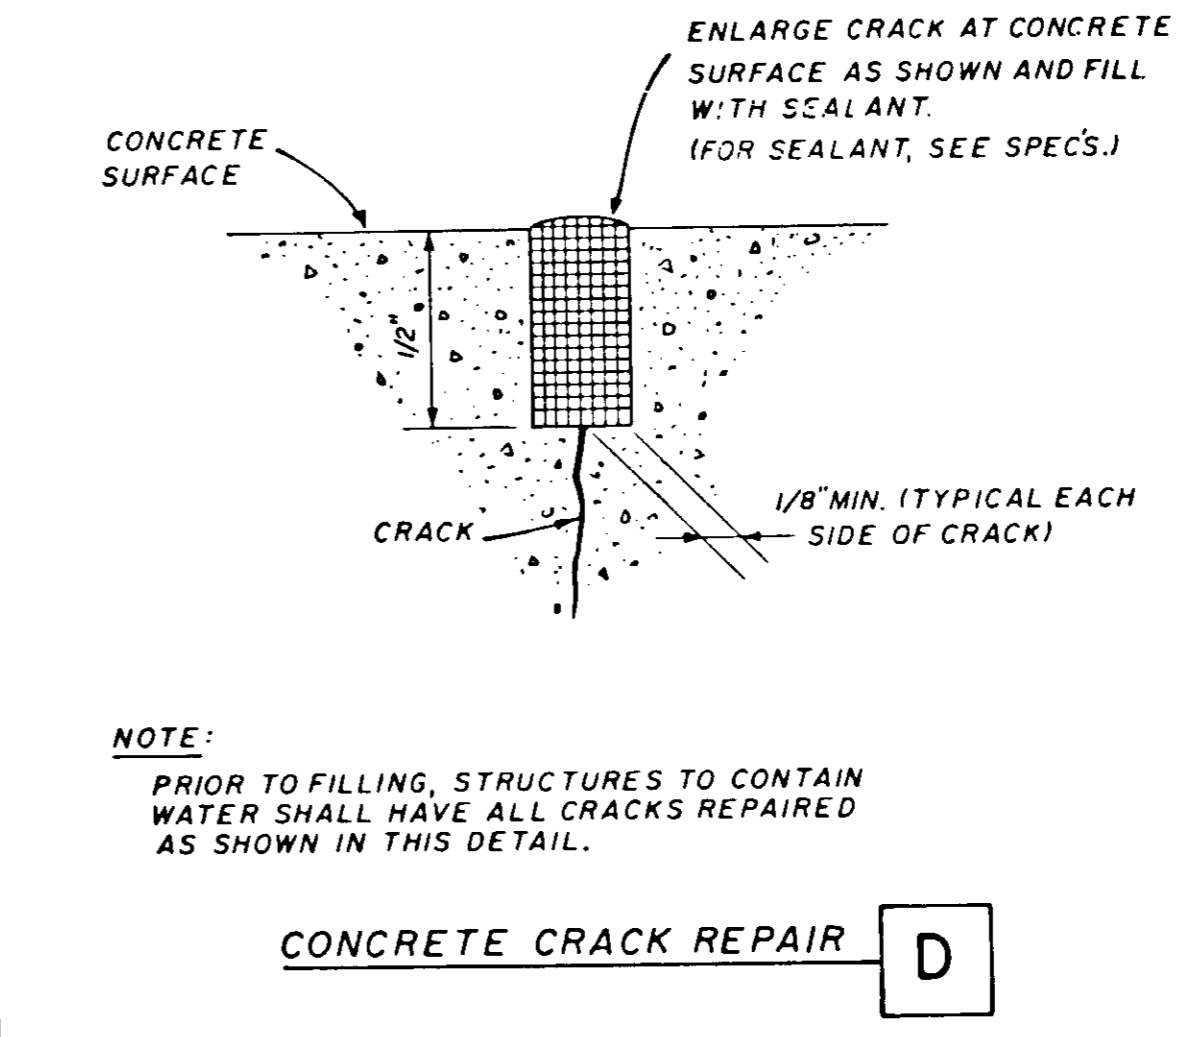
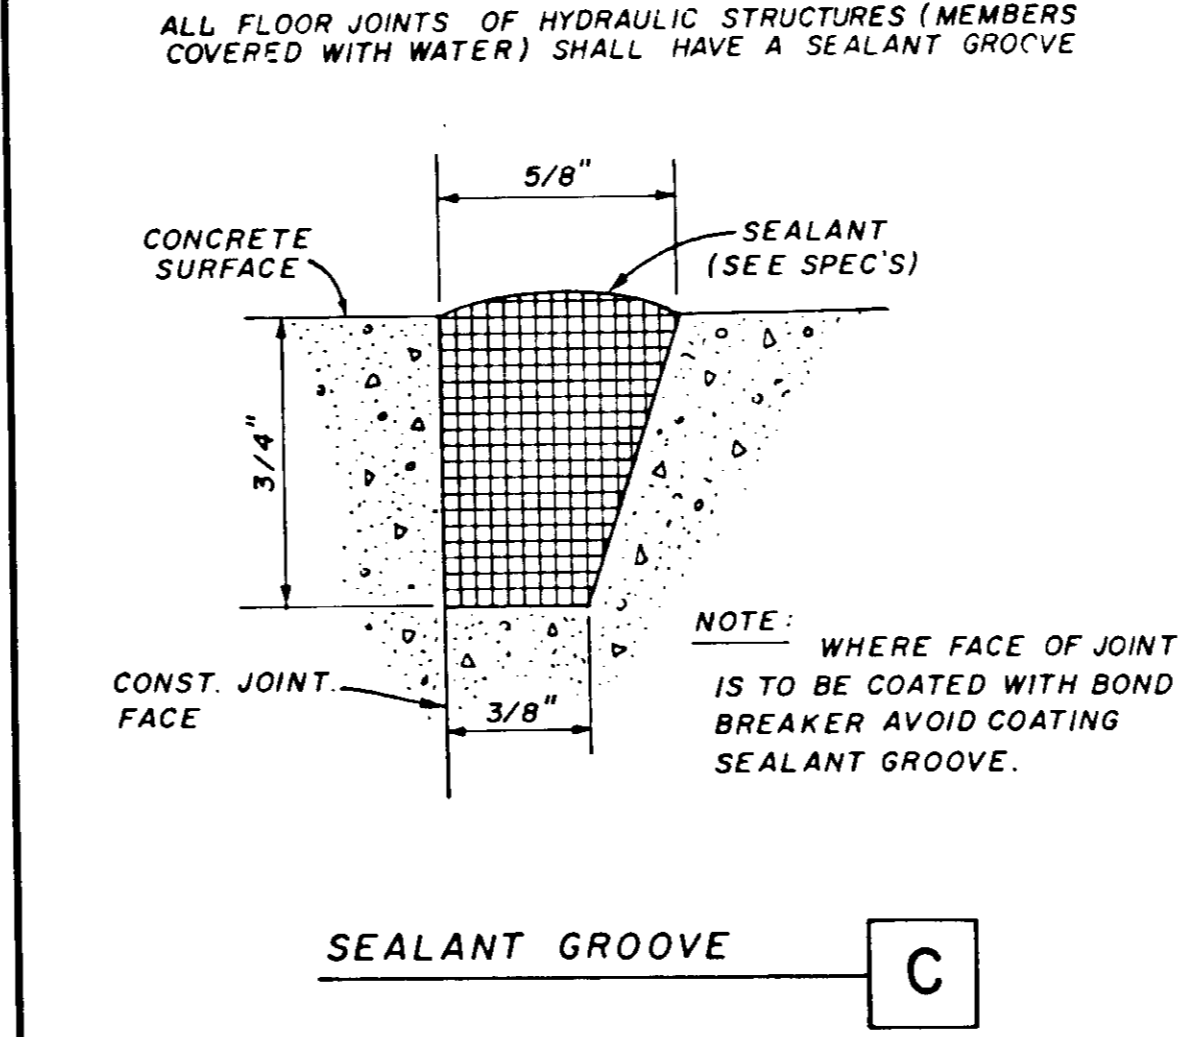
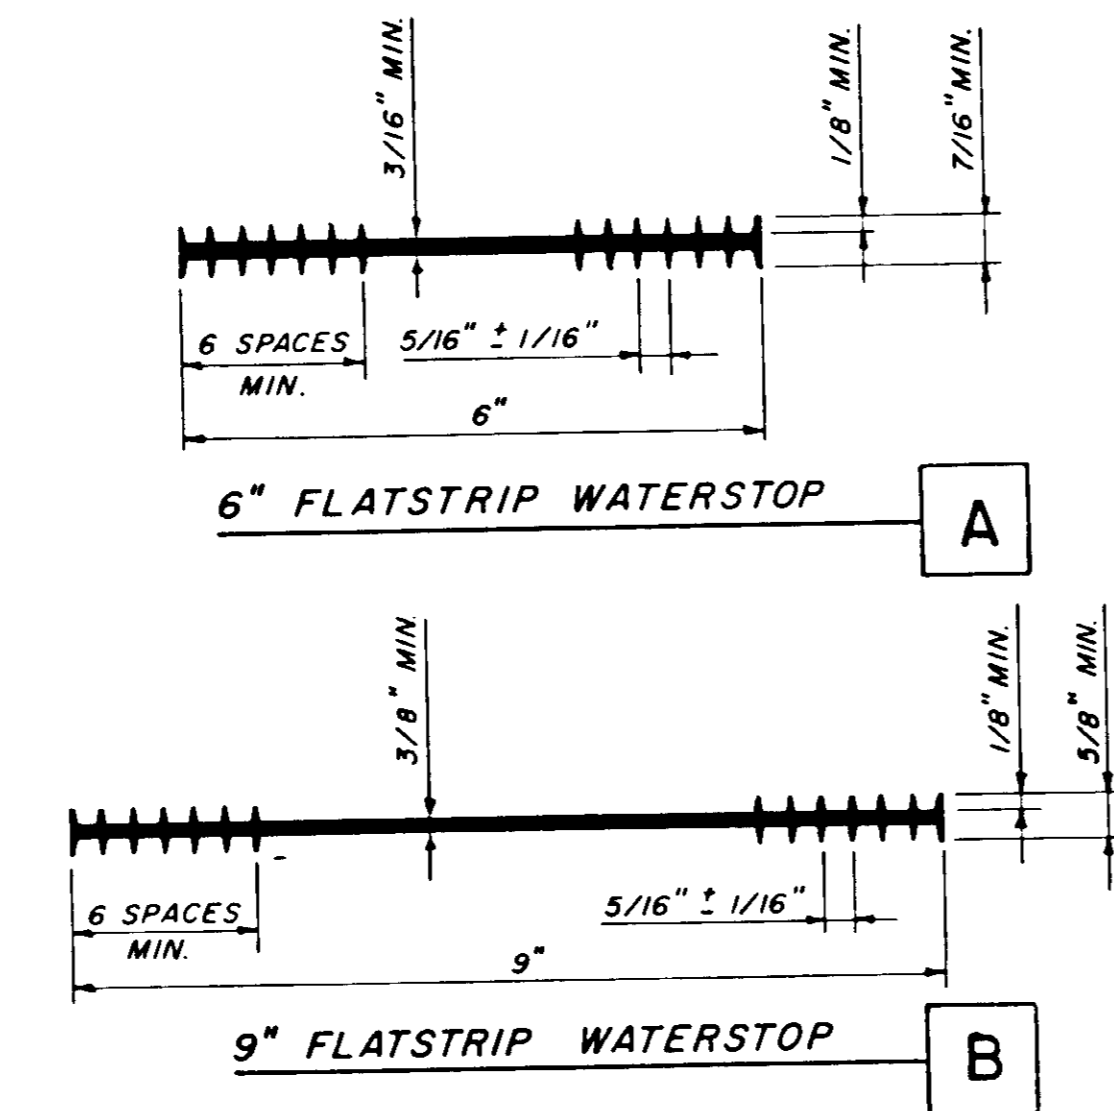


NOTES:

- IN ALL CONSTRUCTION JOINTS WITH WATERSTOPS APPLY 2 COATS OF BONDBREAKER TO FACE OF JOINT, AVOID COATING WATERSTOP (AND SEALANT GROOVE WHERE USED)
- WATERSTOPS AND SEALANT GROOVES TO BE PROVIDED IN ALL WATER RETAINING STRUCTURE, SEE DRAWINGS FOR OTHER LOCATIONS WHERE THEY MAY BE REQUIRED.

a	b	c
6"	3	2"
7"	3 1/2"	2"
8"	4"	2 1/2"

SEE DRAWINGS FOR LAP LOCATIONS, IF NOT SPECIFIED PLACE LAP AS SHOWN HEREIN FOR TOP AND BOTTOM MATS.

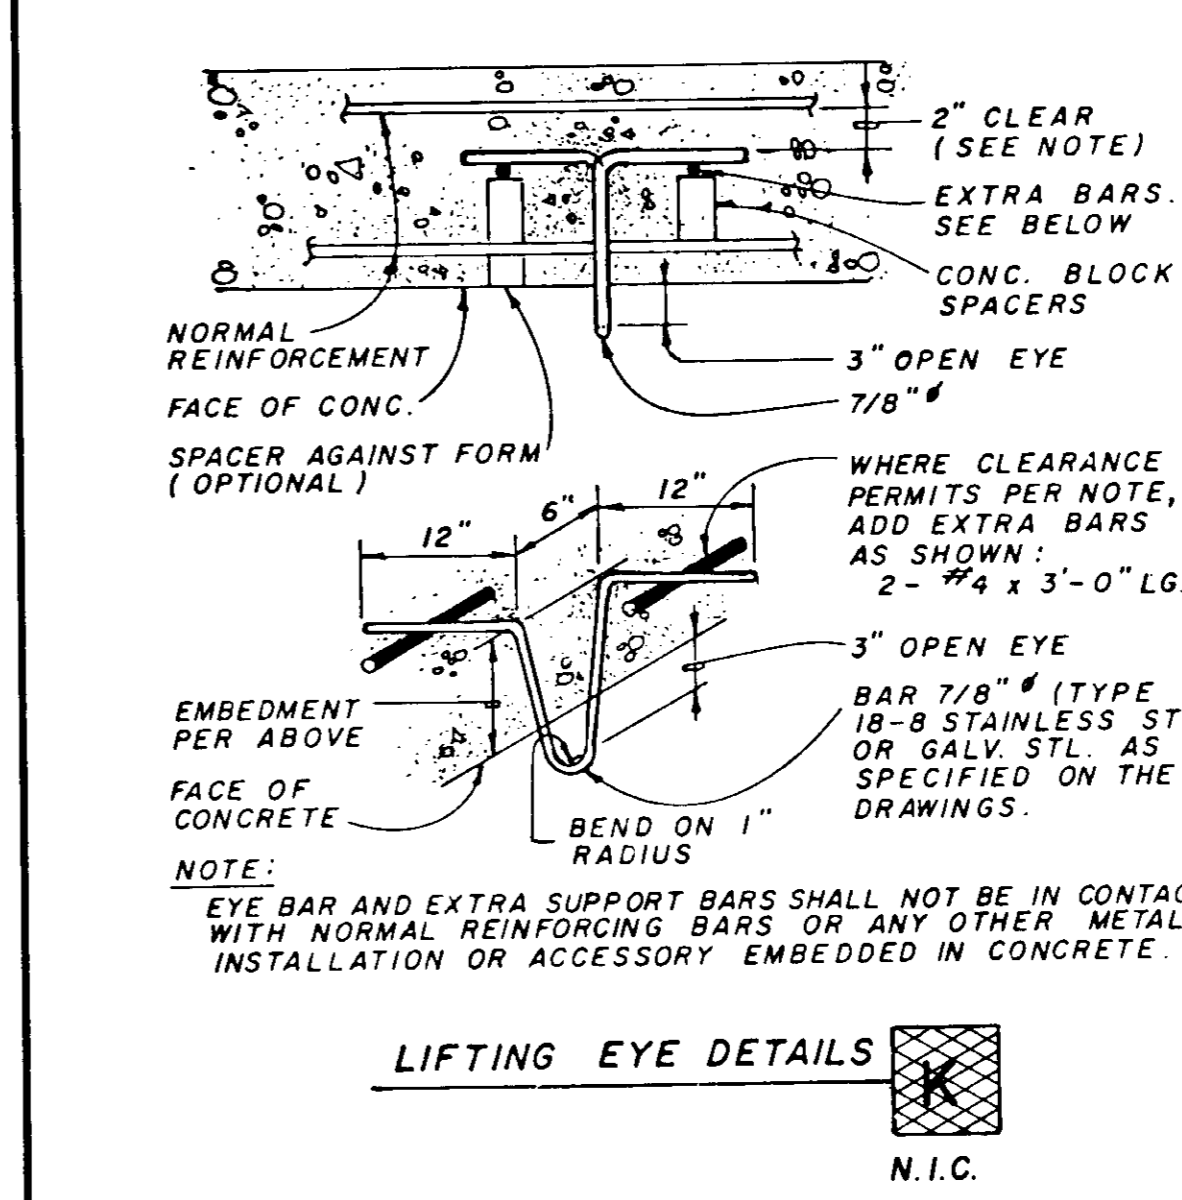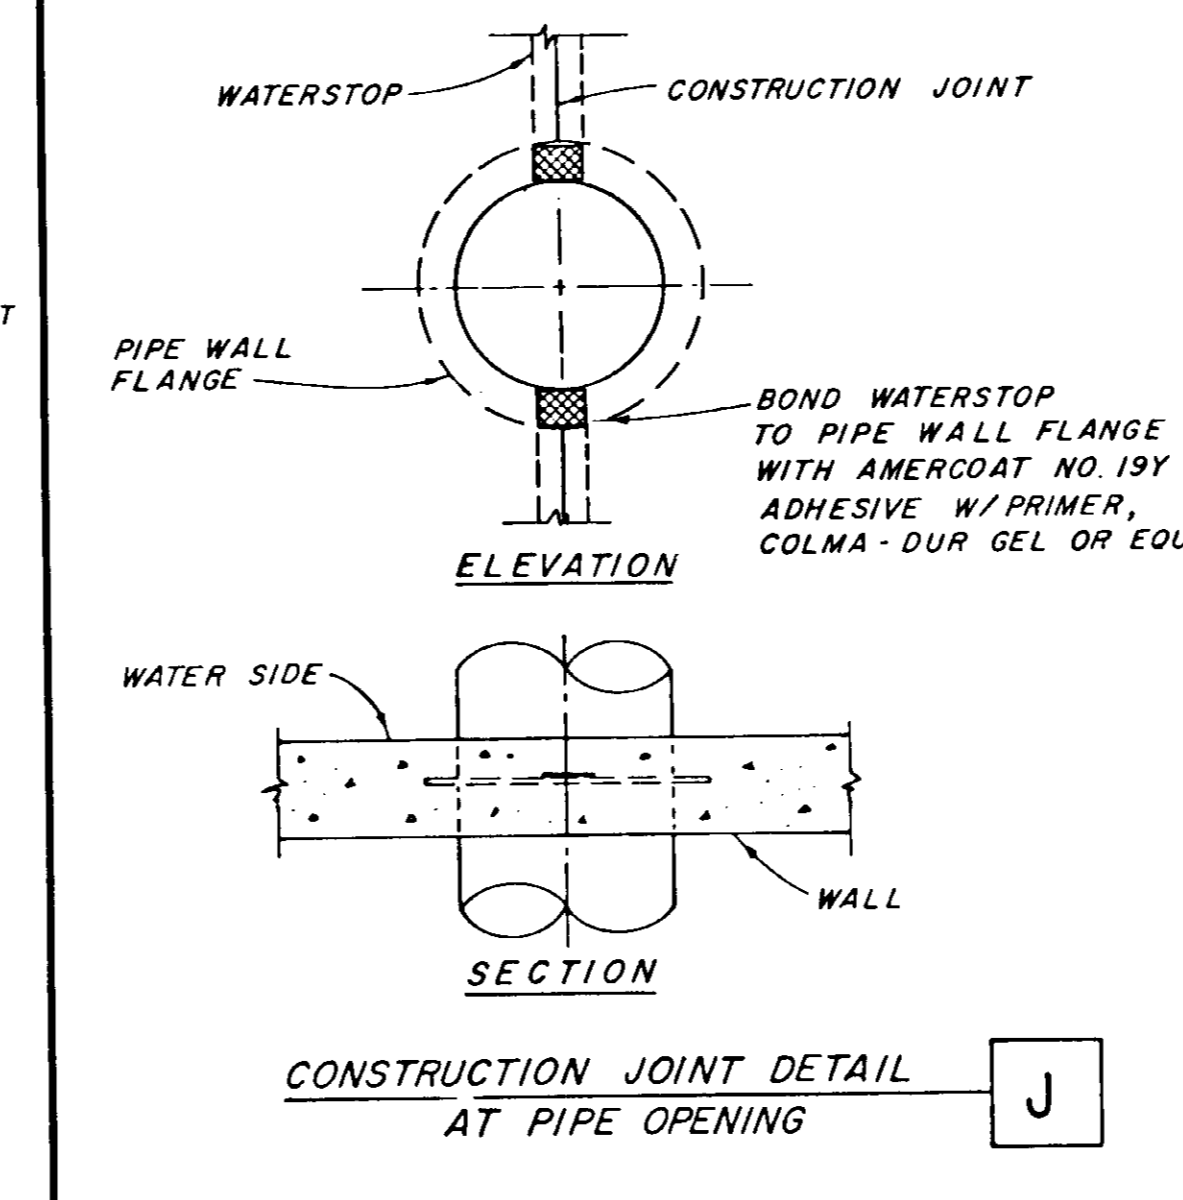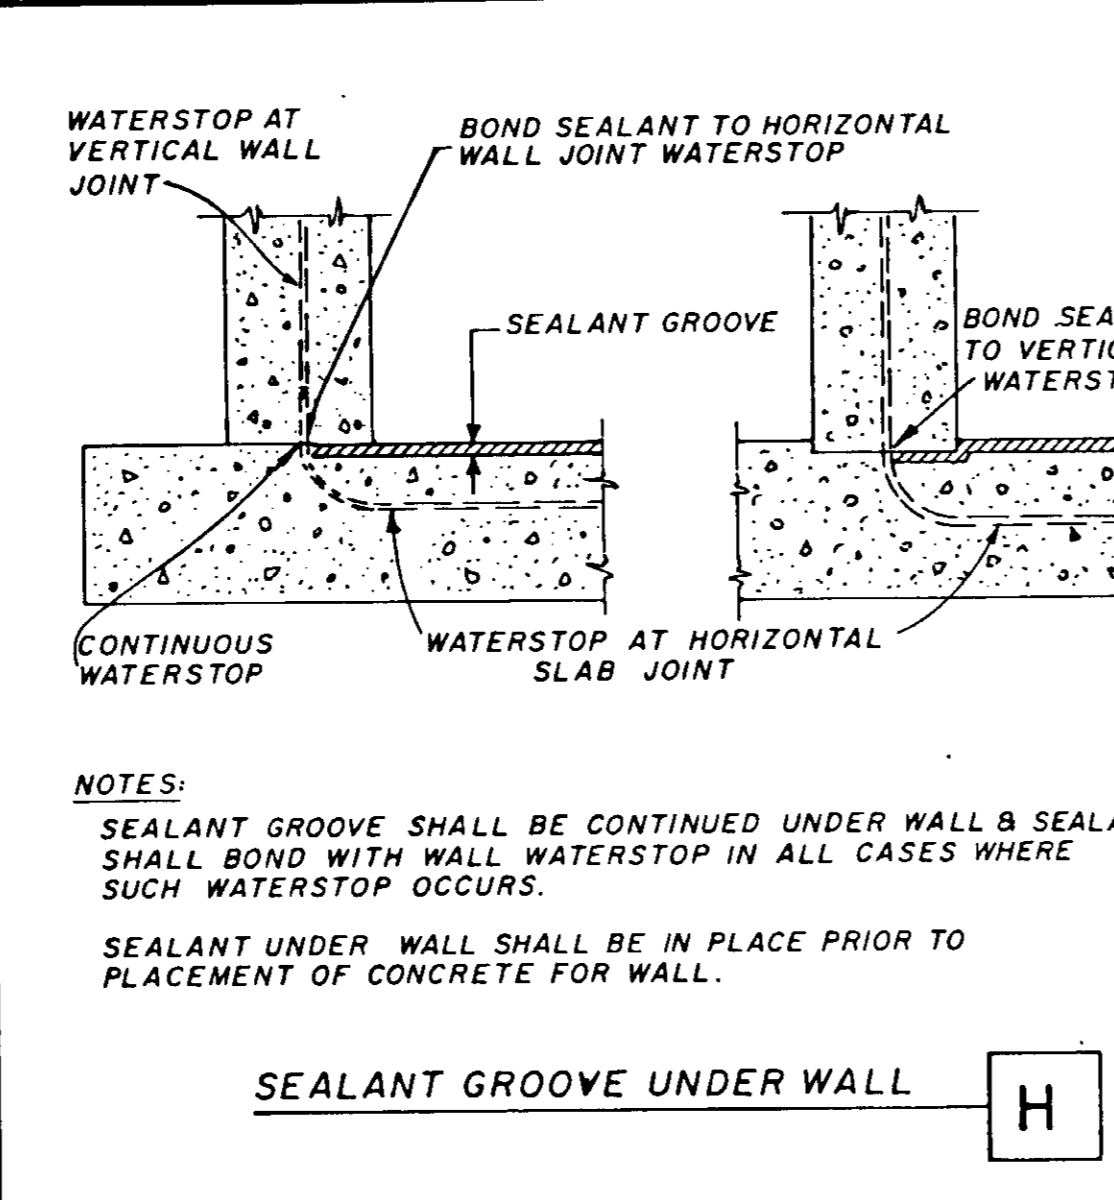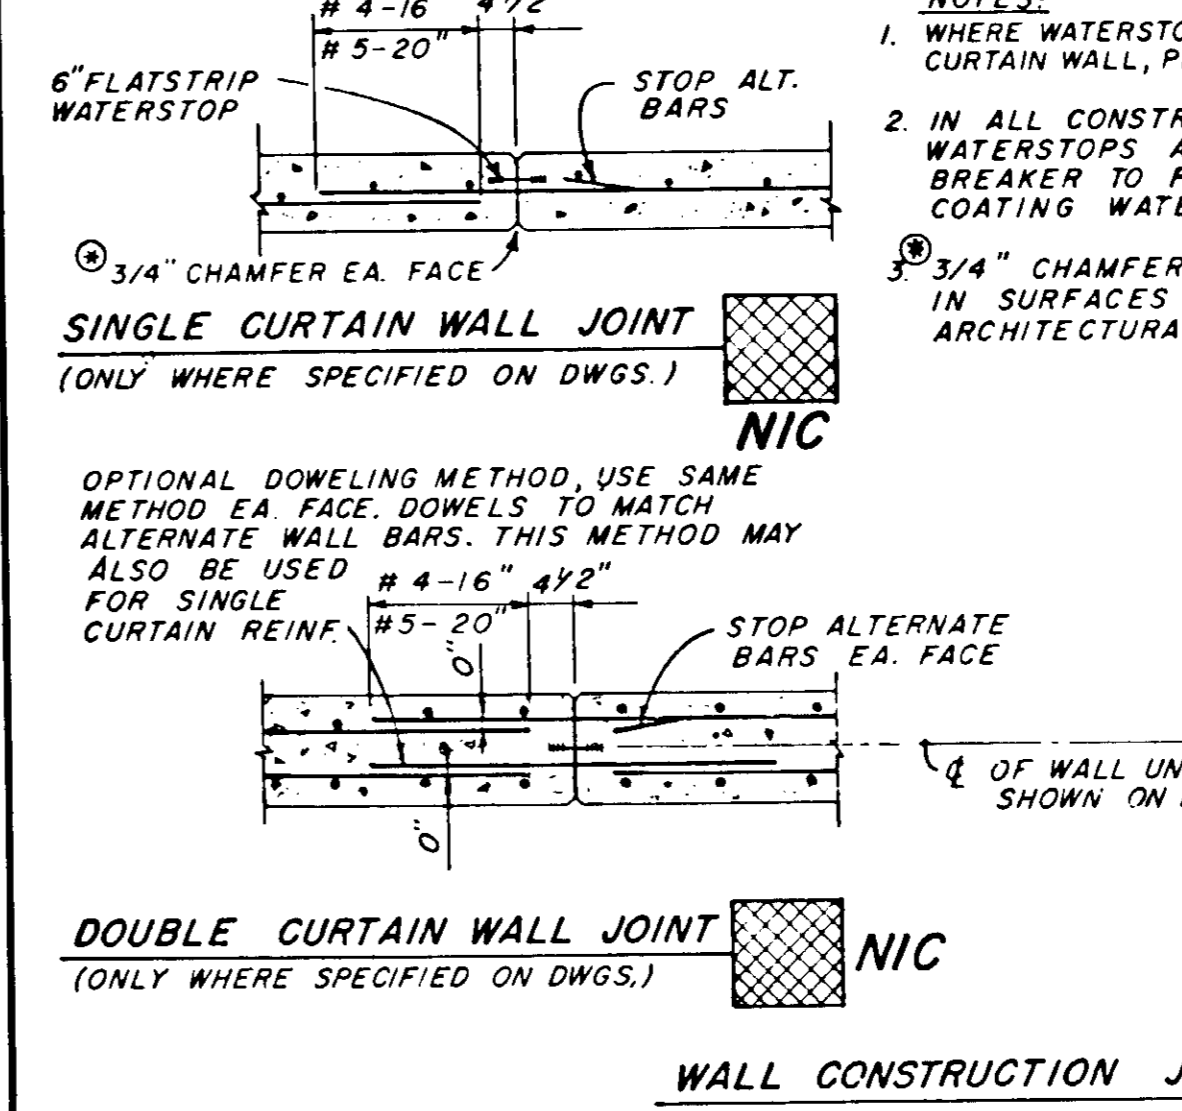

THE DETAILS ILLUSTRATED ON THIS SHEET ARE PART OF JAMES M. MONTGOMERY STANDARD DETAILS. THESE DETAILS ARE TO BE USED WHEN REFERRED TO OR WHEN NO OTHER MORE RESTRICTIVE OR DIFFERENT DETAILS ARE SHOWN ON THE DRAWINGS. DETAILS NOT PERTAINING TO THE PROJECT ARE MARKED THUS N.I.C. (NOT IN CONTRACT)

JOB NO. 9301 P.R.
 DRAWING NO. 42
 SHEET NO. 1

SCALE:	NO SCALE
REVISIONS:	9-30-81 P.R. CONST. JOINT DETAIL ADDED

DESIGNED	P. REYMOND	DATE	8/19/81
DRAWN	M. LASLEY	DATE	8/20/81
CHECKED	P. REYMOND	DATE	8/20/81


JAMES M. MONTGOMERY CONSULTING ENGINEERS, INC.
 555 EAST WALNUT STREET, PASADENA, CALIFORNIA 91101

DISTRICT APPROVAL ON TITLE PAGE

LAS VIRGENES MWD/TRIUNFO CSD		SHEET
TAPIA WRF - FILTRATION/DISINFECTION ADDITION		S-1
PHASE II	GENERAL NOTES AND CONSTRUCTION JOINT DETAILS	OF 66 SHEETS

03580


RECORD DRAWING

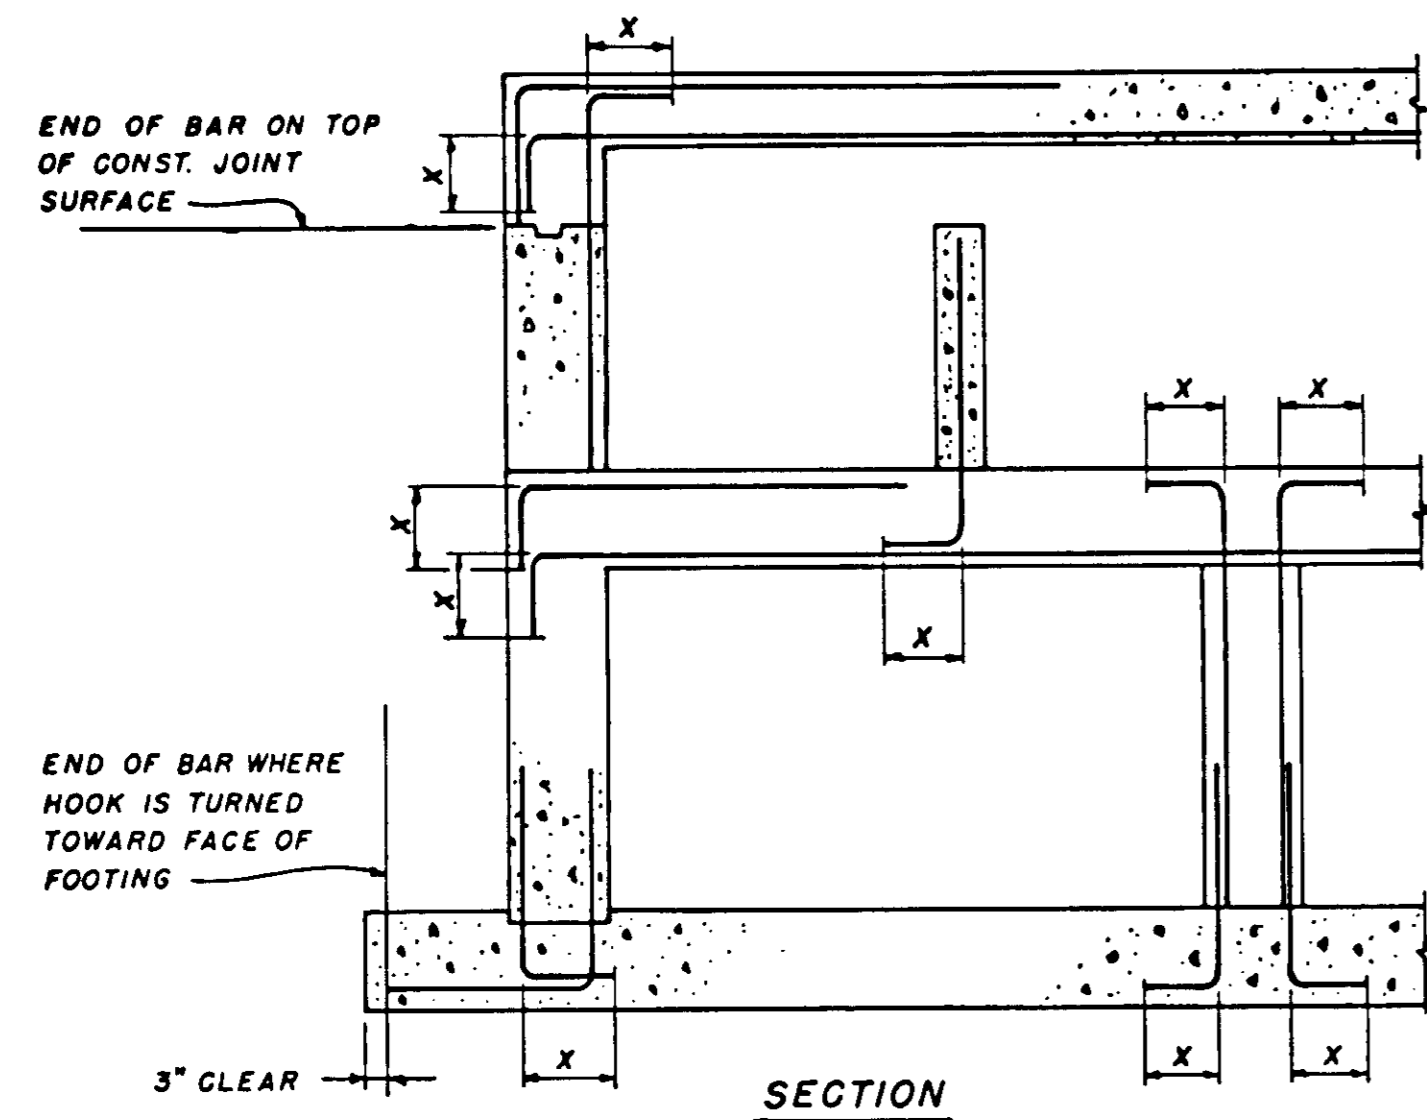

BAR SIZE	90° HOOKS "X"	BAR SIZE	90° HOOKS "X"
# 3	6"	# 8	16"
# 4	8"	# 9	19"
# 5	10"	# 10	22"
# 6	12"	# 11	24"
# 7	14"		

NOTE:
UNLESS OTHERWISE NOTED ON THE DRAWINGS ALL LENGTHS OF BAR HOOKS IN FOOTINGS, COLUMNS, WALLS AND SLABS SHALL BE AS GIVEN IN THE TABLE HEREIN.
THE HOOK LENGTH "X" IS THE STANDARD 90° BAR HOOK LENGTH FOR GRADE 40 OR GRADE 60 REINFORCEMENT STEEL.


STANDARD 90° BAR HOOKS **A**

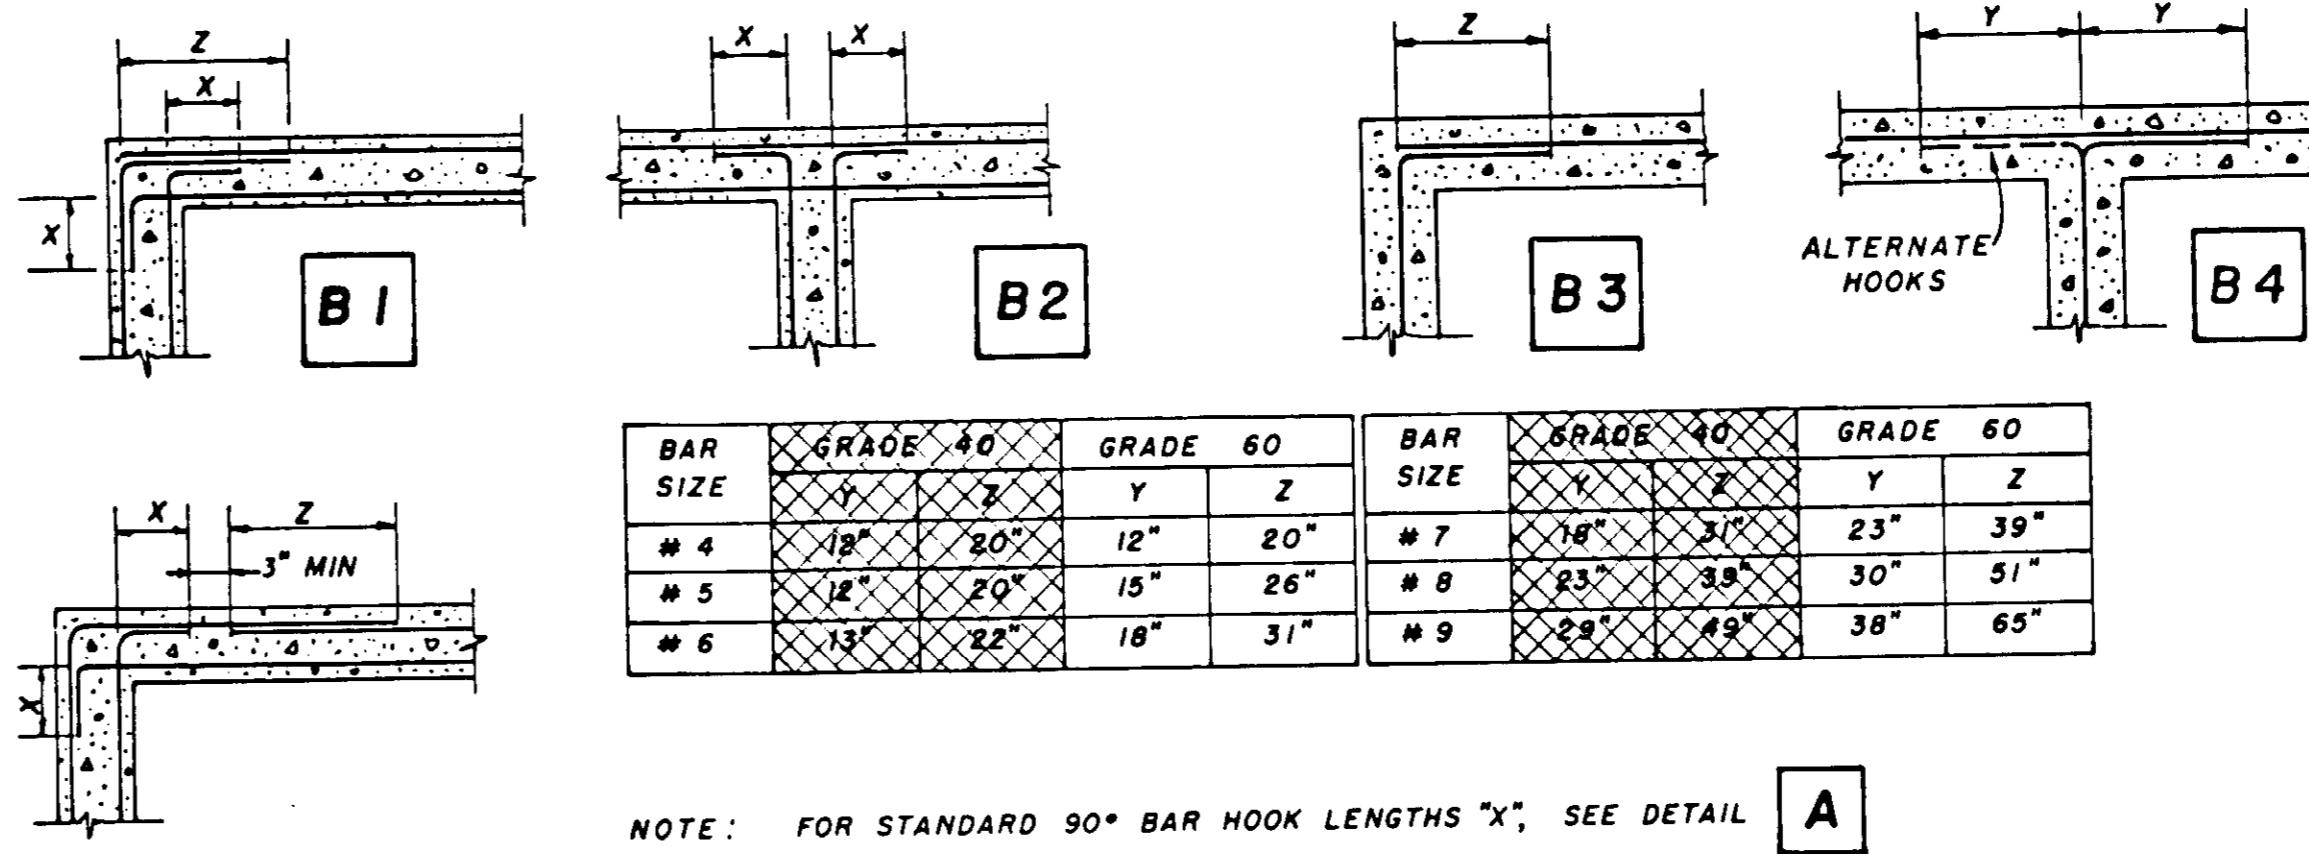

BAR SIZE	GRADE 40		GRADE 60		BAR SIZE	GRADE 40		GRADE 60	
	Y	Z	Y	Z		Y	Z	Y	Z
# 4	18"	20"	12"	20"	# 7	18"	31"	23"	39"
# 5	12"	20"	15"	26"	# 8	23"	38"	30"	51"
# 6	13"	22"	18"	31"	# 9	28"	49"	38"	65"

NOTE: FOR STANDARD 90° BAR HOOK LENGTHS "X", SEE DETAIL **A**


HORIZONTAL REINFORCEMENT AT WALL INTERSECTIONS **B**

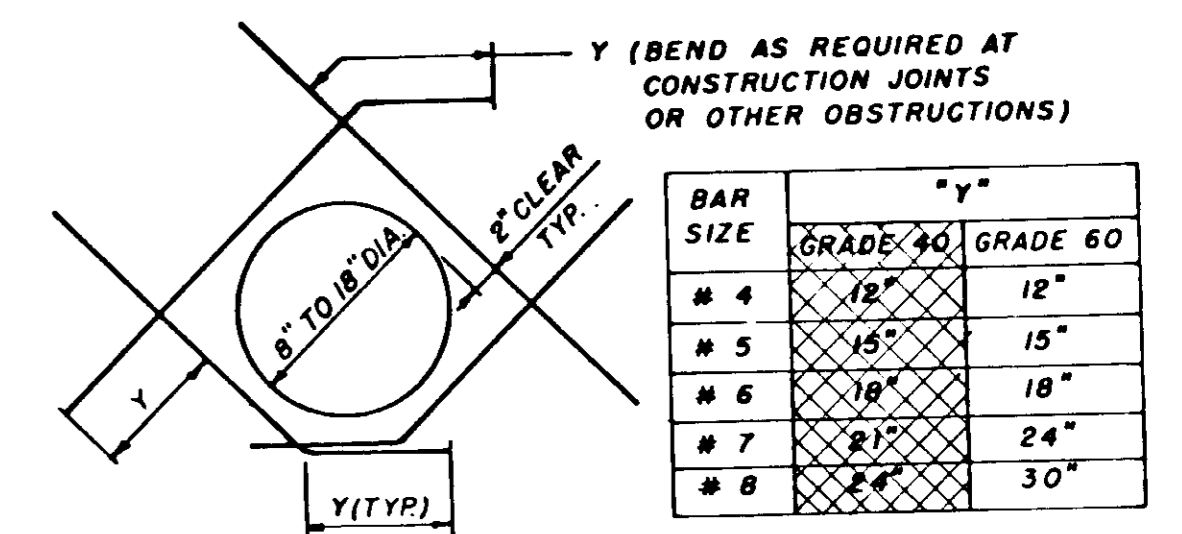

BAR SIZE	"Y"	
	GRADE 40	GRADE 60
# 4	12"	12"
# 5	15"	15"
# 6	18"	18"
# 7	21"	24"
# 8	24"	30"

- CUT NORMAL REINFORCEMENT AT OPENING.
- DIAGONAL BARS TO BE PLACED;
A. AT $\frac{1}{2}$ OF WALL WHERE ONE LAYER OF REINFORCEMENT IS PROVIDED.
B. AT EACH FACE OF WALL WHERE TWO LAYERS OF REINFORCEMENT ARE PROVIDED.
- UNLESS OTHERWISE NOTED, SIZE OF DIAGONAL BARS SHALL BE THE SIZE OF THE LARGEST NORMAL REINF. BAR CUT.
- THIS DETAIL TO BE USED ONLY WHEN CALLED FOR ON THE DRAWINGS OR WHEN NO OTHER DETAIL IS SPECIFIED.


DIAGONAL REINFORCEMENT AT CIRCULAR WALL OPENINGS **C**

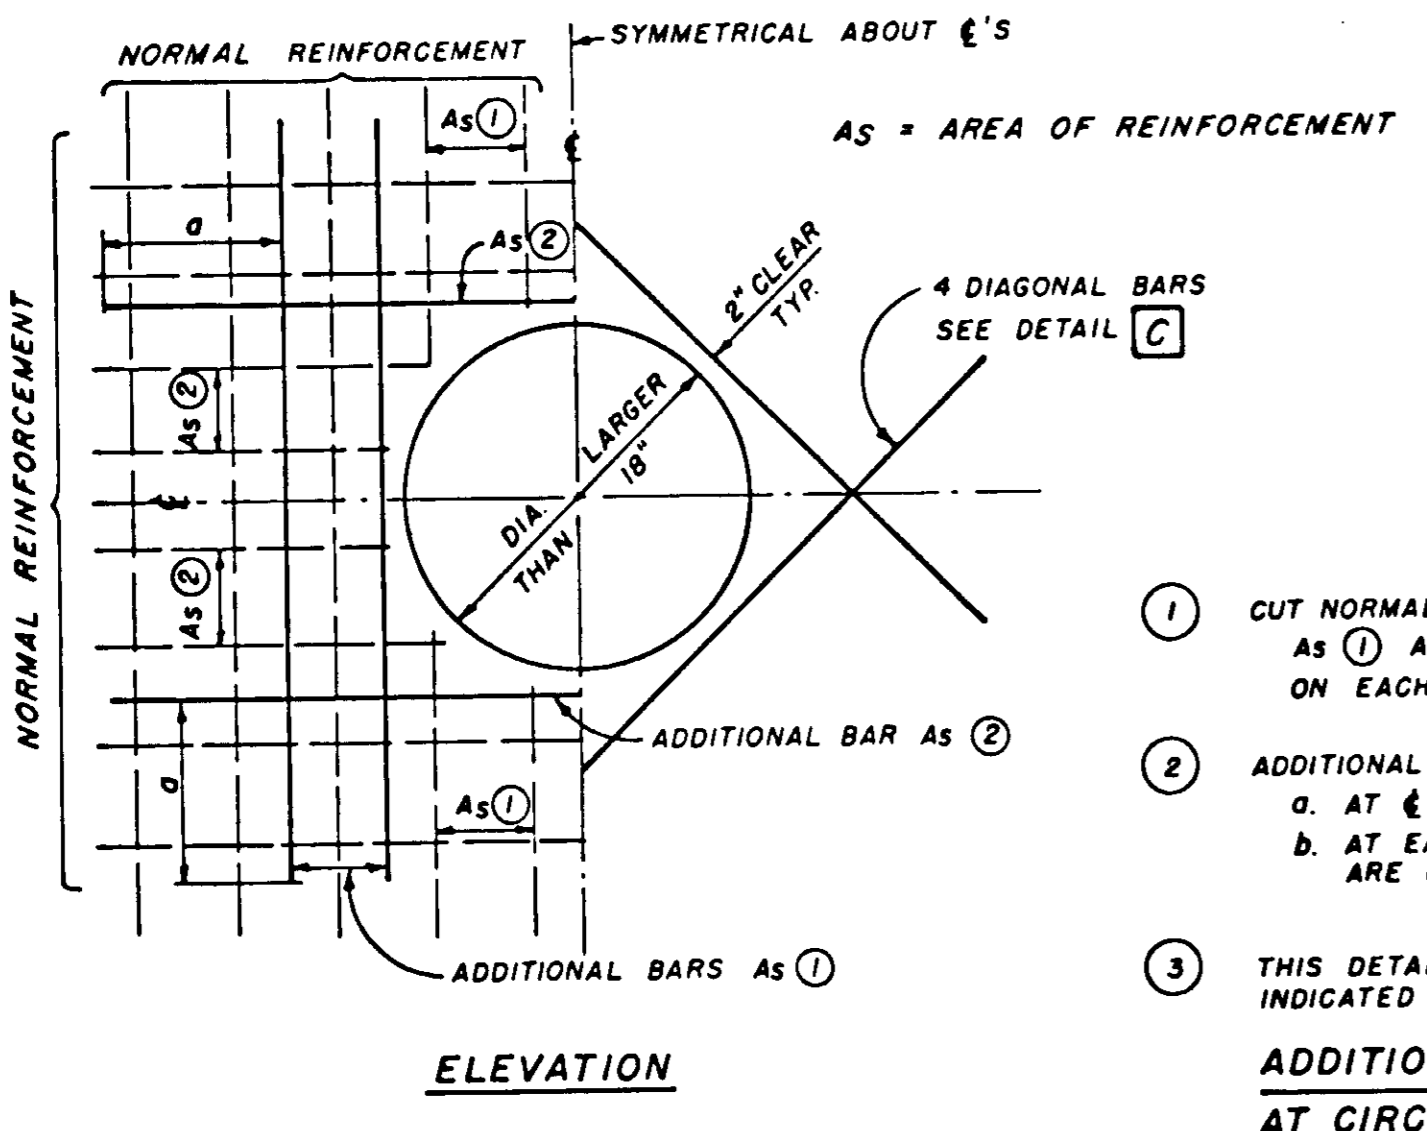

BAR SIZE	"a"	
	GRADE 40	GRADE 60
# 4	15"	15"
# 5	18"	21"
# 6	18"	24"
# 7	21"	27"
# 8	24"	36"
# 9	30"	42"
# 10	36"	48"

- CUT NORMAL REINFORCEMENT AT OPENING:
As ① AND As ② = 1/2 AREA OF CUT BARS TO BE ADDED ON EACH SIDE OF OPENING.
- ADDITIONAL BARS As ① AND As ② TO BE PLACED:
a. AT $\frac{1}{2}$ OF WALLS WHERE ONE LAYER OF REINF. IS PROVIDED.
b. AT EACH FACE OF WALLS WHERE TWO LAYERS OF REINF. ARE PROVIDED.
- THIS DETAIL TO BE USED ONLY WHEN NO OTHER DETAIL IS INDICATED ON THE DRAWINGS.


ADDITIONAL REINFORCEMENT AT CIRCULAR WALL OPENINGS **D**

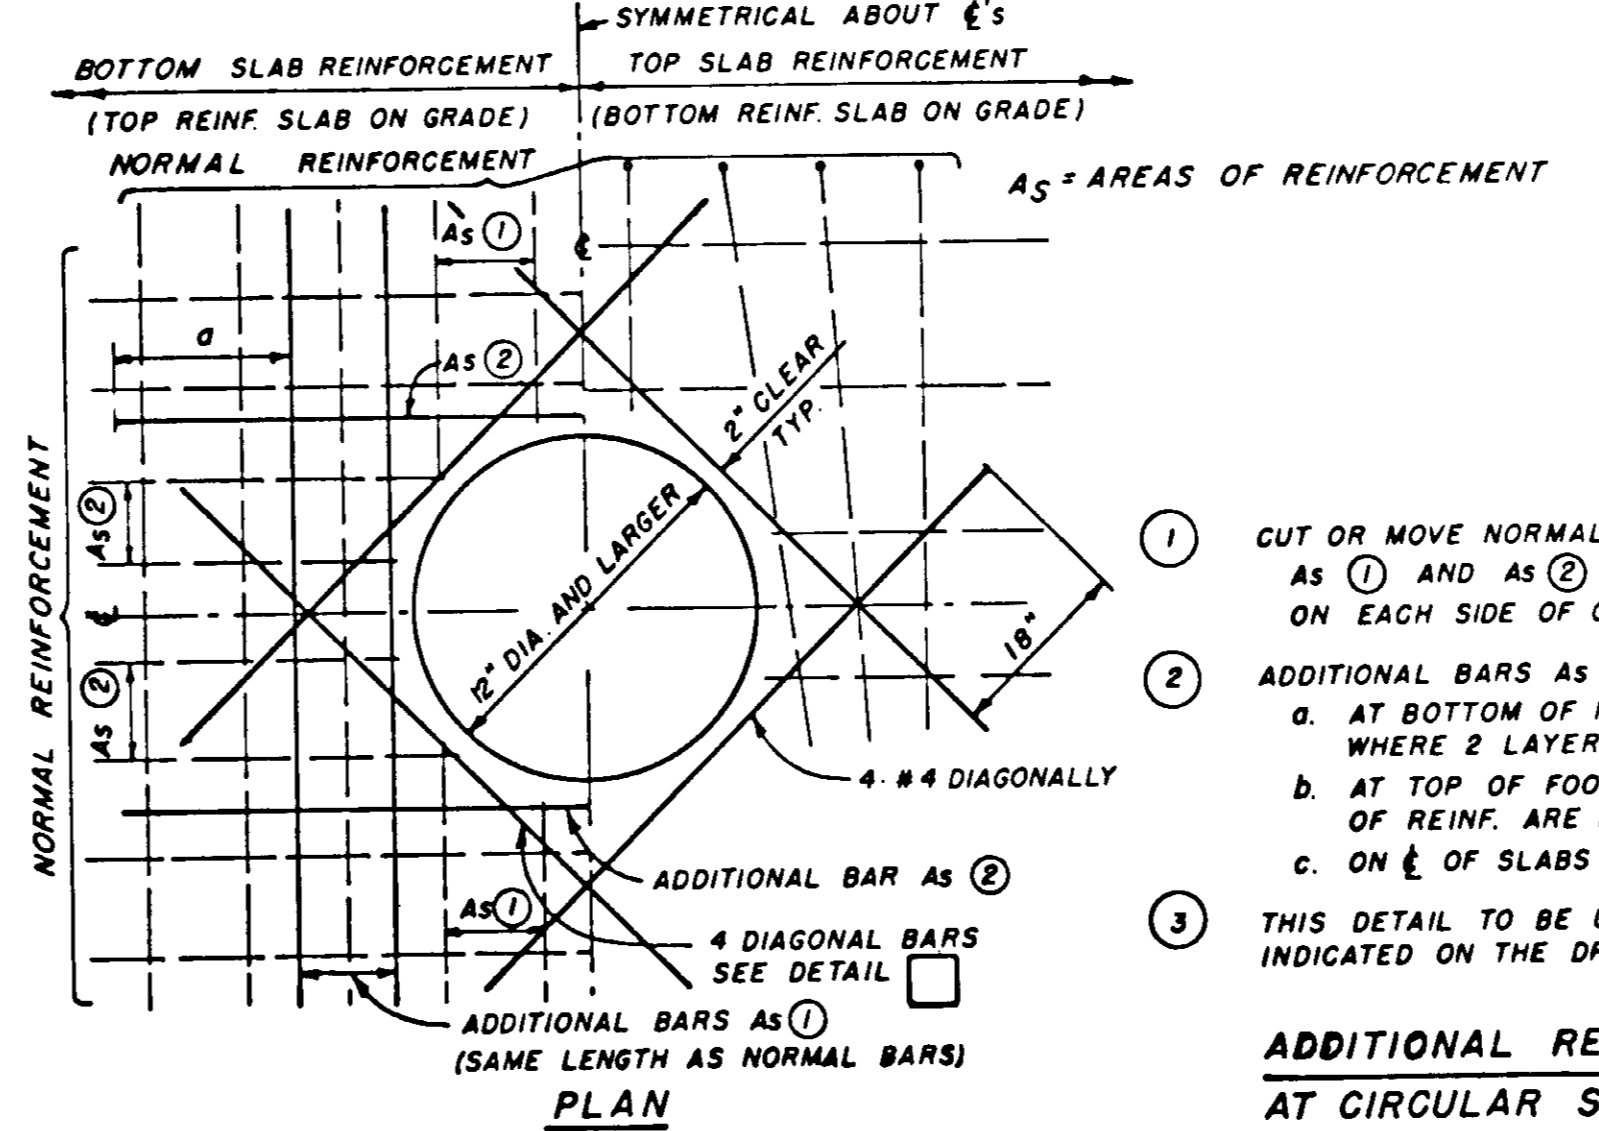


BAR SIZE	"a"	
	GRADE 40	GRADE 60
# 4	15"	15"
# 5	18"	21"
# 6	18"	24"
# 7	21"	27"
# 8	24"	36"
# 9	30"	42"
# 10	36"	48"

- CUT OR MOVE NORMAL REINFORCEMENT AT OPENING:
As ① AND As ② = 1/2 AREA OF CUT BARS TO BE ADDED ON EACH SIDE OF OPENING.
- ADDITIONAL BARS As ① AND As ② TO BE PLACED:
a. AT BOTTOM OF ROOF AND FLOOR SLABS NOT ON GRADE, WHERE 2 LAYERS OF REINF. ARE PROVIDED.
b. AT TOP OF FOOTING SLABS ON GRADE, WHERE 2 LAYERS OF REINF. ARE PROVIDED.
c. ON $\frac{1}{2}$ OF SLABS WHERE ONE LAYER OF REINF. IS PROVIDED.
- THIS DETAIL TO BE USED ONLY WHEN NO OTHER DETAIL IS INDICATED ON THE DRAWINGS.

ADDITIONAL REINFORCEMENT AT CIRCULAR SLAB OPENINGS **E**

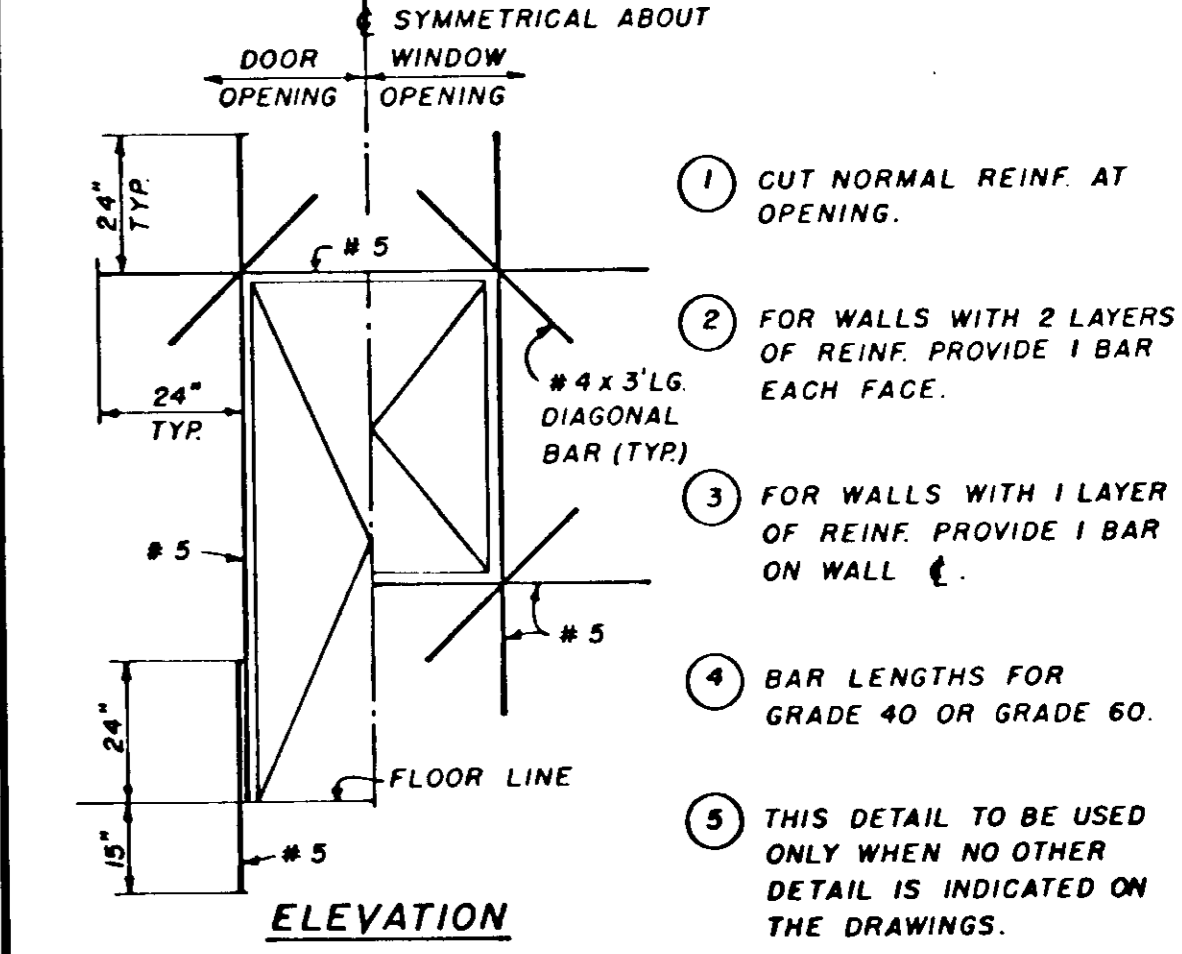


TYPICAL REINFORCEMENT AROUND RECTANGULAR WALL OPENINGS **F**

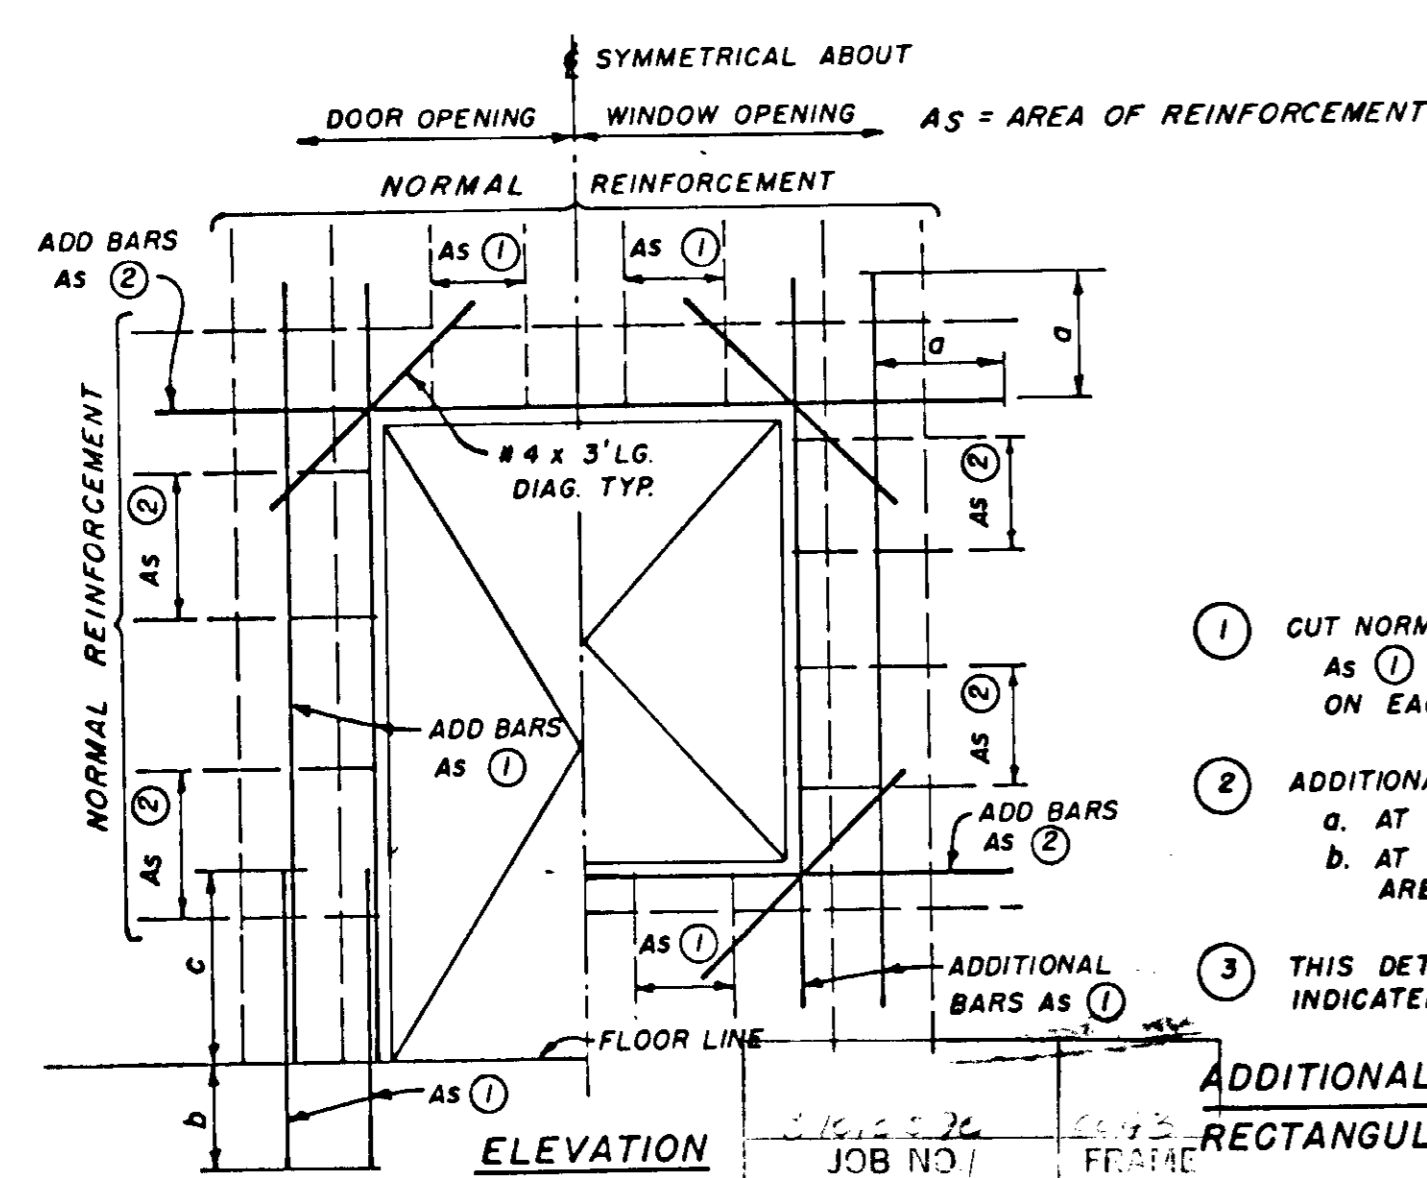

BAR SIZE	GRADE 40		GRADE 60	
	a	b	c	d
# 4	15"	16"	12"	20"
# 5	16"	20"	15"	26"
# 6	17"	22"	18"	31"
# 7	23"	31"	30"	39"
# 8	30"	39"	30"	51"
# 9	38"	49"	38"	65"
# 10	48"	63"	48"	82"

- CUT NORMAL REINFORCEMENT AT OPENING:
As ① AND As ② = 1/2 AREA OF CUT BARS TO BE ADDED ON EACH SIDE OF OPENING.
- ADDITIONAL BARS As ① AND As ② TO BE PLACED:
a. AT $\frac{1}{2}$ OF WALLS WHERE ONE LAYER OF REINF. IS PROVIDED.
b. AT EACH FACE OF WALLS WHERE TWO LAYERS OF REINF. ARE PROVIDED.
- THIS DETAIL TO BE USED ONLY WHEN NO OTHER DETAIL IS INDICATED ON THE DRAWINGS.

ADDITIONAL REINFORCEMENT AROUND RECTANGULAR WALL OPENINGS **G**

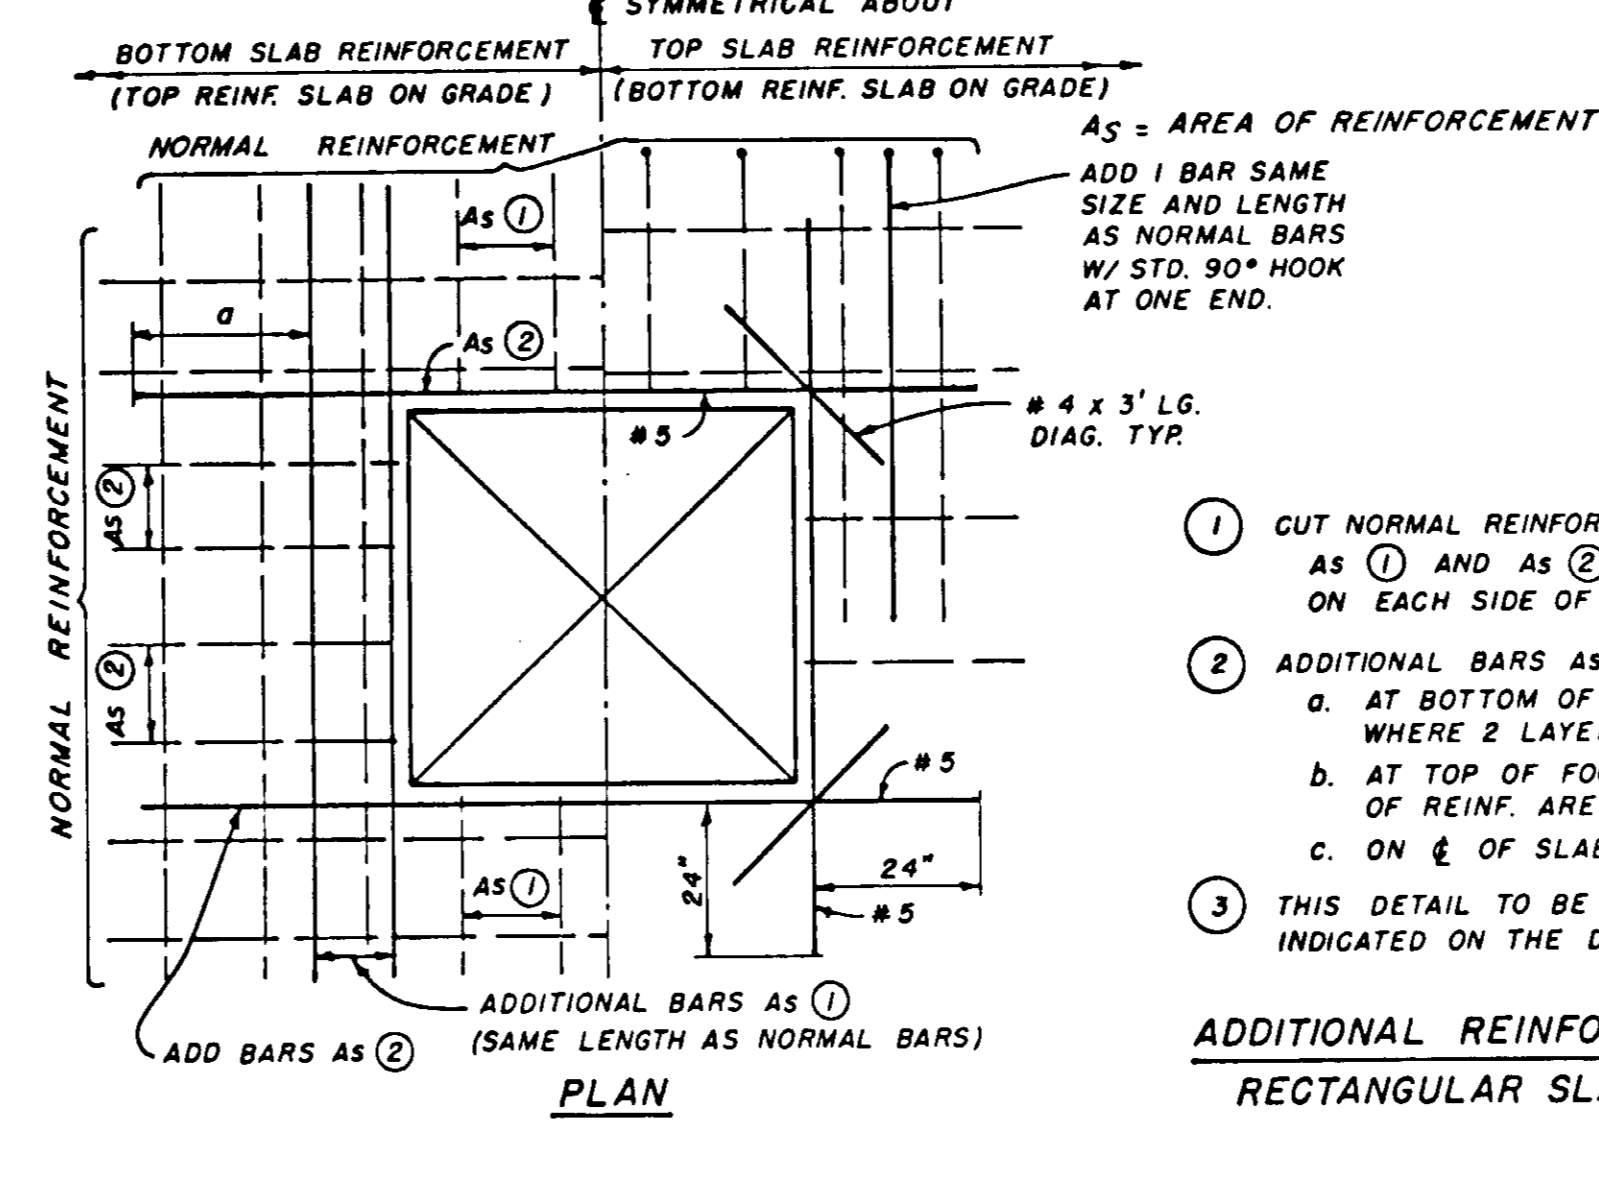

BAR SIZE	"a"	
	GRADE 40	GRADE 60
# 4	16"	16"
# 5	16"	20"
# 6	17"	24"
# 7	23"	30"
# 8	30"	39"
# 9	38"	49"
# 10	48"	63"

- CUT NORMAL REINFORCEMENT AT OPENING:
As ① AND As ② = 1/2 AREA OF CUT BARS TO BE ADDED ON EACH SIDE OF OPENING.
- ADDITIONAL BARS As ① AND As ② TO BE PLACED:
a. AT BOTTOM OF ROOF AND FLOOR SLABS NOT ON GRADE, WHERE 2 LAYERS OF REINF. ARE PROVIDED.
b. AT TOP OF FOOTING SLABS ON GRADE, WHERE 2 LAYERS OF REINF. ARE PROVIDED.
c. ON $\frac{1}{2}$ OF SLAB WHERE ONE LAYER OF REINF. IS PROVIDED.
- THIS DETAIL TO BE USED ONLY WHEN NO OTHER DETAIL IS INDICATED ON THE DRAWINGS.

ADDITIONAL REINFORCEMENT AROUND RECTANGULAR SLAB OPENINGS **H**

THE DETAILS ILLUSTRATED ON THIS SHEET ARE PART OF JAMES M. MONTGOMERY STANDARD DETAILS.
THESE DETAILS ARE TO BE USED WHEN REFERRED TO OR WHEN NO OTHER MORE RESTRICTIVE OR DIFFERENT DETAILS ARE SHOWN ON THE DRAWINGS.

DETAILS NOT PERTAINING TO THE PROJECT ARE MARKED THUS N.I.C. (NOT IN CONTRACT)


03581

RECORD DRAWING

DESIGNED	P. REYMOND	SUBMITTED	27304	8/19/81
DRAWN	C. FITZPATRICK	PROJECT ENGINEER	R.C.E. NO.	DATE
CHECKED	P. REYMOND	RECOMMENDED	27638	8/20/81
		JAMES M. MONTGOMERY CONSULTING ENGINEERS, INC.	R.C.E. NO.	DATE


JAMES M. MONTGOMERY CONSULTING ENGINEERS, INC.
555 EAST WALNUT STREET, PASADENA, CALIFORNIA 91101

DISTRICT APPROVAL ON TITLE PAGE	LAS VIRGENES MWD/TRIUNFO CSD	SHEET
	TAPIA WRF - FILTRATION/DISINFECTION ADDITION	S-2
PHASE II	MISCELLANEOUS REINFORCEMENT DETAILS	OF 66 SHEETS

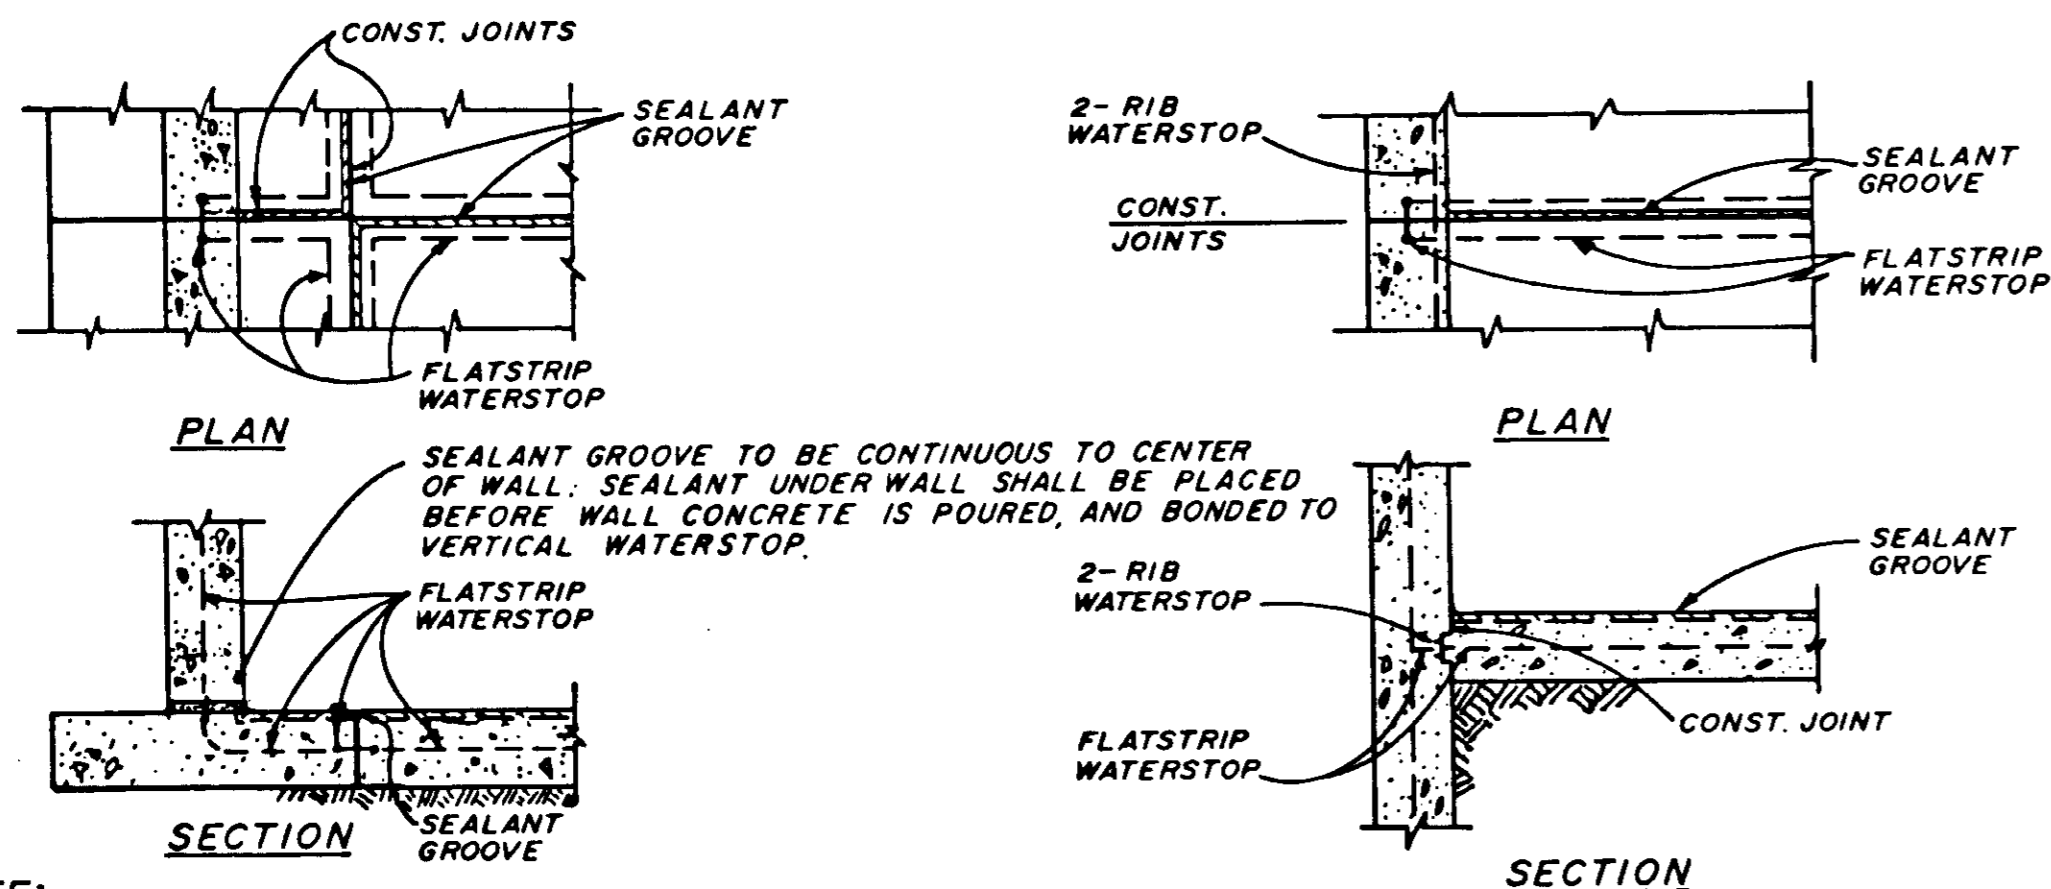


NOTE:
VERTICAL CONSTRUCTION JOINTS PASSING THRU VARIOUS MEMBERS OF A WATER RETAINING STRUCTURE, SHALL BE SEALED WITH WATERSTOPS BONDED TOGETHER, SO AS TO PROVIDE A CONTINUOUS WATERTIGHT JOINT.


WATERSTOP DETAILS FOR FLOOR JOINTS **A**

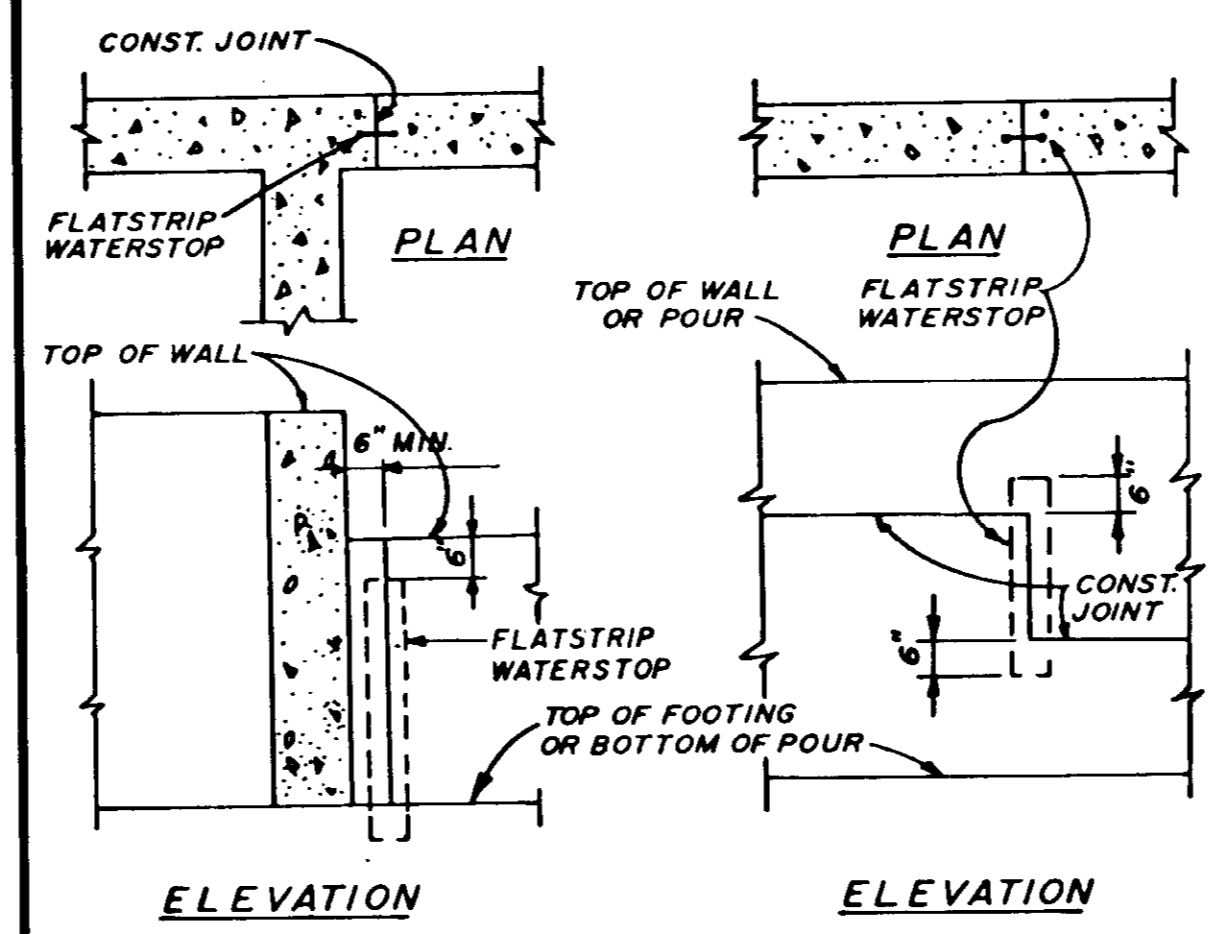


WATERSTOP DETAILS FOR VERTICAL WALL JOINTS **B**

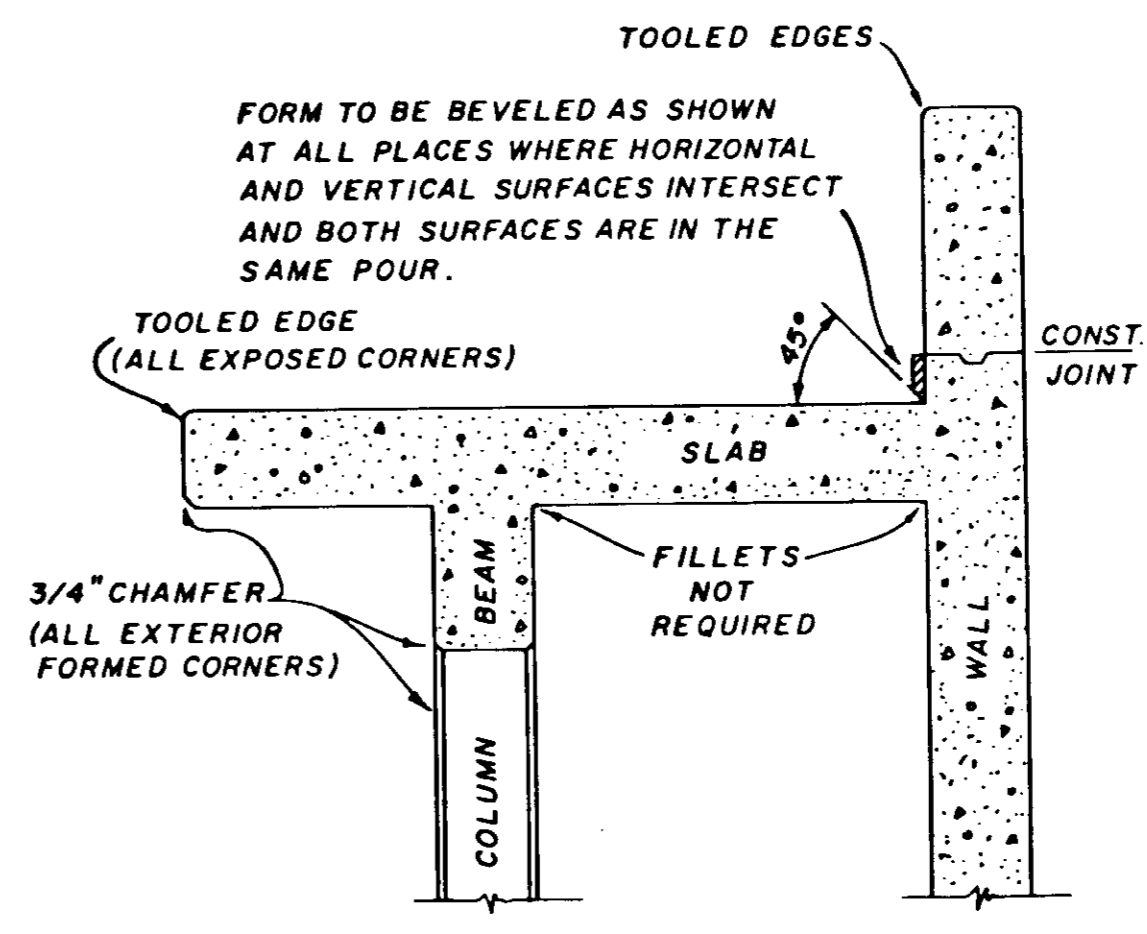


FORMING DETAILS **C**

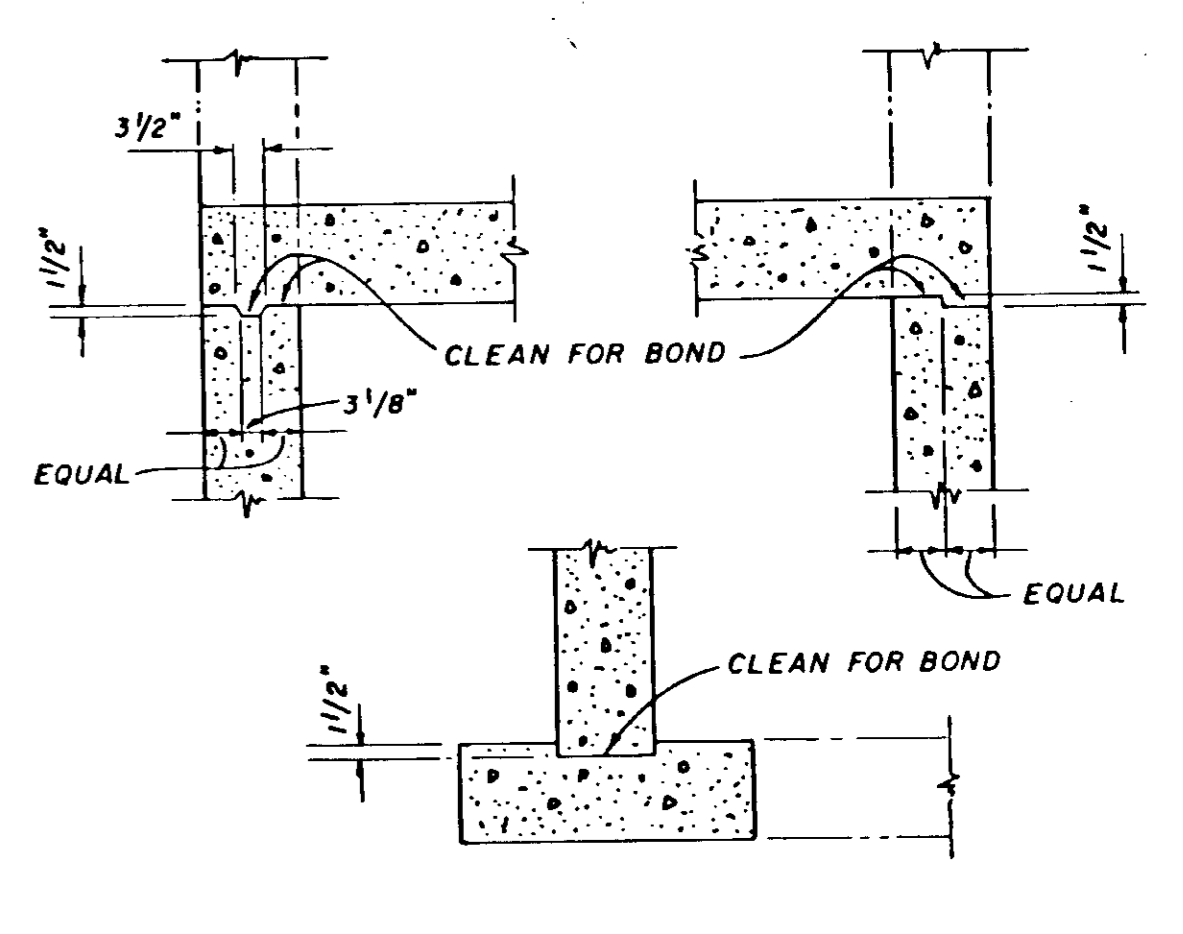


TYPICAL KEYWAYS **D**

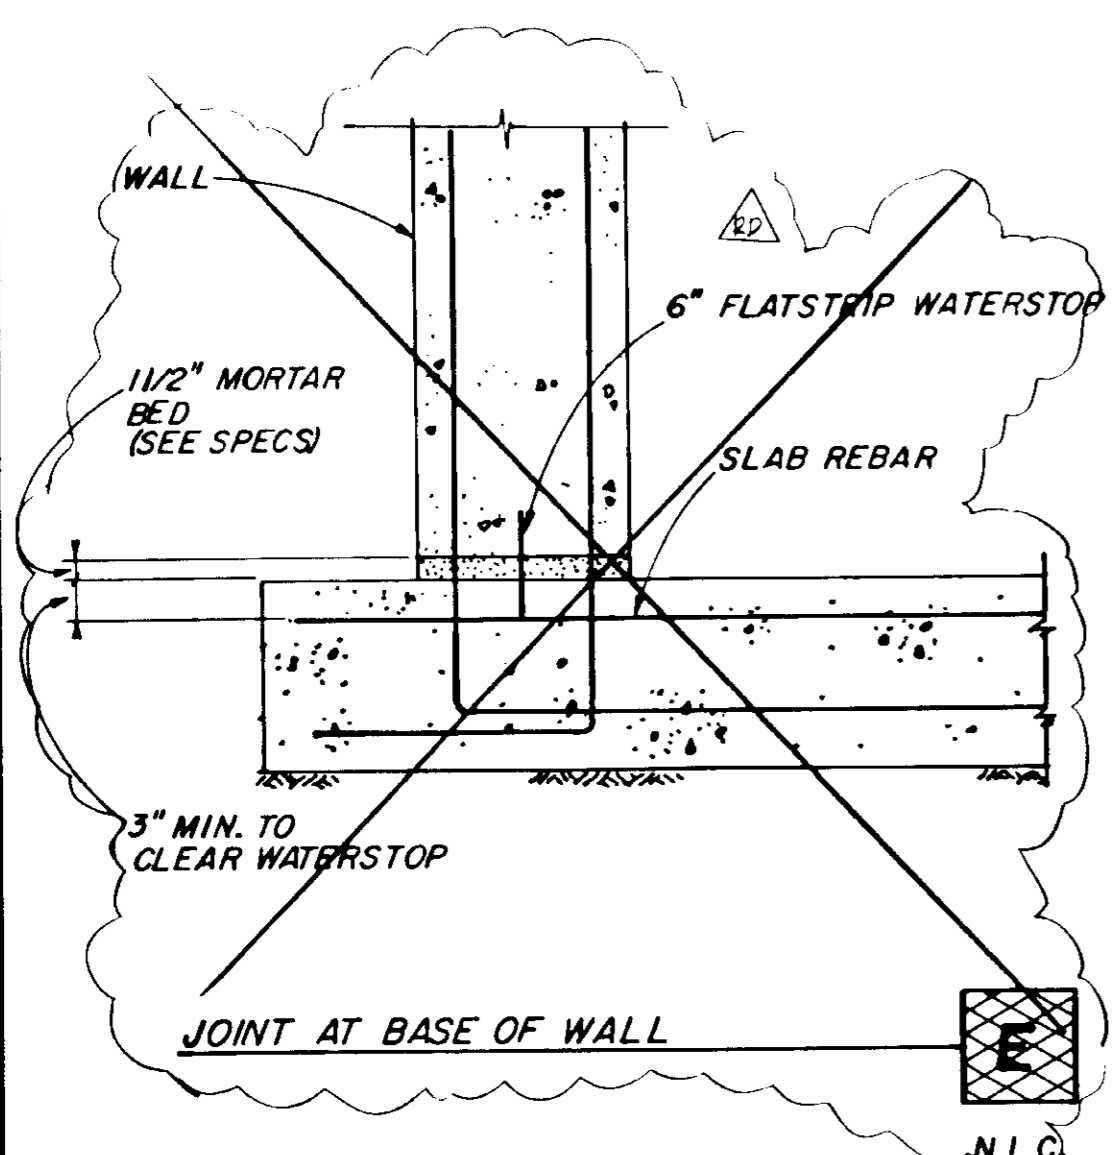


JOINT AT BASE OF WALL **E**

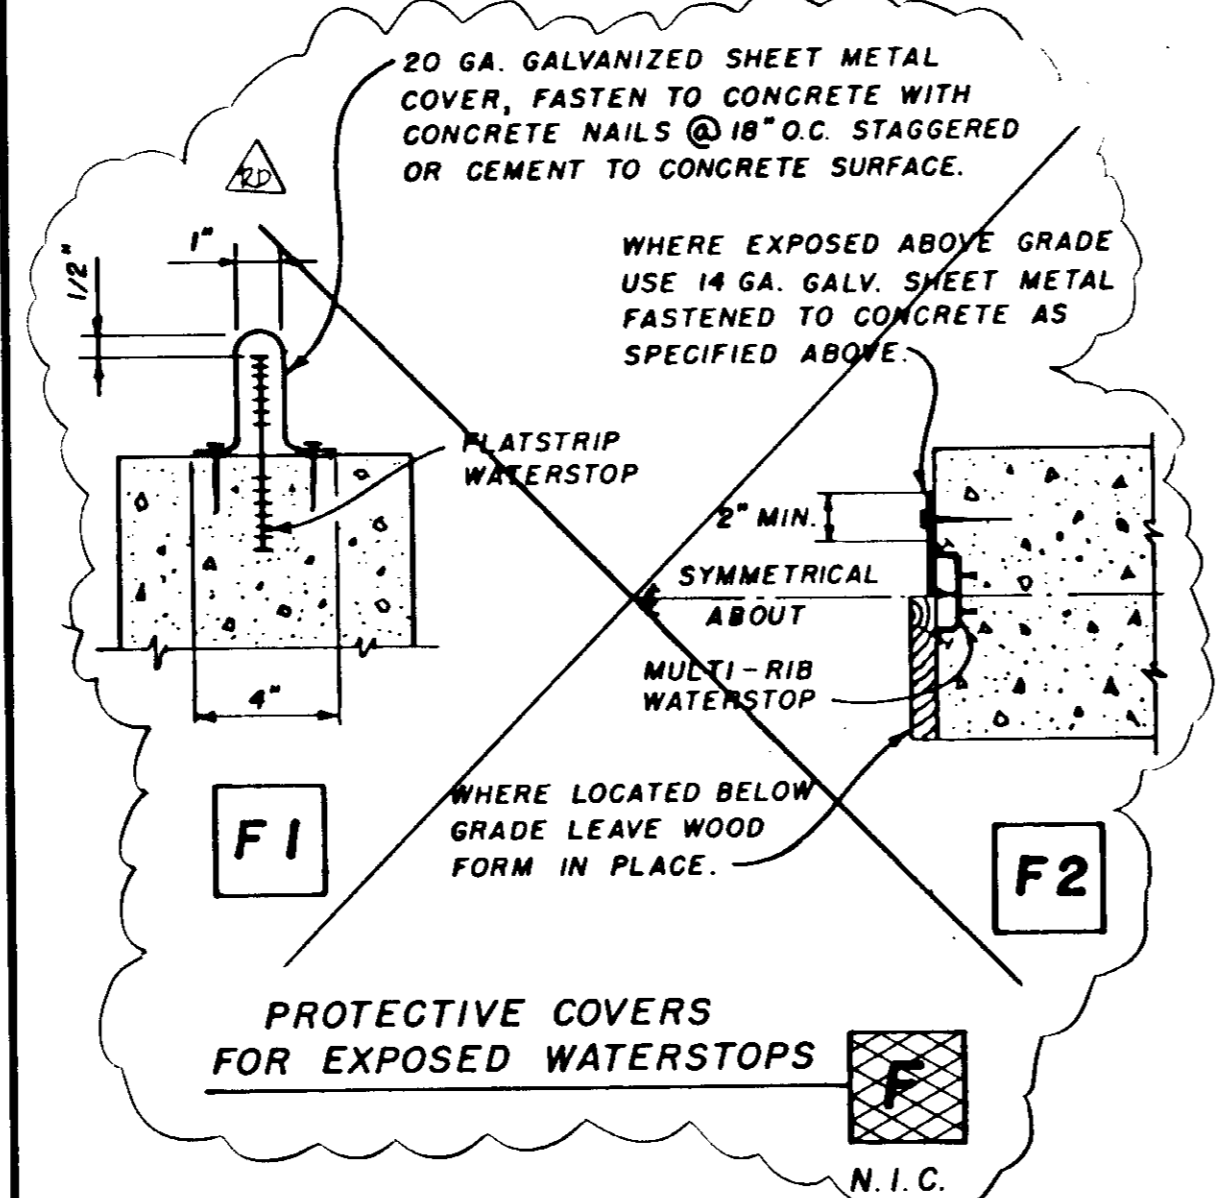


PROTECTIVE COVERS FOR EXPOSED WATERSTOPS **F**

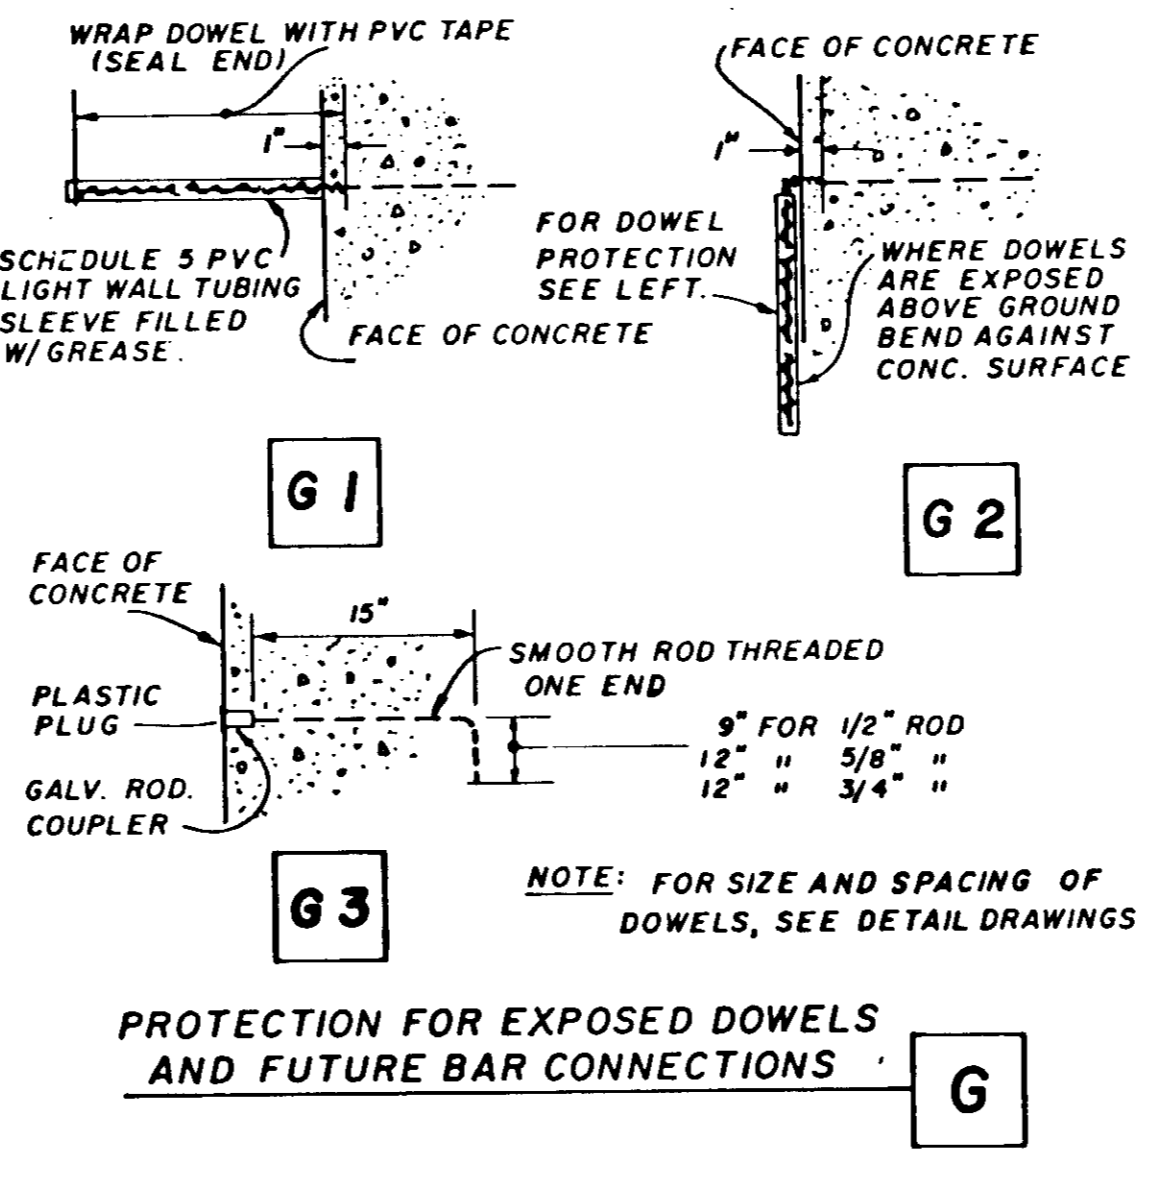


PROTECTION FOR EXPOSED DOWELS AND FUTURE BAR CONNECTIONS **G**

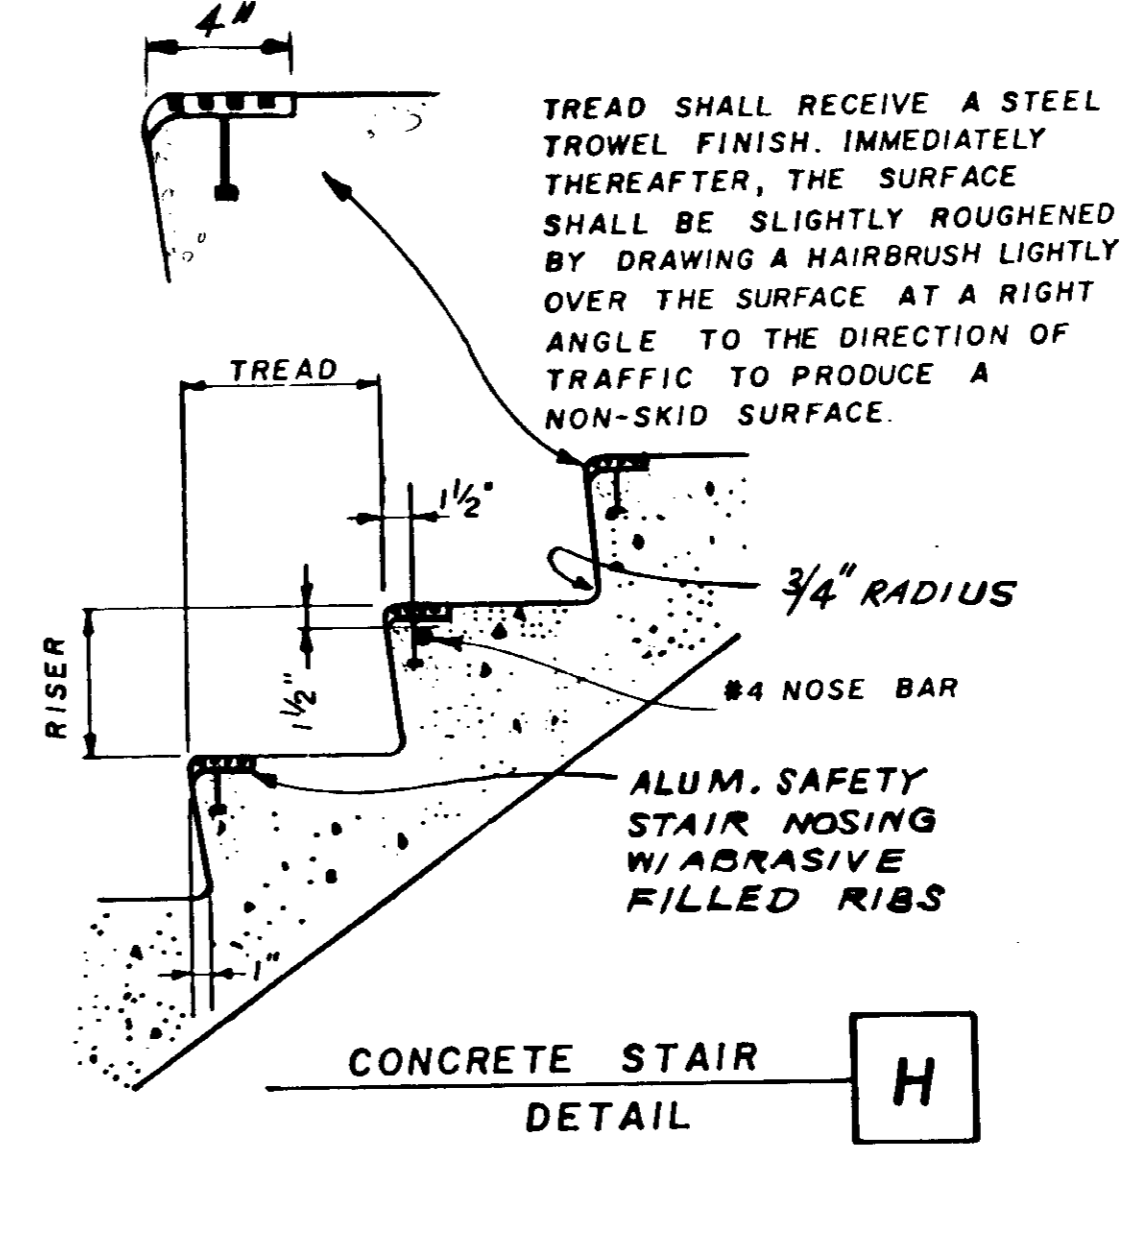


CONCRETE STAIR DETAIL **H**

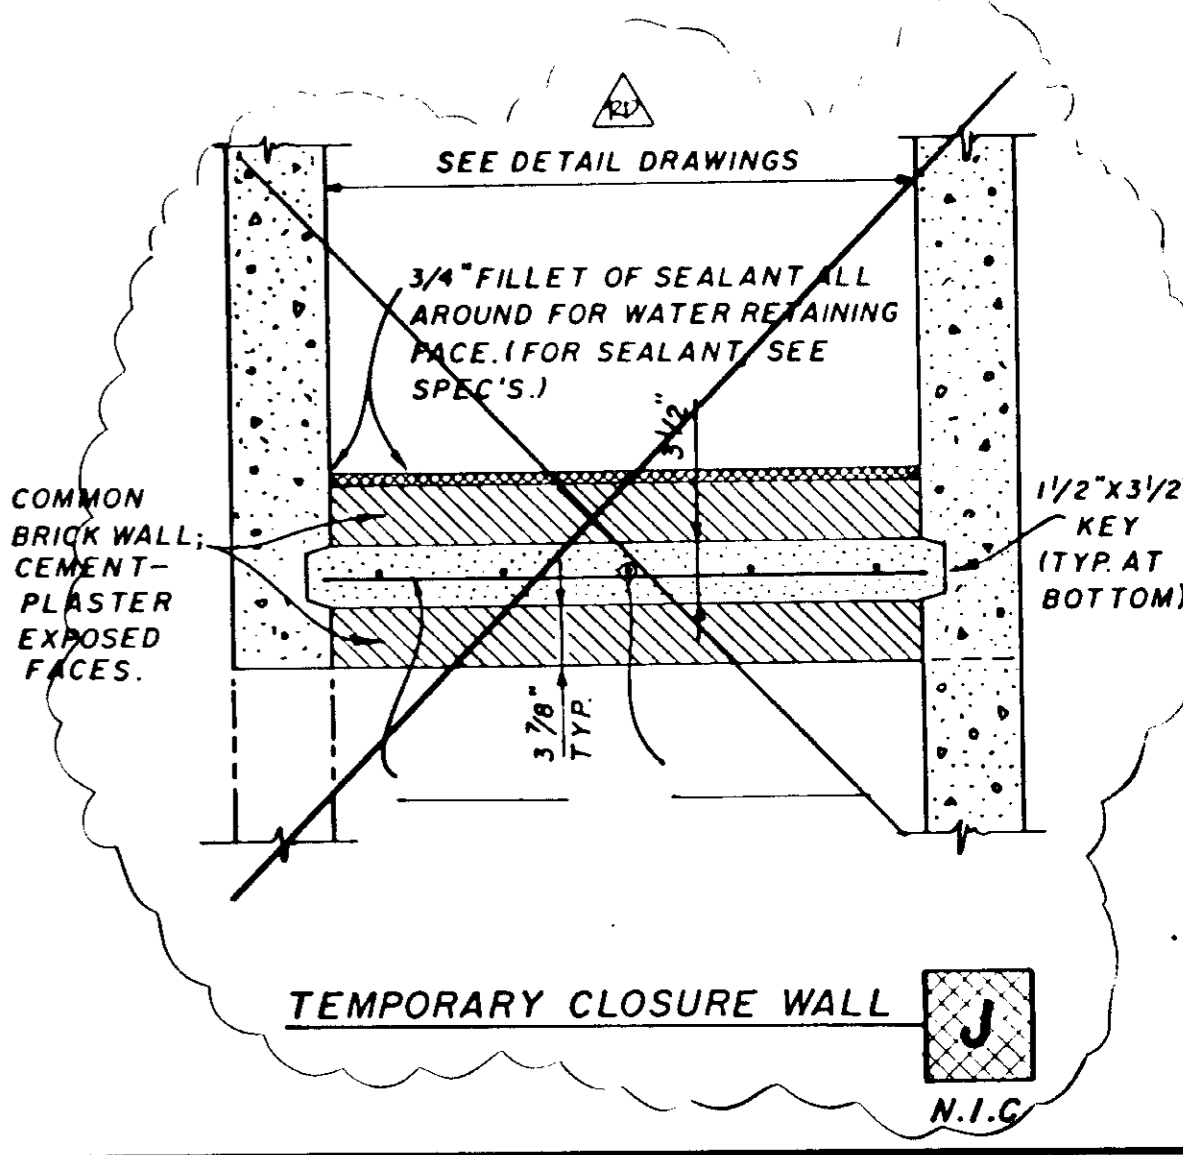


TEMPORARY CLOSURE WALL **J**

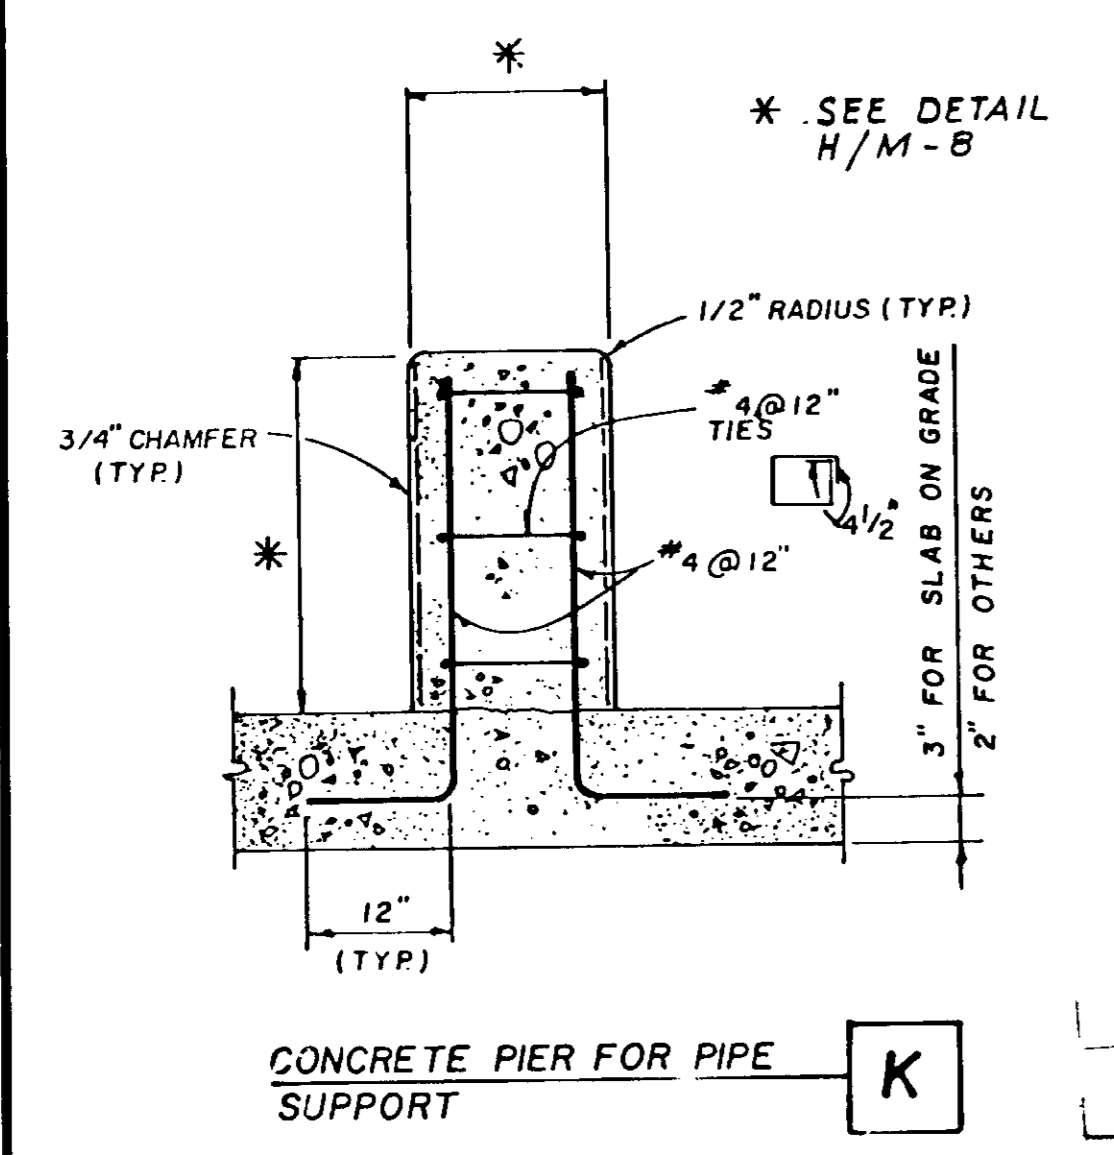


CONCRETE PIER FOR PIPE SUPPORT **K**

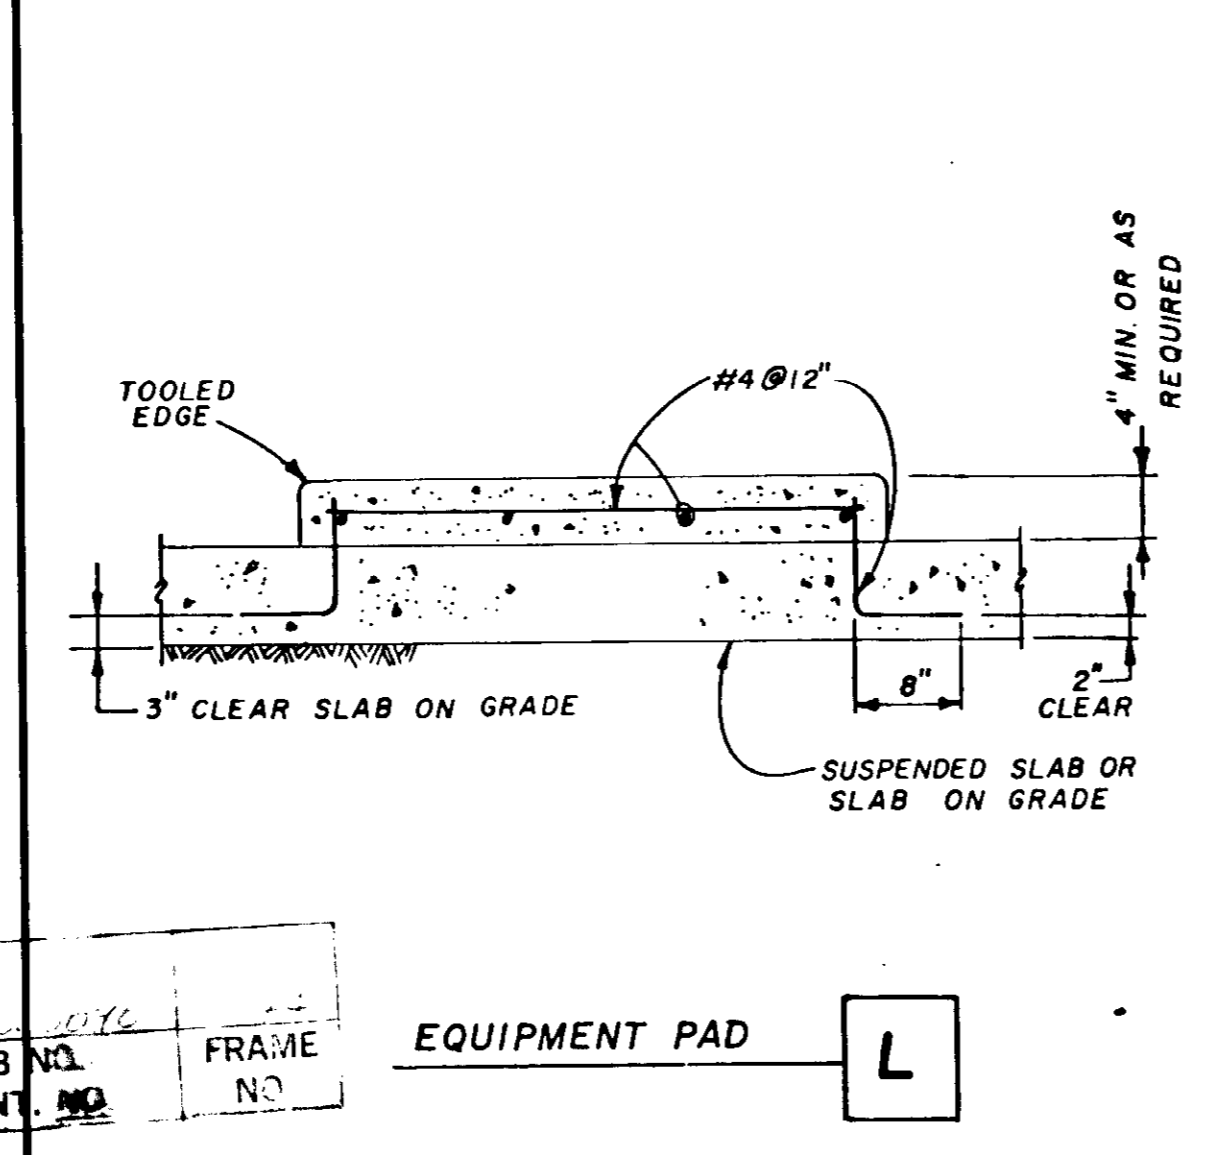

EQUIPMENT PAD **L**

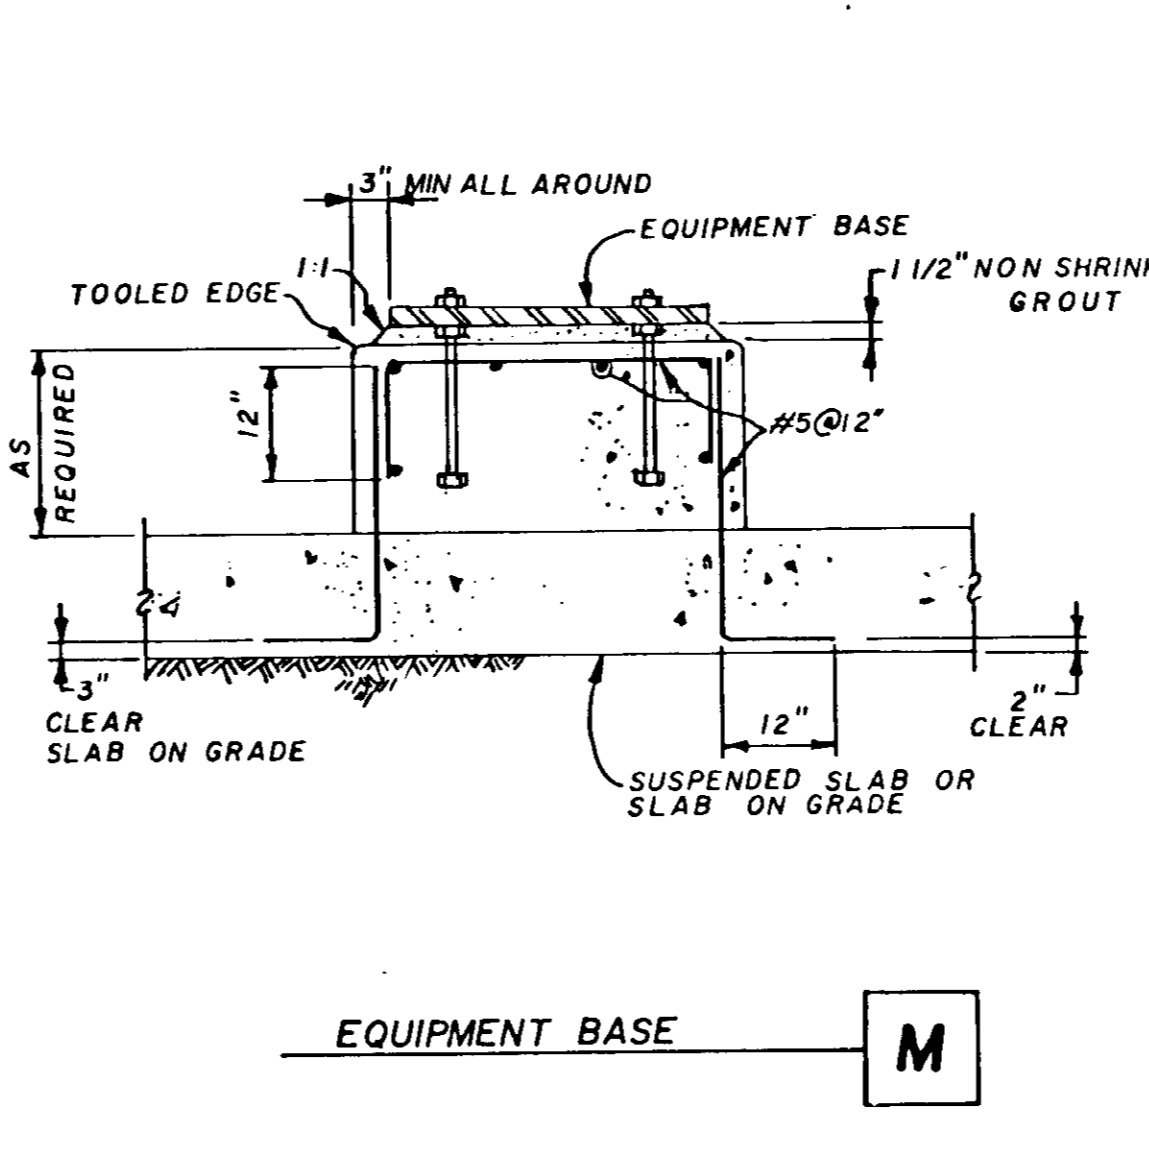

EQUIPMENT BASE **M**

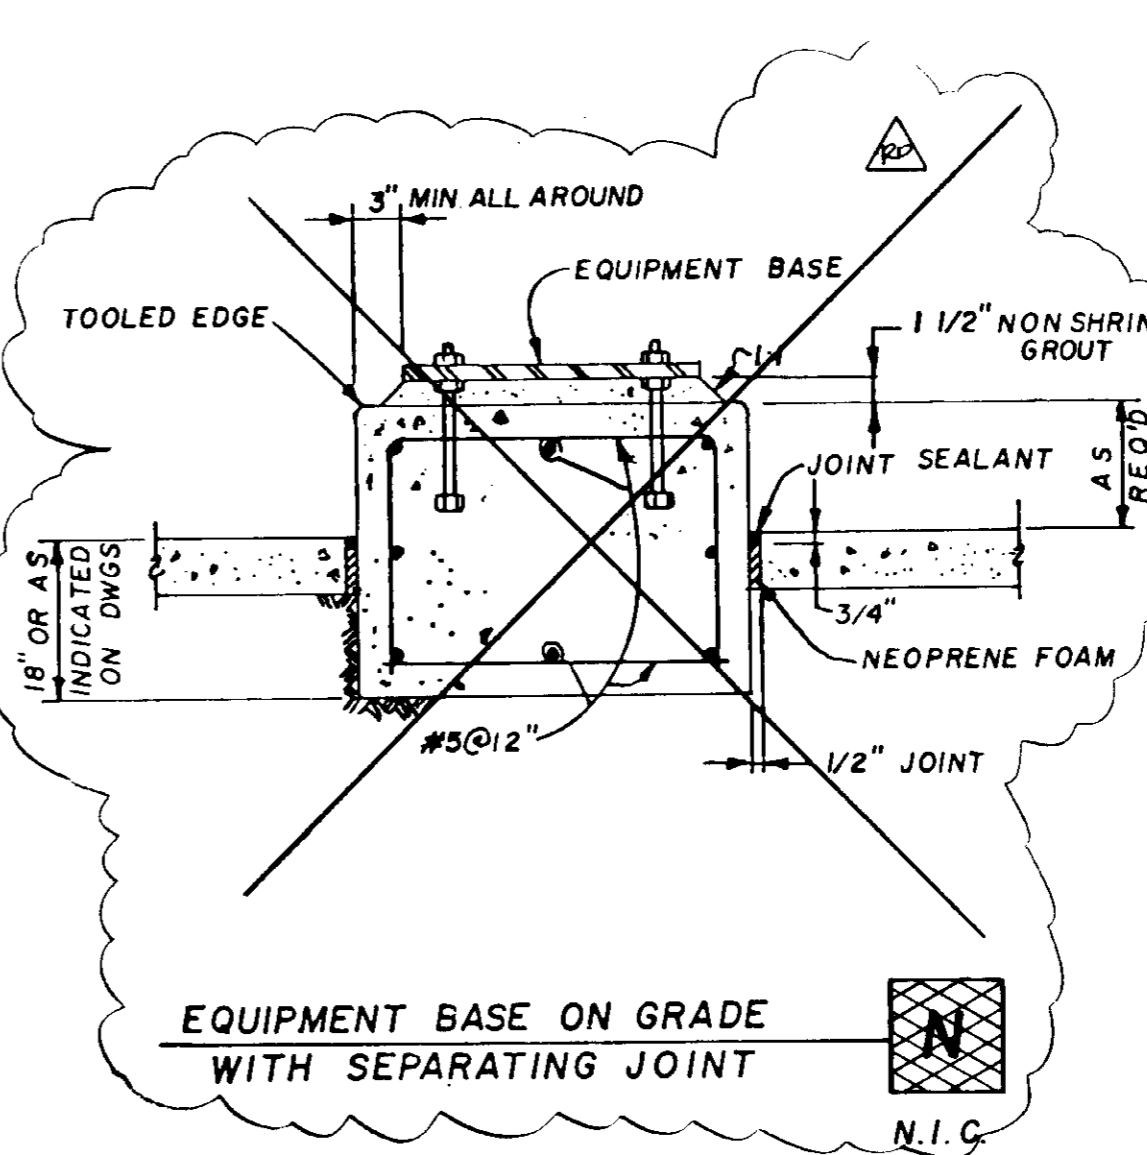

EQUIPMENT BASE ON GRADE WITH SEPARATING JOINT **N**

THE DETAILS ILLUSTRATED ON THIS SHEET ARE PART OF JAMES M. MONTGOMERY STANDARD DETAILS. THESE DETAILS ARE TO BE USED WHEN REFERRED TO OR WHEN NO OTHER MORE RESTRICTIVE OR DIFFERENT DETAILS ARE SHOWN ON THE DRAWINGS. DETAILS NOT PERTAINING TO THE PROJECT ARE MARKED THUS **N.I.C.** (NOT IN CONTRACT)

03582

RECORD DRAWING

RD 4164	MPJ	RECORD DRAWINGS
SCALE:	NO SCALE	
DESIGNED	P. REYMOND	PROJECT ENGINEER
DRAWN	C. FITZPATRICK	RECOMMENDED
CHECKED	P. REYMOND	JAMES M. MONTGOMERY CONSULTING ENGINEERS, INC.
REV	DATE	BY
		DESCRIPTION

SUBMITTED	27304	8/19/91
R.C.E. NO.		DATE
27638	8/20/91	DATE
R.C.E. NO.		


JAMES M. MONTGOMERY CONSULTING ENGINEERS, INC.
355 EAST WALNUT STREET, PASADENA, CALIFORNIA 91101

DISTRICT APPROVAL ON TITLE PAGE


PHASE II	MISCELLANEOUS STRUCTURAL DETAILS	SHEET S-3 OF 66 SHEETS
----------	----------------------------------	------------------------

PROVIDE EXPANSION JOINTS IN ALL RAILINGS FOR ALL EXPANSION JOINTS IN STRUCTURE


ALUMINUM RAILING NOTE:
WHERE ALUMINUM PIPE RAILING IS TO BE INSTALLED, PROVIDE EXPANSION JOINTS FOR 3/4" MIN. EXPANSION PER 100 LINEAR FEET OF RAILING.

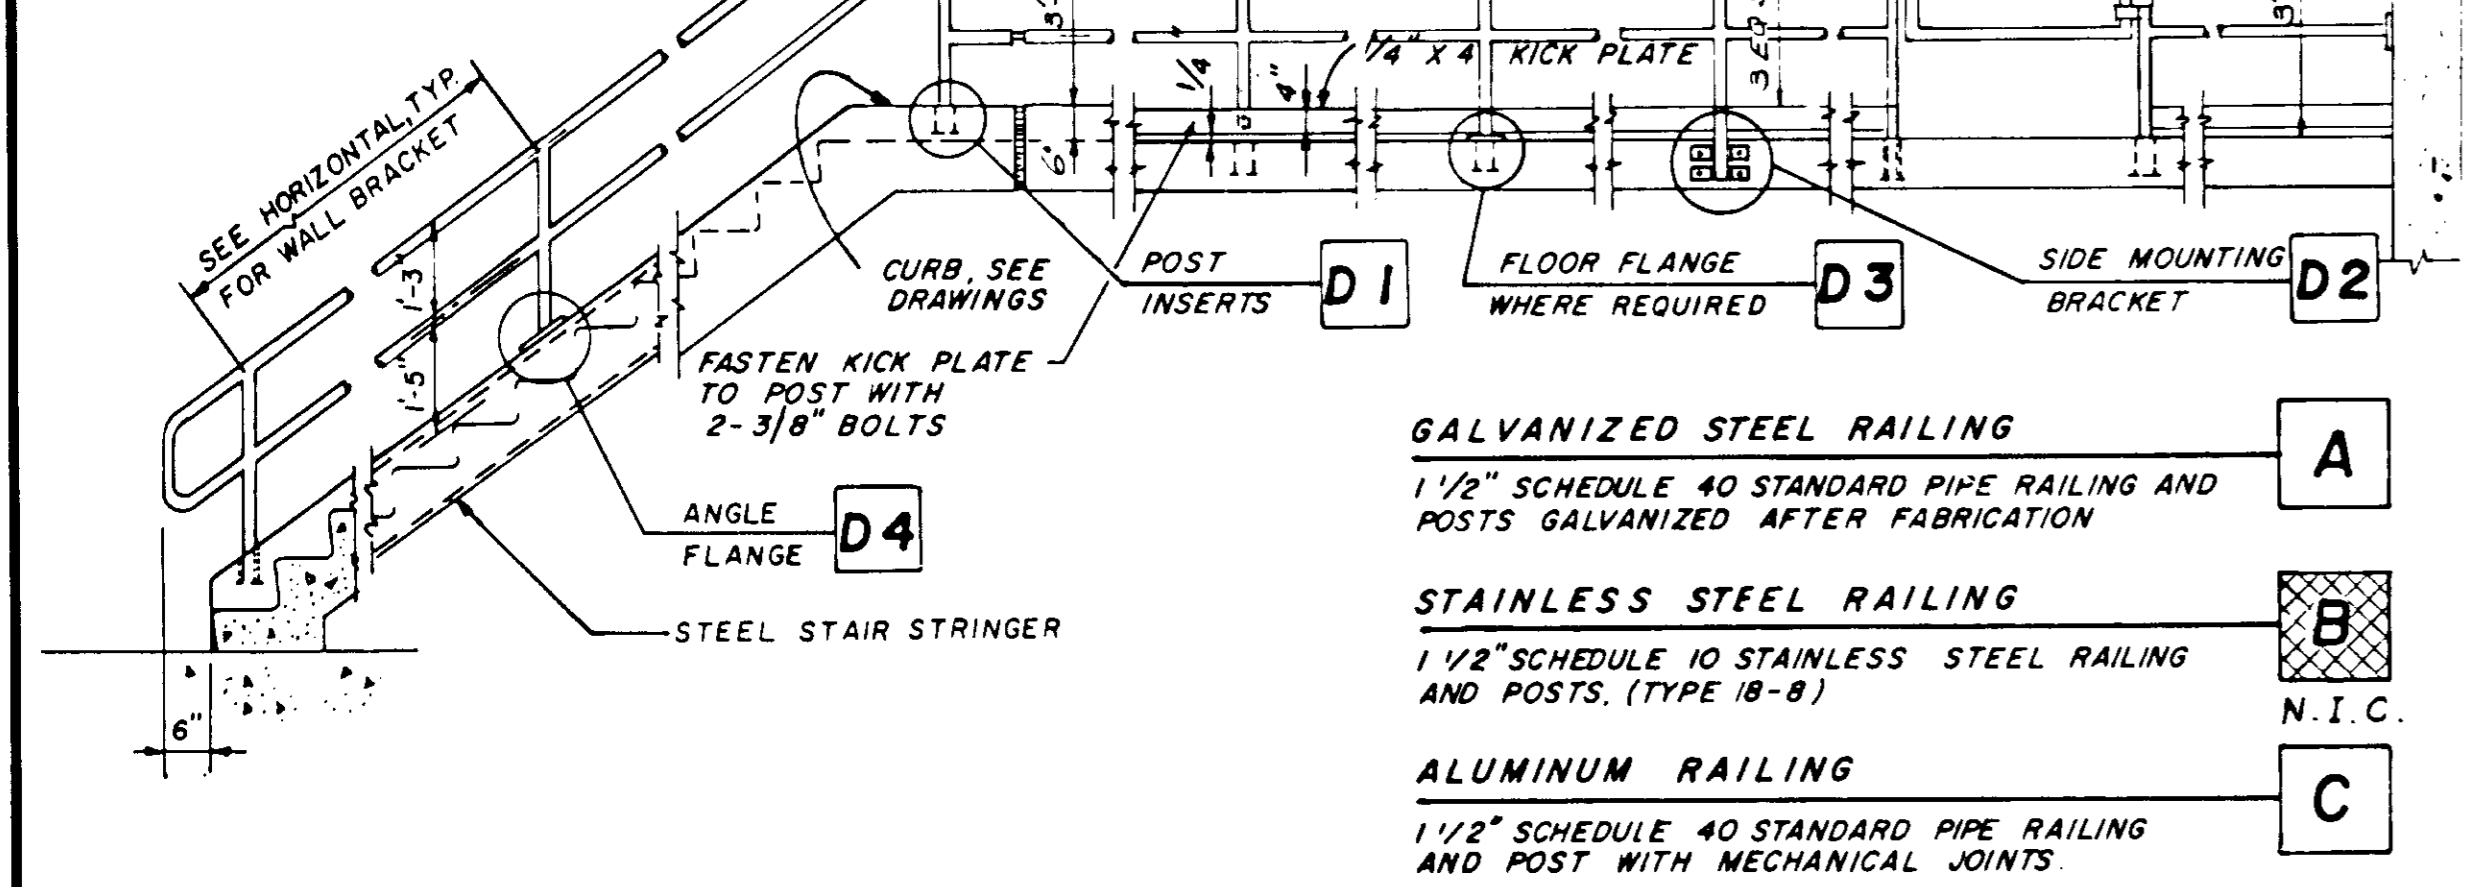


- GALVANIZED STEEL RAILING**
1 1/2" SCHEDULE 40 STANDARD PIPE RAILING AND POSTS GALVANIZED AFTER FABRICATION **A**
- STAINLESS STEEL RAILING**
1 1/2" SCHEDULE 10 STAINLESS STEEL RAILING AND POSTS (TYPE 18-8) **B**
N.I.C.
- ALUMINUM RAILING**
1 1/2" SCHEDULE 40 STANDARD PIPE RAILING AND POST WITH MECHANICAL JOINTS **C**

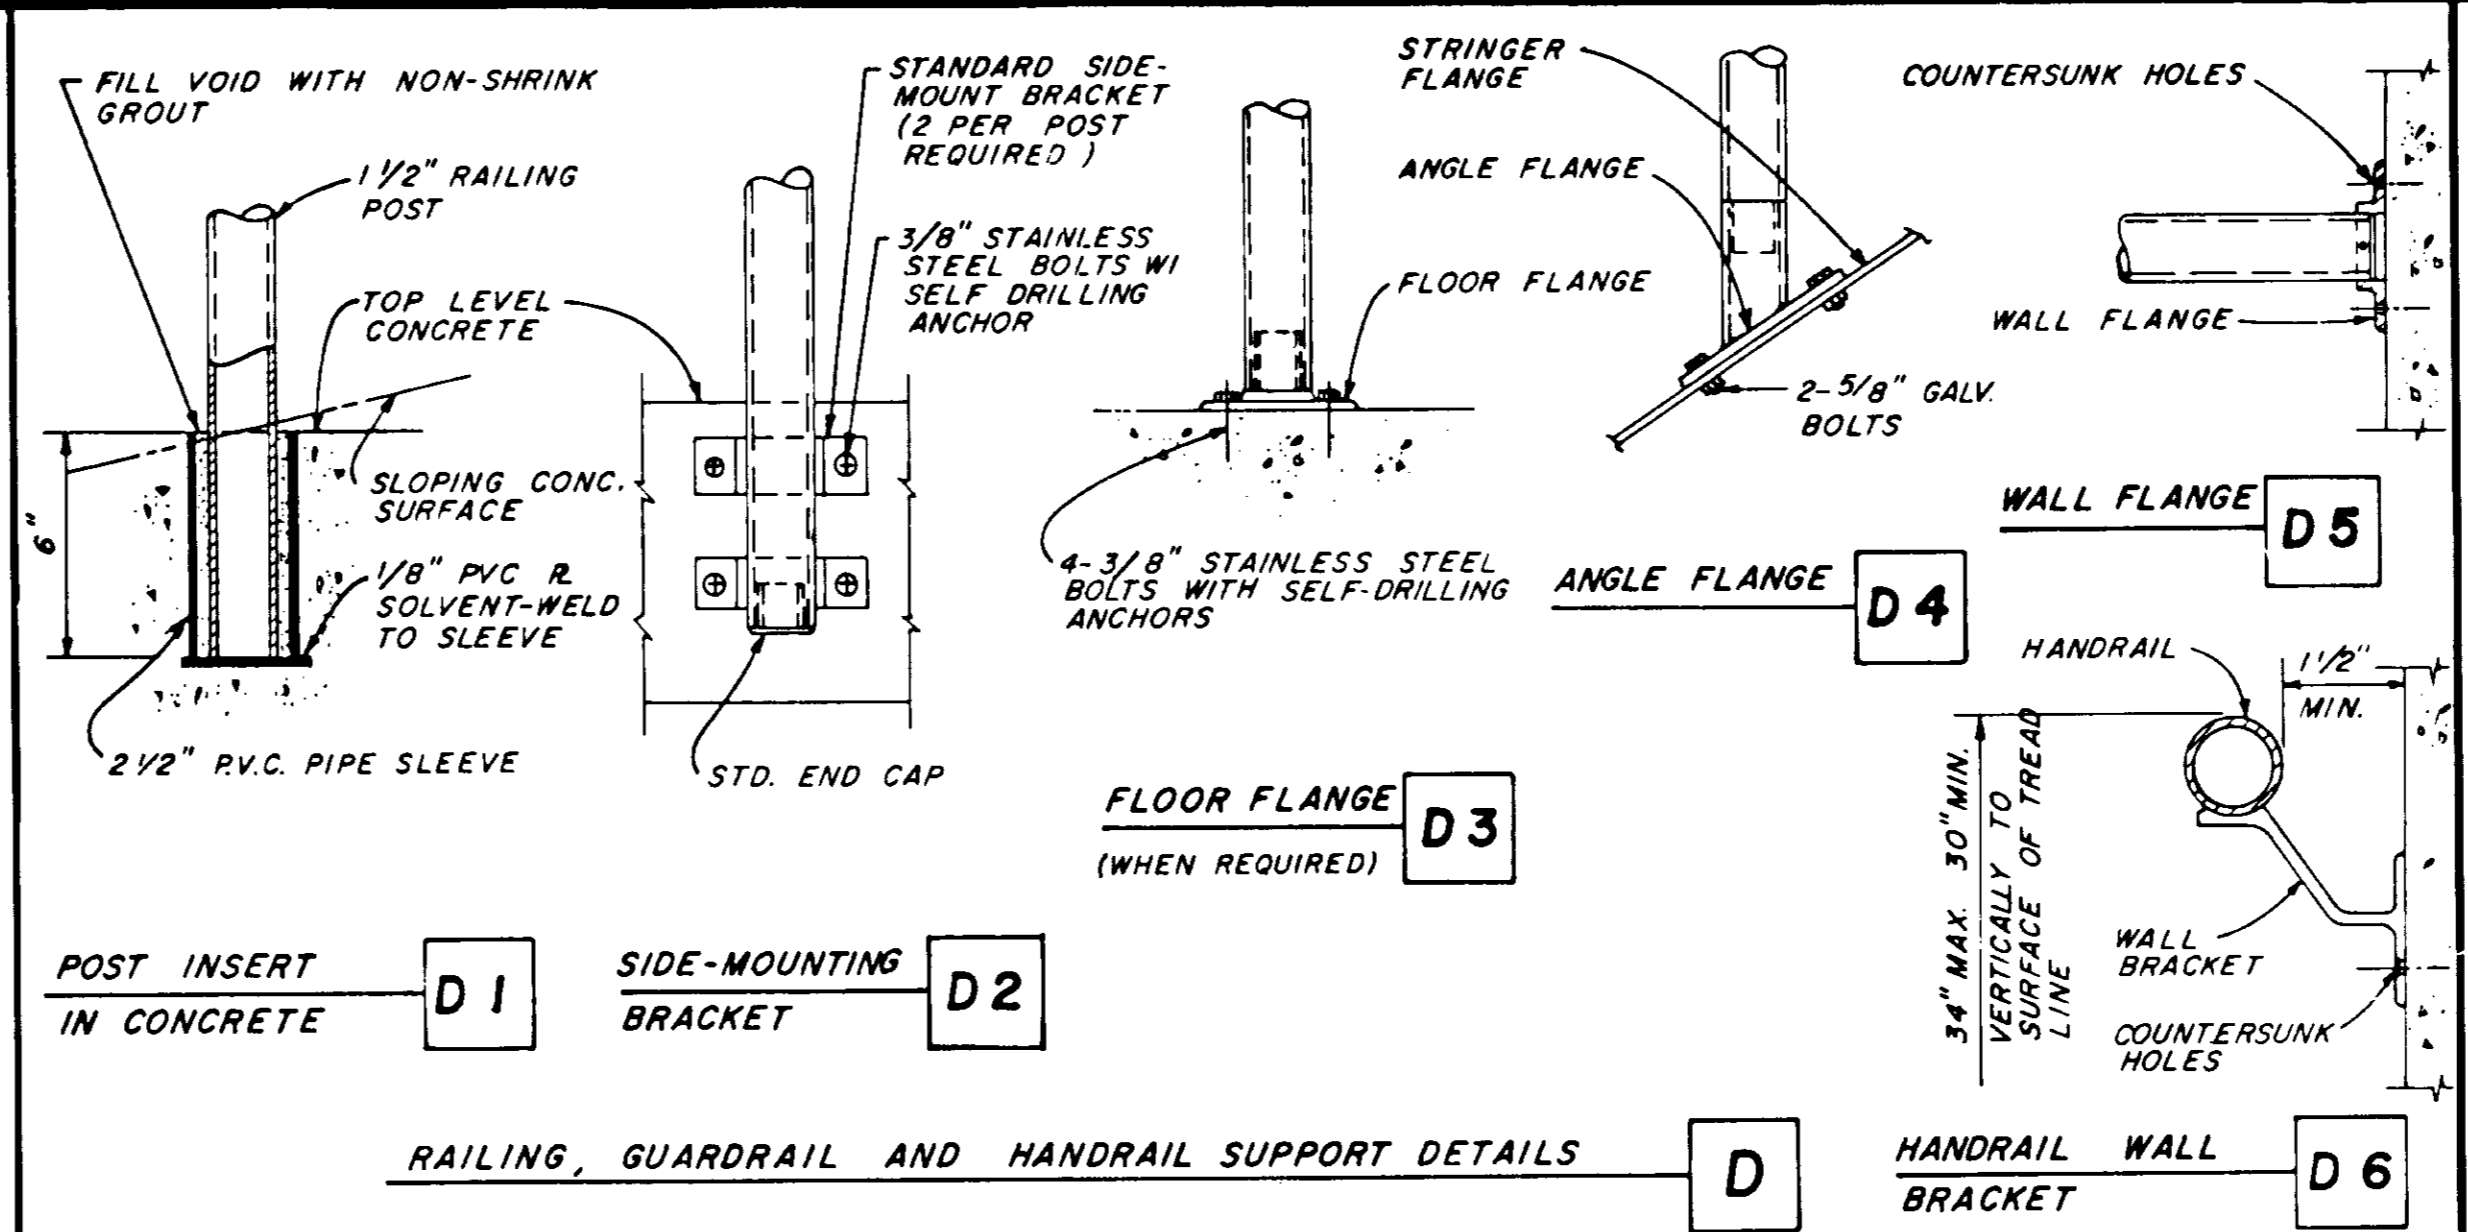


- POST INSERT IN CONCRETE** **D1**
- SIDE-MOUNTING BRACKET** **D2**
- FLOOR FLANGE (WHEN REQUIRED)** **D3**
- RAILING, GUARDRAIL AND HANDRAIL SUPPORT DETAILS** **D**
- HANDRAIL WALL BRACKET** **D6**

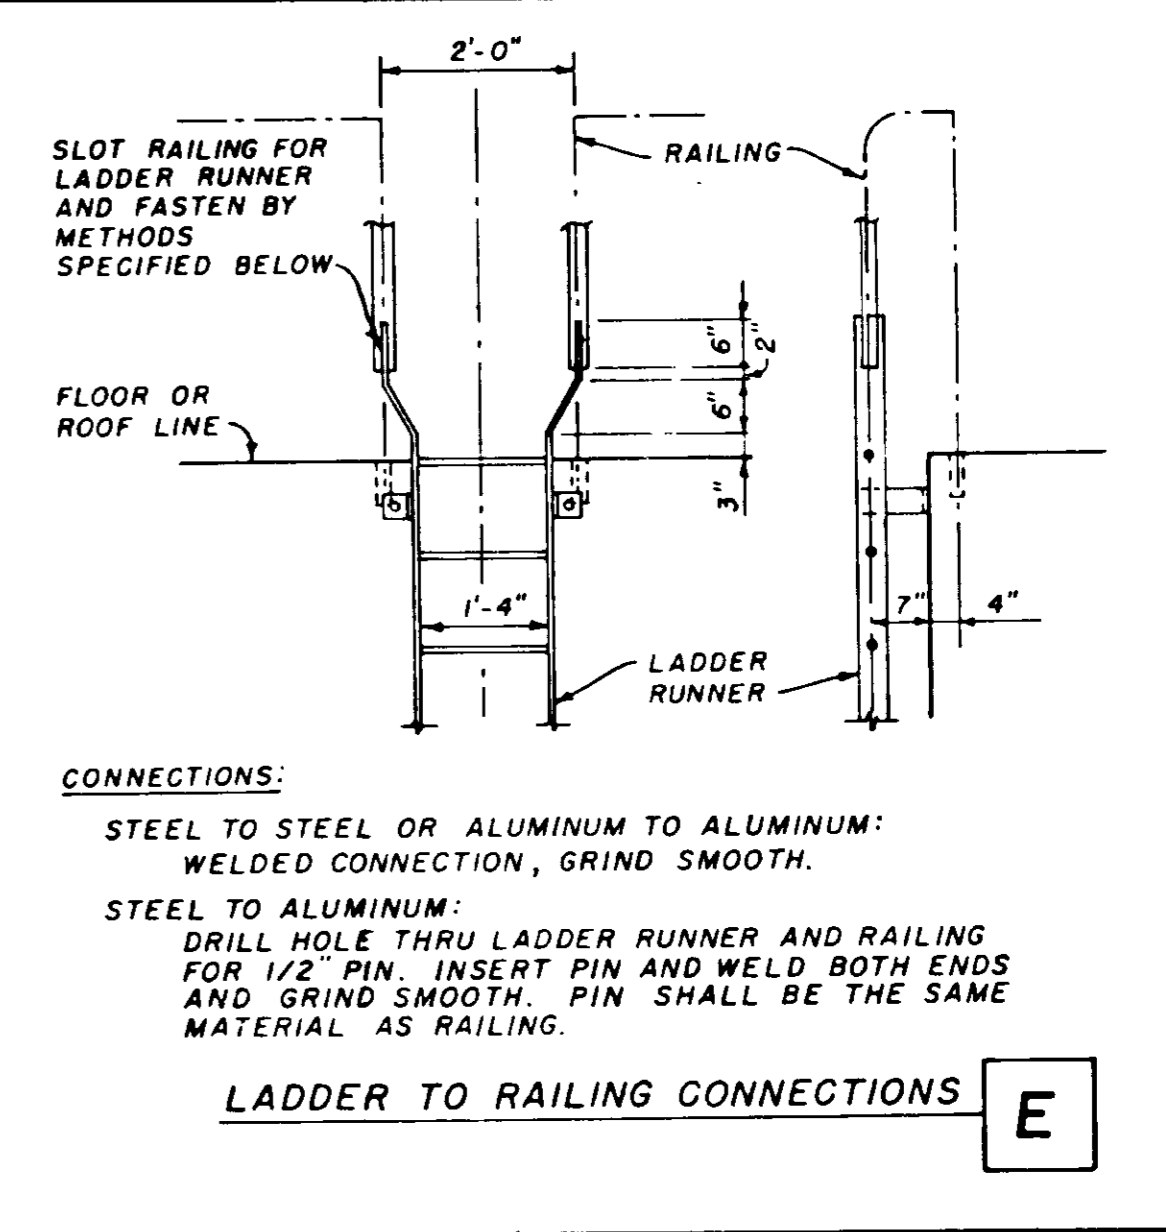


- CONNECTIONS:**
STEEL TO STEEL OR ALUMINUM TO ALUMINUM: WELDED CONNECTION, GRIND SMOOTH.
STEEL TO ALUMINUM: DRILL HOLE THRU LADDER RUNNER AND RAILING FOR 1/2" PIN; INSERT PIN AND WELD BOTH ENDS AND GRIND SMOOTH. PIN SHALL BE THE SAME MATERIAL AS RAILING.
- LADDER TO RAILING CONNECTIONS** **E**

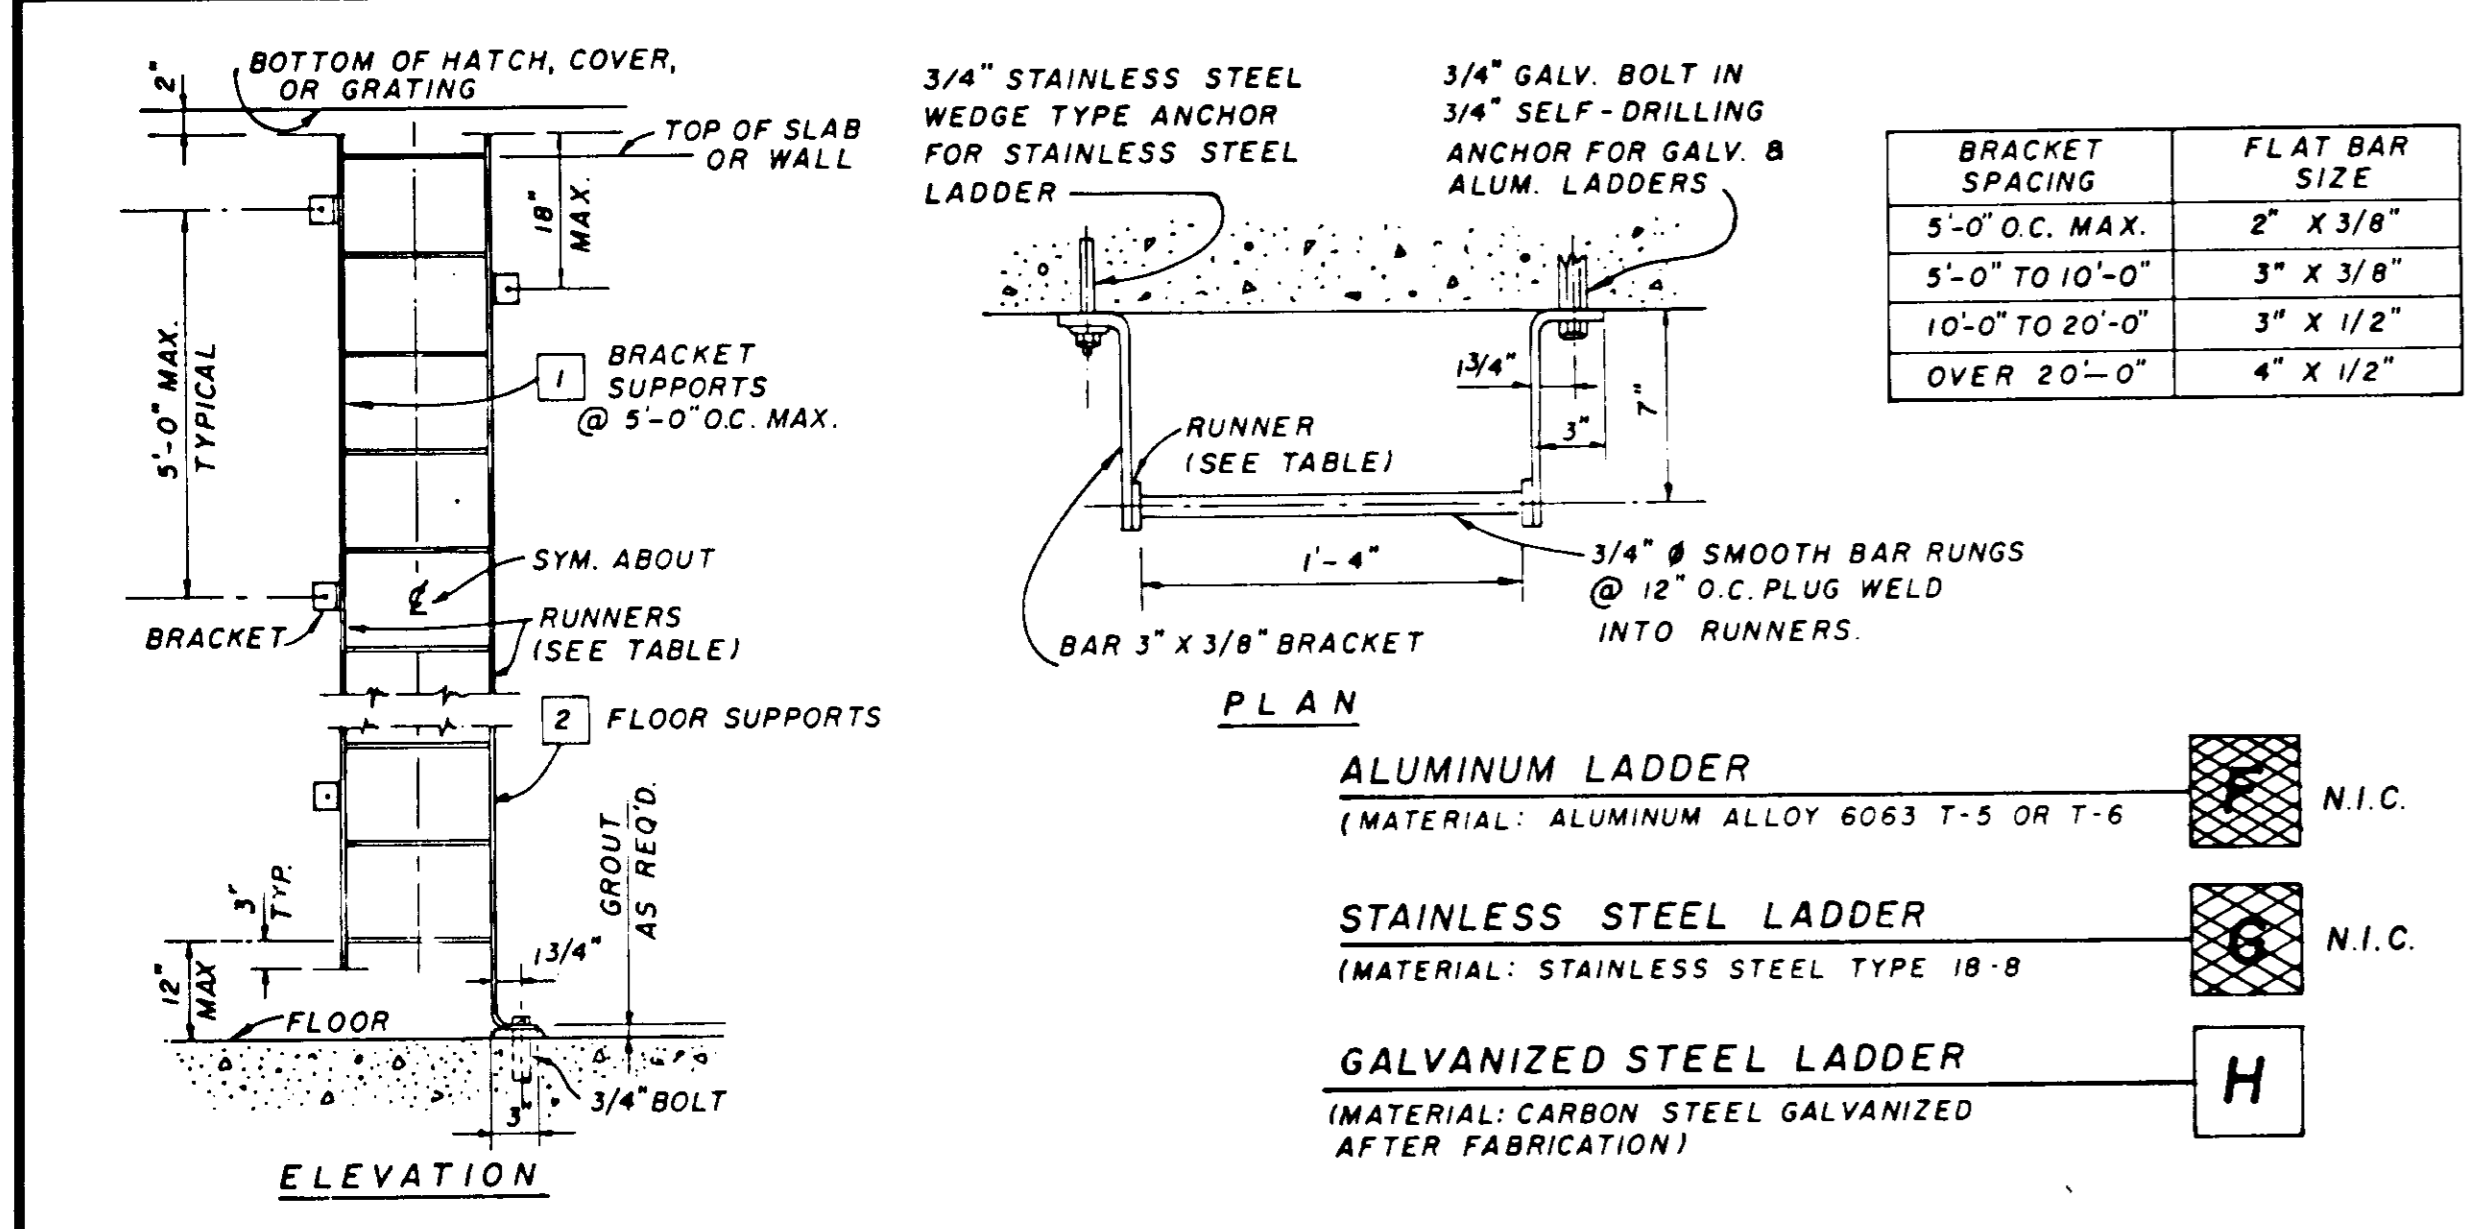


- ALUMINUM LADDER**
(MATERIAL: ALUMINUM ALLOY 6063 T-5 OR T-6) **H**
N.I.C.
- STAINLESS STEEL LADDER**
(MATERIAL: STAINLESS STEEL TYPE 18-8) **G**
N.I.C.
- GALVANIZED STEEL LADDER**
(MATERIAL: CARBON STEEL GALVANIZED AFTER FABRICATION) **H**

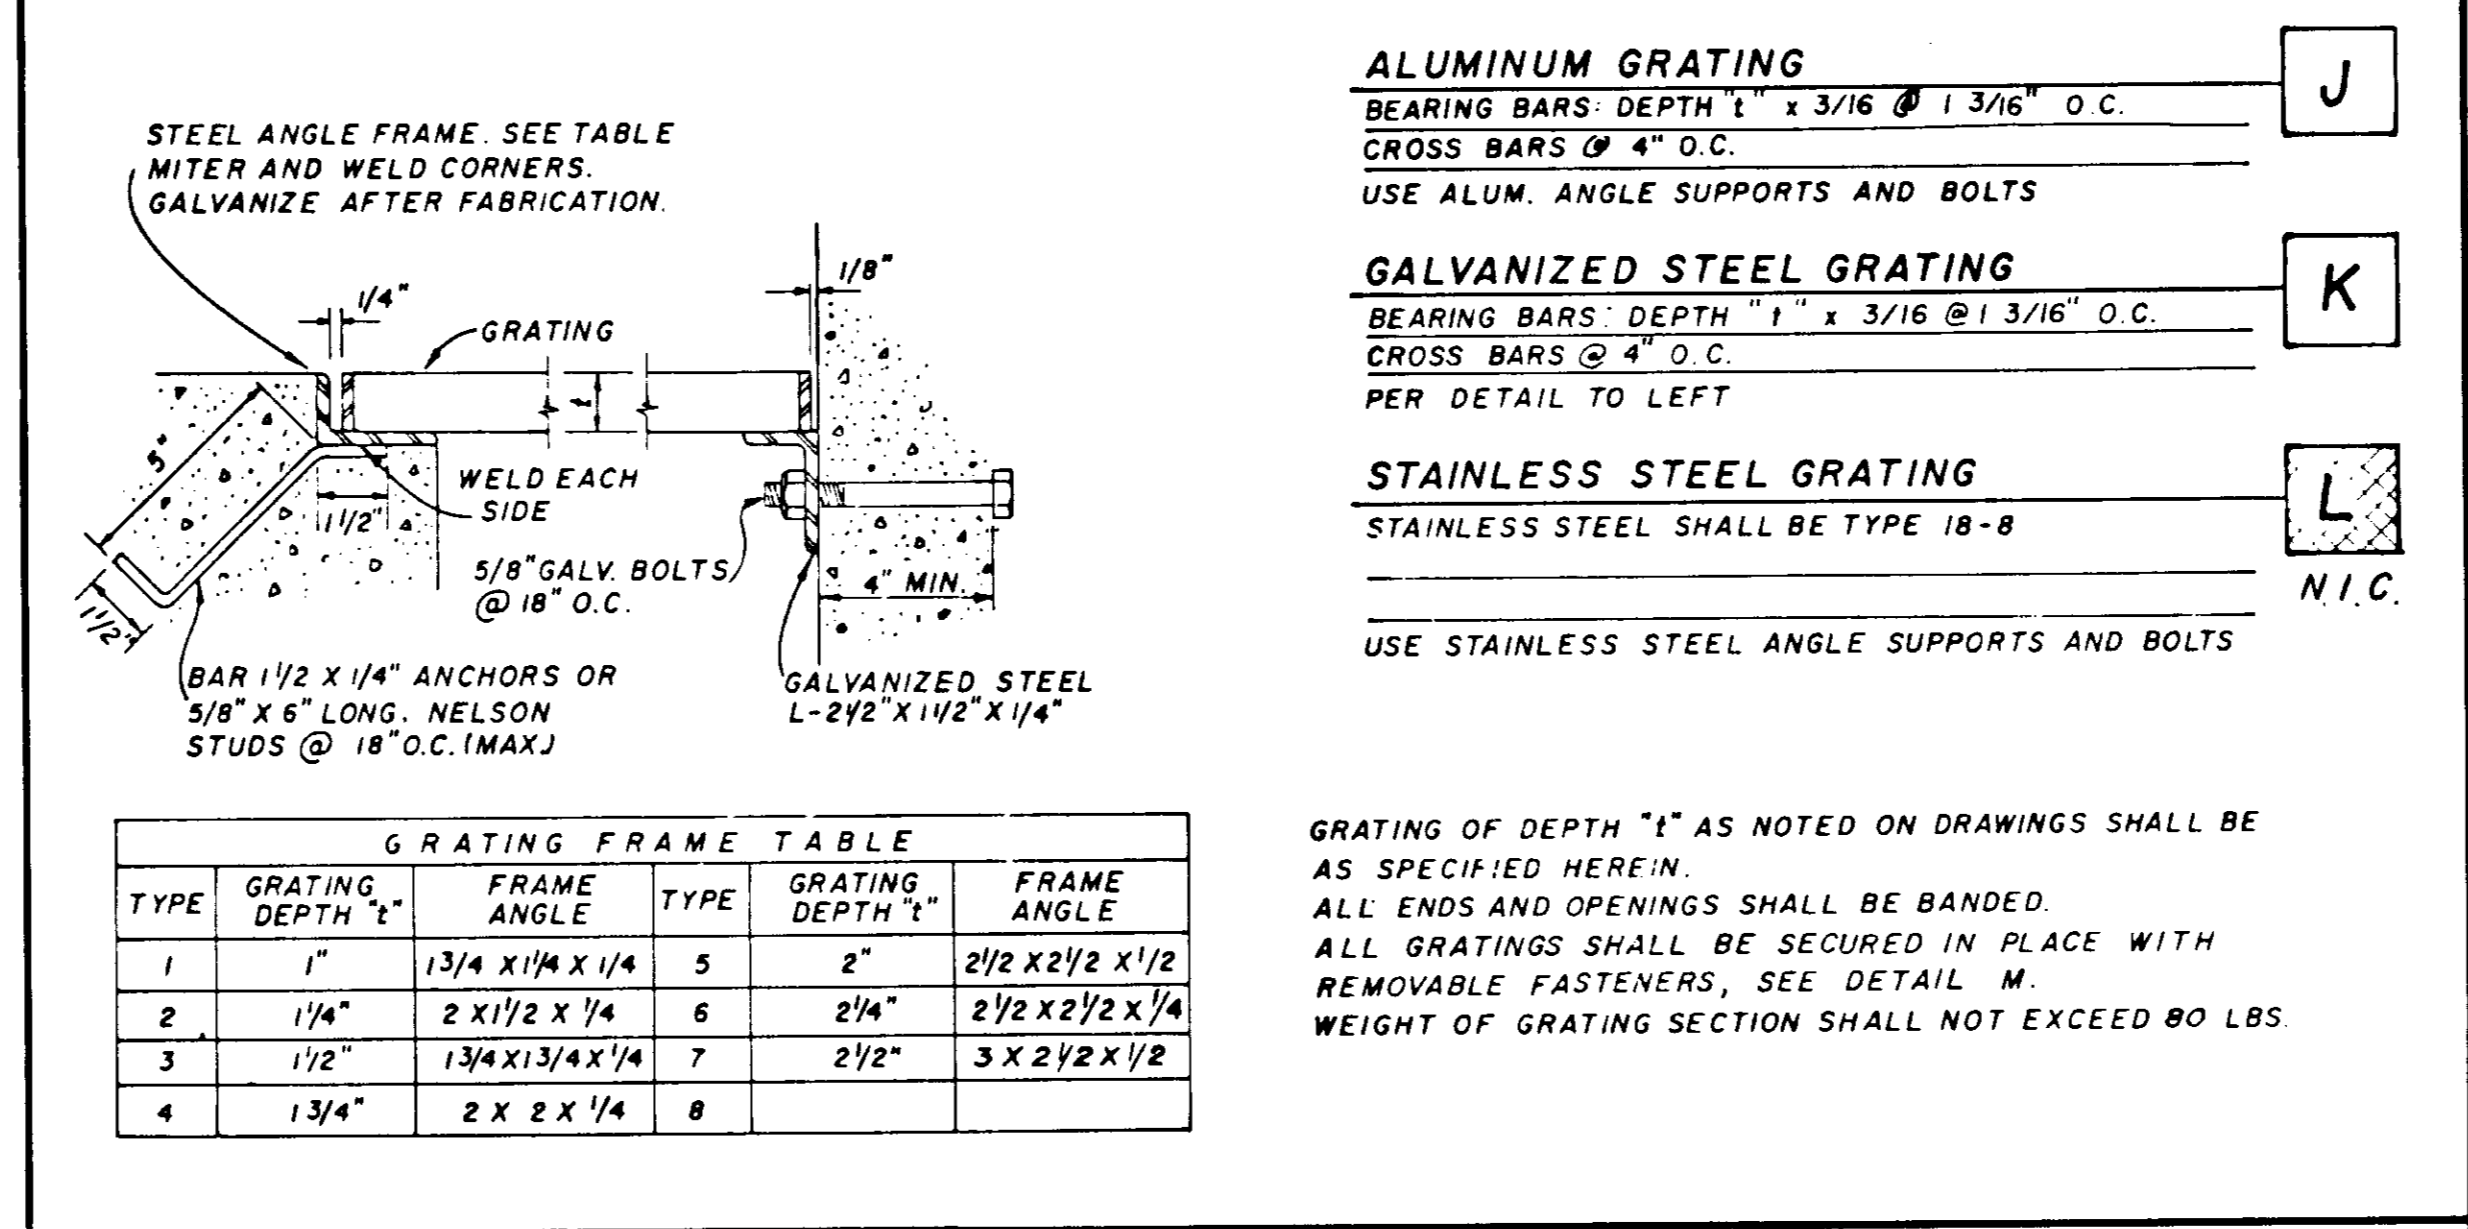


- ALUMINUM GRATING**
BEARING BARS: DEPTH "t" X 3/16 @ 1 3/16" O.C.
CROSS BARS @ 4" O.C.
USE ALUM. ANGLE SUPPORTS AND BOLTS **J**
- GALVANIZED STEEL GRATING**
BEARING BARS: DEPTH "t" X 3/16 @ 1 3/16" O.C.
CROSS BARS @ 4" O.C.
PER DETAIL TO LEFT **K**
- STAINLESS STEEL GRATING**
STAINLESS STEEL SHALL BE TYPE 18-8 **L**
N.I.C.

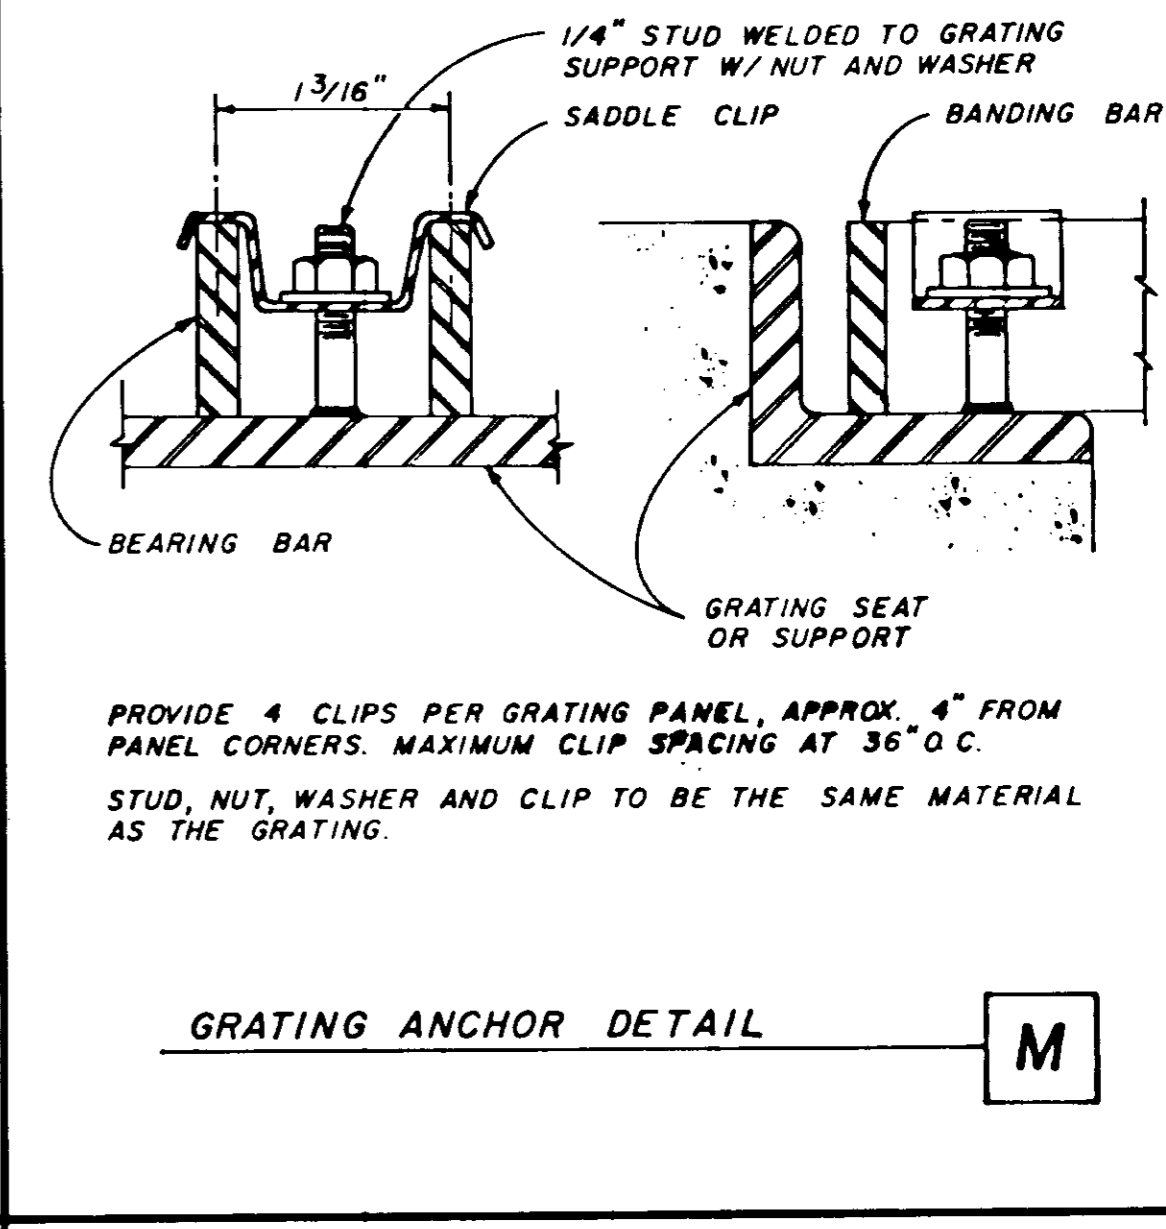

- GRATING ANCHOR DETAIL** **M**

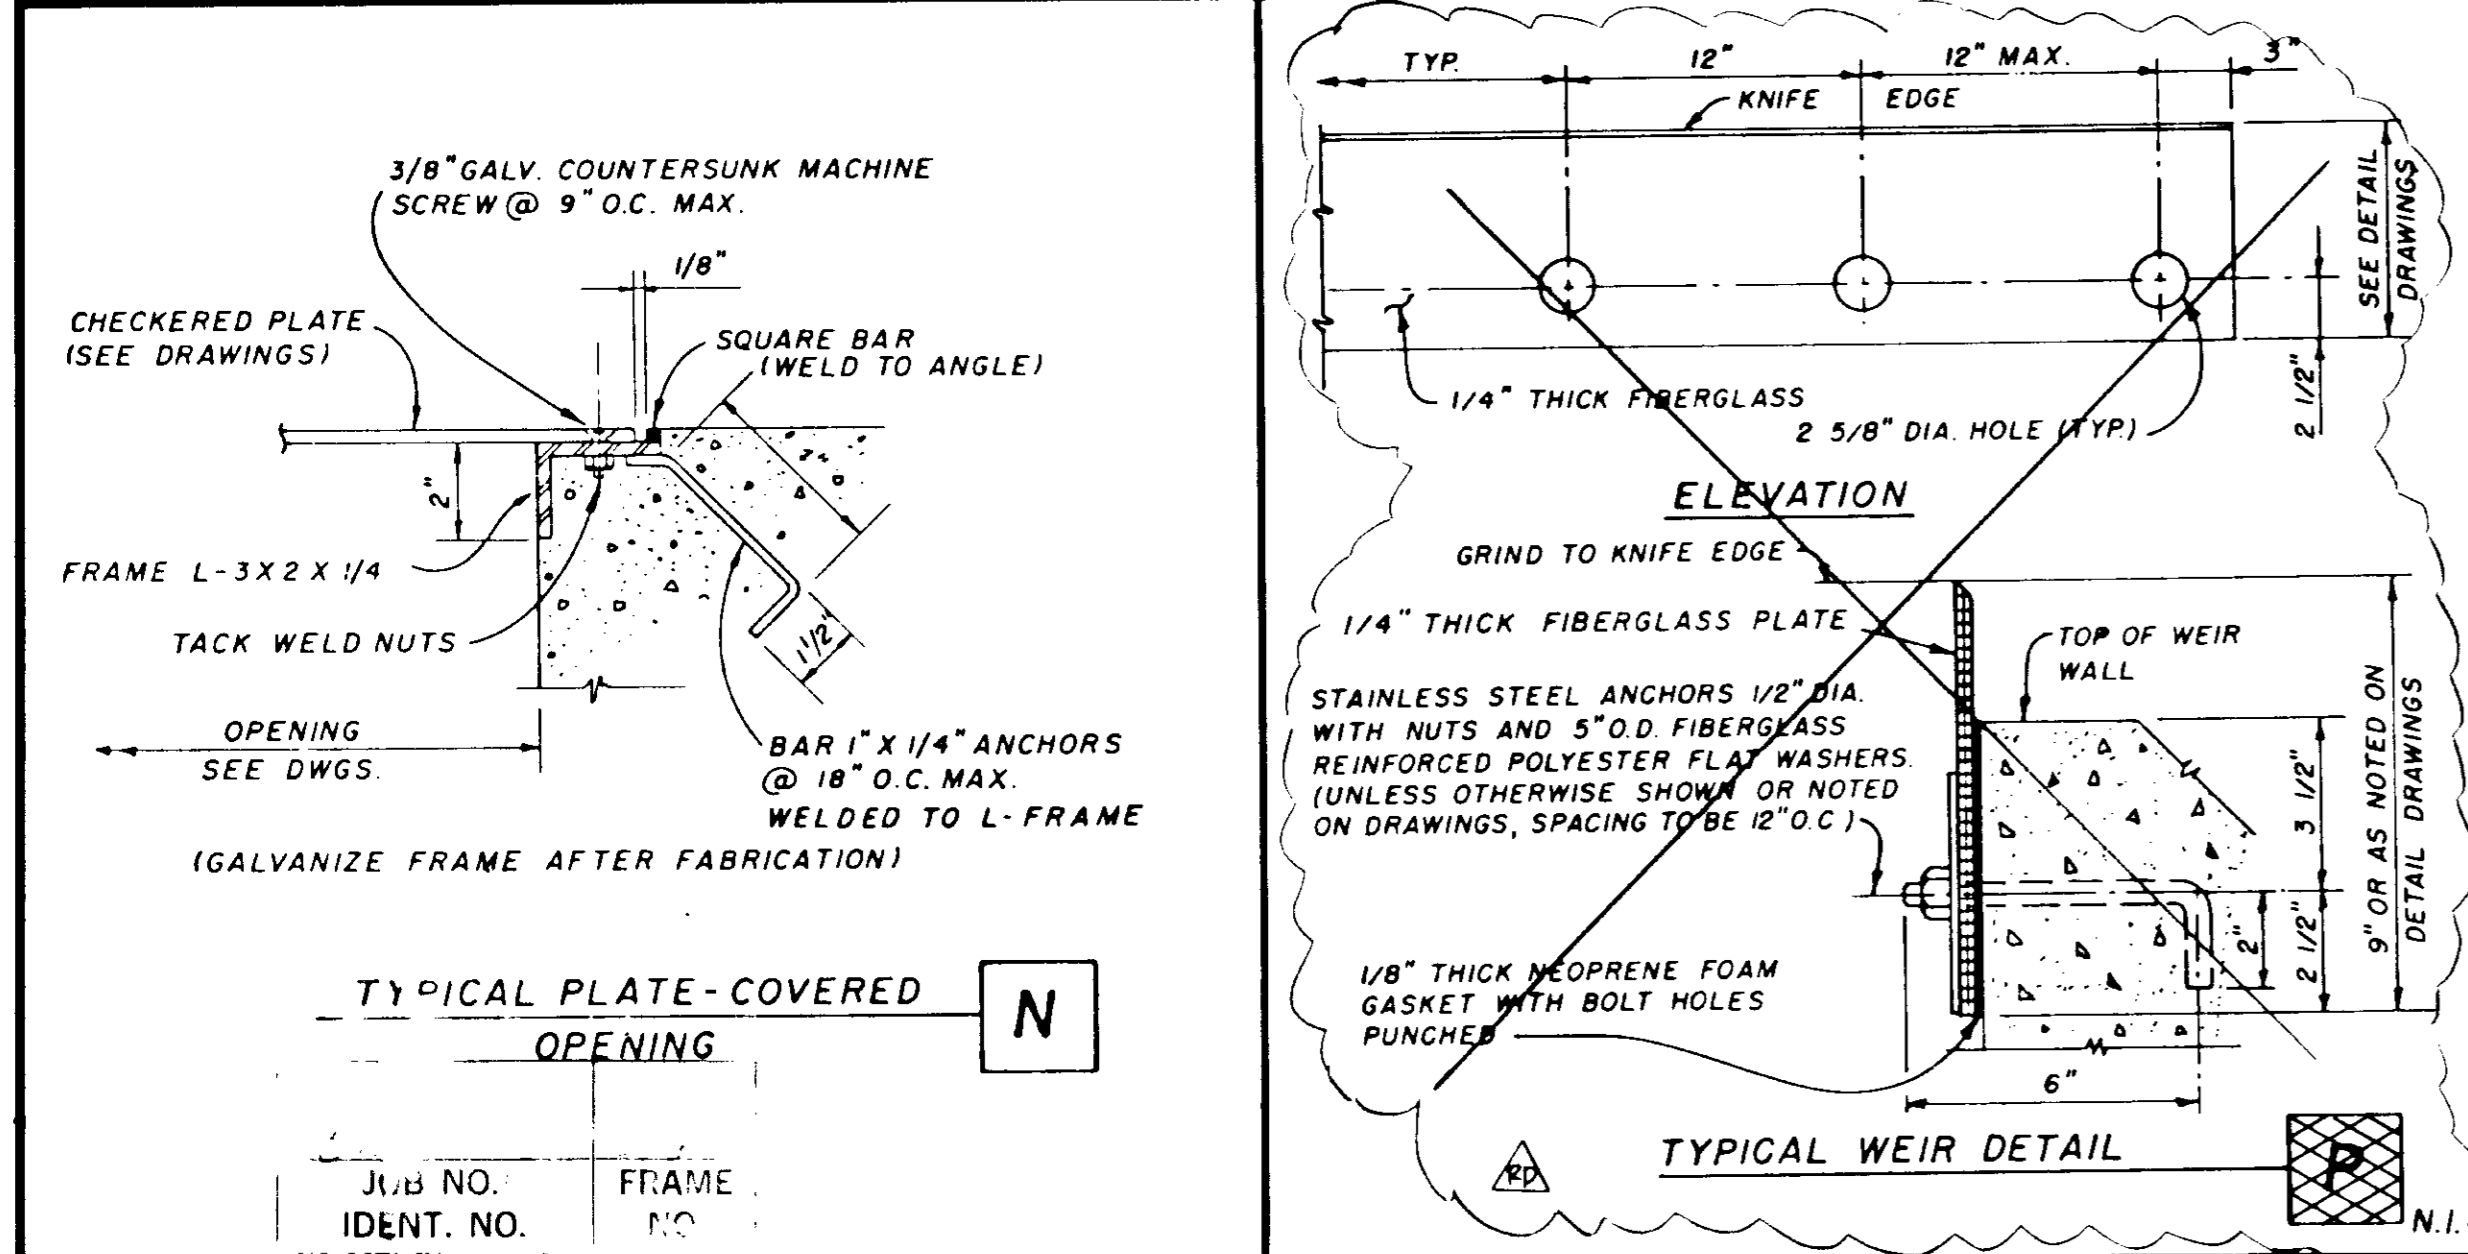

- TYPICAL PLATE-COVERED OPENING** **N**
- TYPICAL WEIR DETAIL** **P**
N.I.C.

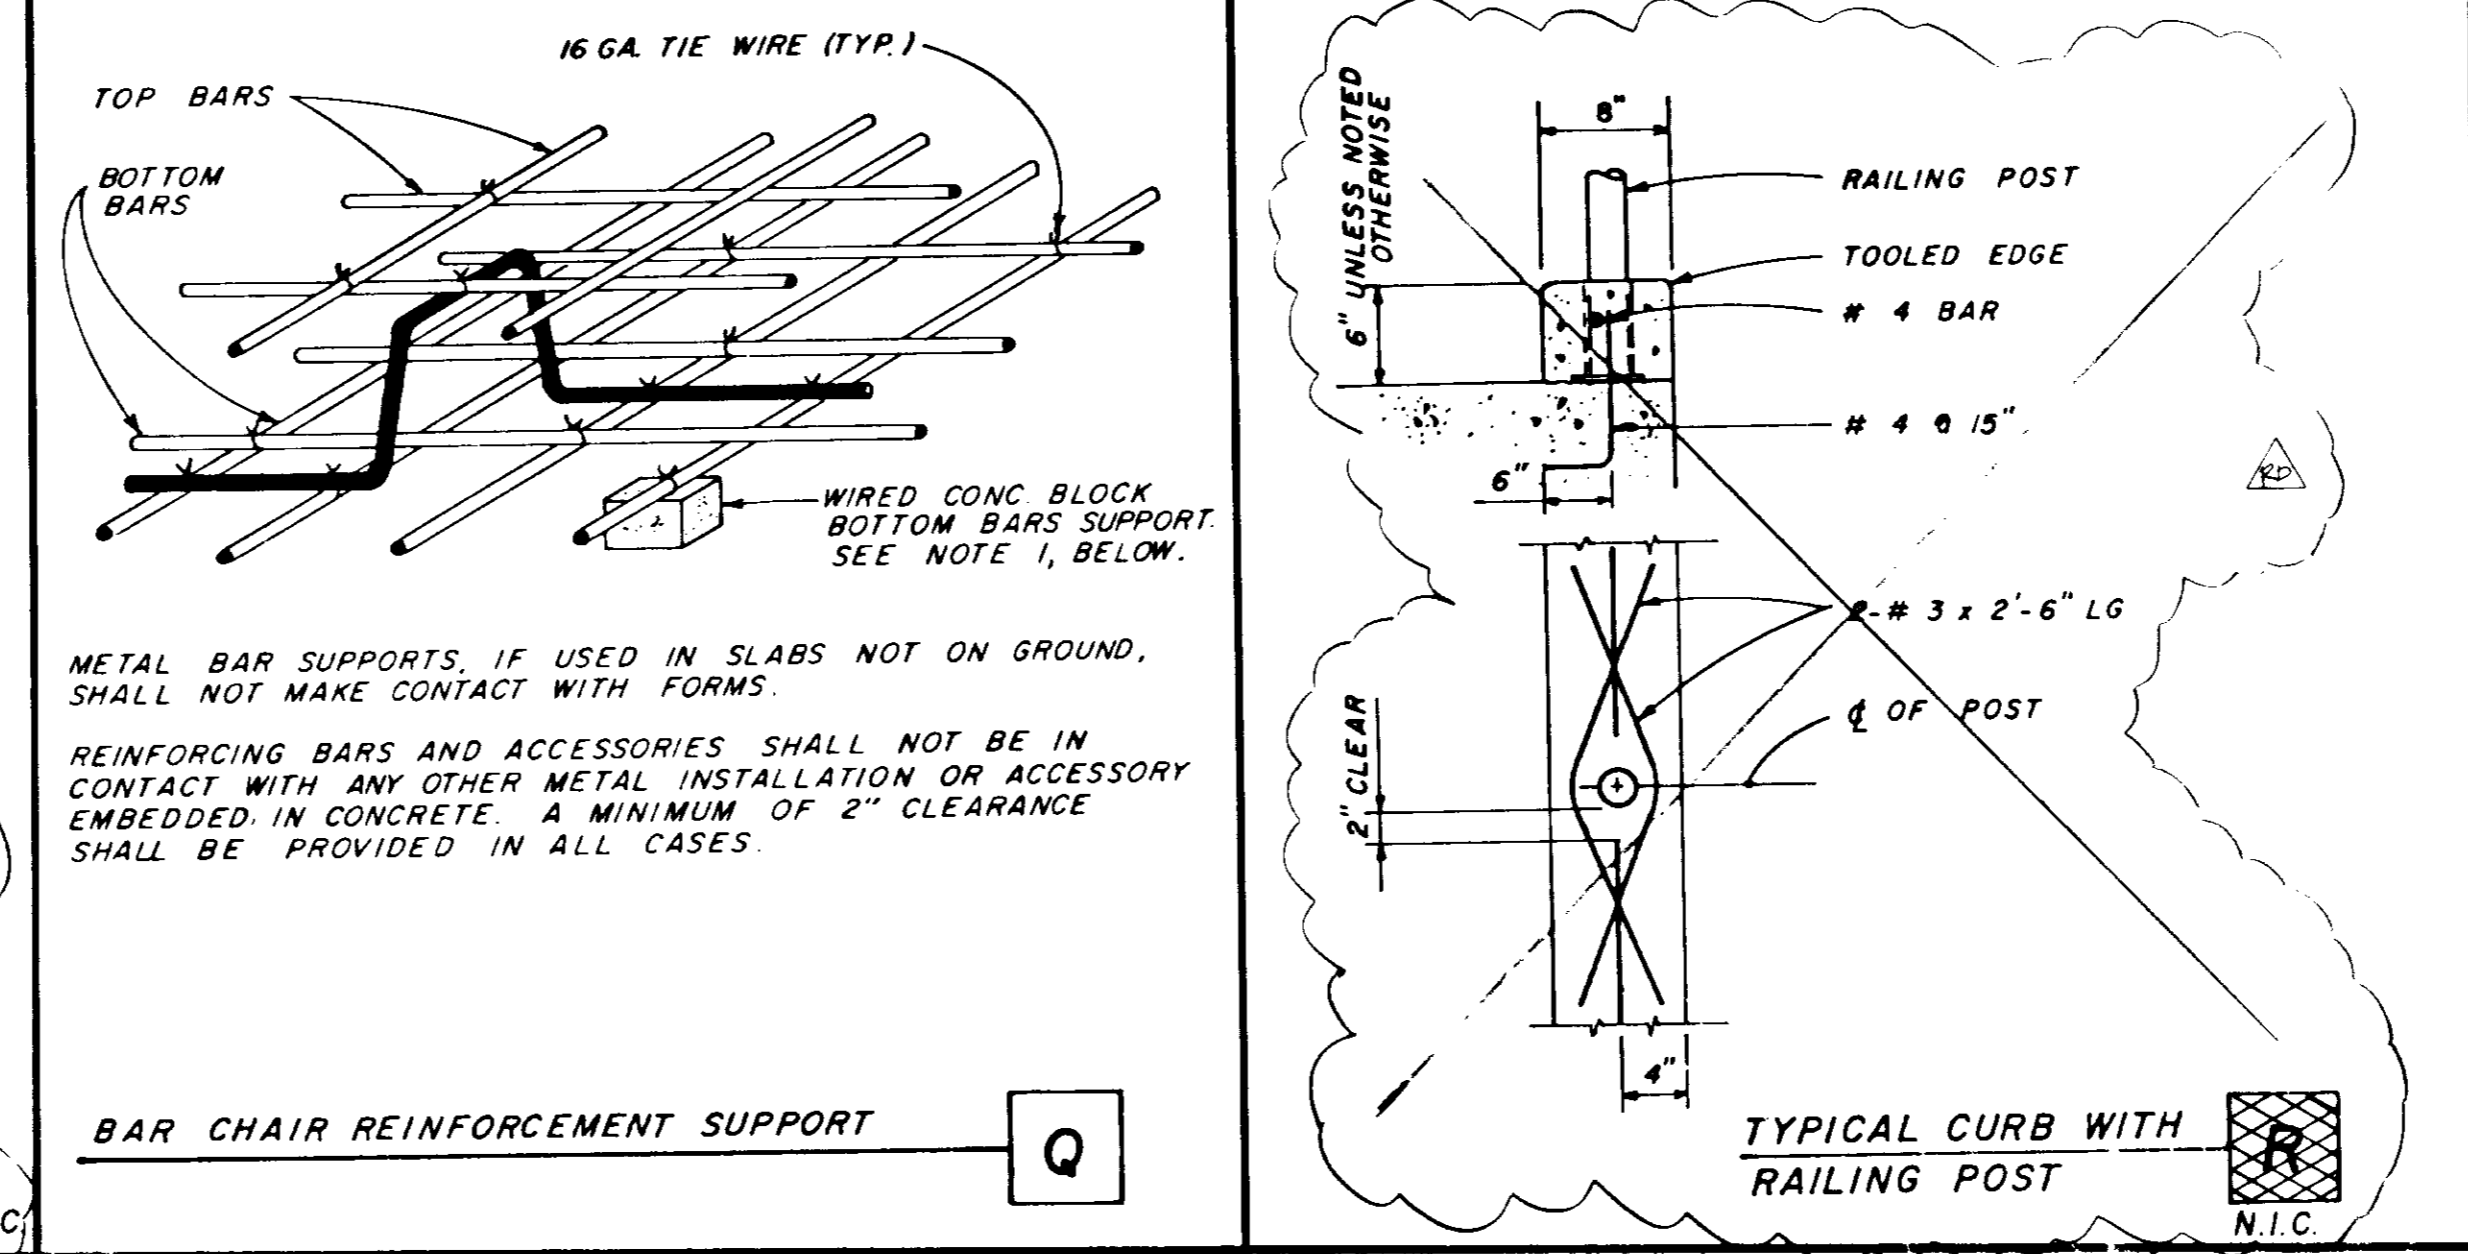

- BAR CHAIR REINFORCEMENT SUPPORT** **Q**
- TYPICAL CURB WITH RAILING POST** **R**
N.I.C.

THE DETAILS ILLUSTRATED ON THIS SHEET ARE PART OF JAMES M. MONTGOMERY STANDARD DETAILS.

THESE DETAILS ARE TO BE USED WHEN REFERRED TO OR WHEN NO OTHER MORE RESTRICTIVE OR DIFFERENT DETAILS ARE SHOWN ON THE DRAWINGS.

DETAILS NOT PERTAINING TO THE PROJECT ARE MARKED THUS **N.I.C.** (NOT IN CONTRACT)


RD 11/24/01	RECORD DRAWINGS	SCALE: NO SCALE	DESIGNED: P. REYMOND	27304	8/19/01
			DRAWN: C. FITZPATRICK	27638	8/20/01
			CHECKED: P. REYMOND		

JAMES M. MONTGOMERY CONSULTING ENGINEERS, INC.

355 EAST WALNUT STREET, PASADENA, CALIFORNIA 91101


DISTRICT APPROVAL ON TITLE PAGE

LAS VIRGENES MWD/TRIUNFO CSD		SHEET S-4
TAPIA WRF - FILTRATION/DISINFECTION ADDITION		
PHASE II	MISCELLANEOUS METALWORK DETAILS	OF 66 SHEETS

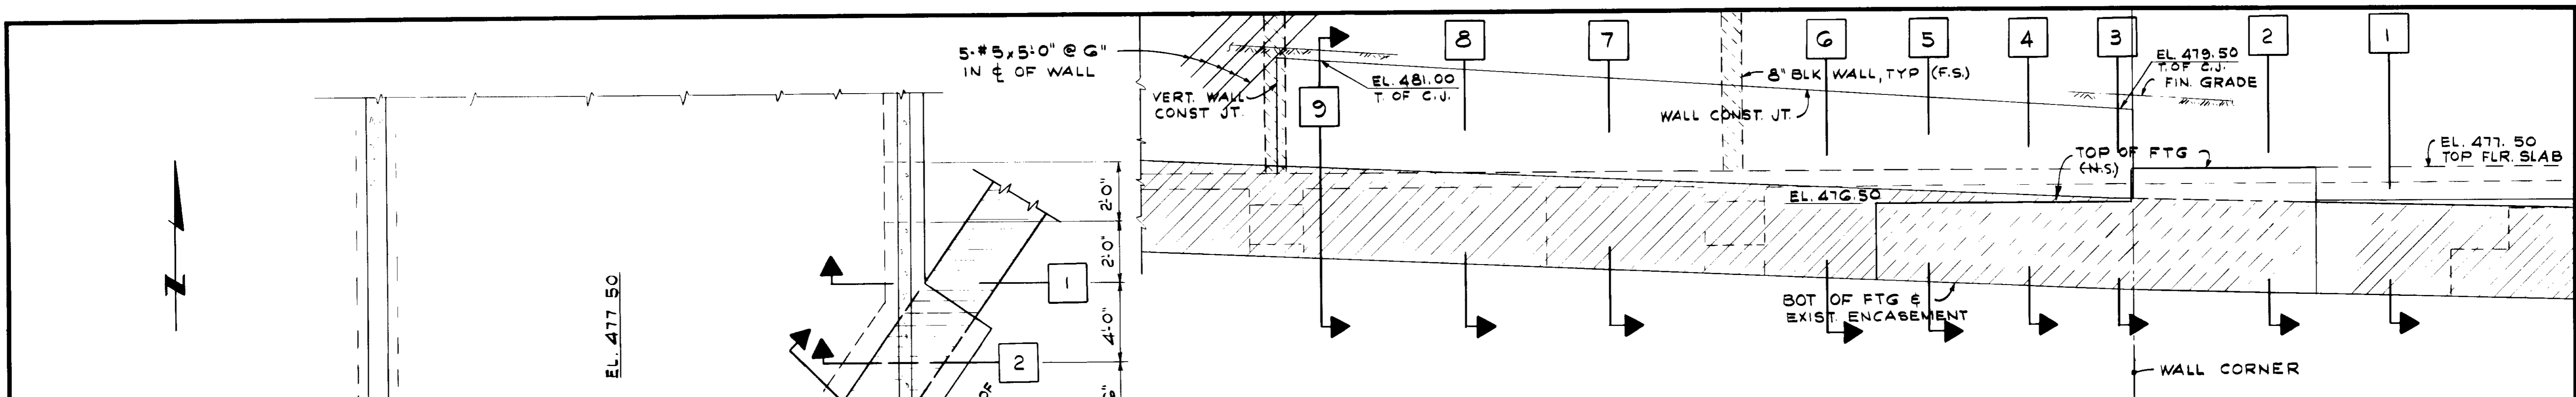

ELEVATION (LOOKING PERPENDICULAR TO BLDG. WALL)

SCALE: 3/8" = 1'-0"

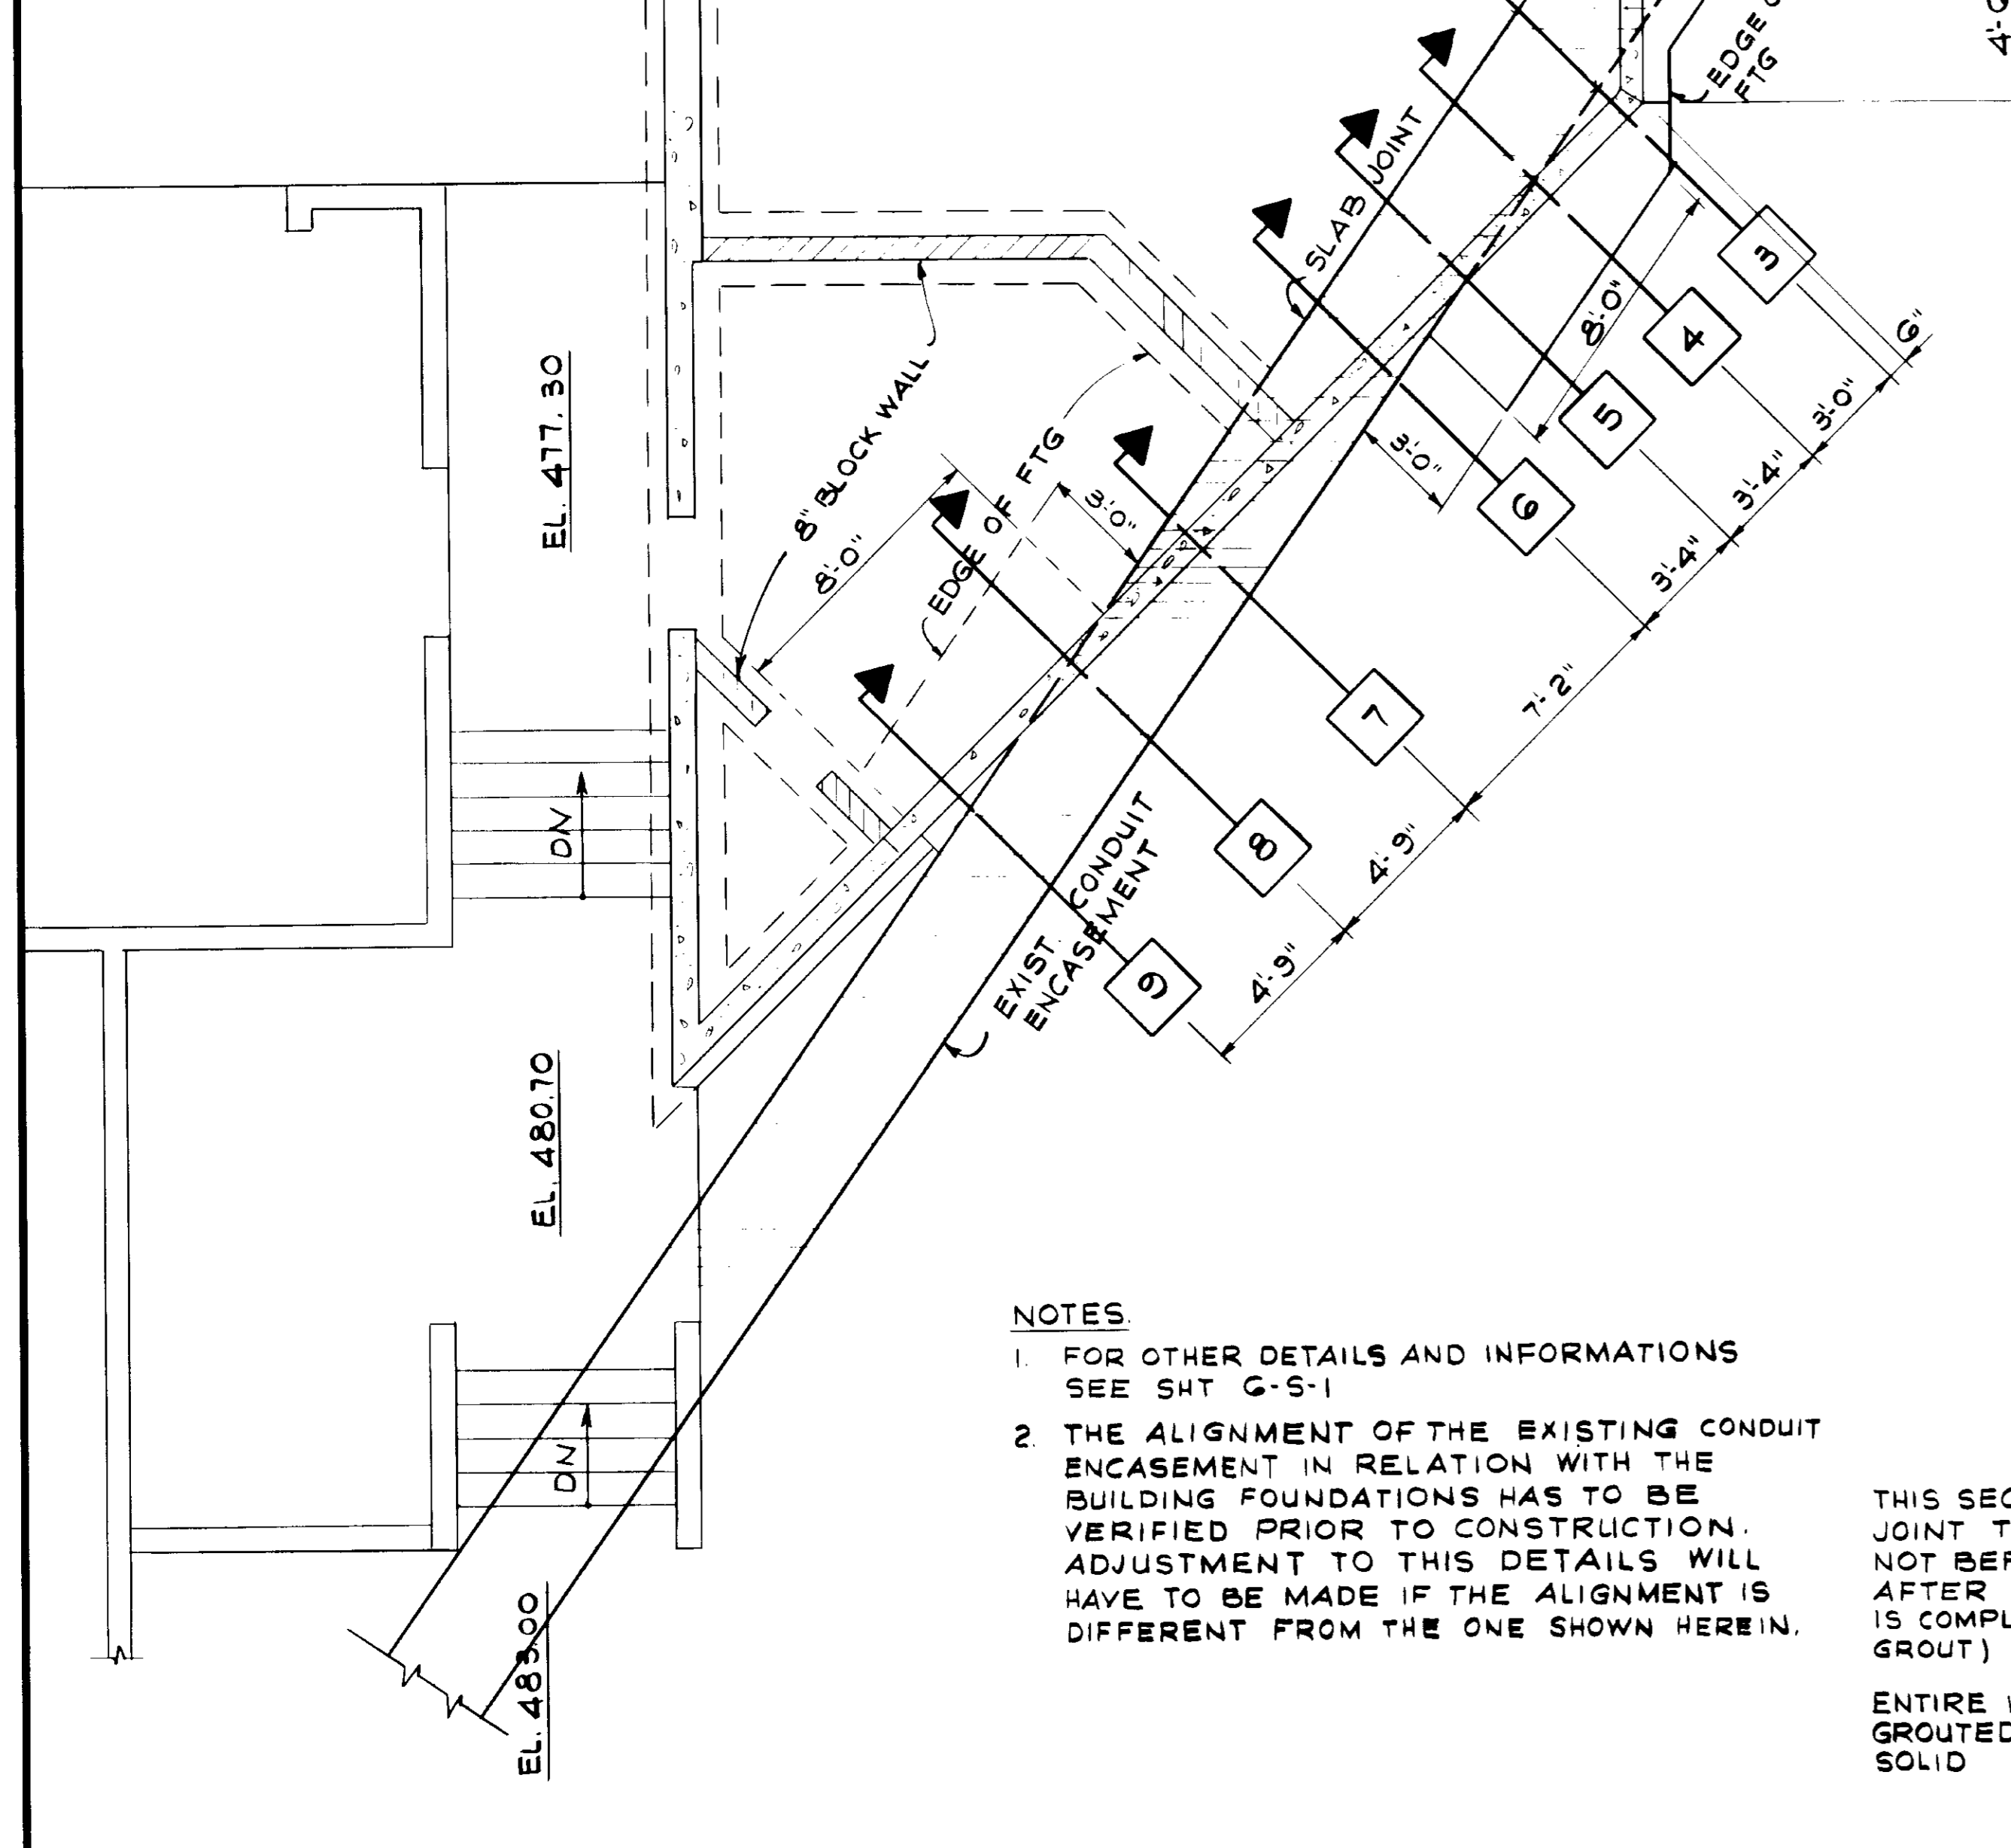


PARTIAL FOUNDATION PLAN
SCALE: 1/4" = 1'-0"

- NOTES
- FOR OTHER DETAILS AND INFORMATIONS SEE SHT G-S-1
 - THE ALIGNMENT OF THE EXISTING CONDUIT ENCASUREMENT IN RELATION WITH THE BUILDING FOUNDATIONS HAS TO BE VERIFIED PRIOR TO CONSTRUCTION. ADJUSTMENT TO THIS DETAILS WILL HAVE TO BE MADE IF THE ALIGNMENT IS DIFFERENT FROM THE ONE SHOWN HEREIN.

THIS SECTION ABOVE CONST. JOINT TO BE PLACED NOT BEFORE 48 HOURS AFTER SECTION BELOW IS COMPLETED (INCLUDING GROUT)


ENTIRE WALL GROUTED SOLID

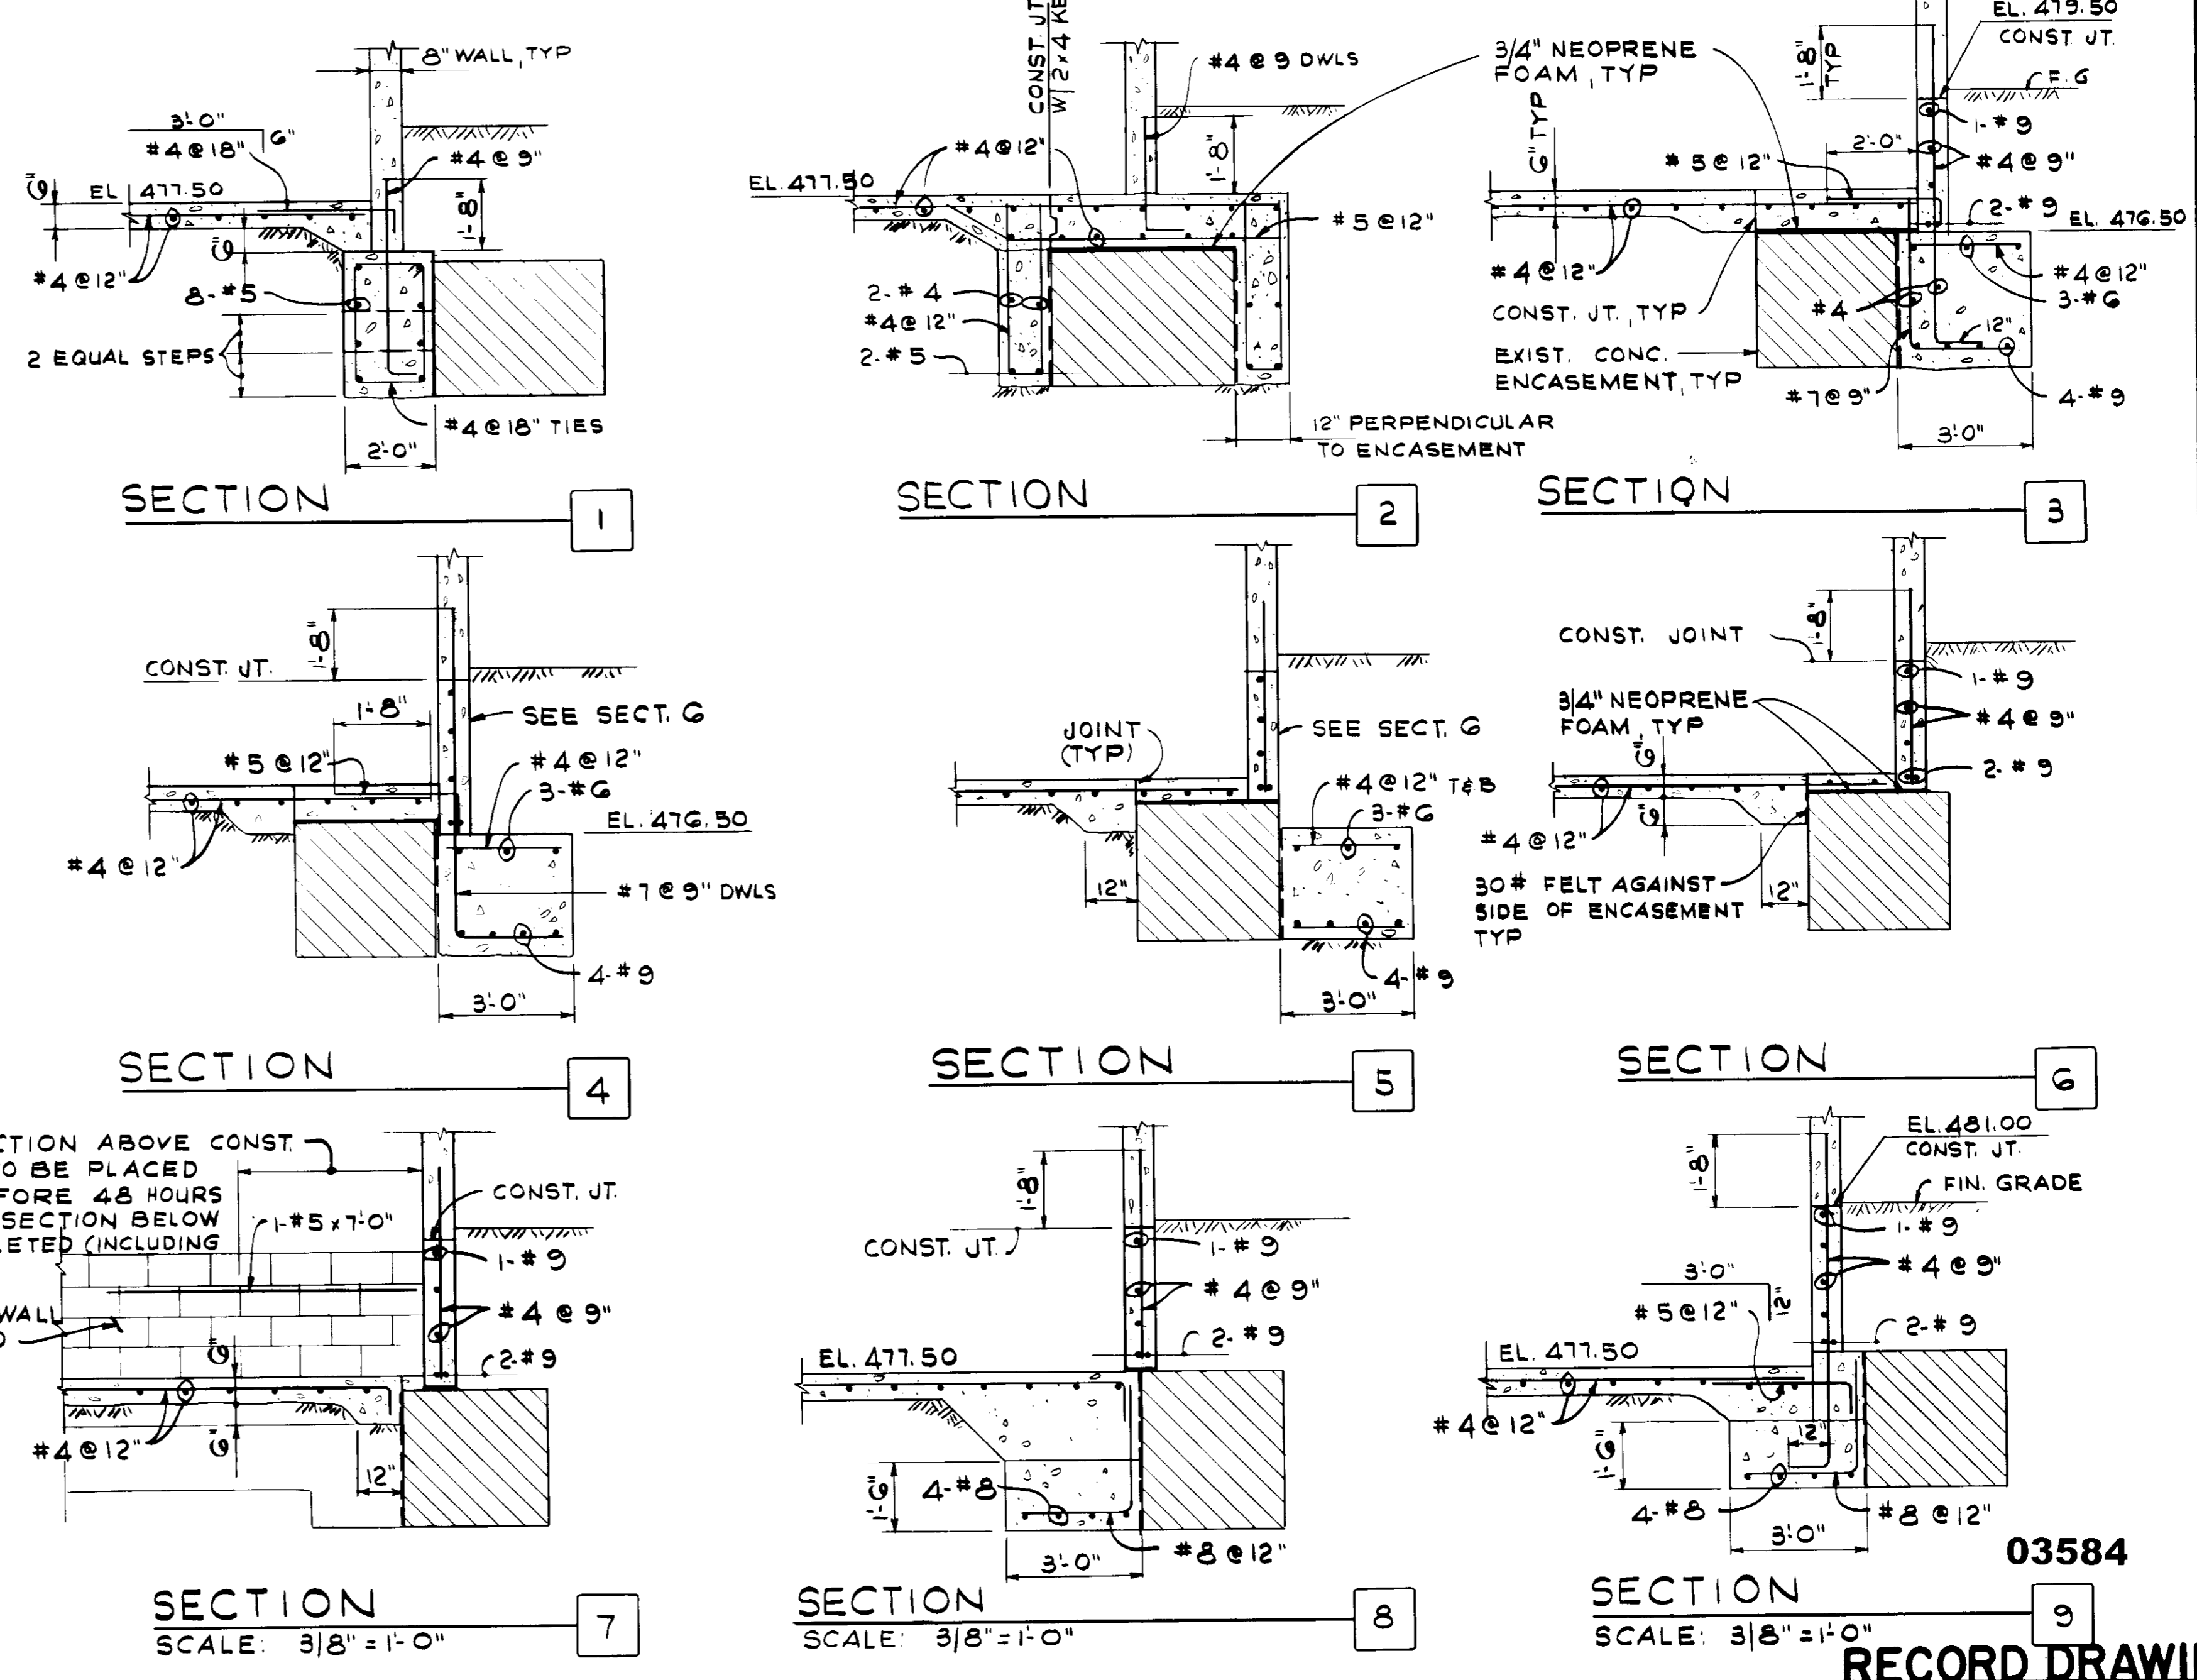


03584

RECORD DRAWING


SCALE: AS NOTED		DESIGNED: P REYMOND DRAWN: M DULNUAN CHECKED: P REYMOND	SUBMITTED: [Signature] 033699 8/5/82 PROJECT ENGINEER RECOMMENDED: [Signature] 27304 8/5/82 JAMES M. MONTGOMERY CONSULTING ENGINEERS, INC.	APPROVED: _____ DATE _____ APPROVED: _____ DATE _____	LAS VIRGINES MWD/TRIUNFO CSD TAPIA WRF-FILTRATION/ DISINFECTION ADDITION CHEMICAL BUILDING CHANGE ORDER NO. _____ FOOTING REVISION _____	SHEET 1 OF 1 SHEETS
REV	DATE	BY	DESCRIPTION			

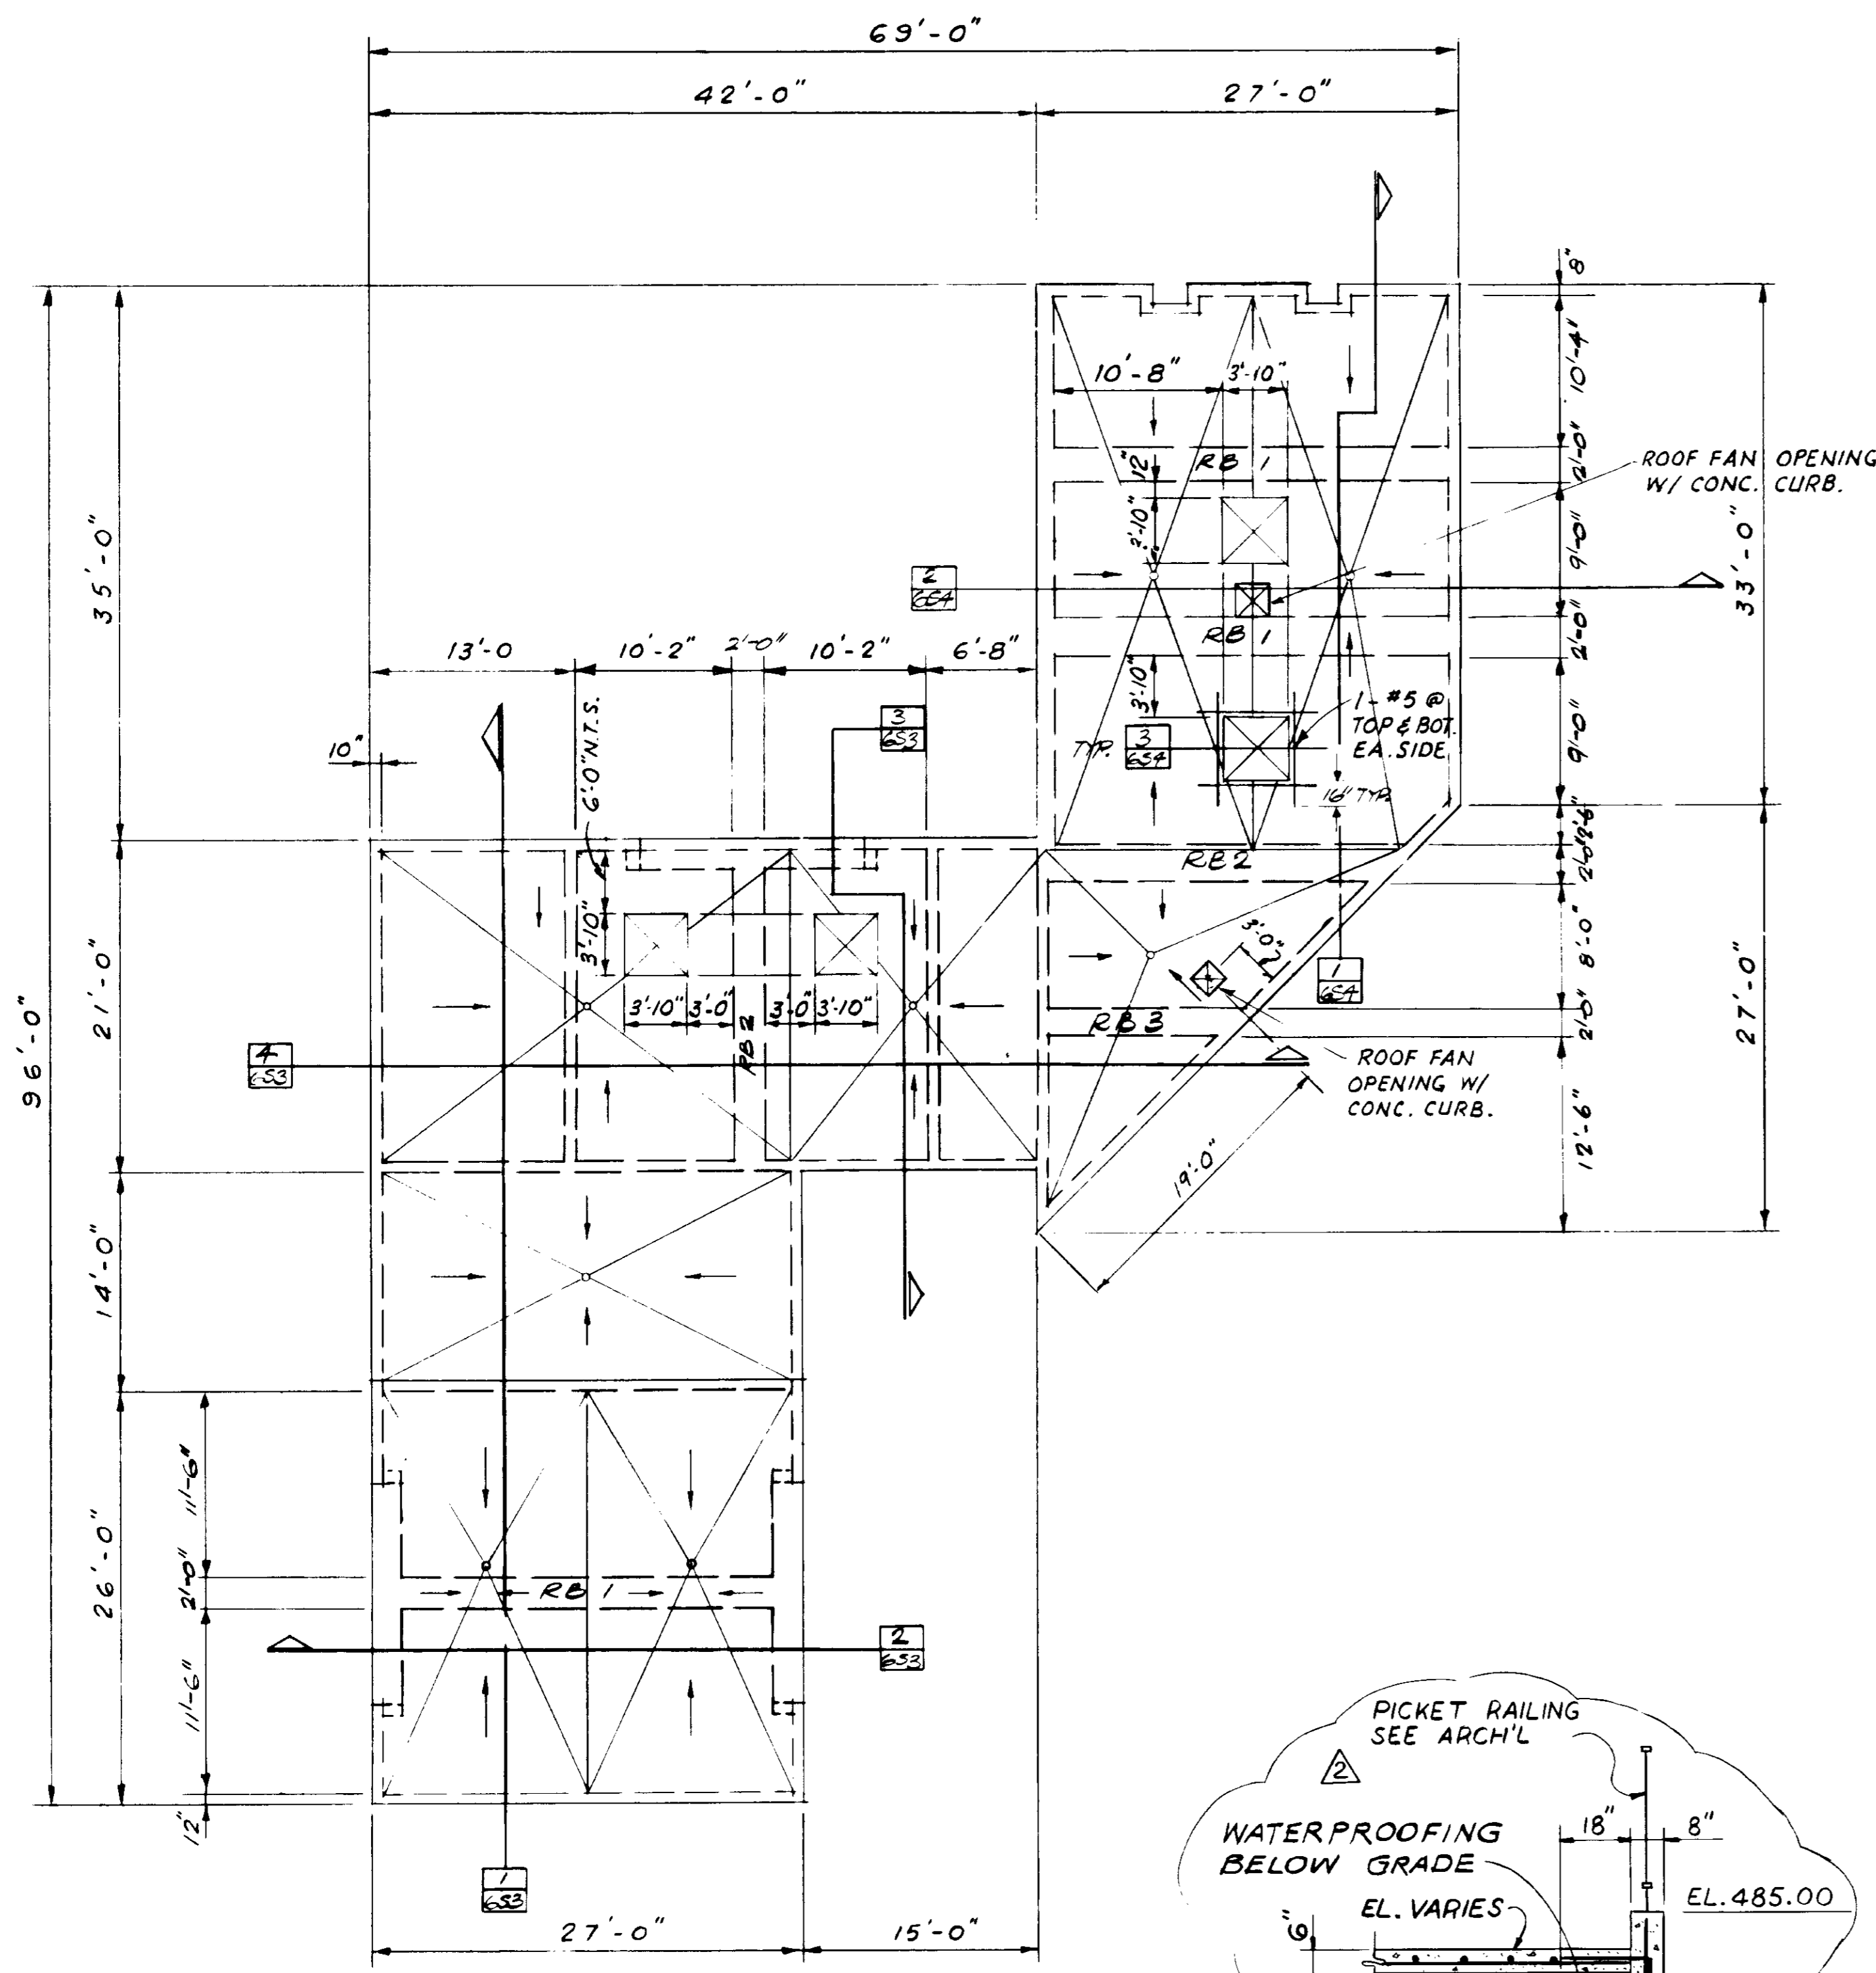

ROOF PLAN
SCALE 1/8" = 1'-0"

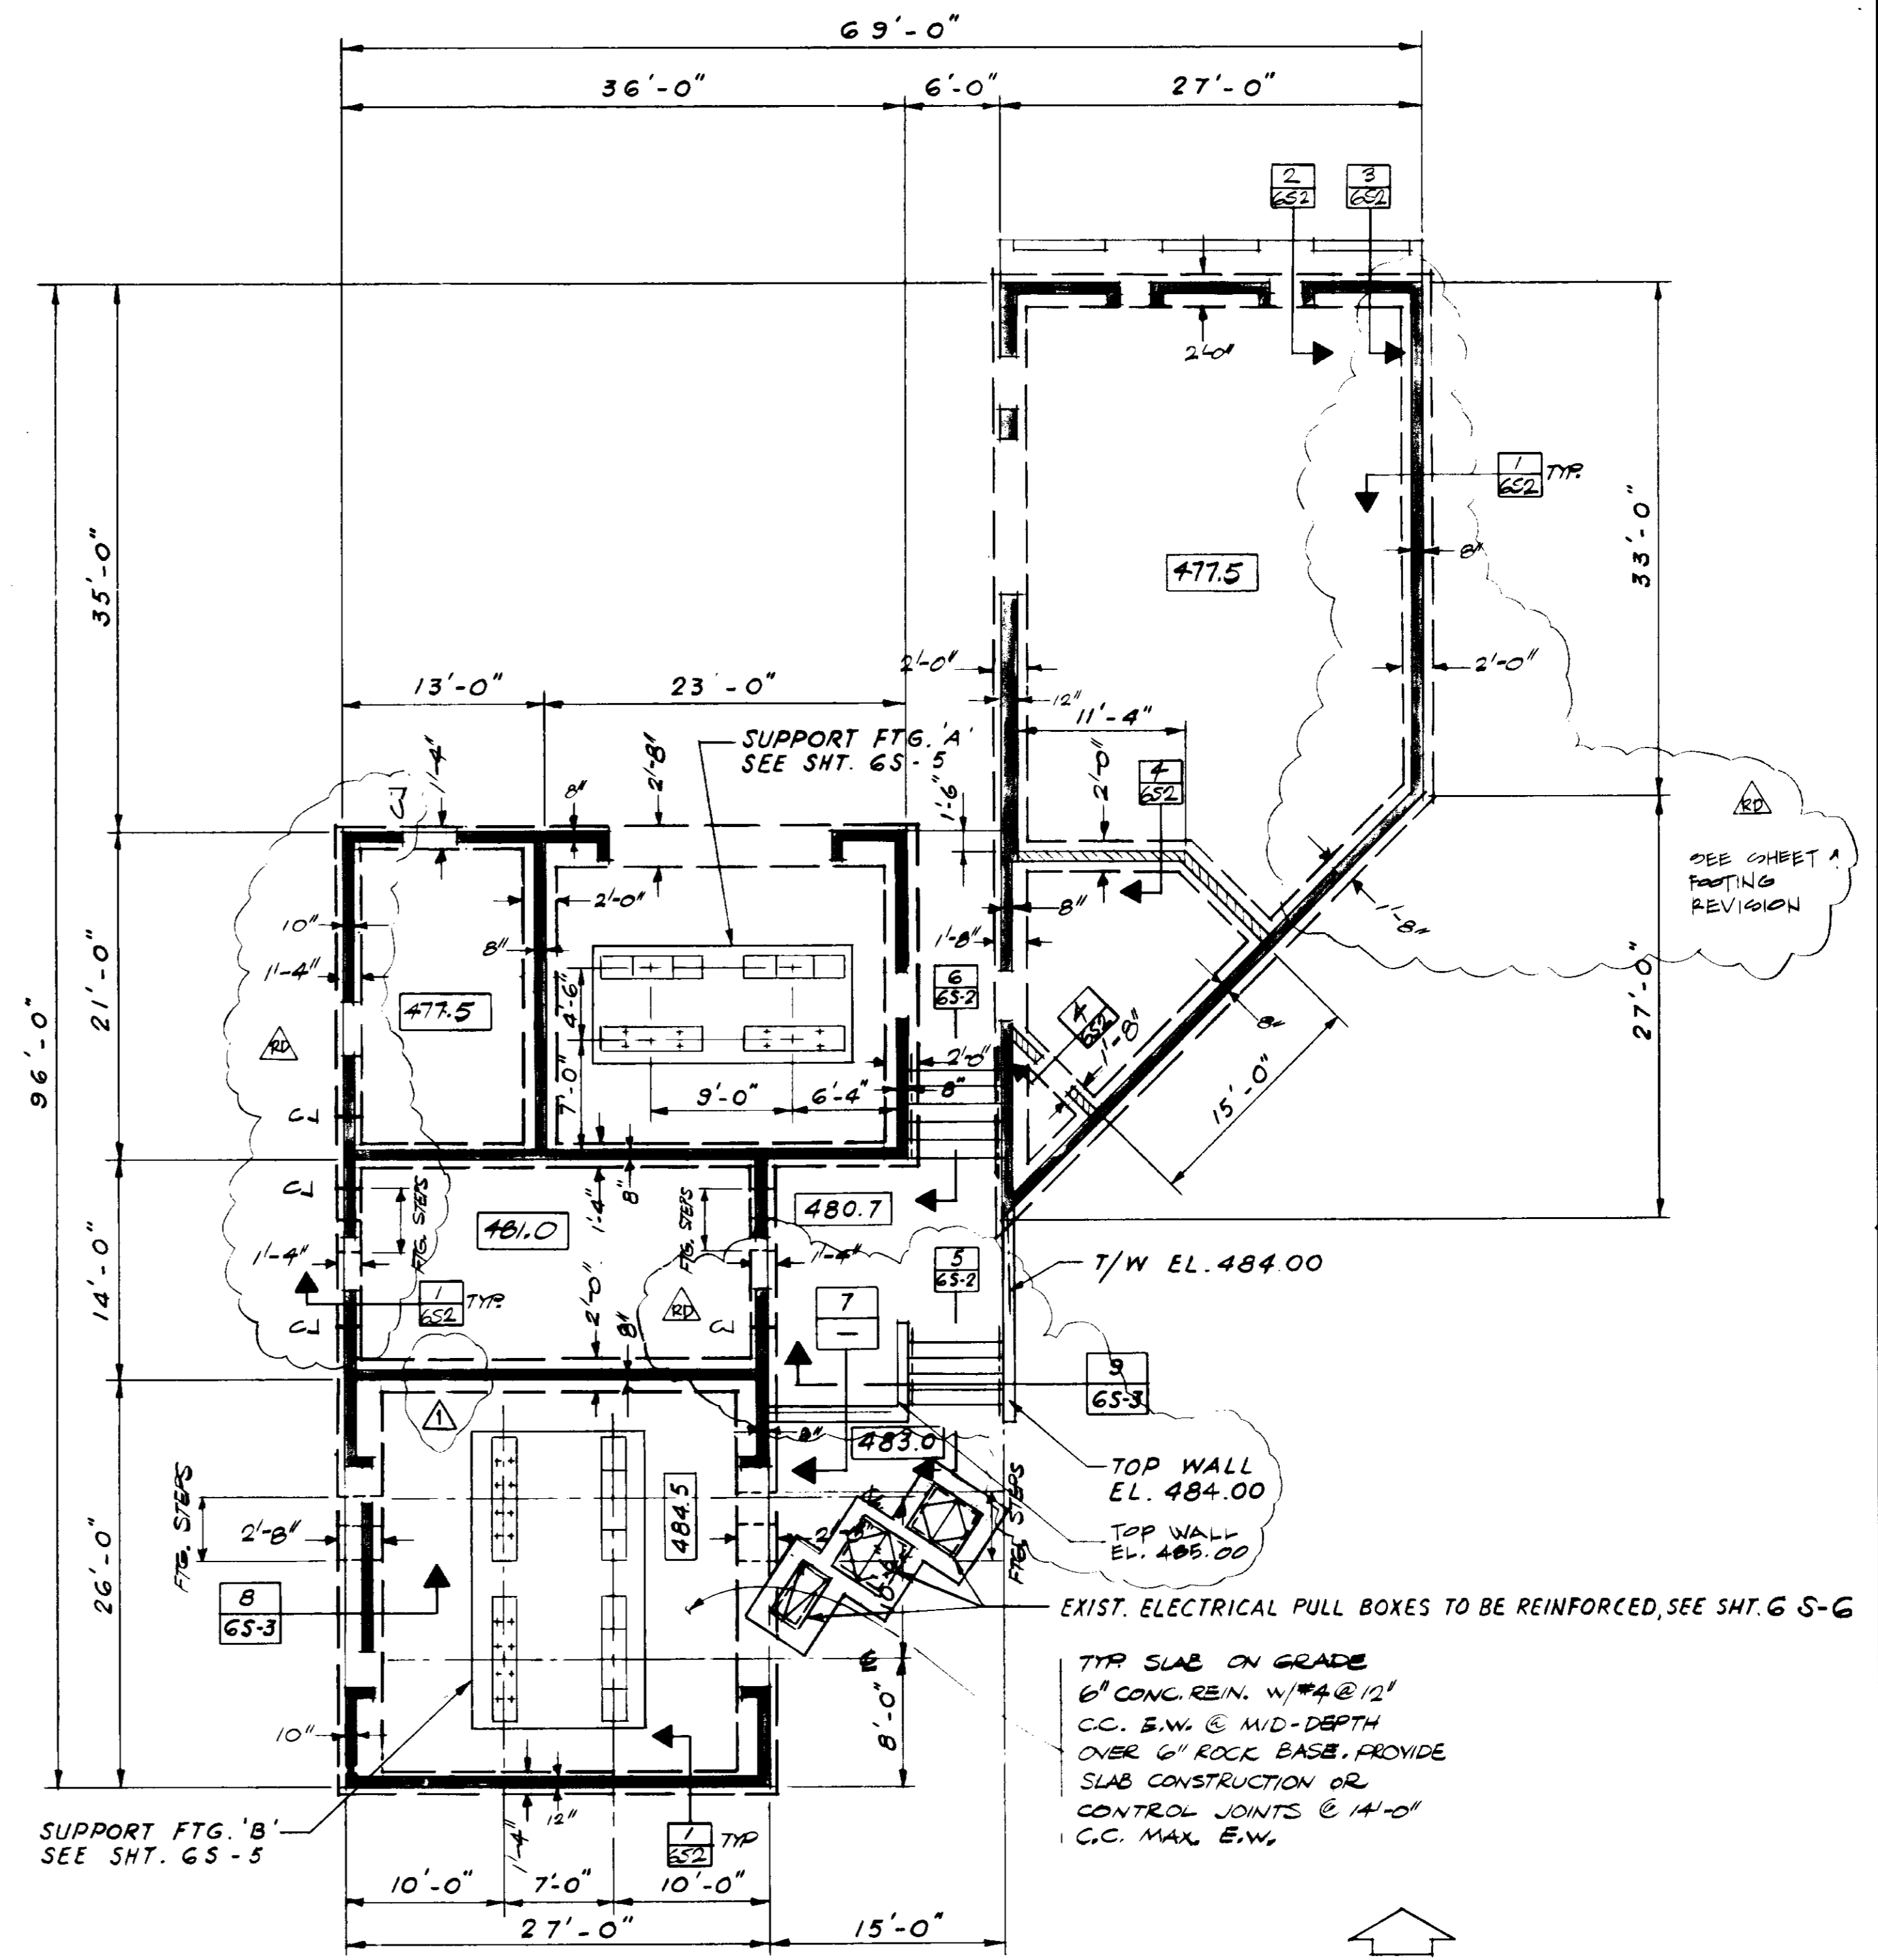

FOUNDATION PLAN
SCALE 1/8" = 1'-0"

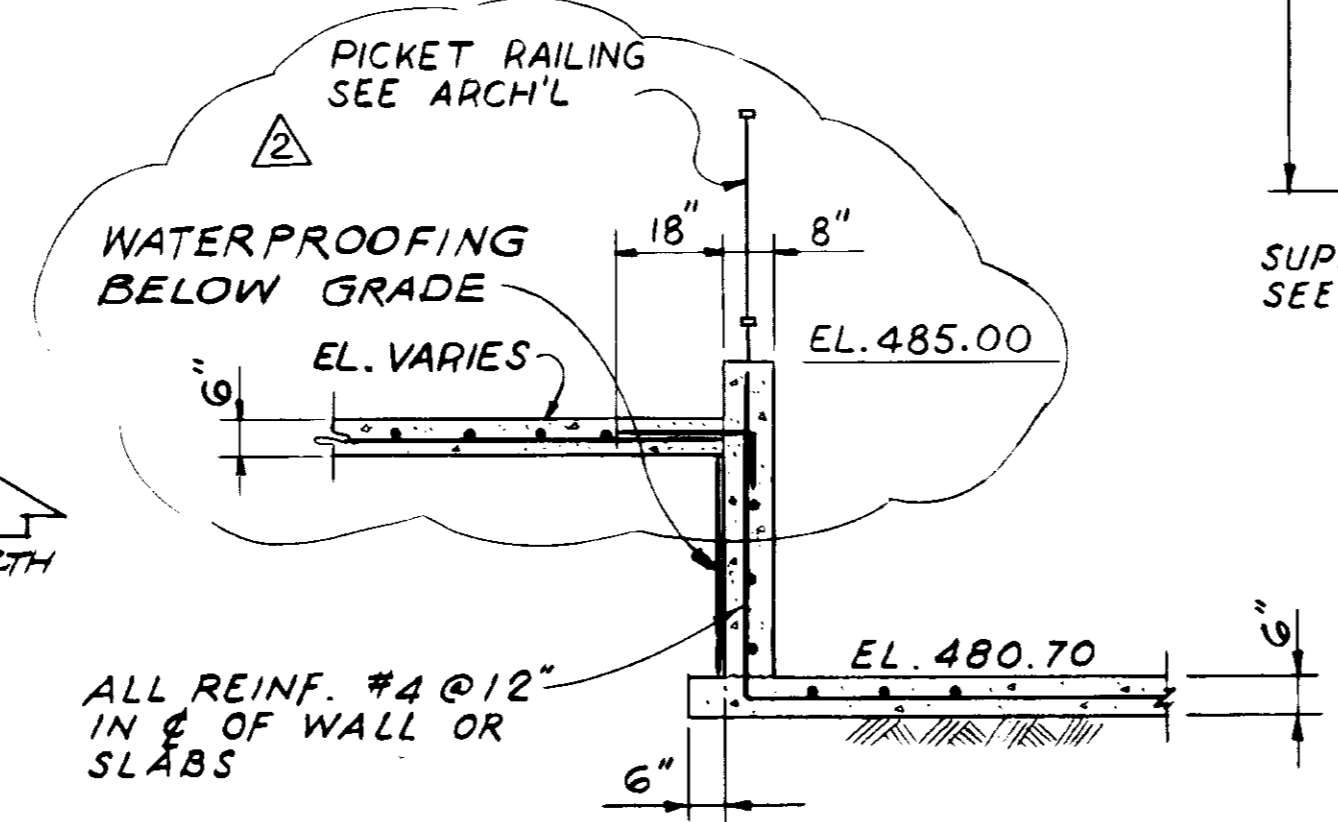

SECTION 7
SCALE: 3/8" = 1'-0"

375	4
JOB NO.	FRAM
IDENT. NO.	

SCALE: AS NOTED	DESIGNED: HDR	SUBMITTED: 27304 3/19/81
DRAWN: DWD	CHECKED: Raymond	R.C.E. NO. DATE
		27638 8/29/81
		R.C.E. NO. DATE


JAMES M. MONTGOMERY CONSULTING ENGINEERS, INC.
355 EAST WALNUT STREET, PARADENA, CALIFORNIA 91011

DISTRICT APPROVAL ON TITLE PAGE


PHASE II	LAS VIRGENES MWD/TRIUNFO CSD TAPIA WRF - FILTRATION/DISINFECTION ADDITION	SHEET 6S-1 OF 66 SHEETS
----------	--	-------------------------------

H D Rueb
STRUCTURAL ENGINEER
380 CIVIC DRIVE SUITE F
PLEASANT HILL, CA 94523
TELEPHONE (415) 826-8840
JOB NUMBER 2370


03585
RECORD DRAWING

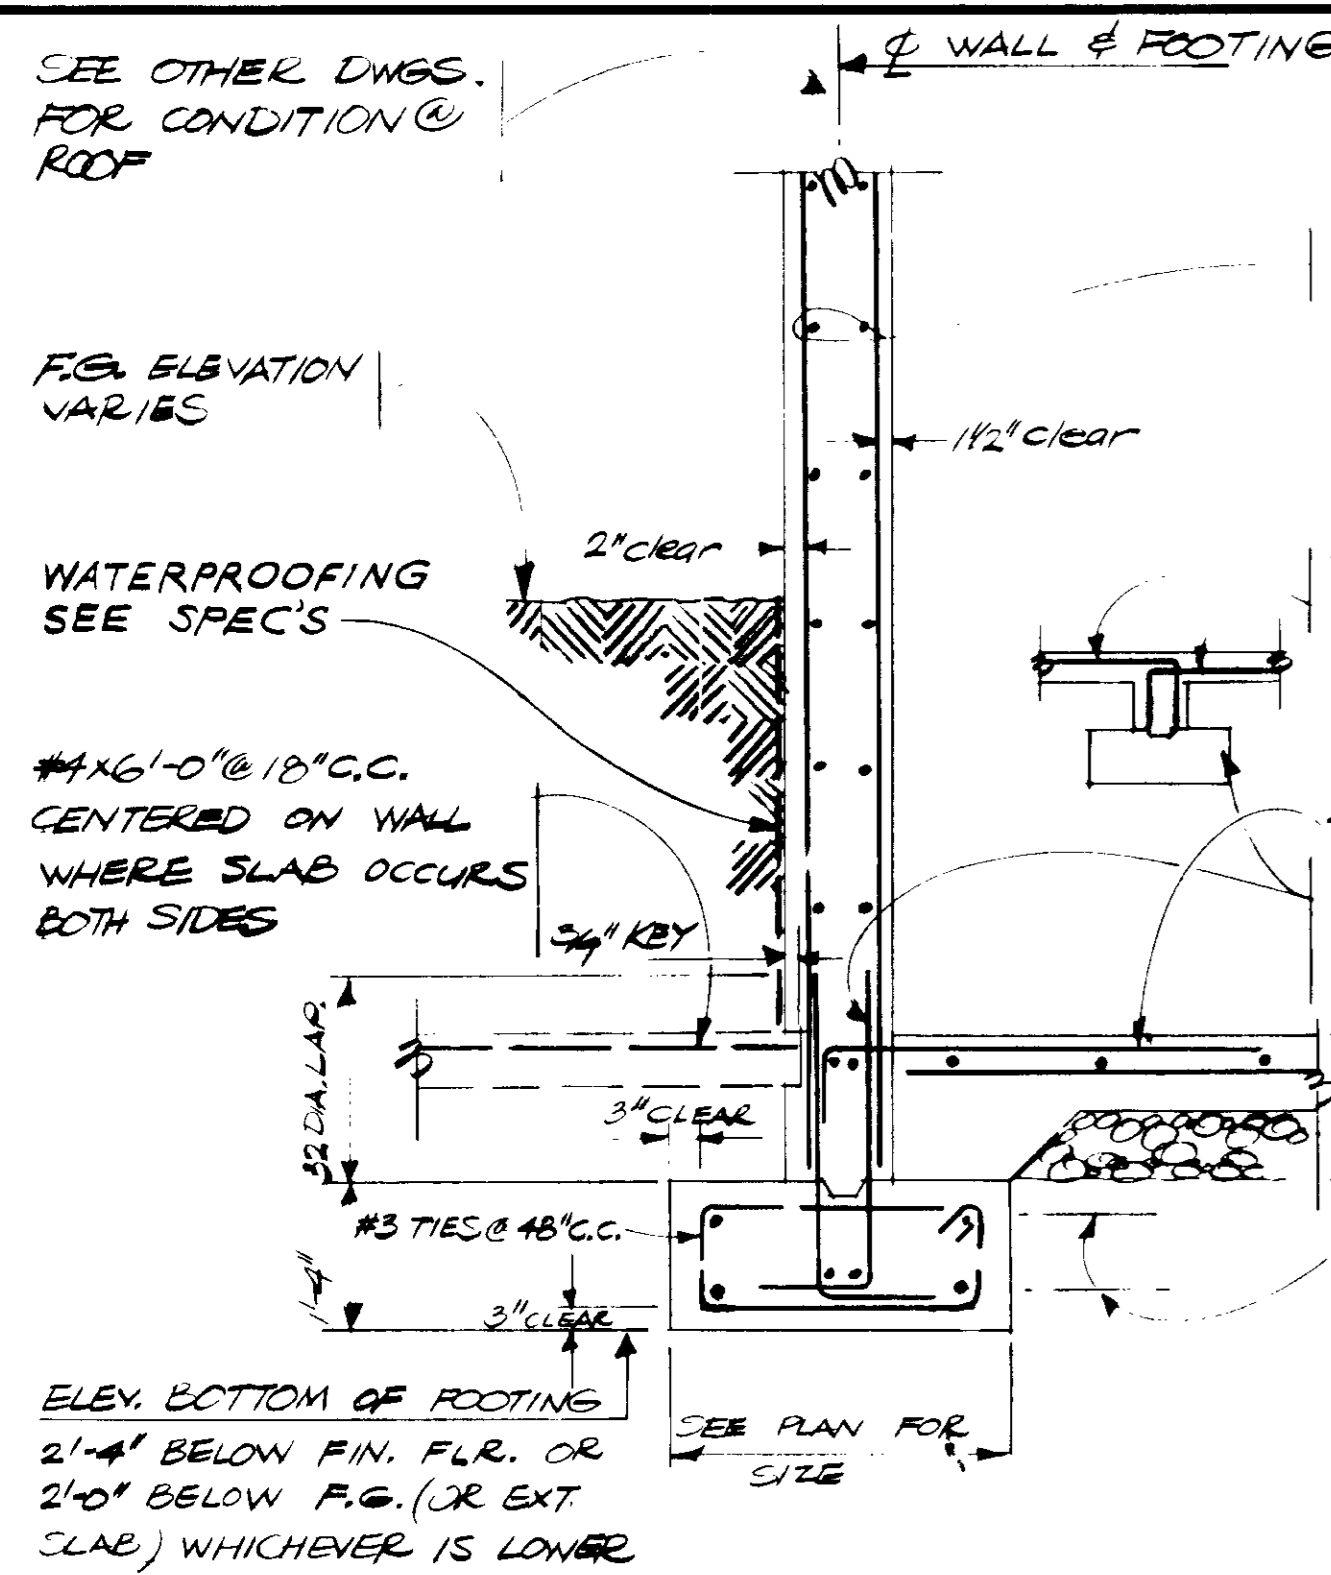


TYPICAL VERTICAL SECTION THRU WALL FOOTING & SLAB SCALE 3/4\" = 1'-0\"

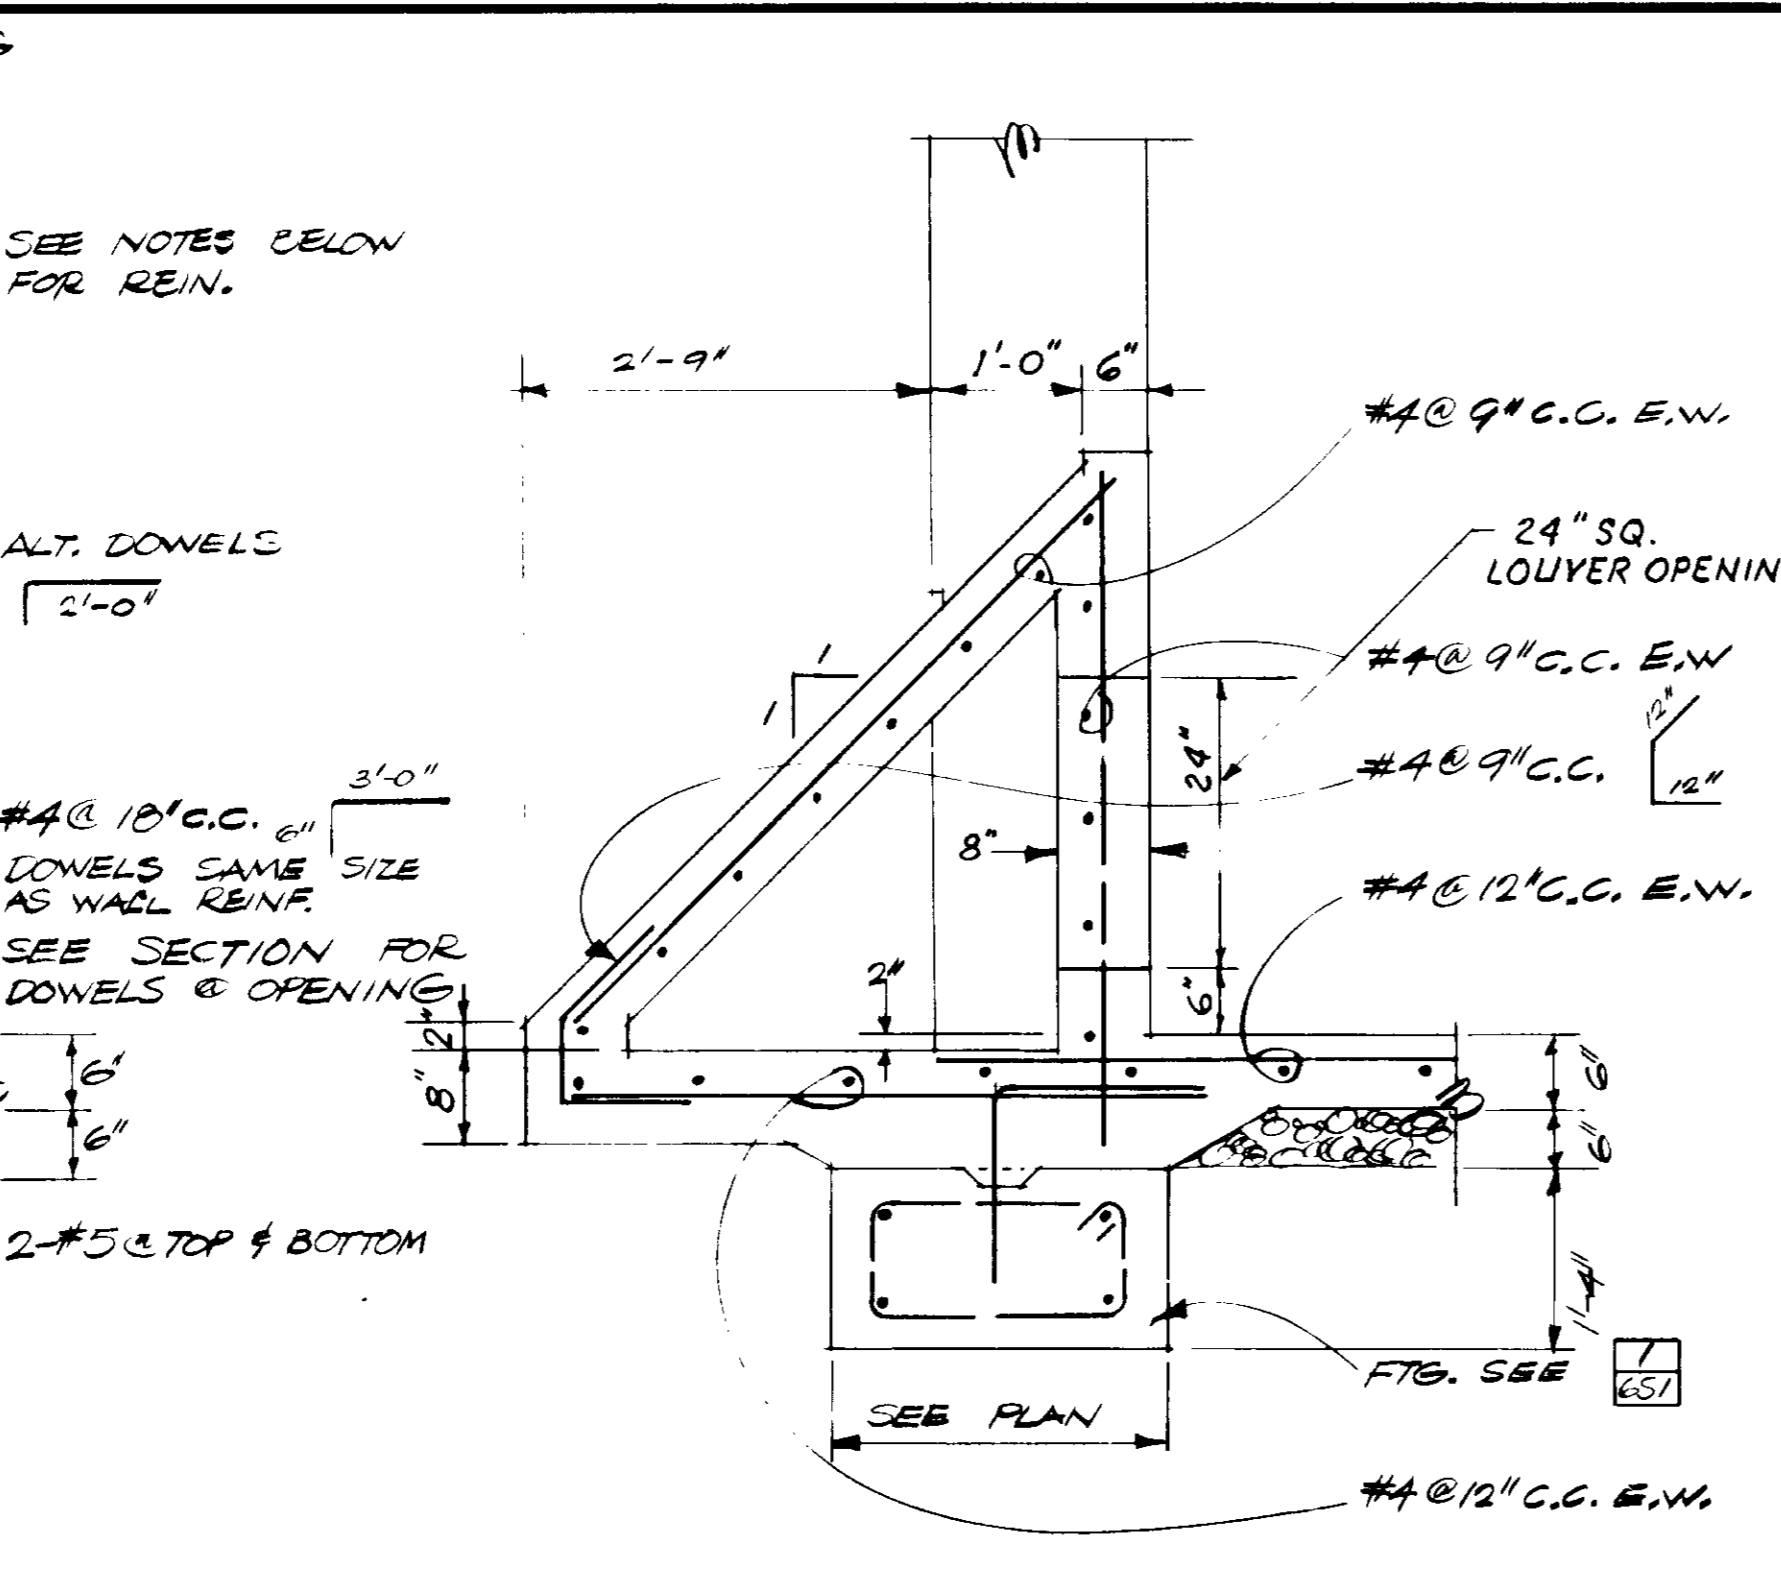

SECTION 2 SCALE 3/4\" = 1'-0\"

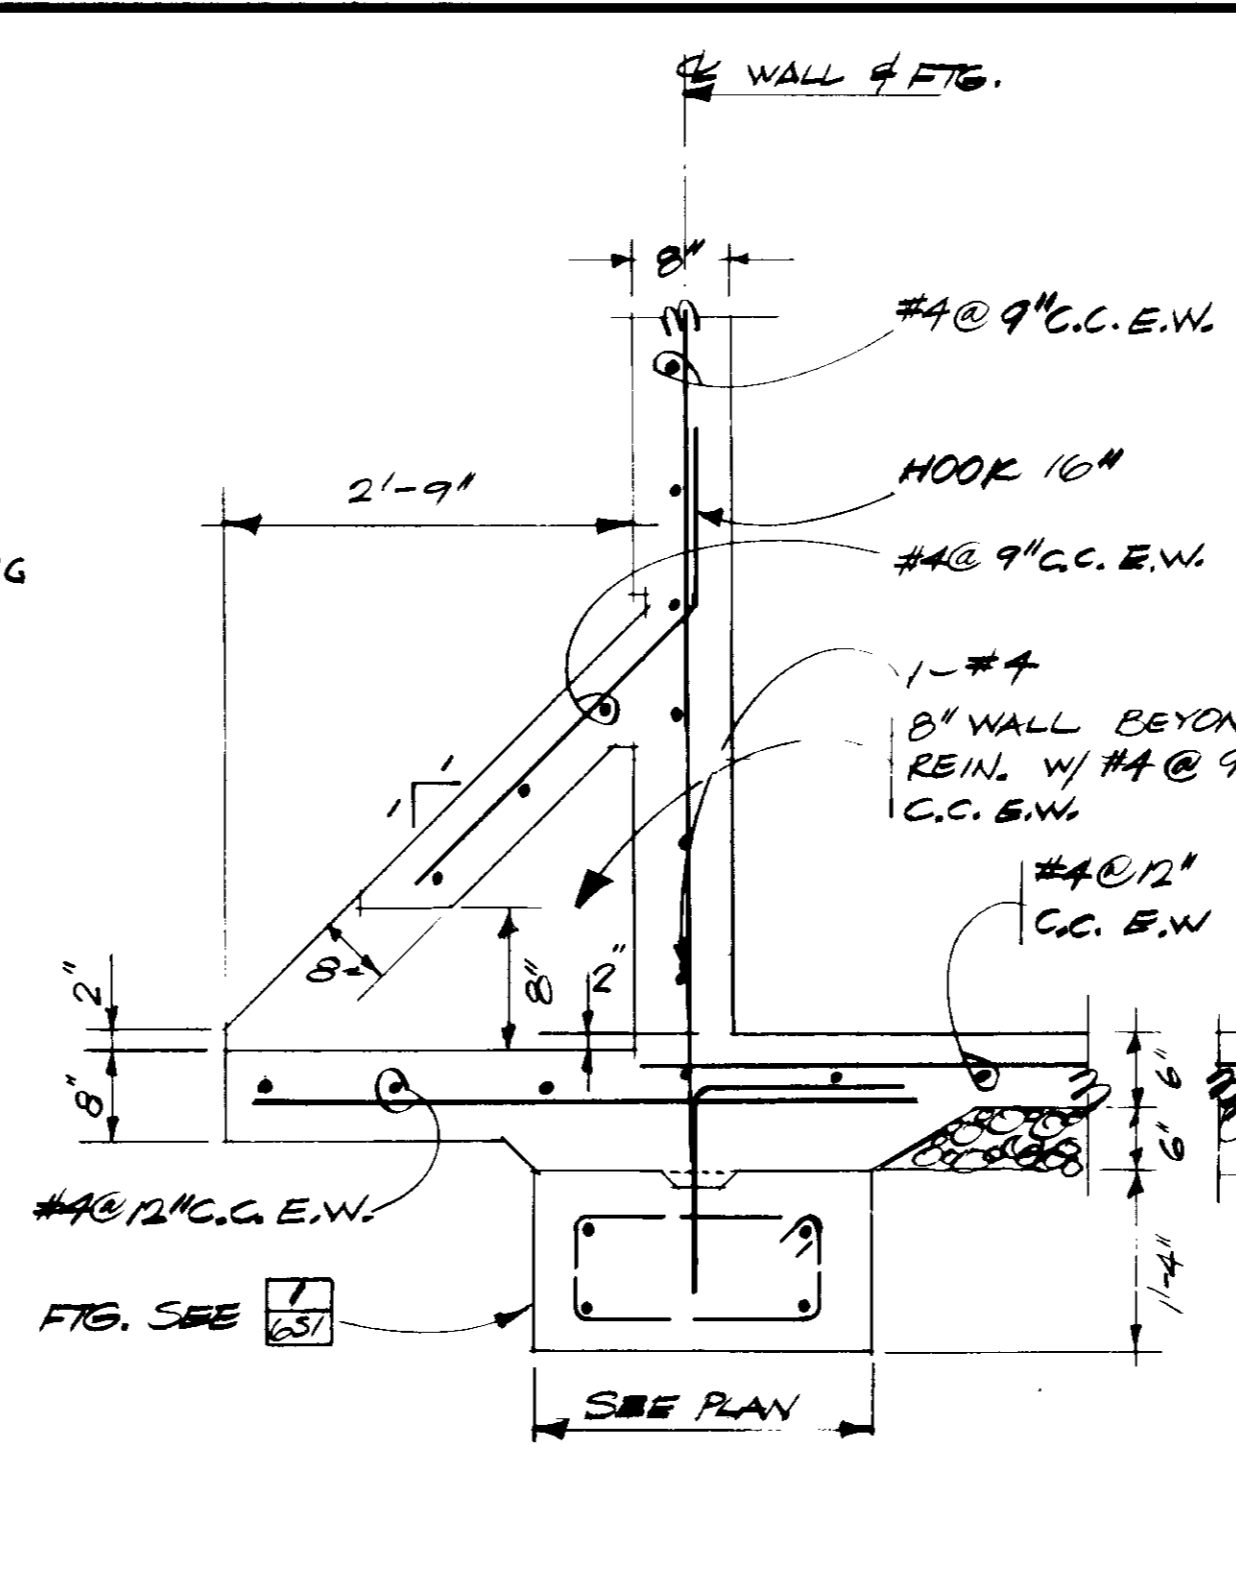


SECTION 3 SCALE 3/4\" = 1'-0\"

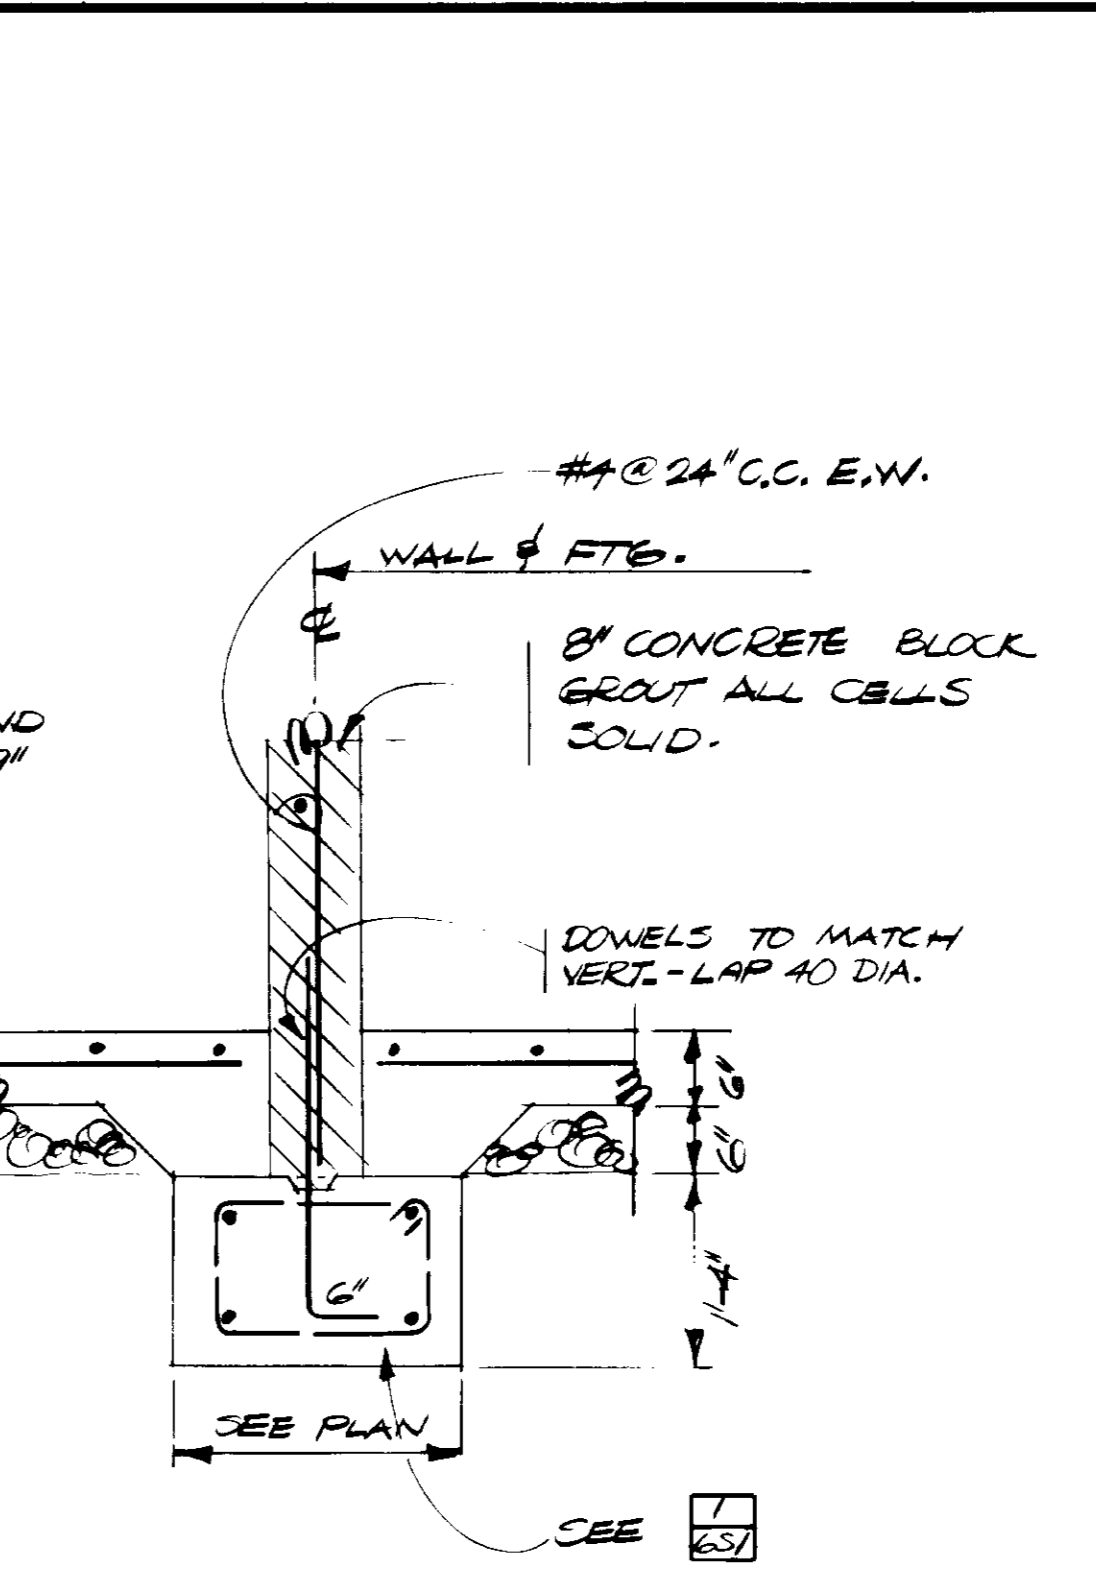


SECTION 4 SCALE 3/4\" = 1'-0\"


- 1. EXTERIOR DOUBLE CURTAIN WALL SHOWN, SINGLE CURTAIN WALL SIM.
- 2. TYR WALL REIN. SHALL BE AS FOLLOWS:
 - 8\" WALL - #4 @ 9\" C.C. E.W. @ CENTER OF WALL (VERT. REIN. @ 2').
 - 10\" WALL - #4 @ 16\" C.C. E.W. EA. FACE.
 - 12\" WALL - #4 @ 12\" C.C. E.W. EA. FACE.

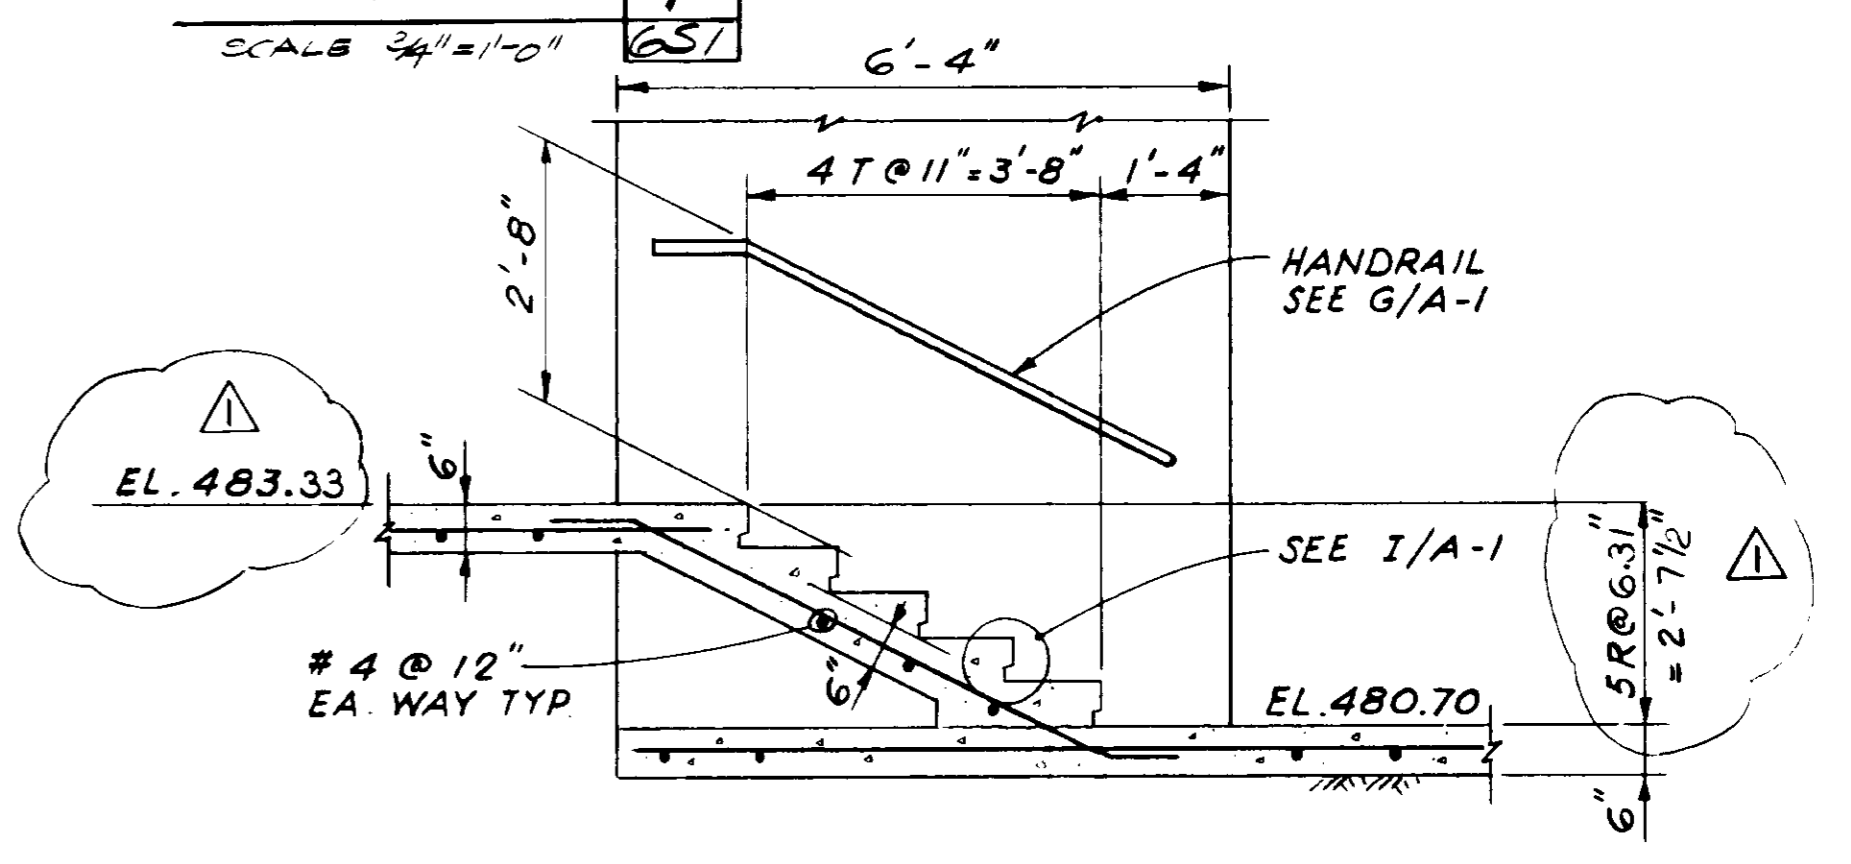


SECTION 5 SCALE: 1/2\" = 1'-0\"

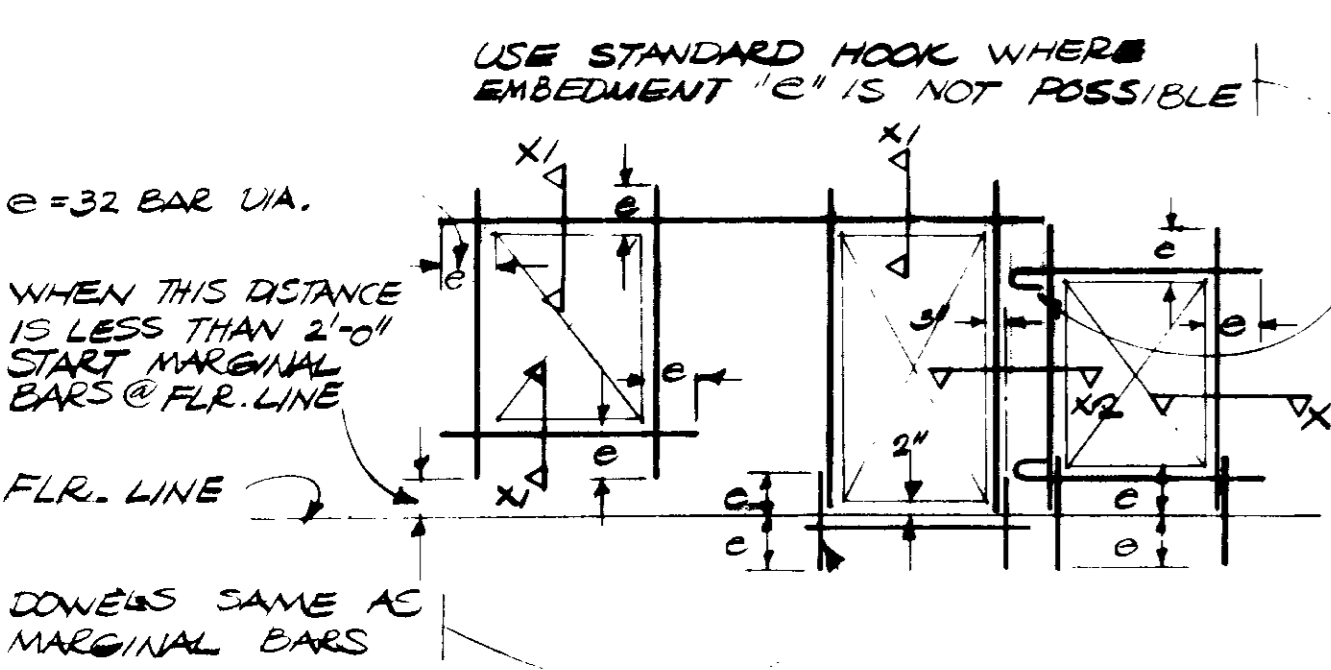

TYPICAL WALL OPENING REINFORCEMENT

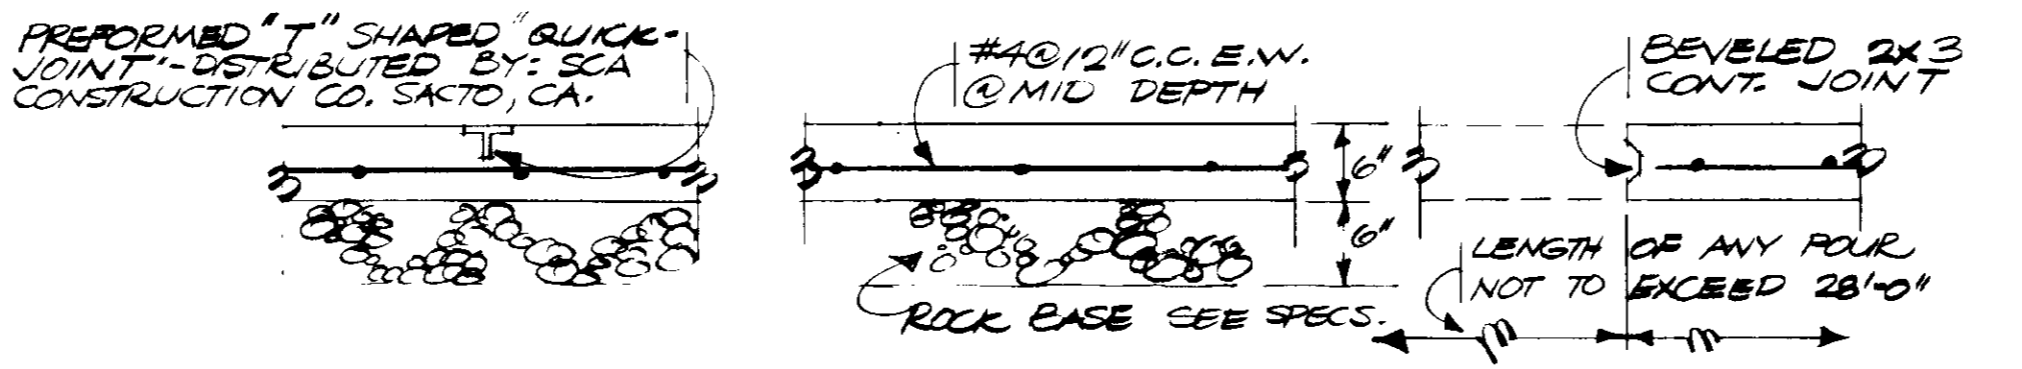


AT CONTROL JOINTS TYP. SLABS AT CONSTRUCTION JOINTS CONCRETE SLAB ON GROUND DETAILS

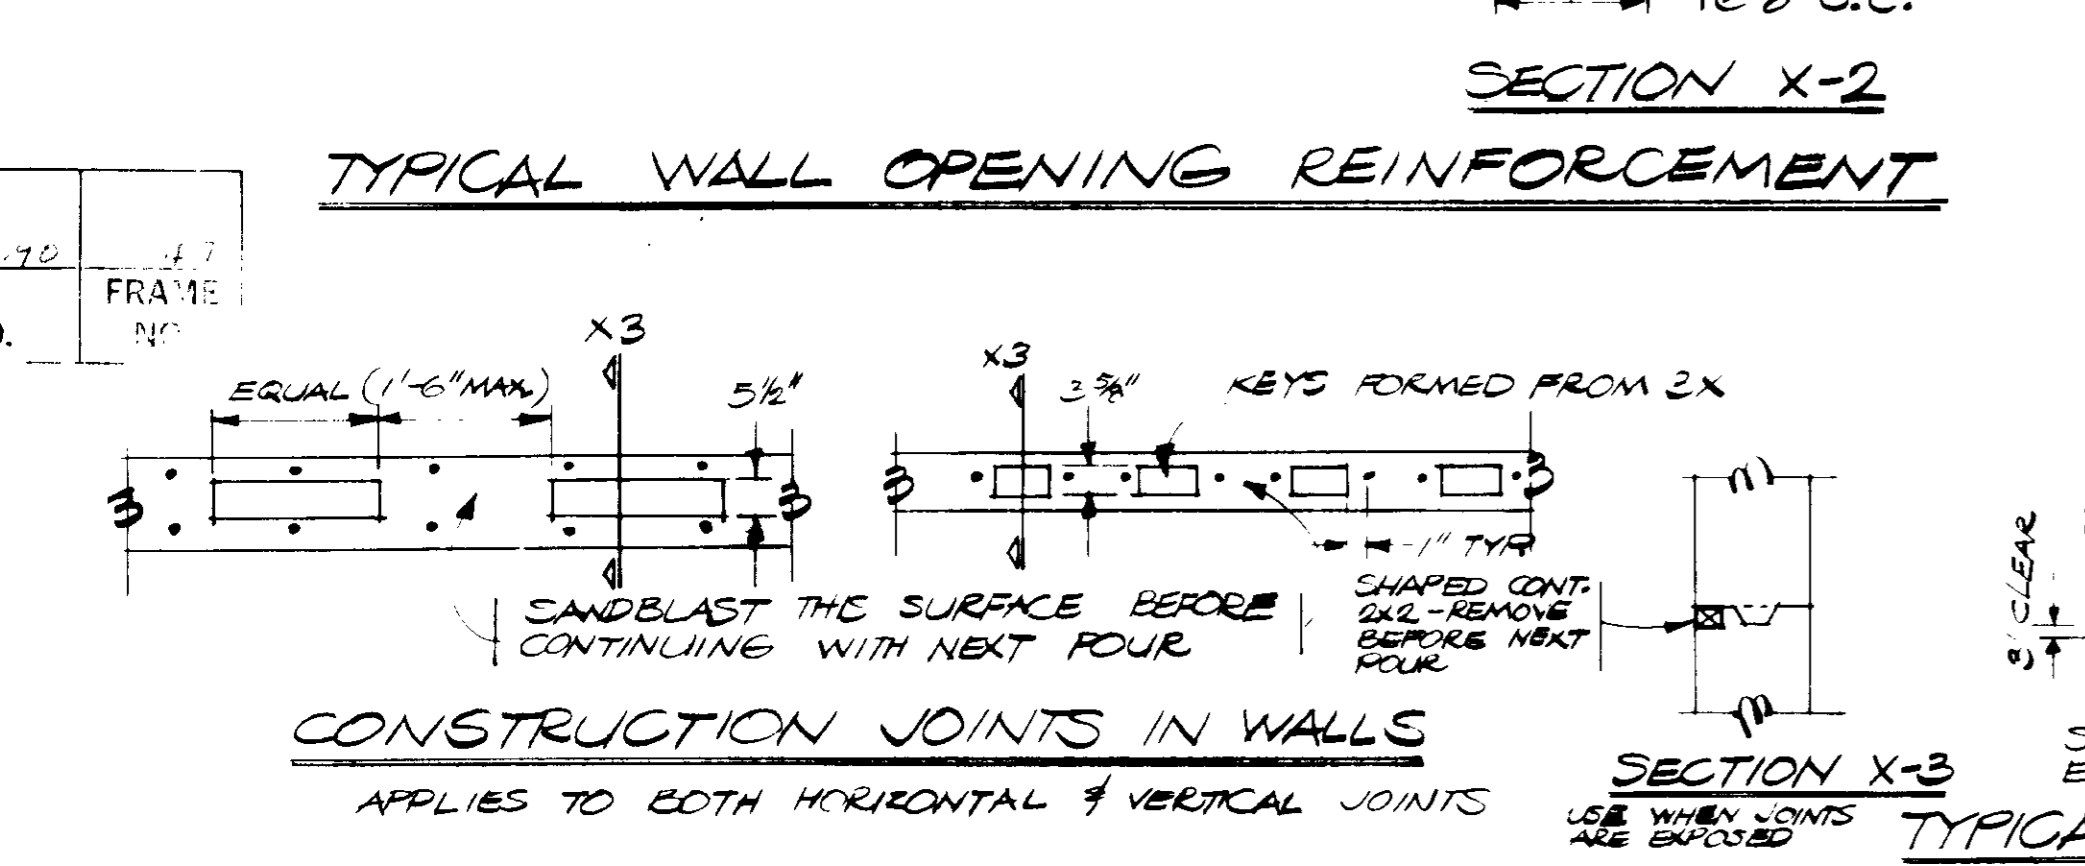

CONSTRUCTION JOINTS IN WALLS APPLIES TO BOTH HORIZONTAL & VERTICAL JOINTS

TYPICAL STEPS IN WALL FOOTING

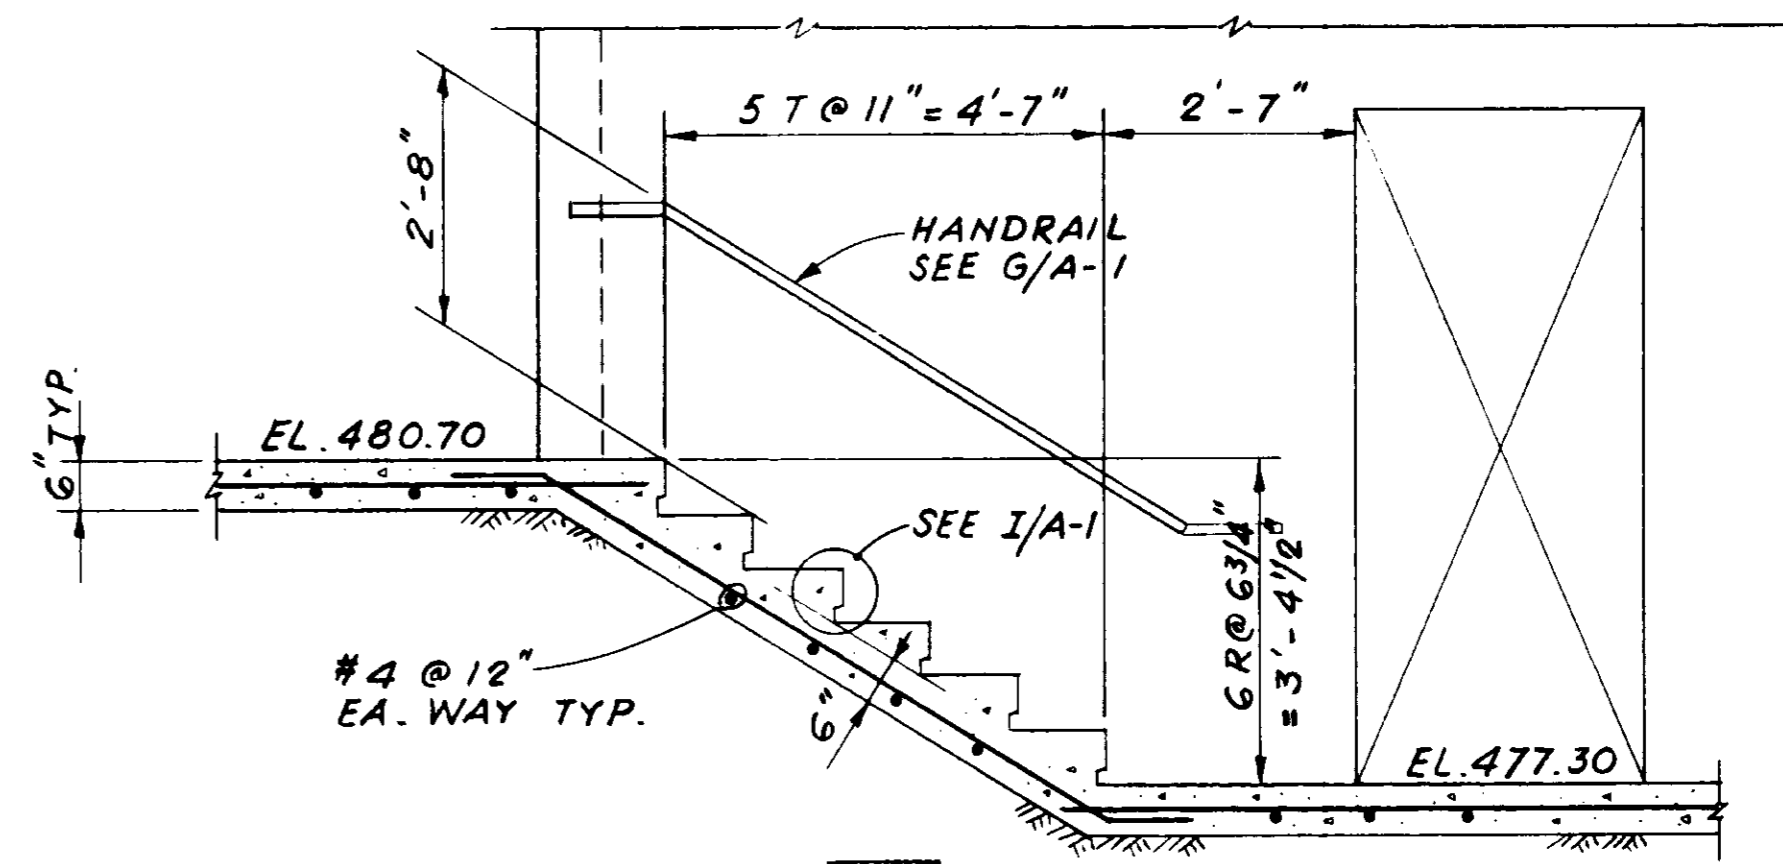

SECTION 6 SCALE: 1/2\" = 1'-0\"

RECORD DRAWING

03586
H D Rueb
 STRUCTURAL ENGINEER
 380 CIVIC DRIVE SUITE F
 PLEASANT HILL, CA 94623
 TELEPHONE (415) 825-8540
 JOB NUMBER 220




SCALE: NOT TO SCALE EXCEPT AS NOTED	DESIGNED: HDR	SUBMITTED: 27034 8/19/81
DRWN: DMD	CHECKED: [Signature]	PROJECT ENGINEER: [Signature] R.C.E. NO. DATE
REVISIONS: 1. 11-82 PR. CLARIFICATION		RECOMMENDED: 27638 8/20/81
		JAMES M. MONTGOMERY CONSULTING ENGINEERS, INC. R.C.E. NO. DATE

JAMES M. MONTGOMERY CONSULTING ENGINEERS, INC.
 555 EAST WALNUT STREET, PASADENA, CALIFORNIA 91101

DISTRICT APPROVAL ON TITLE PAGE

LAS VIRGENES MWD/TRIUNFO CSD
 TAPIA WRF - FILTRATION/DISINFECTION ADDITION
 PHASE I
 CHEMICAL BUILDING - MISCELLANEOUS WALL SECTIONS AND DETAILS

SHEET
6S-2
 OF 6 SHEETS

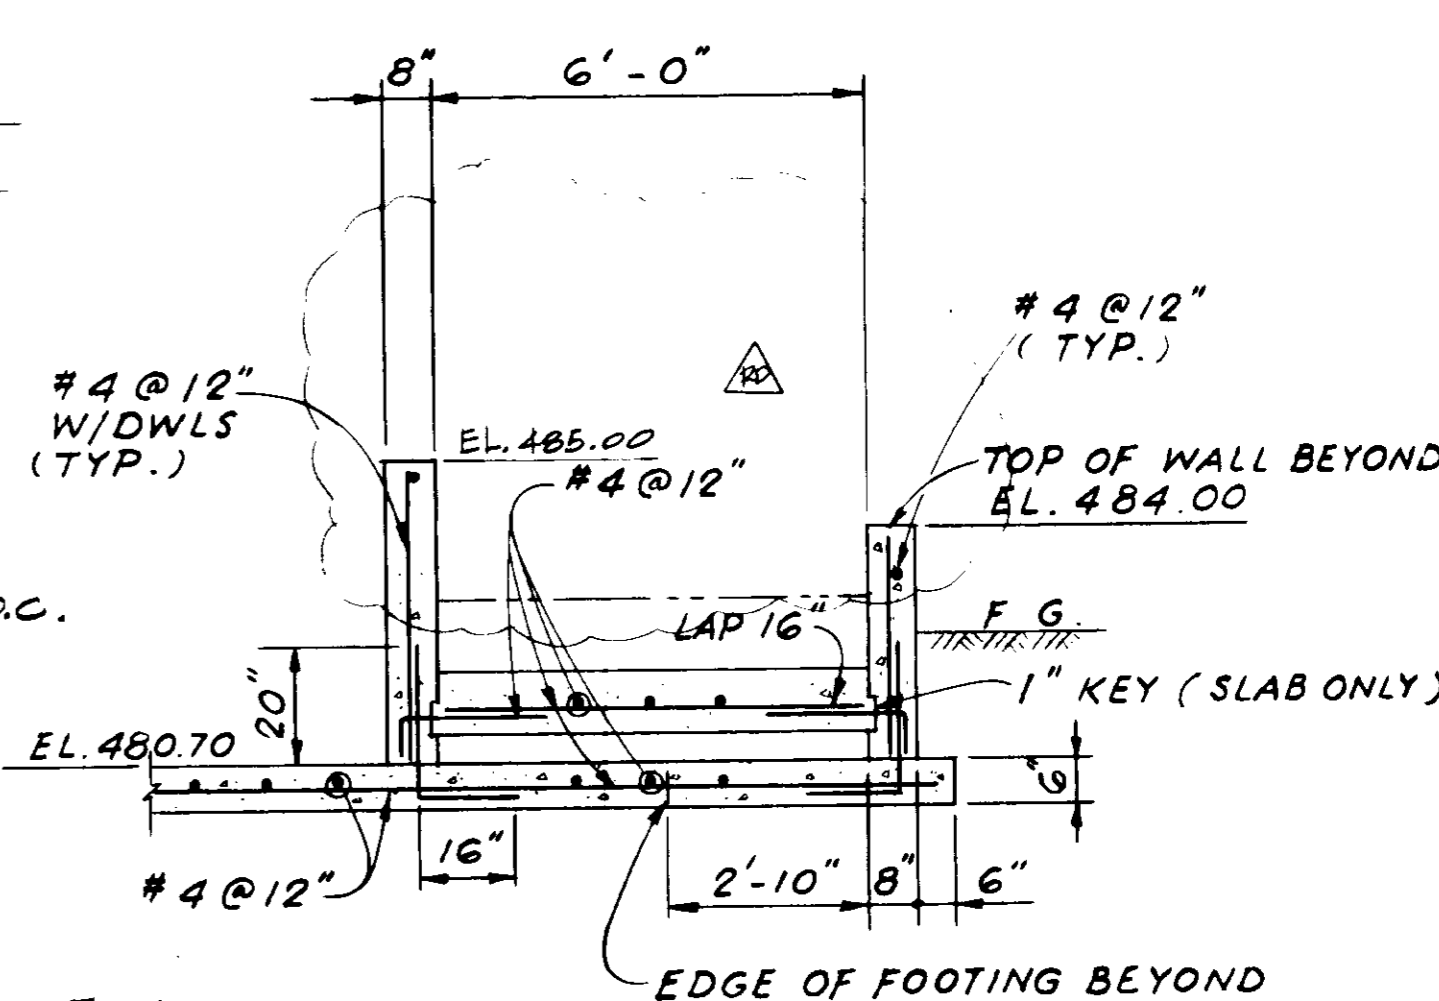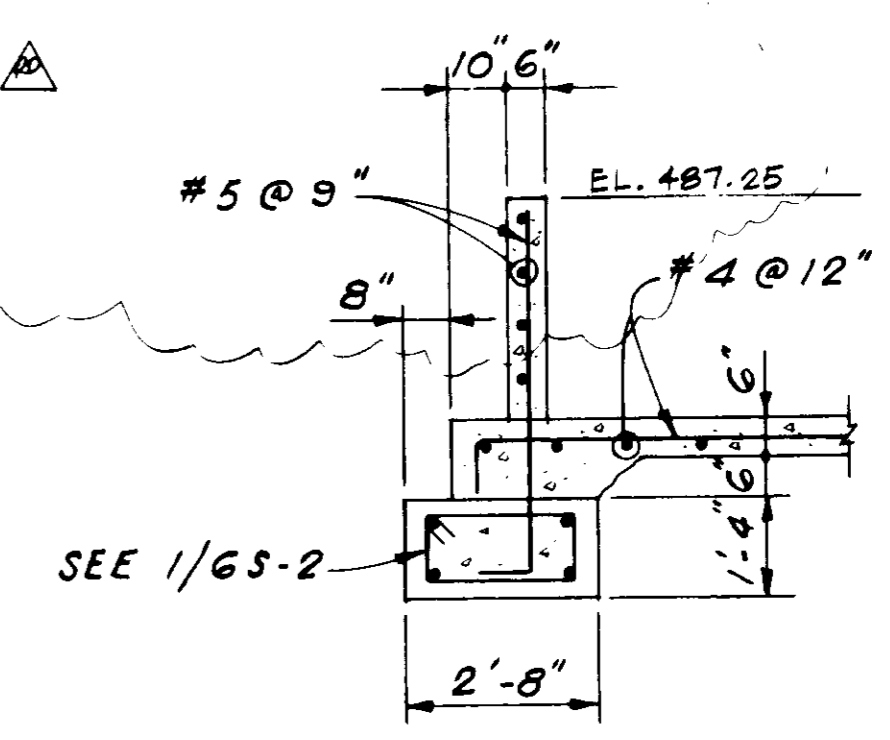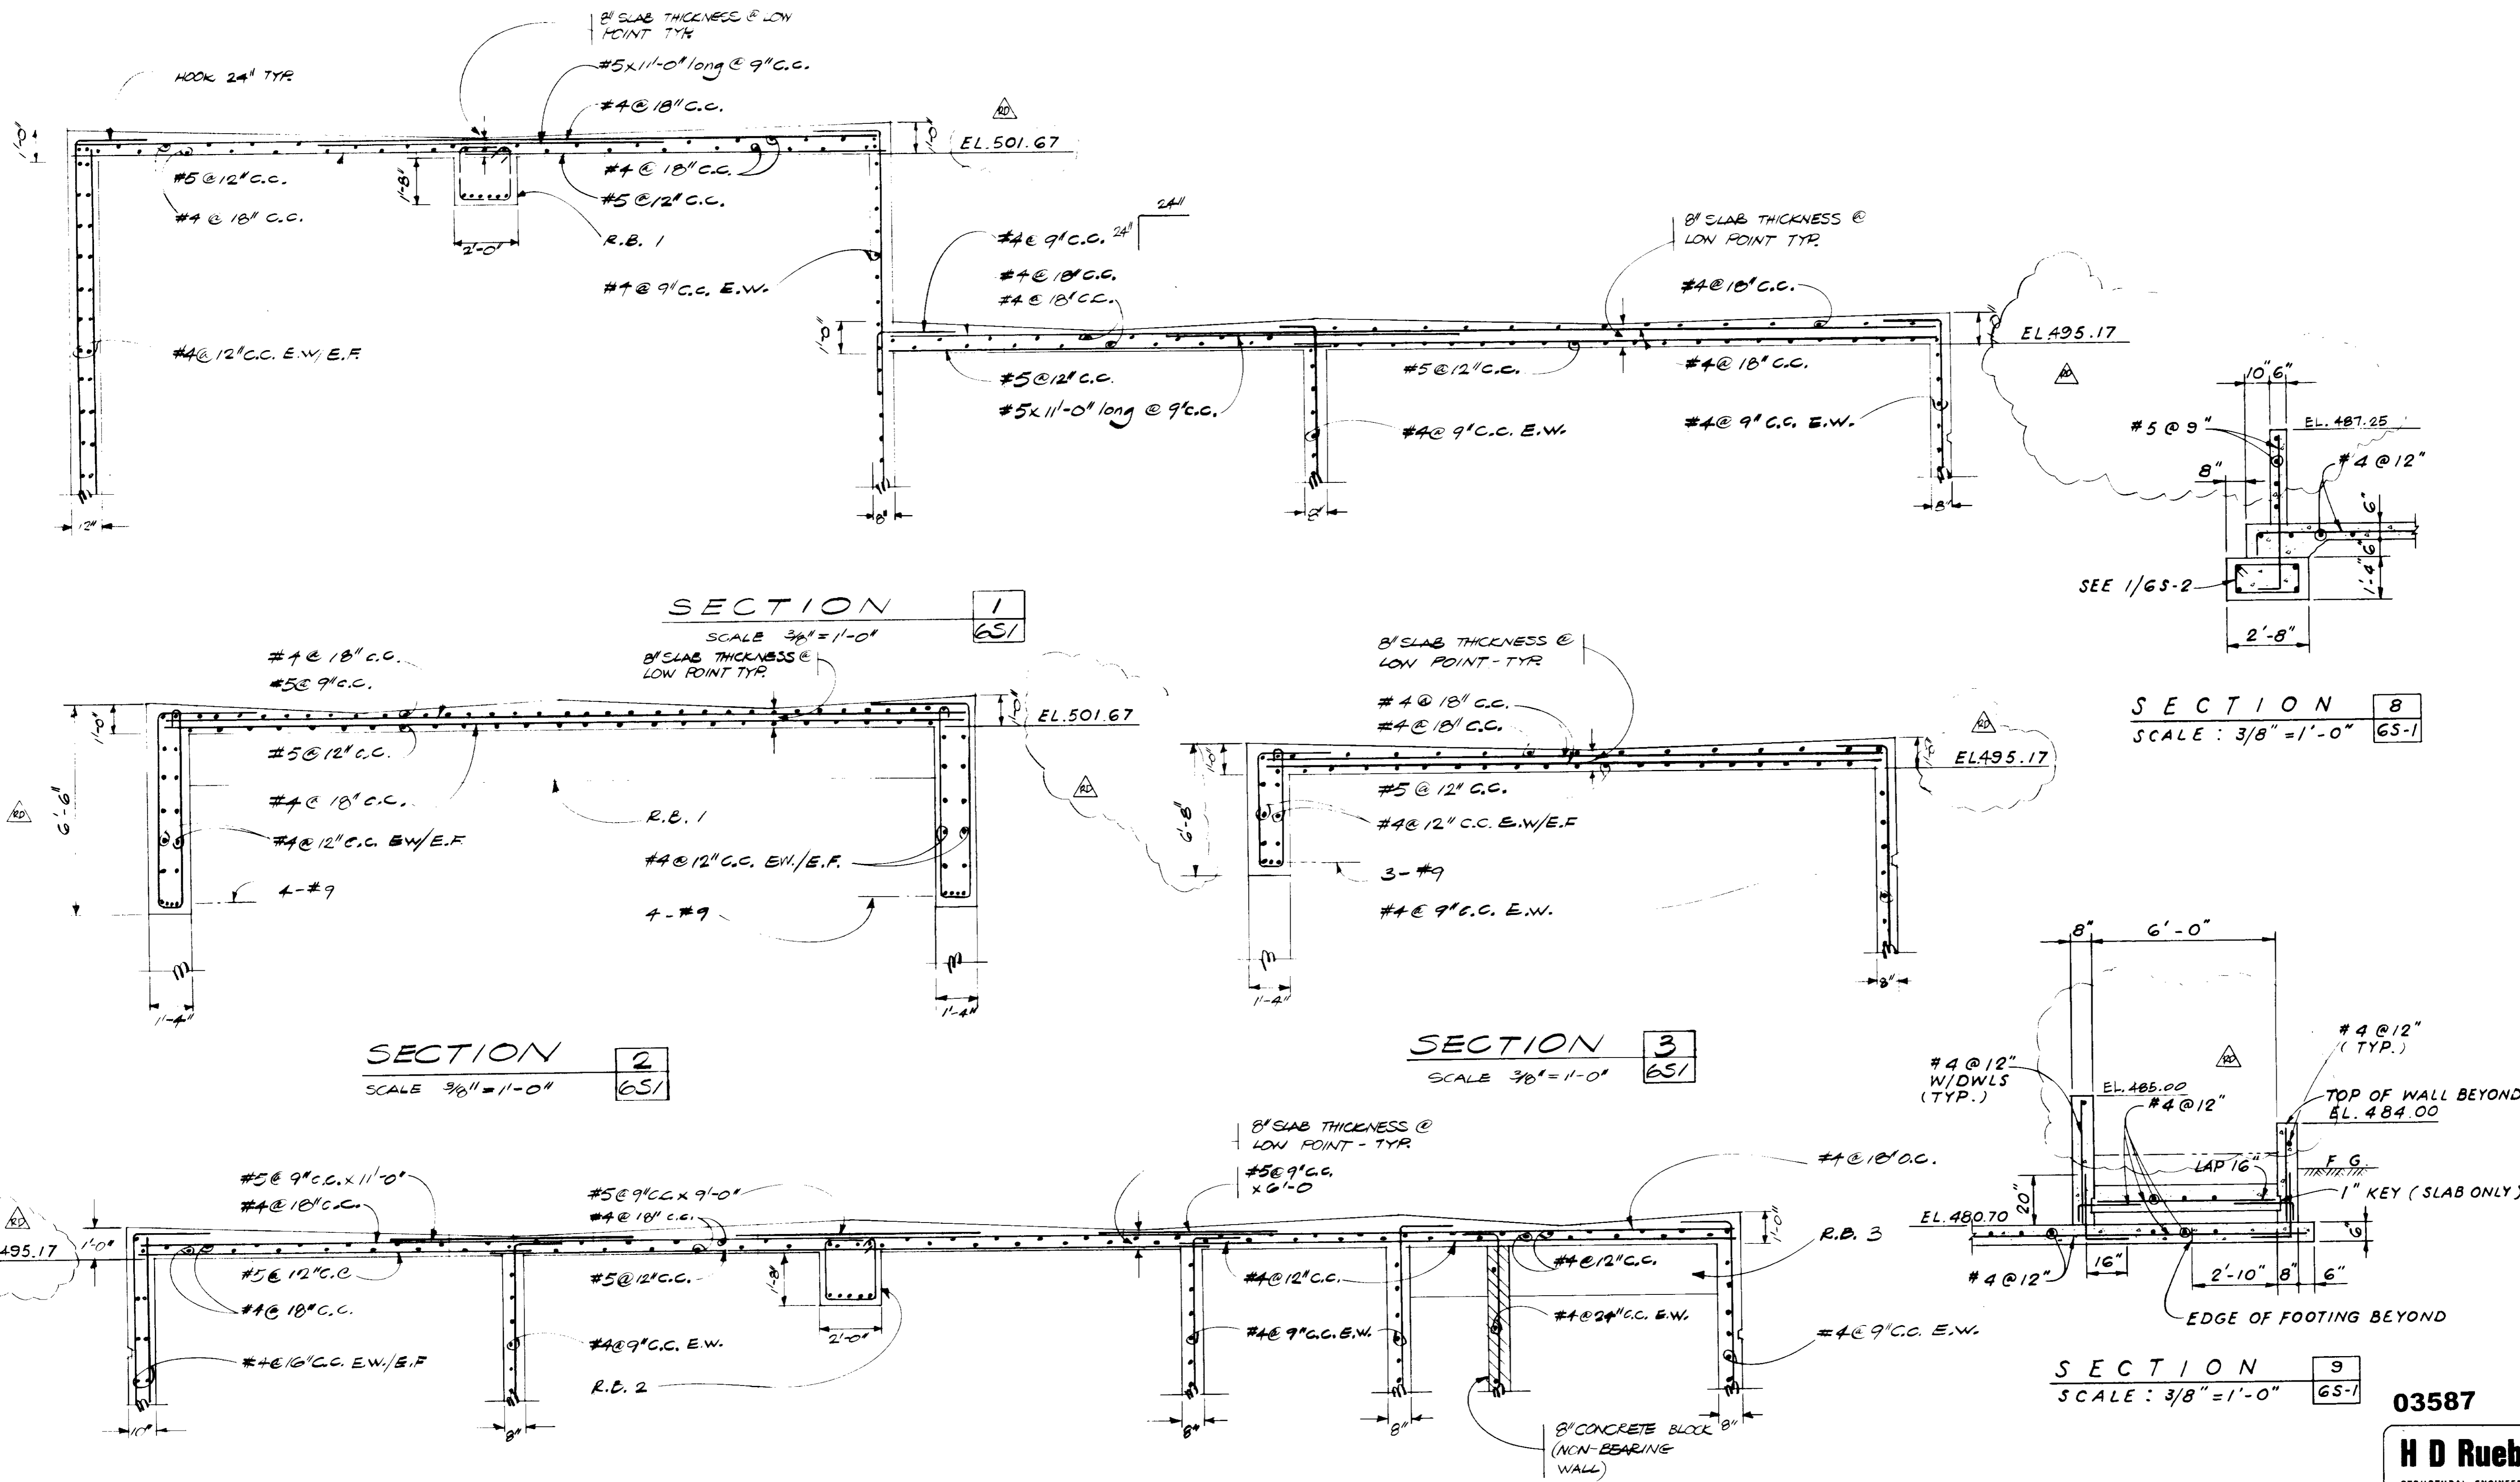

JOB NO. FRA
IDENT. NO.

SECTION 4
SCALE 3/8" = 1'-0"

SECTION 9
SCALE 3/8" = 1'-0"

03587
H D Rueb
STRUCTURAL ENGINEER
300 CIVIC DRIVE SUITE F
PLEASANT HILL CA 94523
TELEPHONE (415) 825-9540
JOB NUMBER 2210

RECORD DRAWING

RD 4/11/84	MDU	RECORD DRAWING
REV	DATE	DESCRIPTION

SCALE: AS NOTED
DESIGNED: HDR
DRAWN: DML
CHECKED: [Signature]


SUBMITTED: [Signature]
PROJECT ENGINEER
R.C.E. NO. 27304
DATE 8/19/81
R.C.E. NO. 27638
DATE 8/20/81

JAMES M. MONTGOMERY CONSULTING ENGINEERS, INC.
555 EAST WALNUT STREET, PASADENA, CALIFORNIA 91101

DISTRICT APPROVAL ON TITLE PAGE


LAS VIRGENES MWD/TRIUNFO CSD
TAPIA WRF - FILTRATION/DISINFECTION ADDITION
PHASE II
CHEMICAL BUILDING - WALLS AND ROOF SLAB SECTIONS

SHEET
6 S-3
OF 66 SHEETS

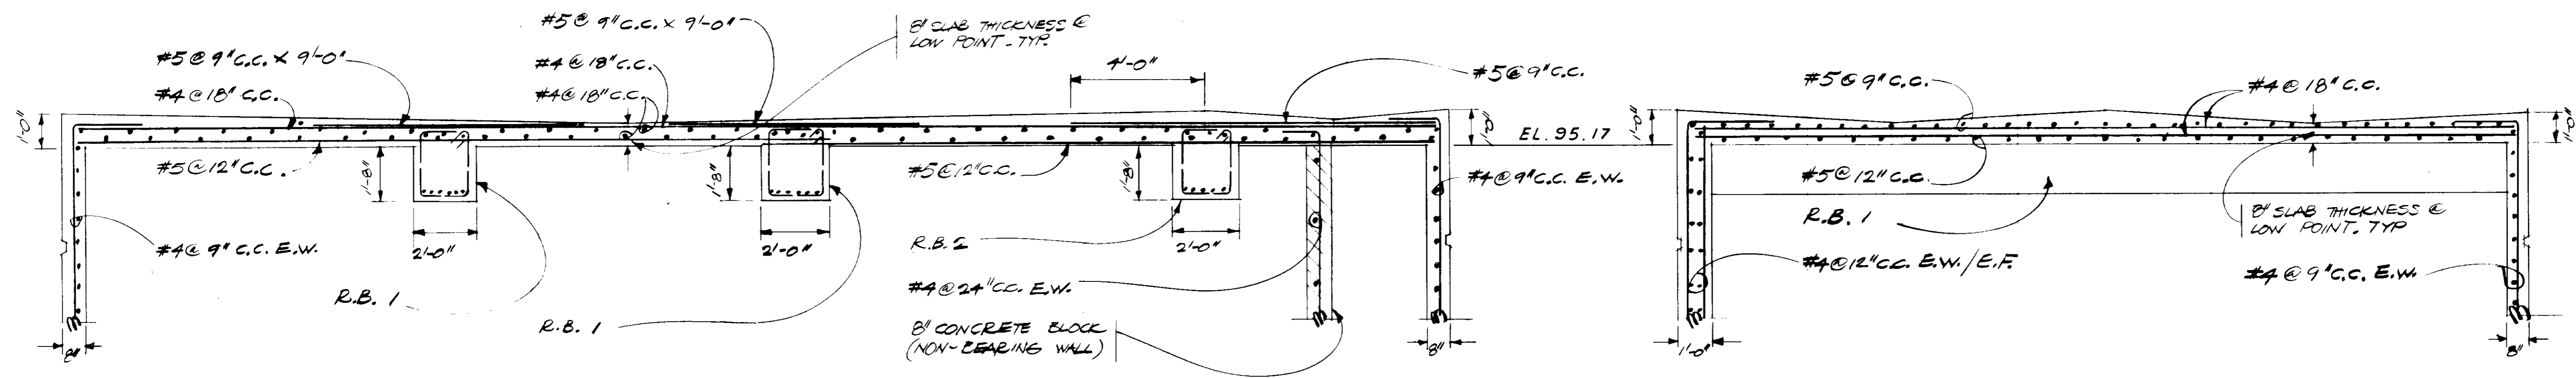


SECTION 1
SCALE 3/8"=1'-0" 6S-1


SECTION 2
SCALE 3/8"=1'-0" 6S-1

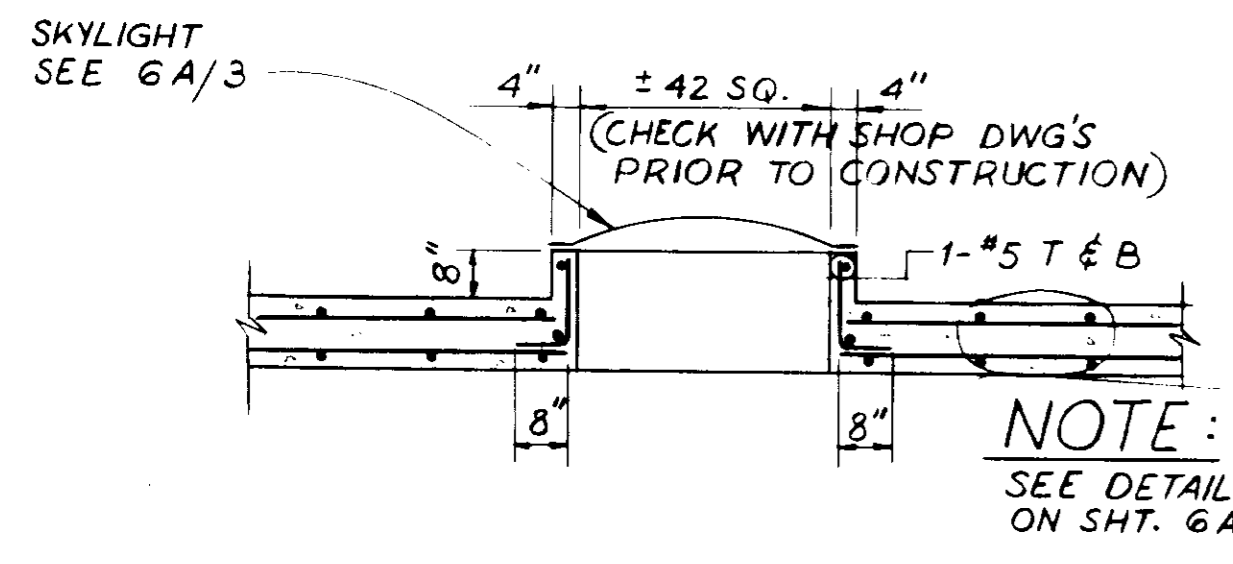

SECTION 3
SCALE 3/8"=1'-0" 6S-1

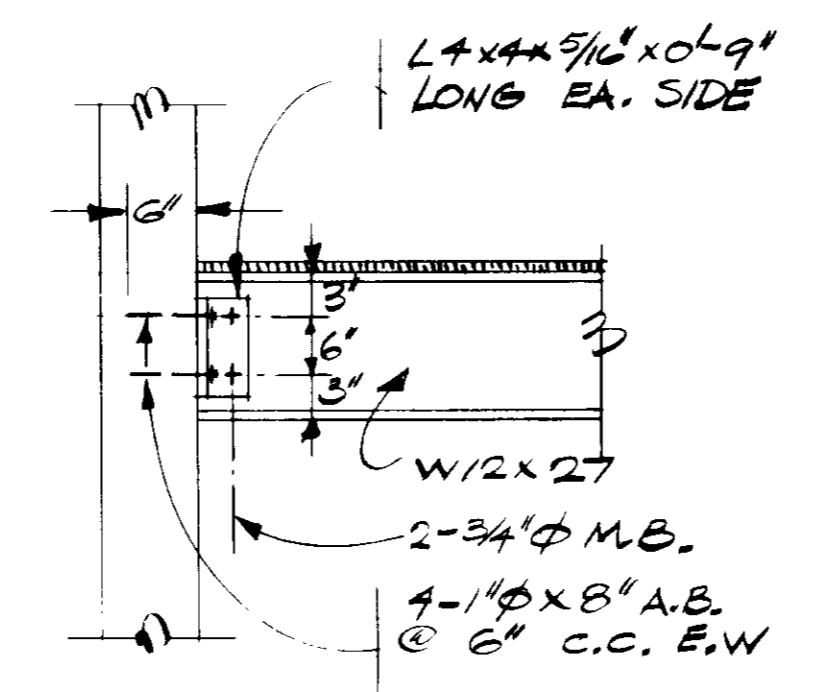


SECTION 4
SCALE 3/4"=1'-0" -

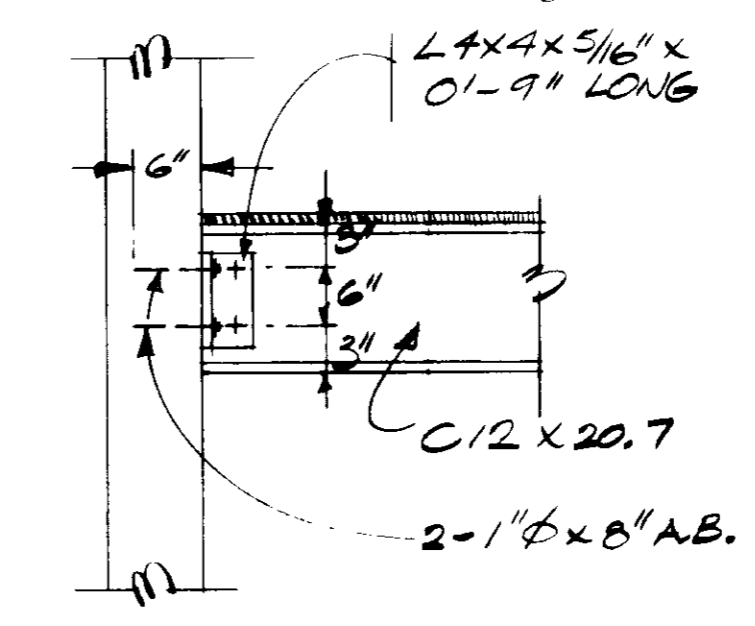


SECTION 5
SCALE 3/4"=1'-0" -


EL. 493.75 G-T-1 AND G-T-2
EL. 486.75 G-T-3 AND G-T-4 } SEE GM-1

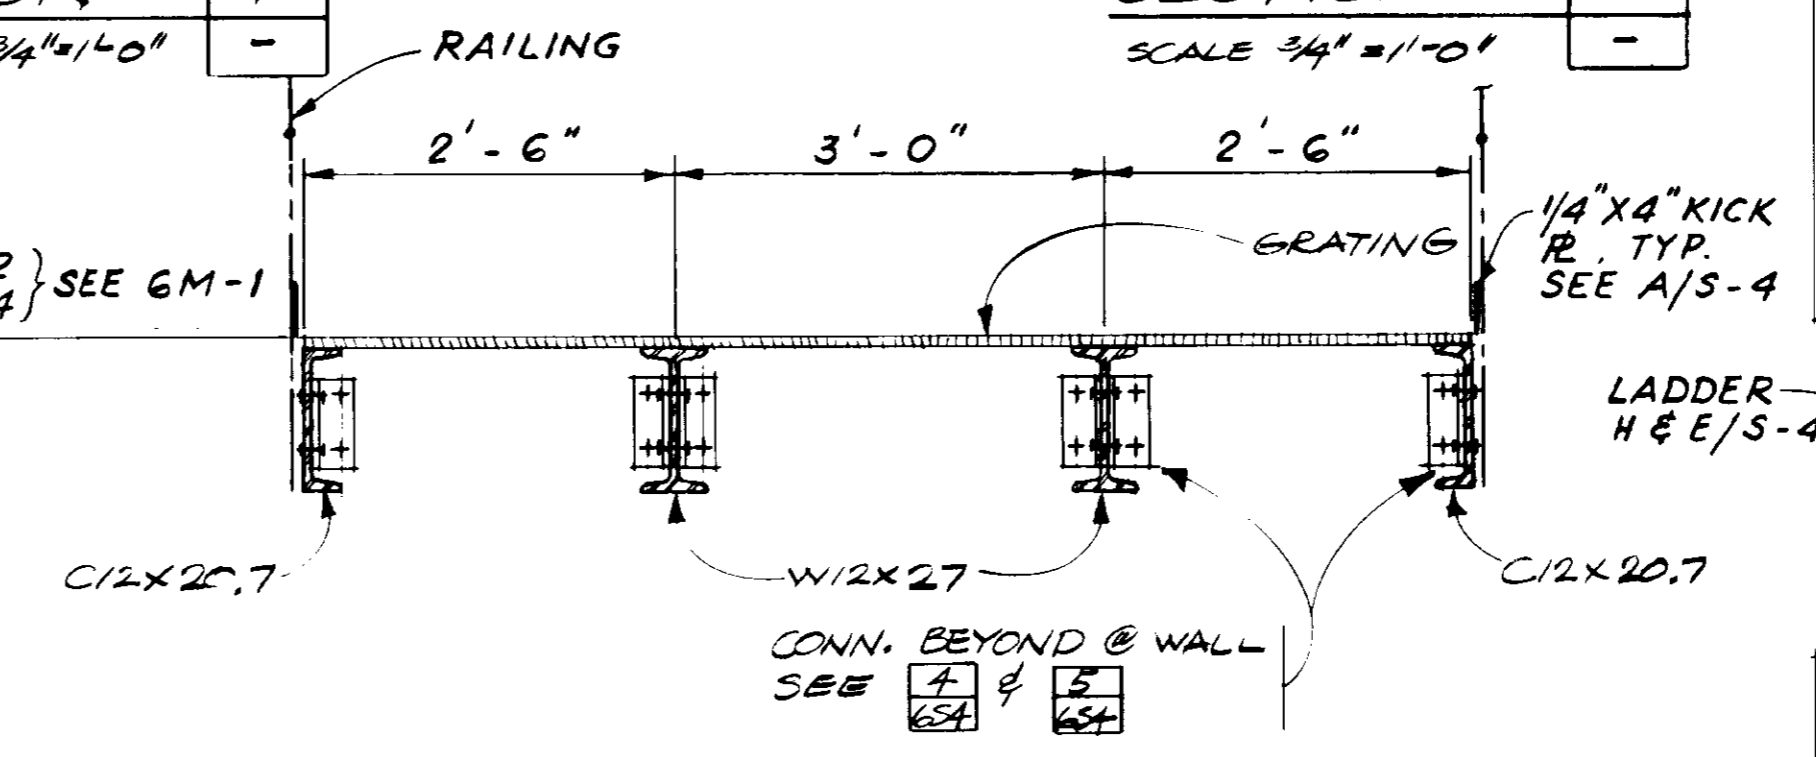


SECTION 6
SCALE 3/4"=1'-0" -

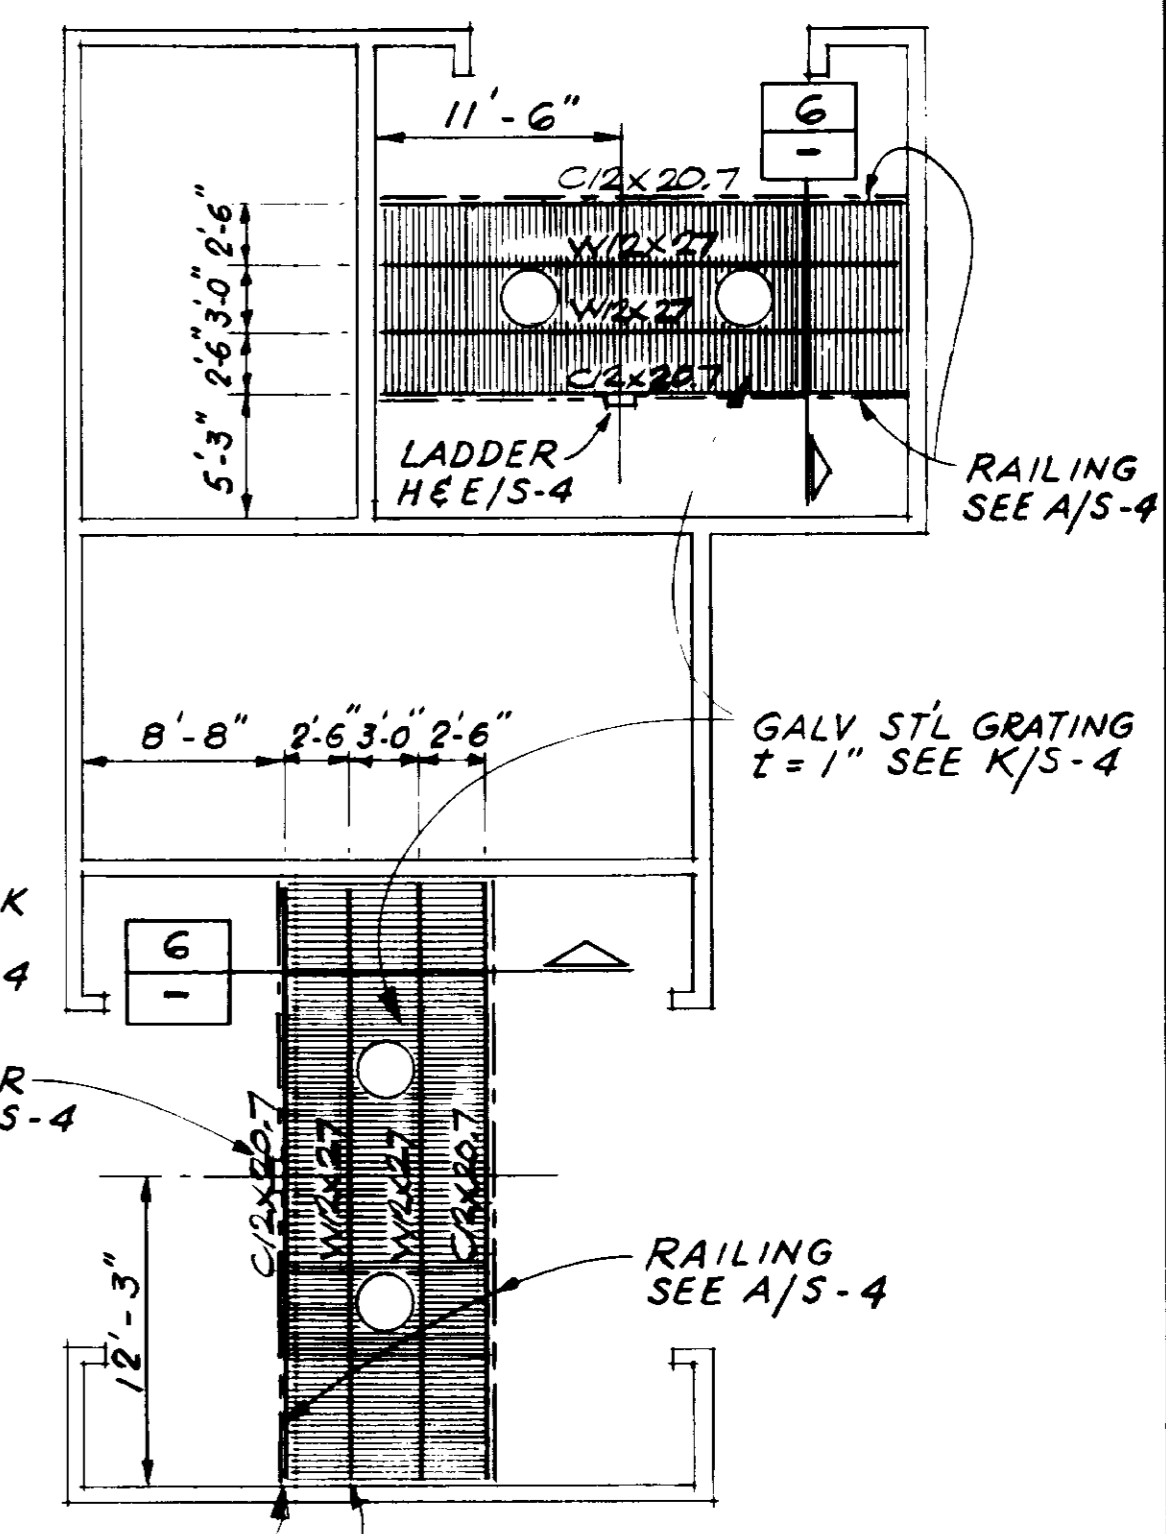

PLATFORM FRAMING PLANS
SCALE 1/8"=1'-0"

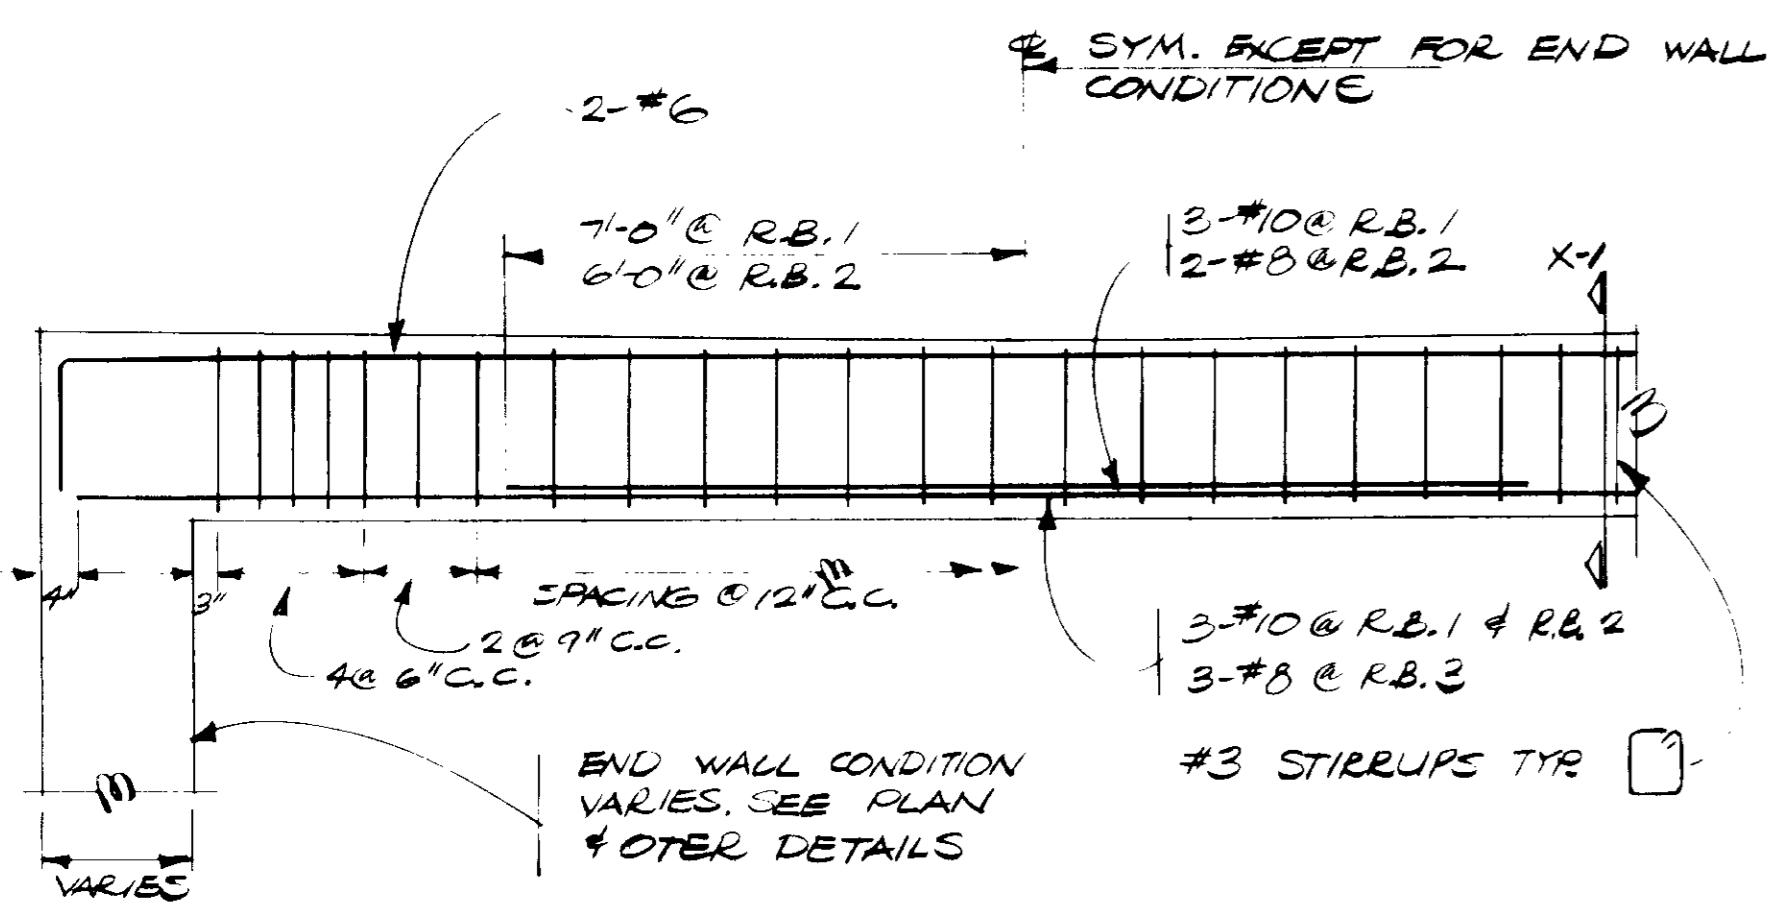

BEAM RB.1, RB.2 & RB.3
SCALE 3/8"=1'-0"









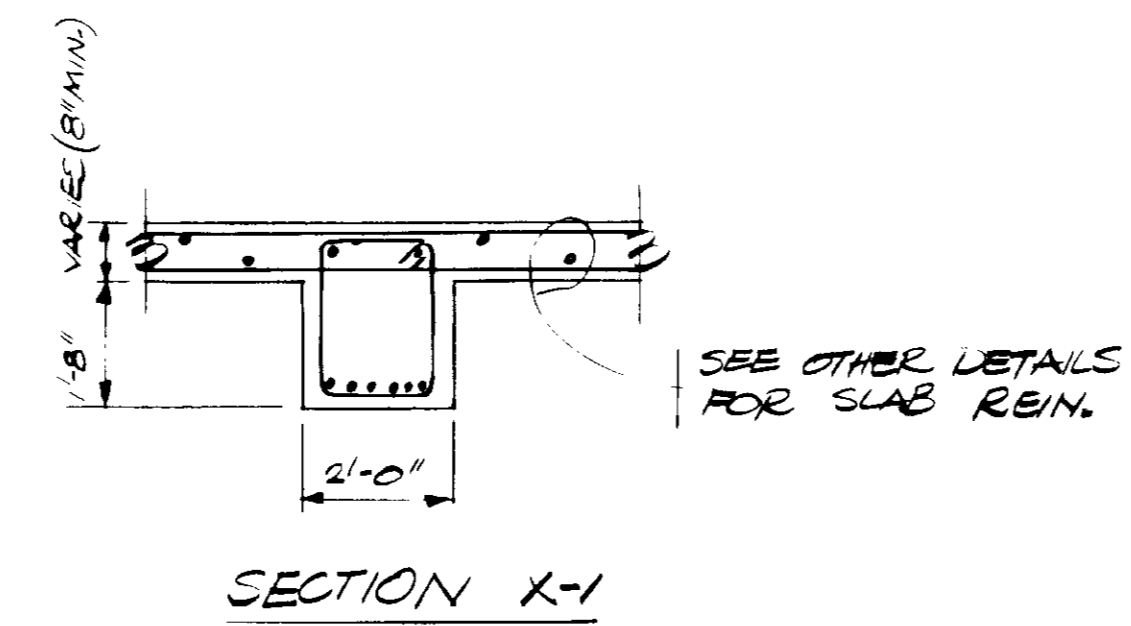


SECTION X-1

03588
H D Rueb
STRUCTURAL ENGINEER
300 CIVIC DRIVE SUITE F
PLEASANT HILL, CA 94523
TELEPHONE (415) 825-8540
JOB NUMBER 2220

RECORD DRAWING

RD 9-30-81	JMH	RECORD DRAWINGS	SCALE: AC NOTED	DESIGNED: HOR	SUBMITTED: J. M. Montgomery	27304	3/19/81	JAMES M. MONTGOMERY CONSULTING ENGINEERS, INC. 555 EAST WALNUT STREET, PASADENA, CALIFORNIA 91101	DISTRICT APPROVAL ON TITLE PAGE	LAS VIRGENES MWD/TRIUNFO CSD	SHEET
				DRAWN: LMD	PROJECT ENGINEER: J. M. Montgomery	27638	3/20/81			TAPIA WRF - FILTRATION/DISINFECTION ADDITION	6S-4
REV 9-30-81	DATE	BY	DESCRIPTION	CHECKED: J. M. Montgomery	RECOMMENDED: J. M. Montgomery					PHASE II	CHEMICAL BUILDING - ROOF SLAB SECTIONS AND PLATFORM FRAMING DETAILS

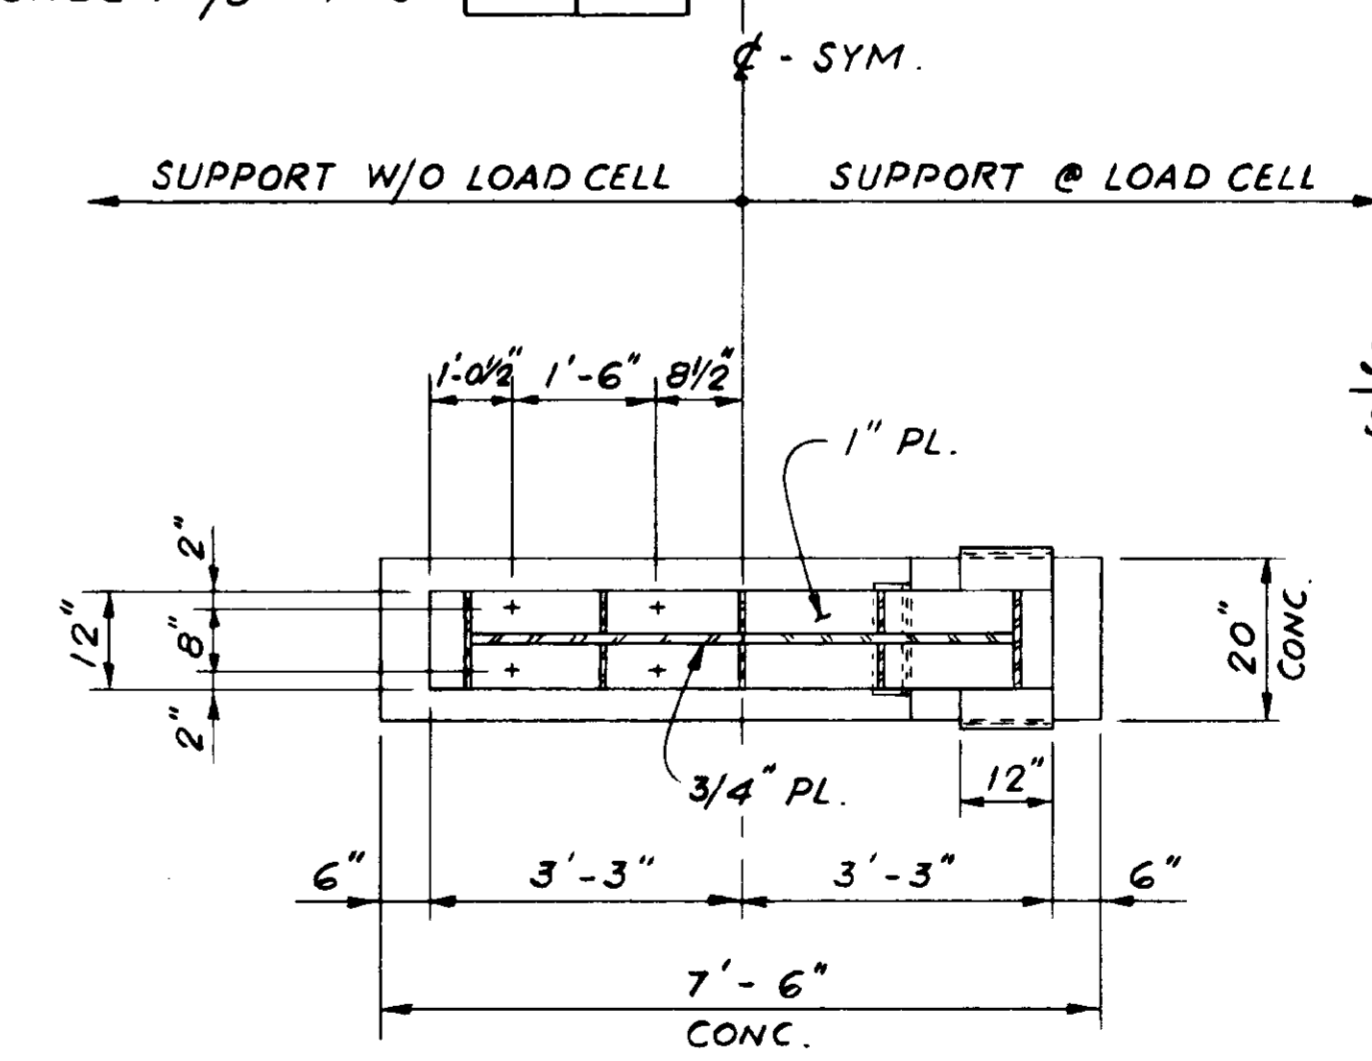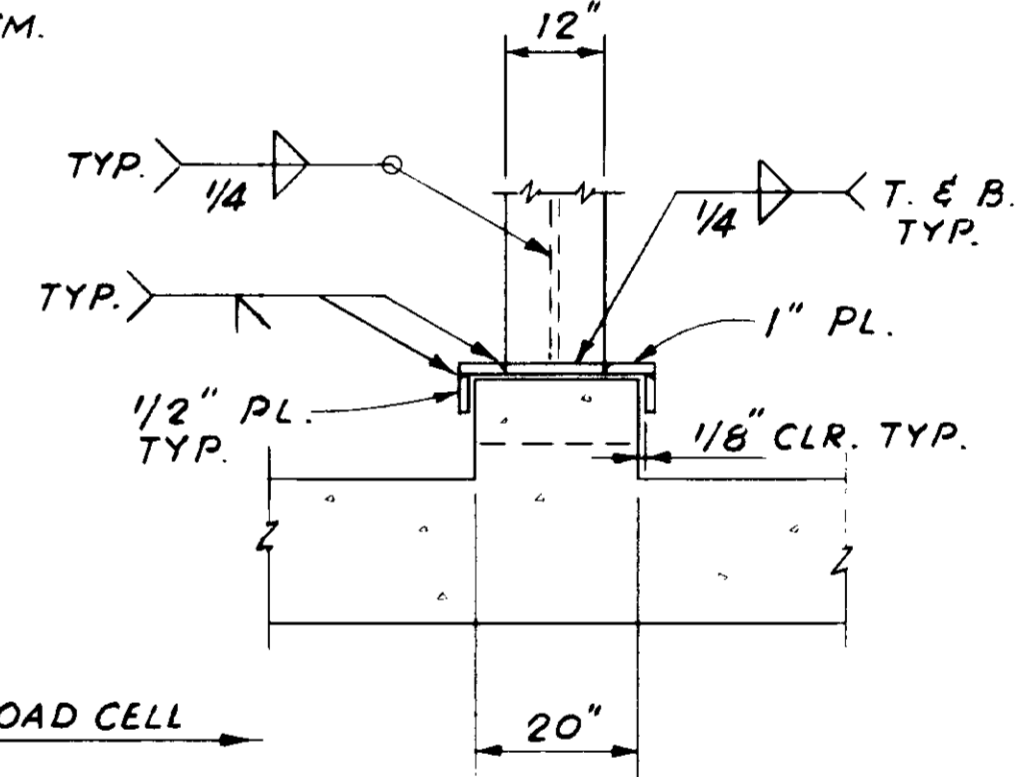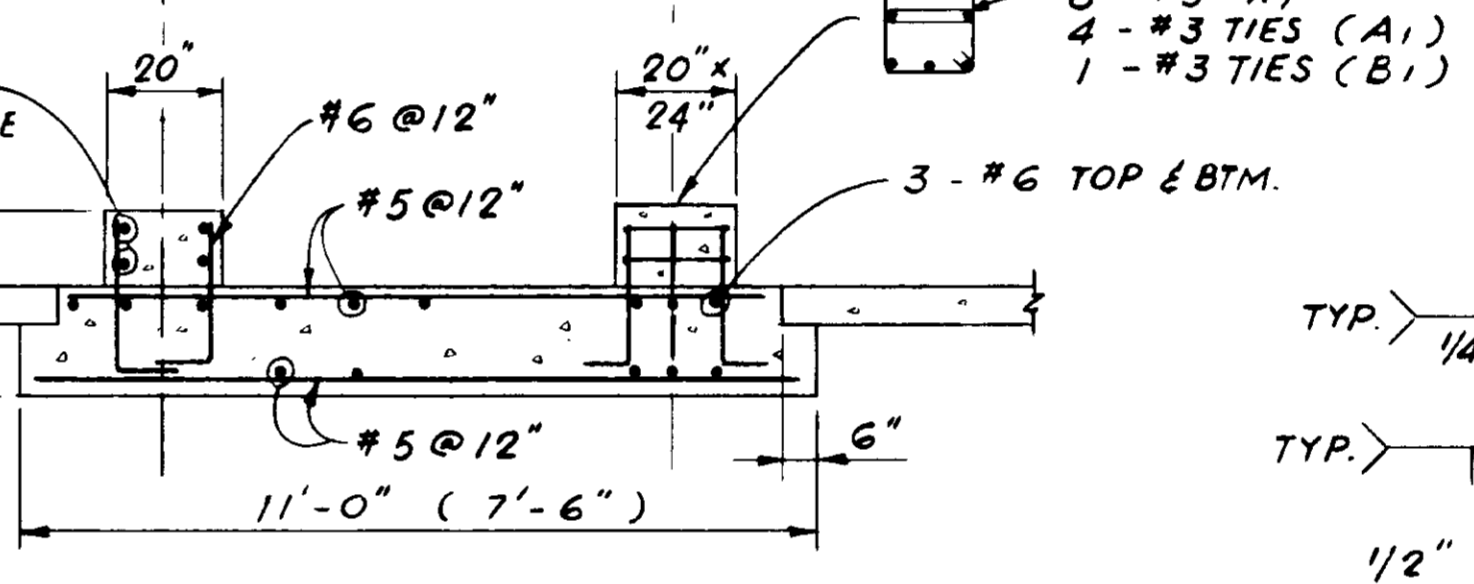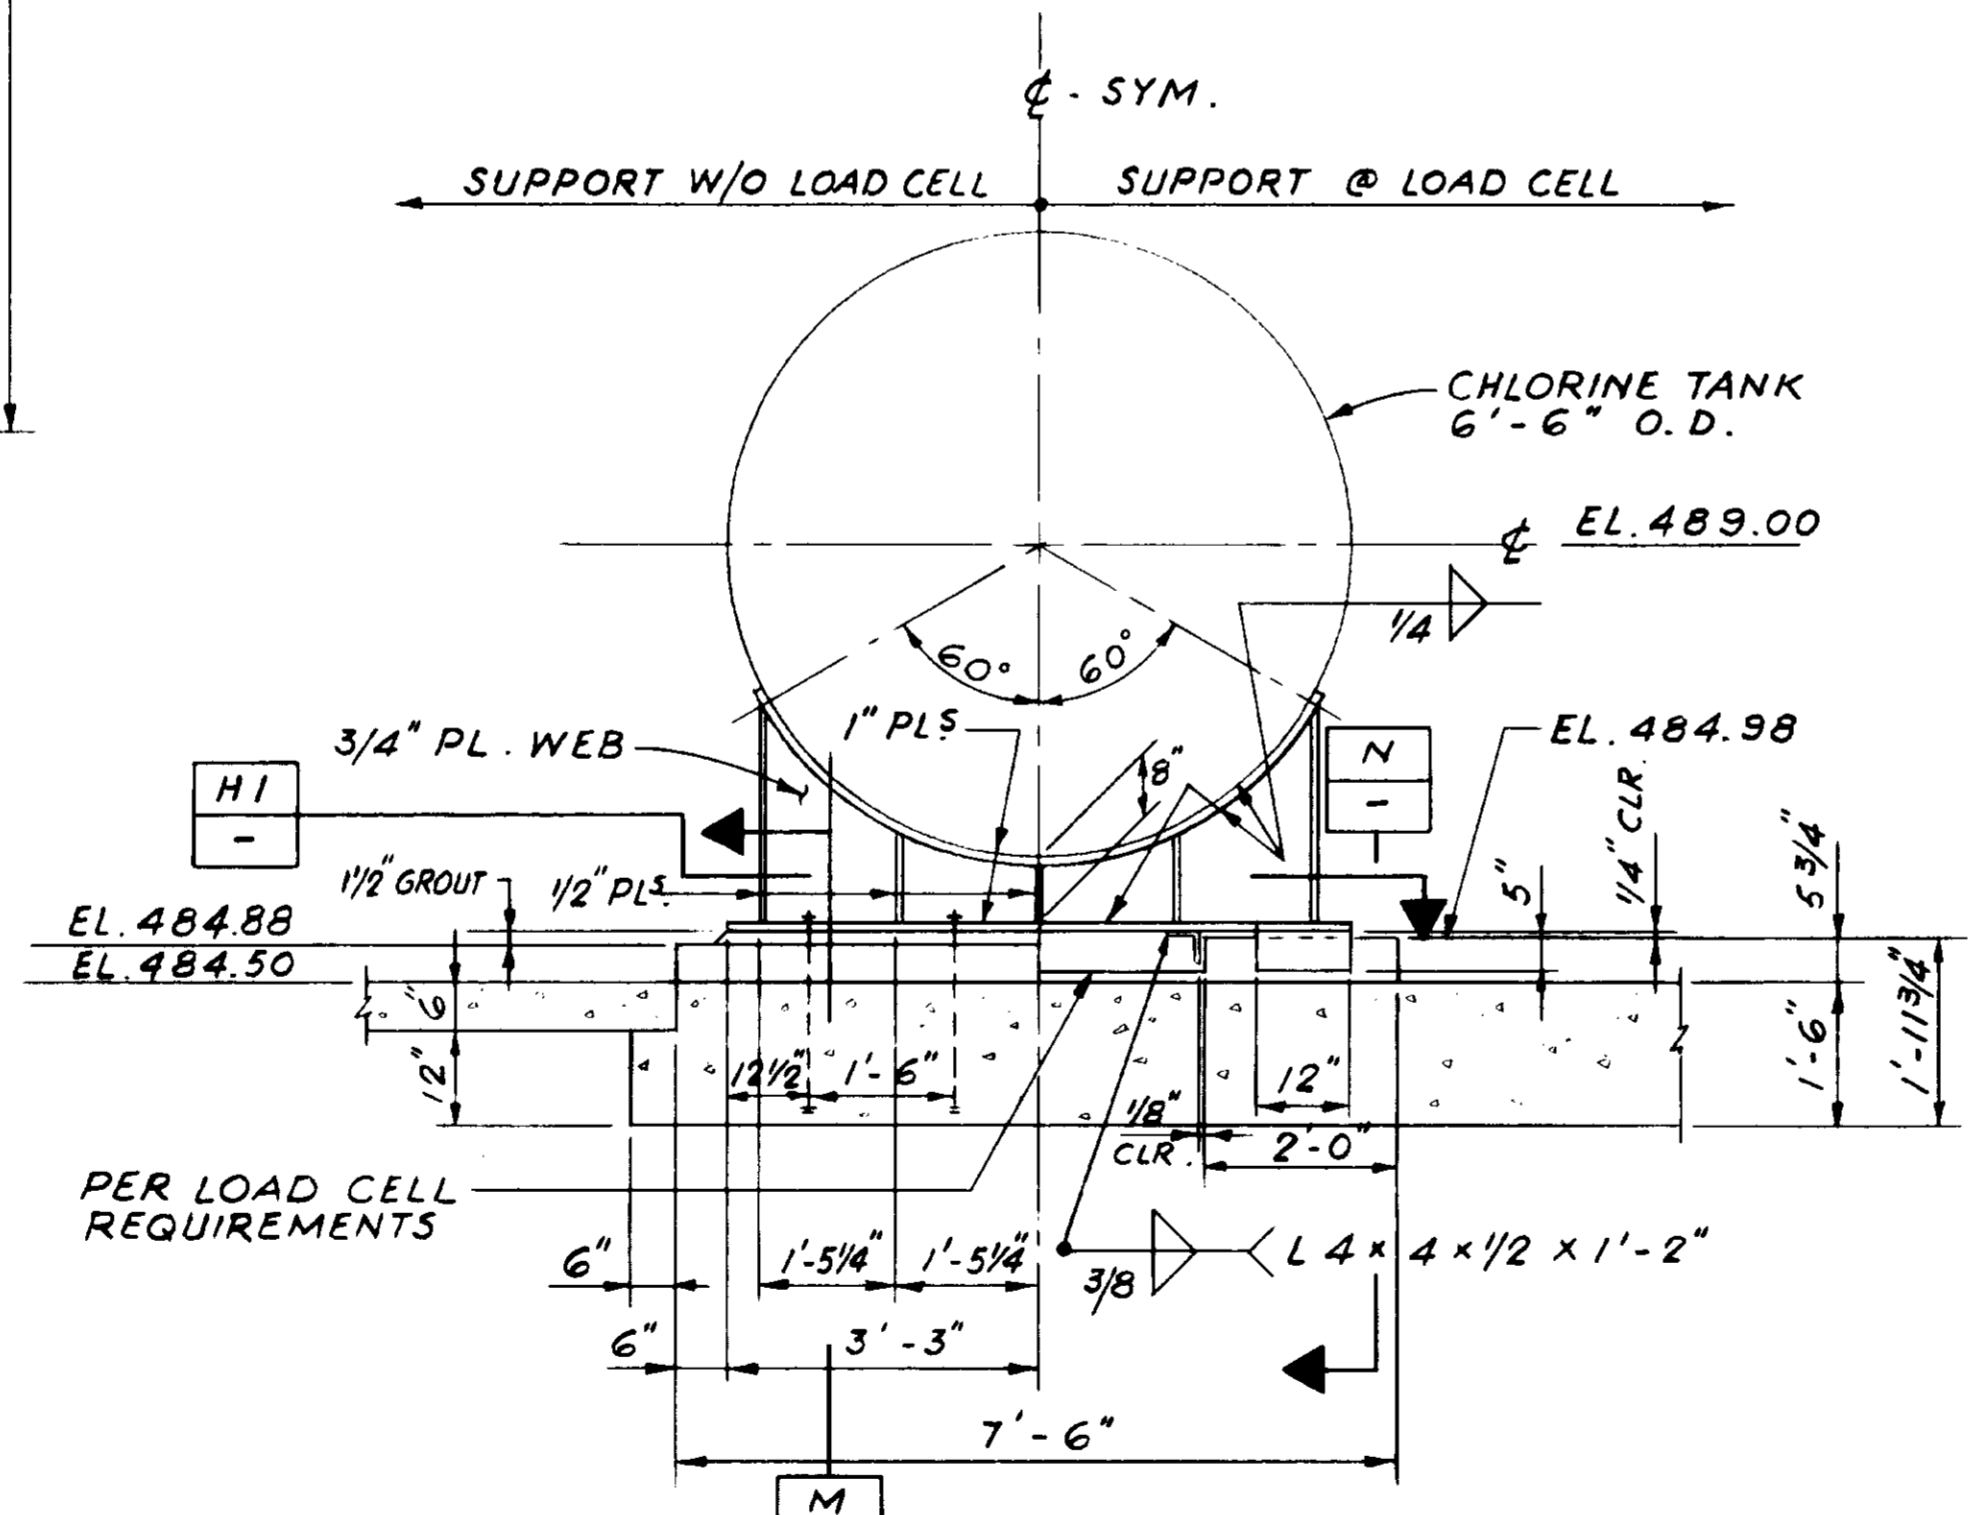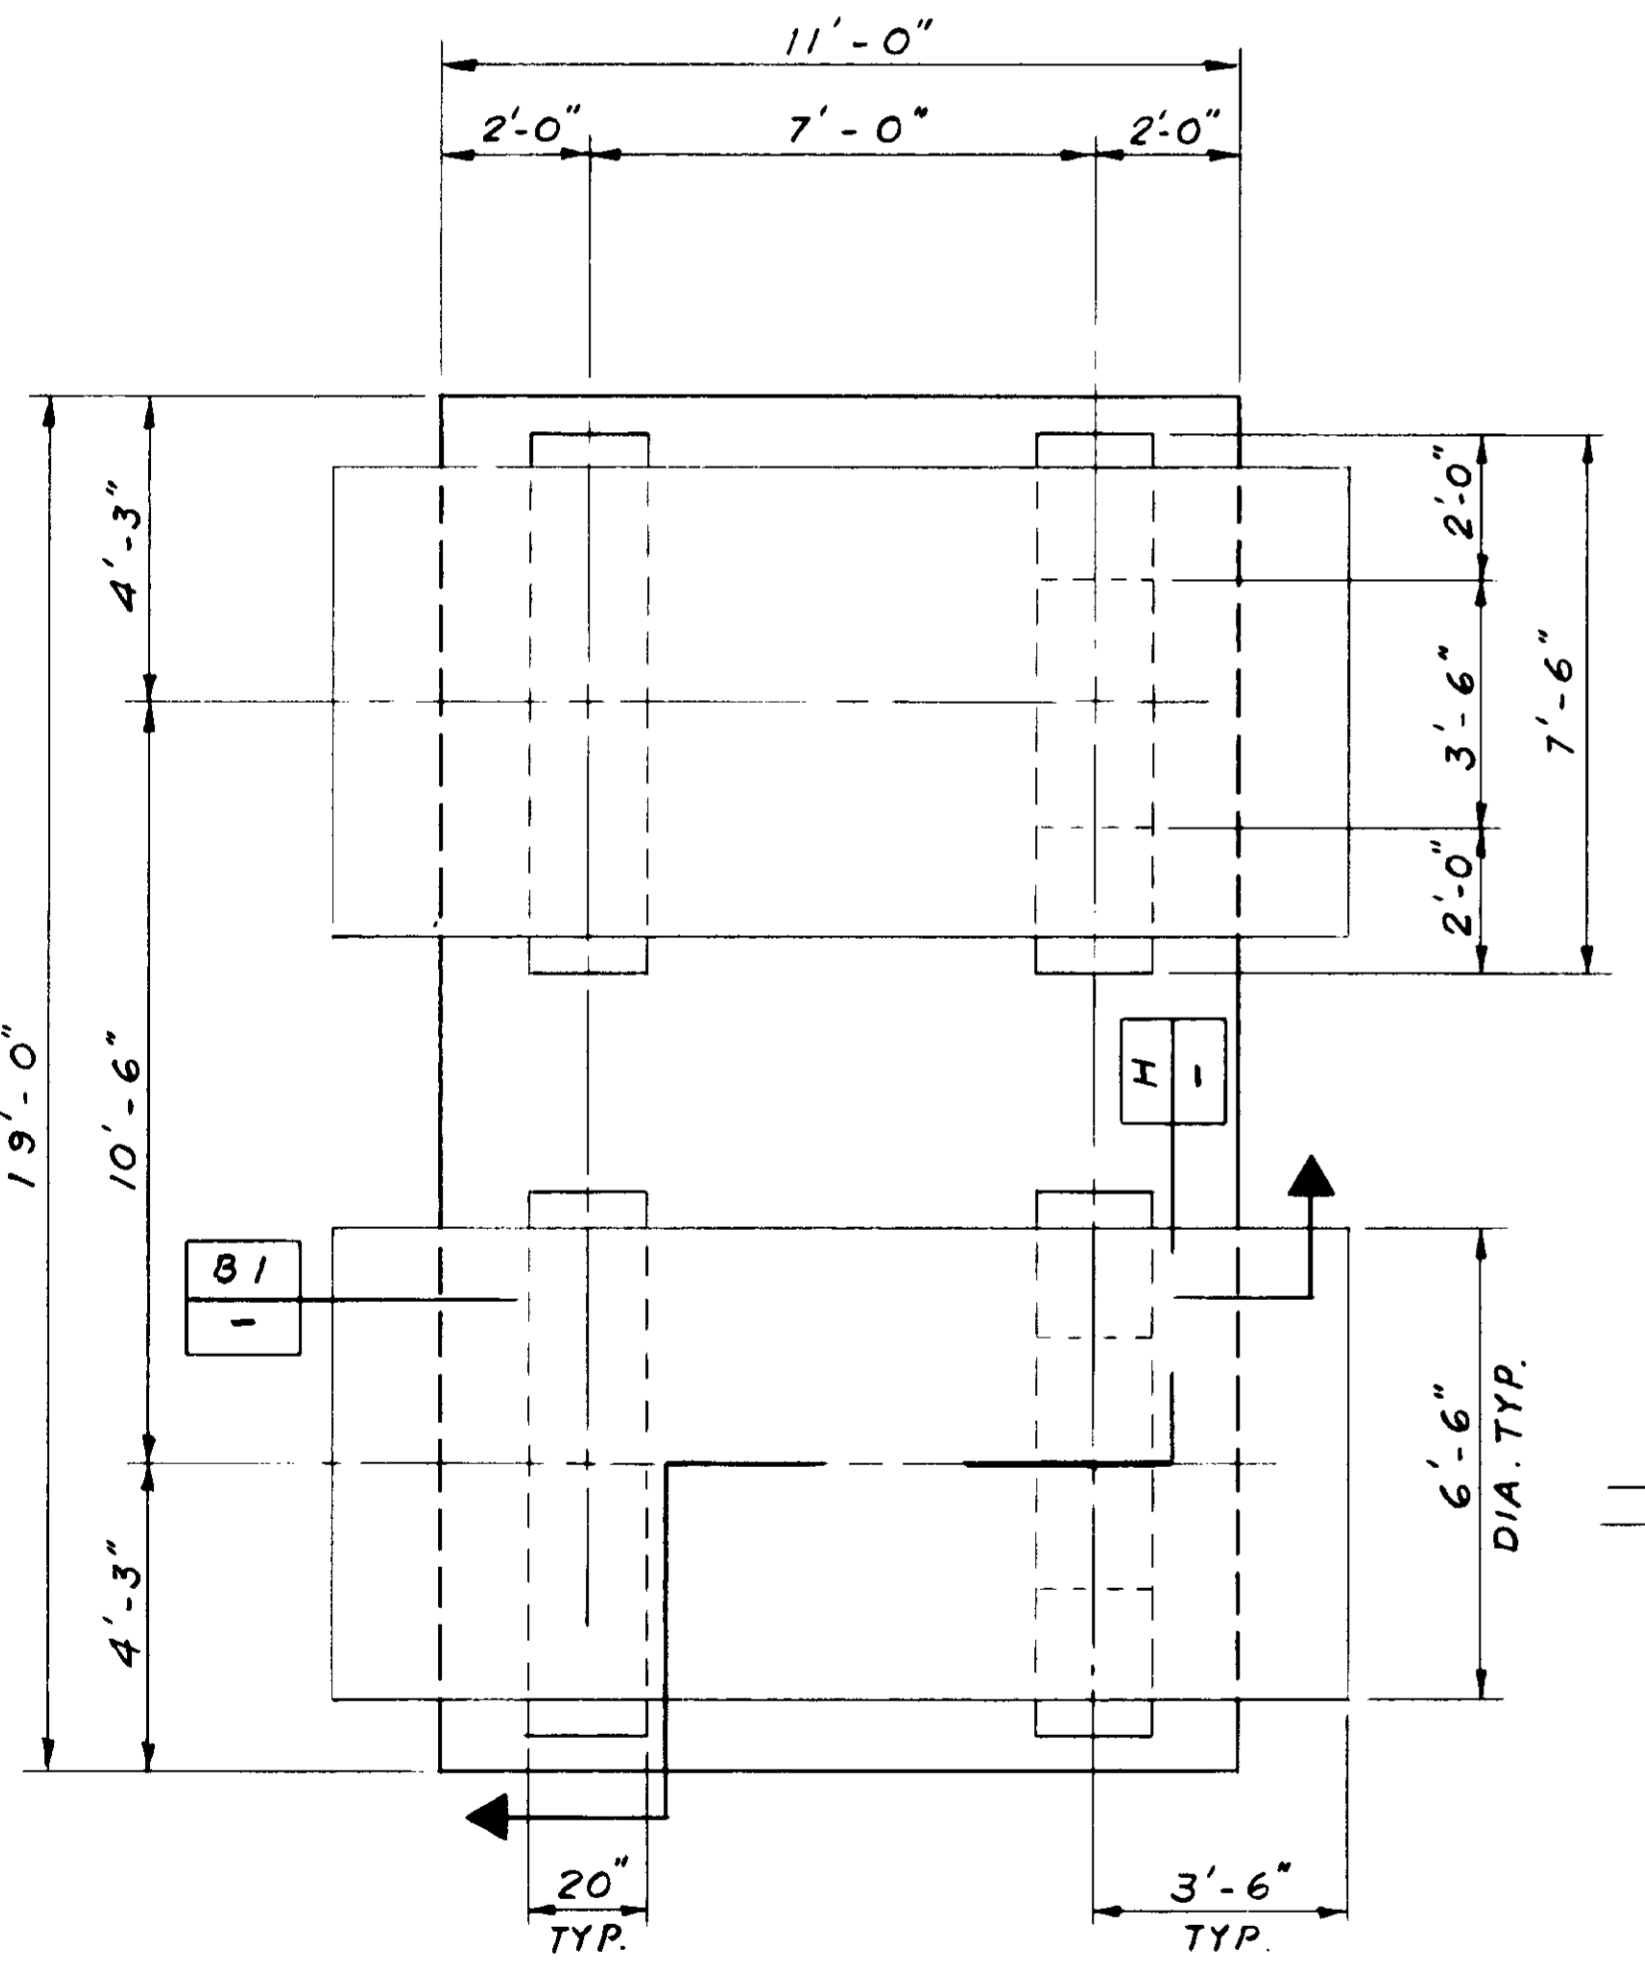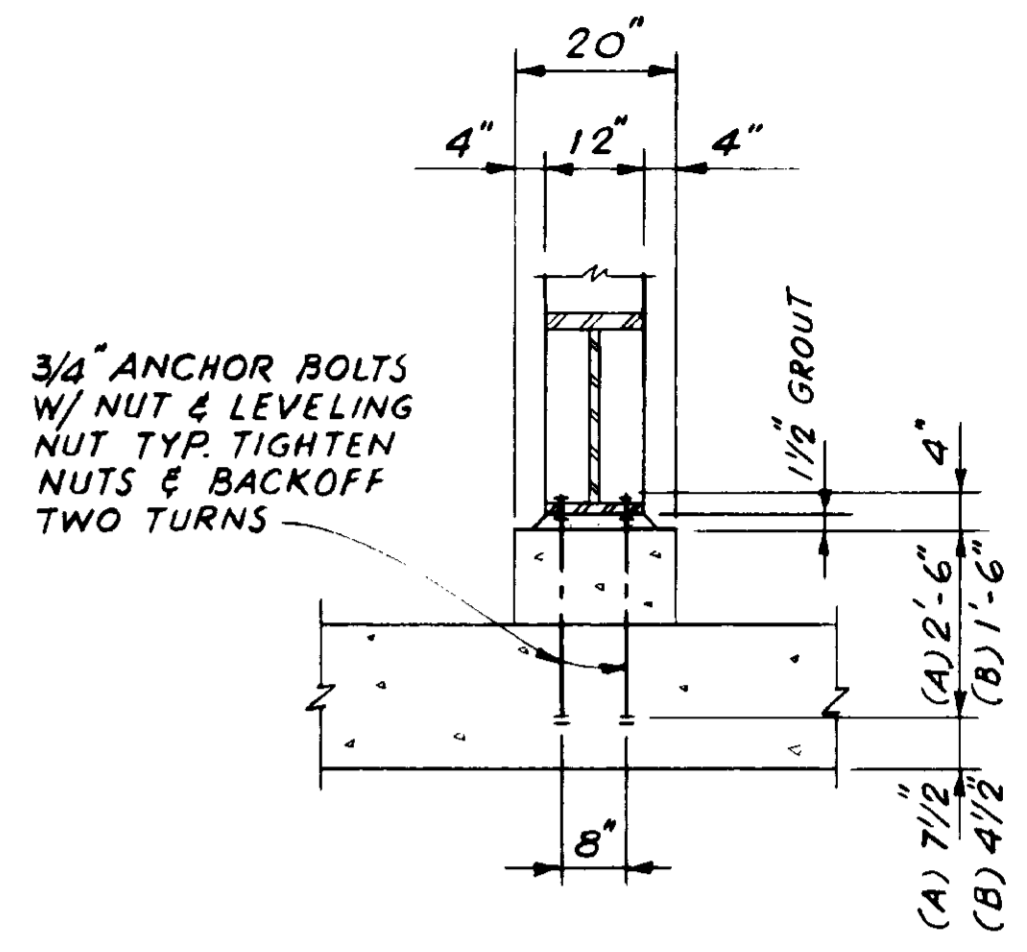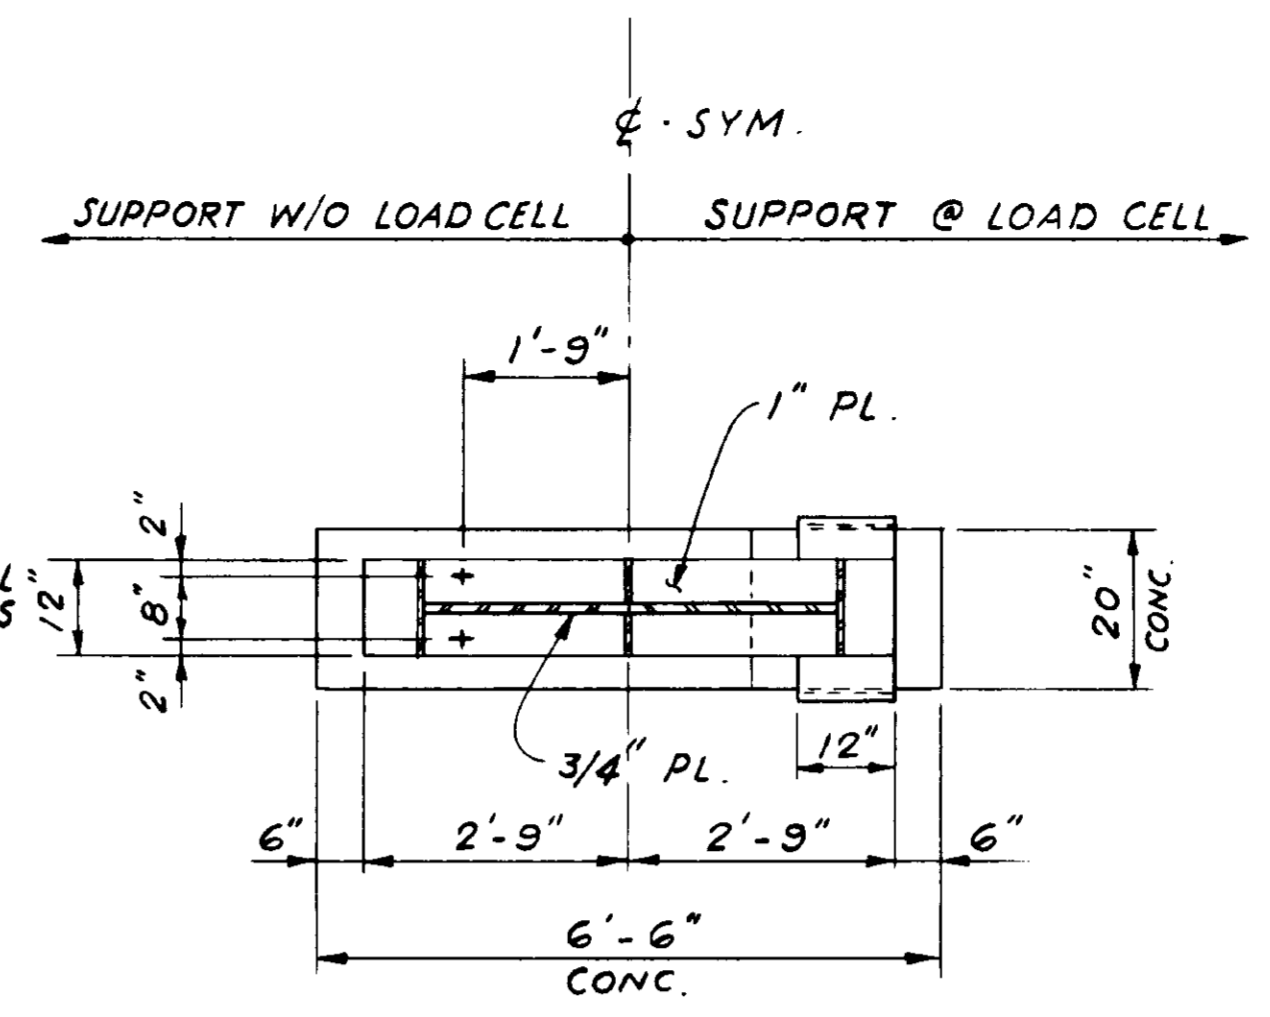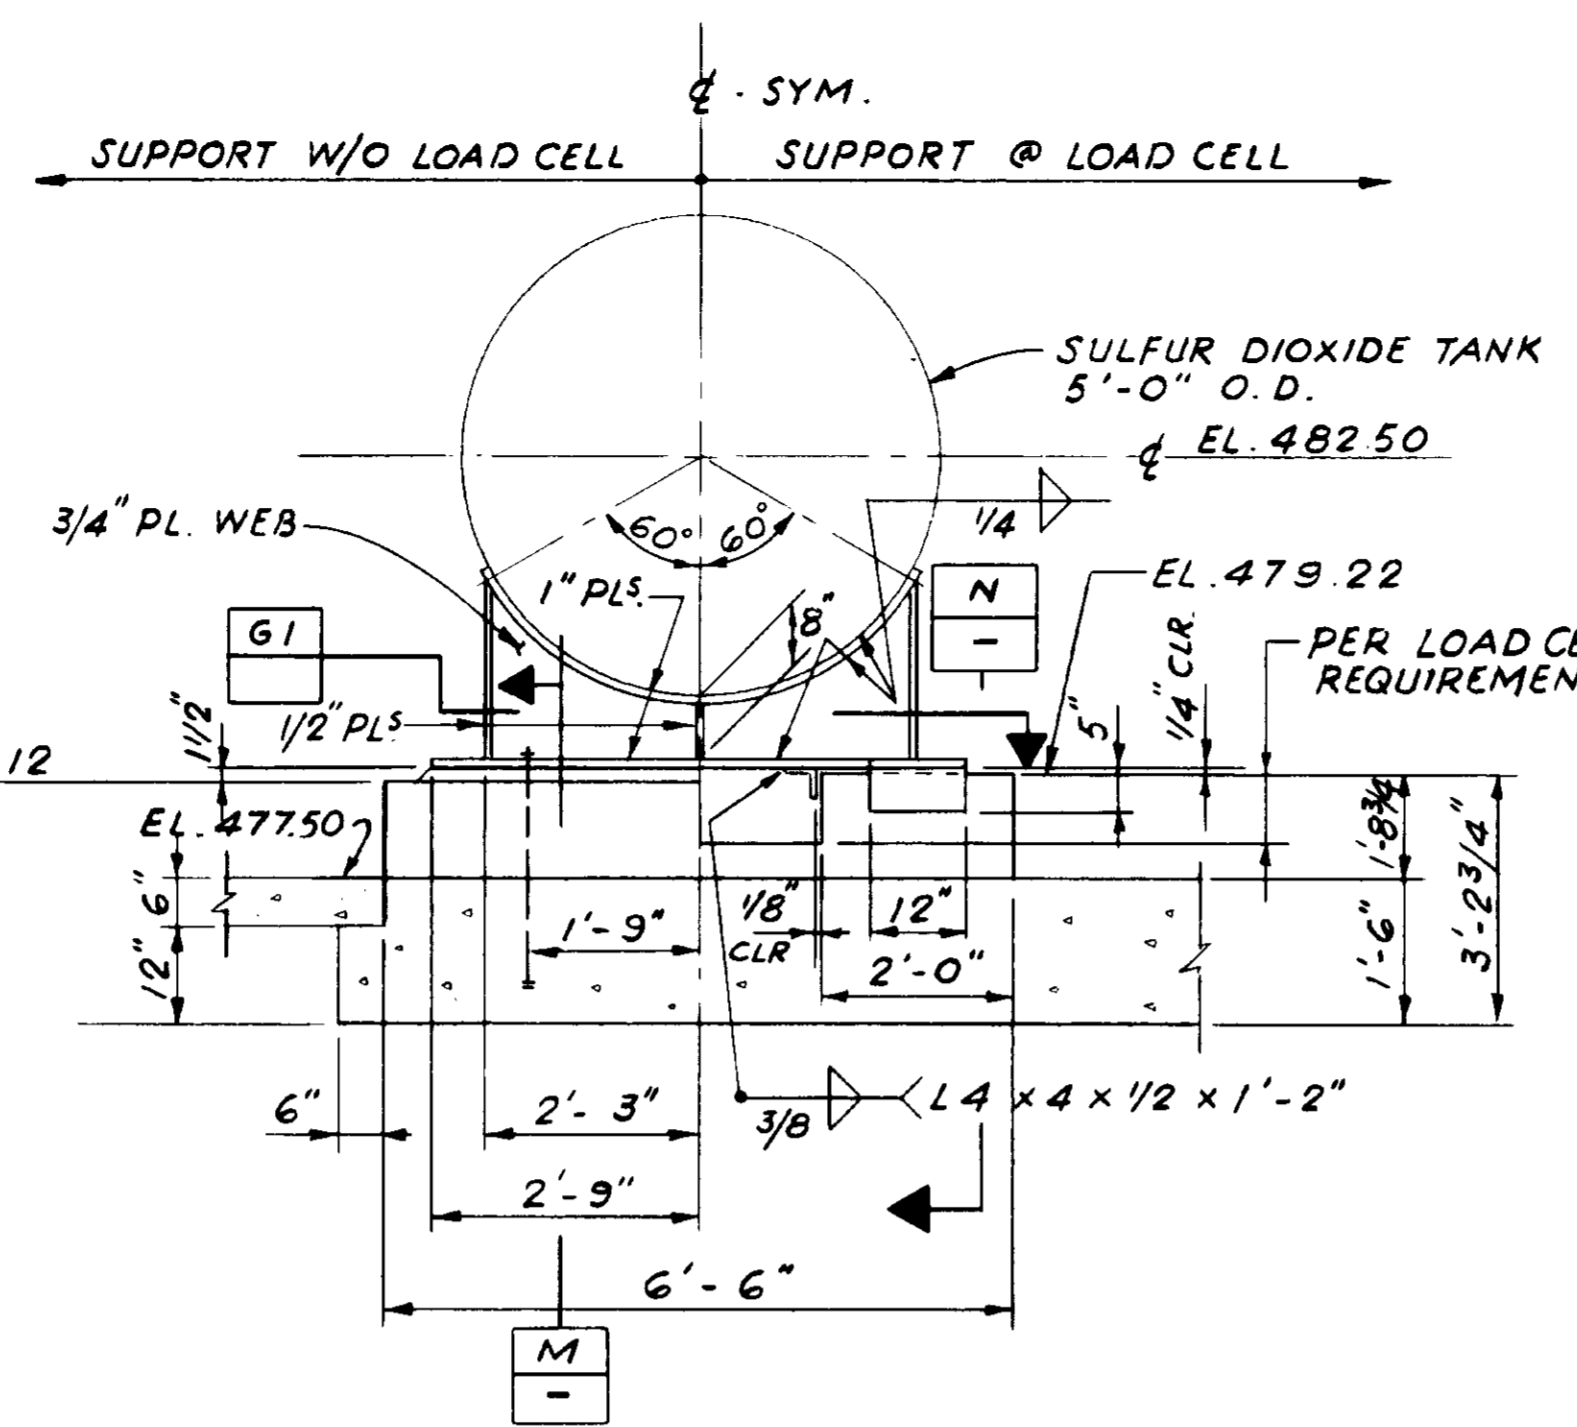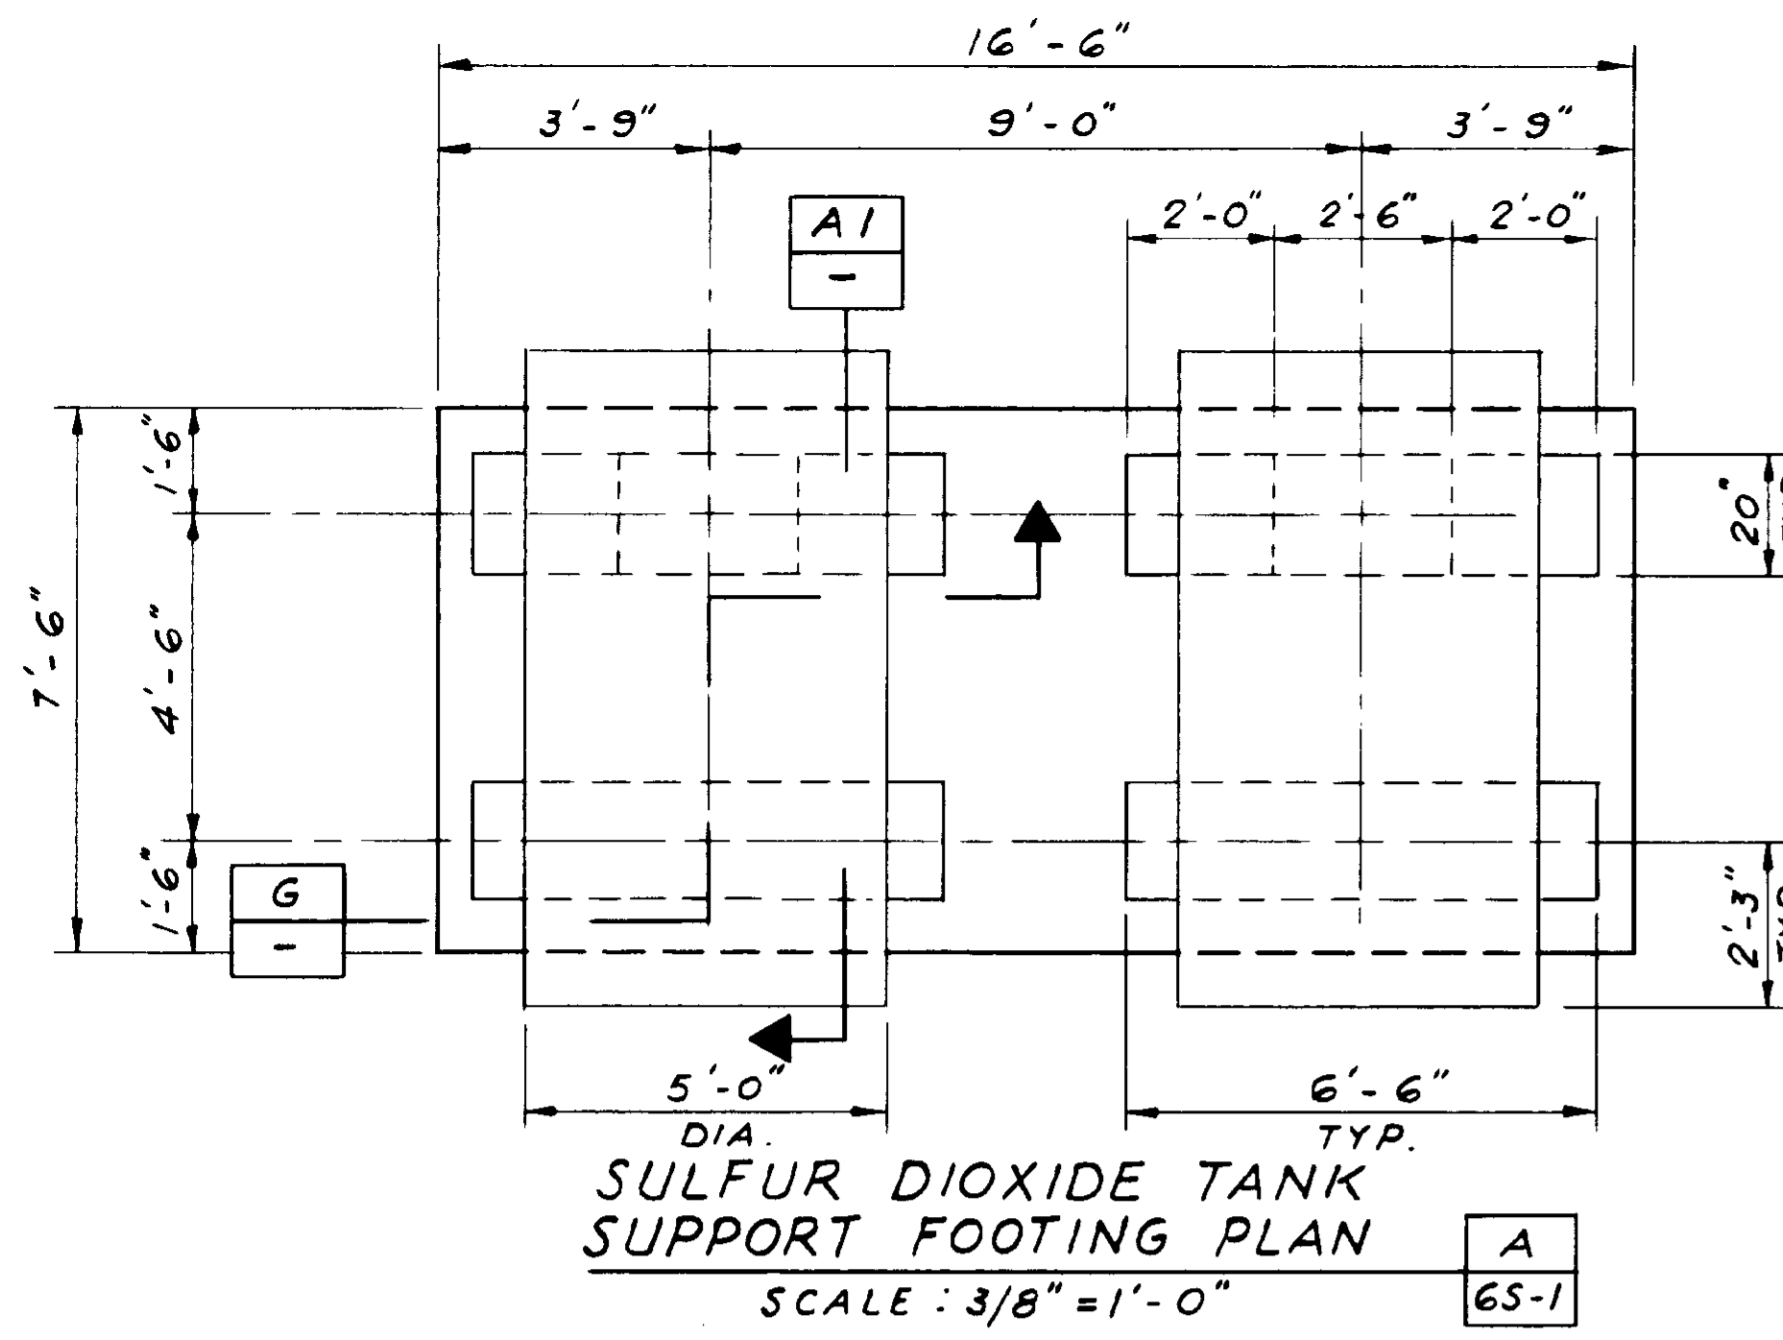

JOB NO.	DATE	BY	DESCRIPTION

SCALE:	DESIGNED:	SUBMITTED:
AS NOTED	P. REYMOND	27304 8/19/81
	T. S. CHONG	27633 9/20/81


JAMES M. MONTGOMERY CONSULTING ENGINEERS, INC.
555 EAST WALNUT STREET, PASADENA, CALIFORNIA 91101

DISTRICT APPROVAL ON TITLE PAGE


LAS VIRGENES MWD/TRIUNFO CSD	
TAPIA WRF - FILTRATION/DISINFECTION ADDITION	
PHASE II	CHEMICAL BUILDING - TANK SUPPORT DETAILS

SHEET
6S-5
OF 66 SHEETS

**03589
RECORD DRAWING**

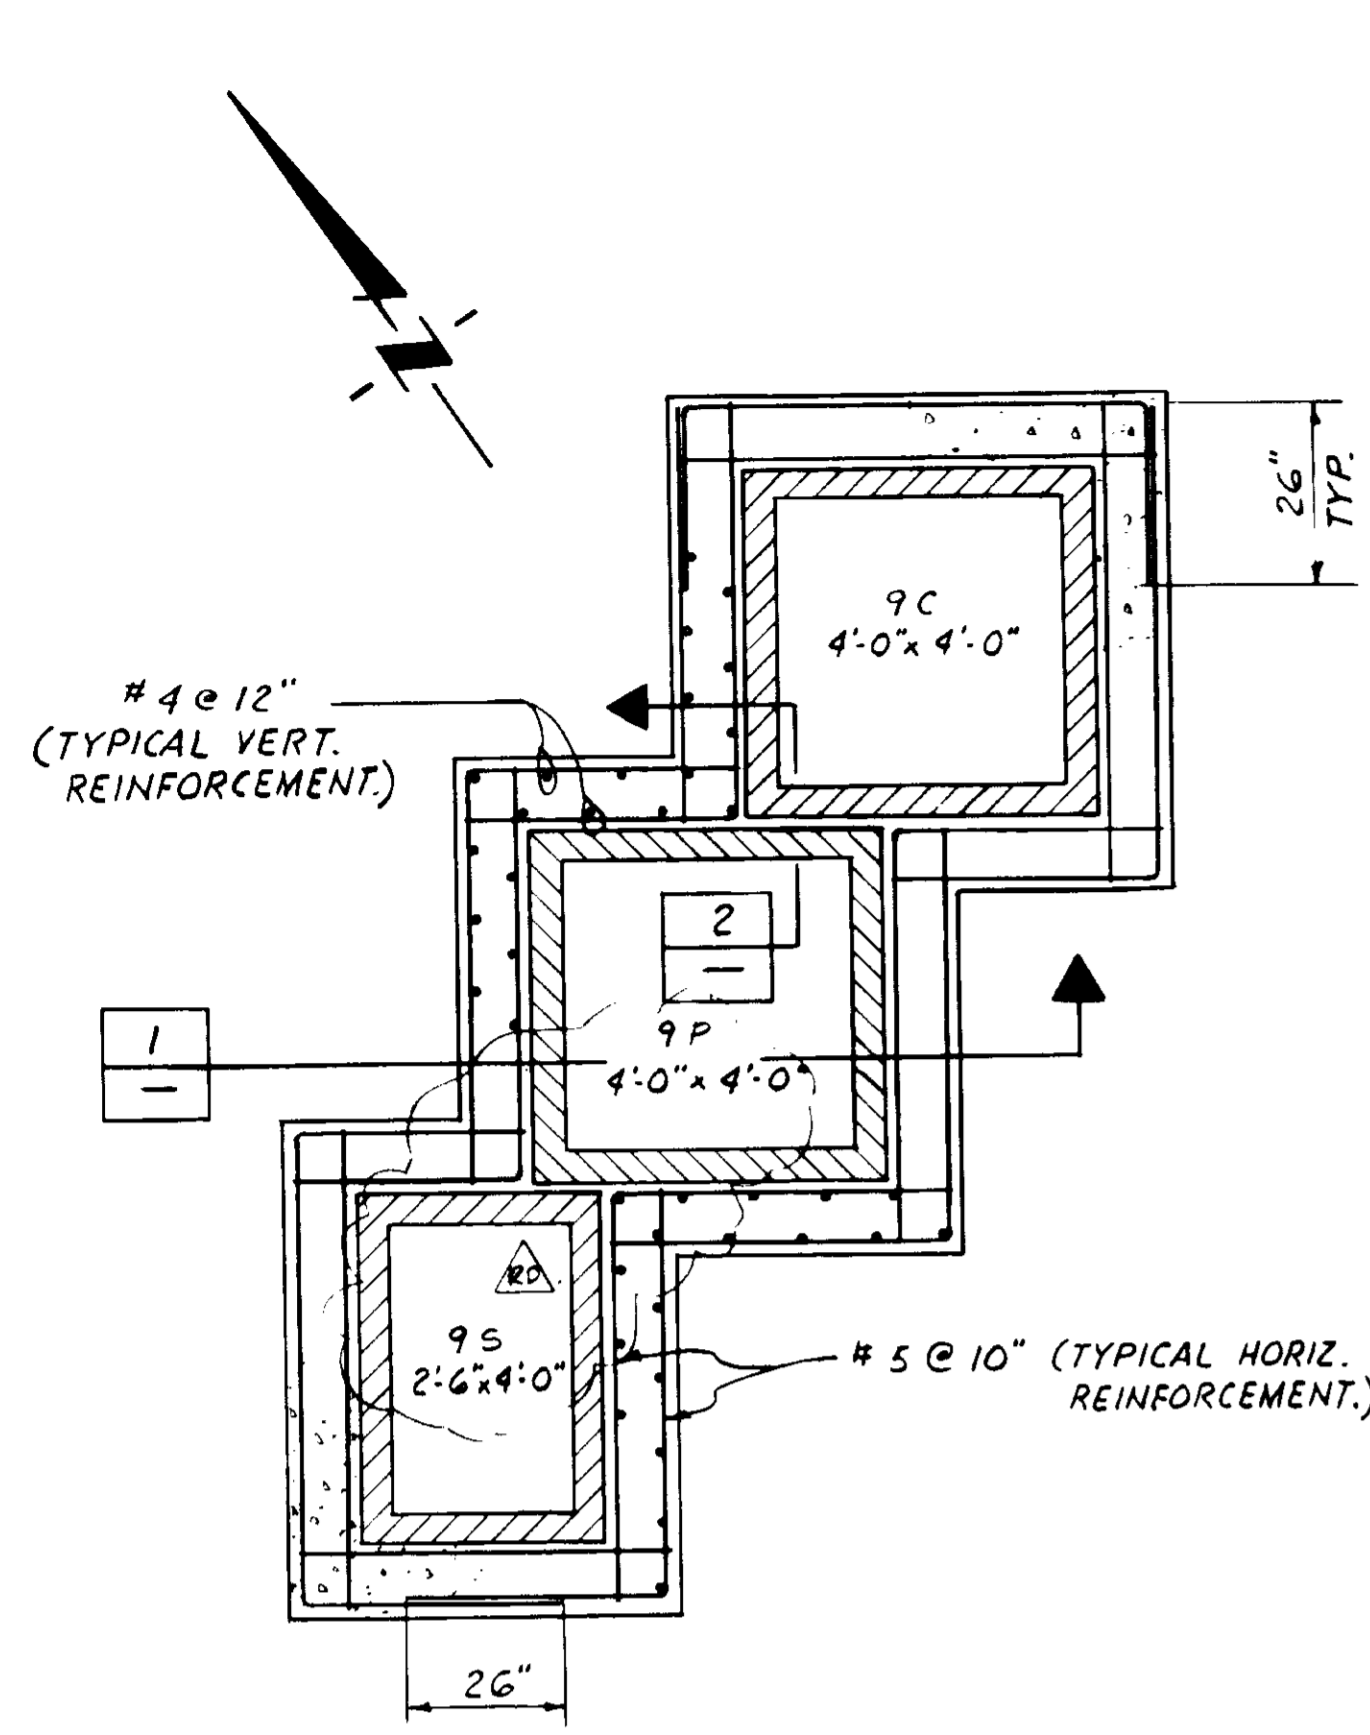

SECTIONAL PLAN A
SCALE 3/8" = 1'-0"

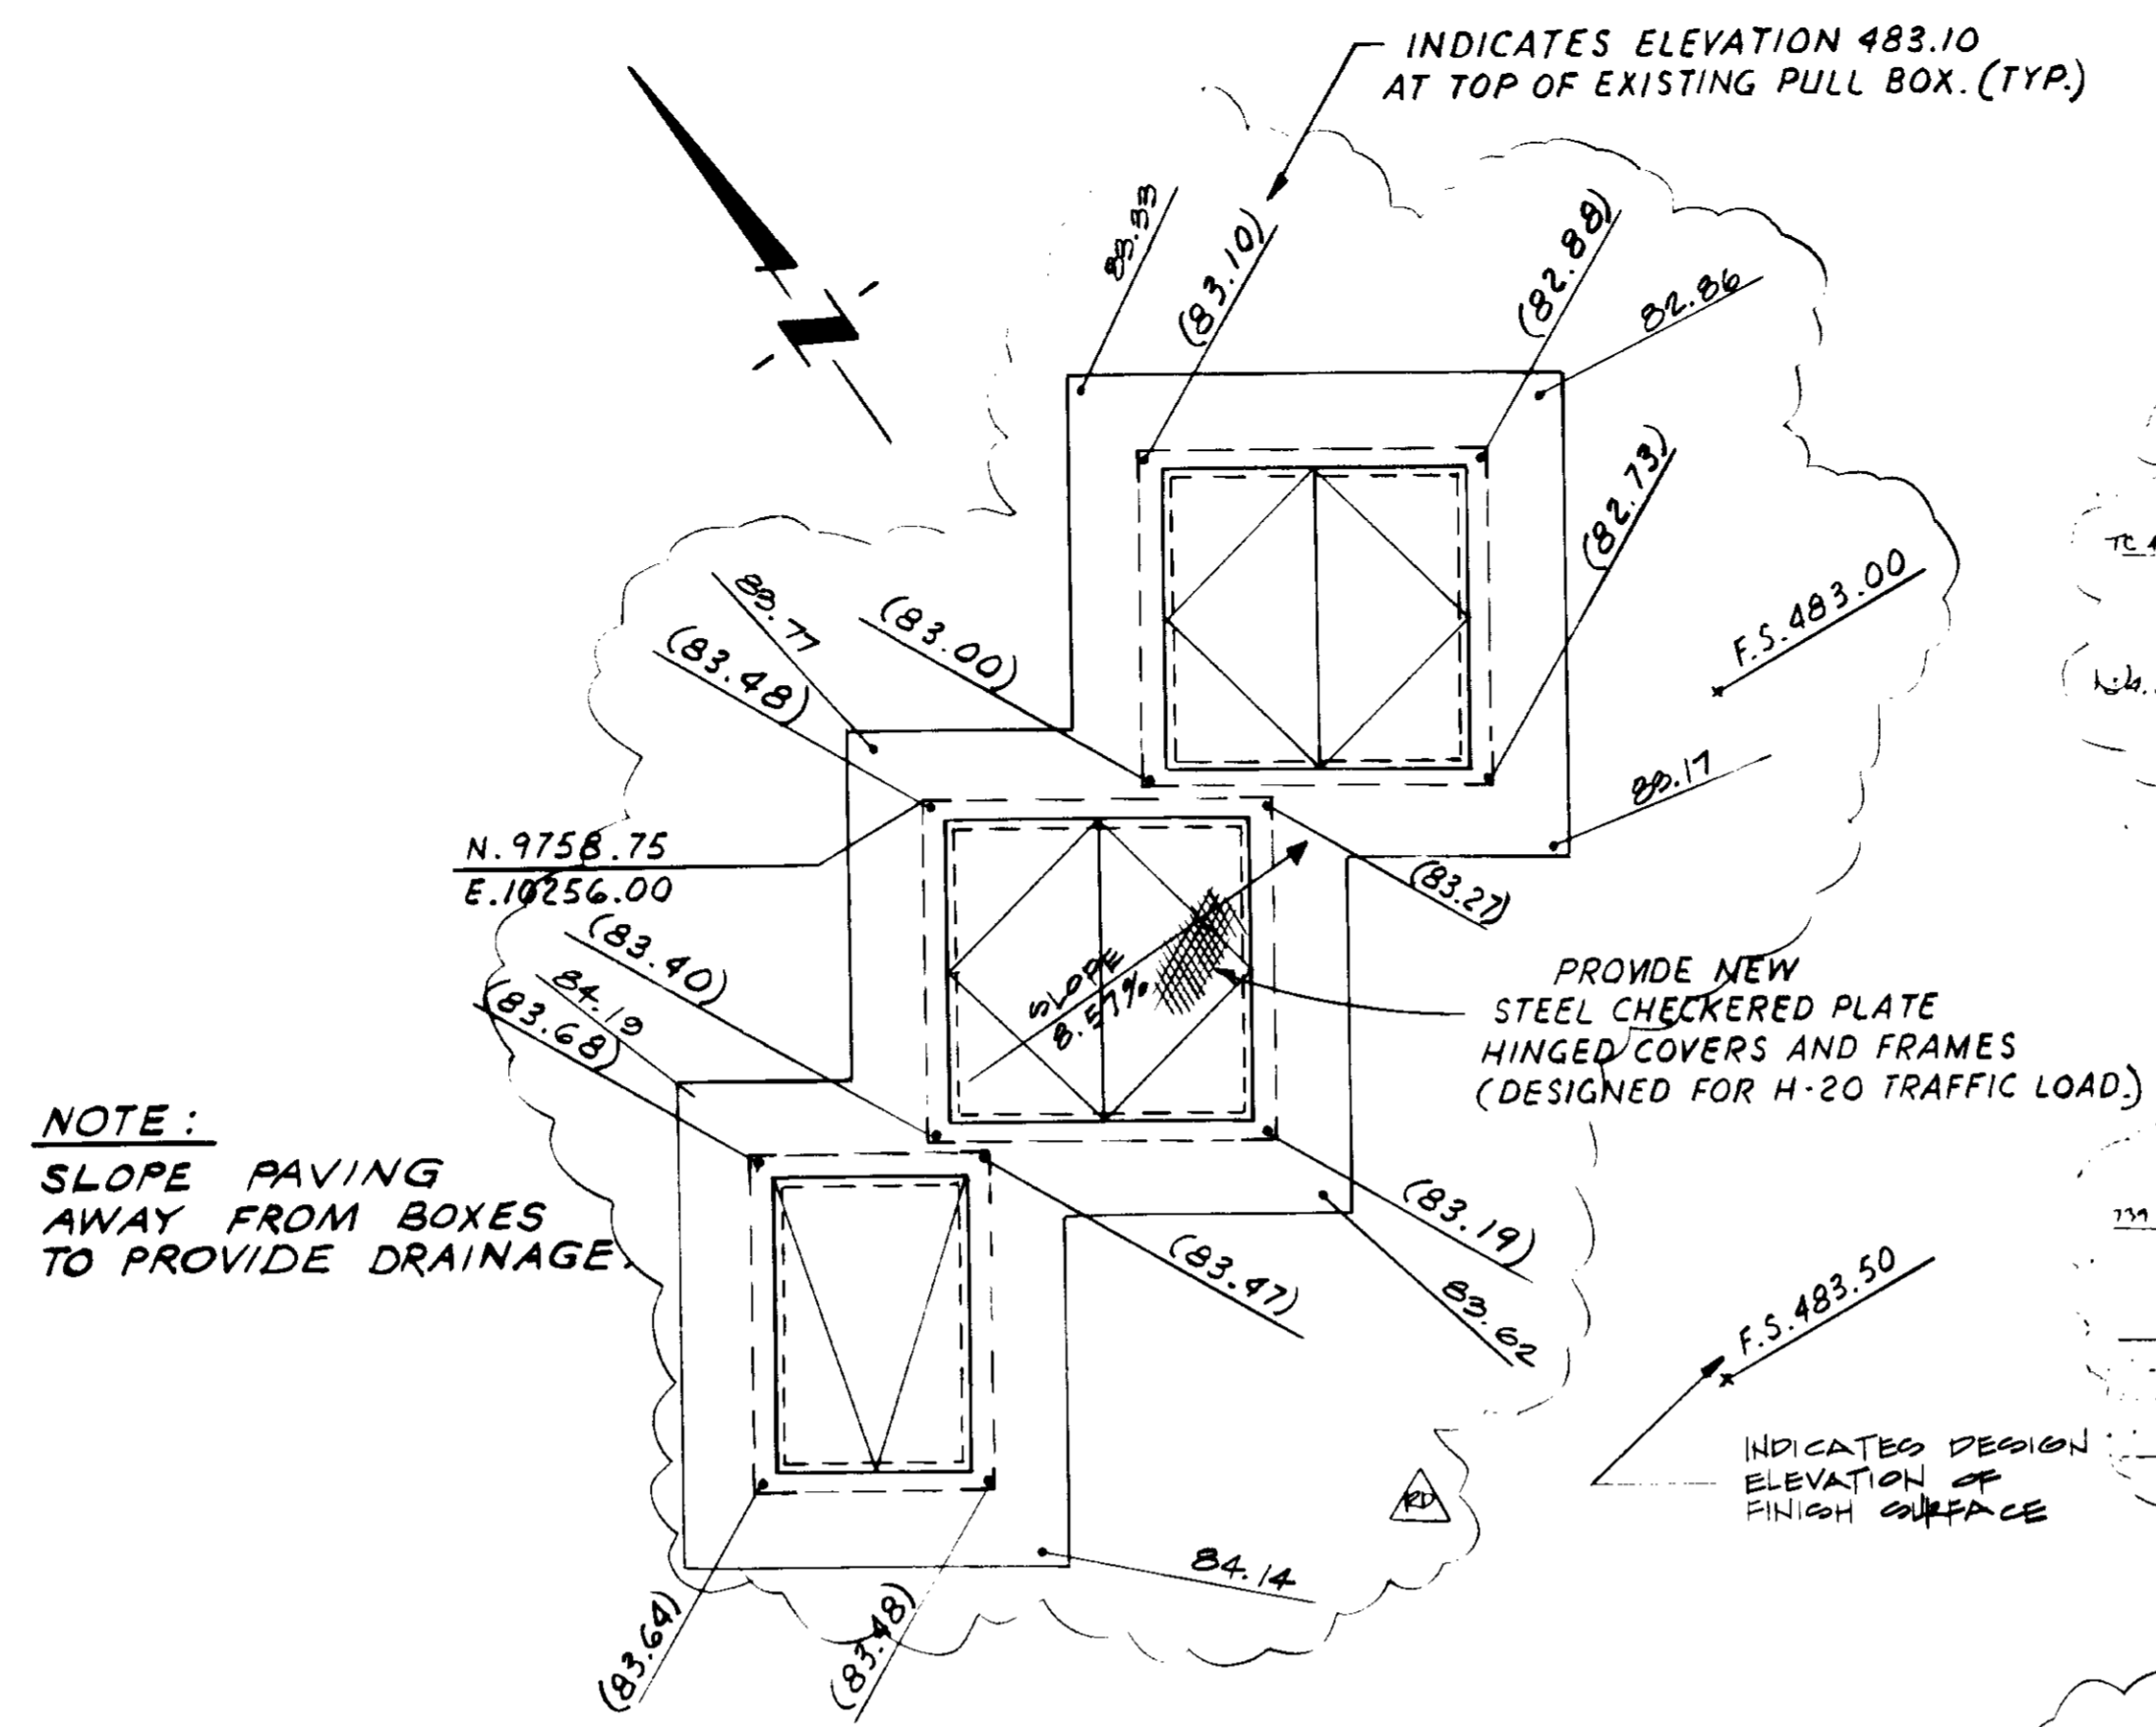


PLAN B
SCALE 3/8" = 1'-0"

NOTE:
SLOPE PAVING AWAY FROM BOXES TO PROVIDE DRAINAGE


PROVIDE NEW STEEL CHECKERED PLATE HINGED COVERS AND FRAMES (DESIGNED FOR H-20 TRAFFIC LOAD)

INDICATES DESIGN ELEVATION OF FINISH SURFACE

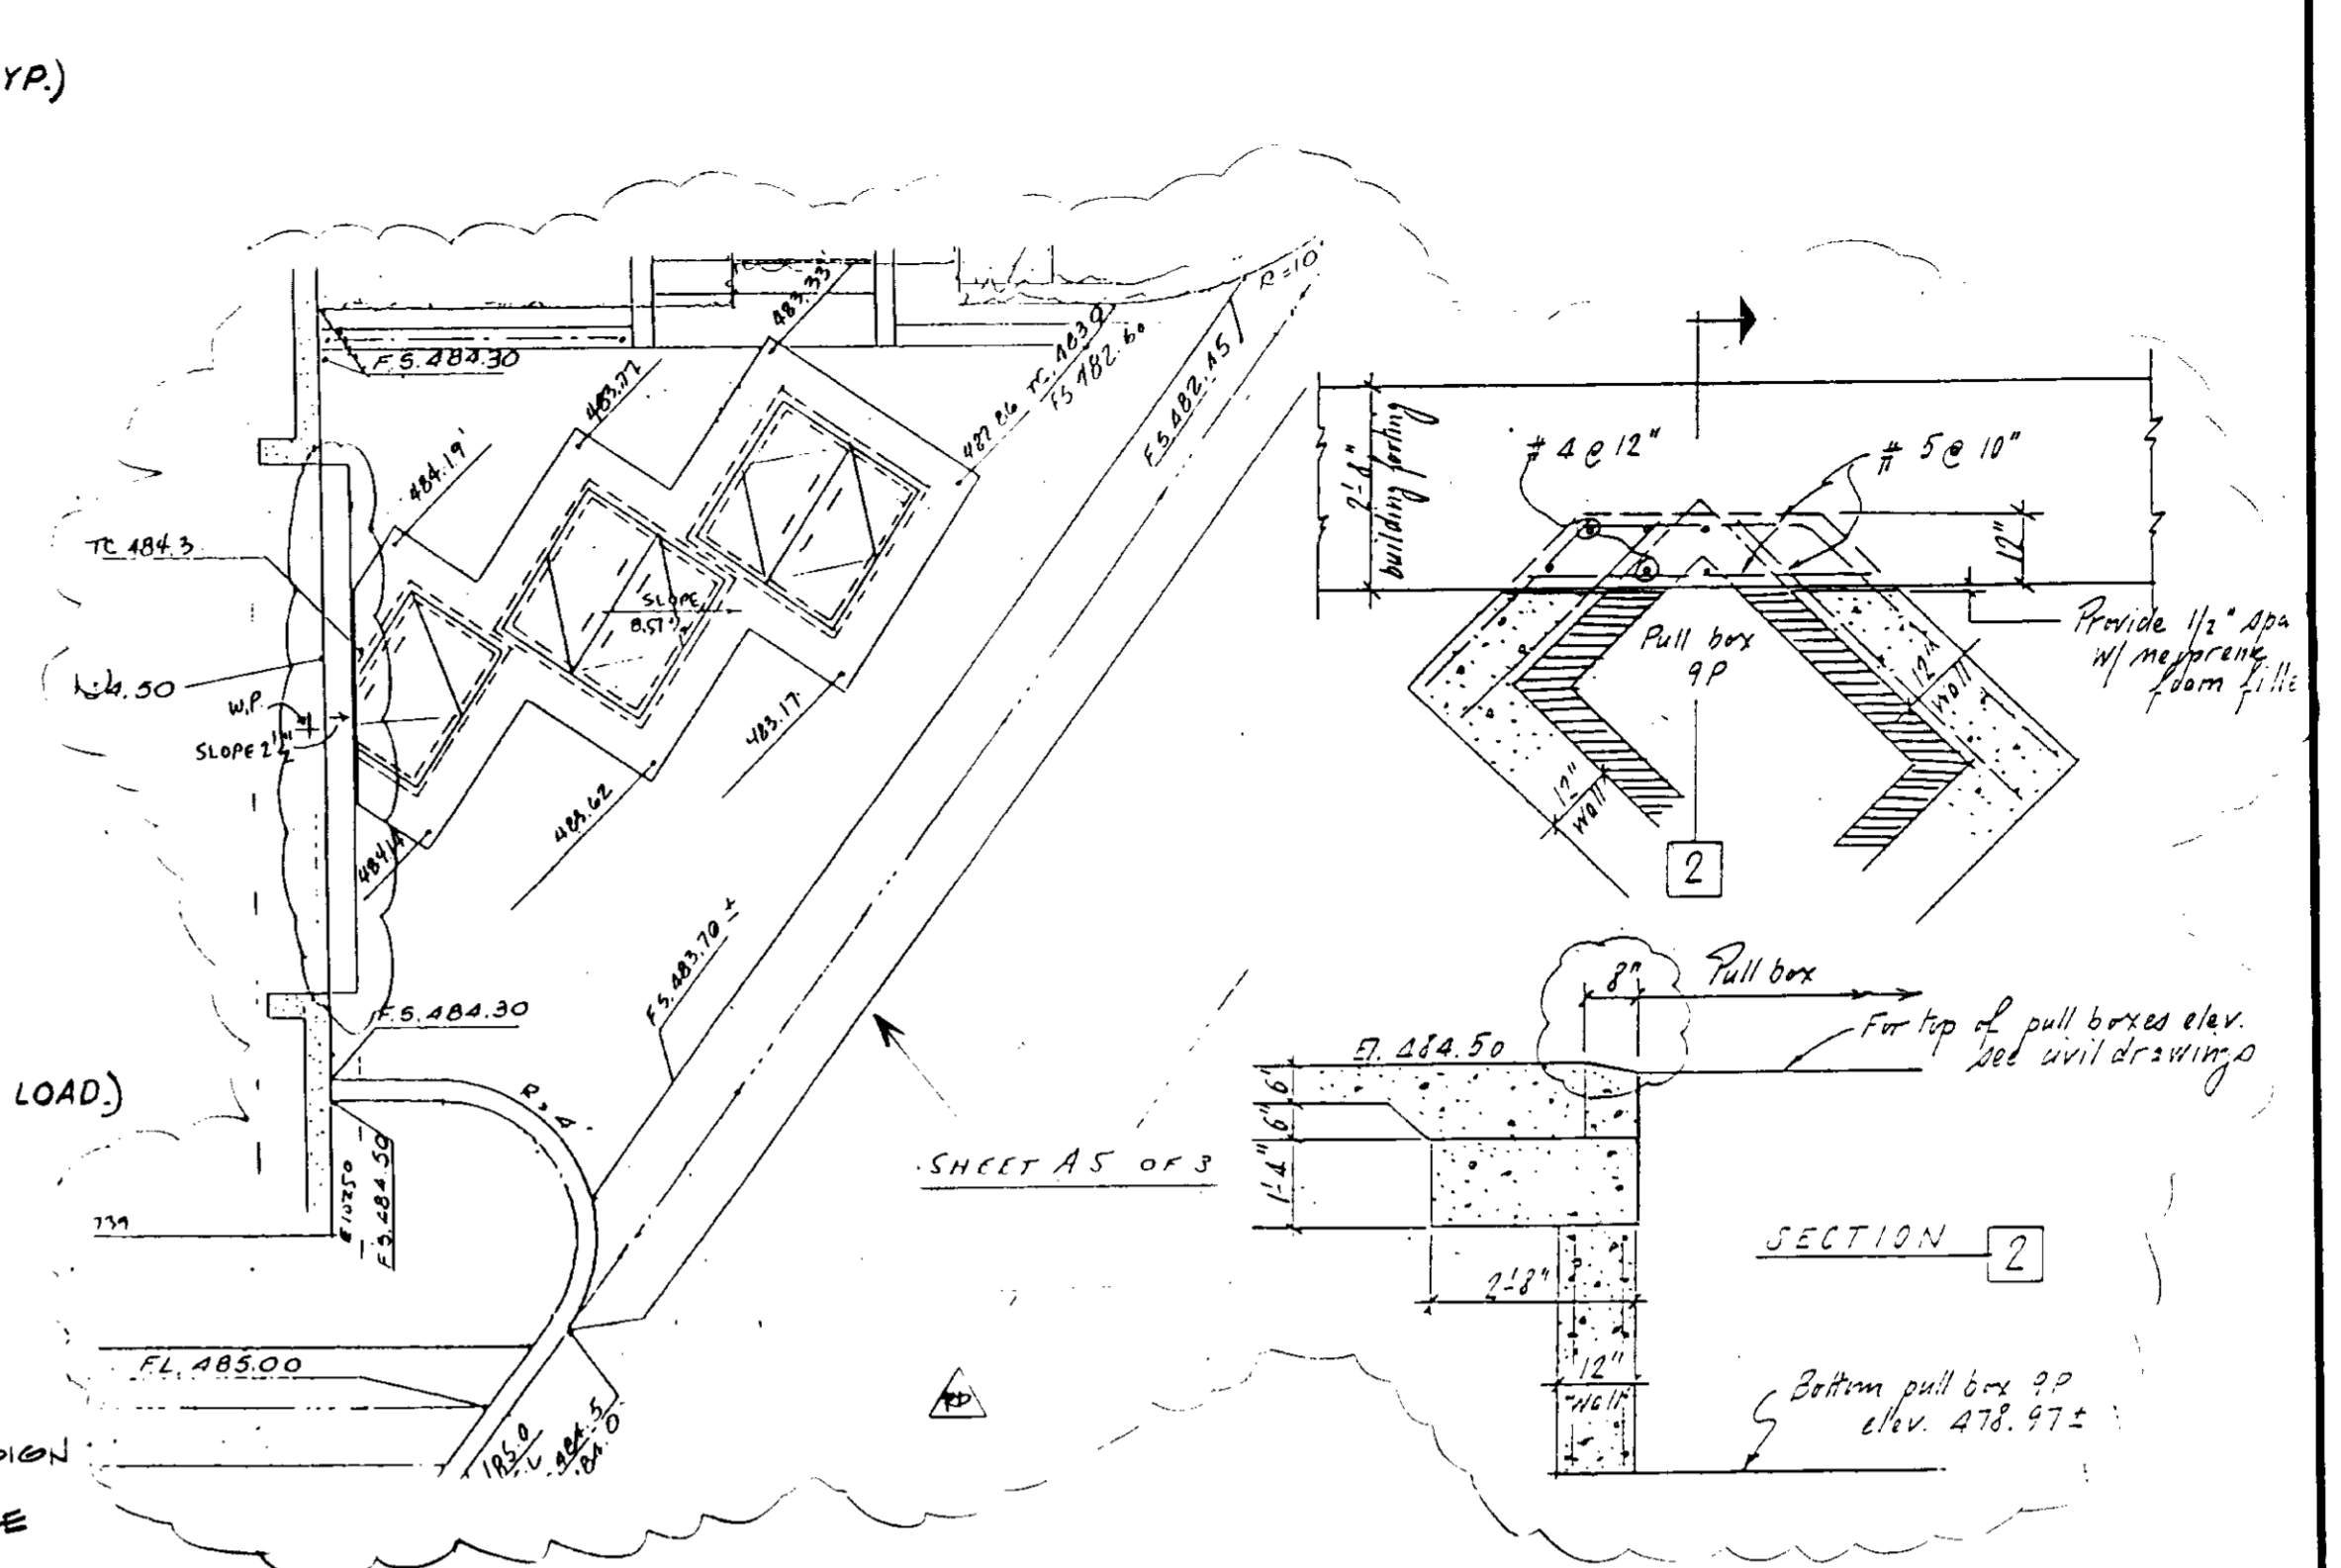


SECTION 2


NOTE:
WHERE REQUIRED REMOVE UPPER SECTION OF EXISTING PULL BOX TO PROVIDE 8" MIN.

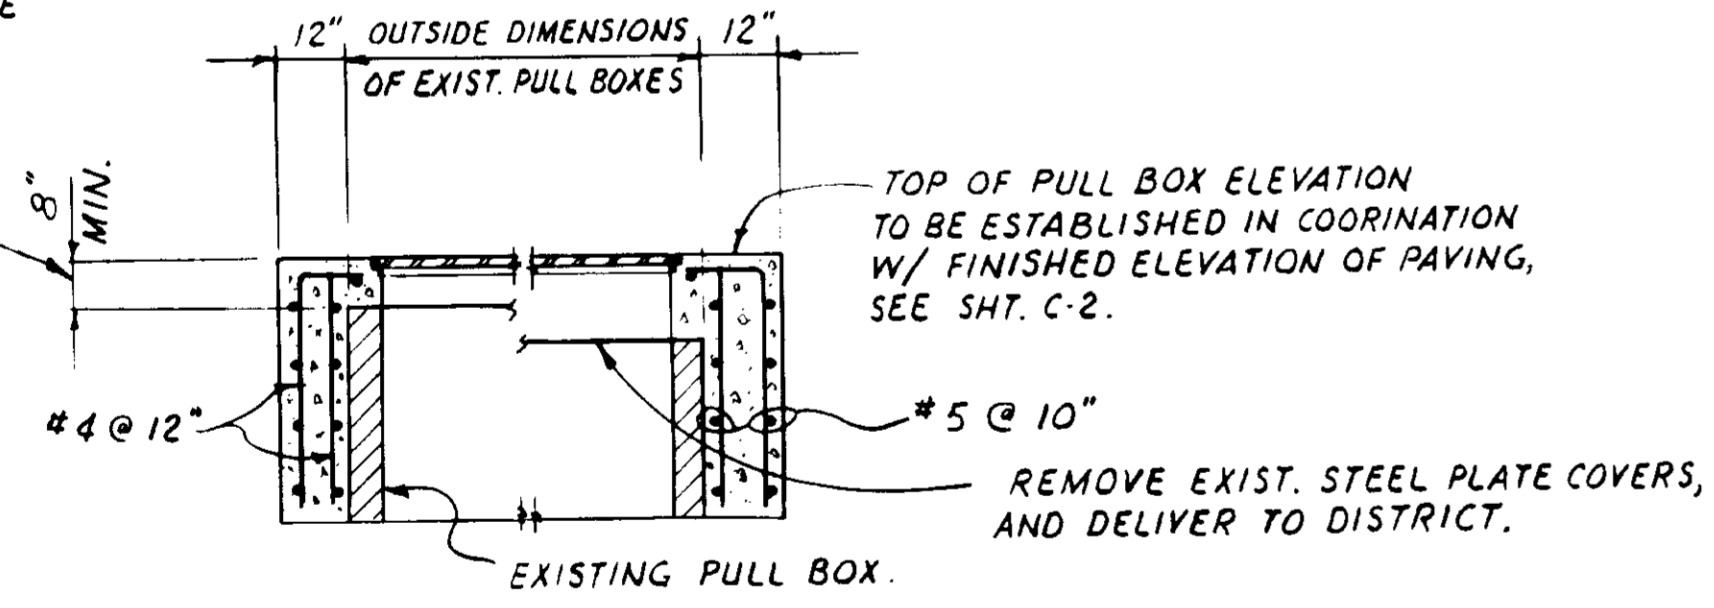


SECTION 1
SCALE 3/8" = 1'-0"

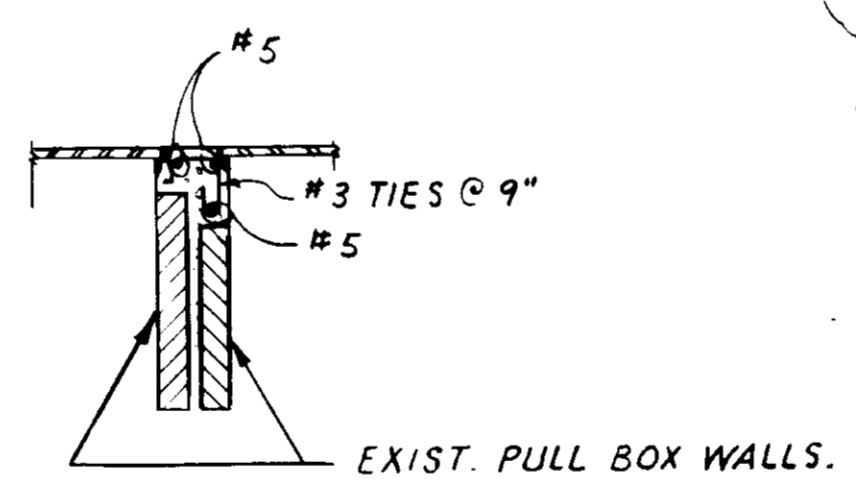

SECTION 2
SCALE 3/8" = 1'-0"

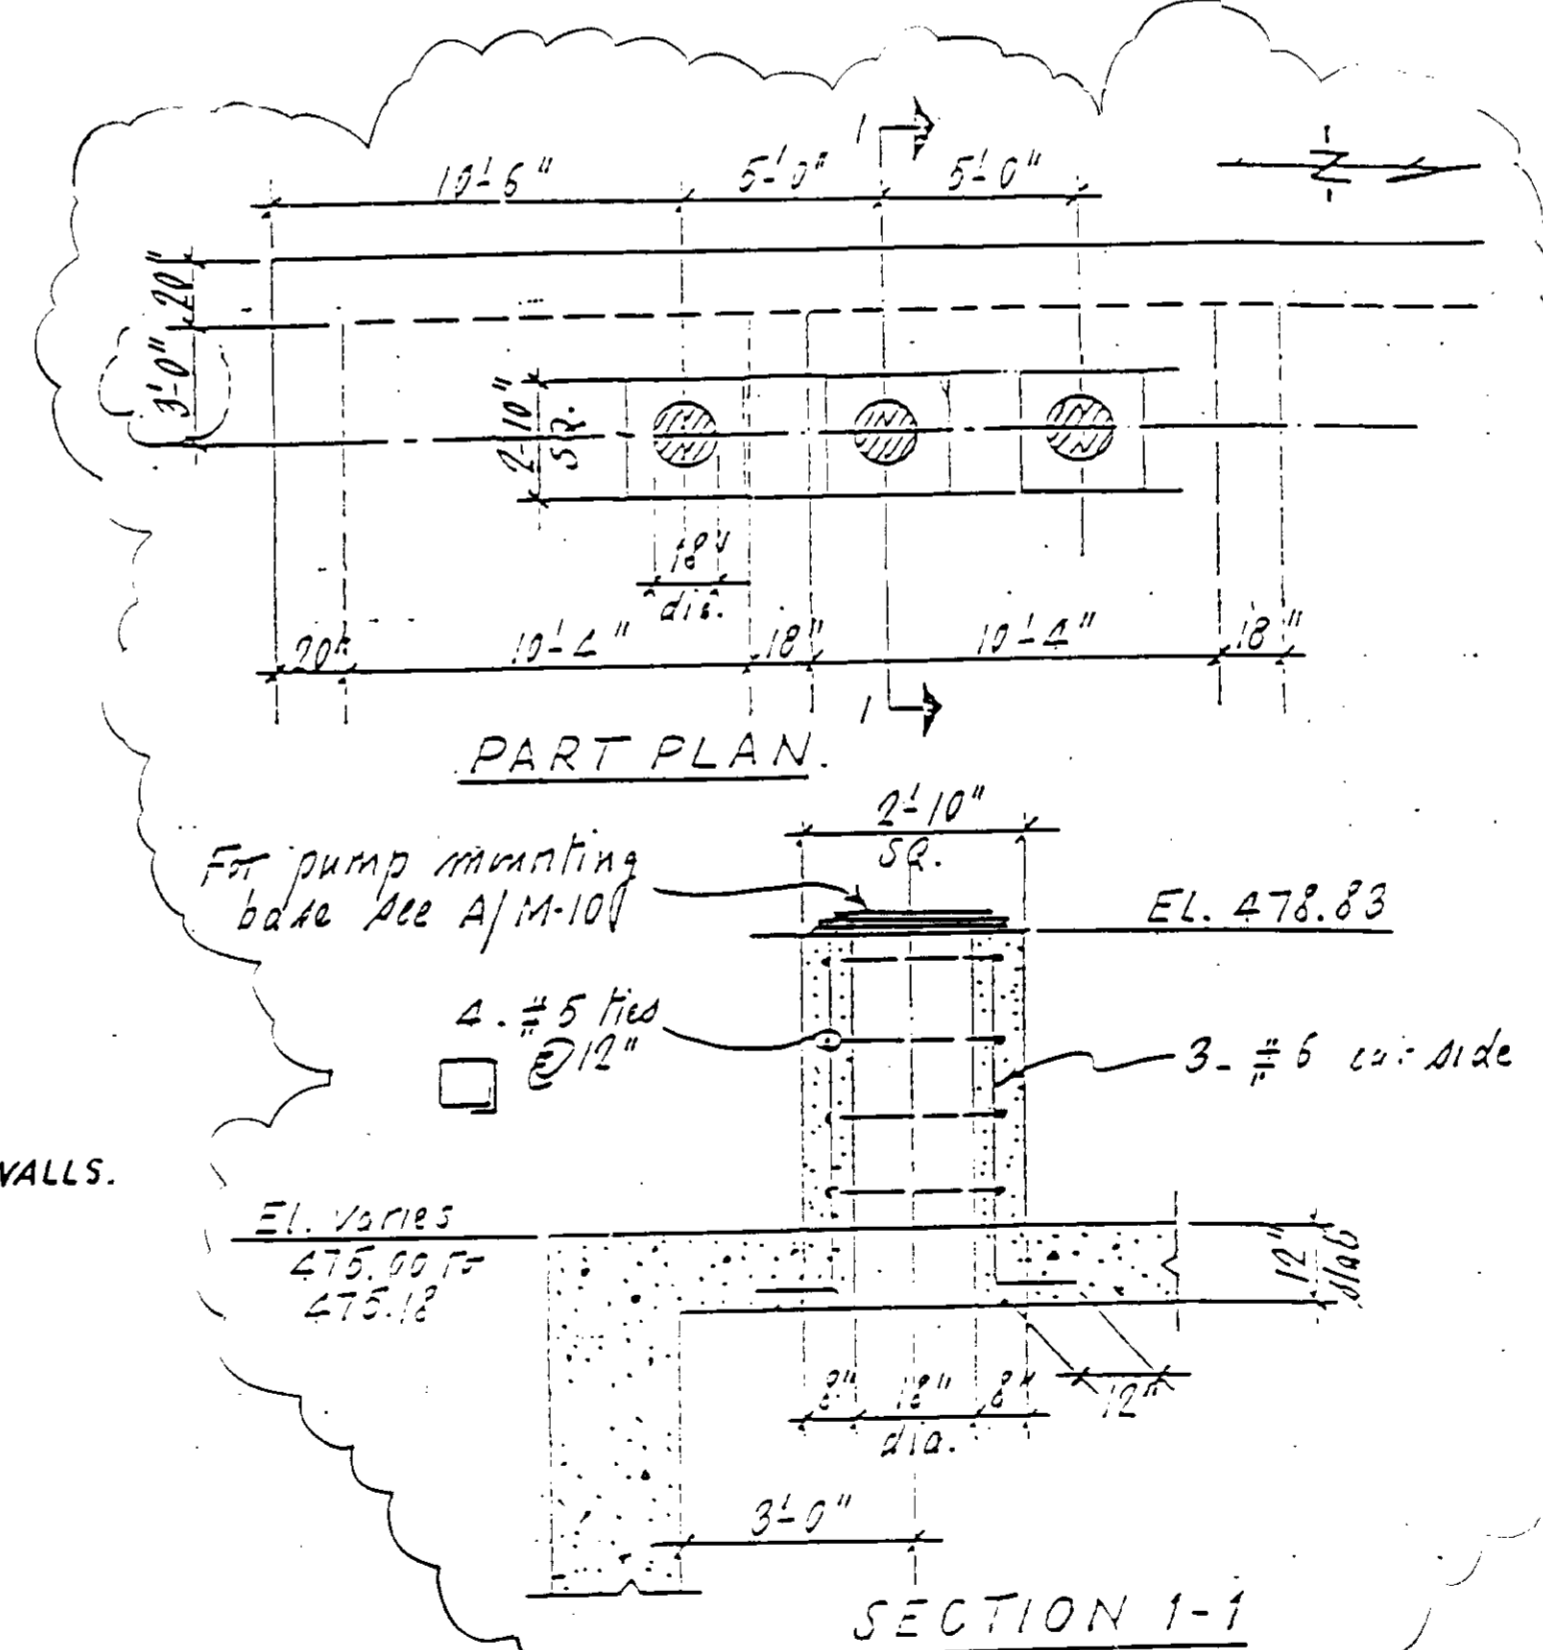

SECTION 1-1

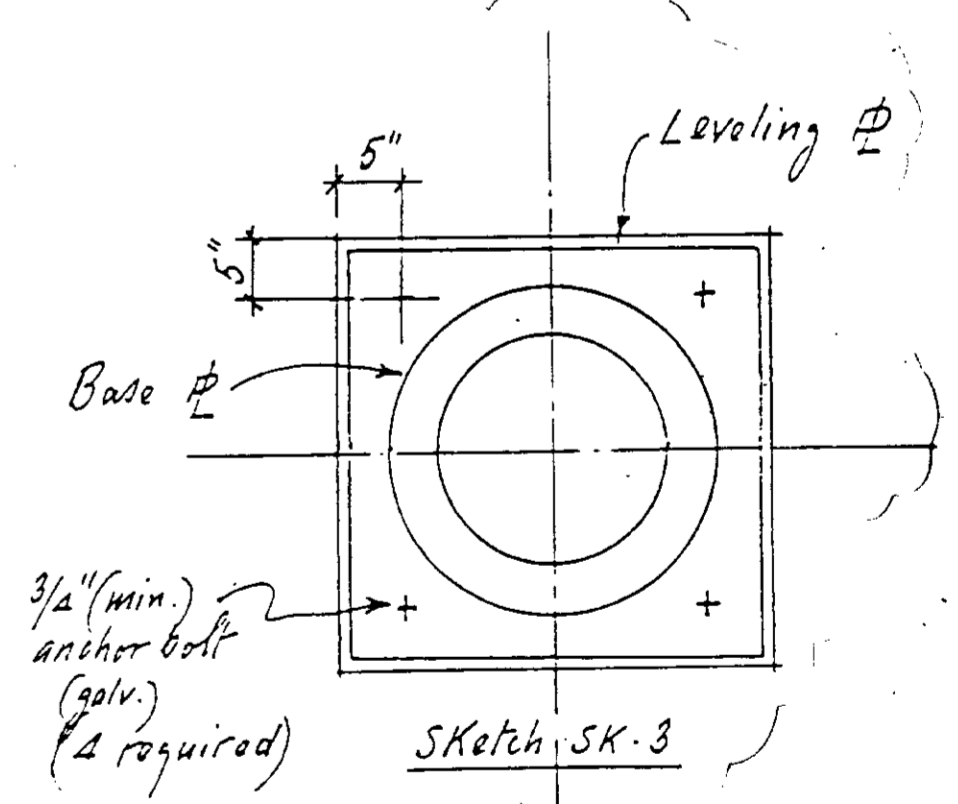

Sketch SK-3

WASTE WASHWATER PUMP BASES

03590 RECORD DRAWING

RD (1/18/81) MPJ	RECORD DRAWING
1	
2	
3	
SCALE: AS NOTED

DESIGNED P. REYMOND
DRAWN T. FLINT
CHECKED J. REYMOND


SUBMITTED 2/23/81
PROJECT ENGINEER
RECOMMENDED 2/27/81
JAMES M. MONTGOMERY CONSULTING ENGINEERS, INC.

JAMES M. MONTGOMERY CONSULTING ENGINEERS, INC.
555 EAST WALNUT STREET, PASADENA, CALIFORNIA 91101

DISTRICT APPROVAL ON TITLE PAGE

LAS VIRGENES WWD/TRIUNFO CSD
TAPIA WRF - FILTRATION/DISINFECTION ADDITION
PHASE II
MODIFICATION OF EXISTING ELECTRICAL PULL BOXES

SHEET 6S-6 OF 66 SHEETS

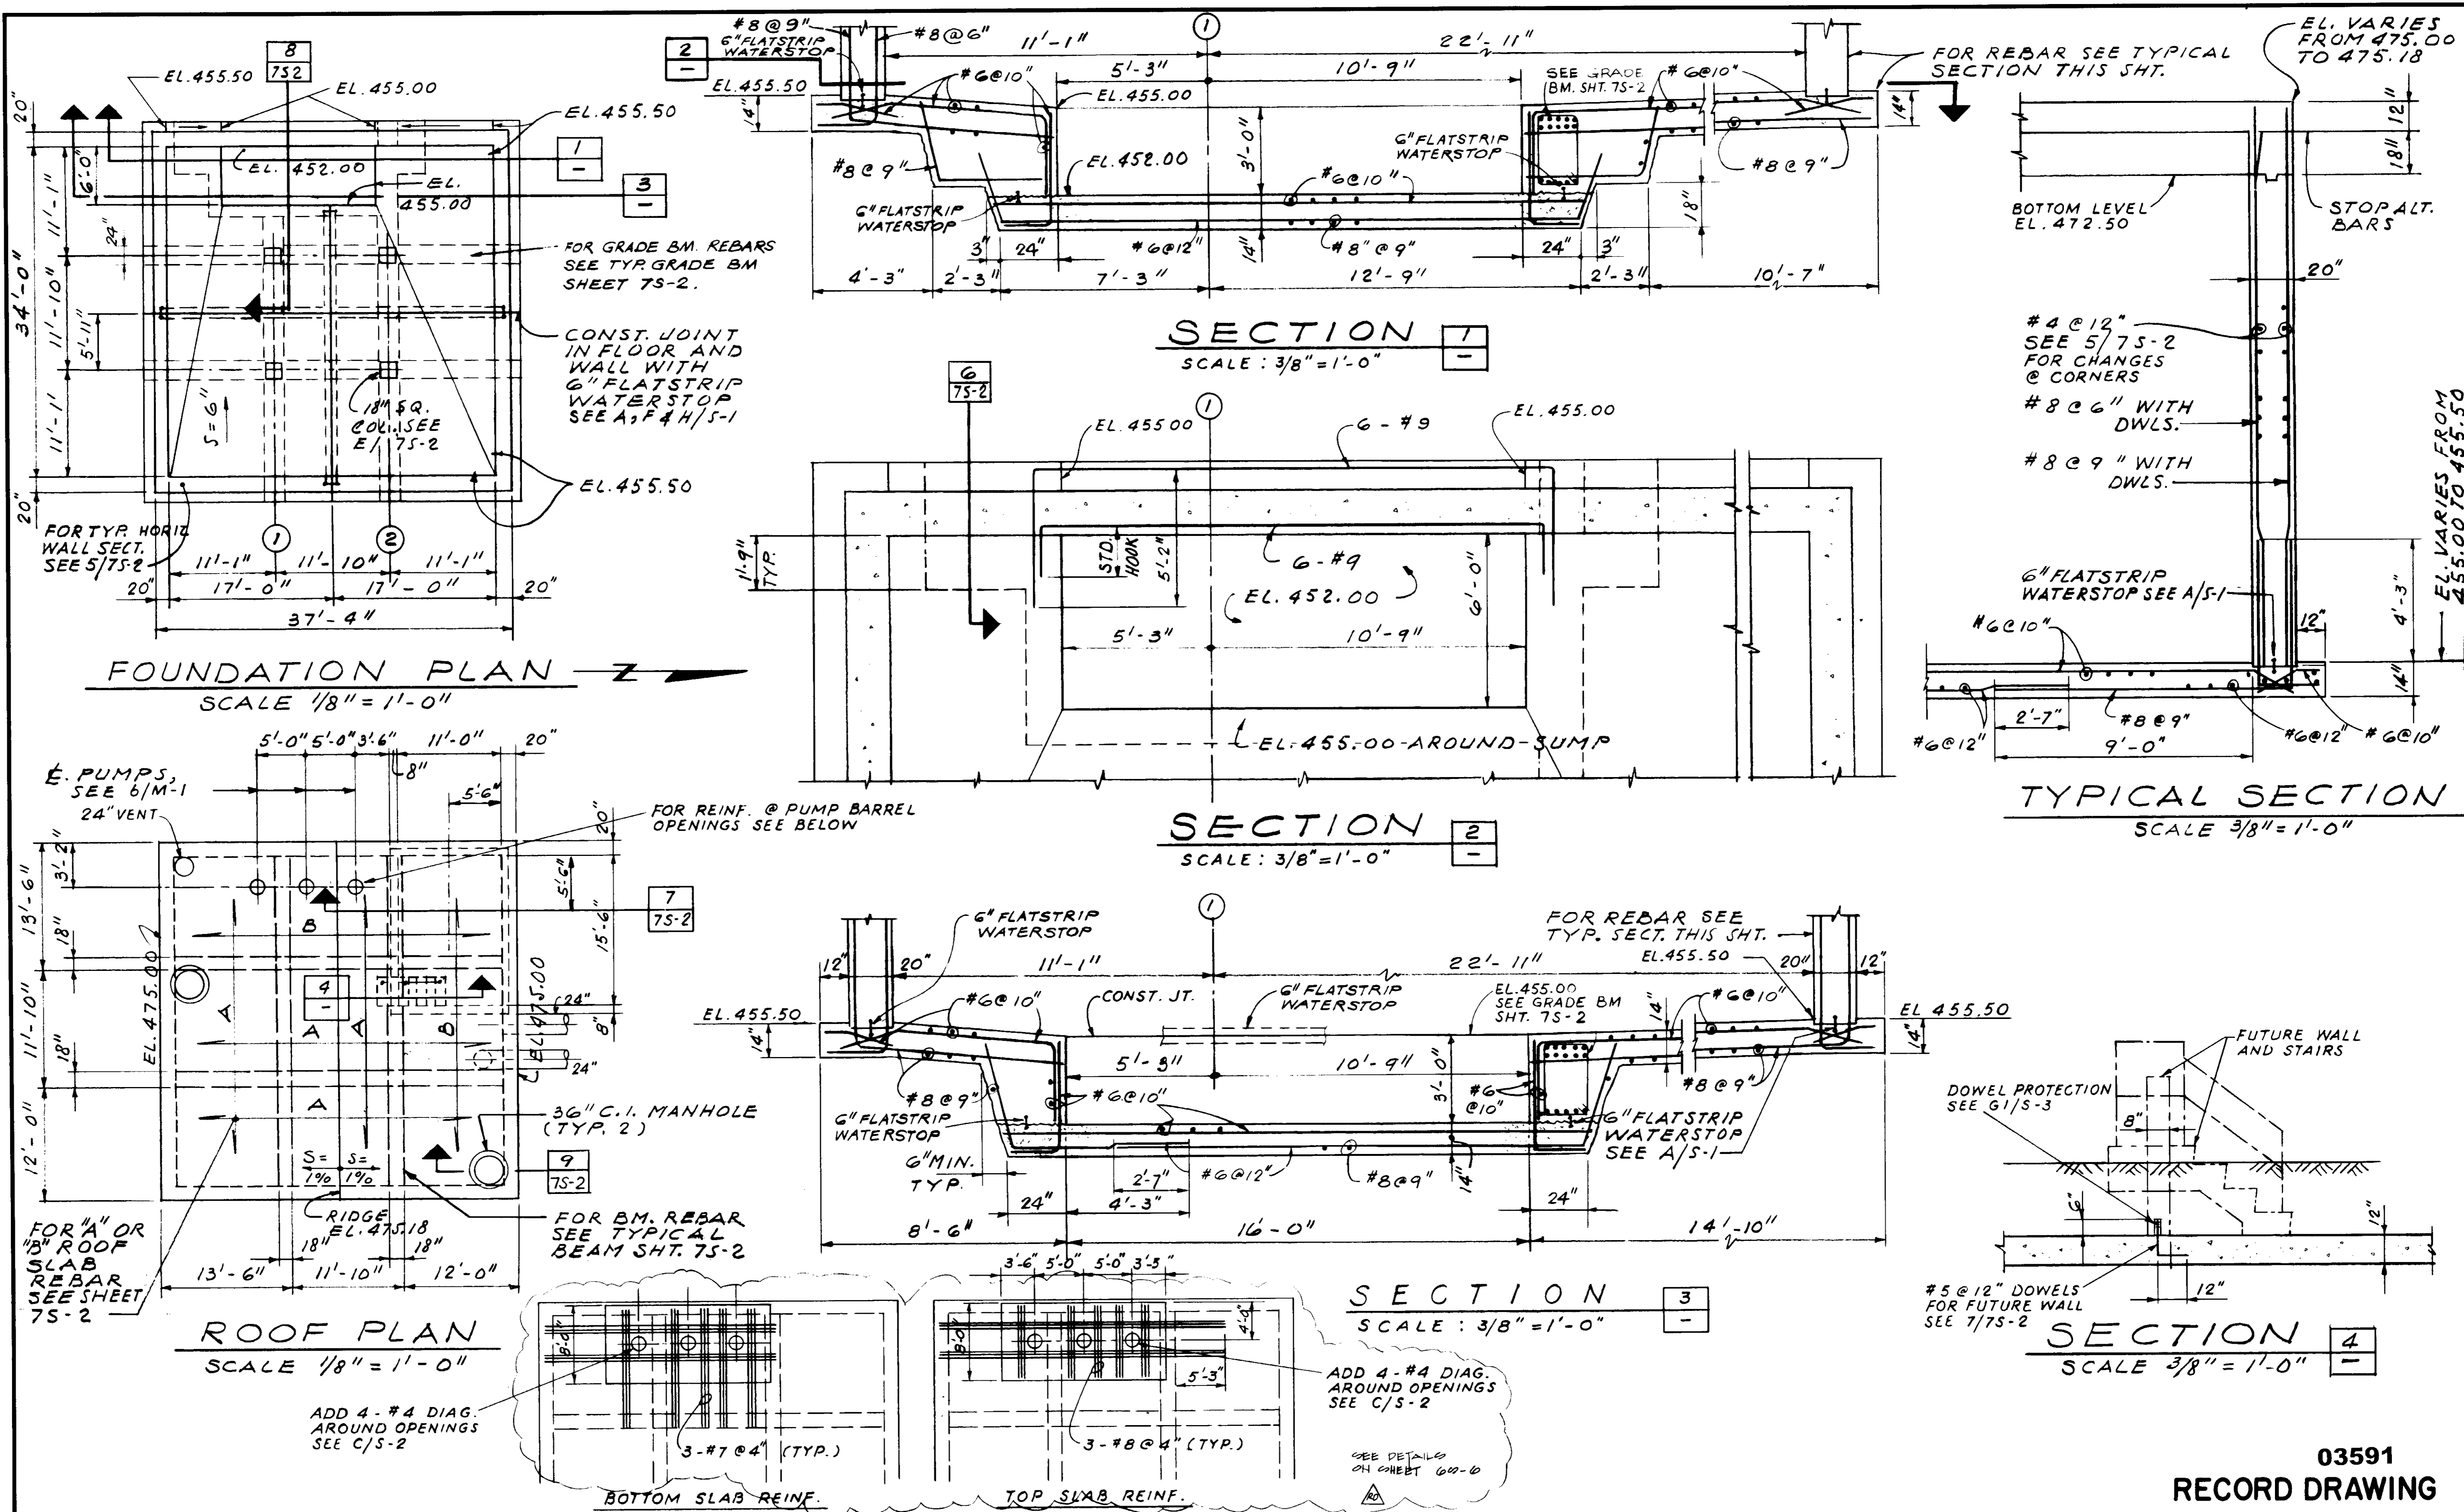

03591
RECORD DRAWING

RD	4/1/84	MDU	RECORD DRAWING
REV	DATE	BY	DESCRIPTION


SCALE:	AS NOTED
DESIGNED:	R. REYMOND
DRAWN:	JANSEN
CHECKED:	R. REYMOND
SUBMITTED:	R. REYMOND
PROJECT ENGINEER:	R. REYMOND
RECOMMENDED:	R. REYMOND
JAMES M. MONTGOMERY CONSULTING ENGINEERS, INC.	

27304 8/10/81
 R.C.E. NO. DATE
 27638 8/23/81
 R.C.E. NO. DATE
JAMES M. MONTGOMERY CONSULTING ENGINEERS, INC.
 555 EAST WALNUT STREET, PASADENA, CALIFORNIA 91101

DISTRICT APPROVAL ON TITLE PAGE

LAS VIRGENES MWD/TRIUNFO CSD		SHEET
TAPIA WRF - FILTRATION/DISINFECTION ADDITION		7S-1
PHASE II	WASTE WASHWATER TANK - PLANS AND SECTIONS	OF 66 SHEETS


JOB NO. FILE

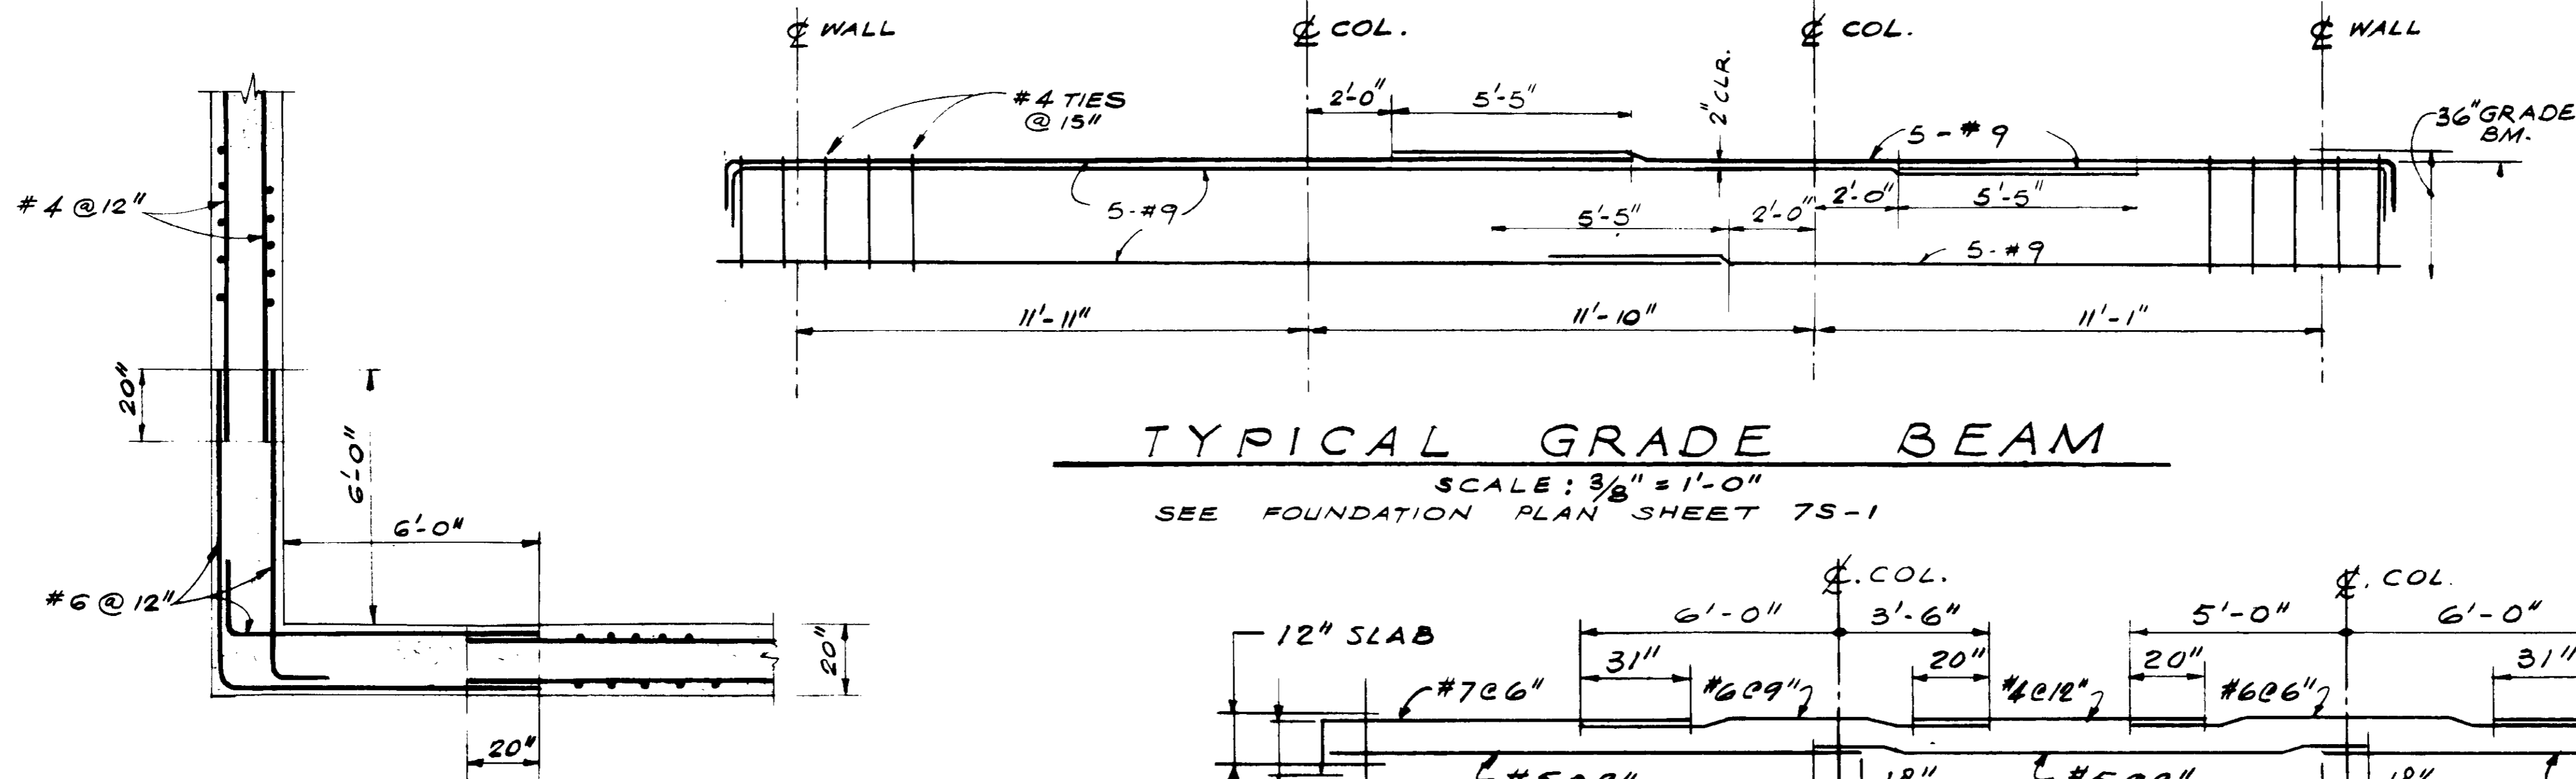

TYPICAL GRADE BEAM


SCALE: 3/8" = 1'-0"
SEE FOUNDATION PLAN SHEET 75-1

HORIZ. WALL SECTION 5
SCALE: 3/8" = 1'-0"
75-1

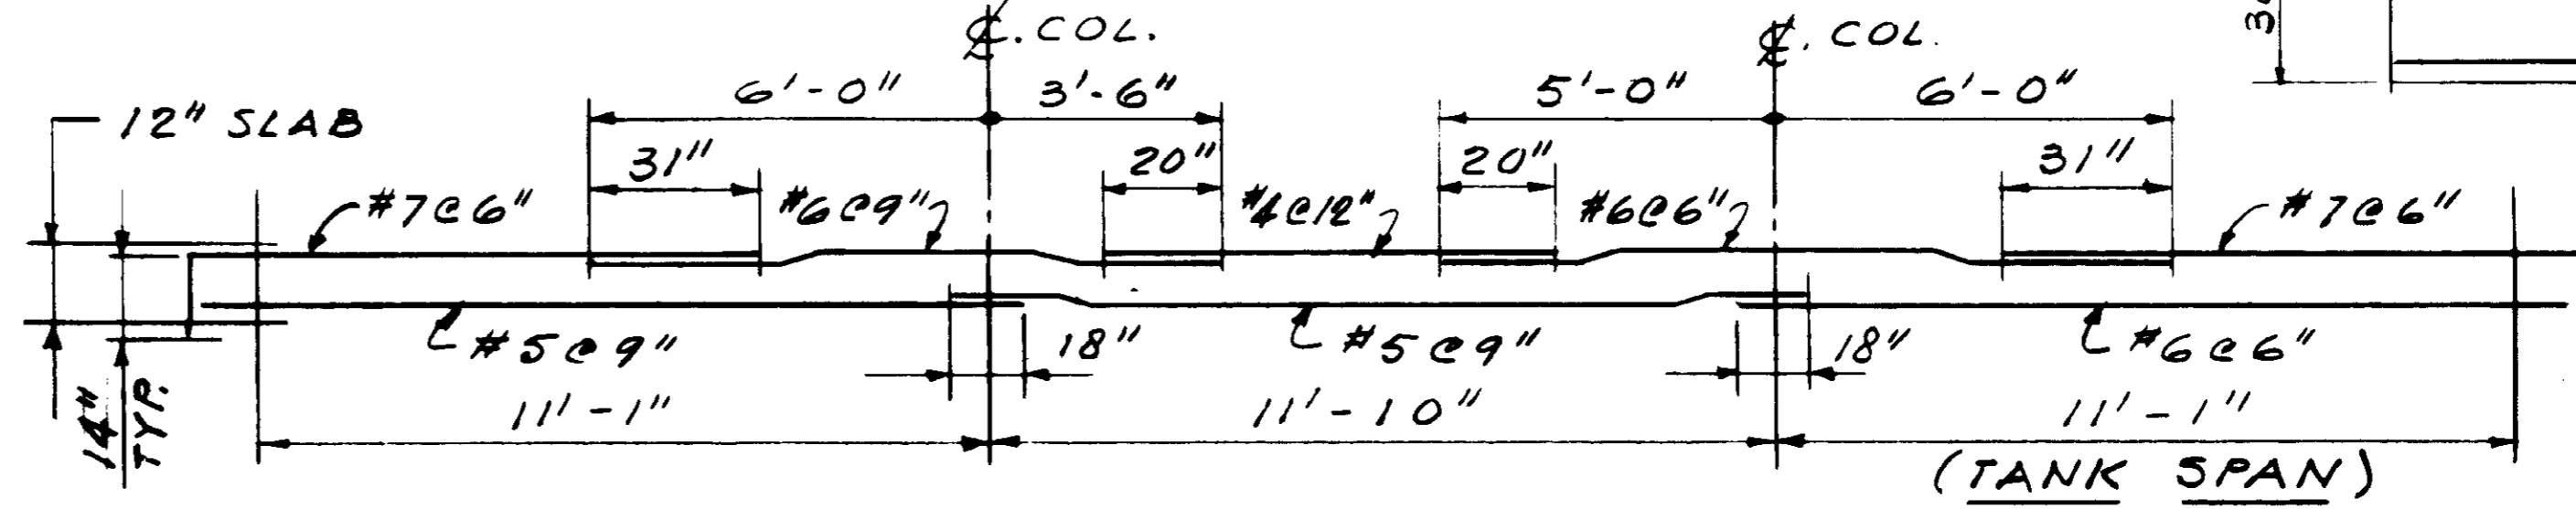


ROOF SLAB STRIP "B" SCALE 3/8" = 1'-0"

SEE ROOF PLAN SHEET 75-1

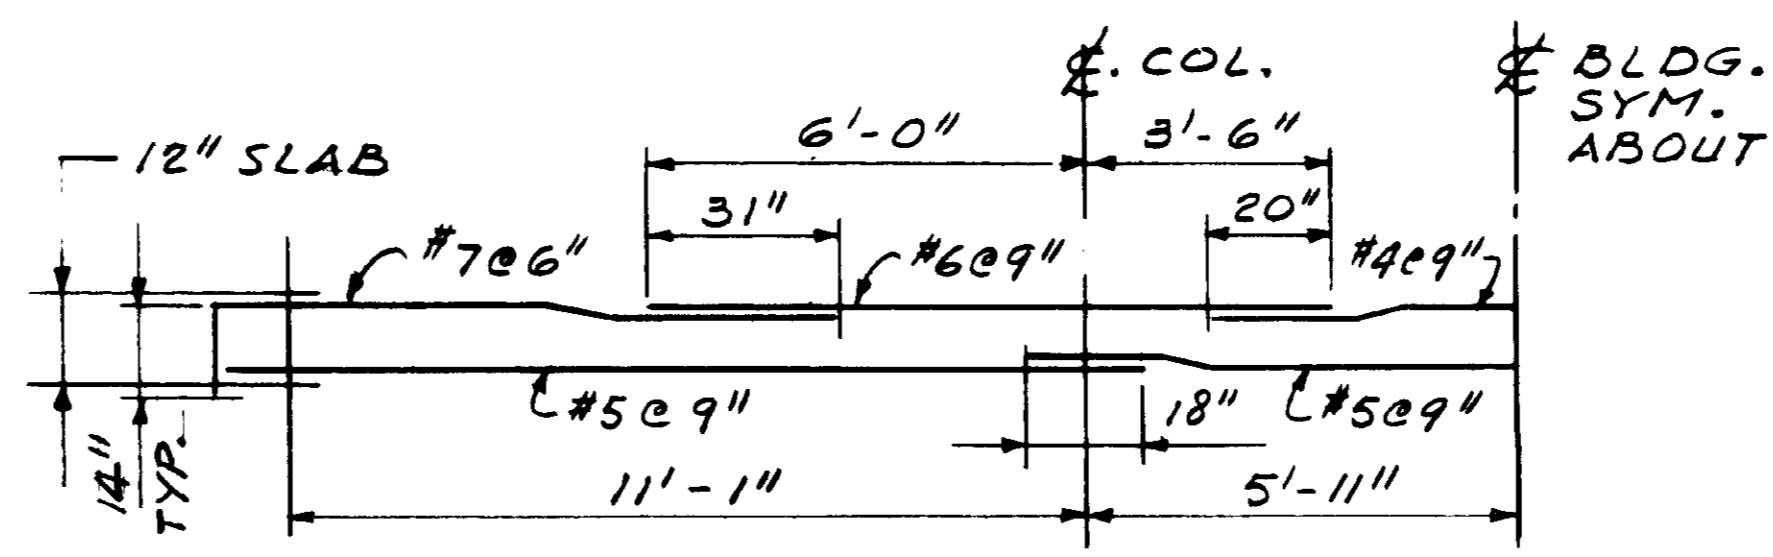

ROOF SLAB STRIP "A"


SEE ROOF PLAN SH. 75-1 SC. 3/8" = 1'-0"

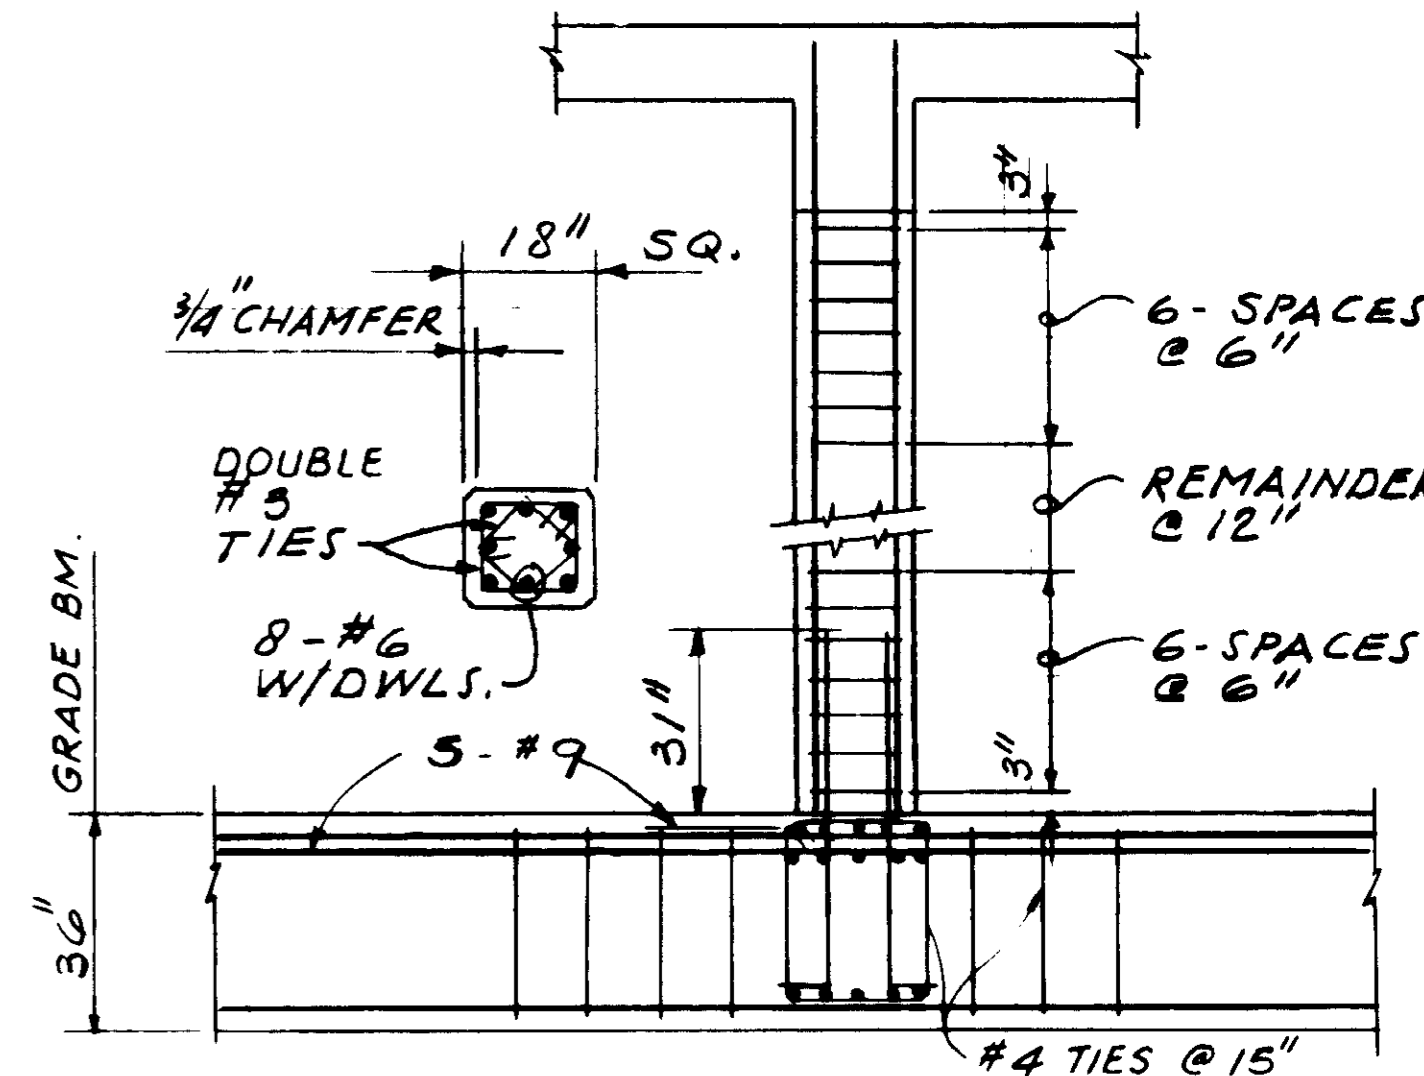

TYP. COLUMN


DETAIL E

SCALE 3/8" = 1'-0" 75-1

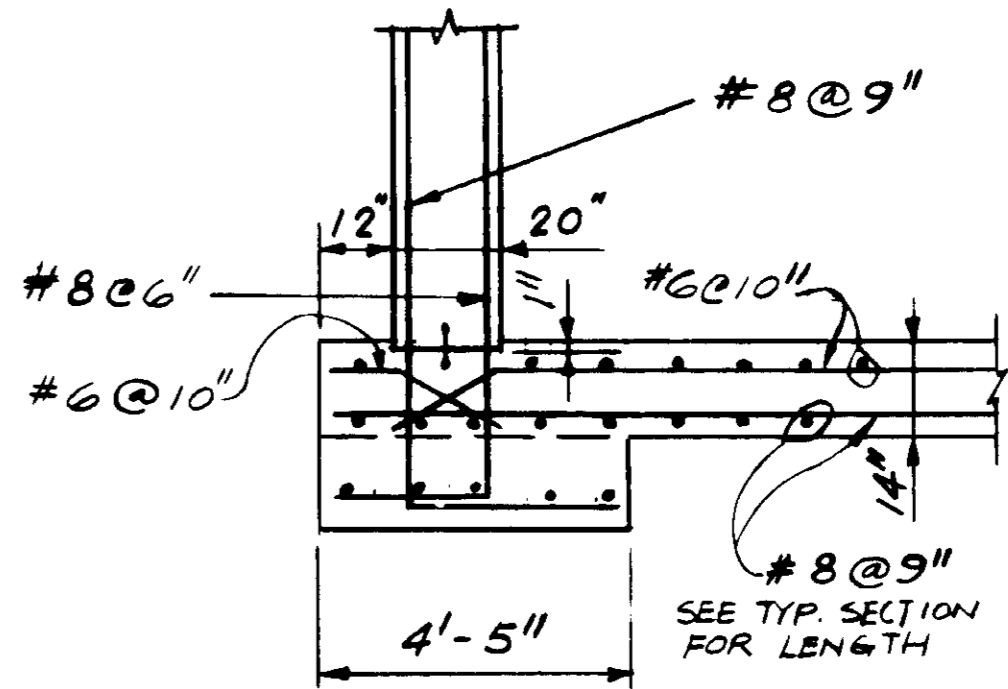


SECTION 6

SCALE 3/8" = 1'-0" 75-1

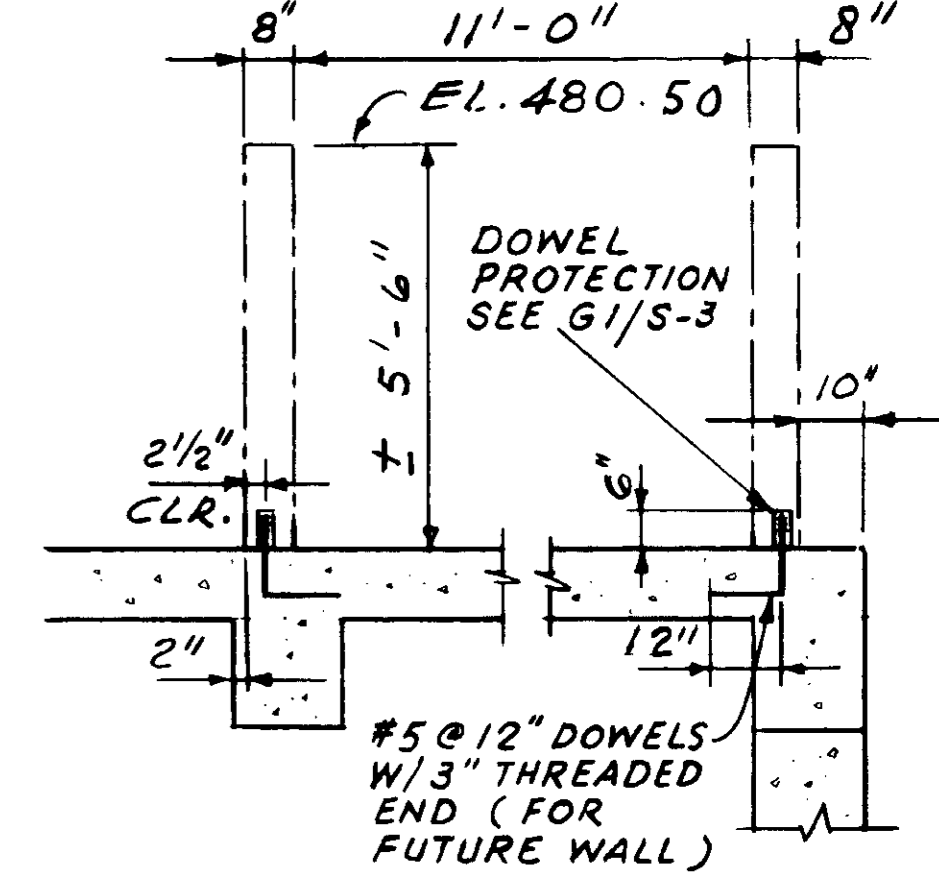


SECTION 7

SCALE 3/8" = 1'-0" 75-1

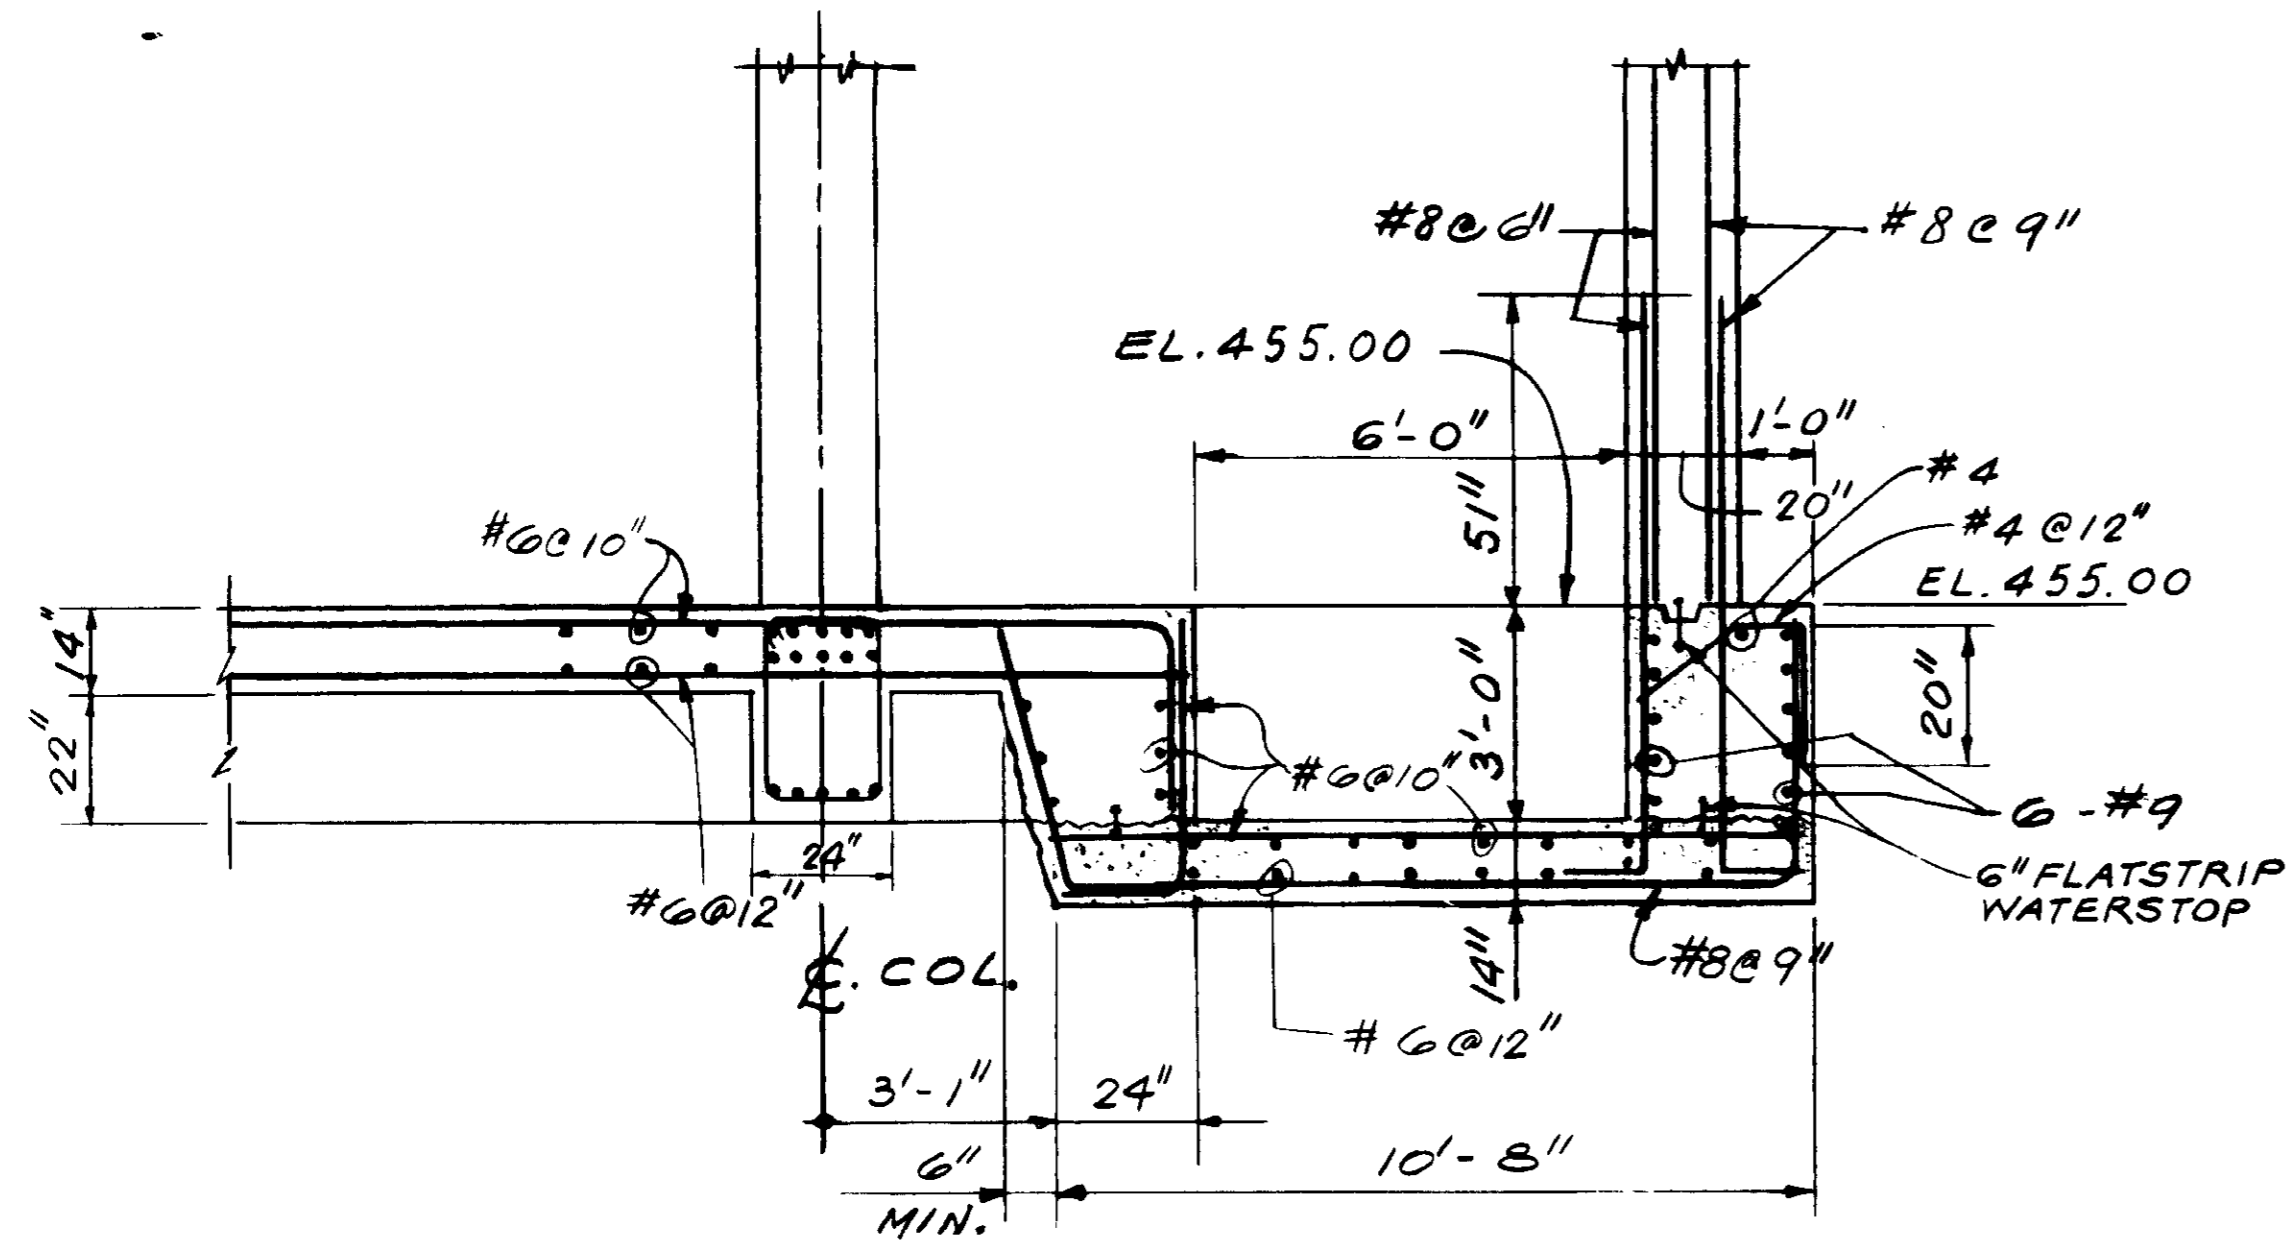


SECTION 8

SCALE 3/8" = 1'-0" 75-1

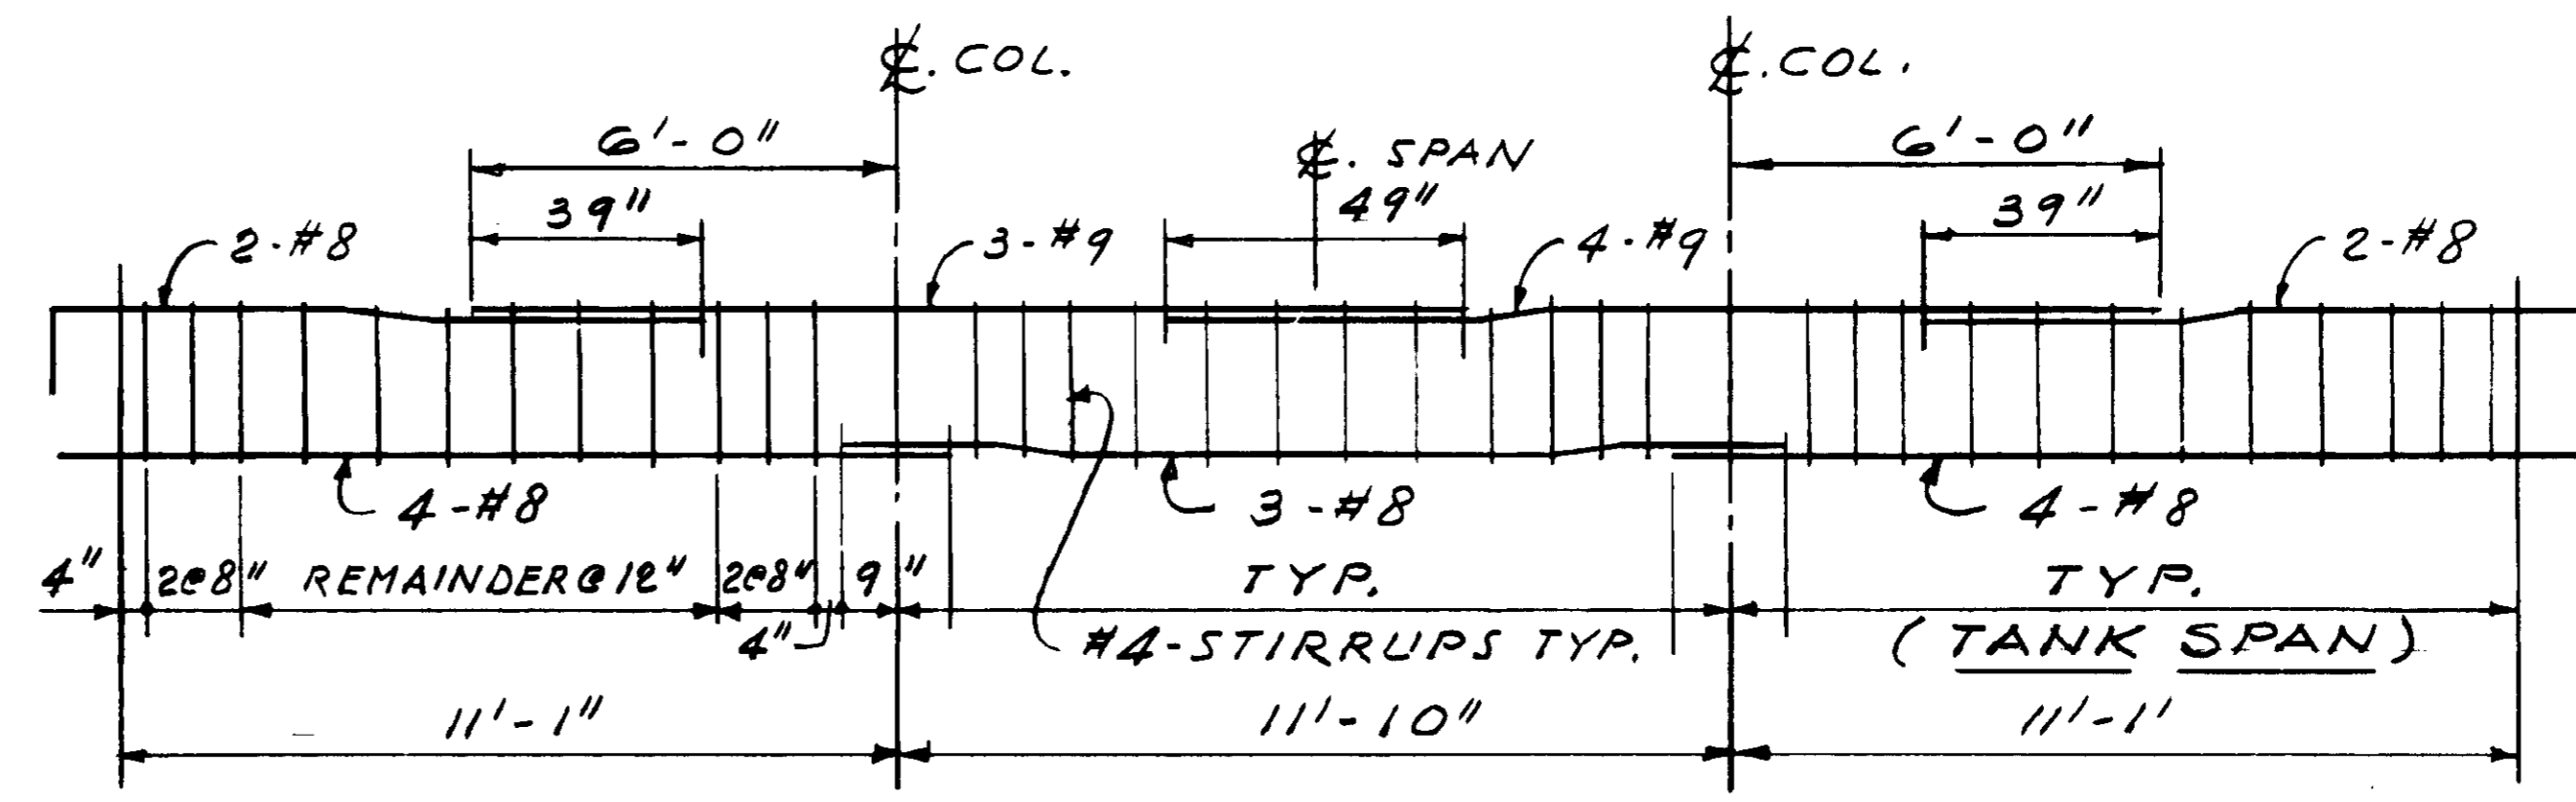

TYPICAL BEAM NOTE TANK SPAN!

SCALE 3/8" = 1'-0"

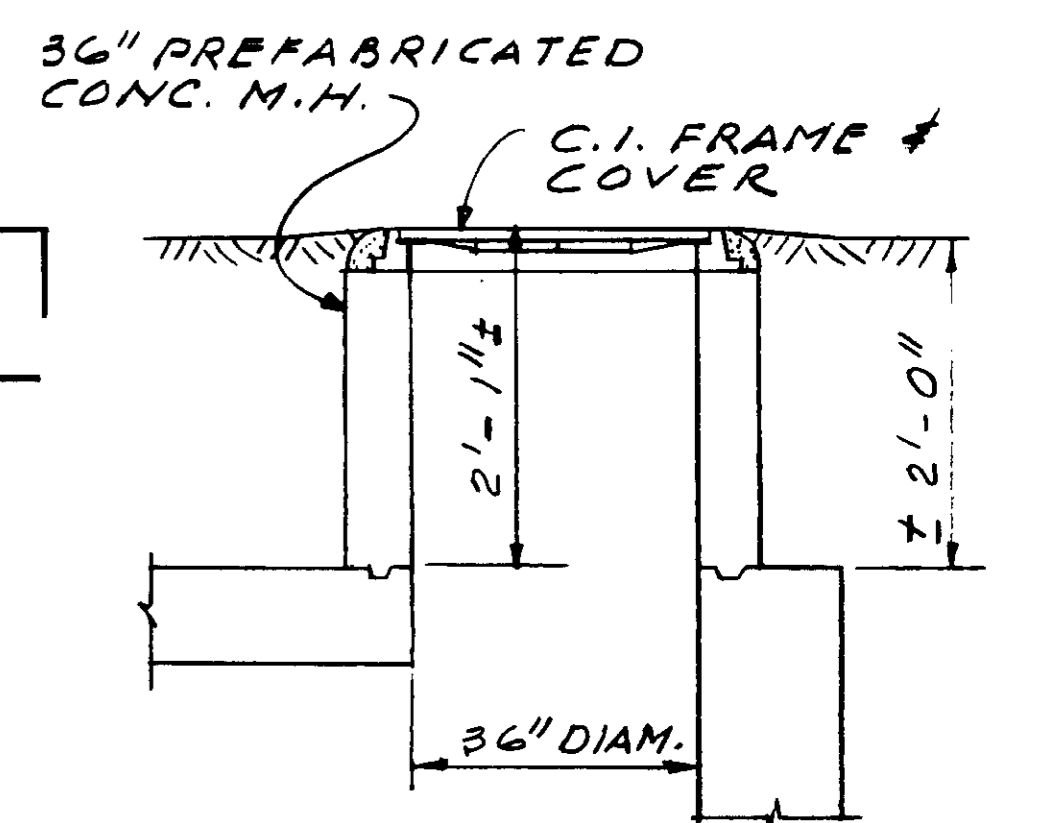


SECTION 9

SCALE 1/2" = 1'-0" 75-1


RECORD DRAWING

DESIGNED AREYMOND DRAWN JANSEN CHECKED AREYMOND		SUBMITTED D. J. C. Smith PROJECT ENGINEER RECOMMENDED D. J. C. Smith JAMES M. MONTGOMERY CONSULTING ENGINEERS, INC.		27304 R.C.E. NO. 8/19/81 DATE		27638 R.C.E. NO. 8/20/81 DATE		LAS VIRGENES MWD/TRIUNFO CSD TAPIA WRF - FILTRATION/DISINFECTION ADDITION PHASE II		DISTRICT APPROVAL ON TITLE PAGE		SHEET 7S-2 OF 66 SHEETS	
SCALE: AS NOTED		JAMES M. MONTGOMERY CONSULTING ENGINEERS, INC. 555 EAST WALNUT STREET, PASADENA, CALIFORNIA 91101		03592		WASTE WASHWATER TANK - SECTIONS AND DETAILS		LAS VIRGENES MWD/TRIUNFO CSD TAPIA WRF - FILTRATION/DISINFECTION ADDITION		SHEET 7S-2 OF 66 SHEETS			


JOB NO. FILE DC 279

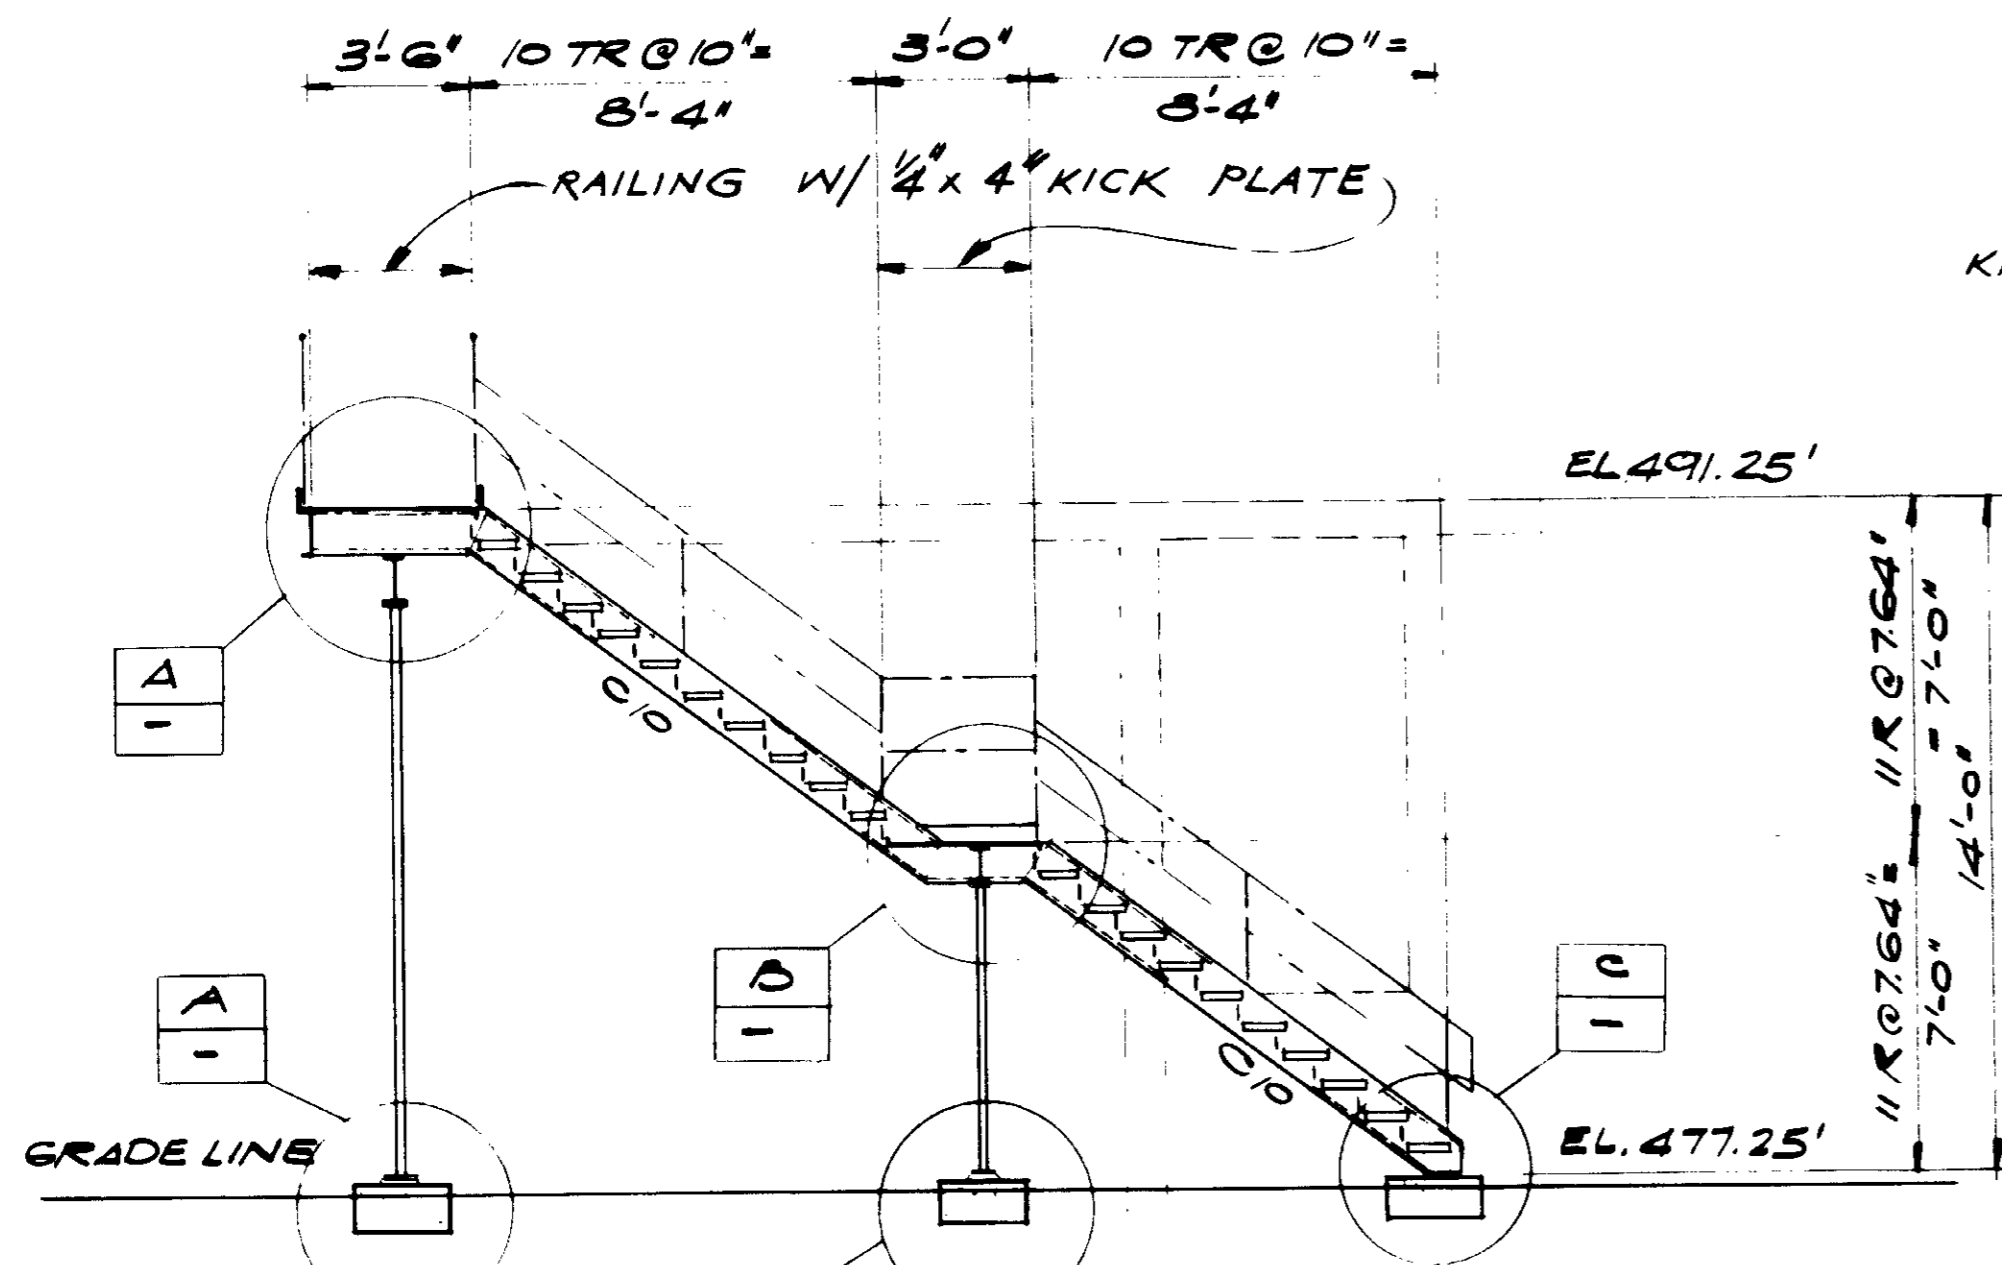


SECTION 1
SCALE: 4" = 1'-0"

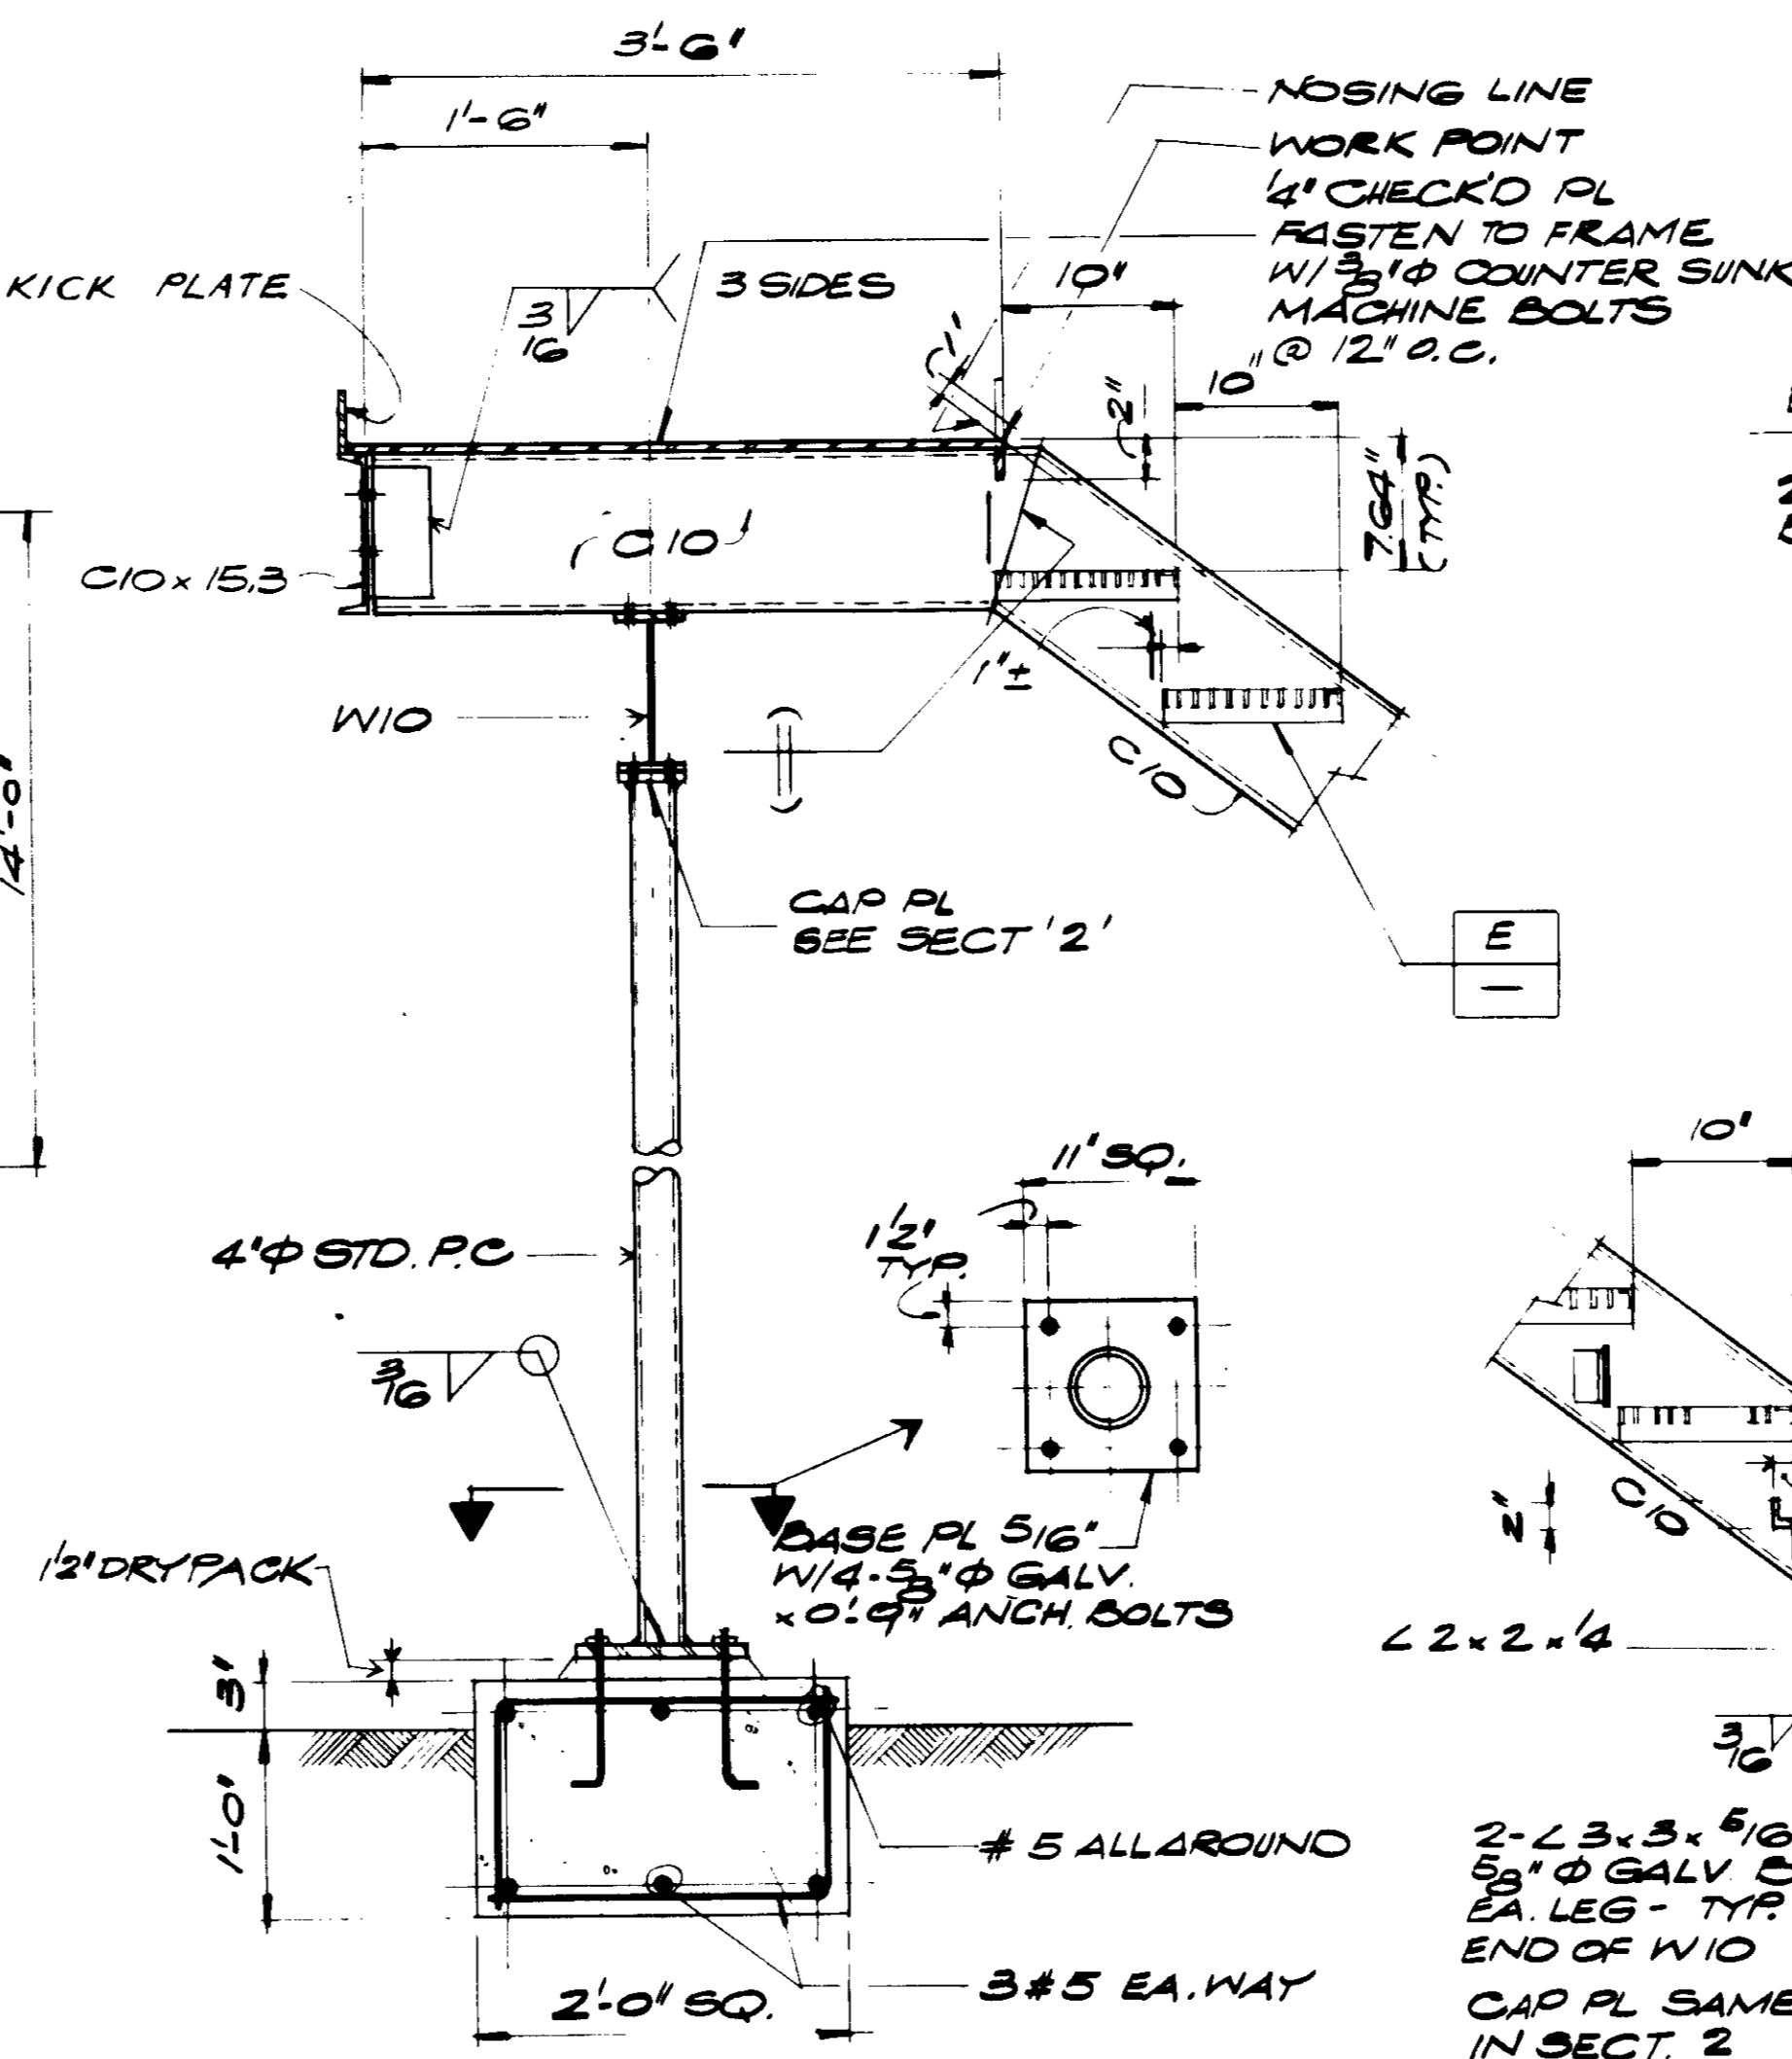


DETAIL A
SCALE: 1" = 1'-0"

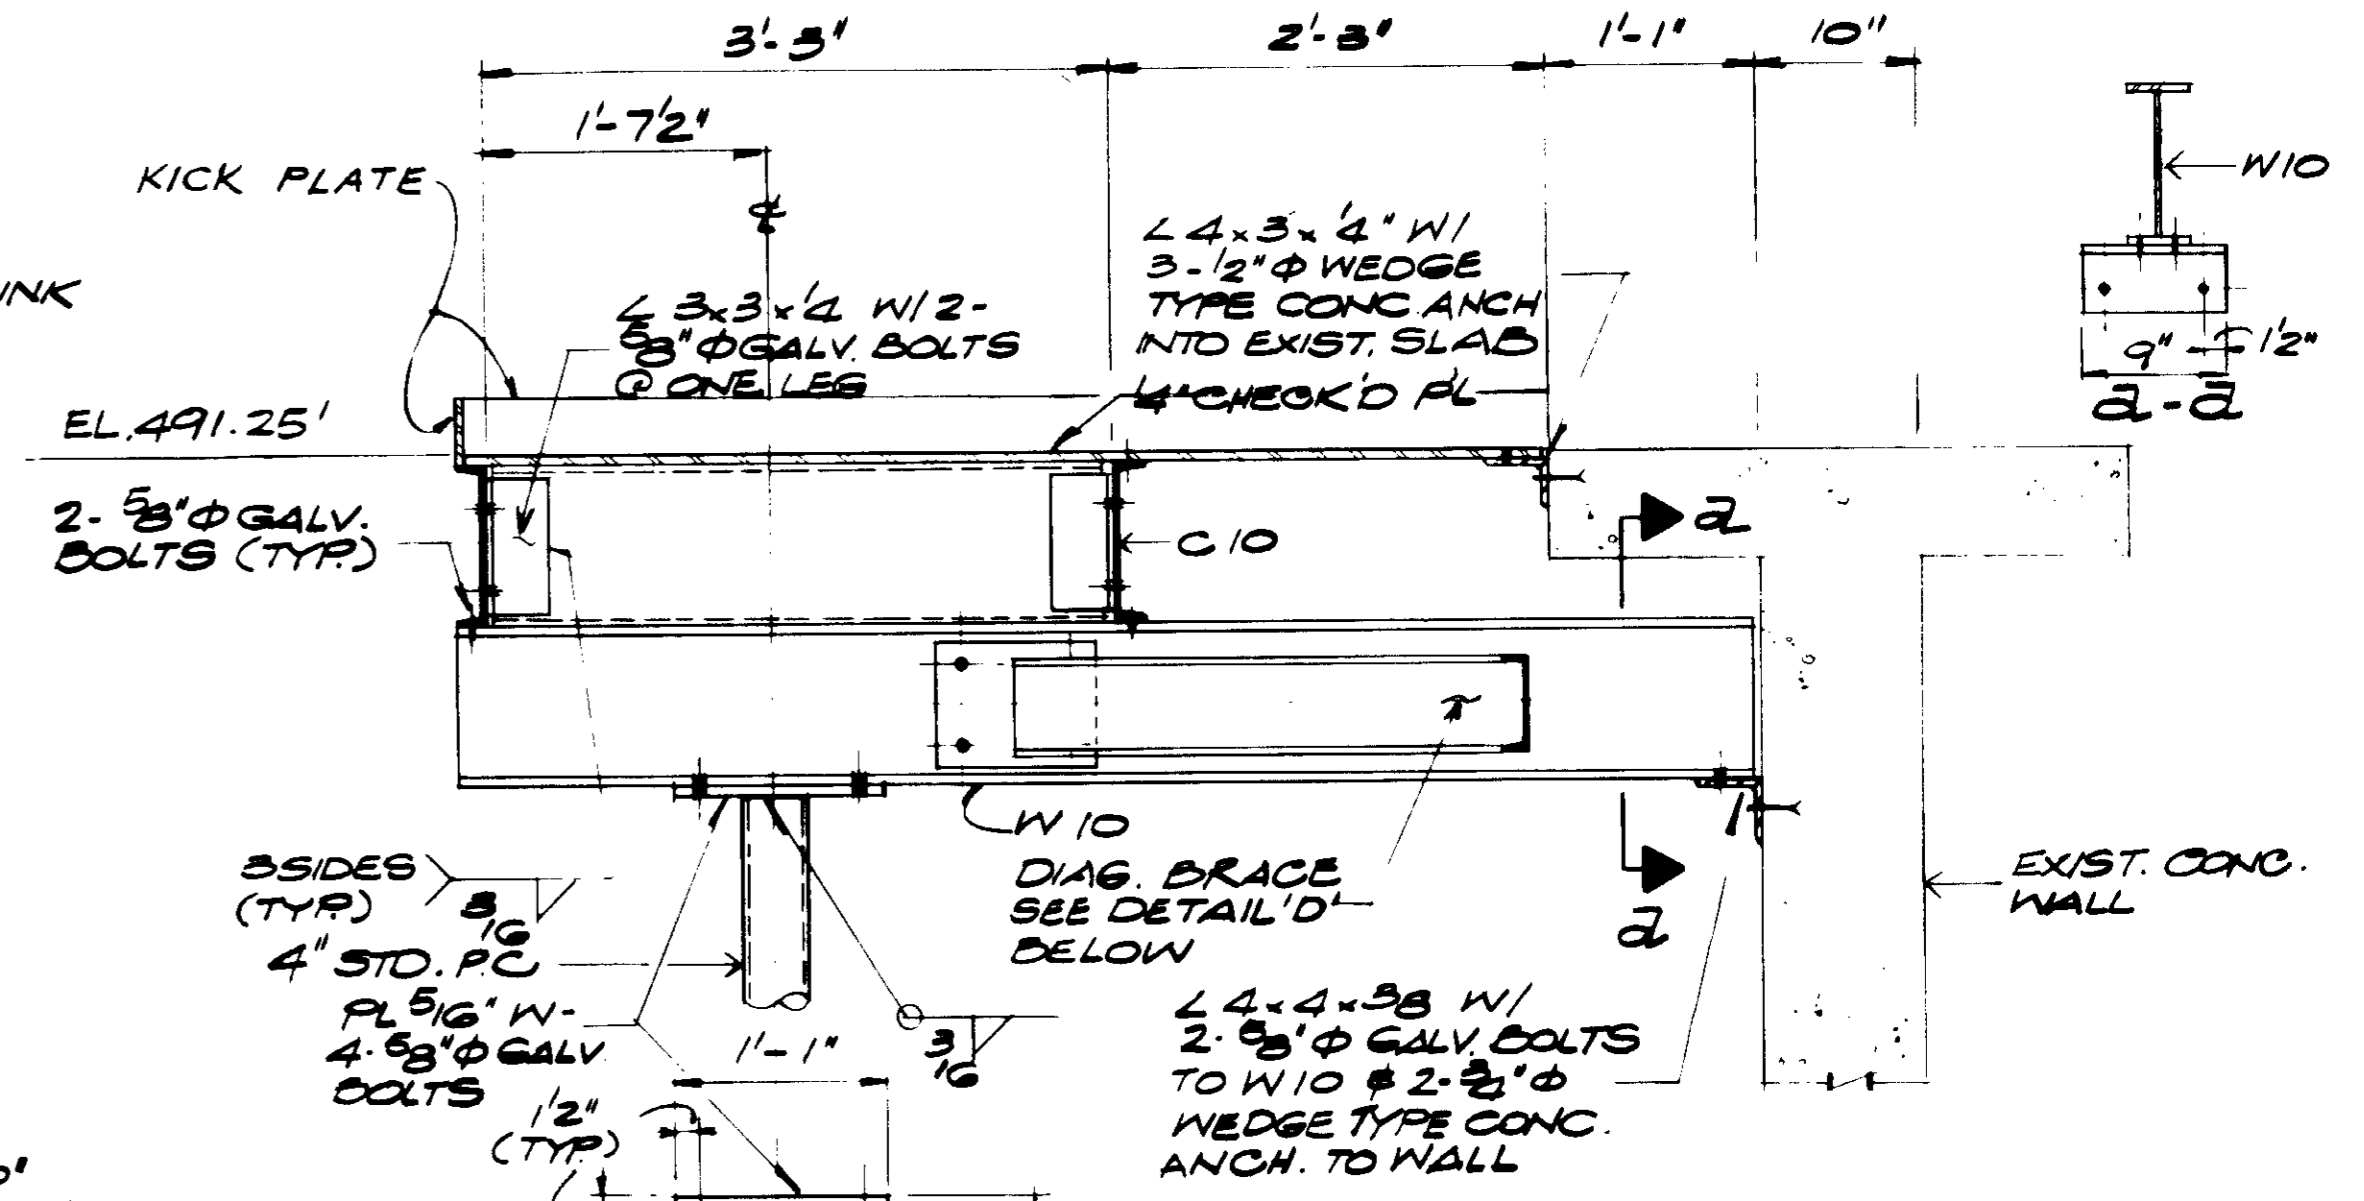


SECTION 2
1" = 1'-0"

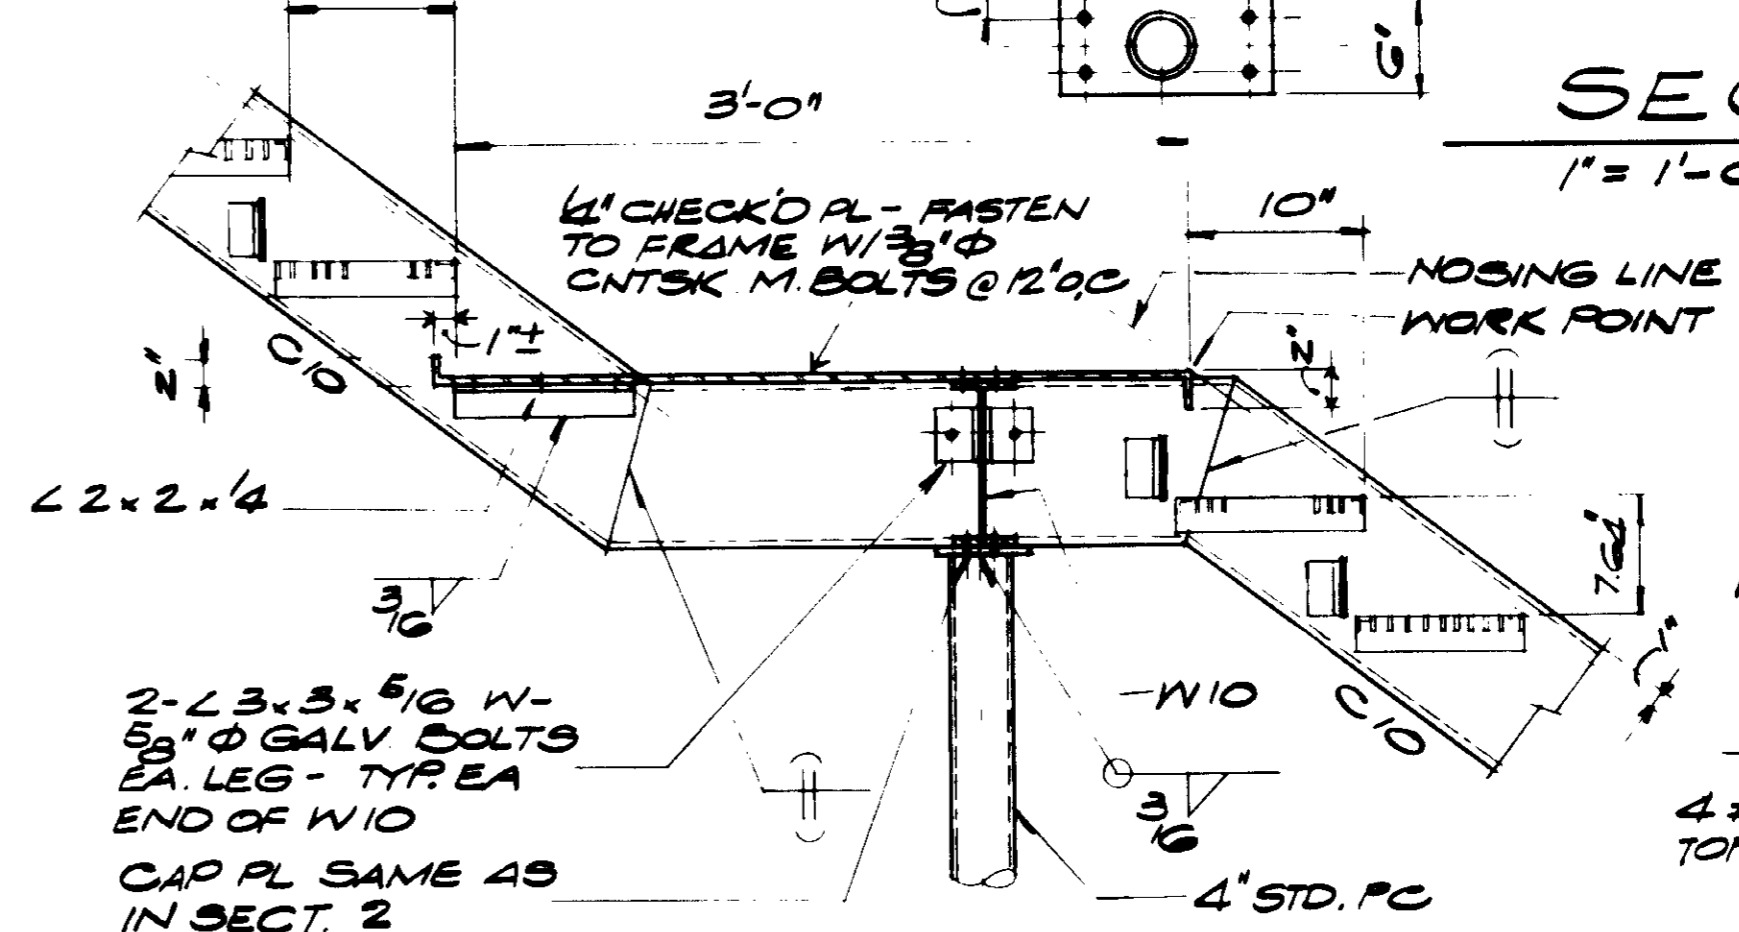


DETAIL B
1" = 1'-0"

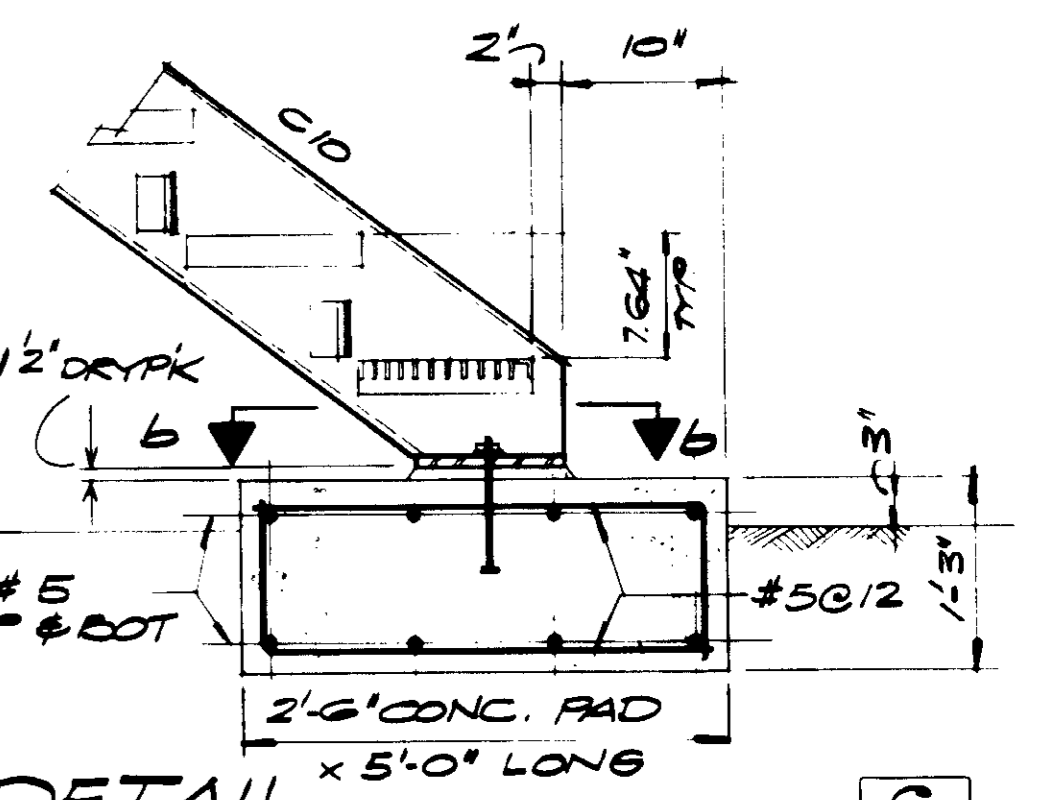


DETAIL C
1" = 1'-0"

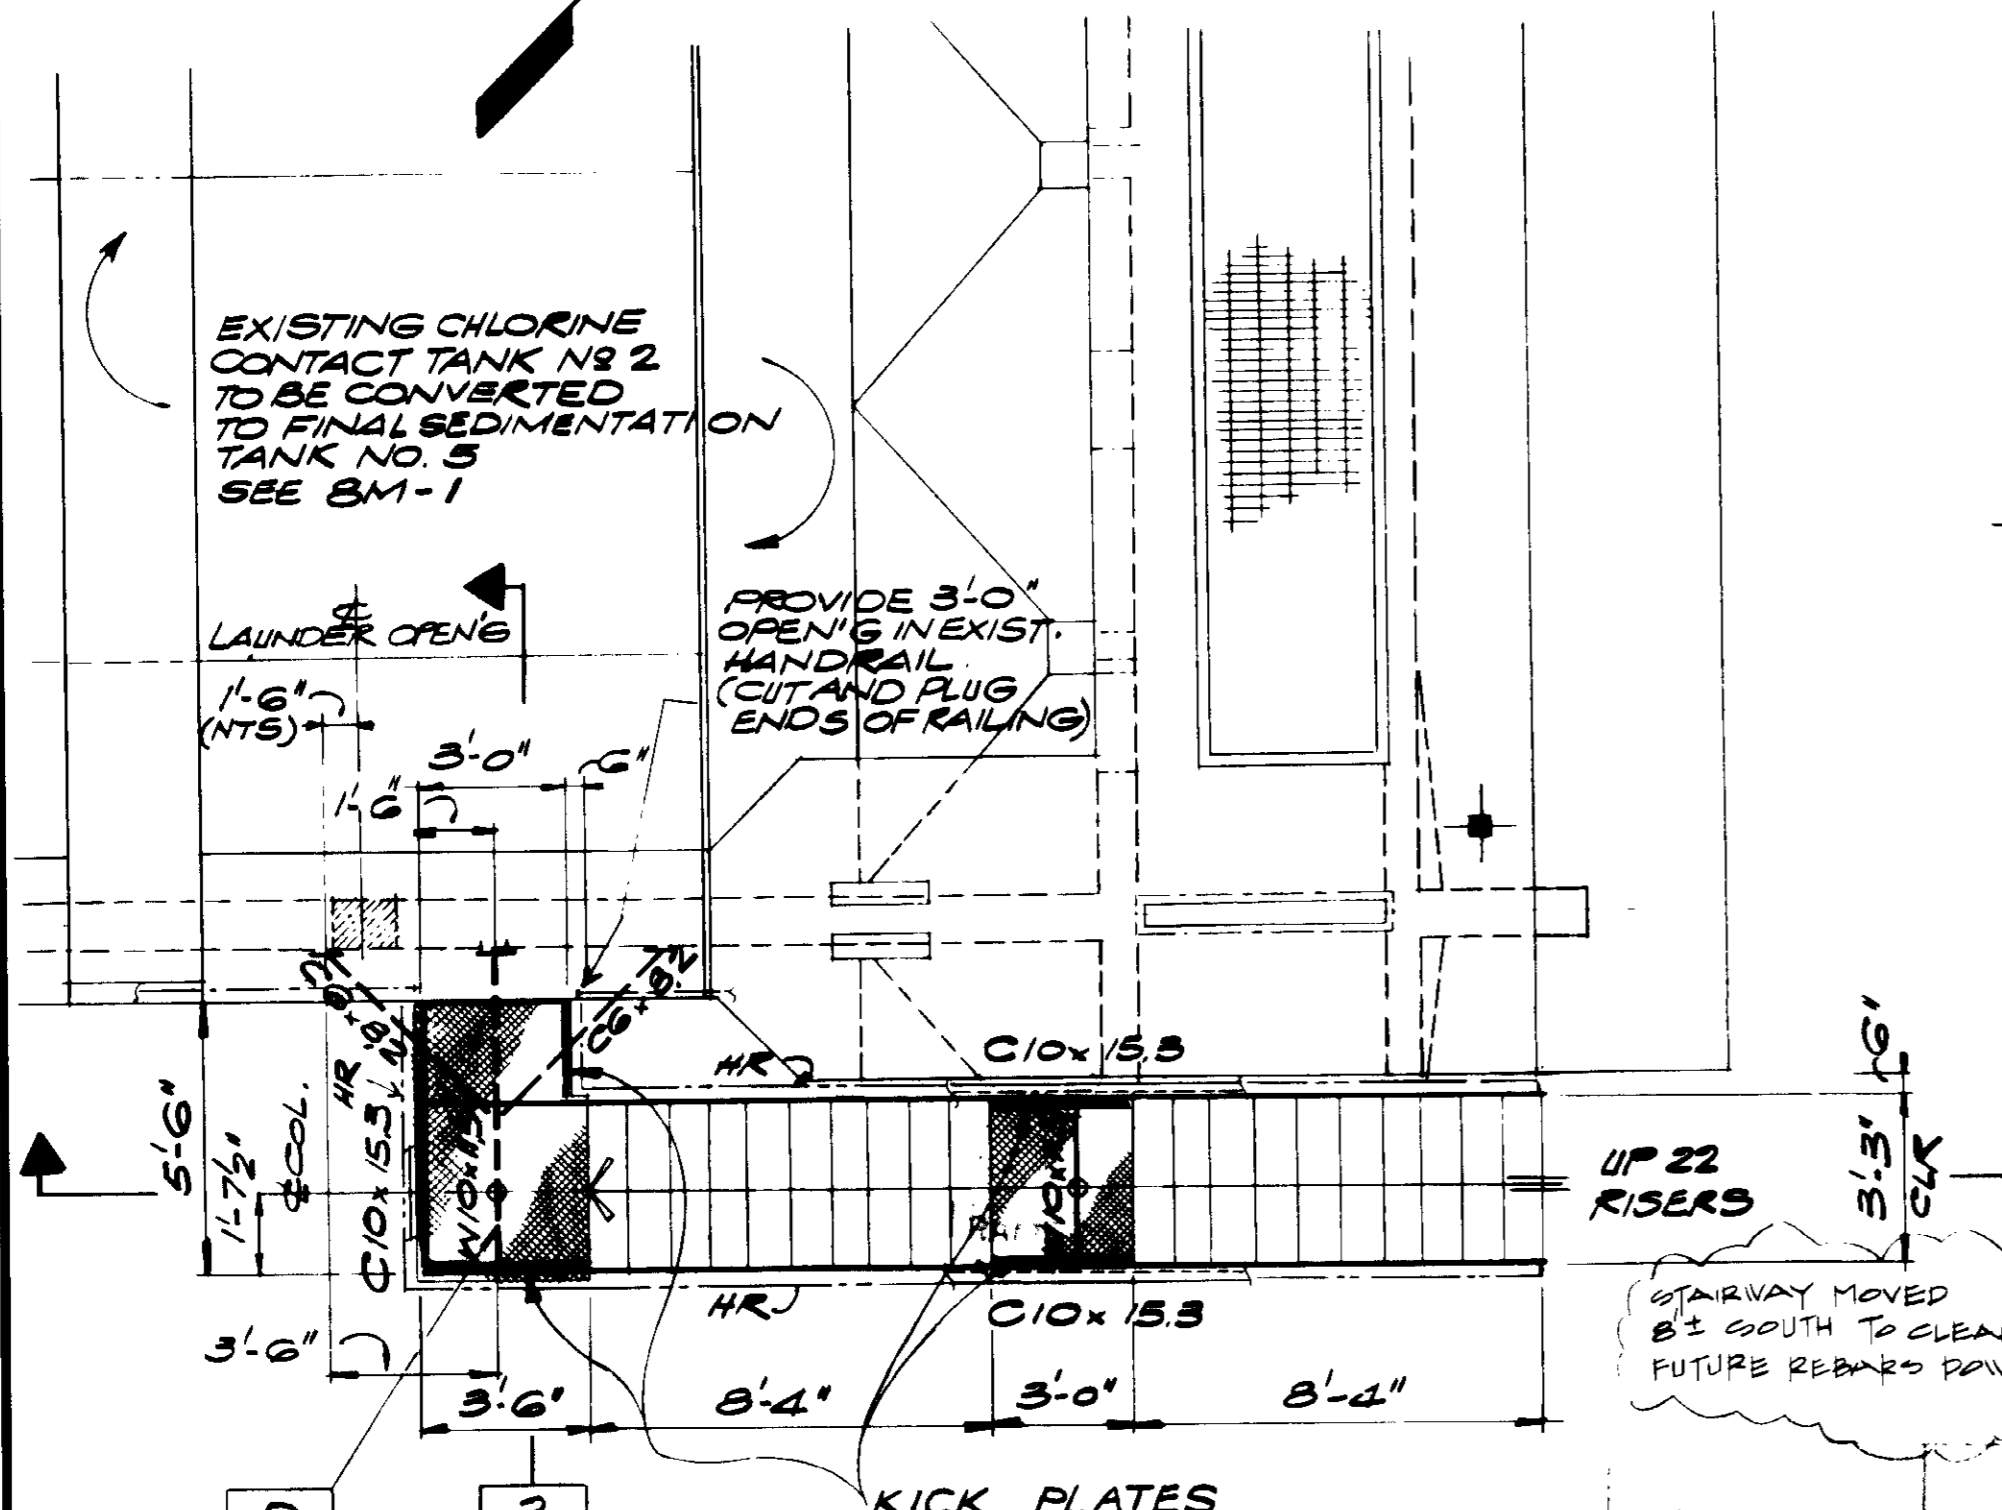


STAIR PLAN
SCALE: 4" = 1'-0"

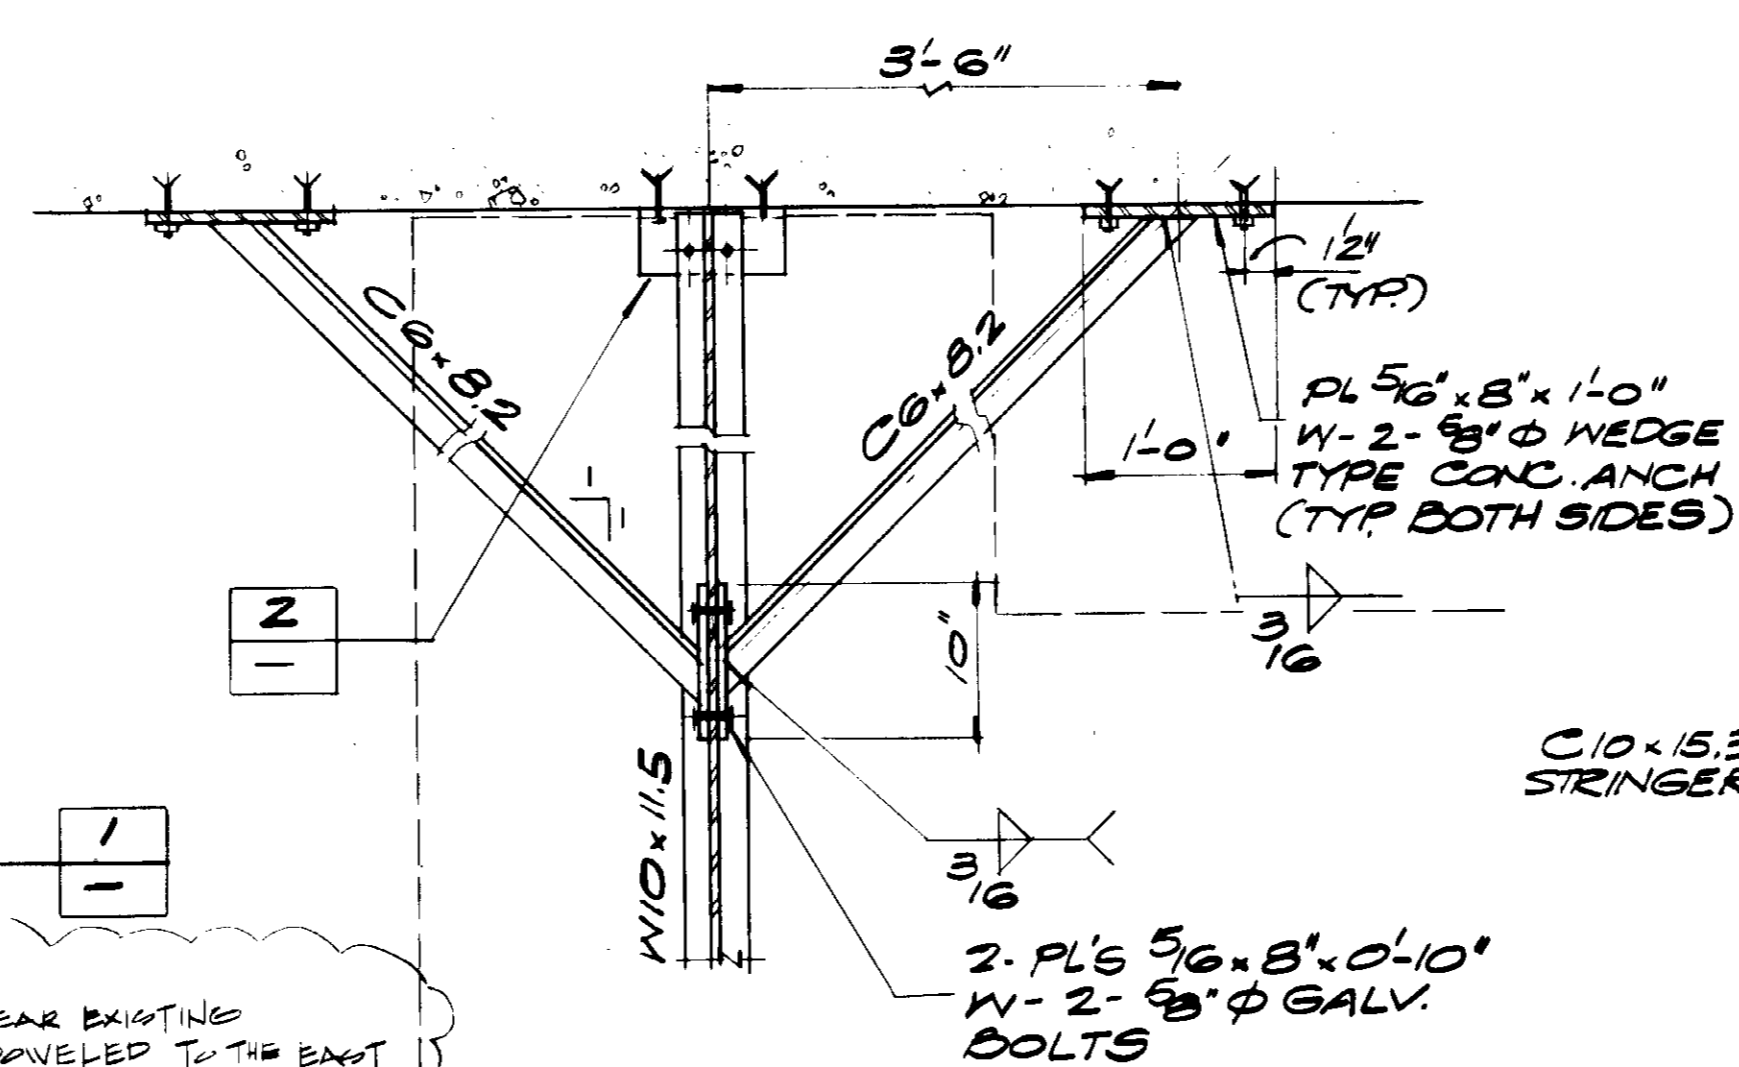

DETAIL D
1" = 1'-0"

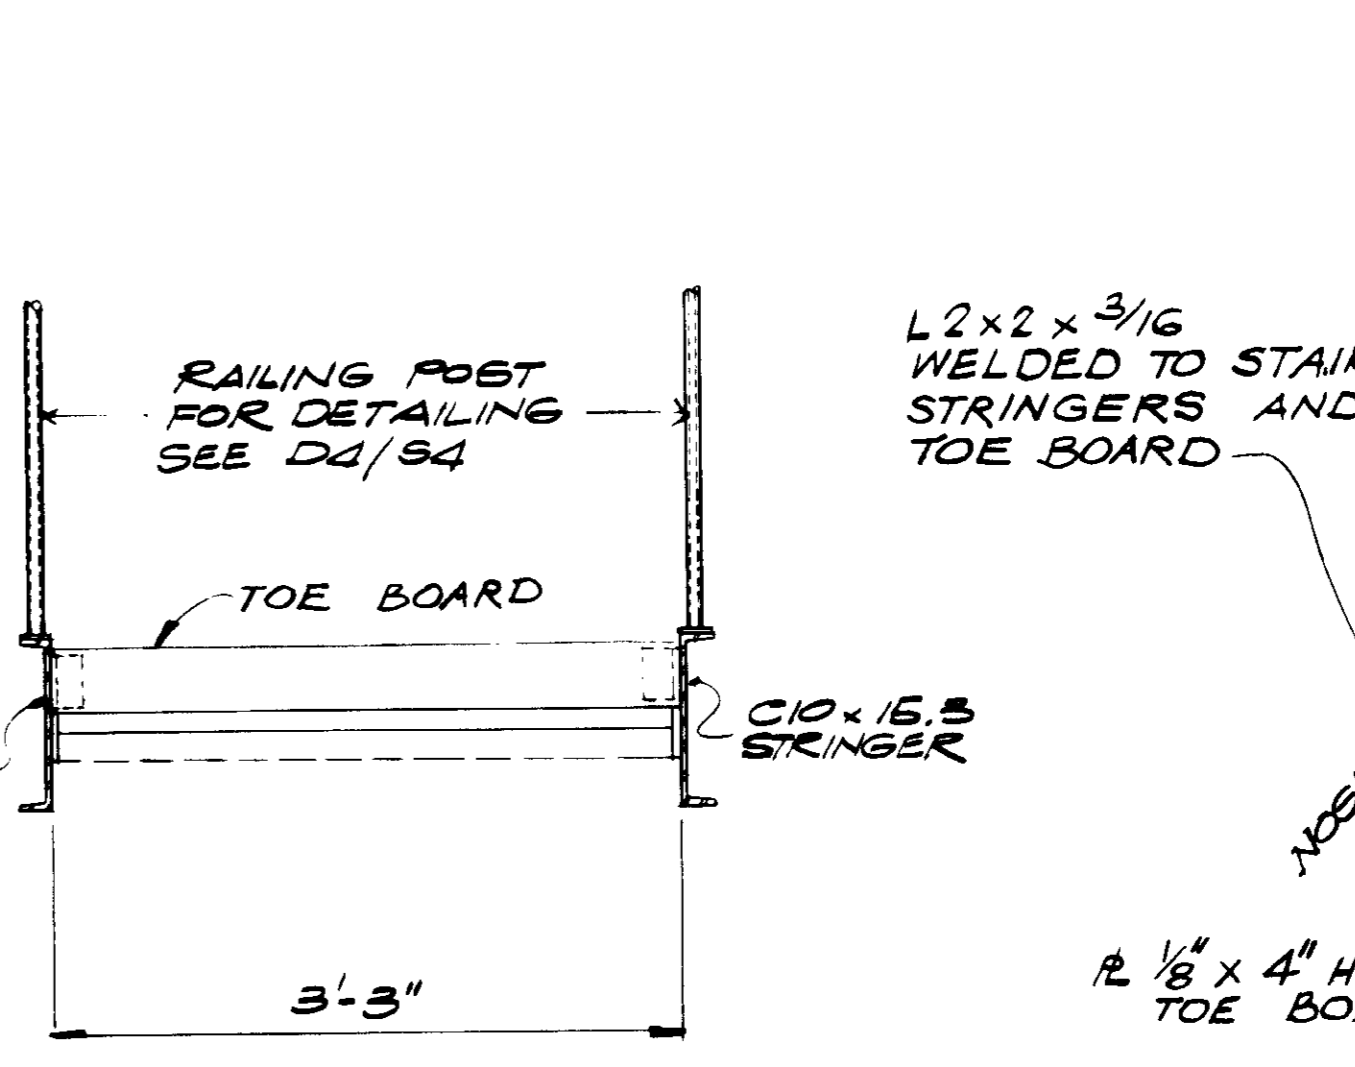

SECTION 3
1" = 1'-0"

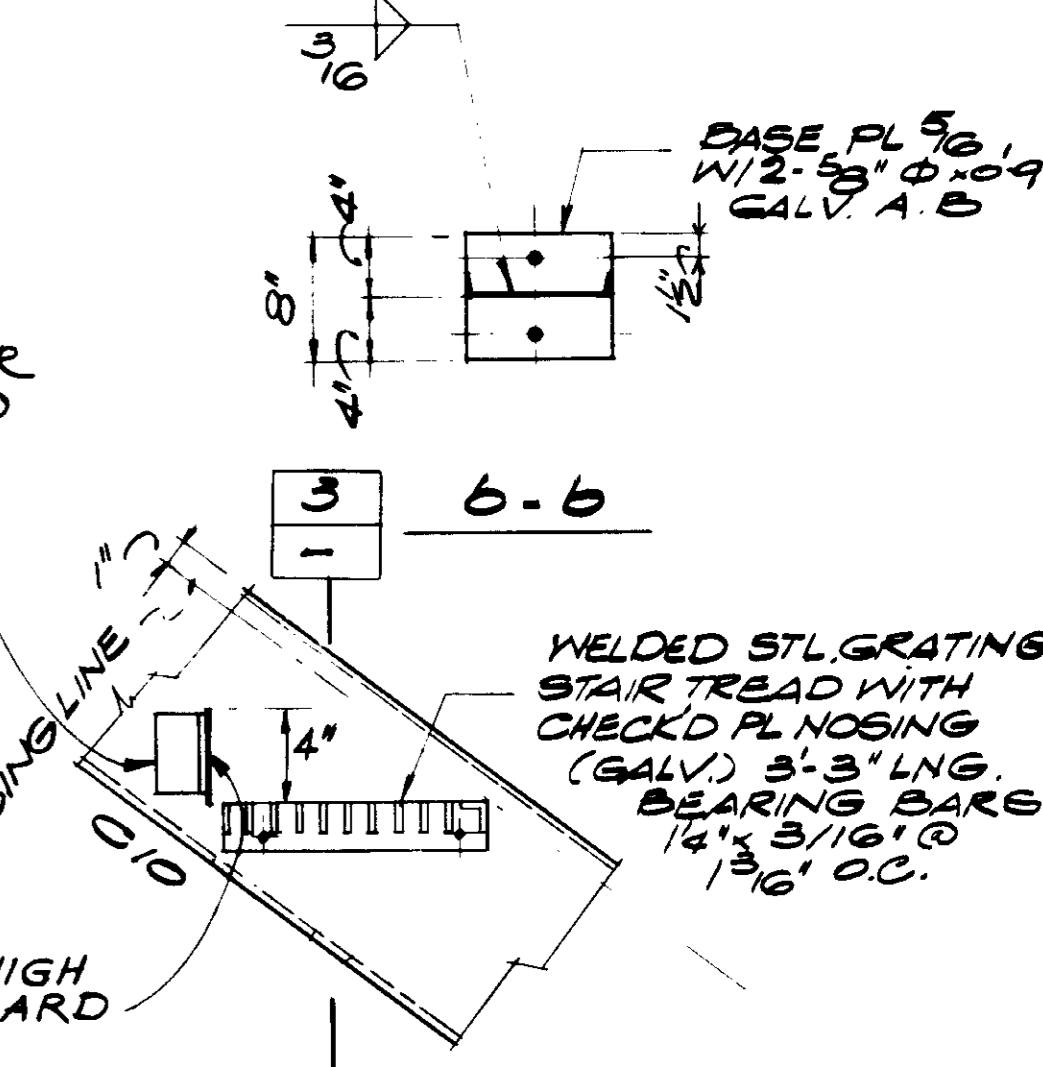

DETAIL E
1/2" = 1'-0"

REV	DATE	BY	DESCRIPTION
1			
2			


SCALE: AS NOTED	DESIGNED: PREYMOND	SUBMITTED: [Signature]	27304	8/19/81
	DRAWN: JAMOLINA	PROJECT ENGINEER: [Signature]	R.C.E. NO.	DATE
	CHECKED: [Signature]	RECOMMENDED: [Signature]	27633	8/23/81
		JAMES M. MONTGOMERY CONSULTING ENGINEERS, INC.	R.C.E. NO.	DATE

JAMES M. MONTGOMERY CONSULTING ENGINEERS, INC.
555 EAST WALNUT STREET, PASADENA, CALIFORNIA 91101

DISTRICT APPROVAL ON TITLE PAGE

LAS VIRGENES MWD/TRIUNFO CSD	SHEET
TAPIA WRF - FILTRATION/DISINFECTION ADDITION	8S-1
ACCESS STAIRS TO EXISTING CHLORINE CONTACT TANK.	OF 68 SHEETS


JOB NO. ETD-0060 FILE CC 7178

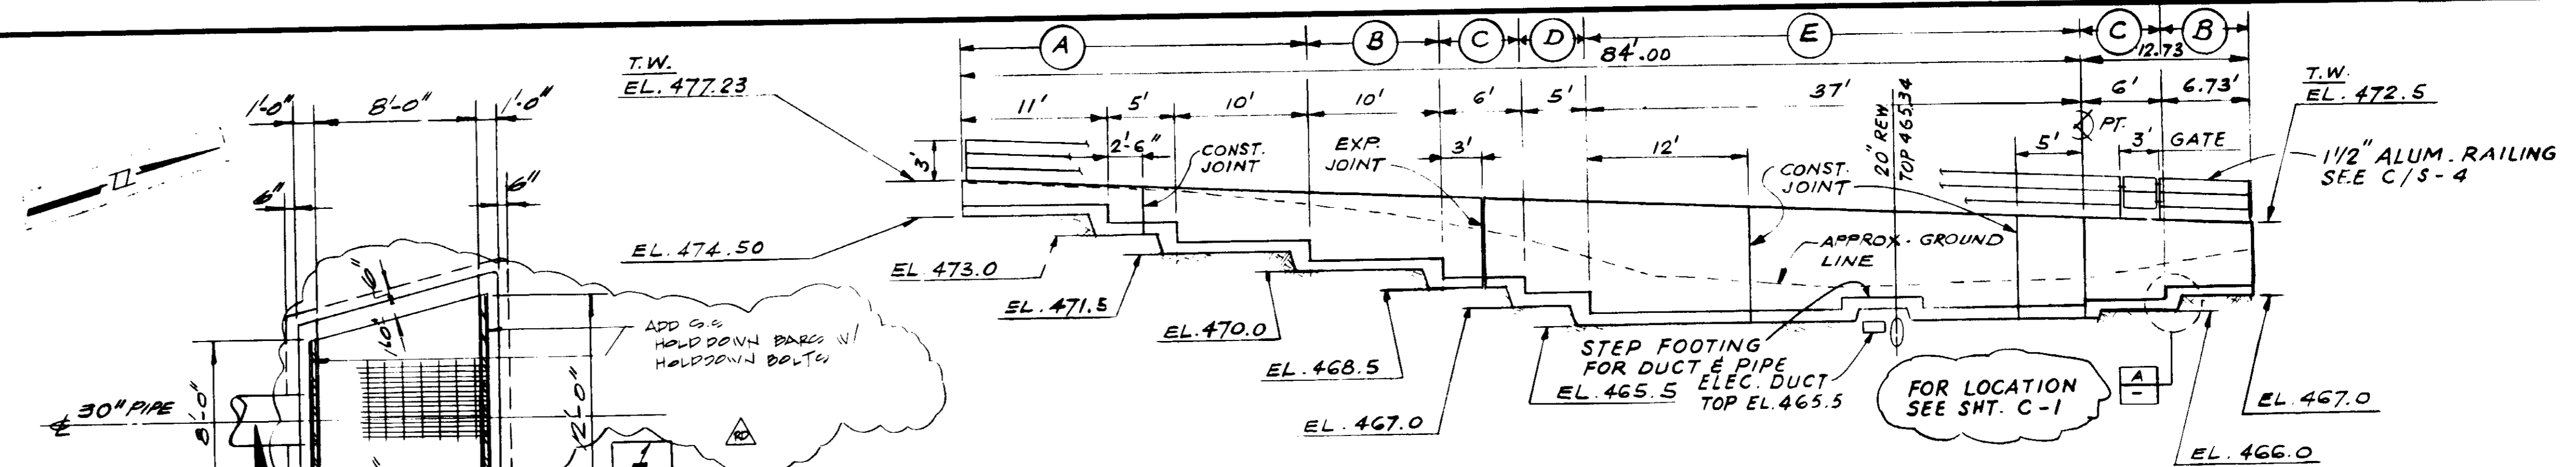


RETAINING WALL ELEVATION
1/8" = 1'-0"

WALL	WALL DIMENSIONS					WALL REINFORCING						
	b	c	d	e	f	h	A BARS	B BARS	C BARS	D BARS		
(A)	10"	4'-0"	10"	8"	2'-6"	OMIT	OMIT	#4@12"	20"	OMIT	OMIT	#4@12"
(B)	10"	4'-6"	10"	8"	3'-0"	OMIT	OMIT	#4@12"	20"	OMIT	OMIT	#4@12"
(C)	10"	5'-6"	11'-2"	8"	3'-8"	OMIT	OMIT	#5@12"	26"	OMIT	OMIT	#4@12"
(D)	12"	6'-6"	1'-4"	10"	4'-4"	OMIT	OMIT	#5@18"	20"	#5@18"	3'-0"	#5@12"
(E)	12"	7'-2"	1'-8"	12"	4'-6"	12"	12"	#5@16"	20"	#5@16"	3'-6"	#5@10"


PLAN OUTFALL STRUCTURE
3/16" = 1'-0"

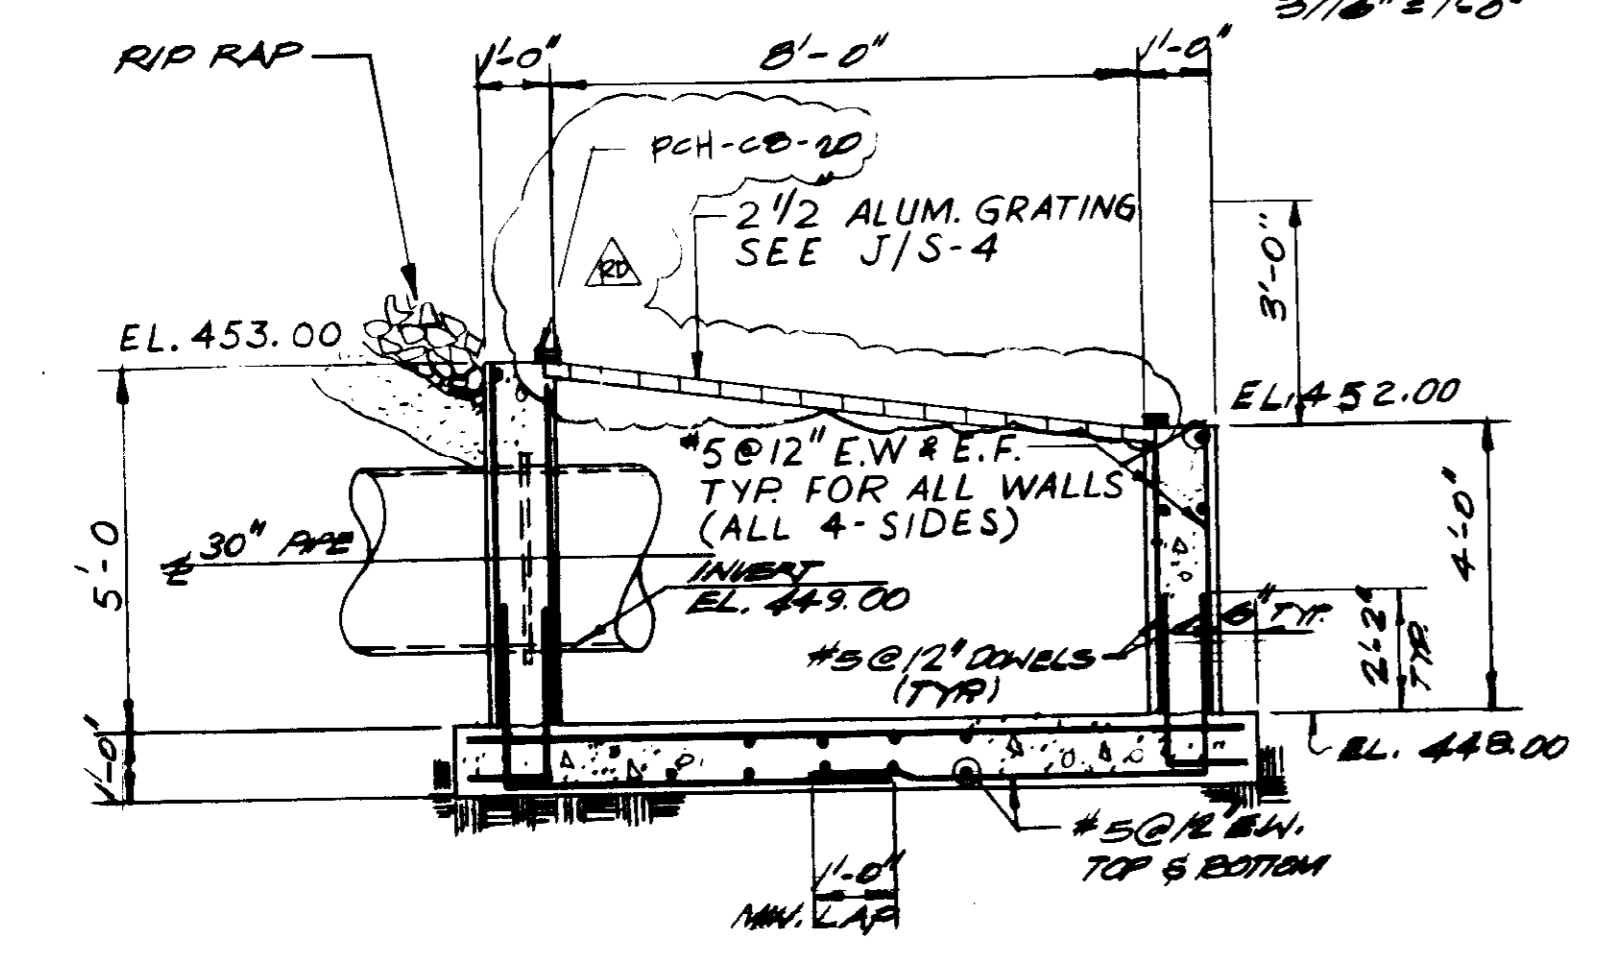


SECT 1
3/8" = 1'-0"

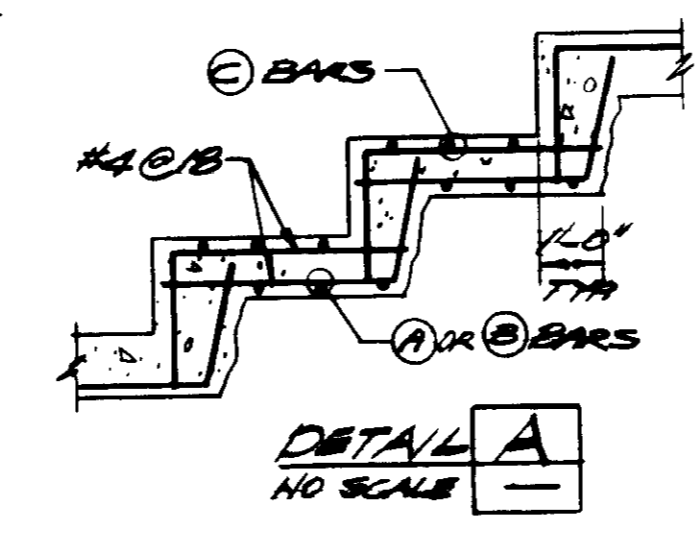


DETAIL A
NO SCALE

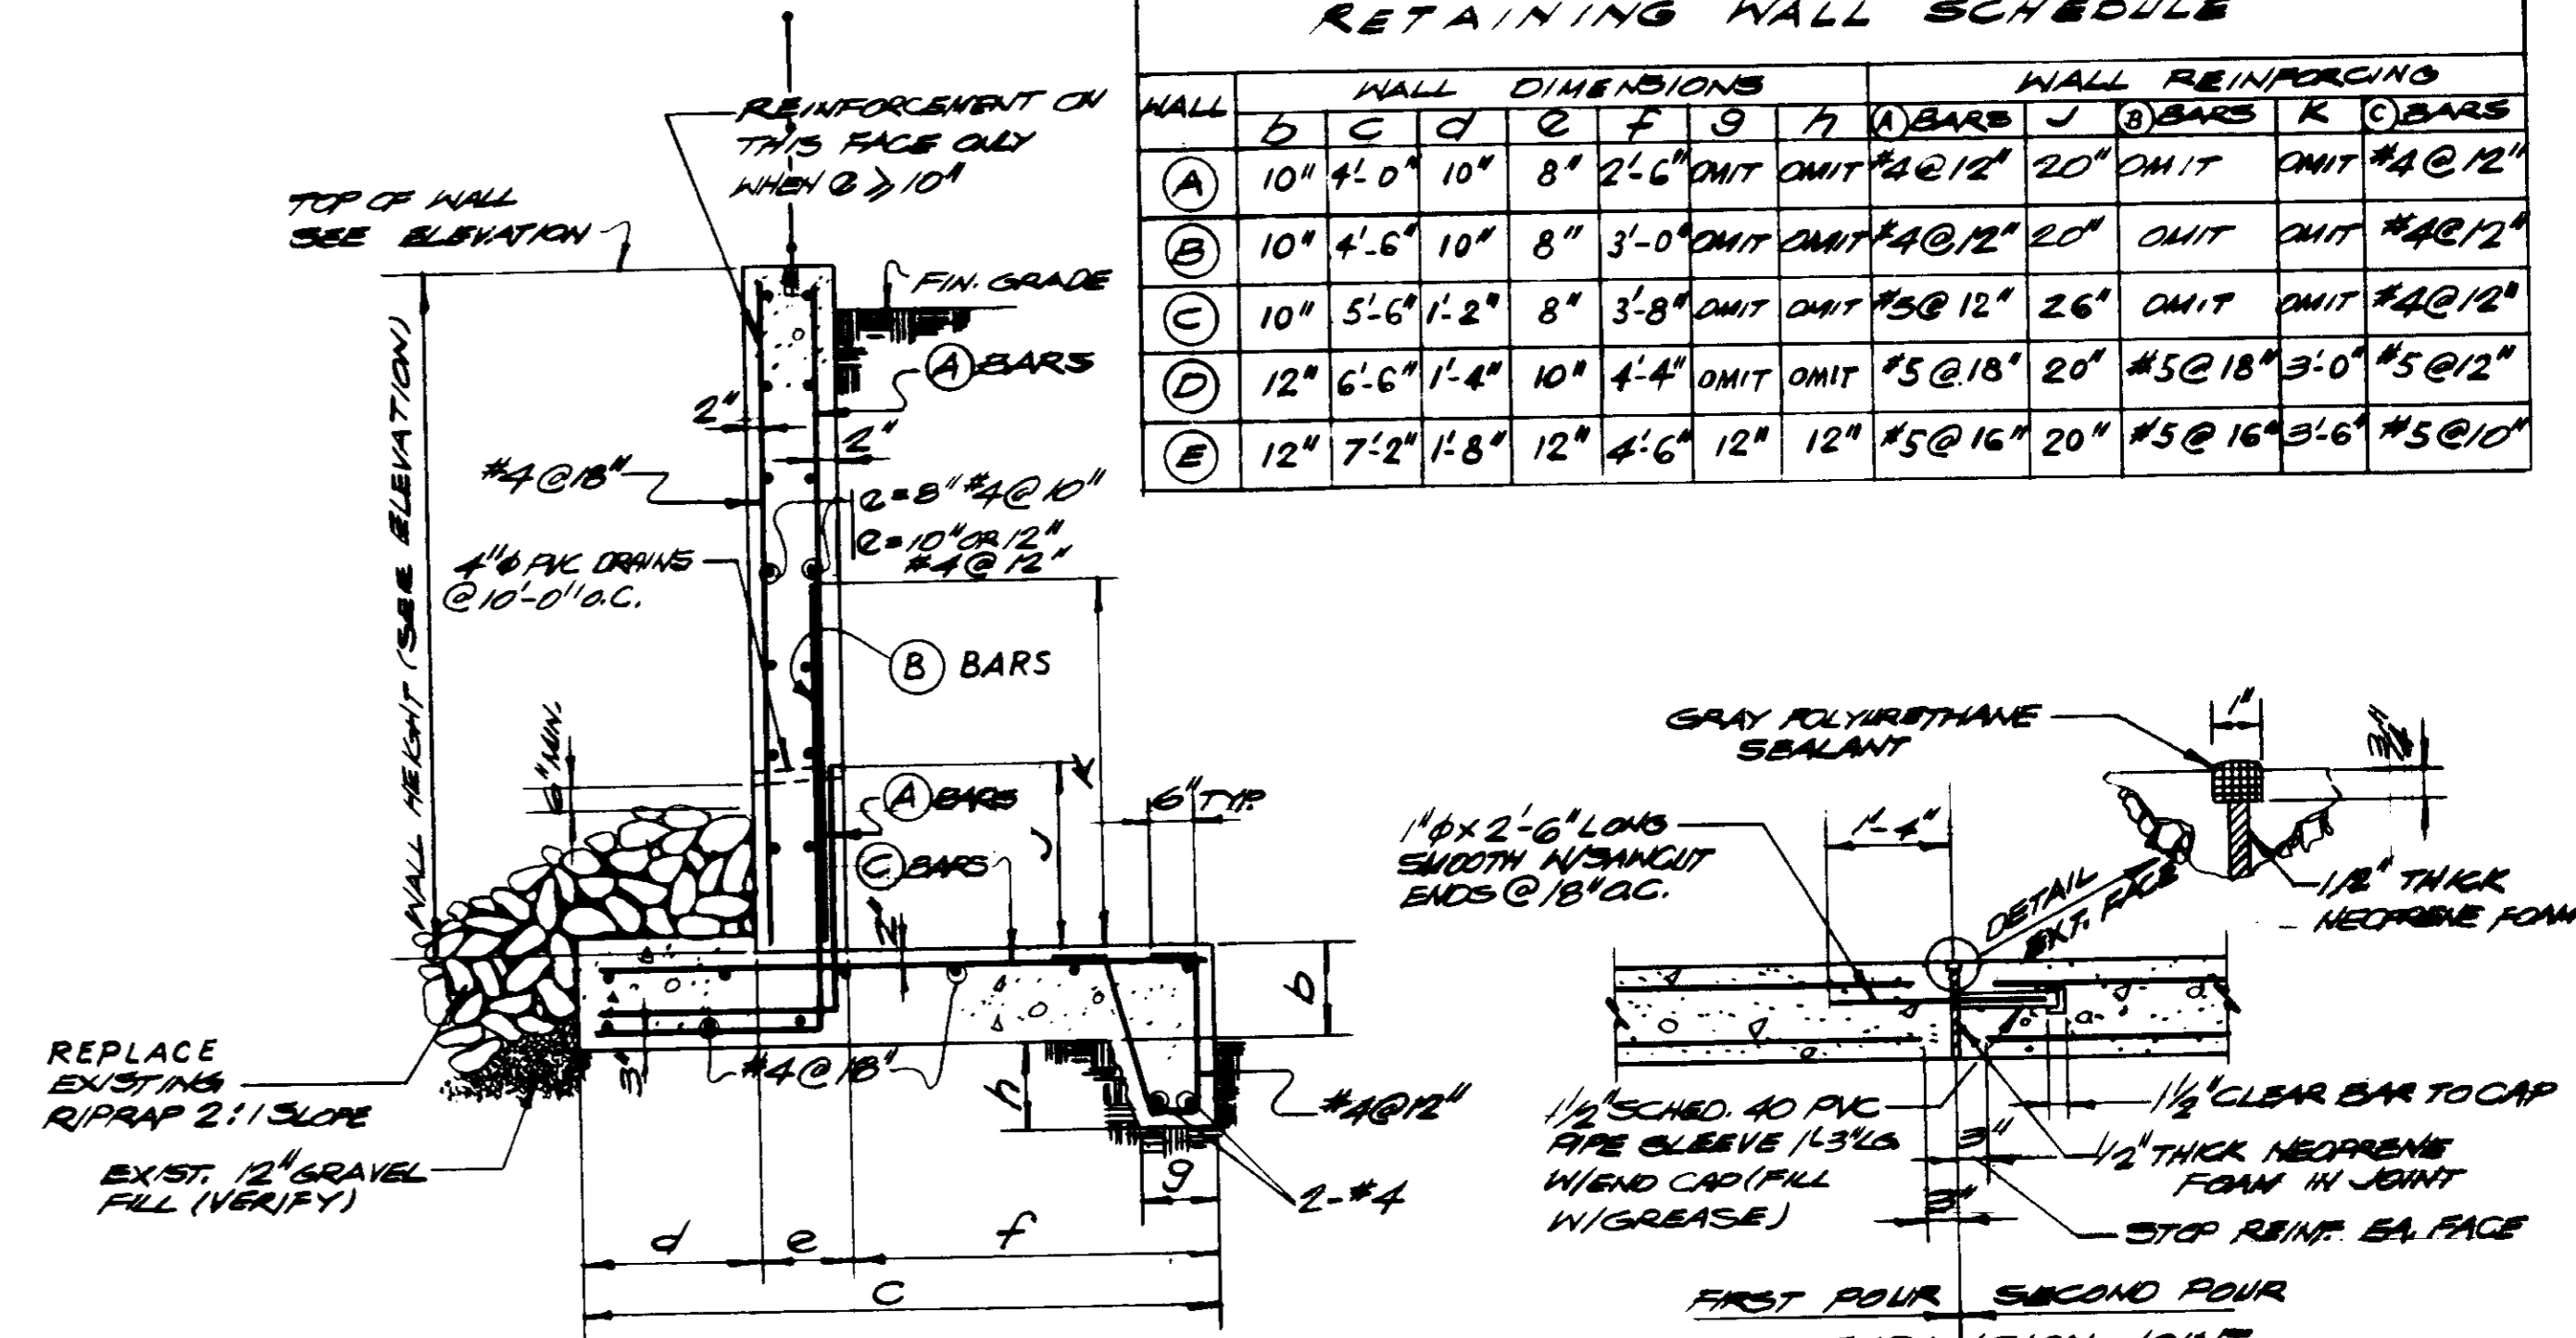

TYPICAL RETAINING WALL SECTION
NO SCALE

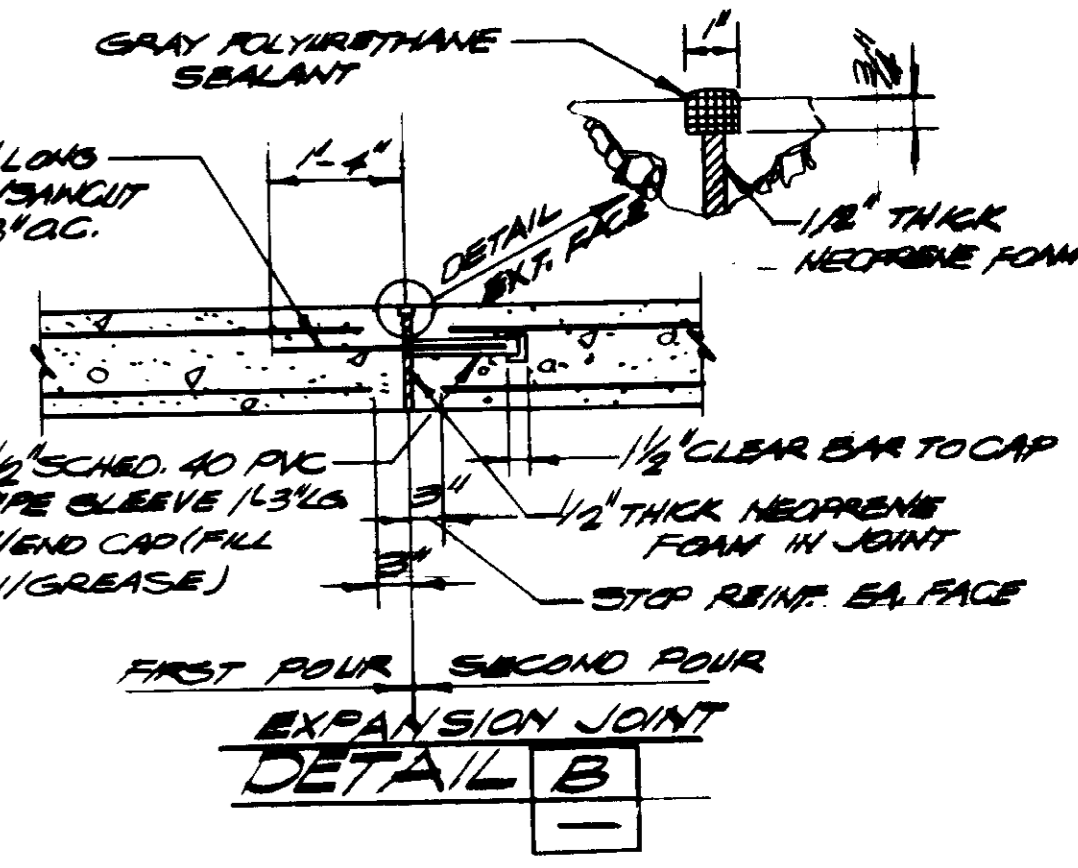

EXPANSION JOINT DETAIL B
NO SCALE

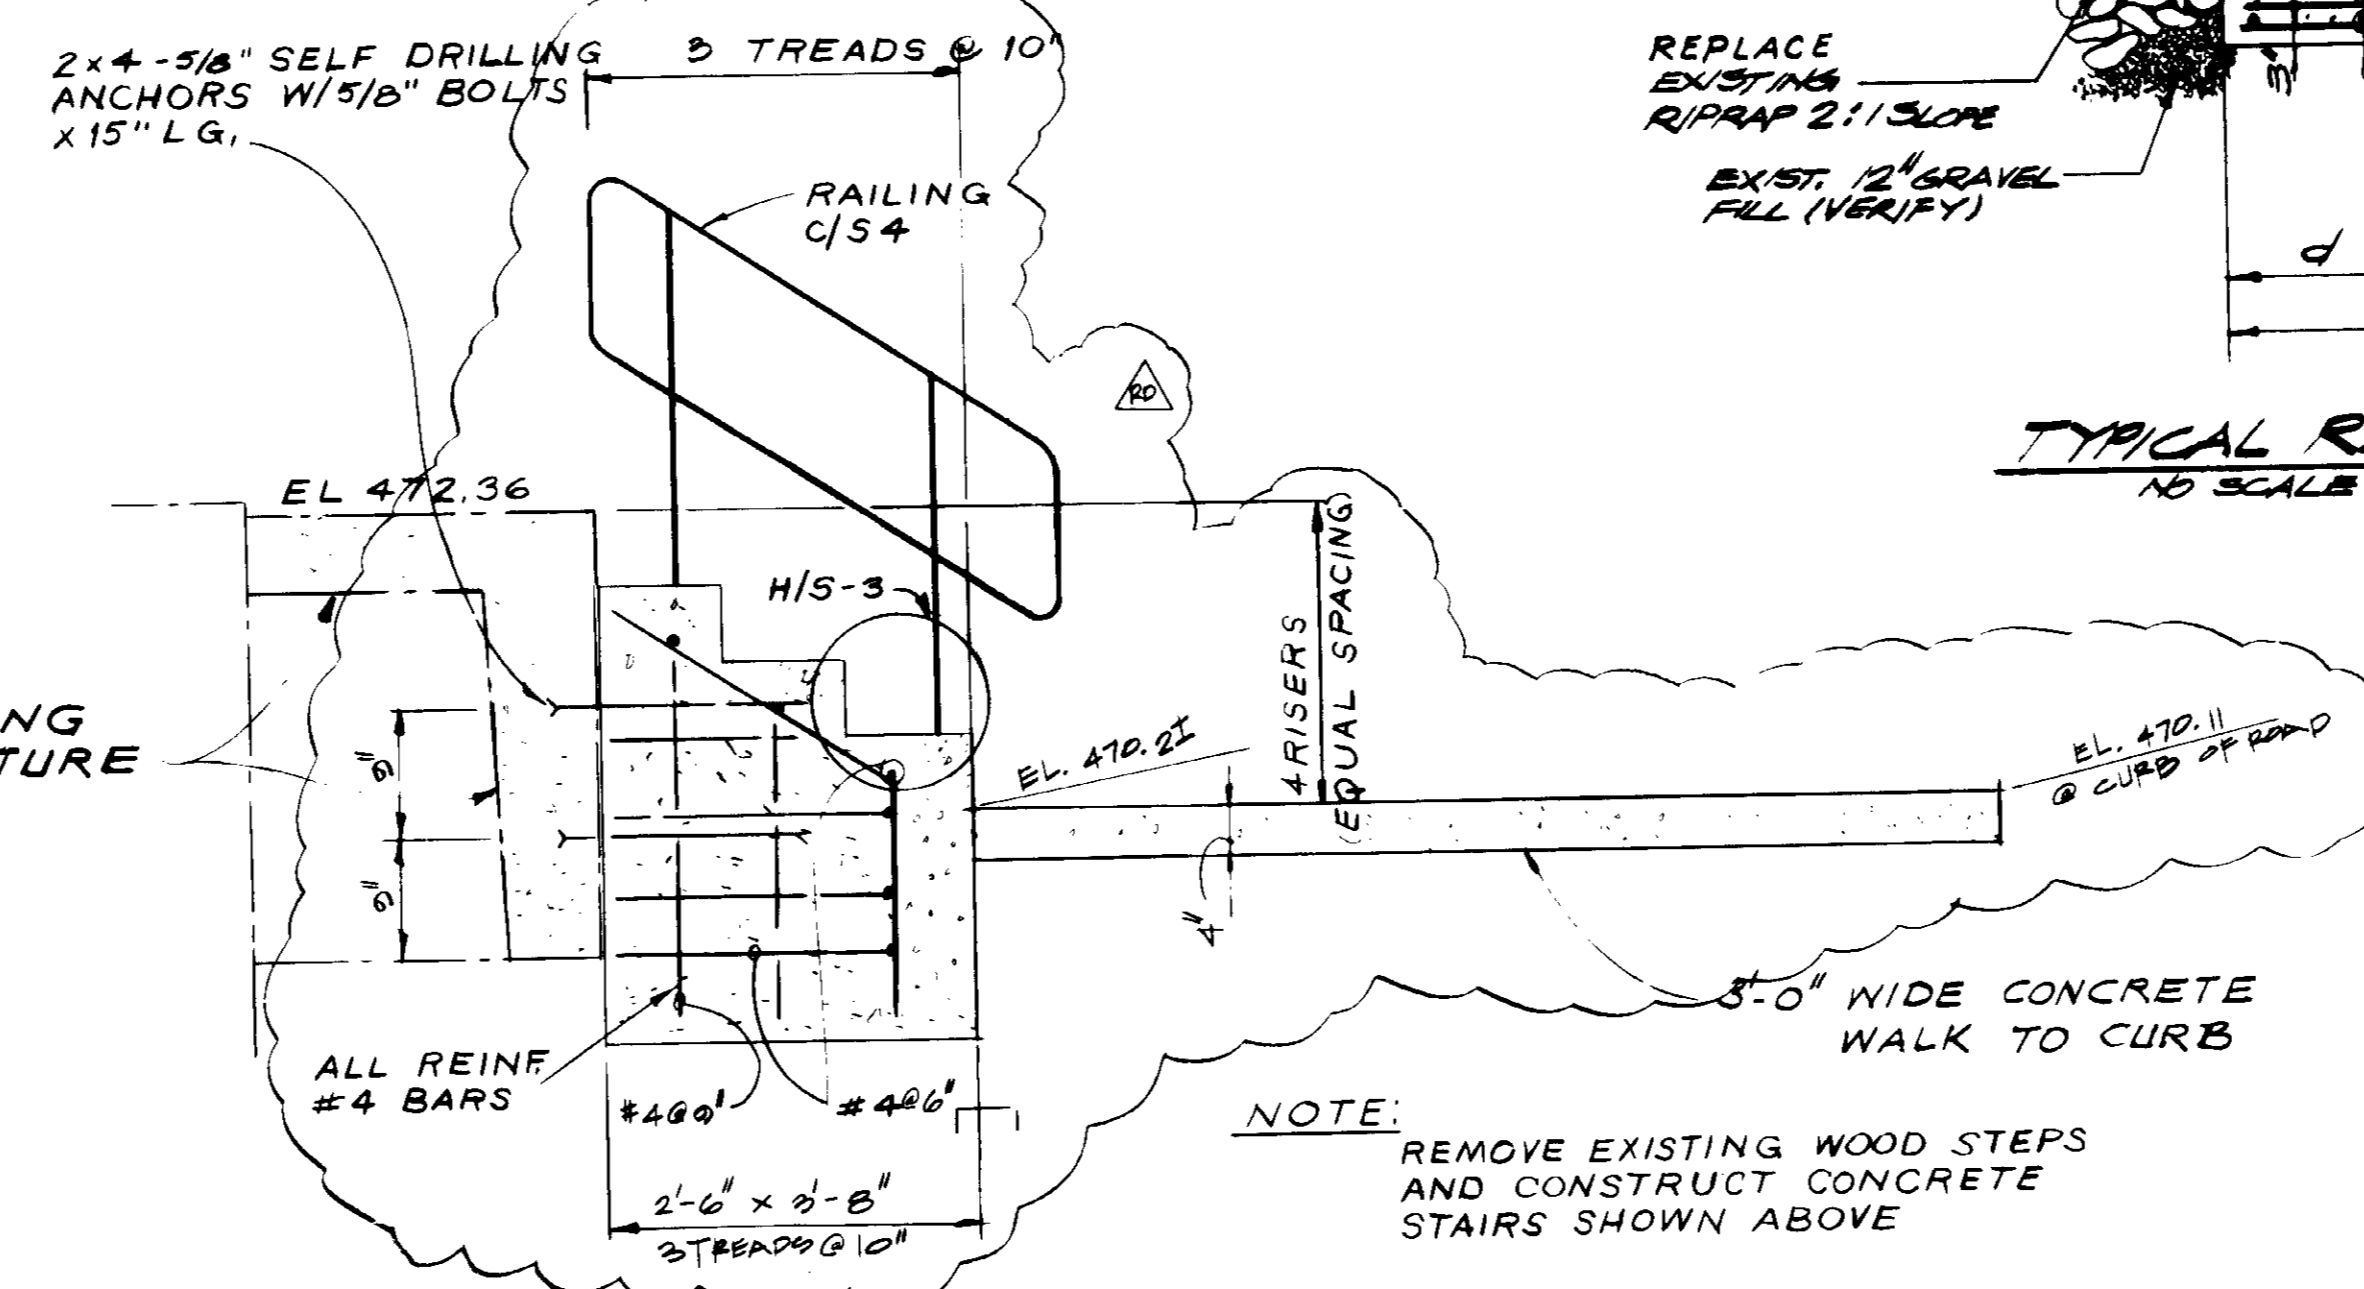

CONCRETE STAIRS TO EFFLUENT PUMP STATION
SCALE: 3/4" = 1'-0"


NOTE: REMOVE EXISTING WOOD STEPS AND CONSTRUCT CONCRETE STAIRS SHOWN ABOVE

03594
RECORD DRAWING

SHEET
10S-1
OF 66 SHEETS

RD: HAV/MDU RECORD DRAWINGS	SCALE: AS NOTED	DESIGNED: E. HATSON DRAWN: [Signature] CHECKED: [Signature]	SUBMITTED: [Signature] PROJECT ENGINEER RECOMMENDED: [Signature] JAMES M. MONTGOMERY CONSULTING ENGINEERS, INC.	27304 R.C.E. NO. 8/19/81 DATE	JAMES M. MONTGOMERY CONSULTING ENGINEERS, INC. 336 EAST WALNUT STREET, PARADISE, CALIFORNIA 95969	DISTRICT APPROVAL ON TITLE PAGE	LAS VIRGENES MWD/TRIUNFO CSD TAPIA WRF - FILTRATION/DISINFECTION ADDITION	PHASE 1 OUTFALL STRUCTURE AND RETAINING WALL DETAILS
REV DATE BY DESCRIPTION	27638 R.C.E. NO. 8/20/81 DATE	PHASE 1 OUTFALL STRUCTURE AND RETAINING WALL DETAILS						

JOB NO. 870.0060 FILE 03 278

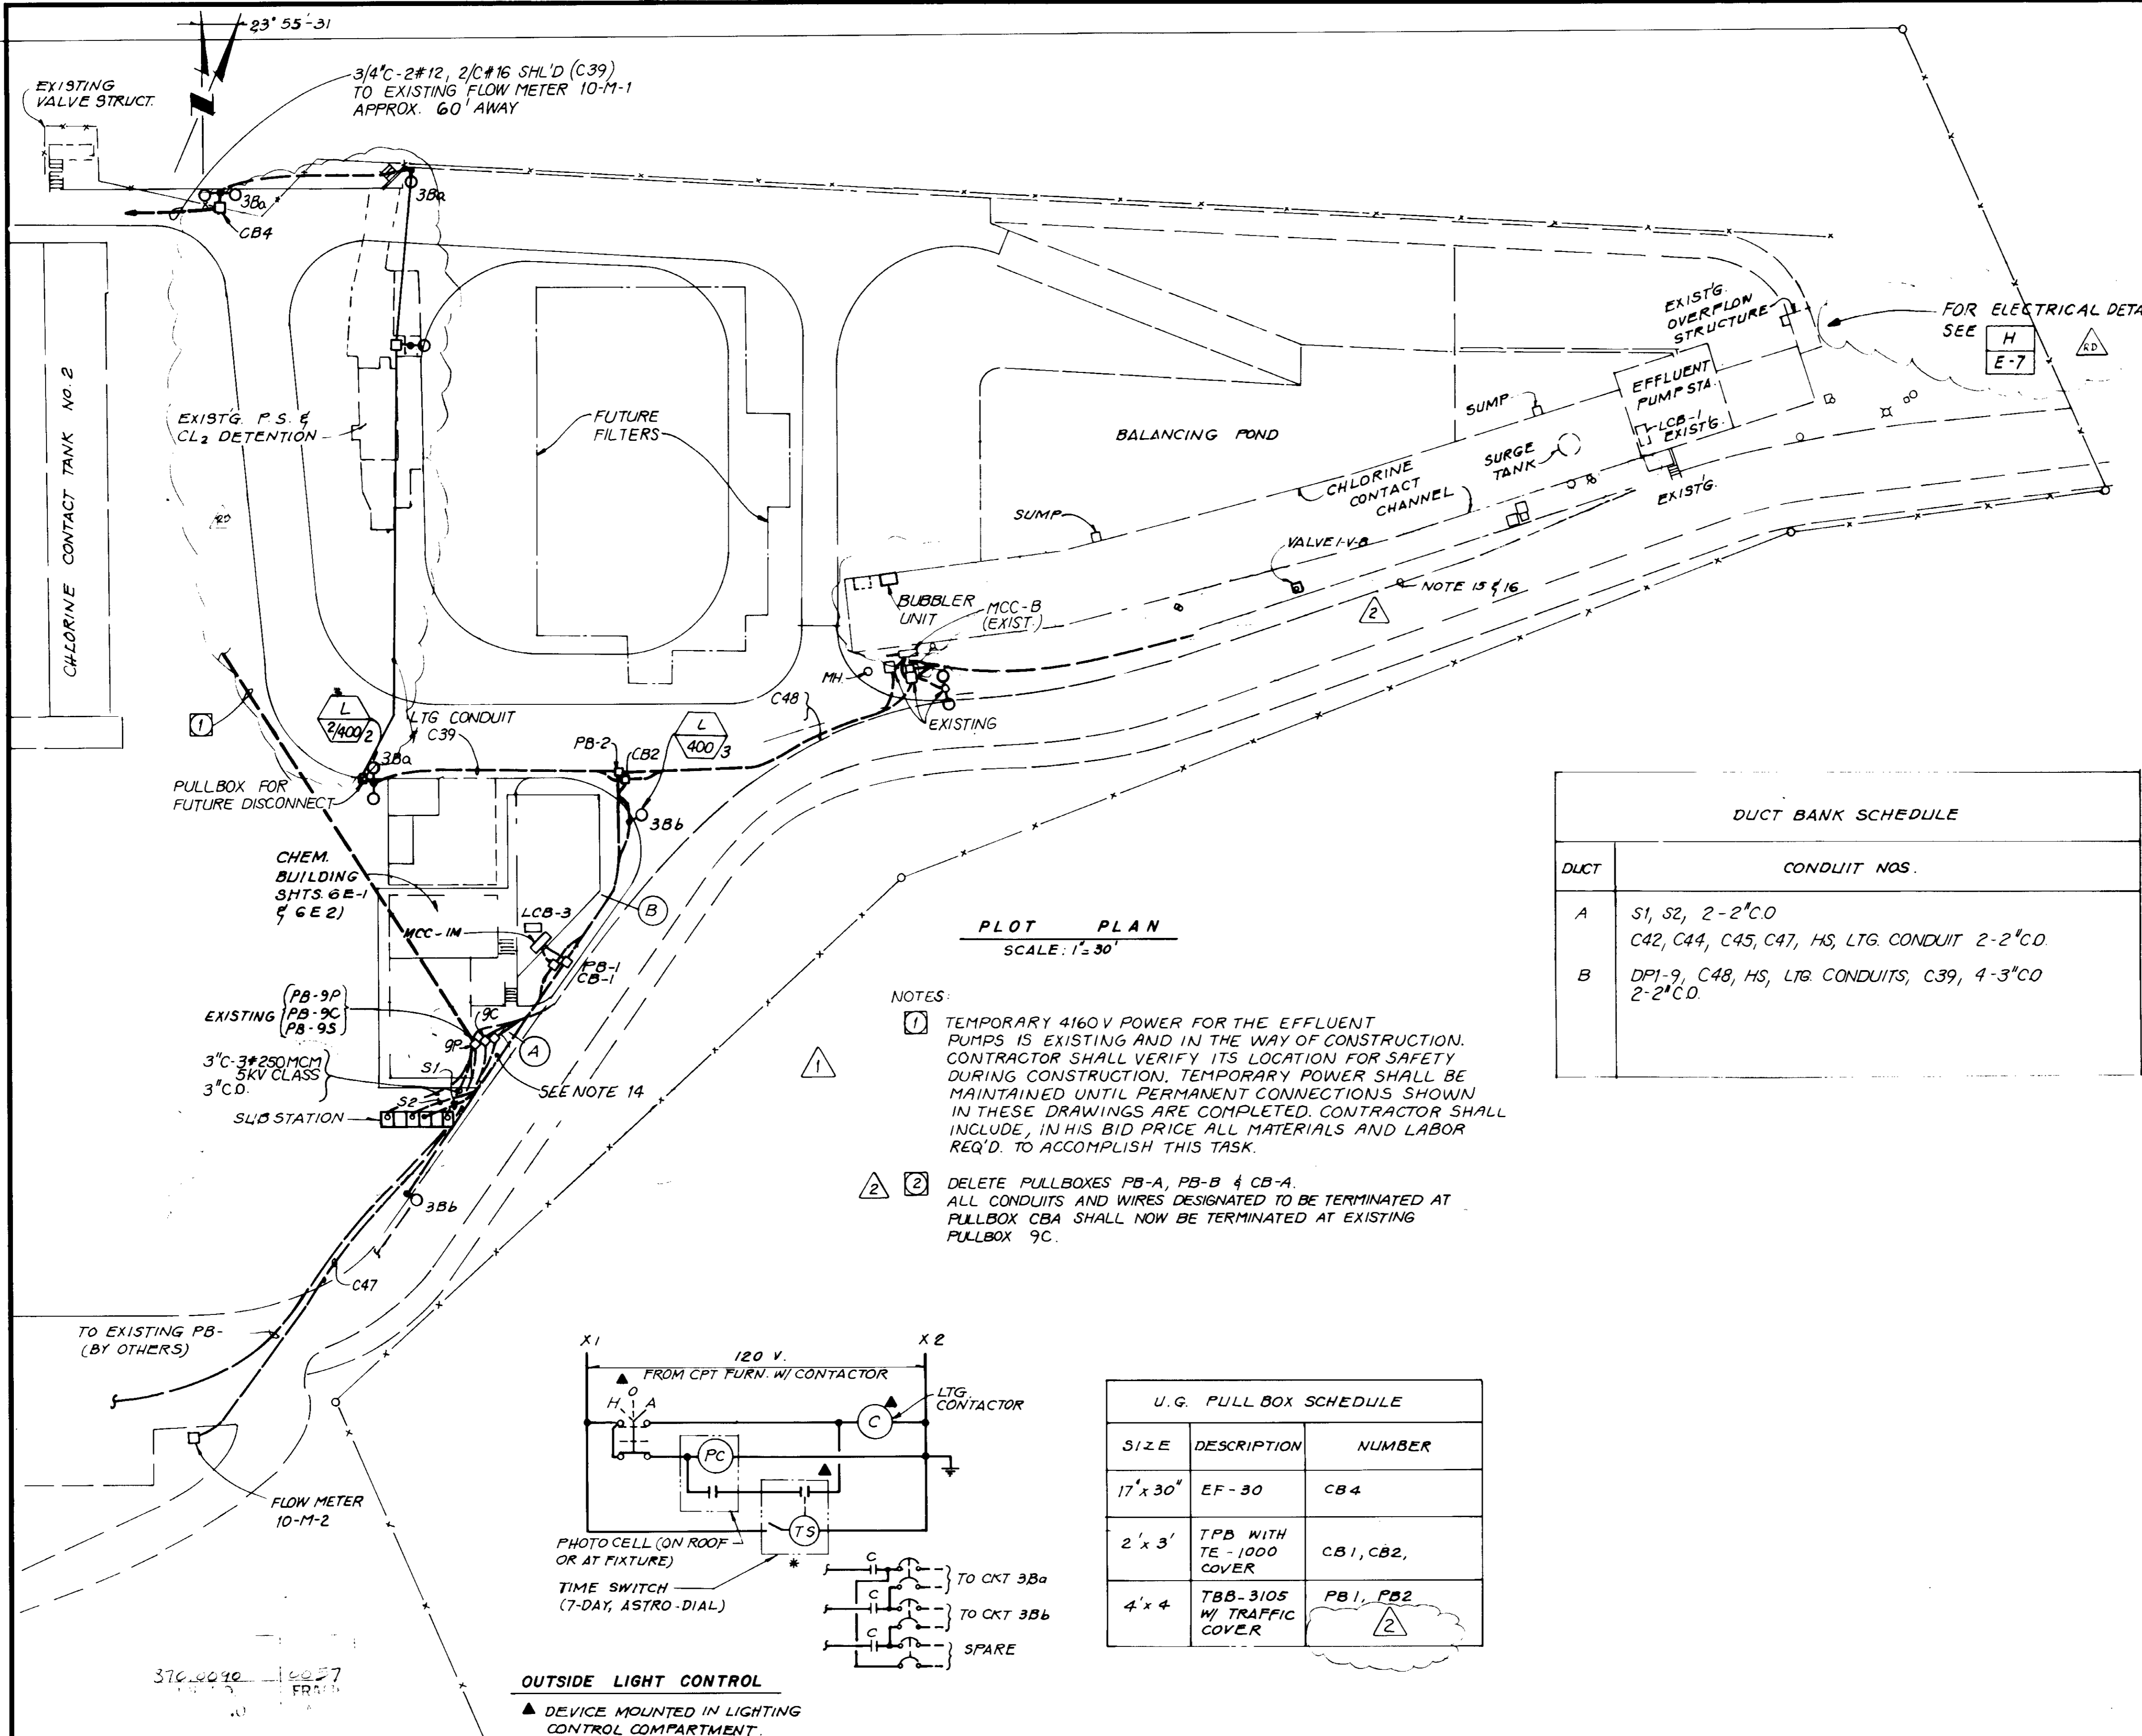

- GENERAL NOTES
1. THE CONTRACTOR SHALL VERIFY EXACT LOCATIONS OF TERMINAL BOXES AND CONDUIT ENTRANCES OF ALL EQUIPMENT AGAINST SHOP DRAWINGS BEFORE STUBBING UP CONDUITS.
 2. CONDUIT RUNS FOR FUTURE EQUIPMENT OR EXTENSION SHALL BE TERMINATED AS SHOWN IN DETAIL 'G' ON SHEET E-7 UNLESS OTHERWISE NOTED ON PLANS.
 3. CONNECTION BETWEEN RIGID CONDUIT AND MOTOR TERMINAL BOX SHALL BE LIQUID-TIGHT.
 4. EXPOSED FLEXIBLE CONNECTION SHALL BE FLEXIBLE LIQUID-TIGHT CONDUIT WITH APPROVED GROUNDING TYPE FITTINGS AND SHALL NOT EXCEED 30" IN LENGTH FOR 2" SIZE AND LARGER. MAX. OF 18" FOR SIZES 1 1/2" AND SMALLER.
 5. CONDUIT STUB-UPS SHALL NOT BE MORE THAN 6" FROM CENTER LINES OF TERMINAL BOXES.
 6. CONDUITS TERMINATING AT MOTOR CONTROL CENTERS, CONTROL CABINETS, ETC., SHALL BE EQUIPPED WITH A GROUNDING BUSHING 'OZ' TYPE GB AND GROUNDED AS A BANK WITH NO. 6 GROUND WIRE.
 7. MOTOR CONTROL CENTERS AND ALL FREE STANDING PANELS SHALL BE SET ON CONCRETE PAD AND LEVELING CHANNELS EMBEDDED IN PAD AS SHOWN UNLESS OTHERWISE INDICATED.
 8. IN CASE OF ANY INTERFERENCE BETWEEN ELECTRICAL EQUIPMENT SHOWN ON THE DRAWINGS AND OTHER EQUIPMENT, THE CONTRACTOR SHALL NOTIFY THE ENGINEER IN WRITING AND THE ENGINEER SHALL REVIEW THE PROPOSED CHANGES BEFORE THEY ARE MADE.
 9. ALL OUTDOOR DEVICES SHALL BE WEATHERPROOF.
 10. ALL RECEPTACLES SHALL BE MOUNTED 12" ABOVE FLOOR SURFACE UNLESS OTHERWISE INDICATED.
 11. WIRES OR CABLES SHOWN FOR FUTURE EQUIPMENT SHALL BE INSTALLED WHEREVER SUCH WIRES OR CABLES ARE SHOWN TOGETHER WITH OTHER WIRES OR CABLES AS MARKED ON PLANS.
 12. ONLY MAJOR PULLBOXES FOR UNDERGROUND RUNS ARE SHOWN. CONTRACTOR SHALL PROVIDE ADDITIONAL PULLBOXES WHERE THEY ARE REQUIRED TO MAKE A WORKABLE INSTALLATION.
 13. 2
 14. PROVIDE AND INSTALL ADDITIONAL 5KV CABLE FROM EXISTING PULLBOX 9P TO EXISTING EFFLUENT PUMP STATION. UTILIZE EXISTING 4" CONDUIT. SEE SINGLE LINE DIAGRAM ON SHEET E-3.
 15. PROVIDE AND INSTALL 4-4 #12 WIRES FROM LCB-1 AT EFFLUENT PUMP STATION TO EXISTING PULLBOX PB-9S. USING ONE EXISTING U.G. 2" CONDUIT.
 16. PROVIDE AND INSTALL 15-3/4 #16 SHIELD CONDUCTORS FROM LCB-1 TO PB-9S USING ANOTHER EXISTING U.G. 2" CONDUIT.
 17. ALL OUTDOOR RECEPTACLES SHALL BE PROVIDED WITH GROUND FAULT INTERRUPTER.
 18. GROUND SURFACE SHALL DRAIN AWAY FROM PULLBOX.


DUCT BANK SCHEDULE

DUCT	CONDUIT NOS.
A	S1, S2, 2-2"CO C42, C44, C45, C47, HS, LTG. CONDUIT 2-2"CO.
B	DP1-9, C48, HS, LTG. CONDUITS, C39, 4-3"CO 2-2"CO.

PLOT PLAN
SCALE: 1/2" = 30'

NOTES:

- 1 TEMPORARY 4160V POWER FOR THE EFFLUENT PUMPS IS EXISTING AND IN THE WAY OF CONSTRUCTION. CONTRACTOR SHALL VERIFY ITS LOCATION FOR SAFETY DURING CONSTRUCTION. TEMPORARY POWER SHALL BE MAINTAINED UNTIL PERMANENT CONNECTIONS SHOWN IN THESE DRAWINGS ARE COMPLETED. CONTRACTOR SHALL INCLUDE, IN HIS BID PRICE ALL MATERIALS AND LABOR REQ'D TO ACCOMPLISH THIS TASK.
- 2 DELETE PULLBOXES PB-A, PB-B & CB-A. ALL CONDUITS AND WIRES DESIGNATED TO BE TERMINATED AT PULLBOX CBA SHALL NOW BE TERMINATED AT EXISTING PULLBOX 9C.

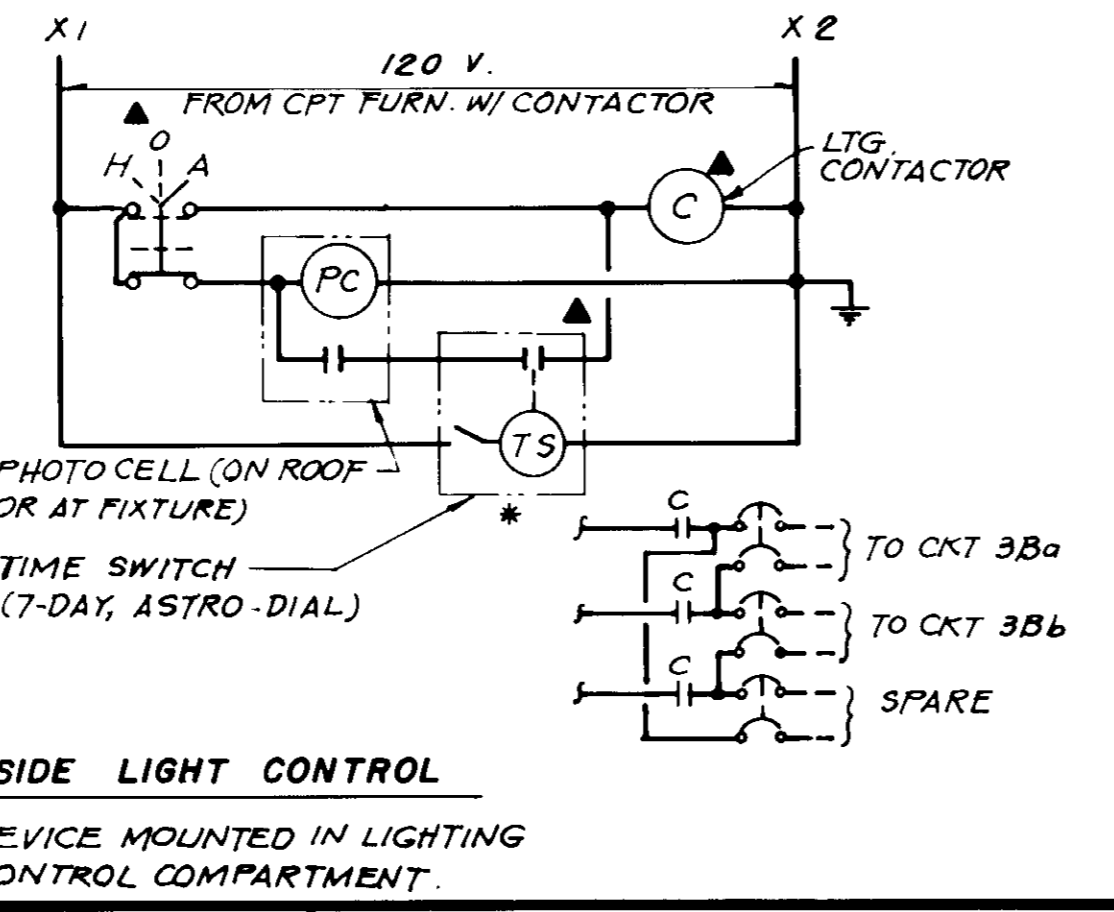

U.G. PULL BOX SCHEDULE

SIZE	DESCRIPTION	NUMBER
17' x 30"	EF-30	CB4
2' x 3'	TPB WITH TE-1000 COVER	CB1, CB2
4' x 4'	TBB-3105 W/ TRAFFIC COVER	PB1, PB2

REV	DATE	BY	DESCRIPTION
RD	4-11-84	MDU	RECORD DRAWINGS
	3-1-88	M.S.	CHANGE ORDER
	7-28-88	M.S.	ADDENDUM 2

SCALE: AS NOTED

DESIGNED: M. SANTOS	SUBMITTED: [Signature]	27304	0/19/81
DRAWN: R.S.	PROJECT ENGINEER	R.C.E. NO.	DATE
CHECKED: H. RODRIGUEZ	RECOMMENDED: [Signature]	27638	9/20/81
	JAMES M. MONTGOMERY CONSULTING ENGINEERS, INC.	R.C.E. NO.	DATE

JAMES M. MONTGOMERY CONSULTING ENGINEERS, INC.

555 EAST WALNUT STREET, PASADENA, CALIFORNIA 91101

DISTRICT APPROVAL ON TITLE PAGE

LAS VIRGENES MWD/TRIUNFO CSD
TAPIA WRF - FILTRATION/DISINFECTION ADDITION

PHASE II PLOT PLAN


SHEET E-2 OF 66 SHEETS

JOB NO. 870-0070 FILE 00 238

03596

RECORD DRAWING

REF 6373

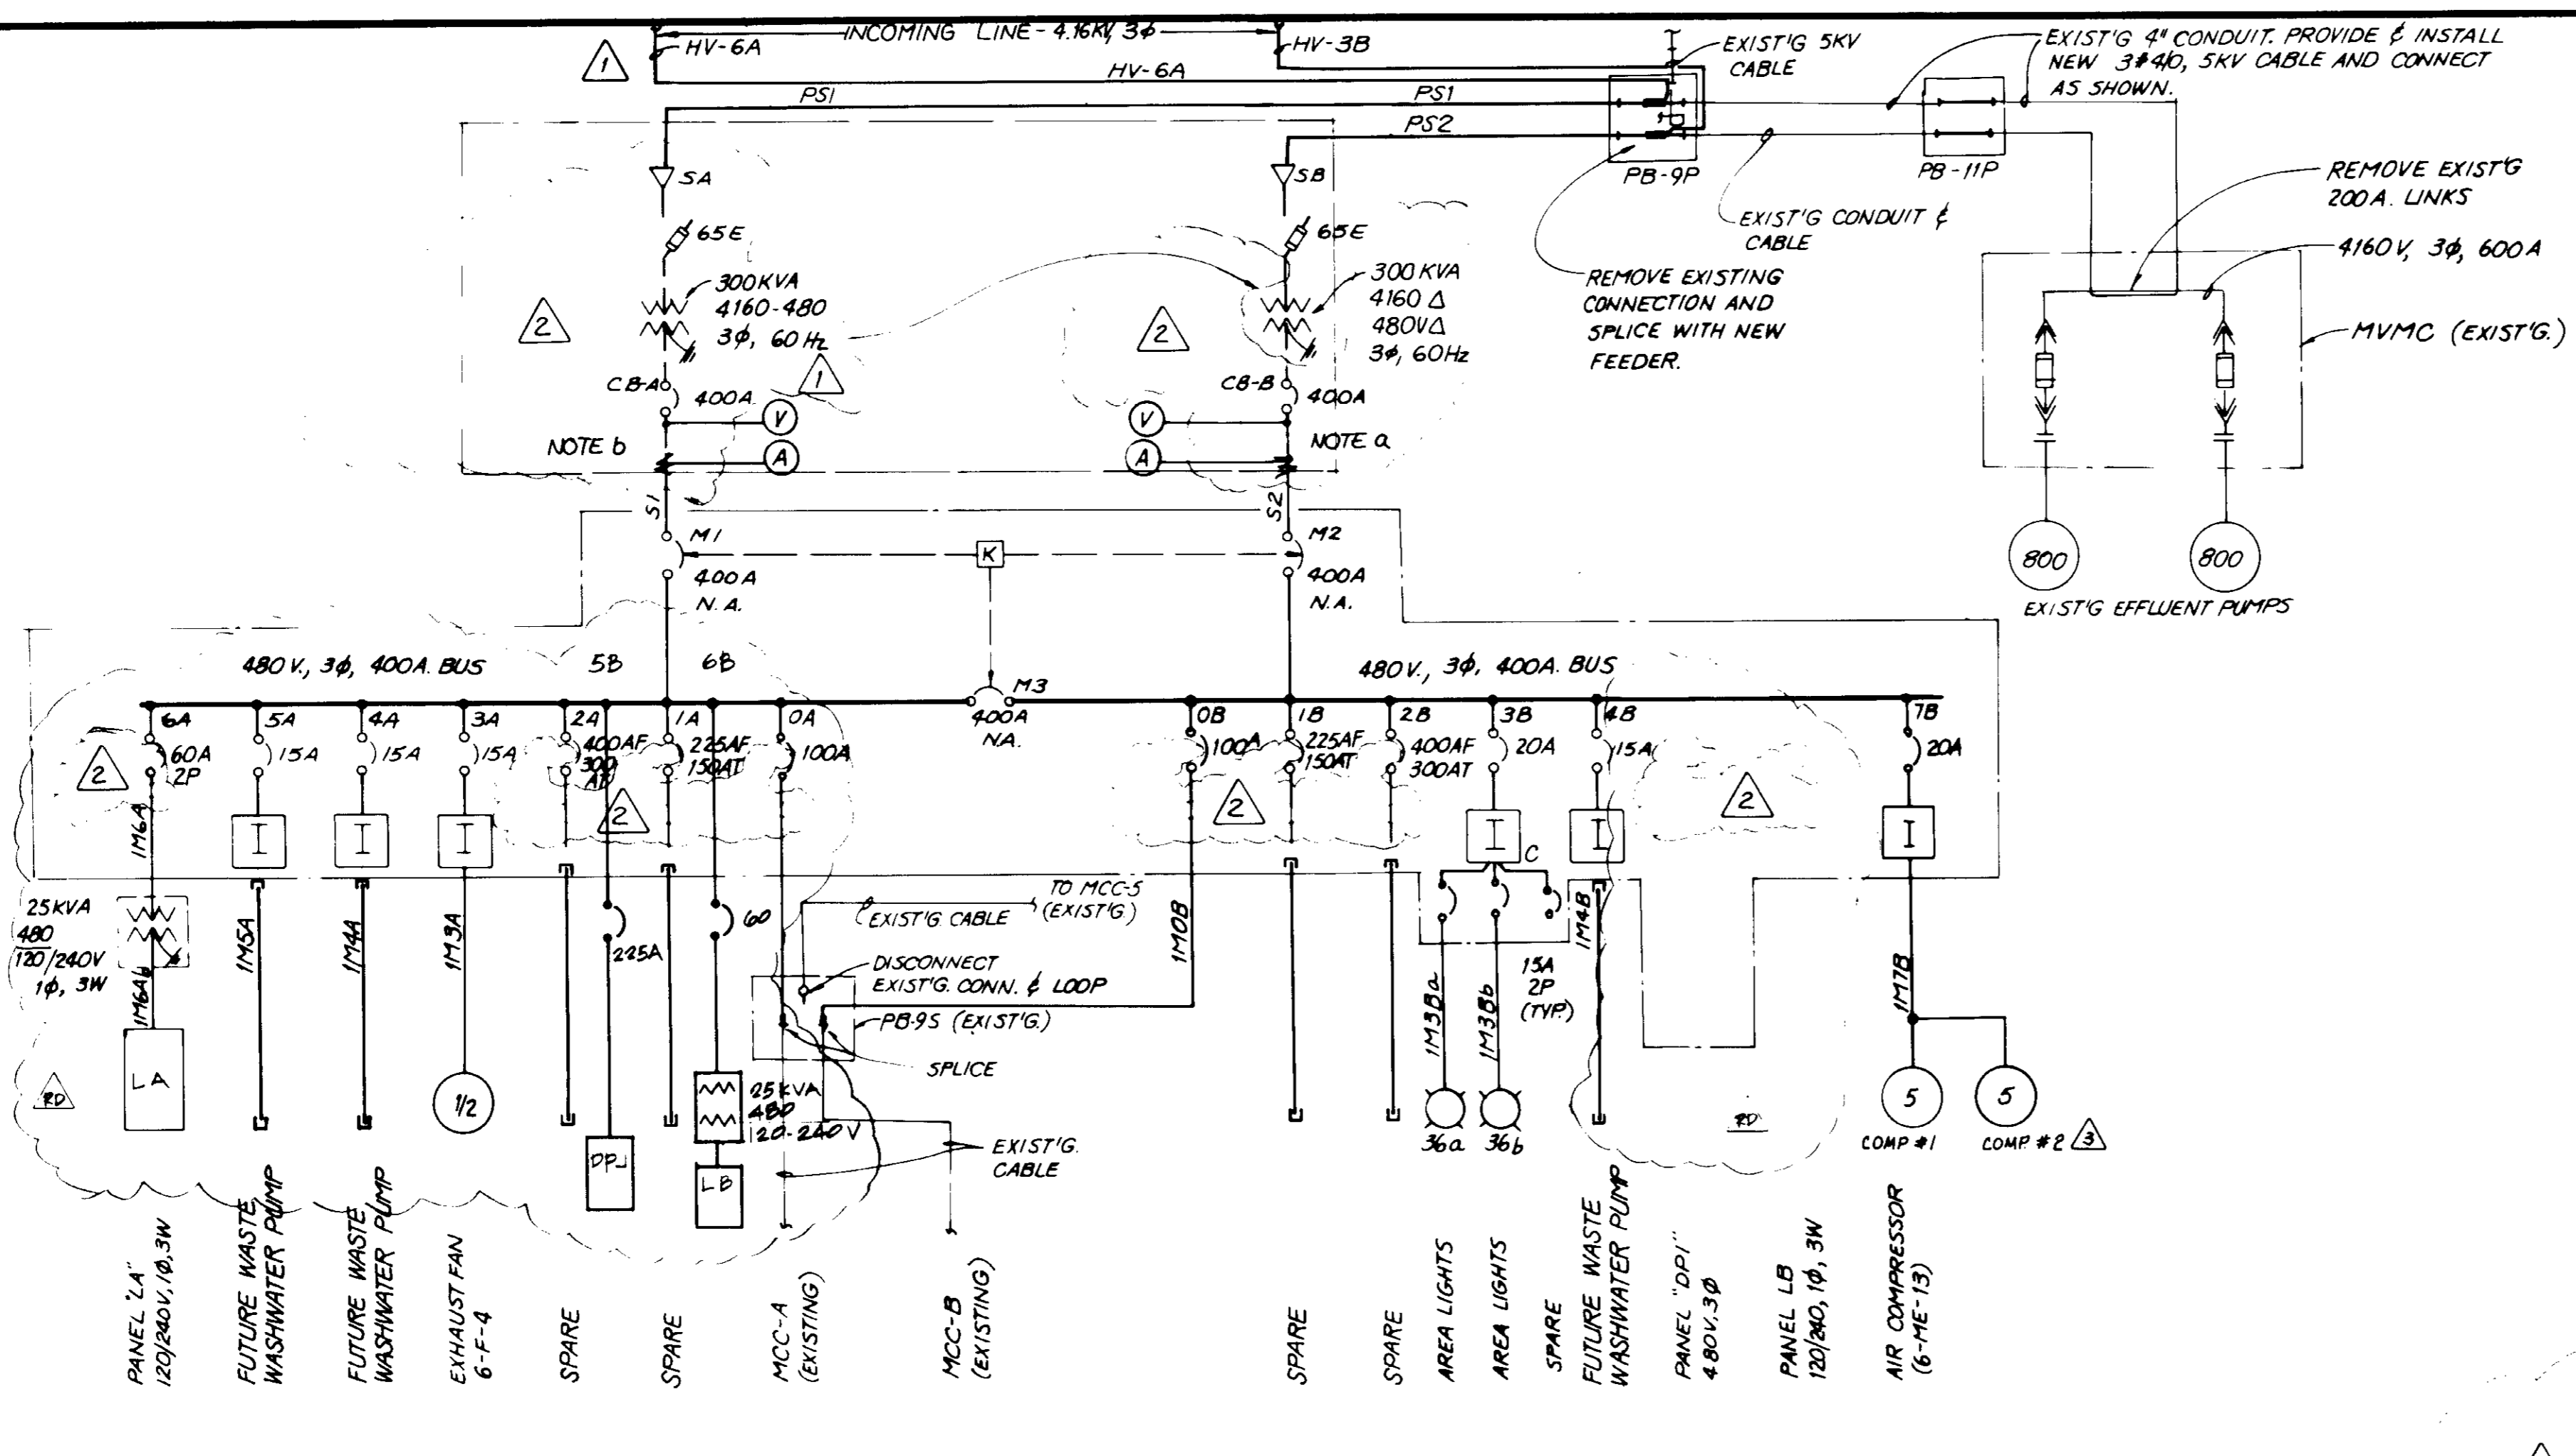


NOTE: DELETE PULLBOXES PB-A & PB-B. SPLICE 5KV CABLE IN PULLBOX PB-9P. DELETE ONE 300KVA TRANSFORMER TOGETHER WITH PRIMARY AND SECONDARY DISCONNECT AND IN PLACE OF IT INSTALL ONE EXISTING 300KVA TRANSFORMER TOGETHER WITH EXISTING DISCONNECTS. CONTRACTOR SHALL INSPECT THIS EXISTING 300KVA TRANSFORMER NOW ON SITE AND EXAMINE PRIMARY AND SECONDARY CONDUCTOR TERMINATIONS. CONTRACTOR SHALL PROVIDE ALL NECESSARY ACCESSORIES AND COMPONENTS TO MAKE INSTALLATION COMPLETE.

a. FURNISH AND INSTALL MOLDED CASE CIRCUIT BREAKER WITH SOLID STATE TRIP UNITS INSTEAD OF AIR CIRCUIT BREAKER AS DESCRIBED IN SPECS.

b. DELETE ALL GROUND FAULT PROTECTION IN FAVOR OF GROUND FAULT ALARM

EXISTING 300KVA SUBSTATION TO BE REUSED.
 * PHYSICAL DIMENSIONS SHALL BE VERIFIED W/EXIST'G SUBSTATION.

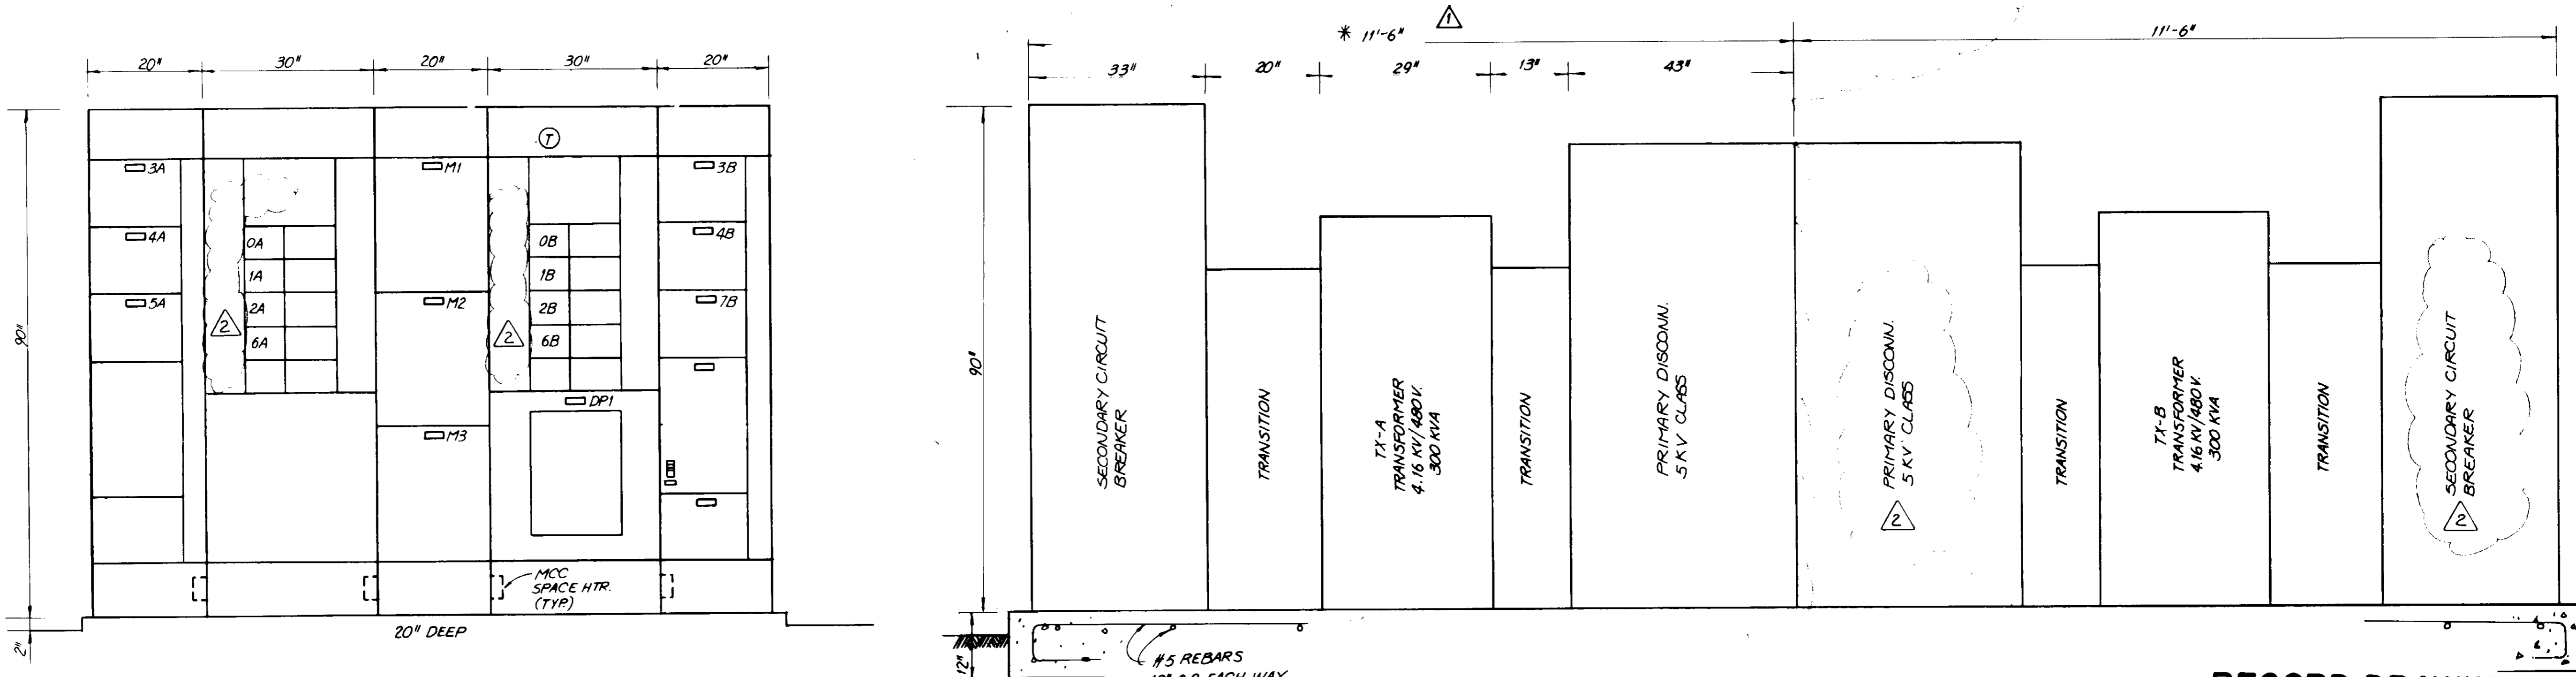

MCC - IM

SUBSTATION

03597

RECORD DRAWING

West Schneider REE 6373

REV	DATE	BY	DESCRIPTION
3/20/01		MCS	AS-BUILT REVISION - ADDED COMP #2
4/11/04		MDU	RECORD DRAWING
8-6-04		M.S.	PCH #18
3-18-04		M.S.	CHANGE ORDER

SCALE:	DESIGNED:	SUBMITTED:
NONE	M. SANTOS	27304 3/10/01
	M. LASLEY	27304 R.C.E. NO. DATE
	H. RODRIGUEZ	27638 3/20/01
		27638 R.C.E. NO. DATE



JAMES M. MONTGOMERY CONSULTING ENGINEERS, INC.

355 EAST WALNUT STREET, PASADENA, CALIFORNIA 91101

DISTRICT APPROVAL ON TITLE PAGE

LAS VIRGENES MWD/TRIUNFO CSD		SHEET
TAPIA WRF - FILTRATION/DISINFECTION ADDITION		E-3
PHASE II	SINGLE LINE DIAGRAM AND EQUIPMENT ELEVATIONS	OF 66 SHEETS

JOB NO. 570.0070 FILE NO. CC 278

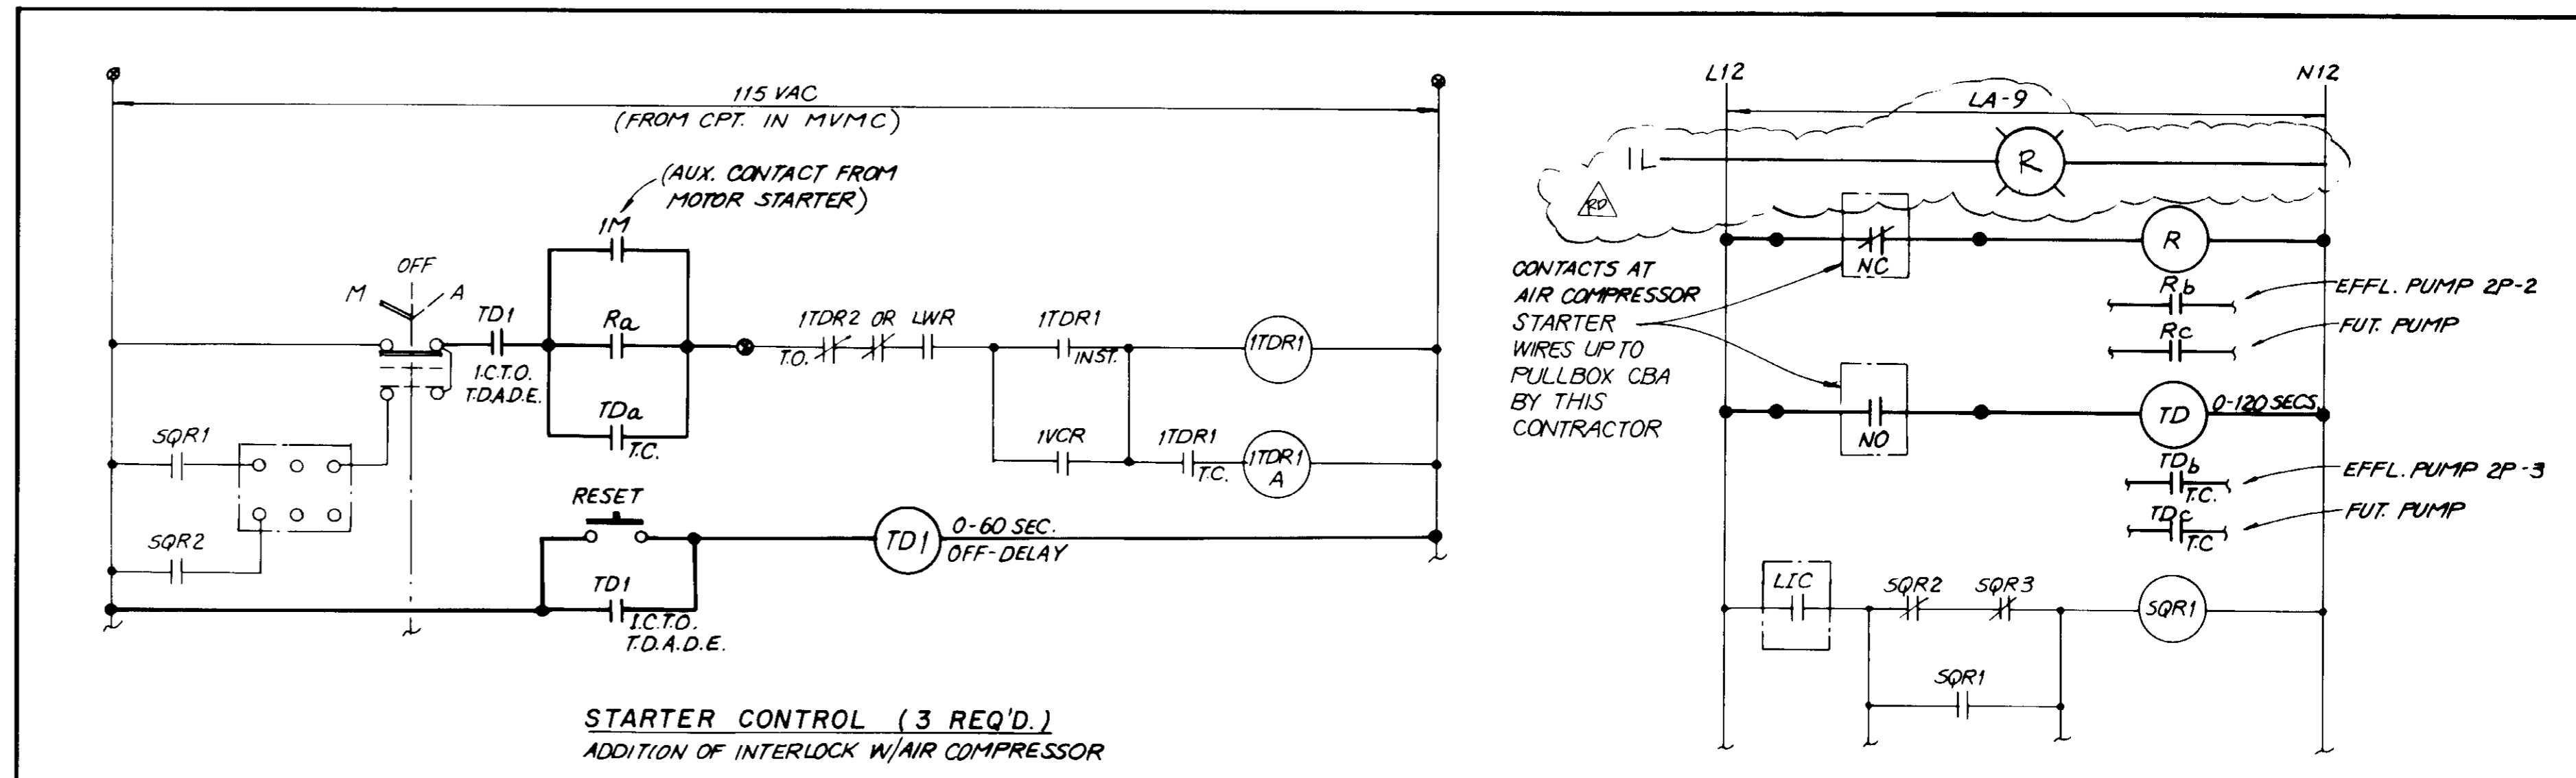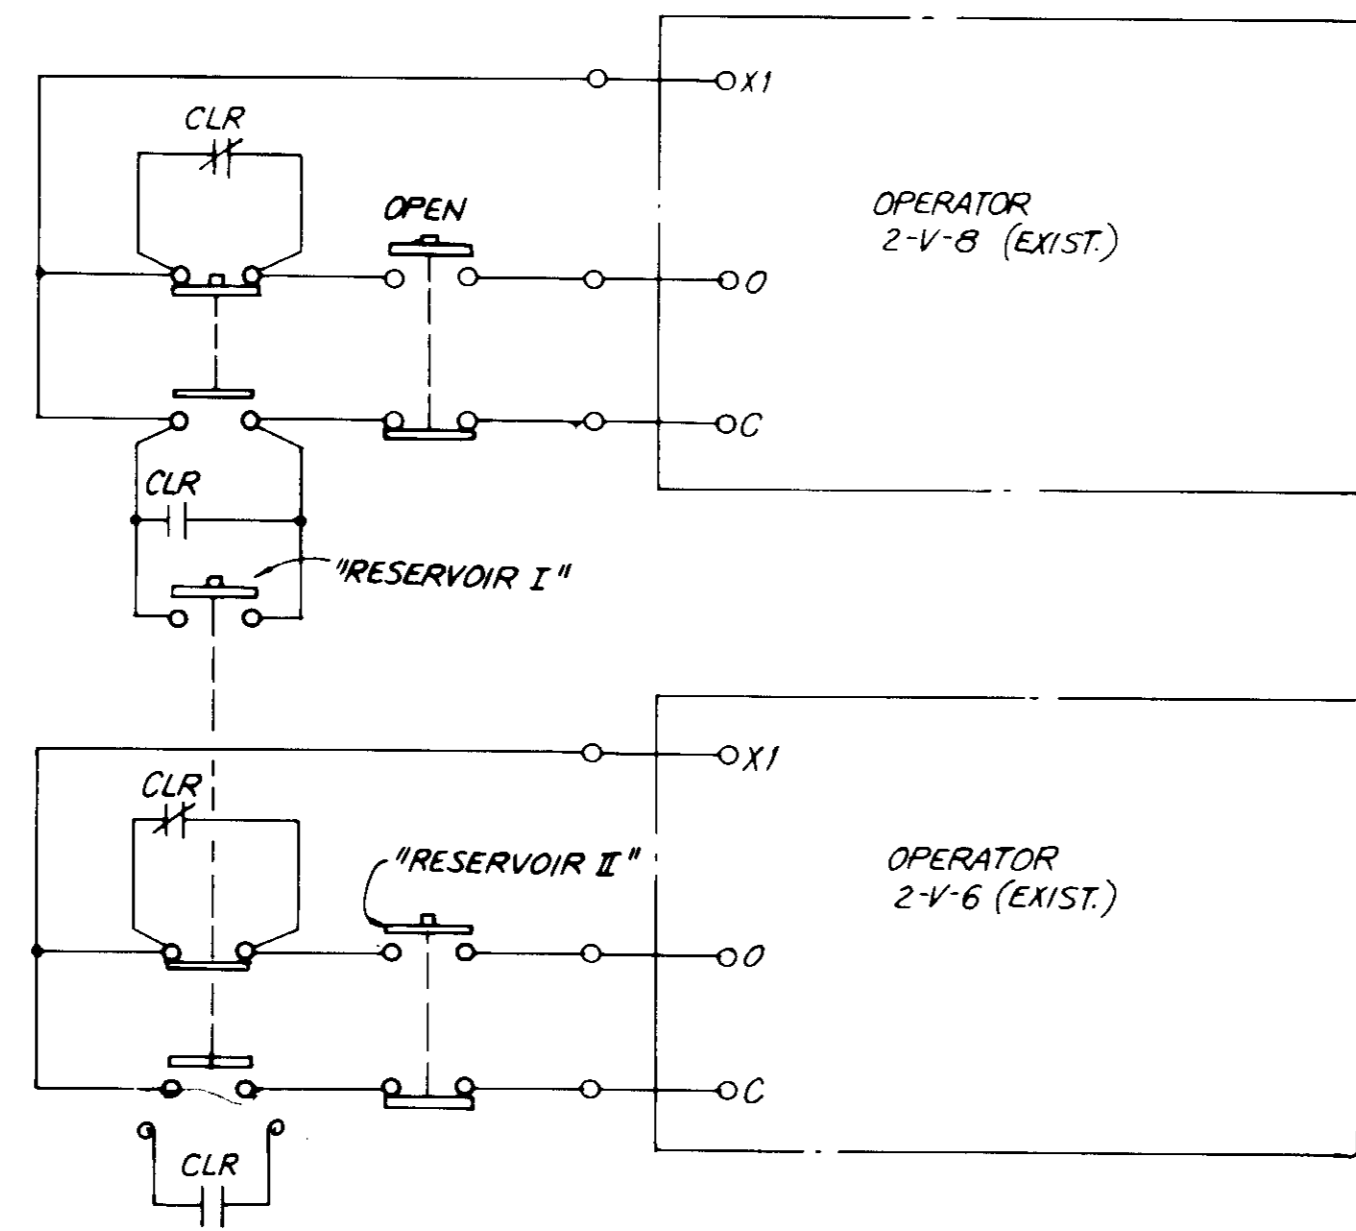

STARTER CONTROL (3 REQ'D.)
ADDITION OF INTERLOCK W/AIR COMPRESSOR

EFFLUENT PUMP CONTROL MODIFICATION
 * ALL COMPONENTS SHOWN IN HEAVY LINES SHALL BE PROVIDED AND INSTALLED BY THIS CONTRACTOR INCLUDING ADDITIONAL AUXILIARY CONTACT AT EXIST. MOTOR STARTERS. COMPONENTS SHOWN IN LIGHT LINES ARE EXISTING.

3700099
JOB NO.



03598
RECORD DRAWING
Noel Schneider
 REE 6373

JOB NO. 8702.0070 FILE CC 279

DESIGNED	M. SANTOS	SUBMITTED	27709	8/19/81
DRAWN	D. BARBIER M. LASLEY	PROJECT ENGINEER		
CHECKED	H. RODRIGUEZ	RECOMMENDED	27638	9/20/81
REV	DATE	BY	DESCRIPTION	
1	3/1/82	MS	CHANGE ORDER	

JAMES M. MONTGOMERY CONSULTING ENGINEERS, INC.
 555 EAST WALNUT STREET, PASADENA, CALIFORNIA 91101

DISTRICT APPROVAL ON TITLE PAGE

LAS VIRGENES MWD/TRIUNFO CSD		SHEET E-4 OF 66 SHEETS
TAPIA WRF - FILTRATION/DISINFECTION ADDITION		
PHASE II	SCHMATIC DIAGRAMS	

CABLE NO.	CONDUCTORS	CONDUIT NO.	SIZE	FUNCTION	FROM	TO	ROUTE	REMARKS
PS1	3# 250 MCM	PS1	3"	POWER	SUBSTATION	PB-9P (EXIST.)		SKV CLASS, SHIELDED
PS2	3# 250 MCM	PS2	3"	POWER	SUBSTATION	PB-9P (EXIST.)		
S1a	3# 250 MCM	S1a	3"	POWER FEEDER TO MCC-1M	SUBSTATION (300 KVA)	MCC-1M		PARALLEL FDR'S. (S1)
S1b	3# 250 MCM	S1b	3"					
S2a	3# 250 MCM	S2a	3"					PARALLEL FDR'S. (S2)
S2b	3# 250 MCM	S2b	3"					
1M1A	3# 20	1M1A	3"		MCC-2M	MCC-1M	MCC-2M	
1M2A	3# 350 MCM	1M2A	3"		MCC-3M	MCC-1M	MCC-3M	
1M0A	3# 1	1M0A	1 1/2"	POWER	MCC-1M	PULL BOX PB 9S (EXIST.)		
1M0B	3# 1	1M0B	1 1/2"	POWER	MCC-1M	PULL BOX PB 9S		
1M1B	3# 20	1M1B	3"	POWER	MCC-1M	MCC-2M		
1M2B	3# 250 MCM	1M2B	3"	POWER	MCC-1M	MCC-3M		
1M3BA								
1M6A b	3# 1/0	1M6A b	2"	120/240V POWER	25 KVA TRANSFORMER	PANEL LA		
1M6B b	3# 1/0	1M6B b	2"	120/240V POWER	25 KVA TRANSFORMER	PANEL LB		
2M1A	3# 8	2M1A	1"	POWER	MCC-2M	FILT. BW. PUMP 1P-4		
2M2A	3# 8	2M2A	1"	POWER	MCC-2M	FILT. BW. PUMP 1P-3		
2M1B	3# 8	2M1B	1"	POWER	MCC-2M	FILT. BW. PUMP 1P-5		
3M1A	3# 2	3M1A	1 1/2"	POWER	MCC-3M	FILT. INFL. PUMP 5P-1		
3M3A	3# 8, 8# 14	3M3A	1 1/4"	POWER & CONTROL	MCC-3M	CHAN. AGITATOR 4P-2		
3M1B	3# 2	3M1B	1 1/2"	POWER	MCC-3M	FILT. INFL. PUMP 5P-2		
		3M2B	1 1/2"	POWER		FILT. INFL. PUMP (FUT.)		C.O.
3M3B	3# 12	3M3B	3/4"	POWER		UNIT HEATER 4ME-1		
3M4B	3# 12, 8# 14	3M4B	1 1/4"	POWER & CONTROL		FLASH MIXER 4P-1		
3M7	3# 12	3M7B	3/4"	POWER	MCC-3M	SUMP PUMP 4P-3 (4P-4)		

CABLE NO.	CONDUCTORS	CONDUIT NO.	SIZE	FUNCTION	FROM	TO	ROUTE	REMARKS
		C0	2"		SEE DUCT SCHEDULE			
C1	8# 14	C1	1"	CONTROL & SPACE HTR.	MCC-3M	FILT. INFL. PUMP 5P-1		
C2	8# 14	C2	1"	CONTROL & SPACE HTR.	MCC-3M	FILT. INFL. PUMP 5P-2		
		C3	1"	CONTROL & SPACE HTR.	MCC-3M	FILT. INFL. PUMP (FUT.)		
C4	3# 14	C4	3/4"	LOW SUCTION CUT OFF	MCC-3M	FILT. INFL. PUMP STA.		
C5	8# 14	C5	1"	CONTROL	VALVE 5V-5	PUSH BUTTON STA. LCB2		
C6	2# 12, 2# 16 SHLD	C6	1"	POWER & SIGNAL	LCB-2	FLOW TRANS. 4M-2 (4M-1)		
C7	2# 12, 2# 16 SHLD	C7	1"	POWER & SIGNAL	LCB-2	SONIC METER 4P-1		
C8	2# 12	C8	3/4"	POWER	LP-B	HEAT TRACE		
C11	8# 14	C11	1"	CONTROL & SPACE HTR.	MCC-2M	BW. PUMP 1P-3		
C12	8# 14	C12	1"	CONTROL & SPACE HTR.	MCC-2M	BW. PUMP 1P-4		
C13	8# 14	C13	1"	CONTROL & SPACE HTR.	MCC-2M	BW. PUMP 1P-5		
C14	8# 14	C14	1"	CONTROL	MCC-2M	LO-WATER AT SUCTION		
C18	2# 12, 2# 16 SHLD	C18	3/4"	POWER AND SIGNAL	FLOW METER 10-M-1	LCB-3		
C19	10-2C#16 SHLD	C19	2"	SIGNAL	LCB-2	LCB-3		
C20	15# 12	C20	1"	CONTROL	LCB-2	MOV 10-V-6		
C21	15# 12	C21	1"	CONTROL	LCB-2	MOV 4-V-1		
C22	10# 14	C22	1"	CONTROL	MCC-1M	FILT. AUTO C.P.		
C23	2# 14	C23	3/4"	SIGNAL	HI-LEVEL SENSOR	LCB-2		
C30	15# 14	C30	1"	CONTROL	MCC-2M	FILT. RELAY PANEL		
C31	18# 14	C31	1"	STATUS	MCC-2M	LCB-2		
		HS		SEE DRAWINGS FOR CONDUIT SIZE,	CABLES BY INTERCOM SUPPLIER			
C39	2# 12, 2# 16 SHLD	C39	1"	POWER & SIGNAL	FLOW METER 10-M-1	LCB-3		
C42	17-2C#16 SHLD	C42	2"	SIGNALS	LCB-3	PULL BOX 9C		
C44	80# 14	C44	2"	ALARM, STATUS	LCB-3	PULL BOX 9C		
C45	3# 10	C45	1"	SPRINKLER SYSTEM	CHEM. BLDG.	PULL BOX 9C		
		C46	1"	SPRINKLER SYSTEM	CHEM. BLDG.	PULL BOX 9C		
C47	2# 12, 2# 16 SHLD	C47	3/4"	POWER AND SIGNAL	METER 10-M-2	LCB-3		
C48	2# 12, 2# 16 SHLD	C48	1"	POWER AND SIGNAL	BUBBLER UNIT	PANEL "LA"		
B20	2# 12	B20	1"	POWER	PANEL B	SPRINKLER		

NOT INCLUDED IN CONTRACT

NOTE: THIS CABLE AND CONDUIT SCHEDULE IS NOT COMPLETE. CONTRACTOR SHALL REFER TO ALL DRAWINGS FOR ADDITIONAL WIRES AND CONDUITS.

03599

RECORD DRAWING

Robert Schneider


REE 6373

870.0070


SCALE: NONE DESIGNED: M. SANTOS DRAWN: D. BARBIER CHECKED: H. RODRIGUEZ	SUBMITTED: <i>[Signature]</i> 27304 4/17/31 PROJECT ENGINEER R.C.E. NO. DATE RECOMMENDED: <i>[Signature]</i> 27638 2/20/31 JAMES M. MONTGOMERY CONSULTING ENGINEERS, INC. R.C.L. NO. DATE	DISTRICT APPROVAL ON TITLE PAGE LAS VIRGENES MWD/TRIUNFO CSD TAPIA WRF - FILTRATION/DISINFECTION ADDITION PHASE II CONDUIT AND WIREFILL SCHEDULE	SHEET E-5 OF 66 SHEETS

JAMES M. MONTGOMERY CONSULTING ENGINEERS, INC.

555 EAST WALNUT STREET, PASADENA, CALIFORNIA 9101

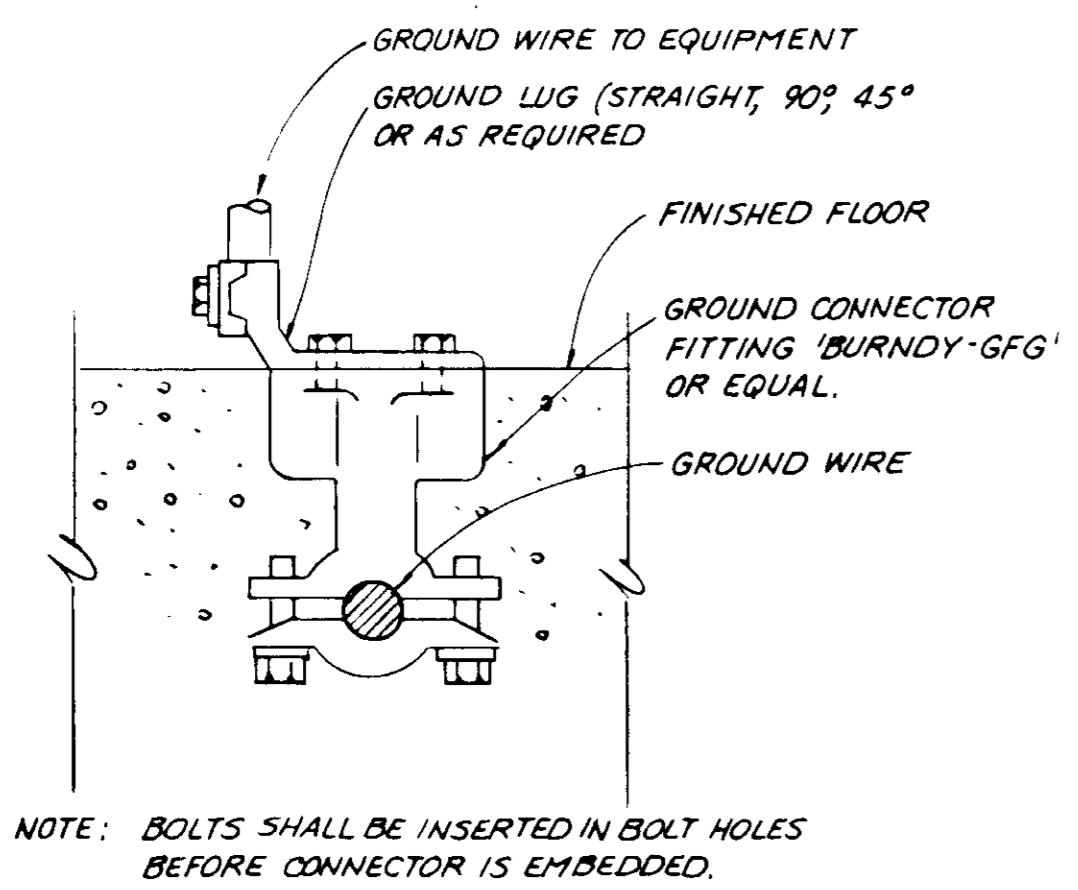


GROUNDING INSERT A

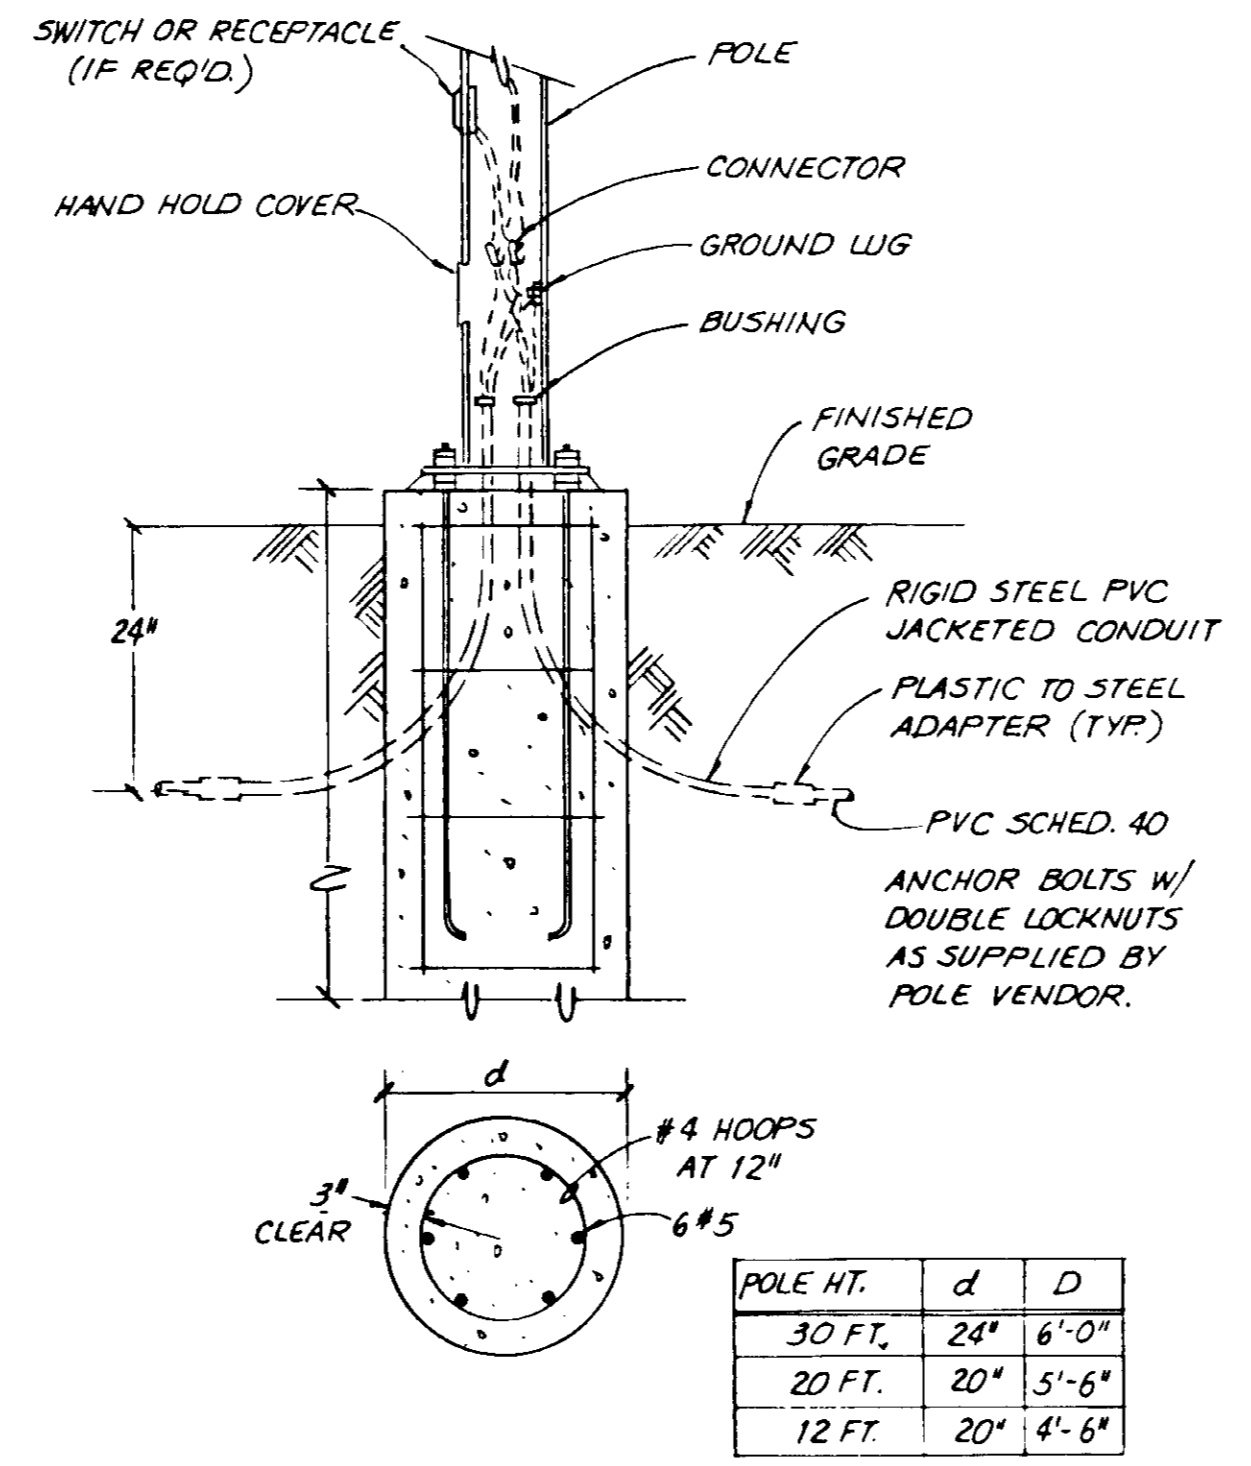


POLE MOUNTING B

POLE HT.	d	D
30 FT.	24"	6'-0"
20 FT.	20"	5'-6"
12 FT.	20"	4'-6"

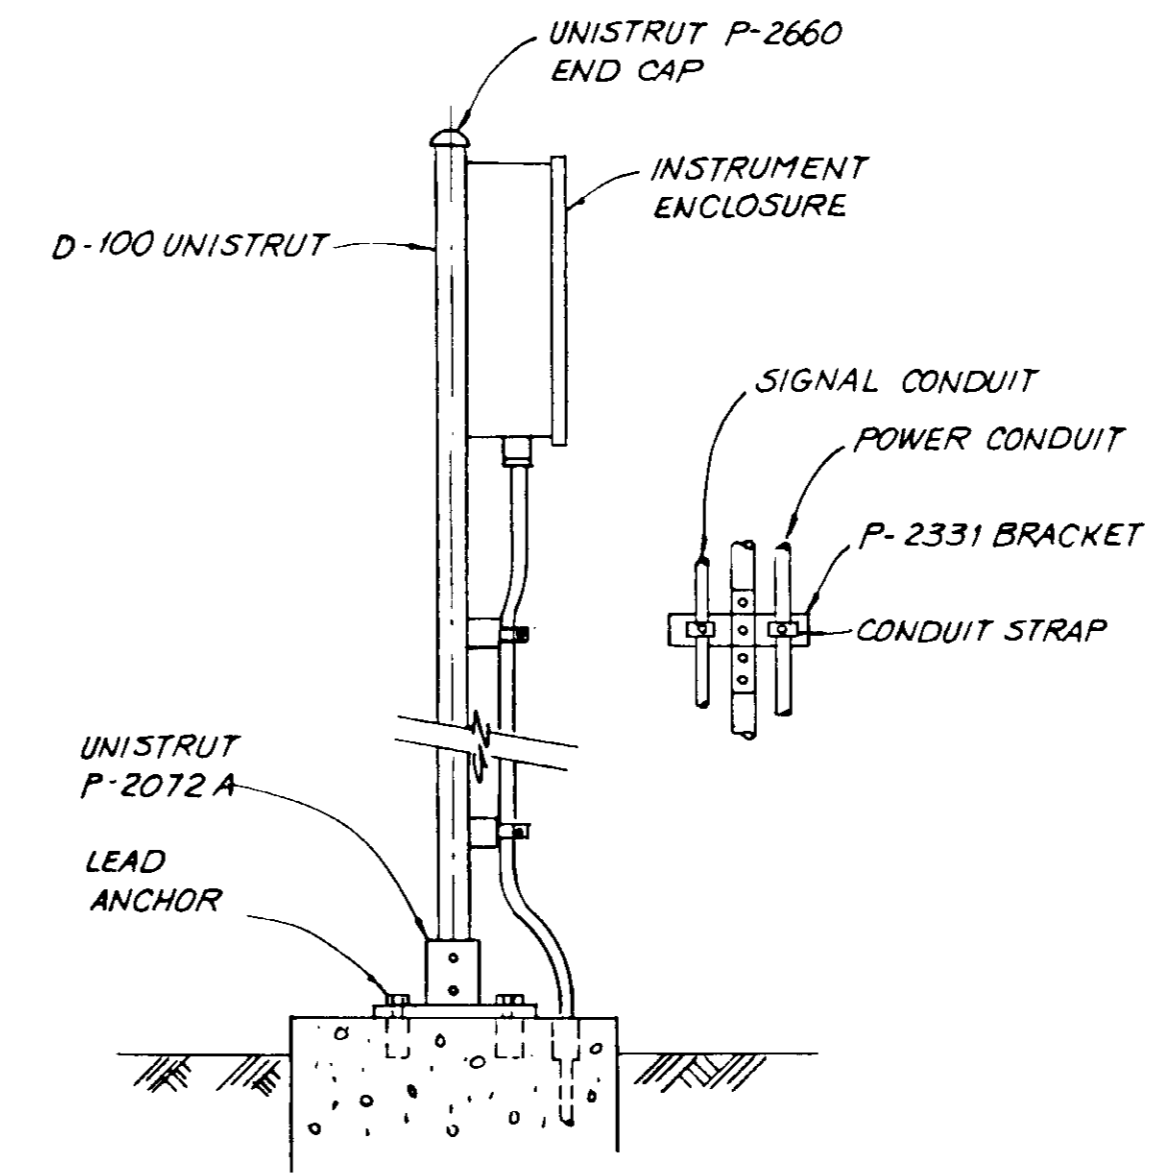


INSTRUMENT ENCLOSURE MOUNTING C

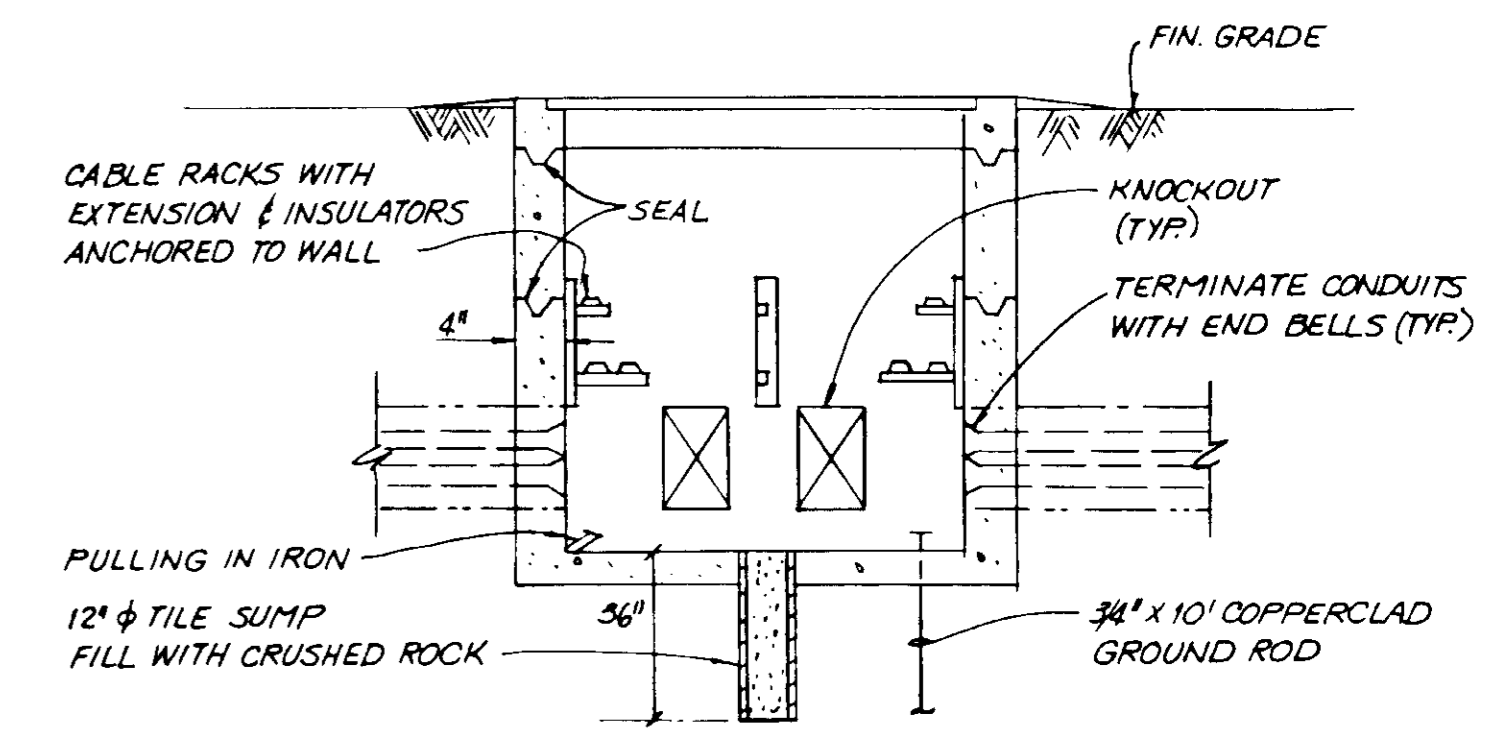


UNDERGROUND PULLBOX D


DRAINAGE AWAY FROM PULLBOXES. CONTRACTOR TO ADJUST PAVING TO ACCOMMODATE THIS.

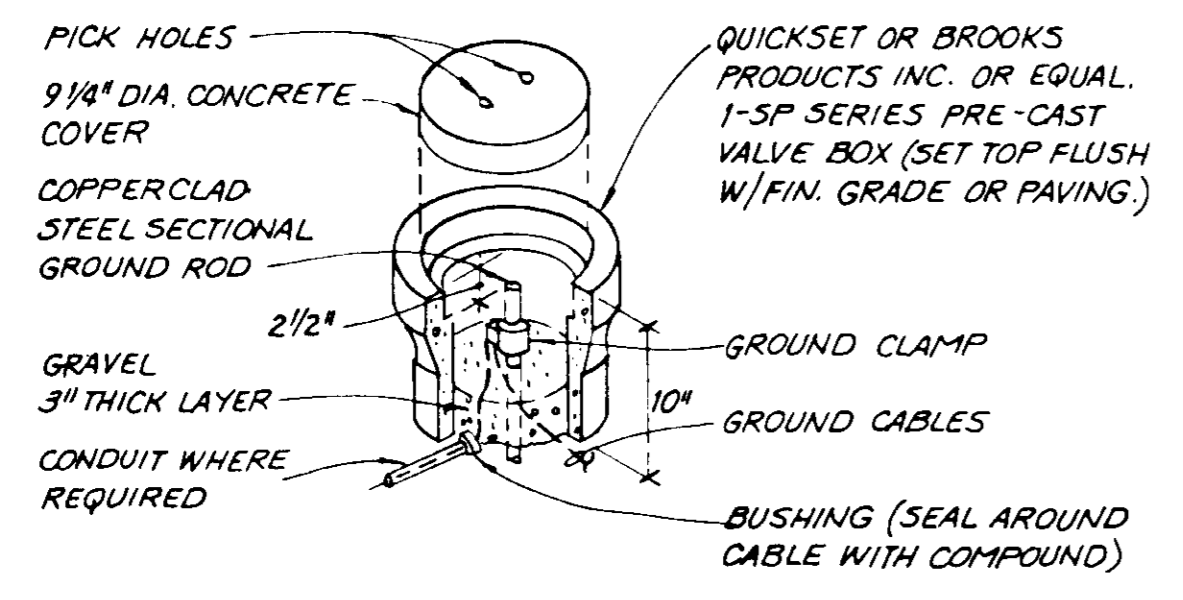


GROUND ROD & BOX INSTALLATION E

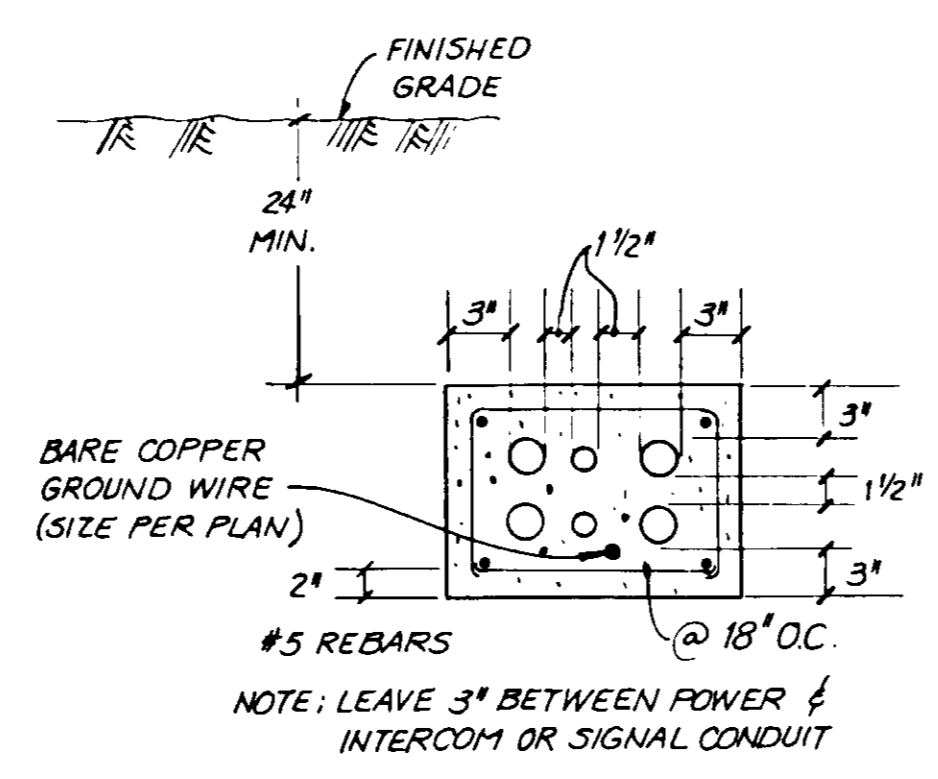


DUCT BANK SECTION F

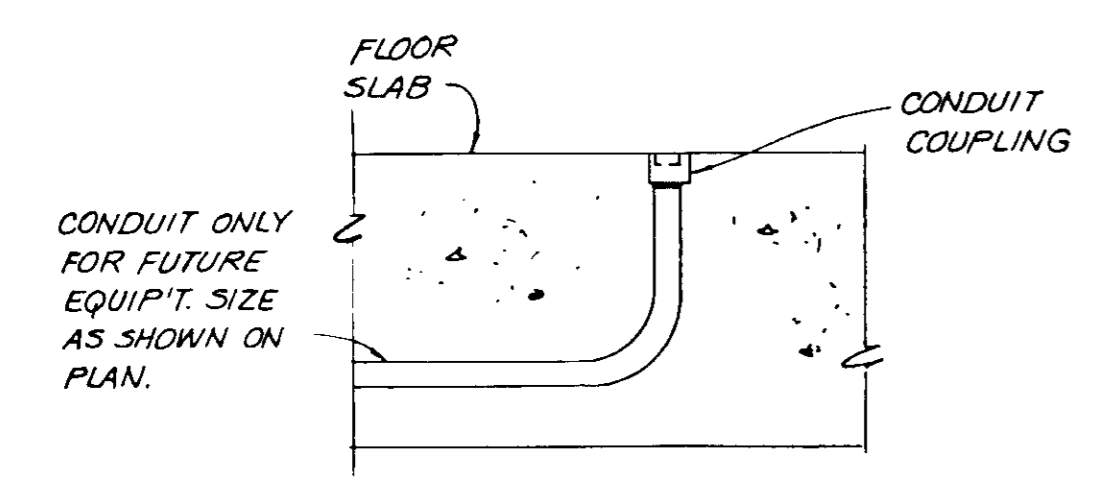

CONDUIT STUB-UP FOR FUTURE EQUIPMENT G

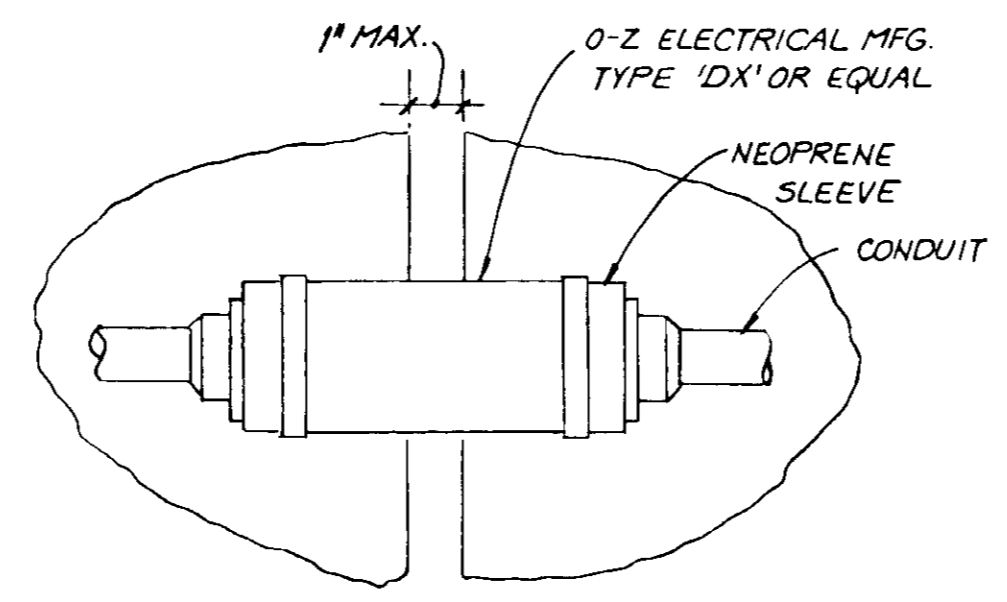

EXPANSION COUPLING J

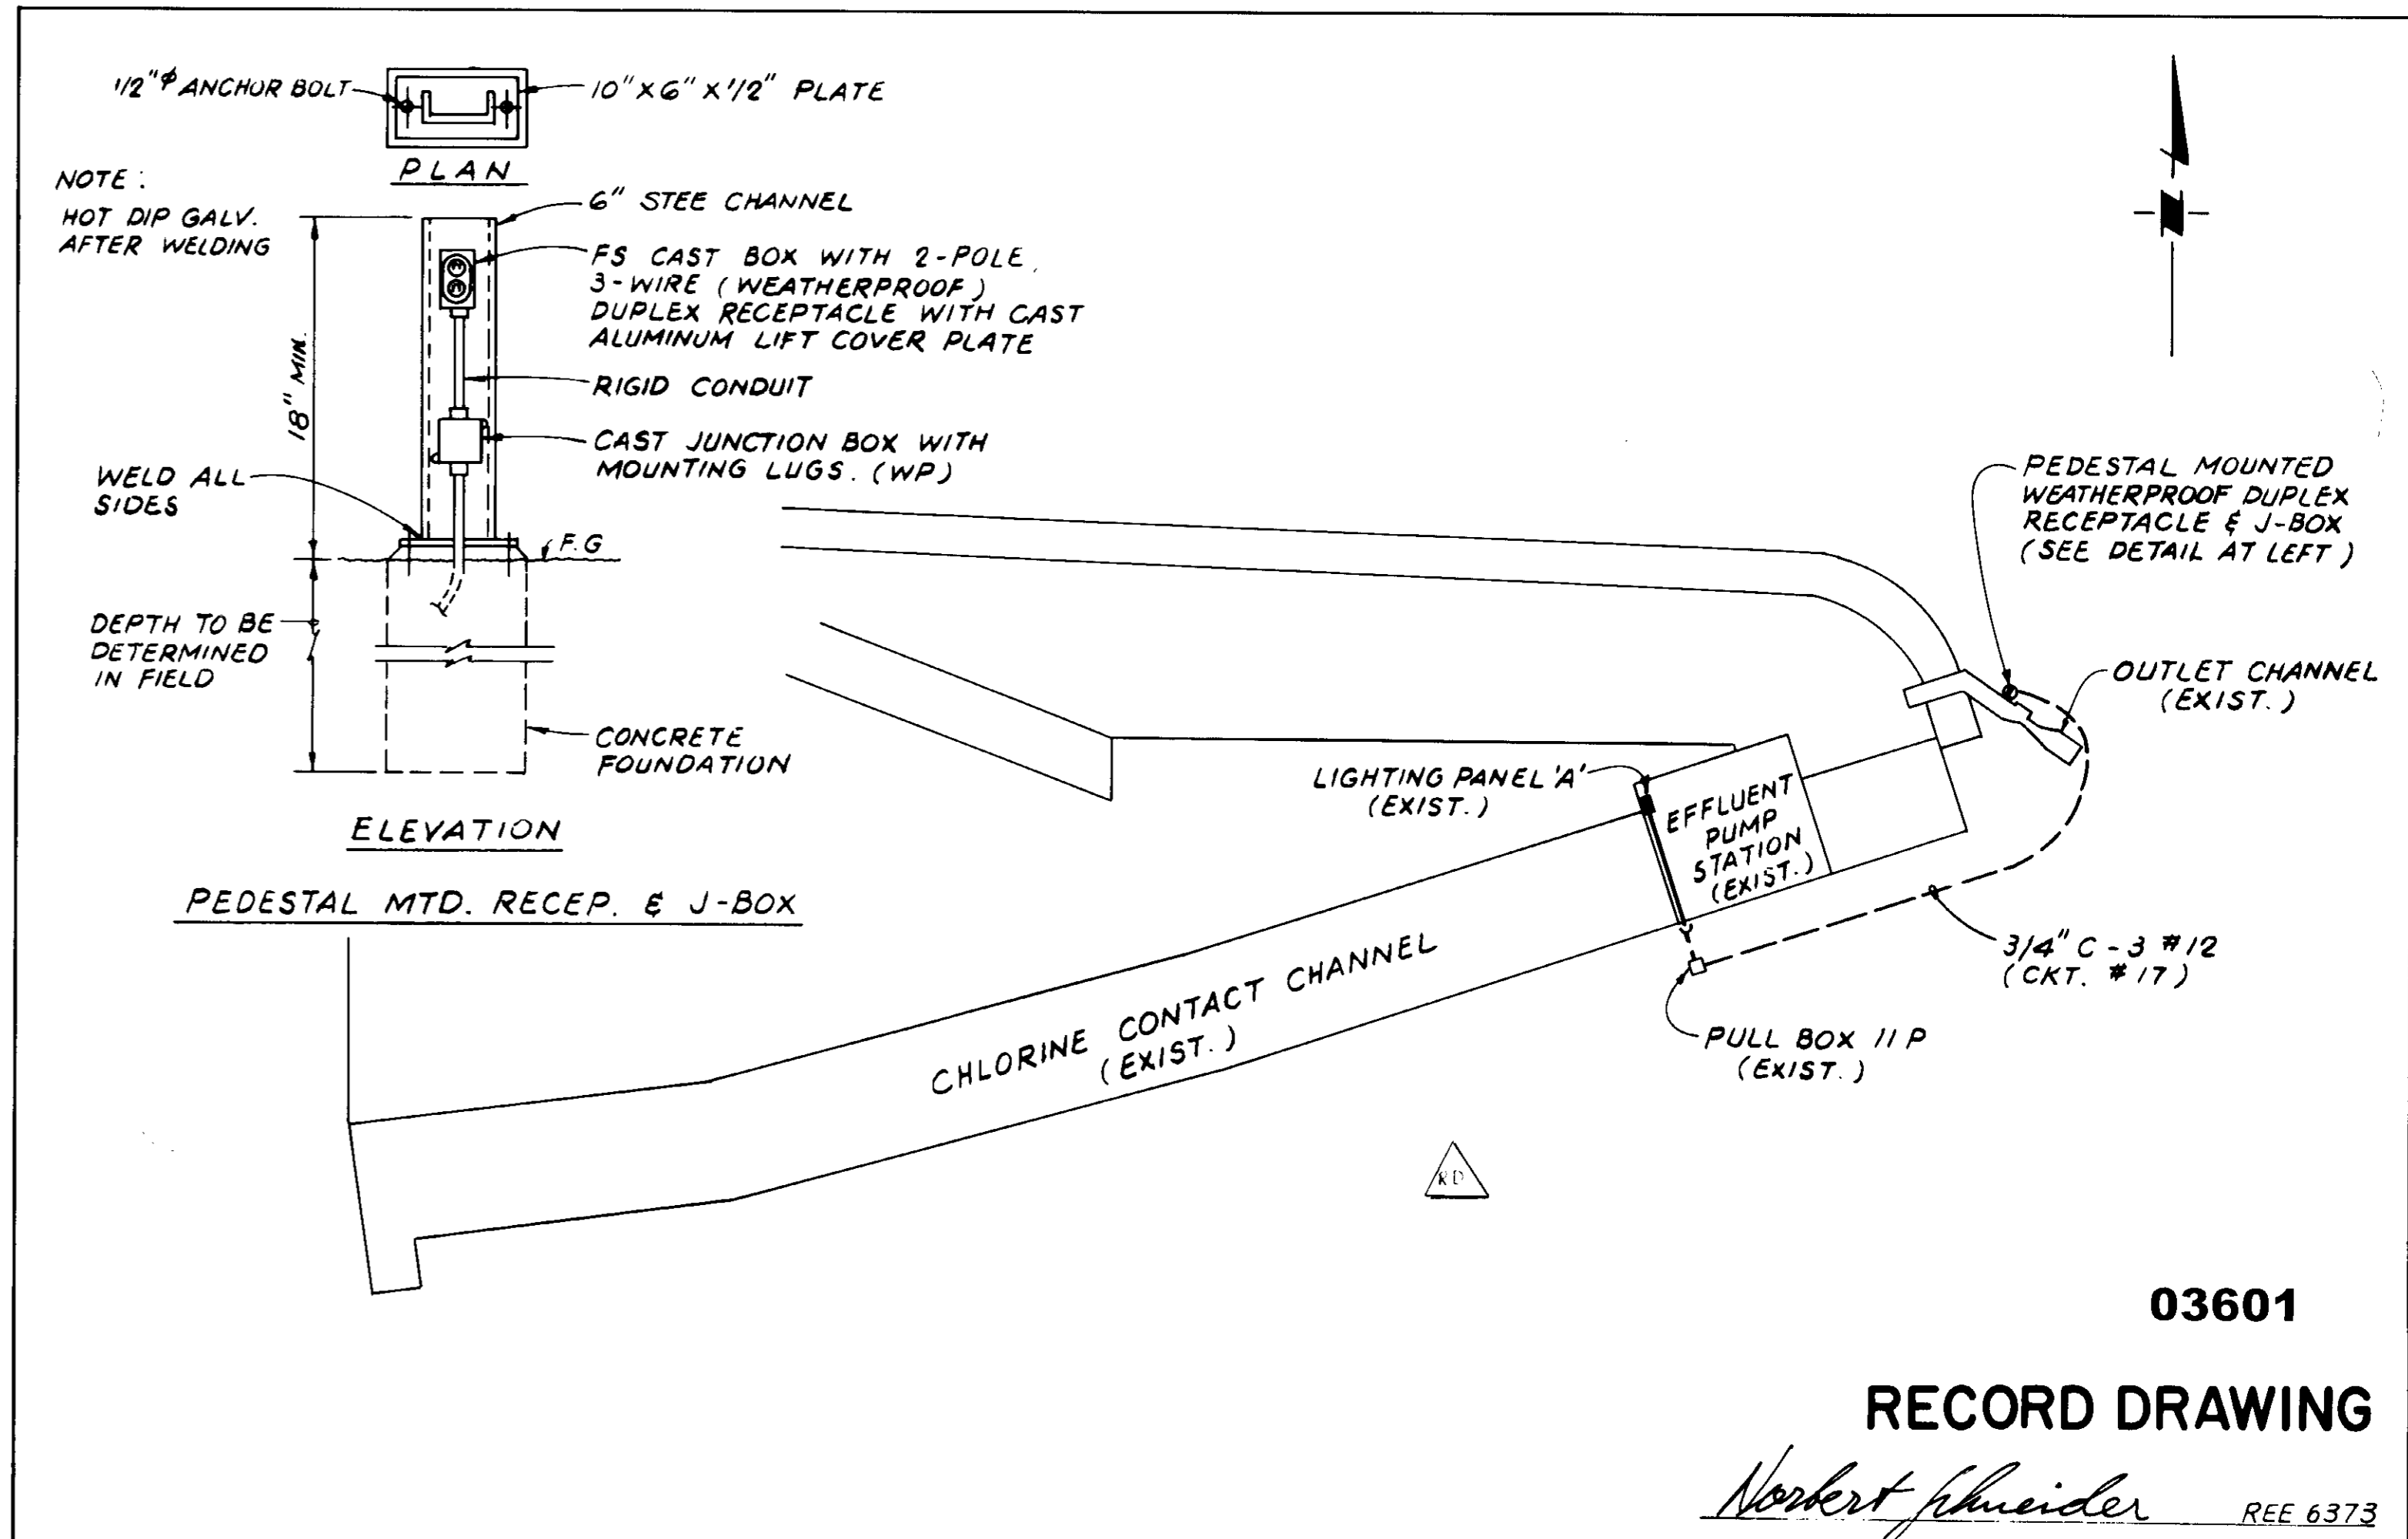

PEDESTAL MTD. RECEPT. & J-BOX I

03601

RECORD DRAWING

Wookert Schneider REE 6373

B70.0070

REV	DATE	BY	DESCRIPTION



DESIGNED	H. RODRIGUEZ	SUBMITTED	27304	9/19/81
DRAWN	BC/DB	PROJECT ENGINEER	R.C.E. NO.	DATE
CHECKED	M. SANTOS	RECOMMENDED	27638	9/20/81
		JAMES M. MONTGOMERY CONSULTING ENGINEERS, INC.	R.C.E. NO.	DATE

JAMES M. MONTGOMERY CONSULTING ENGINEERS, INC.
 555 EAST WALNUT STREET, PASADENA, CALIFORNIA 91101


DISTRICT APPROVAL ON TITLE PAGE

PHASE II	MISCELLANEOUS DETAILS
----------	-----------------------

SHEET E-7 OF 66 SHEETS

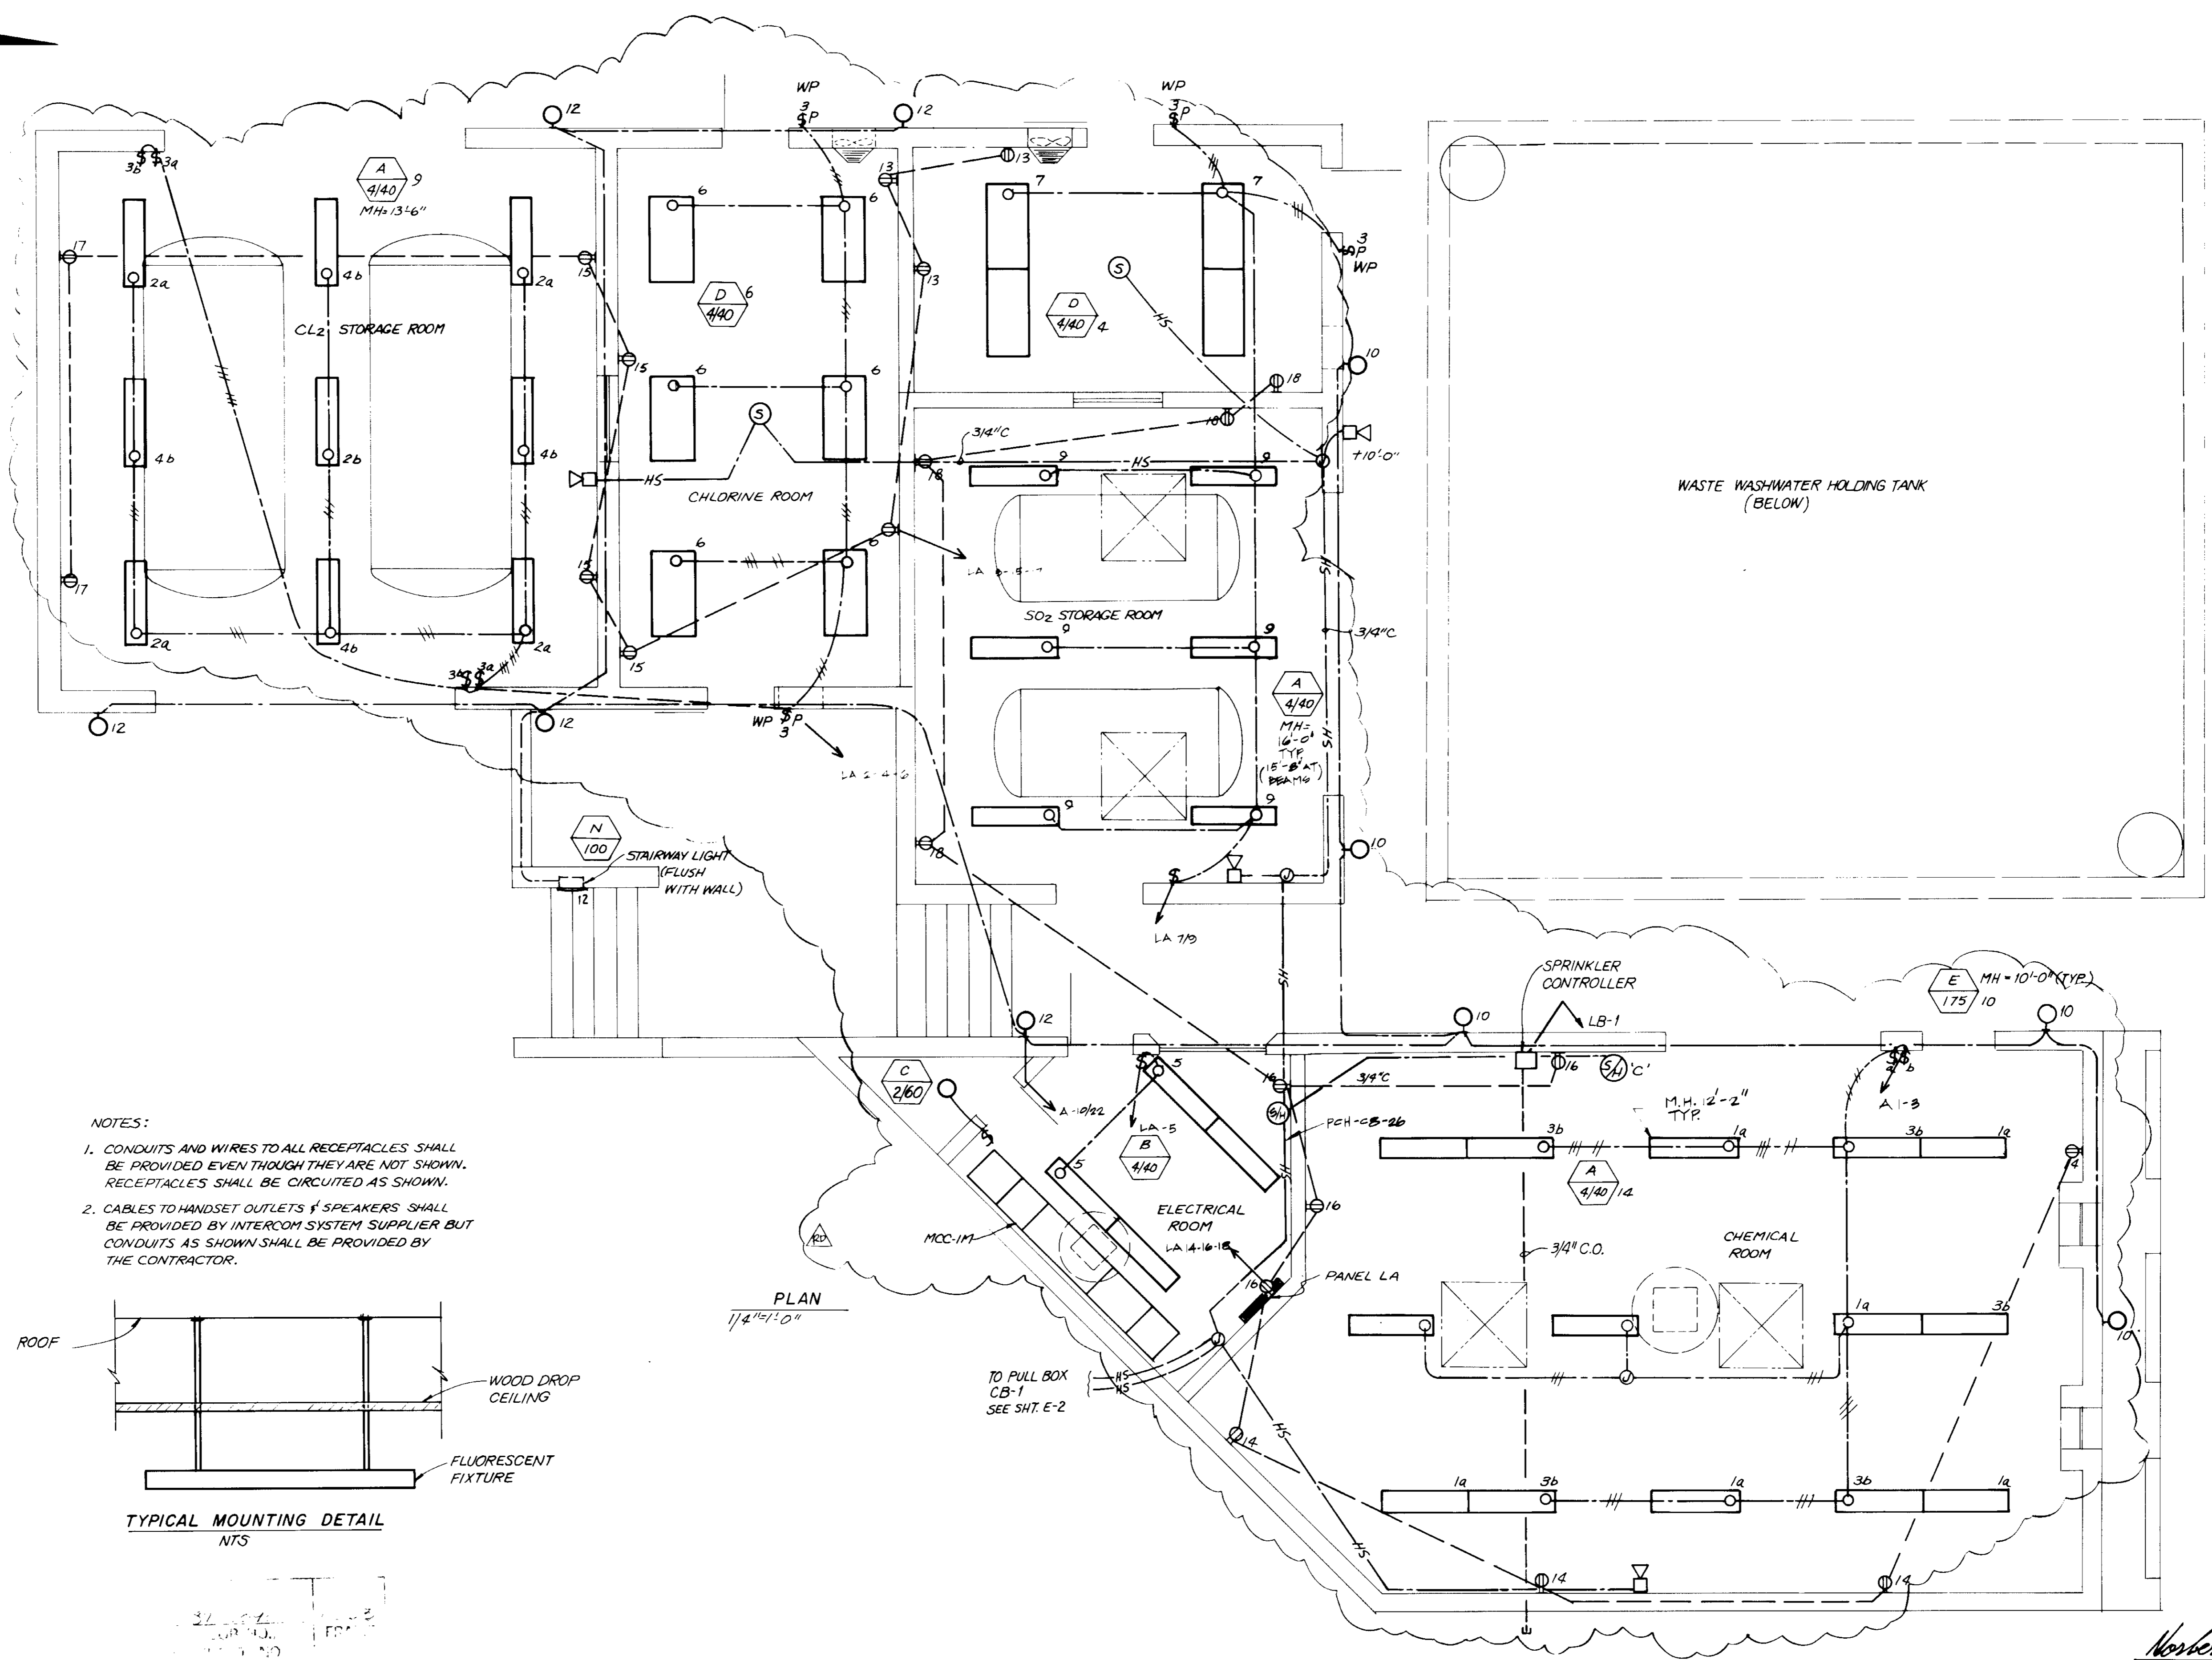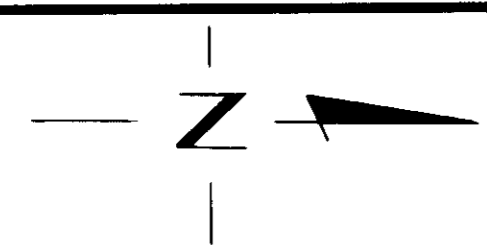

- NOTES:
1. CONDUITS AND WIRES TO ALL RECEPTACLES SHALL BE PROVIDED EVEN THOUGH THEY ARE NOT SHOWN. RECEPTACLES SHALL BE CIRCUITED AS SHOWN.
 2. CABLES TO HANDSET OUTLETS & SPEAKERS SHALL BE PROVIDED BY INTERCOM SYSTEM SUPPLIER BUT CONDUITS AS SHOWN SHALL BE PROVIDED BY THE CONTRACTOR.

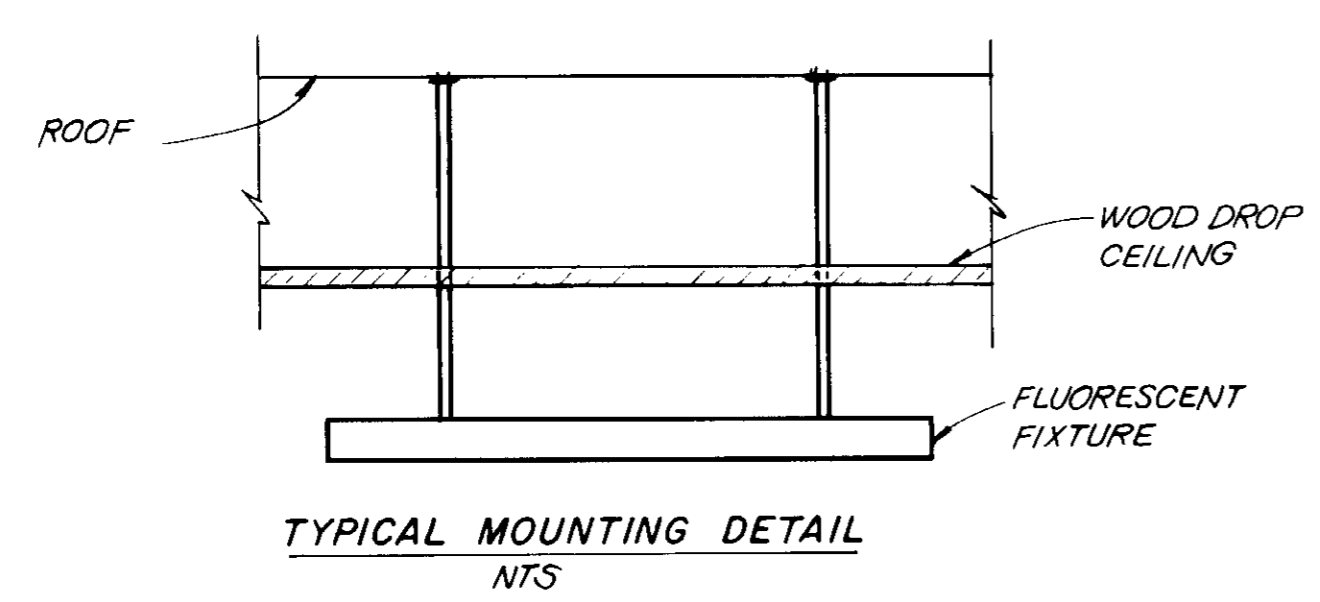

PLAN
1/4" = 1'-0"

03602

RECORD DRAWING

Herbert Schneider REE 6373

RD	4/18/81	MPJ	RECORD DRAWING
REV	DATE	BY	DESCRIPTION

SCALE:
AS NOTED

DESIGNED: H. RODRIGUEZ
DRAWN: MICHAEL LASLEY
CHECKED: M. SANTOS

SUBMITTED
PROJECT ENGINEER
RECOMMENDED
JAMES M. MONTGOMERY CONSULTING ENGINEERS, INC.

27304 9/19/81
R.C.E. NO. DATE

27633 8/29/81
R.C.E. NO. DATE

JAMES M. MONTGOMERY CONSULTING ENGINEERS, INC.

555 EAST WALNUT STREET, PASADENA, CALIFORNIA 91101

DISTRICT APPROVAL ON TITLE PAGE




LAS VIRGENES MWD/TRIUNFO CSD
TAPIA WRF - FILTRATION/DISINFECTION ADDITION

PHASE II

CHEMICAL BUILDING
LIGHTING AND RECEPTACLE PLAN

SHEET
6E-1
OF 66 SHEETS

FILE CC 7/79
JOB NO. 870-0070

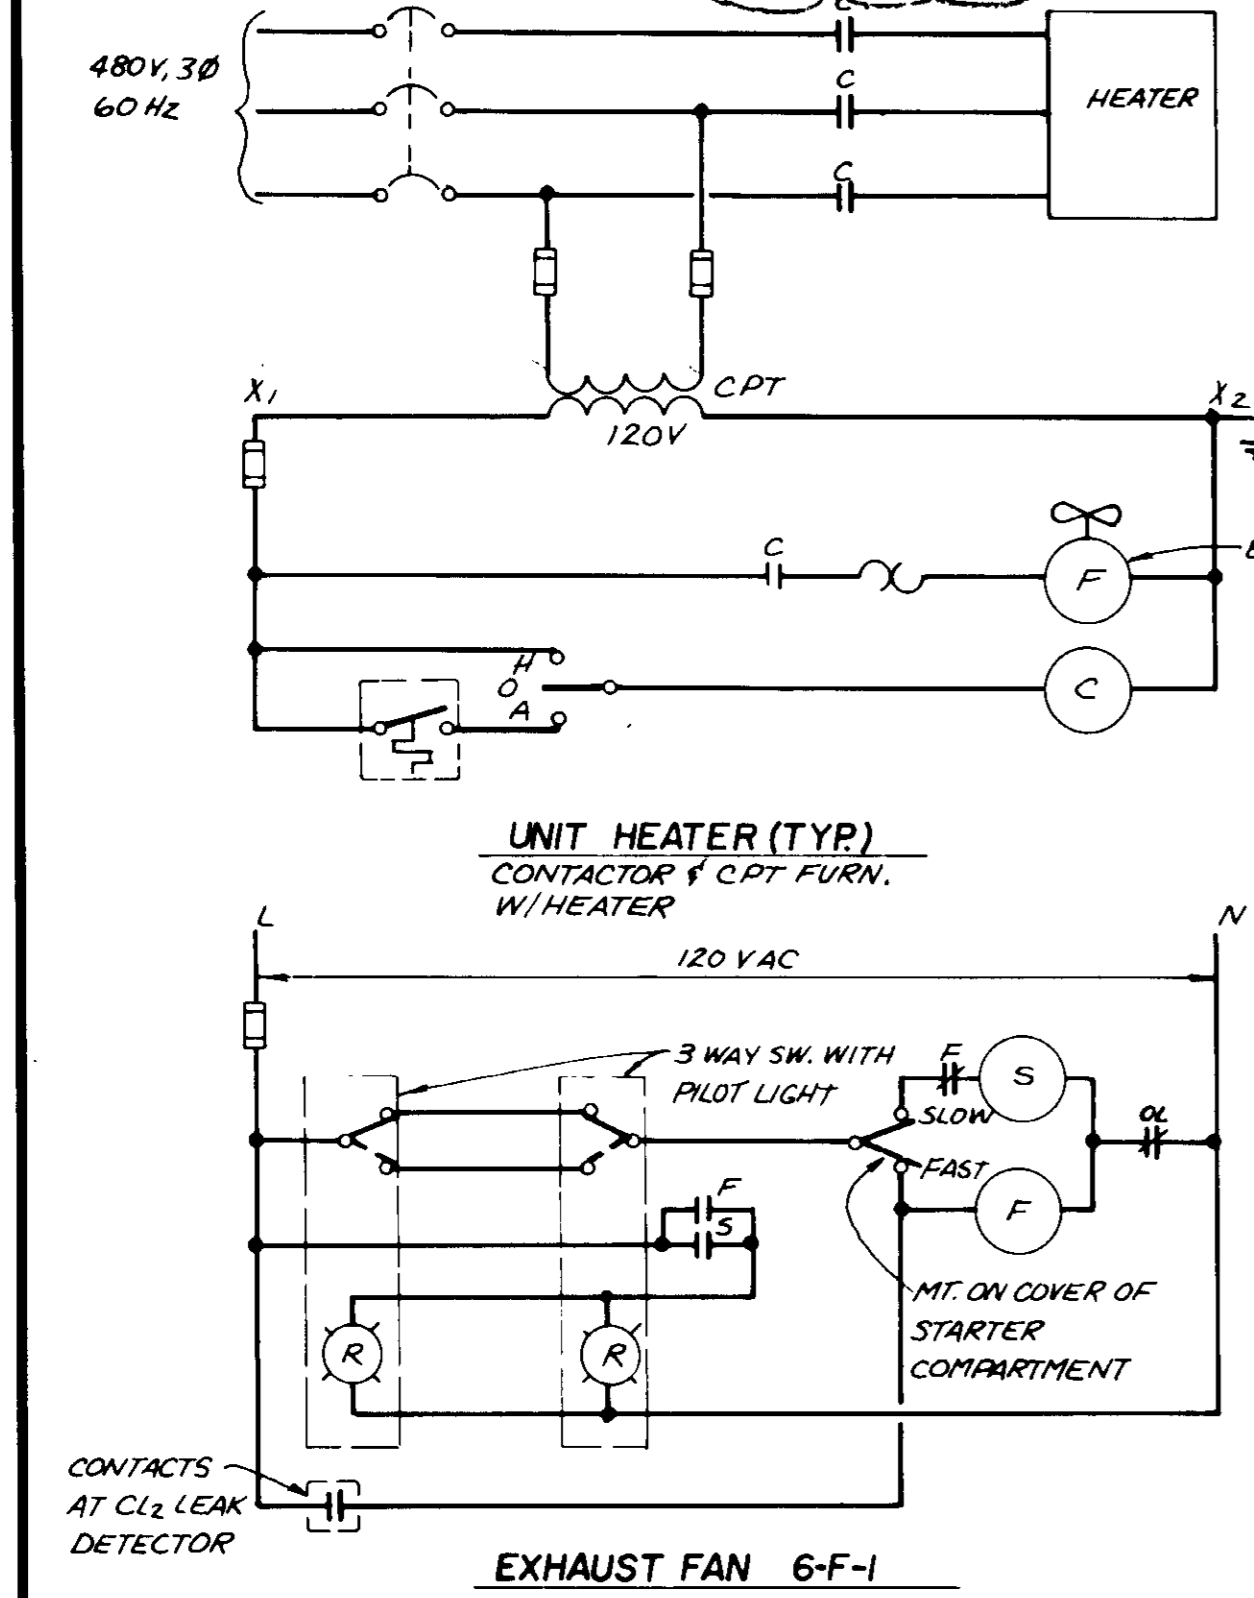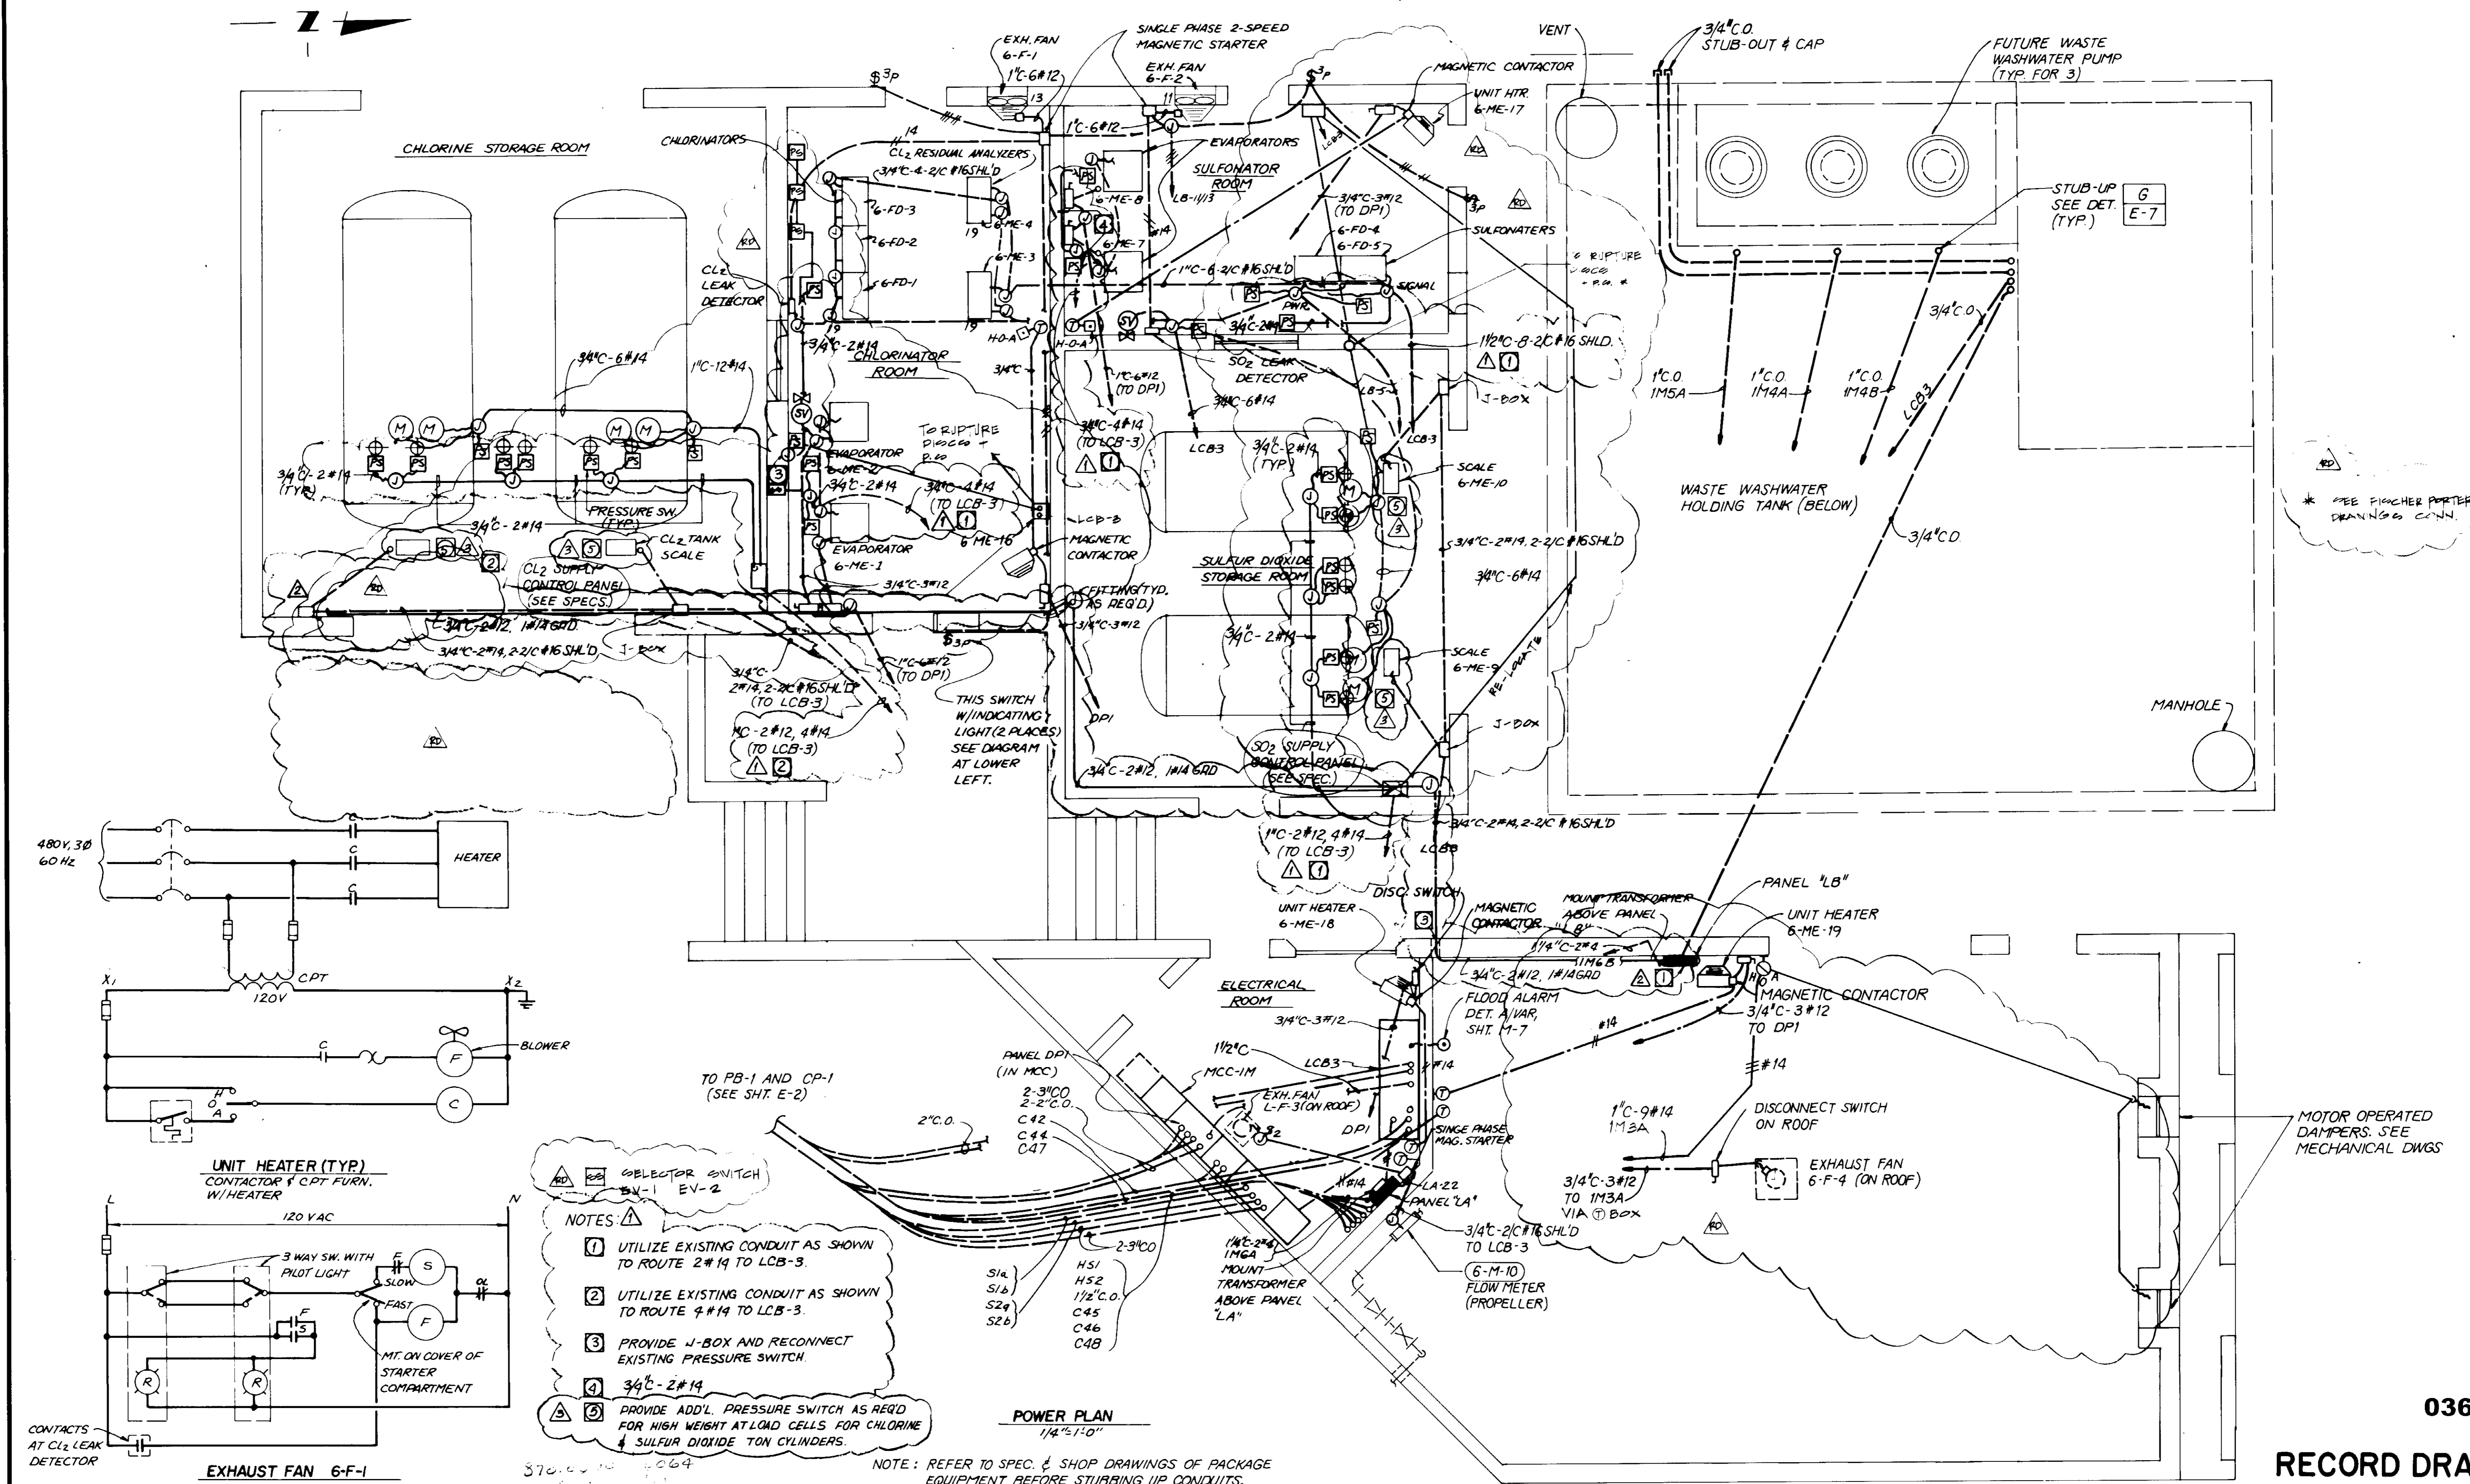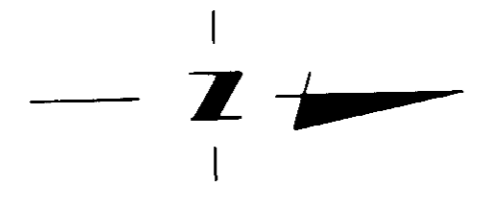

- NOTES**
- UTILIZE EXISTING CONDUIT AS SHOWN TO ROUTE 2#19 TO LCB-3.
 - UTILIZE EXISTING CONDUIT AS SHOWN TO ROUTE 4#19 TO LCB-3.
 - PROVIDE J-BOX AND RECONNECT EXISTING PRESSURE SWITCH.
 - 3/4" - 2#19
 - PROVIDE ADD'L. PRESSURE SWITCH AS REQ'D FOR HIGH WEIGHT AT LOAD CELLS FOR CHLORINE & SULFUR DIOXIDE TON CYLINDERS.

POWER PLAN
1/4" = 1'-0"

NOTE: REFER TO SPEC. & SHOP DRAWINGS OF PACKAGE EQUIPMENT BEFORE STUBBING UP CONDUITS.

* SEE FISHER PORTER DRAWINGS CONT.

03603
RECORD DRAWING

Robert Schneider REE 6373

REV	DATE	BY	DESCRIPTION
2/1/81		RA	PLAN CLARIFICATION
3/1/81		RA	CHANGE ORDER
4/1/81		RA	CHANGE ORDER
4/1/81		MDU	RECORD DRAWINGS
4/1/81		JMH	

DESIGNED	H. RODRIGUEZ	SUBMITTED	27304	3/19/81
DRAWN	M. LASLEY	PROJECT ENGINEER	R.C.E. NO.	DATE
CHECKED	M. SANTOS	RECOMMENDED	27638	2/20/81
		JAMES M. MONTGOMERY CONSULTING ENGINEERS, INC.	R.C.E. NO.	DATE

JAMES M. MONTGOMERY CONSULTING ENGINEERS, INC.
555 EAST WALNUT STREET, PASADENA, CALIFORNIA 91101

DISTRICT APPROVAL ON TITLE PAGE

PHASE II	LAS VIRGENES MWD/TRIUNFO CSD TAPIA WRF - FILTRATION/DISINFECTION ADDITION CHEMICAL BUILDING POWER AND CONTROL PLAN
----------	---

SHEET
6E-2
OF 66 SHEETS

JOB NO. 870.0070 FILE CC 279

INSTRUMENT SYMBOLS

LIT INSTRUMENT OR OTHER COMPONENT TO BE MOUNTED IN FIELD (FOR LOCATIONS, SEE PLANS)

TSL INSTRUMENT OR OTHER COMPONENT TO BE MOUNTED INSIDE MAIN CONTROL BOARD OR OTHER PANEL AS MARKED

FIC INSTRUMENT OR OTHER COMPONENT TO BE MOUNTED ON MCB FRONT PANEL OR OTHER PANEL AS MARKED.

PIR PSH SINGLE INSTRUMENT OR OTHER COMPONENT HAVING MULTIPLE FUNCTIONS.

(Empty Circle) INSTRUMENT OR OTHER COMPONENT TO BE FURNISHED AND INSTALLED BY OTHERS IN THE FUTURE.

F MULTIPLEXER INTERFACE

[] RELATED DEVICE PERFORMS LINEARIZING OR SQUARE ROOT FUNCTION.

[Σ] RELATED DEVICE PERFORMS SUMMATING FUNCTION.

[Relay Symbol] RELAY CONTACT

***** INDICATED COMPONENTS ARE NOT SPECIFIED AS PART OF THE INSTRUMENT PACKAGE.

// PNEUMATIC PRESSURE SIGNAL

- - - - - PULSE FREQUENCY ELECTRIC SIGNAL.

- - - - - ELECTRONIC INSTRUMENT SIGNAL 4-20ma, EXCEPT AS NOTED.

- - - - - HYDRAULIC LINE

- - - - - PROCESS PIPING

~ ~ ~ ~ ~ SONIC SIGNAL

ES ELECTRICAL SUPPLY (115V, 60HZ - EXCEPT AS NOTED)

AS AIR SUPPLY (20 PSIG - EXCEPT AS NOTED)

VALVE ACTUATORS

M ELECTRIC MOTOR

(Cylinder) PNEUMATIC CYLINDER, SINGLE ACTING

(Hand) HAND

S SOLENOID

(Diaphragm) PNEUMATIC DIAPHRAGM SPRING OPPOSED.

FLOW METERS

(Propeller) PROPELLER

(Magnetic) MAGNETIC

(Sonic) SONIC

(Liquid Vortex) LIQUID VORTEX

(Pitot Tube) PITOT TUBE (ANNUBAR)


(Venturi) VENTURI

(Orifice) ORIFICE


(Flume) FLUME

(Weir) WEIR

MECHANICAL EQUIPMENT CALL OUT

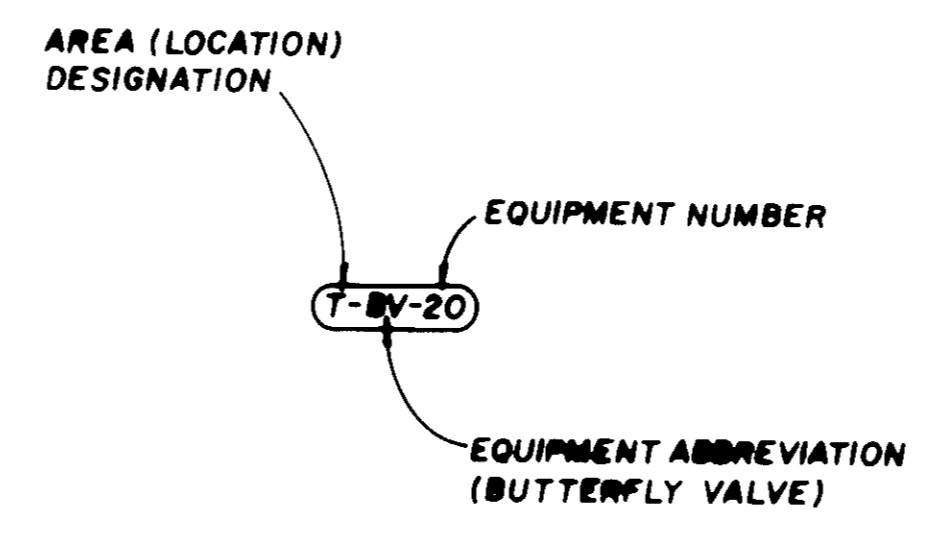

INSTRUMENT TAG NUMBER

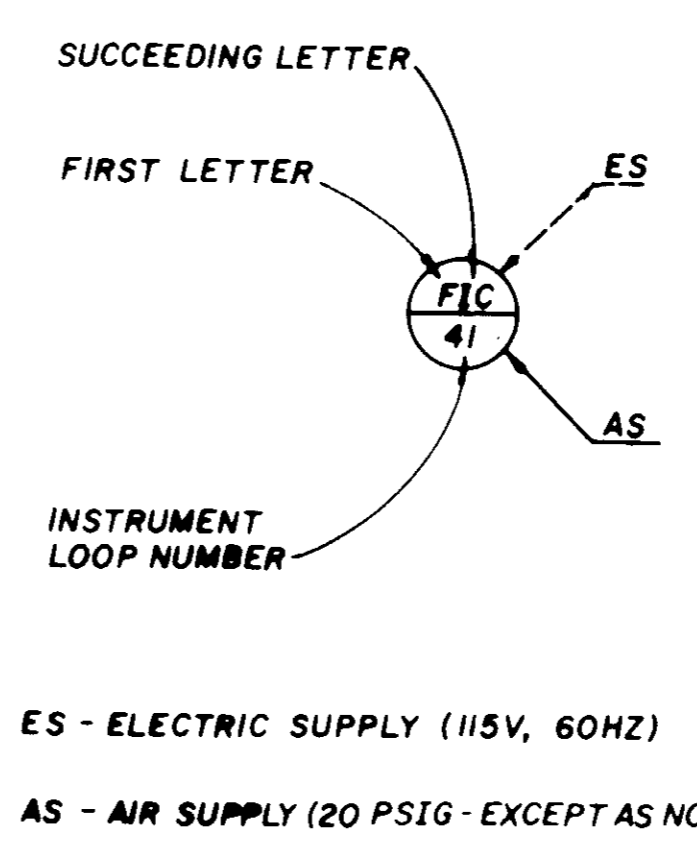


INSTRUMENT IDENTIFICATION TAG LETTERS

LETTER	FIRST LETTER		SUCCEEDING LETTERS		
	MEASURED OR INITIATING VARIABLE	MODIFIER	READOUT OR PASSIVE FUNCTION	OUTPUT FUNCTION	MODIFIER
A	ANALYSIS		ALARM		
B	BURNER FLAME		USER'S CHOICE	USER'S CHOICE	USER'S CHOICE
C	CONDUCTIVITY (ELECTRICAL)			CONTROL	
D	DENSITY (MASS) OR SPECIFIC GRAVITY	DIFFERENTIAL			
E	VOLTAGE (EMF)		PRIMARY ELEMENT		
F	FLOW RATE	RATIO			
G	GAGING (DIMENSIONAL)		GLASS		
H	HAND (MANUALLY INITIATED)				HIGH
I	CURRENT (ELECTRICAL)		INDICATE		
J	POWER	SCAN			
K	TIME OR TIME SCHEDULE			CONTROL STATION	
L	LEVEL		LIGHT (PILOT)		LOW MIDDLE OR INTERMEDIATE
M	MOISTURE OR HUMIDITY				
N	TORQUE		ISOLATOR		
O	USER'S CHOICE		ORIFICE (RESTRICTION)		
P	PRESSURE OR VACUUM		POINT (TEST CONNECTION)		
Q	QUANTITY OR EVENT	INTEGRATE OR TOTALIZER			
R	RADIOACTIVITY		RECORD OR PRINT		
S	SPEED OR FREQUENCY	SAFETY		SWITCH	
T	TEMPERATURE			TRANSMIT	
U	MULTIVARIABLE		MULTIFUNCTION	MULTIFUNCTION	MULTIFUNCTION
V	VISCOSITY			VALVE, DAMPER, OR LOUVER	
W	WEIGHT OR FORCE		WELL		
X	UNCLASSIFIED		UNCLASSIFIED	TRANSDUCER OR CONVERTER	UNCLASSIFIED
Y	USER'S CHOICE			RELAY OR COMPUTE	
Z	POSITION			DRIVE, ACTUATE OR UNCLASSIFIED FINAL CONTROL ELEMENT	

DO DISSOLVED OXYGEN LCB LOCAL CONTROL BOARD
 pH HYDROGEN CONCENTRATION
 SS SUSPENDED SOLIDS
 TOC TOTAL ORGANIC CARBON
 Tu TURBIDITY
 CL CHLORINE

NOTES

- ADDITIONAL INSTRUMENTATION AND CONTROL SYMBOLS MAY BE USED AS REQUIRED. SYMBOLS AND NOMENCLATURE ARE BASED ON ISA STANDARD S5.1 (1975).
- SEE ASSOCIATED ELECTRICAL AND MECHANICAL SYMBOL SHEETS FOR ADDITIONAL SYMBOLS AND ABBREVIATIONS.
- FOR PIPE SIZES, MATERIAL, AS WELL AS DETAILS OF METER COUPLING AND OTHER MECHANICAL EQUIPMENT (e.g. VALVES, PUMPS, ETC.) SEE MECHANICAL DRAWINGS AND SPECIFICATIONS.

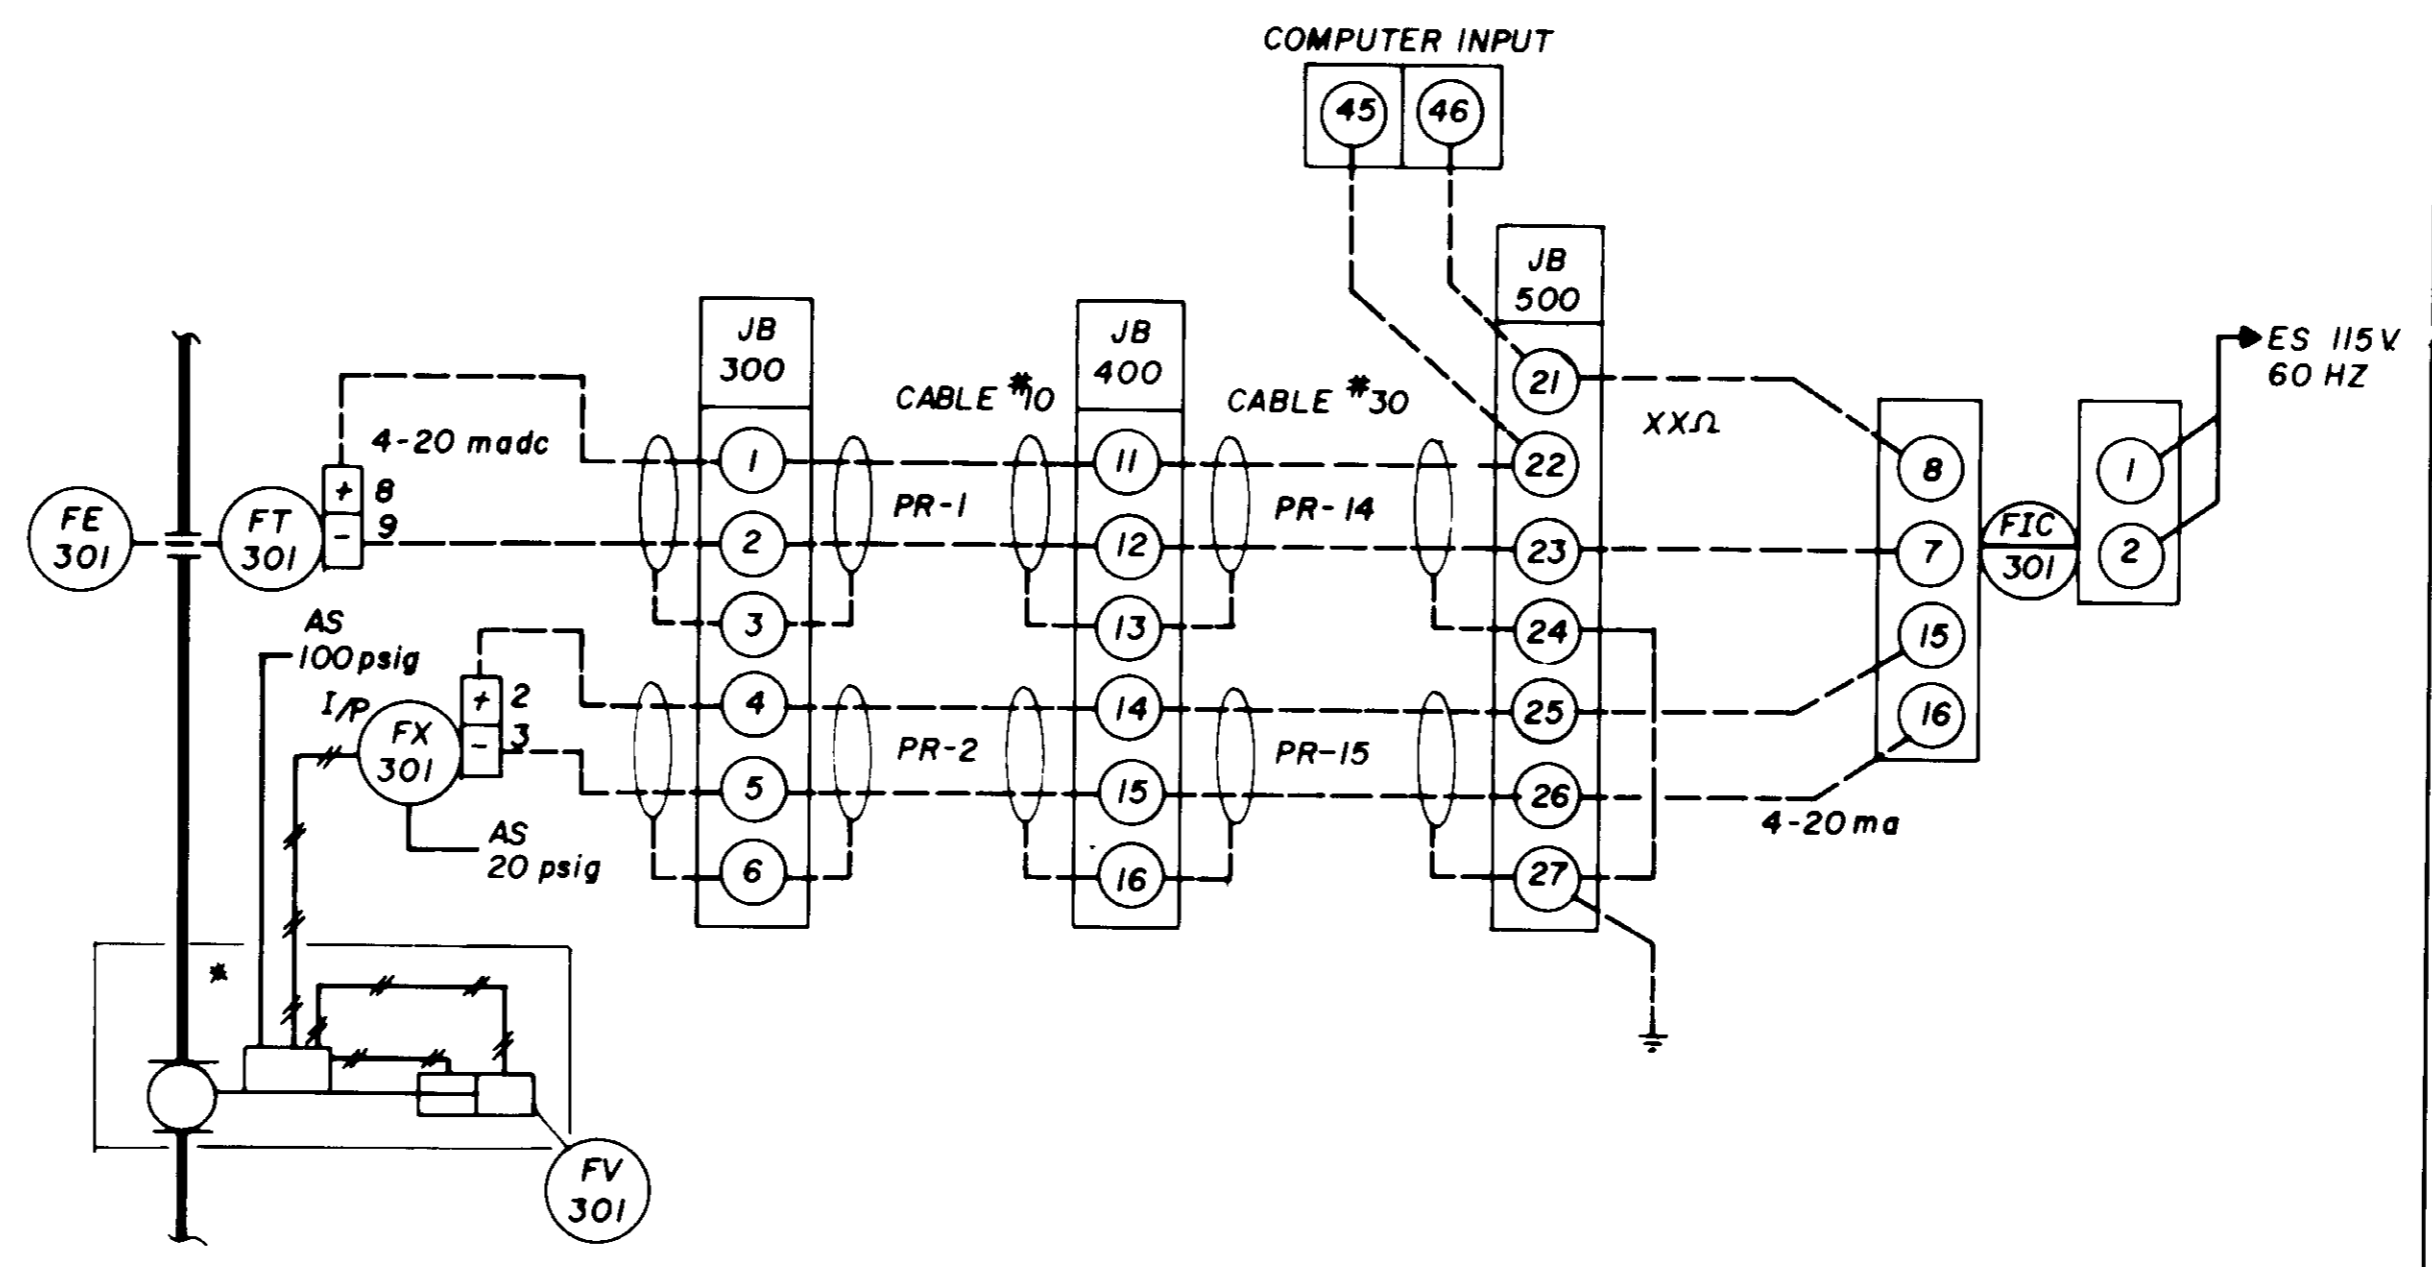

SAMPLE LOOP DIAGRAM - MINIMUM REQUIRED
(BASED ON ISA STANDARD S5.4)

NOTE: SEE SPECIFICATION DIVISION 403 FOR DETAILS OF SHOP DRAWING SUBMITTAL REQUIREMENTS.

03604


RECORD DRAWING

Horbert Schneider REE 6373


JOB NO. FILE CC 37

<p>SCALE: NONE</p>		<p>DESIGNED: <i>D. Barbier</i></p> <p>DRAWN: <i>D. Barbier</i></p> <p>CHECKED: <i>[Signature]</i></p>	<p>SUBMITTED: <i>[Signature]</i></p> <p>PROJECT ENGINEER: <i>[Signature]</i> 27304 R.C.E. NO. 8/19/31 DATE</p> <p>RECOMMENDED: <i>[Signature]</i></p> <p>JAMES M. MONTGOMERY CONSULTING ENGINEERS, INC. 27638 R.C.E. NO. 8/20/31 DATE</p>	<p>JAMES M. MONTGOMERY CONSULTING ENGINEERS, INC.</p> <p>555 EAST WALNUT STREET, PASADENA, CALIFORNIA 91101</p>	<p>DISTRICT APPROVAL ON TITLE PAGE</p>	<p>LAS VIRGENES MWD/TRIUNFO CSD</p> <p>TAPIA WRF - FILTRATION/DISINFECTION ADDITION</p> <p>PHASE II</p> <p>SYMBOLS AND SYMBOL NOMENCLATURE</p>	<p>SHEET I-1</p> <p>OF 66 SHEETS</p>
--------------------	--	---	---	--	--	--	--------------------------------------


JOB NO. 870.0070 FILE CC 7/79

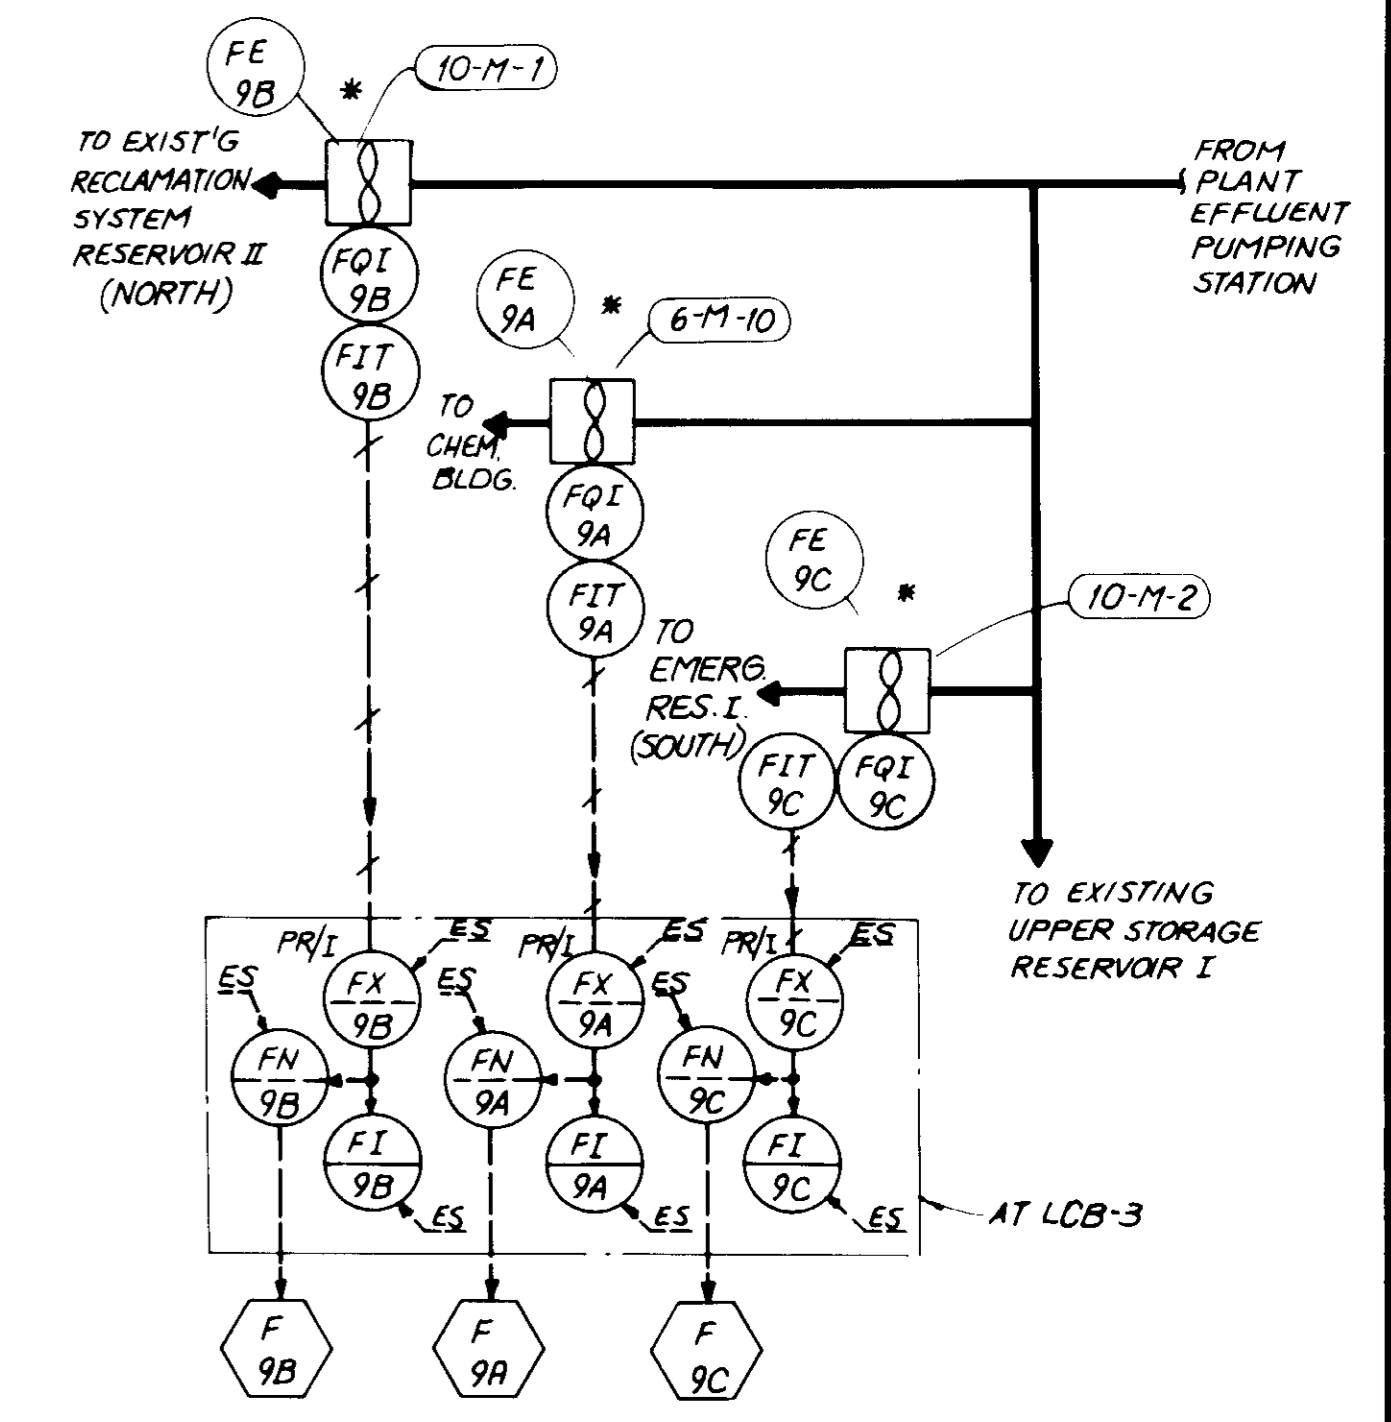


UTILITY WATER FLOW MEASUREMENTS
(LOOPS F-9A, F-9B AND F-9C)

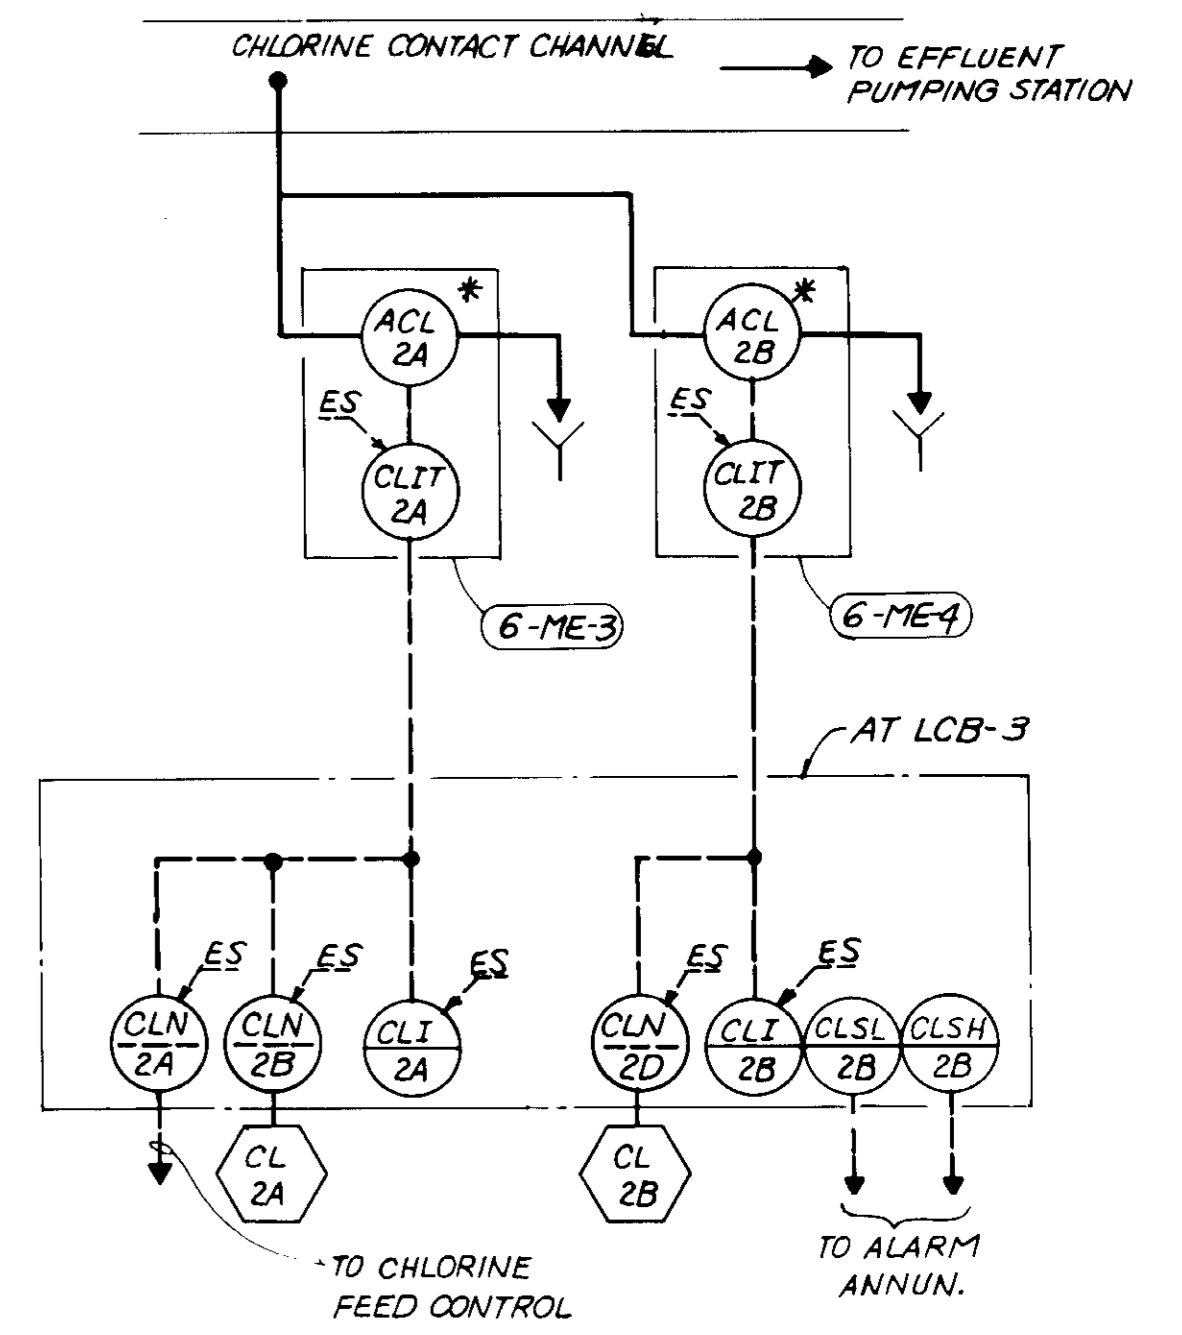

CHLORINE CONTACT CHANNEL TOTAL AND FREE
CHLORINE RESIDUAL ANALYSES
(LOOPS 2A AND 2B)

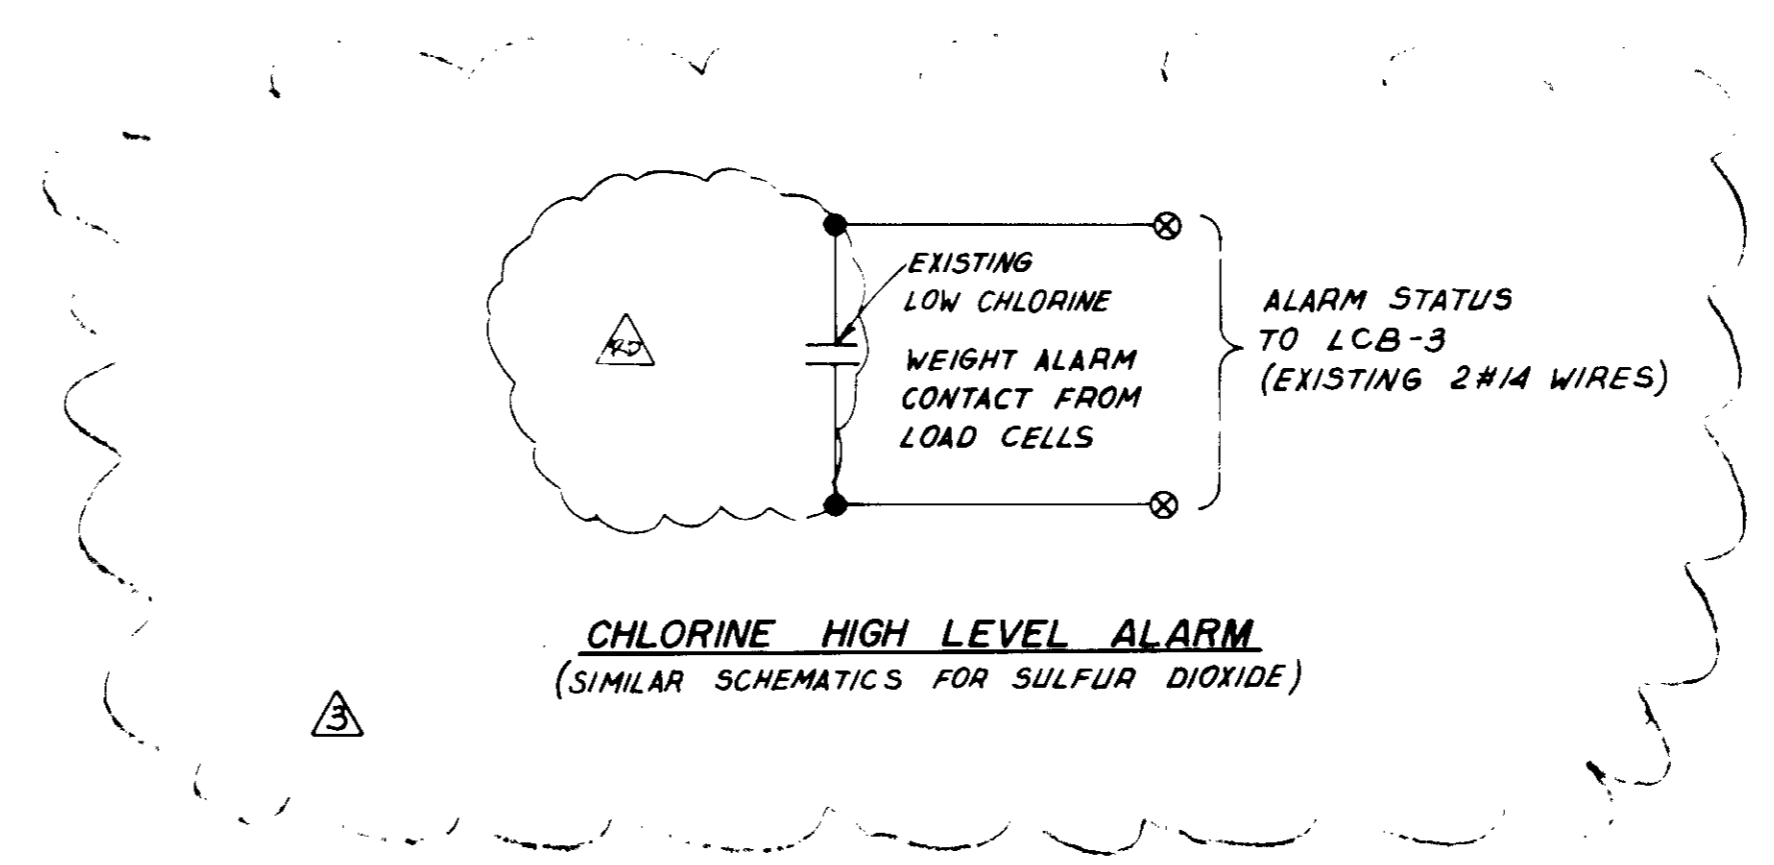

CHLORINE HIGH LEVEL ALARM
(SIMILAR SCHEMATICS FOR SULFUR DIOXIDE)

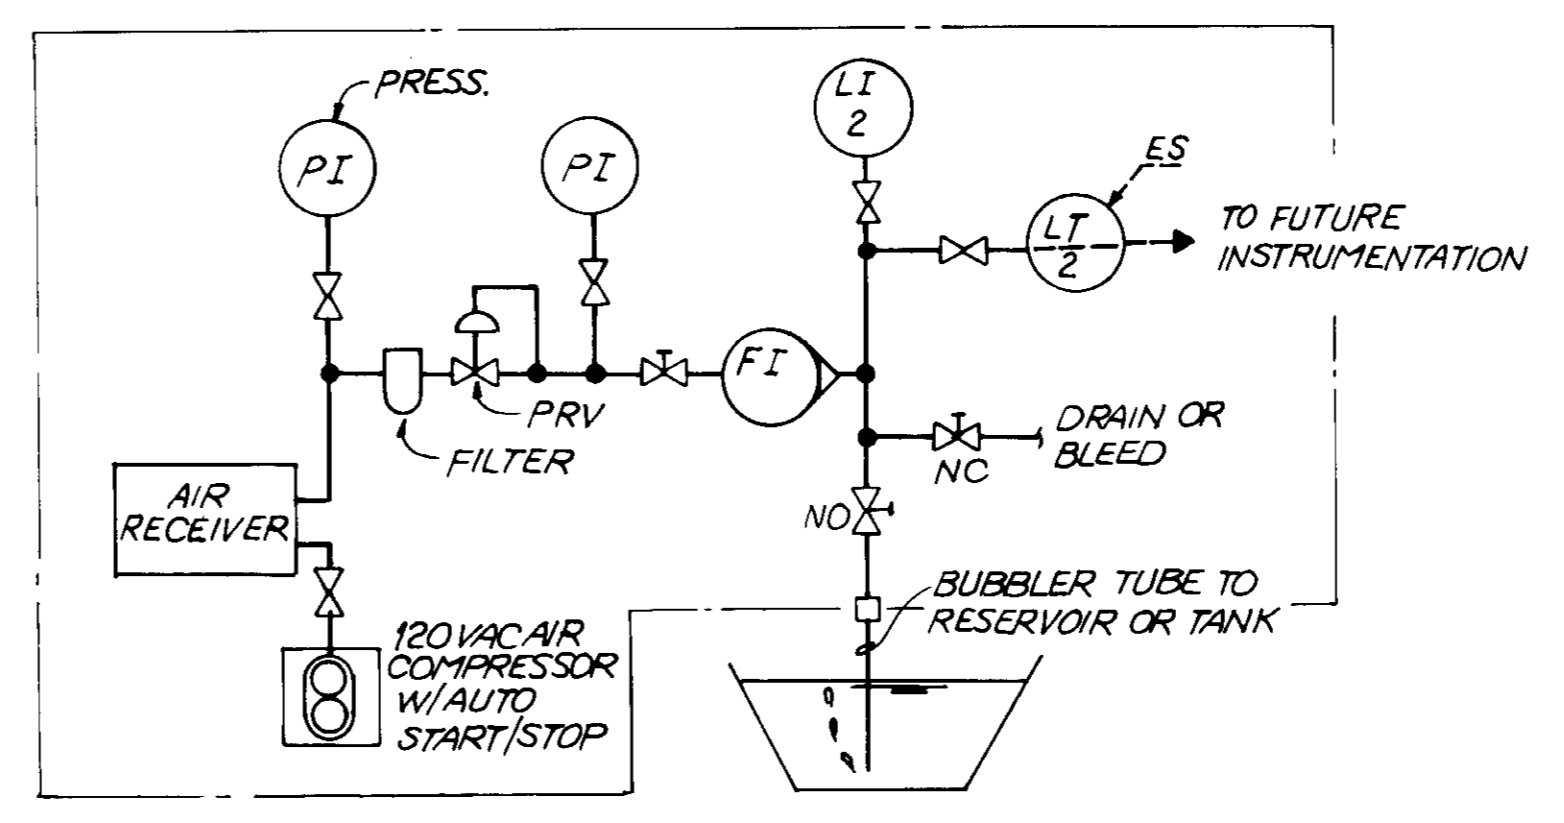

BALANCING POND LEVEL MEASUREMENT
(LOOP L-2)

03605


RECORD DRAWING

Robert Schneider

REE 6373

RD 64664 JMH RECORD DRAWING CHANGE ORDER 6-15-83			SCALE: NONE	DESIGNED: <i>M. Barber</i> DRAWN: D. BARBIER CHECKED: <i>L. Gomez</i>	SUBMITTED: <i>Robert C. Simons</i> PROJECT ENGINEER RECOMMENDED BY: <i>G. J. M.</i> JAMES M. MONTGOMERY CONSULTING ENGINEERS, INC.	27304 8/10/81 R.C.E. NO. DATE 27638 3/20/81 R.C.E. NO. DATE	JAMES M. MONTGOMERY CONSULTING ENGINEERS, INC. 555 EAST WALNUT STREET, PASADENA, CALIFORNIA 91101	DISTRICT APPROVAL ON TITLE PAGE	LAS VIRGENES MWD/TRIUNFO CSD TAPIA WRF - FILTRATION/DISINFECTION ADDITION PHASE II INSTRUMENTATION LOOP DIAGRAMS	SHEET I-2 OF 66 SHEETS
--	--	--	-------------	---	---	--	--	---------------------------------	--	---------------------------


ANNUNCIATOR SCHEDULE			
NO.	WINDOW ENGRAVING	FIELD ACTUATING DEVICE	LOCATION
A-1	(BLANK)		
** 2	SULFUR DIOXIDE / LEAK	6-ME-14	CHEMICAL BLDG.
** 3	CHLORINE / LEAK	6-ME-15	
** 4	SULFUR DIOXIDE / RUPTURE DISK	SO ₂ FEED LINE	
** 5	CHLORINE / RUPTURE DISK	CL ₂ FEED LINE	
** 6	CONTACT CHANNEL / CHLORINE RESIDUAL / HIGH	CLSH-2B	
** 7	CHLORINE FEED SYSTEM / MALFUNCTION	6-FD-2 & 3	
** 8	SULFUR DIOXIDE FEED SYSTEM / MALFUNCTION	6-FD-4 & 5	
B-1	CHEMICAL BUILDING / FLOODING	SUMP LEVEL SW.	
** 2	CHLORINE SUPPLY / LOW / HIGH	6-T-1 & 2	
** 3	SULFUR DIOXIDE SUPPLY / LOW / HIGH	6-T-3 & 4	
4	(BLANK)		
5	(BLANK)		
** 6	CONTACT CHANNEL / CHLORINE RESIDUAL / LOW	CLSH-2B	
** 7	SO ₂ EVAPORATOR / MALFUNCTION	GME-7 & 8	
** 8	CL ₂ EVAPORATOR / MALFUNCTION	6-ME-1 & 2	

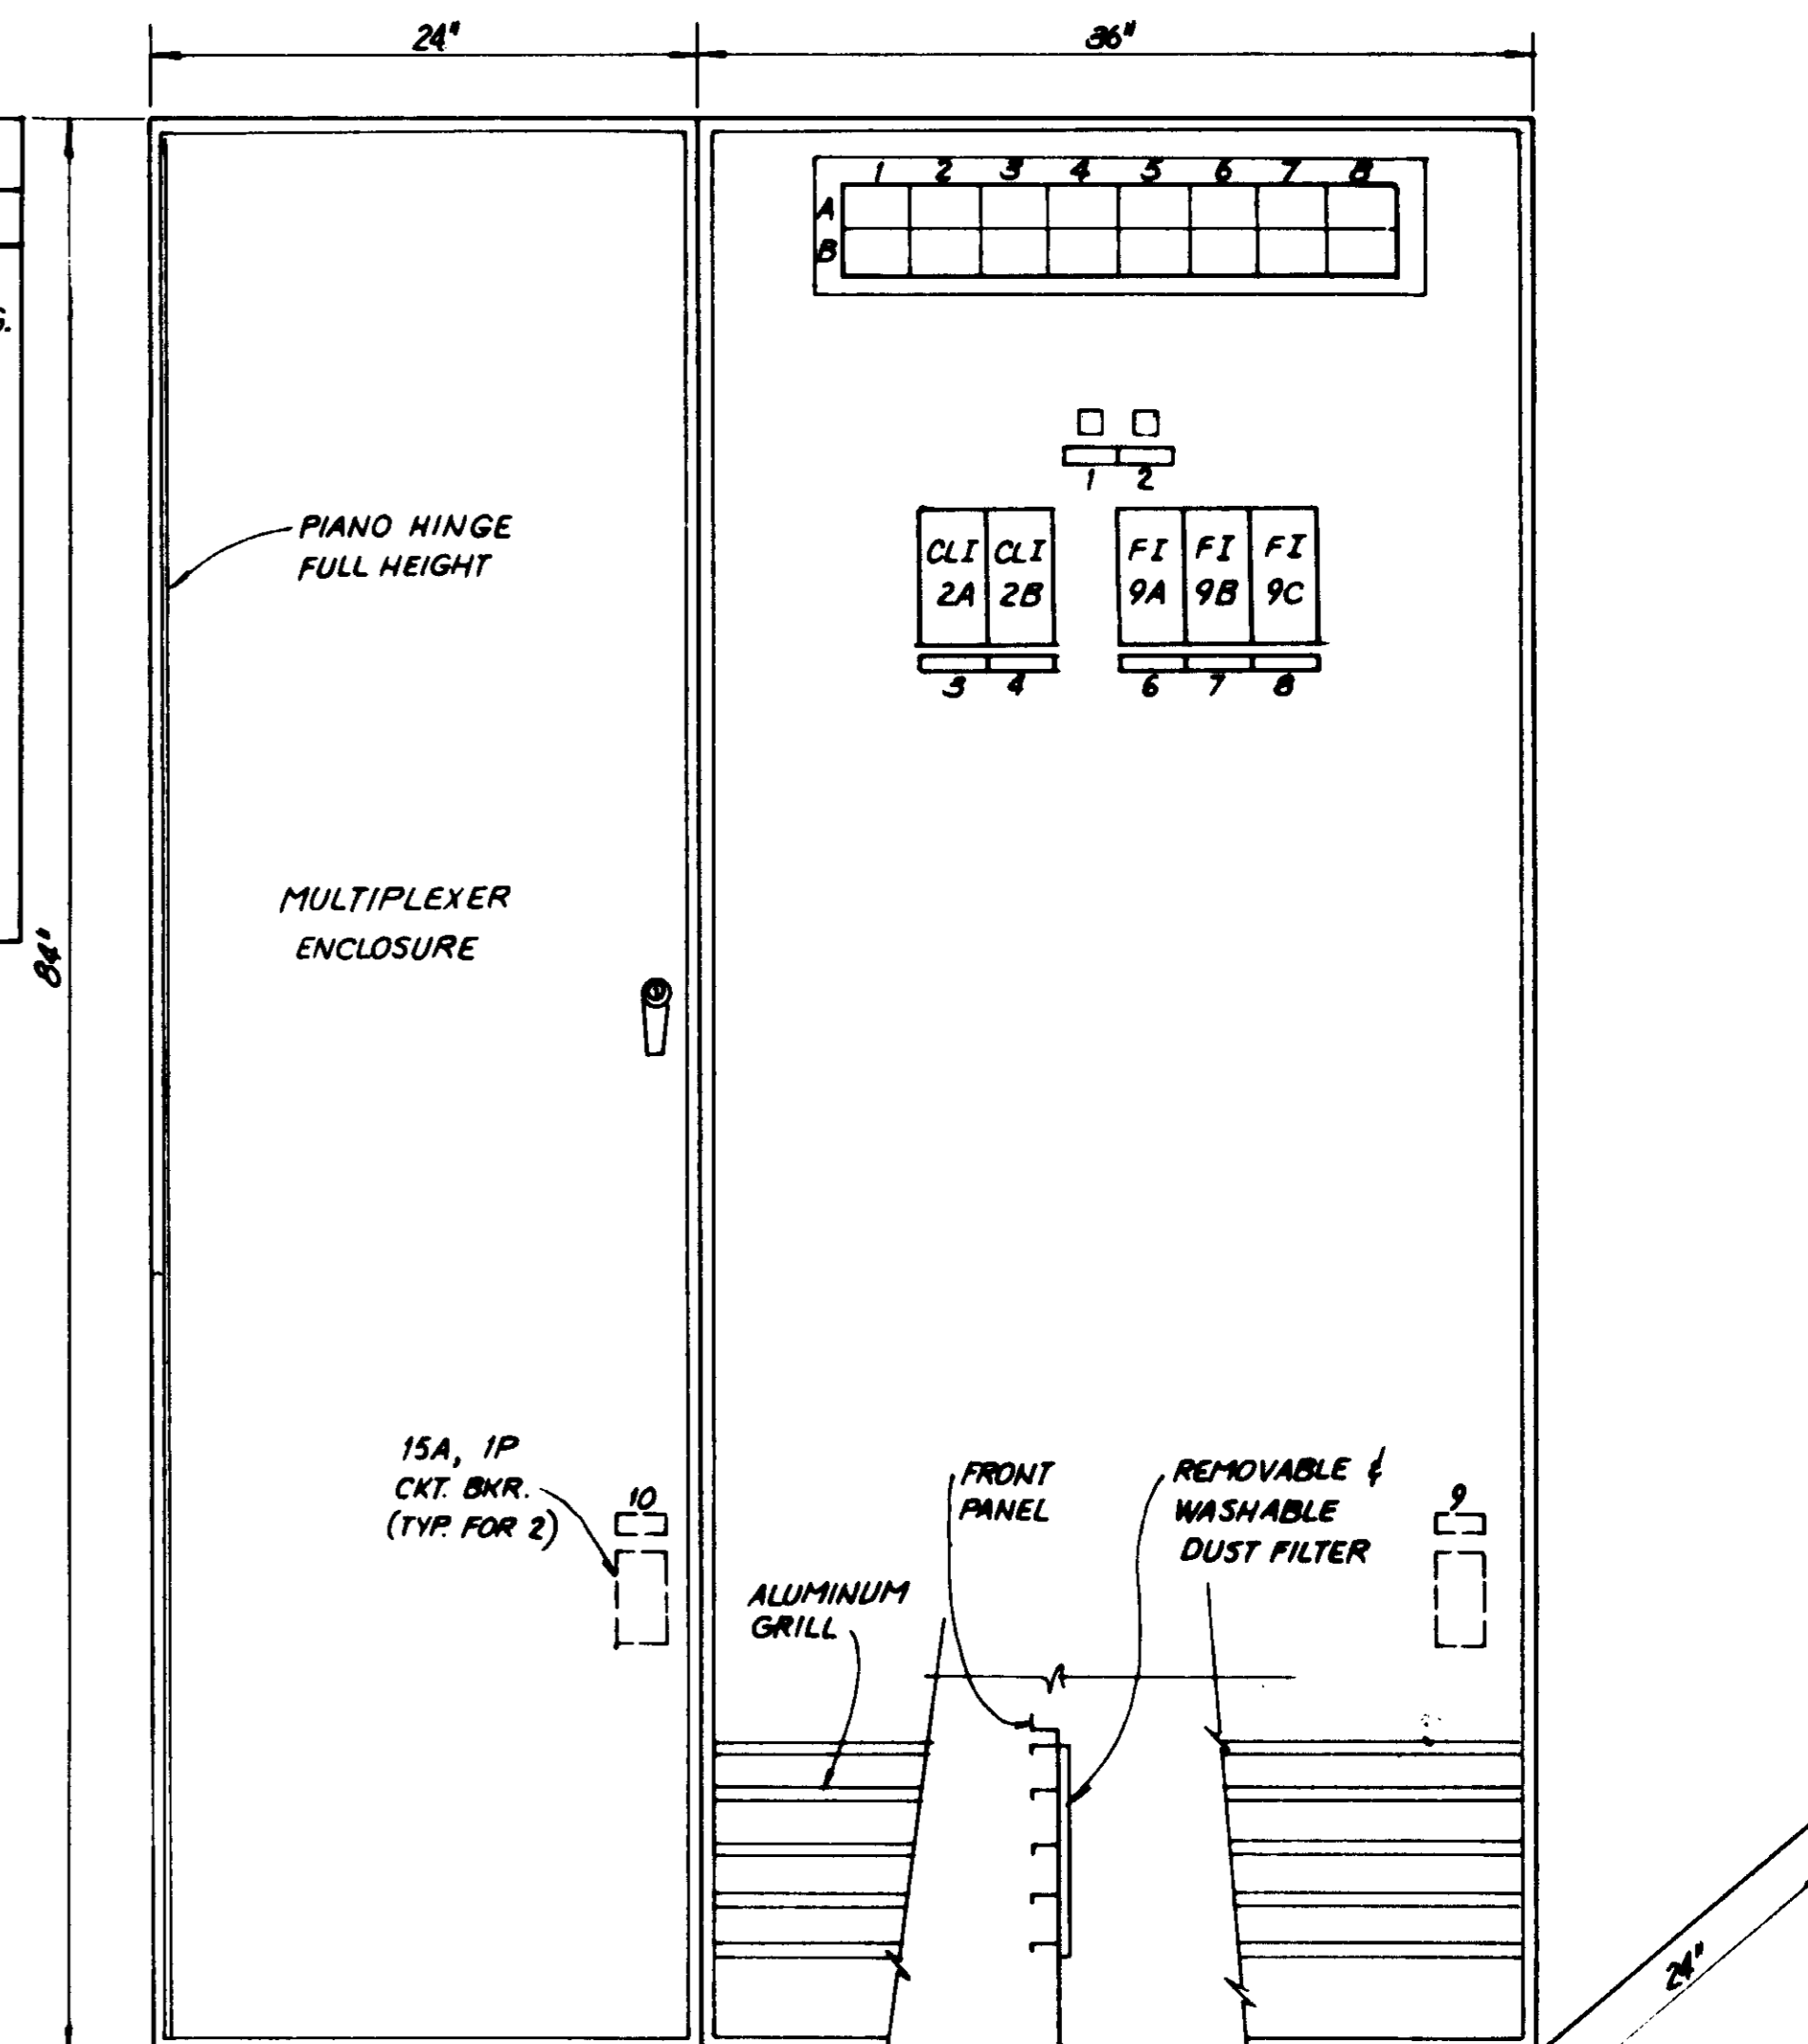

LOCAL CONTROL BOARD (LCB-3) - ELEVATION

NOTES

- ALL SINGLE OR DUAL-FUNCTION CONTROL DEVICES SHALL BE RECTANGULAR PUSHBUTTON OPERATORS ENGRAVED IN WHITE LETTERS ON A BLACK BACKGROUND.
- SLASH "/" ON NAMEPLATE INSCRIPTIONS AND ANNUNCIATOR WINDOW ENGRAVINGS MEANS START A NEW LINE. SUPPLIER SHALL SUBMIT LETTER SIZE AND LINE THICKNESS FOR APPROVAL BY THE ENGINEER.
- ASTERISKS (**) ADJACENT TO ANNUNCIATOR POINT INDICATES RETRANSMISSION REQUIRED. EACH POINT SHALL BE EQUIPPED WITH DUPLICATE RETRANSMITTING ALARM CONTACTS TO THE MULTIPLEXER EQUIPMENT FURNISHED BY OTHERS.
- ADDITIONAL ENGRAVED LETTERS FOR WINDOWS B-2 AND B-3.

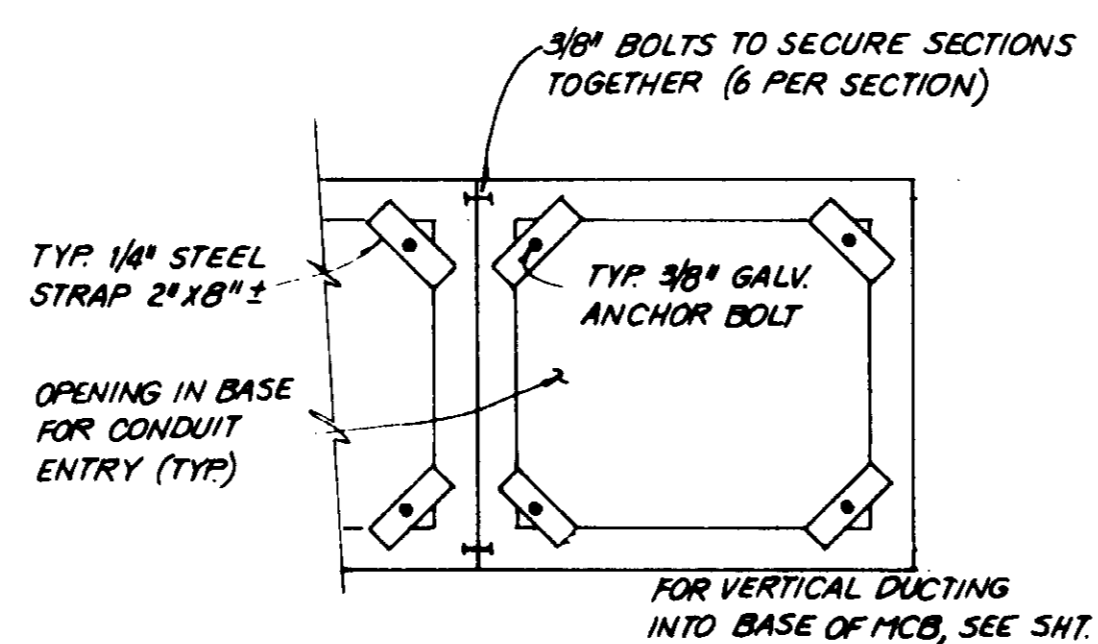

PARTIAL BASE ANCHORING PLAN NTS

NAMEPLATE SCHEDULE	
NO.	DESCRIPTION
1	ALARM TEST
2	ALARM ACKNOWLEDGE
3	CONTACT CHANNEL / TOTAL / CHLORINE RESIDUAL-MG/L
4	CONTACT CHANNEL / FREE / CHLORINE RESIDUAL-MG/L
5	NOT USED
6	UTILITY WATER / FLOW RATE - GPM / CHEMICAL BUILDING
7	UTILITY WATER / FLOW RATE - GPM / NORTH
8	UTILITY WATER / FLOW RATE - GPM / SOUTH
9	LCB-3 / CONTROL POWER
10	MULTIPLEX / CONTROL POWER

03606

RECORD DRAWING

Robert Schneider

REE 6373

SCALE: AS NOTED DESIGNED: <i>M. J. Barber</i> DRAWN: <i>D. BARBIER</i> CHECKED: <i>L. J. Barber</i>		SUBMITTED: <i>Robert C. Simsek</i> PROJECT ENGINEER: <i>Robert C. Simsek</i> RECD. MONTGOMERY JAMES M. MONTGOMERY CONSULTING ENGINEERS, INC.		27304 R.C.E. NO. 8/12/01 DATE		DISTRICT APPROVAL ON TITLE PAGE		LAS VIRGENES MWD/TRIUNFO CSD TAPIA WRF - FILTRATION/DISINFECTION ADDITION PHASE II LOCAL CONTROL BOARD (LCB-3) - ELEVATIONS & DETAILS		SHEET I-3 OF 66 SHEETS	
--	--	---	--	--	--	---------------------------------	--	---	--	-------------------------------------	--

JAMES M. MONTGOMERY CONSULTING ENGINEERS, INC.

555 EAST WALNUT STREET, PASADENA, CALIFORNIA 91101

870.0070 FILE DC 279