









**GENERAL PIPING NOTES**

- INFORMATION PROVIDED ON THIS SHEET ARE MINIMUM REQUIREMENTS. REFER TO THE SPECIFICATIONS FOR ADDITIONAL REQUIREMENTS.
- LAY PIPE TO UNIFORM GRADE BETWEEN INDICATED ELEVATION POINTS. MINIMUM COVER SHALL BE 3'-0" UNLESS OTHERWISE SHOWN.
- SIZE OF FITTINGS SHOWN ON DRAWINGS SHALL CORRESPOND TO ADJACENT STRAIGHT RUN OF PIPE, UNLESS OTHERWISE INDICATED. TYPE OF JOINT AND FITTING MATERIAL SHALL BE THE SAME AS SHOWN FOR ADJACENT STRAIGHT RUN OF PIPE.
- NUMBER OF PIPE HANGERS AND PIPE SUPPORTS SHOWN IS ONLY APPROXIMATE. FINAL SUPPORT REQUIREMENTS SHALL BE DETERMINED IN THE FIELD AND APPROVED BY THE ENGINEER PRIOR TO INSTALLATION. MAXIMUM SPACING SHALL BE SPECIFIED.
- APPROPRIATE STANDARD WALL PIPE DETAIL SHALL BE USED WHEREVER PIPING PASSES FROM A STRUCTURE TO BACKFILL.
- ALL FLEXIBLE CONNECTORS OR FLANGED COUPLING ADAPTERS SHALL BE PROVIDED WITH THRUST TIES, BLOCKS, OR ANCHORS, UNLESS OTHERWISE NOTED. THRUST PROTECTION SHALL BE ADEQUATE FOR TEST PRESSURES SPECIFIED.
- SYMBOLS, LEGENDS, AND PIPE IDENTIFICATIONS SHOWN SHALL BE FOLLOWED THROUGHOUT THE DRAWINGS. ALL OF THE ITEMS SHOWN ARE NOT NECESSARILY USED IN THE PROJECT.
- ALL PIPING WITH UNRESTRAINED JOINTS, SHALL BE PROVIDED WITH THRUST PROTECTION AT ALL DIRECTION CHANGES, UNLESS OTHERWISE NOTED. SEE THRUST DETAILS AND NOTES ON DRAWINGS.
- NUMBER AND LOCATION OF UNIONS SHOWN ON DRAWINGS ARE ONLY APPROXIMATE. PROVIDE ALL UNIONS NECESSARY TO FACILITATE CONVENIENT REMOVAL OF VALVES AND MECHANICAL EQUIPMENT.
- THE CONTRACTOR IS RESPONSIBLE FOR COORDINATING AND PERFORMING THE CONNECTION OF THE PIPING AND ASSOCIATED APPURTENANCES INSTALLED UNDER THIS CONTRACT TO THE EXISTING PIPING AND FACILITIES, AND TO THE WORK OF OTHER CONTRACTORS.
- PRIOR TO SUBMITTING PIPING DRAWINGS FOR ANY NEW PIPE THAT IS TO CONNECT TO AN EXISTING PIPE OR STRUCTURE, THE CONTRACTOR SHALL EXPOSE THE EXISTING PIPE OR STRUCTURE TO VERIFY ITS EXACT LOCATION, SIZE, MATERIALS, AND INVERT ELEVATIONS.
- ALL PIPING IS TO BE PAINTED AND LABELED UNLESS NOTED OTHERWISE. LABELING SHALL INCLUDE FLOW DIRECTION ARROW AND PIPE USE.
- ALL PIPING UNDER STRUCTURES TO BE CONCRETE ENCASED UNLESS NOTED OTHERWISE.

**PIPING DESIGNATION**

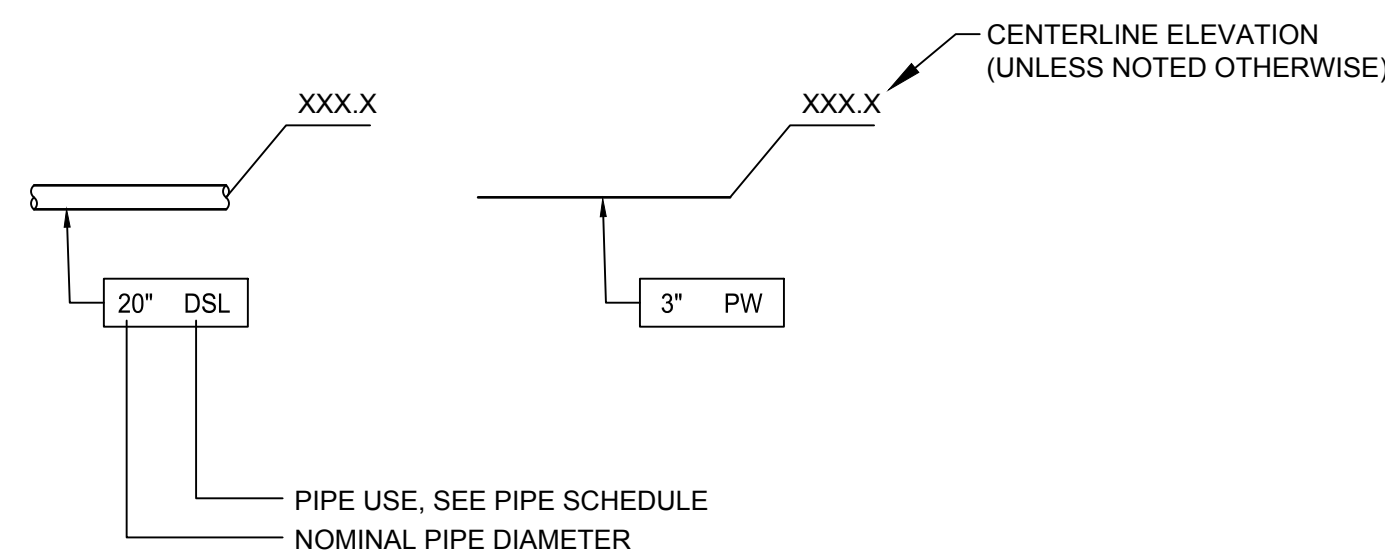

**VALVE DESIGNATION**

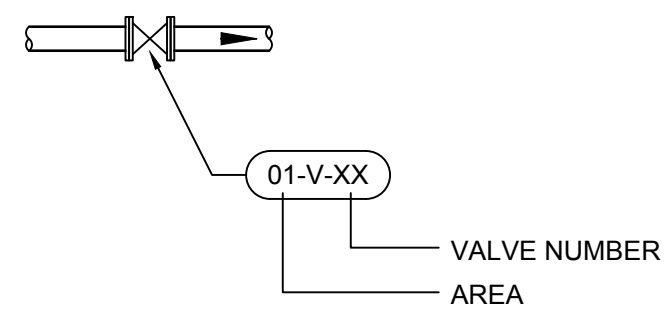

**PIPE SYMBOLS**

DESCRIPTION	SINGLE LINE	DOUBLE LINE
EXISTING PIPE		
NEW PIPE		
PIPE TO BE REMOVED		
FLANGED, WELD NECK		
FLANGED, SLIP ON		
SCREWED OR SOCKET WELD		
BELL & SPIGOT		
MECHANICAL JOINT		
ELBOW - STRAIGHT		
ELBOW - REDUCING		
ELBOW - DOWN		
ELBOW - UP		
CROSS		
REDUCER		
TEE		
TEE - DOWN		
TEE - UP		
UNION		
FLEXIBLE RUBBER CONNECTOR		
FLEXIBLE HOSE CONNECTOR		
FLANGED COUPLING ADAPTER		
FLEXIBLE COUPLING		
DISASSEMBLING JOINT		
FLOOR DRAIN		
CLEAN OUT		

**PIPE SUPPORT DESIGNATION**

**VALVE SYMBOLS**

DESCRIPTION	SINGLE LINE	DOUBLE LINE (PLAN)	DOUBLE LINE (ELEVATION)
GATE VALVE			
KNIFE GATE VALVE			
GLOBE VALVE			
PLUG VALVE			
SWING CHECK VALVE			
LIFT CHECK VALVE			
BUTTERFLY (FLANGED)			
BUTTERFLY (WAFER)			
BALL VALVE			
DIAPHRAGM VALVE			
CAPILLARY CONTROL VALVE			
CONTROL VALVE			
PRESSURE RELIEF VALVE (ELEVATION)			
PRESSURE RELIEF VALVE (PLAN)			
HOSE BIBB			

**ACTUATOR SYMBOLS**

MOTOR	
SOLENOID	
PNEUMATIC	

**FLOWMETER SYMBOLS**

DESCRIPTION	SINGLE LINE	DOUBLE LINE
MAGMETER		
TURBINE METER		
VENTURI METER		

**PIPE SCHEDULE**

ID	DESCRIPTION	SIZE	SERVICE	MATERIAL	VALVE SYSTEM***
PW	PLANT WATER	ALL	ALL	CPVC SCH 80	A
D	DRAIN	ALL	ALL	CI	A
SD	STORM DRAIN	ALL	ALL	CISP	N/A
SG	DIGESTER GAS	ALL	ALL	SS	F
SS	SANITARY SEWER	ALL	ALL	CISP	N/A
DSL	DIGESTED SLUDGE	<8"	ALL	DICML	B
		>8"	ALL	WSCML	B
HWR	HOT WATER RETURN	ALL	ALL	BS **	K
HWS	HOT WATER SUPPLY	ALL	ALL	BS **	K
NPW	PROCESS WATER (NON-POTABLE)	ALL	ALL	CPVC SCH 80	A
REW	RECLAIMED WATER	ALL	ALL	BS	A
RSL	RAW SLUDGE	ALL	ALL	DIGL	B

\*\* INSULATED PER SECTION 15050  
\*\*\* PER SECTION 15050

**SERVICE LEGEND**

B = BURIED  
E = EXPOSED  
C = CONCRETE ENCASED

**VALVES AND ACCESSORIES**

AIRVAC	AIR AND VACUUM VALVE
ARV	AIR RELEASE VALVE
BCV	BALL CHECK VALVE
BFV	BUTTERFLY VALVE
BV	BALL VALVE
CO	CLEANOUT
CV	CHECK VALVE
GLV	GLOBE VALVE
GV	GATE VALVE
HB	HOSE BIBB
MV	MUD VALVE
PDV	PLUG DRAIN VALVE
PINV	PINCH VALVE
PRFV	PRESSURE RELIEF VALVE
PRV	PRESSURE REDUCING VALVE
PV	PLUG VALVE
SG	SLUICE GATE
SV	SOLENOID VALVE
TCV	TWIN ELEMENT CHECK VALVE

**PIPE LININGS, COATINGS**

CMC	CEMENT MORTAR COATED
CML	CEMENT MORTAR LINED
CML&C	CEMENT MORTAR LINED & COATED
EC	EPOXY COATED
EL	EPOXY LINED
EL&C	EPOXY LINED & COATED
GL	GLASS LINED
IC	INSULATION COATED
PC	PLASTIC COATED

**PIPE JOINTS**

BC	BOLT-ON COUPLING
DRG	DOUBLE RUBBER GASKET JOINT
FC	FLEXIBLE COUPLING
FCA	FLANGED COUPLING ADAPTER
GC	GROOVED COUPLING
MJ	MECHANICAL JOINT
SRG	SINGLE RUBBER GASKET JOINT
TA	TENSION ANCHOR
TIG	TONGUE & GROOVE JOINT


**PIPE MATERIAL TABLE**

ABS	ACRYLONITRILE-BUTADIENE-STYRENE PIPE
AL	ALUMINUM PIPE
BI	BLACK IRON PIPE
BS	BLACK STEEL PIPE
CC	CONCRETE CYLINDER
CI	CAST IRON PIPE
CPVC	CHLORINATED POLYVINYL CHLORIDE PIPE
CU	COPPER PIPE
DI	DUCTILE IRON PIPE
DICML	DUCTILE IRON CEMENT MORTAR LINED
DICML&I	DUCTILE IRON CEMENT MORTAR LINED AND INSULATED
DIGL	DUCTILE IRON GLASS LINED
DICML&I	DUCTILE IRON GLASS LINED AND INSULATED
FRP	FIBERGLASS REINFORCED PLASTIC PIPE
GI	GALVANIZED IRON PIPE
GS	GALVANIZED STEEL PIPE
HDPE	HIGH DENSITY POLYETHYLENE PIPE
PE	POLYETHYLENE PIPE
PVC	POLYVINYL CHLORIDE PIPE
RC	REINFORCED CONCRETE PIPE
RPM	REINFORCED PLASTIC MORTAR PIPE
SS	STAINLESS STEEL
WS	WELDED STEEL PIPE
WSCML	WELDED STEEL CEMENT MORTAR LINED

**NOTE**

THIS IS A GENERALIZED ABBREVIATIONS, LEGEND, AND DETAILS SHEET. THIS CONTRACT MAY NOT USE ALL INFORMATION SHOWN.

**RECORD DRAWING**  
These Record Drawings have been prepared based on information provided by the contractor and others. Kennedy/Jenks Consultants has not verified the accuracy or completeness of information provided to them and does not warrant the accuracy or completeness of these Record Drawings. Users of these Record Drawings assume all risk of loss resulting from their use.

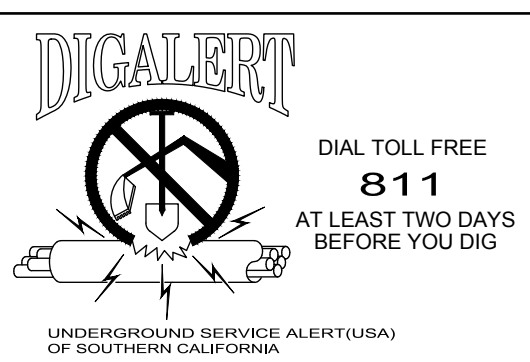

REV	DATE	DESCRIPTION	APPR
2	2-2015	RECORD DRAWING	WYC

DESIGNED BY KRV	PROJECT ENGINEER KAPIL VERMA
DRAWN BY VL	REG NUMBER C74589
CHECKED BY JMW	EXP DATE 12/31/13
DATE NOV 2012	PROJECT NUMBER 1188026*00
	CADD STANDARDS KENNEDY/JENKS

**KENNEDY/JENKS CONSULTANTS**  
2775 NORTH VENTURA ROAD, SUITE 100  
OXNARD, CALIFORNIA 93036



**LAS VIRGENES - TRIUNFO JOINT POWERS AUTHORITY**  
RANCHO LAS VIRGENES THIRD DIGESTER

**PIPE MATERIAL TABLE, PIPE SCHEDULE, SYMBOLS AND GENERAL NOTES**

DRAWING  
**G-04**

SHEET 4 OF 86


**CIVIL/GENERAL SYMBOLS**

FIRE PROTECTION WATER (EXISTING)	FW	FW	FW
SEWER (EXISTING)	SS	SS	SS
STORM DRAIN (EXISTING)	SD	SD	SD
WATER LINE (EXISTING)	W		
RECLAIMED WATER (EXISTING)	RW		
GAS LINE (EXISTING)	G	G	G
TELEPHONE LINE (EXISTING)	T	T	T
ELECTRICAL LINE (EXISTING)	E	E	E
OVERHEAD POWER (EXISTING)	OH	OH	OH
PUBLIC UTILITY DISTRICT (EXISTING)	PUD		
CABLE TV (EXISTING)	CTV		
CROSSING UTILITIES (EXISTING)			
FENCE	X	X	
PROPERTY LINE/RIGHT-OF-WAY			
CONTRACTORS WORK AREA LIMITS	WA		
CENTERLINE			
CULVERT WITH END SECTIONS			
HANDRAIL OR GUARDRAIL			
WATER SURFACE			
GRADE CHANGE LINE			
RIDGE LINE			
FLOW LINE			
GRADED SLOPE			
DITCH OR SWALE			
CONTOUR MAJOR (NEW)	110		
CONTOUR MINOR (NEW)			
CONTOUR MAJOR (EXIST)	110		
CONTOUR MINOR (EXIST)			

BENCH MARK	BM
SOIL BORING, IDENTIFICATION NUMBER	B-10
SOIL TEST PIT, IDENTIFICATION NUMBER	TP-10
SPOT ELEVATION	10.35
ELECTROLYSIS TEST STATION	ETS
WATER METER	WM
FIRE DEPT. CONNECTION	
FIRE HYDRANT	
UTILITY BOX (AS LABELED)	
POWER POLE	
STREET LIGHT	
STREET LIGHT AND TRAFFIC SIGNAL	
YARD LIGHT	
TRAFFIC SIGNAL	
TELEPHONE RISER	T RISER
GUY ANCHOR	
CATCH BASIN	CB
DROP INLET	DI
CLEAN OUT	CO
DRIVEWAY	
HANDICAP ACCESS RAMP	
CURVE NO.	14
SURVEY PANEL	
MONUMENT OR SURVEY POINT	
SECTION CORNER	
ELEVATION MARK (REFERENCE)	
ELEVATION MARK (DESIGN)	
FLAG NOTE	
WATER GATE VALVE	


STRUCTURE OR PIPE (NEW)	
STRUCTURE OR PIPE	
DEMOLITION	
CONCRETE IN SECTION	
STEEL IN SECTION	
WOOD IN SECTION	
GRATING IN PLAN	
CHECKERED PLATE IN PLAN	
GRAVELED AREA IN PLAN OR SECTION	
SAND	
BRICK OR CONCRETE BLOCK IN SECTION	
GRADE	
FILL	
ASPHALT CONCRETE (IN PLAN)	
ASPHALT CONCRETE (IN SECTION)	

**SECTION OR DETAIL REFERENCE**

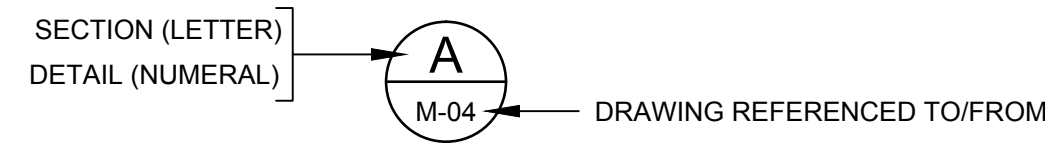

**NOTES:**


1. THIS IS A GENERALIZED LEGEND SHEET. THIS CONTRACT MAY NOT USE ALL INFORMATION SHOWN.
2. INFORMATION SHOWN MAY NOT BE ALL INCLUSIVE.

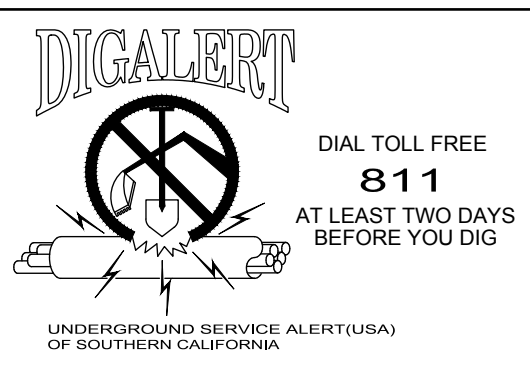

**RECORD DRAWING**  
 These Record Drawings have been prepared based on information provided by the contractor and others. Kennedy/Jenks Consultants has not verified the accuracy or completeness of information provided to them and does not warrant the accuracy or completeness of these Record Drawings. Users of these Record Drawings assume all risk of loss resulting from their use.

DESIGNED BY <b>KRV</b> PROJECT ENGINEER <b>KAPIL VERMA</b>	DRAWN BY <b>VL</b>	REG NUMBER <b>C74589</b>	EXP DATE <b>12/31/13</b>	CHECKED BY <b>JMW</b>	PROJECT NUMBER <b>1188026*00</b>	DATE <b>NOV 2012</b>	CADD STANDARDS <b>KENNEDY/JENKS</b>	KENNEDY/JENKS CONSULTANTS 2775 NORTH VENTURA ROAD, SUITE 100 OXNARD, CALIFORNIA 93036			LAS VIRGENES - TRIUNFO JOINT POWERS AUTHORITY RANCHO LAS VIRGENES THIRD DIGESTER	DRAWING <b>G-05</b>
		VERIFY SCALES BAR IS ONE INCH ON ORIGINAL DRAWING IF NOT ONE INCH ON THIS SHEET, ADJUST SCALES ACCORDINGLY	WCY		SHEET <b>5</b> OF <b>86</b>							

P:\K\A\14-0001\14-0001.dwg  
 DATE: Feb 12, 2015 3:56pm  
 USER: cjb  
 PROJECT: 14-0001-001-14-0001.dwg  
 DRAWING: 14-0001-001-14-0001.dwg  
 IMAGE: L:\MWD\_BNK.HIF  
 USER: cjb  
 PROJECT: 14-0001-001-14-0001.dwg  
 DRAWING: 14-0001-001-14-0001.dwg  
 IMAGE: L:\MWD\_BNK.HIF

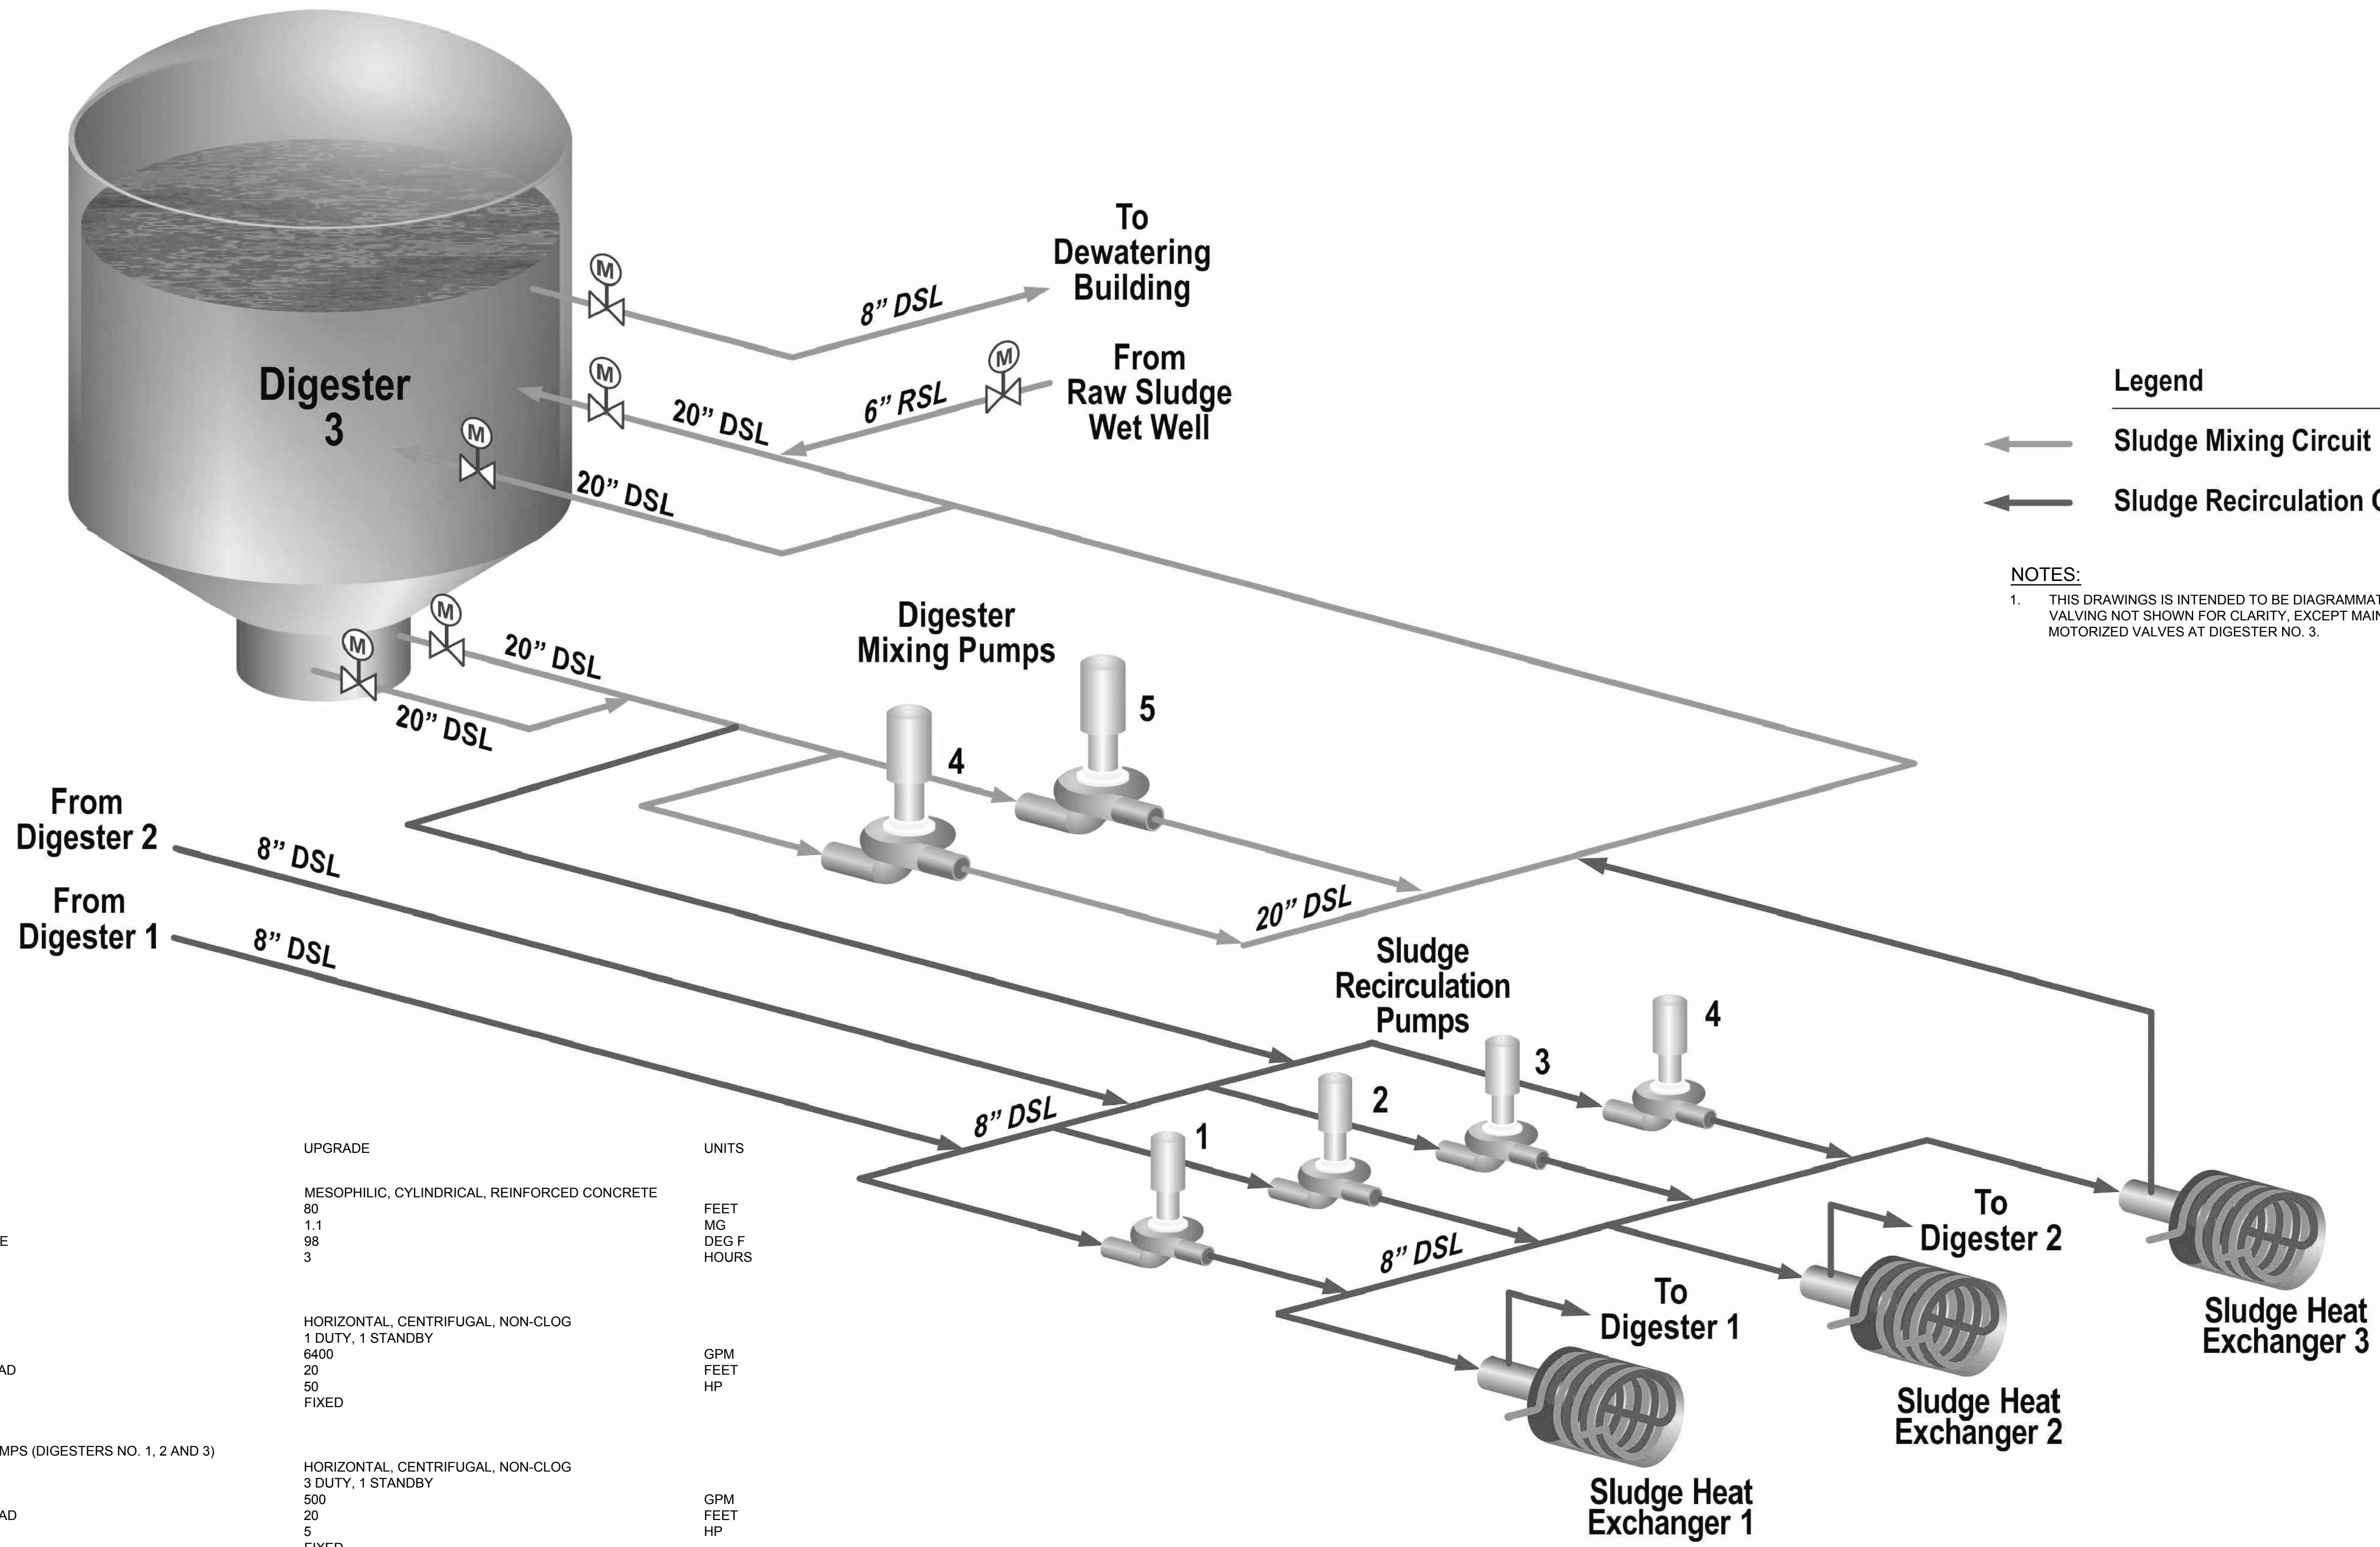

**Legend**

← Sludge Mixing Circuit


← Sludge Recirculation Circuit

**NOTES:**

1. THIS DRAWINGS IS INTENDED TO BE DIAGRAMMATIC. VALVING NOT SHOWN FOR CLARITY, EXCEPT MAIN MOTORIZED VALVES AT DIGESTER NO. 3.

**DESIGN CRITERIA**

DESCRIPTION	UPGRADE	UNITS
<b>ANAEROBIC DIGESTER NO. 3</b>		
TYPE	MESOPHILIC, CYLINDRICAL, REINFORCED CONCRETE	FEET
DIAMETER	80	MG
CAPACITY	1.1	DEG F
OPERATING TEMPERATURE	98	HOURS
MIXING TURNOVER TIME	3	
<b>DIGESTER MIXING</b>		
<b>SLUDGE MIXING PUMPS</b>		
PUMP TYPE	HORIZONTAL, CENTRIFUGAL, NON-CLOG	GPM
NUMBER OF PUMPS	1 DUTY, 1 STANDBY	FEET
PUMP CAPACITY (EACH)	6400	HP
PUMP TOTAL DYNAMIC HEAD	20	
PUMP MOTOR	50	
SPEED CONTROL	FIXED	
<b>DIGESTER HEATING</b>		
<b>SLUDGE RECIRCULATION PUMPS (DIGESTERS NO. 1, 2 AND 3)</b>		
PUMP TYPE	HORIZONTAL, CENTRIFUGAL, NON-CLOG	GPM
NUMBER OF PUMPS	3 DUTY, 1 STANDBY	FEET
PUMP CAPACITY (EACH)	500	HP
PUMP TOTAL DYNAMIC HEAD	20	
PUMP MOTOR	5	
SPEED CONTROL	FIXED	
<b>SLUDGE HEATING DEMAND</b>		
WINTER RAW SLUDGE HEATING DEMAND	1,741	MBH (10 <sup>3</sup> BTU/HR)
WINTER DIGESTER HEAT LOSS (EACH DIGESTER)	533	MBH
WINTER TOTAL SLUDGE HEATING DEMAND (DIGESTER 3 ONLY)	2,274	MBH
WINTER TOTAL COMBINED HEAT DEMAND (2 DIGESTERS)	2,807	MBH
SUMMER RAW SLUDGE HEATING DEMAND	1,393	MBH
SUMMER DIGESTER HEAT LOSS (EACH DIGESTER)	137	MBH
SUMMER TOTAL SLUDGE HEATING DEMAND (DIGESTER 3 ONLY)	1,530	MBH
SUMMER TOTAL COMBINED HEAT DEMAND (2 DIGESTERS)	1,667	MBH

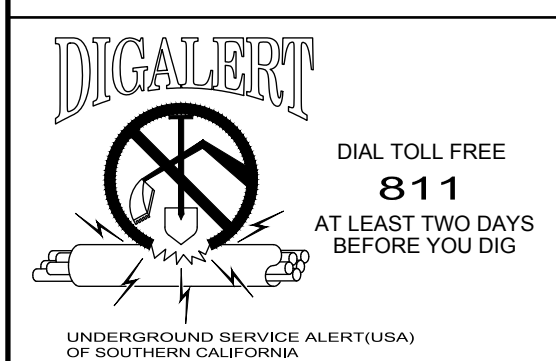

**RECORD DRAWING**

These Record Drawings have been prepared based on information provided by the contractor and others. Kennedy/Jenks Consultants has not verified the accuracy or completeness of information provided to them and does not warrant the accuracy or completeness of these Record Drawings. Users of these Record Drawings assume all risk of loss resulting from their use.

VERIFY SCALES BAR IS ONE INCH ON ORIGINAL DRAWING IF NOT ONE INCH ON THIS SHEET, ADJUST SCALES ACCORDINGLY	DESIGNED BY: KRV DRAWN BY: VL CHECKED BY: JMW DATE: NOV 2012	PROJECT ENGINEER: KAPIL VERMA REG NUMBER: C74589 PROJECT NUMBER: 1188026*00 CADD STANDARDS: KENNEDY/JENKS	EXP DATE: 12/31/13	KENNEDY/JENKS CONSULTANTS 2775 NORTH VENTURA ROAD, SUITE 100 OXNARD, CALIFORNIA 93036			LAS VIRGENES - TRIUNFO JOINT POWERS AUTHORITY RANCHO LAS VIRGENES THIRD DIGESTER	DRAWING: <b>G-06</b> SHEET: 6 OF 86
	2-2015 RECORD DRAWING WCY DATE DESCRIPTION APPR	1	2	3	4	5	6	7
















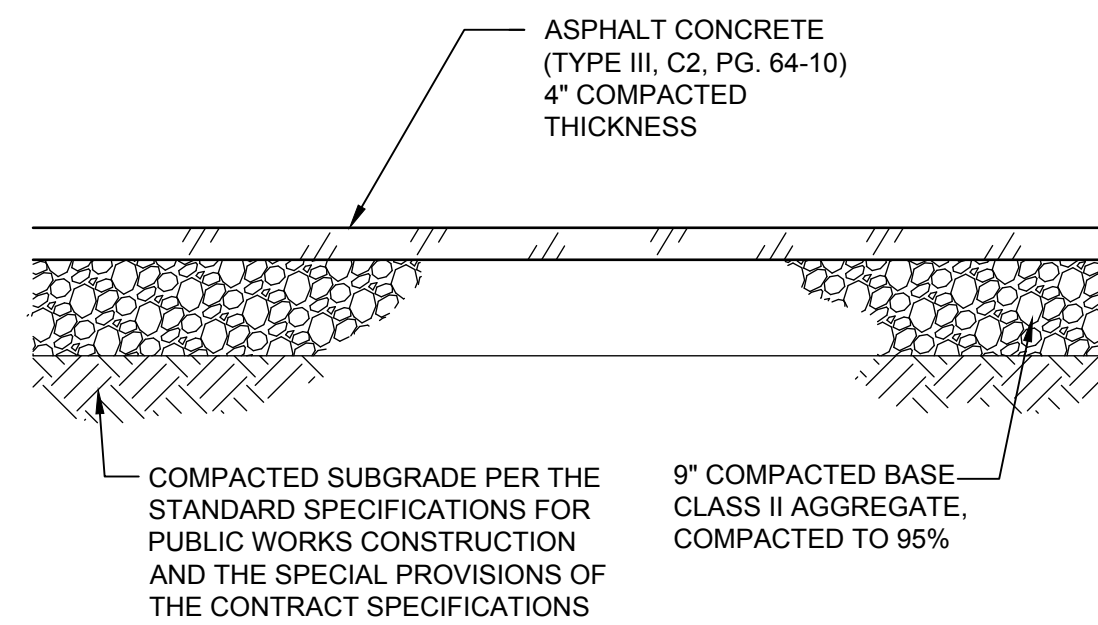

**TYPICAL ASPHALT CONCRETE PAVING DETAIL** 1  
SCALE: NONE C-03

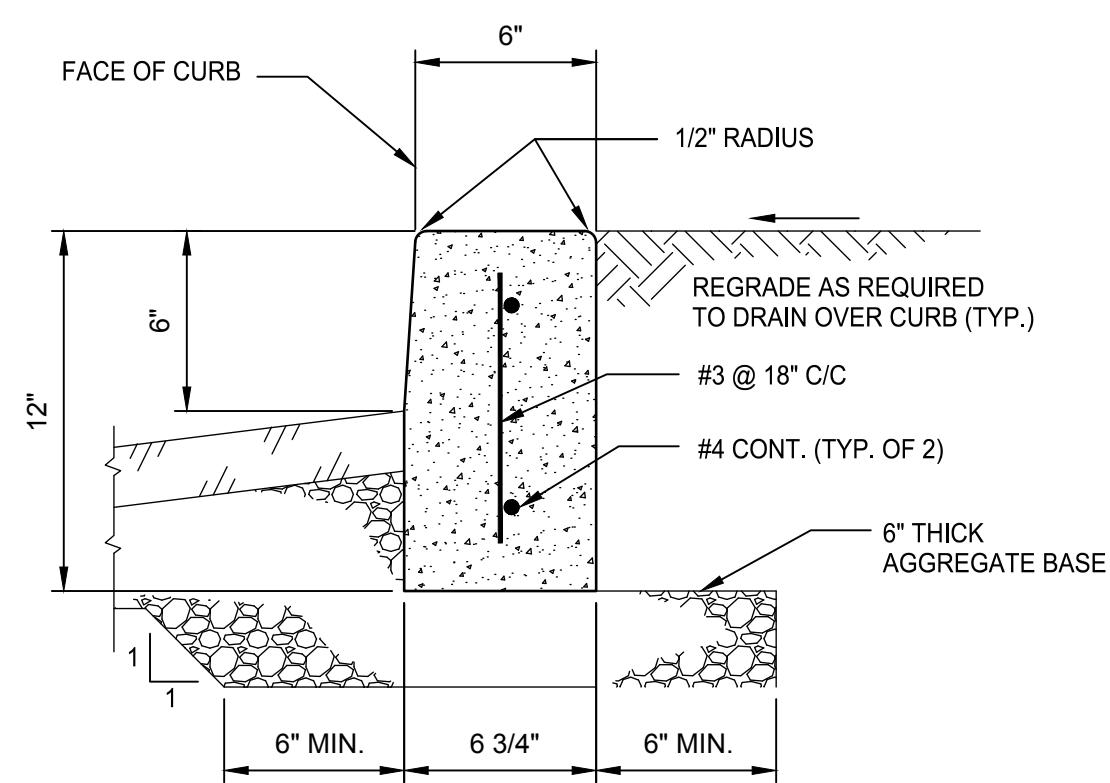


**TYPICAL CONCRETE CURB DETAIL** 2  
SCALE: NONE C-03

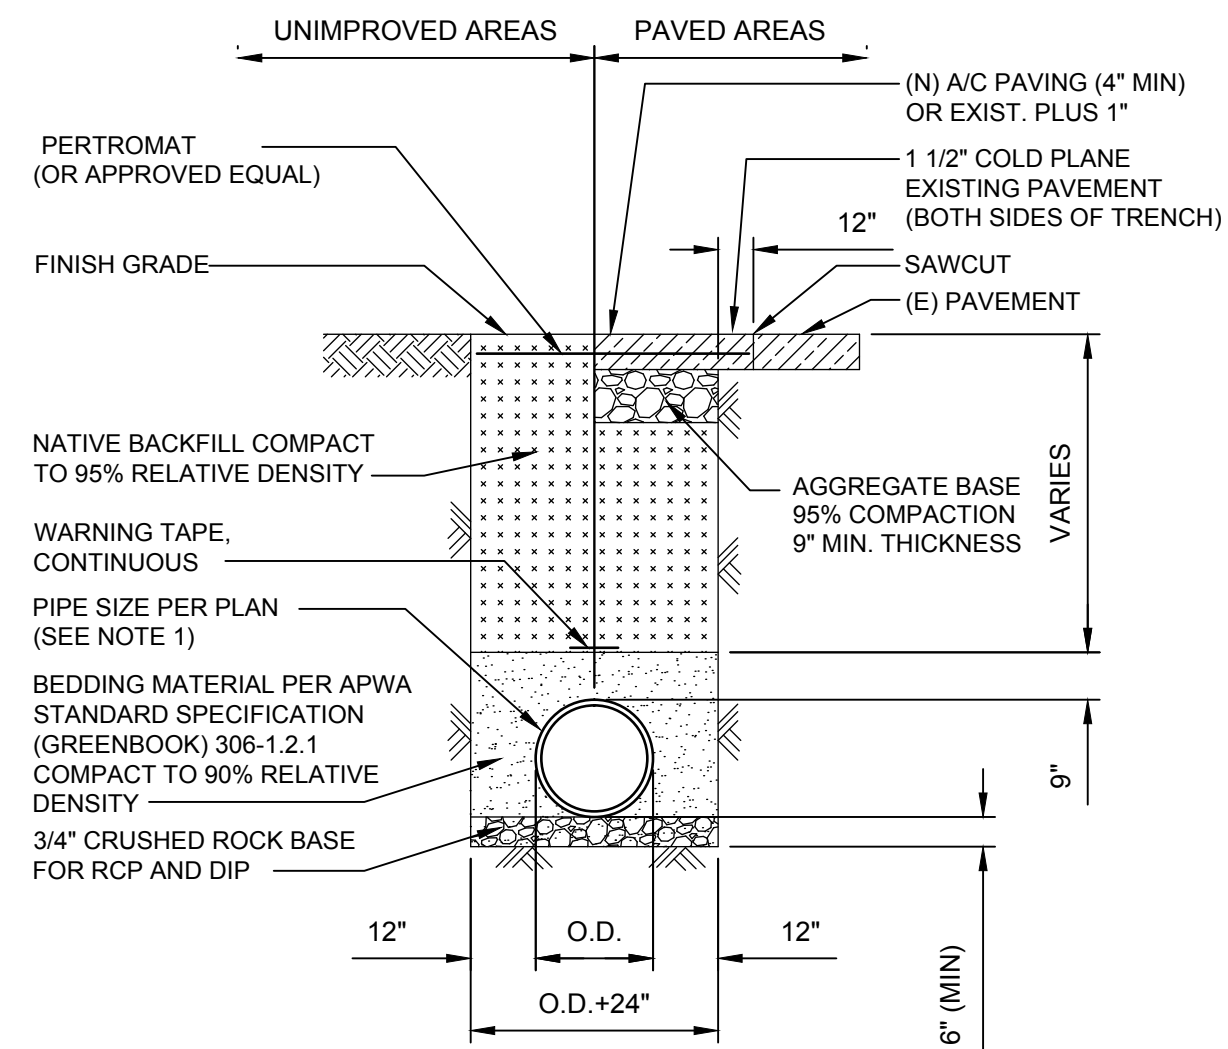


**NOTES:**  
1. FOR TRENCHES WHICH CONTAIN MORE THAN ONE PIPE USE STANDARD PIPE SPACING.

**TYPICAL TRENCH SECTION FOR PIPES UNDER 24" DIA.** 3  
SCALE: NONE C-03

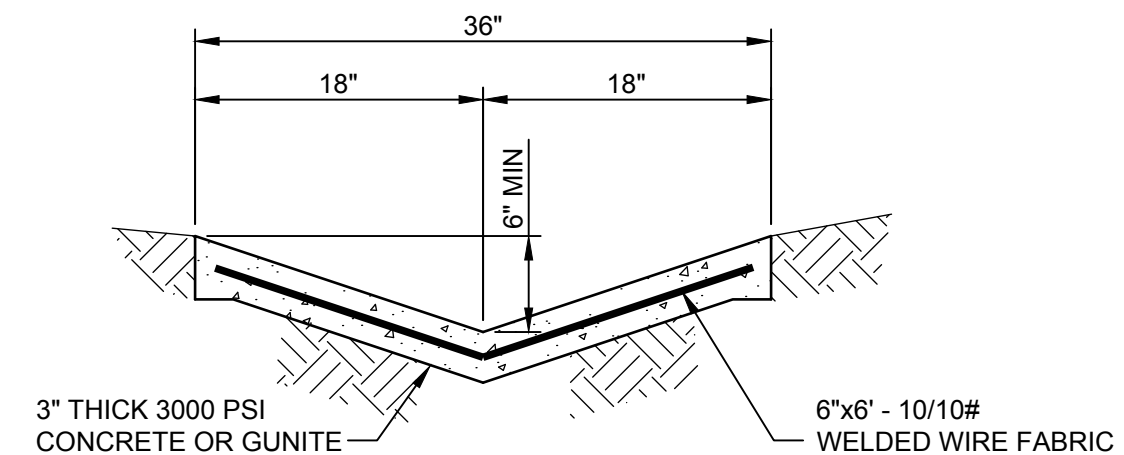


**TYPICAL CONCRETE VEE TRENCH DETAIL** 4  
SCALE: NONE C-03

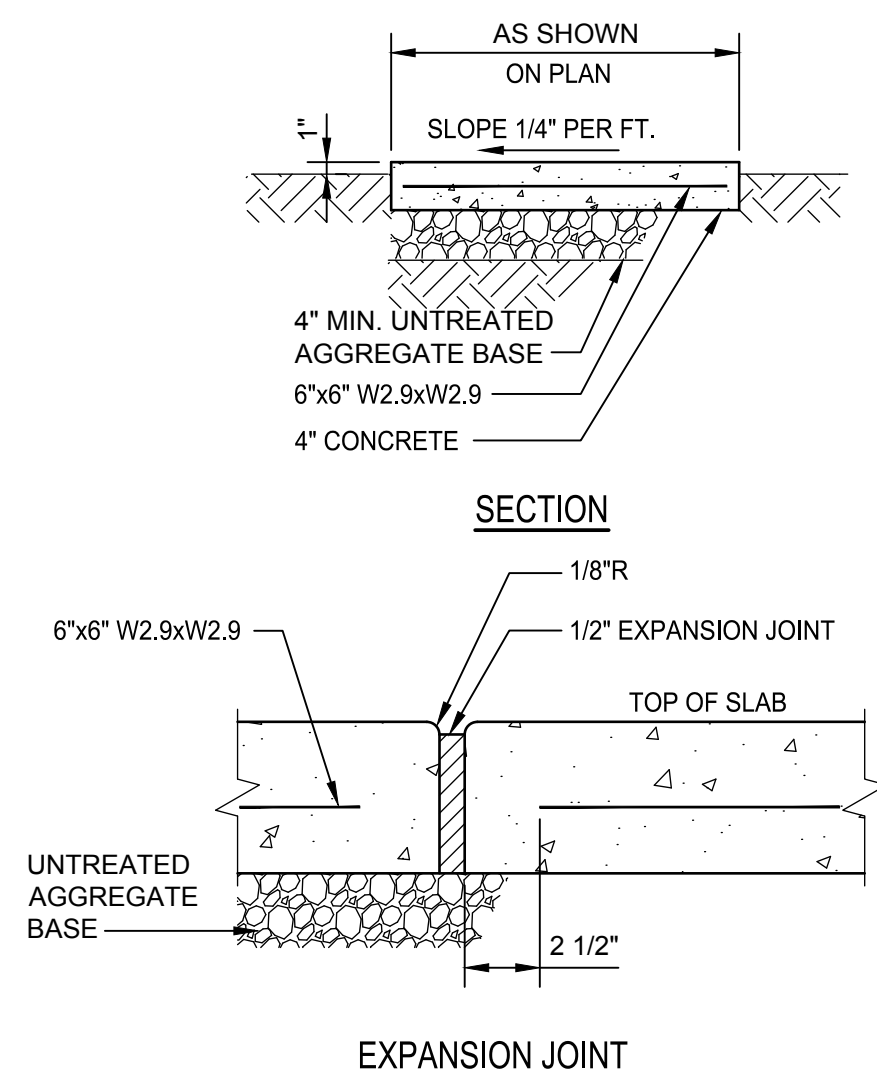


**NOTES:**  
1. WALK SHALL BE CONSTRUCTED OF PORTLAND CEMENT CONCRETE.  
2. EXPANSION JOINTS OF ONE-HALF INCH RIGID BITUMINOUS MATERIAL SHALL BE PLACED AT APPROXIMATELY 25-FOOT SPACING.  
3. SCORE LINES AT RIGHT ANGLES TO CENTER LINE SHALL BE MARKED AT 36-INCH INTERVALS. ON WALKS EXCEEDING FOUR FEET IN WIDTH, A CONTINUOUS SCORE LINE SHALL BE MARKED ON CENTERLINE.  
4. WALKS SHALL BE SLOPED AWAY FROM STRUCTURES.


**TYPICAL SIDEWALK DETAIL** 5  
SCALE: NONE C-03

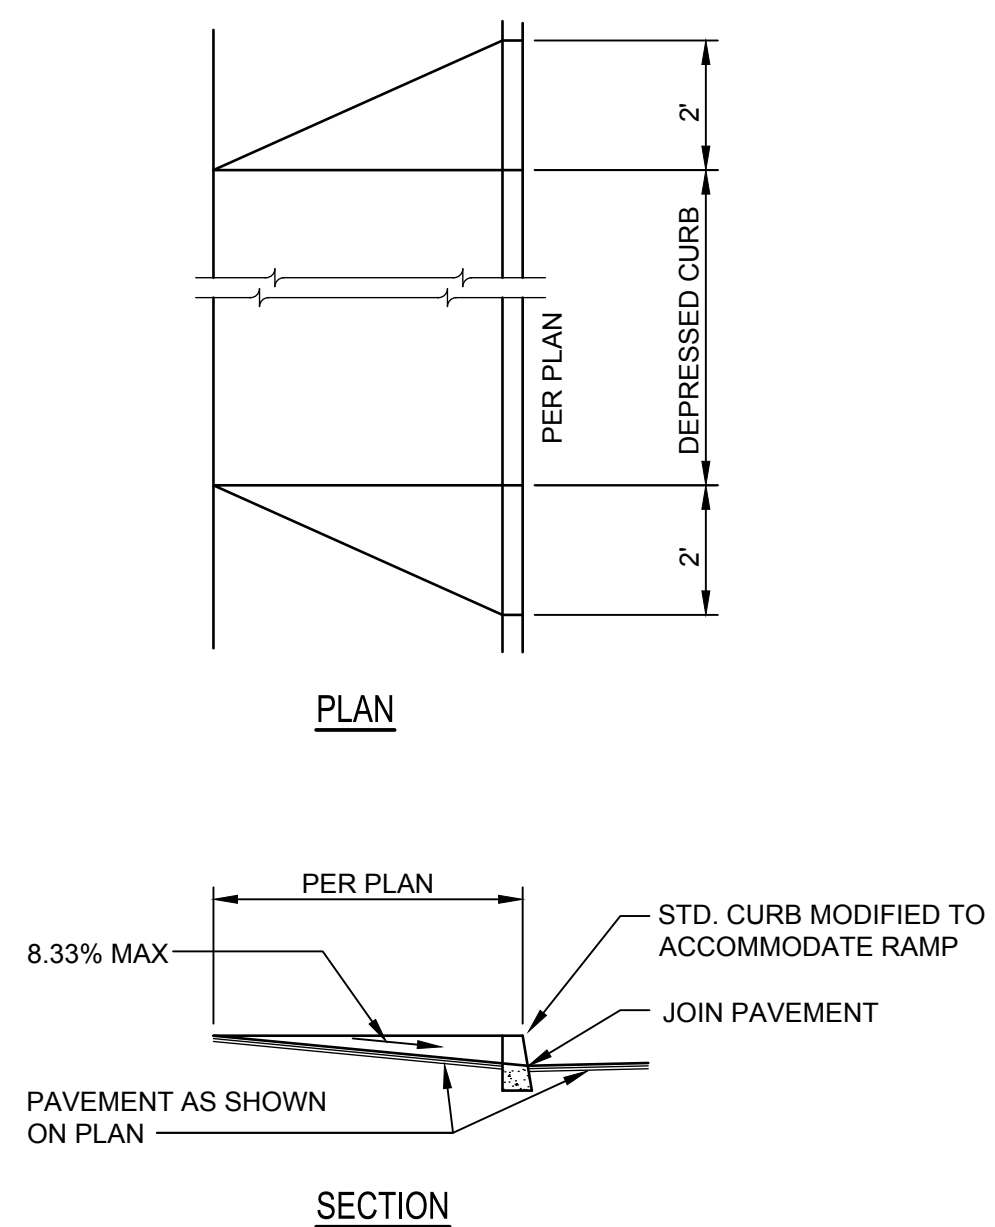

**TYPICAL DRIVEWAY DETAIL** 6  
SCALE: NONE C-03

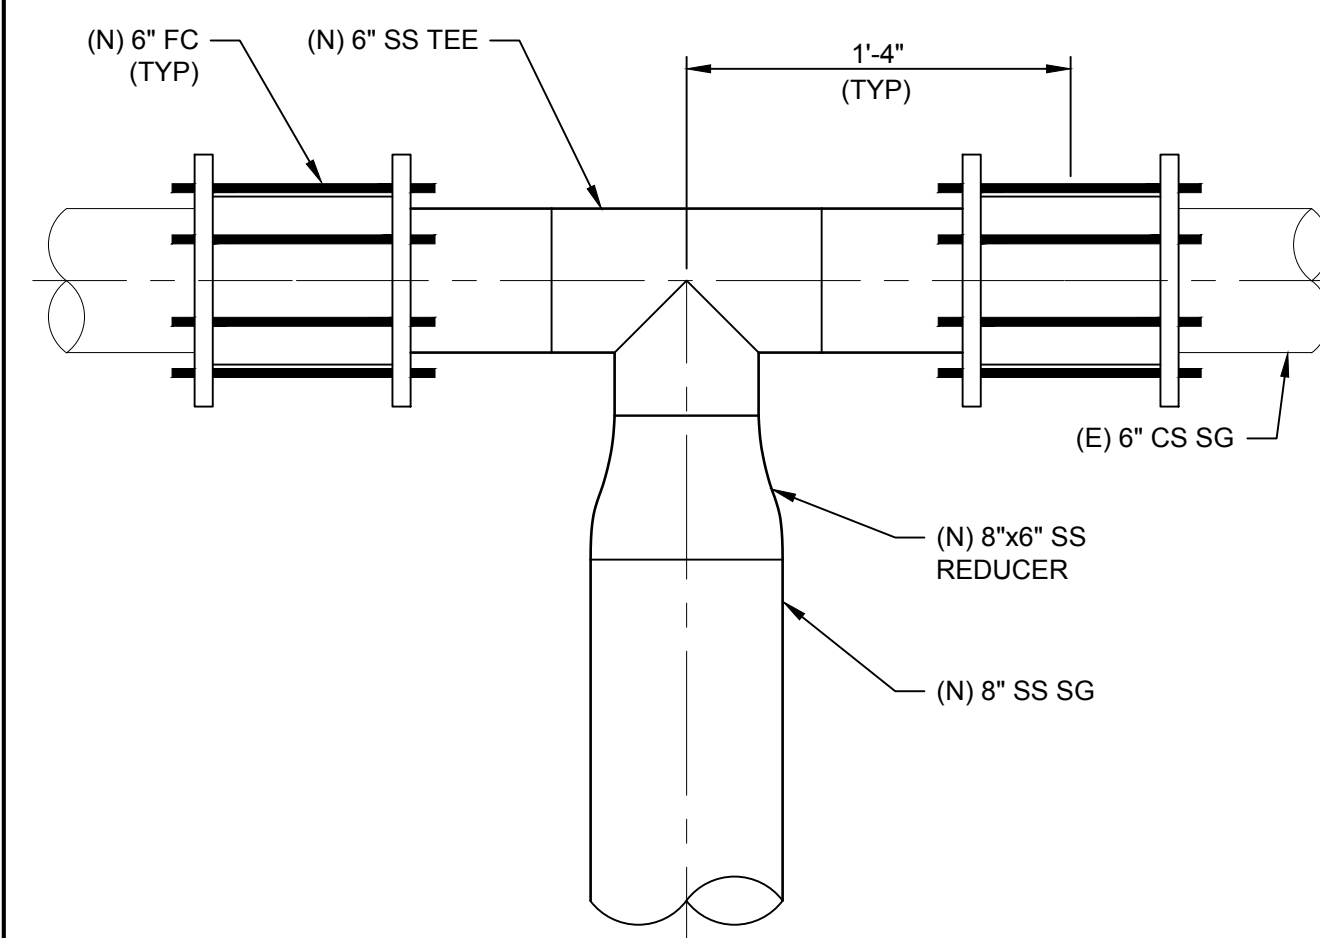

**SLUDGE GAS PIPING CONNECTION DETAIL** 7  
SCALE: 1-1/2" = 1'-0" C-02

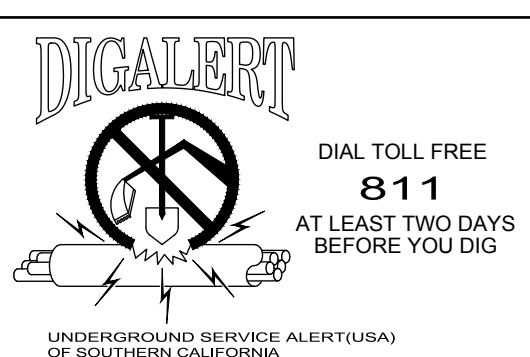

**RECORD DRAWING**  
These Record Drawings have been prepared based on information provided by the contractor and others. Kennedy/Jenks Consultants has not verified the accuracy or completeness of information provided to them and does not warrant the accuracy or completeness of these Record Drawings. Users of these Record Drawings assume all risk of loss resulting from their use.

PWS: \\K:\p\m\h\k\p\cod\Sch\Draw\1\168026\*00\_Las\_Virgenes\_Third\_Digester\_Design\168026\_00E.dwg USER: m\kumar DATE: Feb 12, 2015 4:17pm PAGES: 1-168026-TBR PLT: 168026-TBPrinter IMAGES: L:\MKT\_BW.plt

DESIGNED BY JTS	PROJECT ENGINEER KAPIL VERMA
DRAWN BY VL	REG NUMBER C74589
CHECKED BY JMW	EXP DATE 12/31/13
DATE NOV 2012	PROJECT NUMBER 1188026*00
	CADD STANDARDS KENNEDY/JENKS

**KENNEDY/JENKS CONSULTANTS**  
2775 NORTH VENTURA ROAD, SUITE 100  
OXNARD, CALIFORNIA 93036



**TRIUNFO SANITATION DISTRICT**  
A PUBLIC AGENCY

LAS VIRGENES - TRIUNFO JOINT POWERS AUTHORITY  
RANCHO LAS VIRGENES THIRD DIGESTER

MISCELLANEOUS CIVIL DETAILS

DRAWING  
**C-05**

SHEET 12 OF 86