


PROFILE
 NO. 00068-01
 PROJECTED
 BY M. QUIROS
 STRUCTURE NOTATION CHECKED

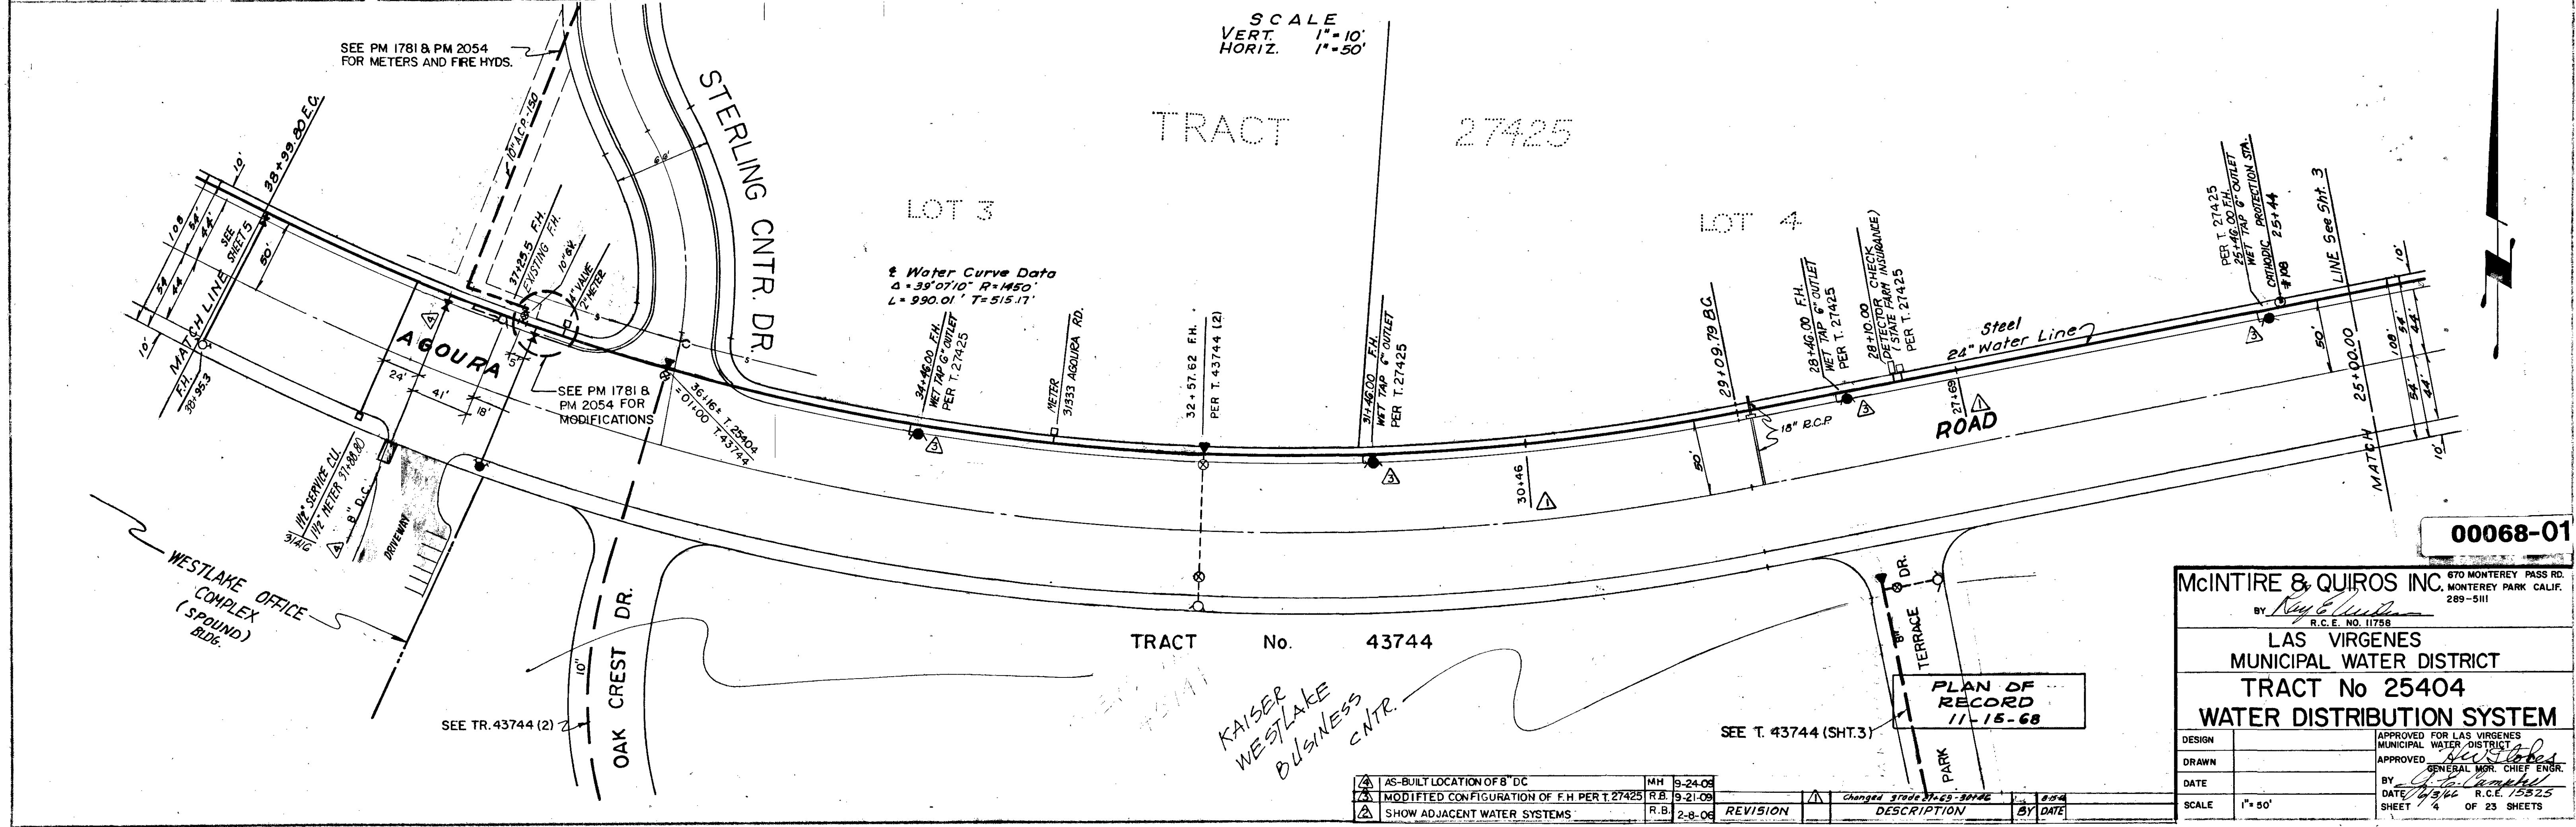

PLAN
 NO. 00068-01
 PROJECTED
 BY M. QUIROS
 STRUCTURE NOTATION CHECKED

00068-01

McINTIRE & QUIROS INC. 670 MONTEREY PASS RD. MONTEREY PARK CALIF. 289-5111

BY *Ray C. Quiros*
 R.C.E. NO. 11758

LAS VIRGENES MUNICIPAL WATER DISTRICT
 TRACT No 25404
 WATER DISTRIBUTION SYSTEM

DESIGN: APPROVED FOR LAS VIRGENES MUNICIPAL WATER DISTRICT
 DRAWN: APPROVED BY *Ray C. Quiros* GENERAL MGR. CHIEF ENGR.
 DATE: 11-15-68 R.C.E. 15525
 SCALE: 1" = 50'
 SHEET 4 OF 23 SHEETS

REVISION	DESCRIPTION	BY	DATE
AS-BUILT LOCATION OF 8" DC		MH	9-24-09
MODIFIED CONFIGURATION OF F.H. PER T. 27425		R.B.	9-21-09
SHOW ADJACENT WATER SYSTEMS		R.B.	2-8-06
Changed grade 31.65-31.74			


PLAN OF RECORD
 11-15-68

TRACT No. 43744


KAISER WESTLAKE BUSINESS CNTR.

SEE TR. 43744 (2)

SEE T. 43744 (SHT. 3)

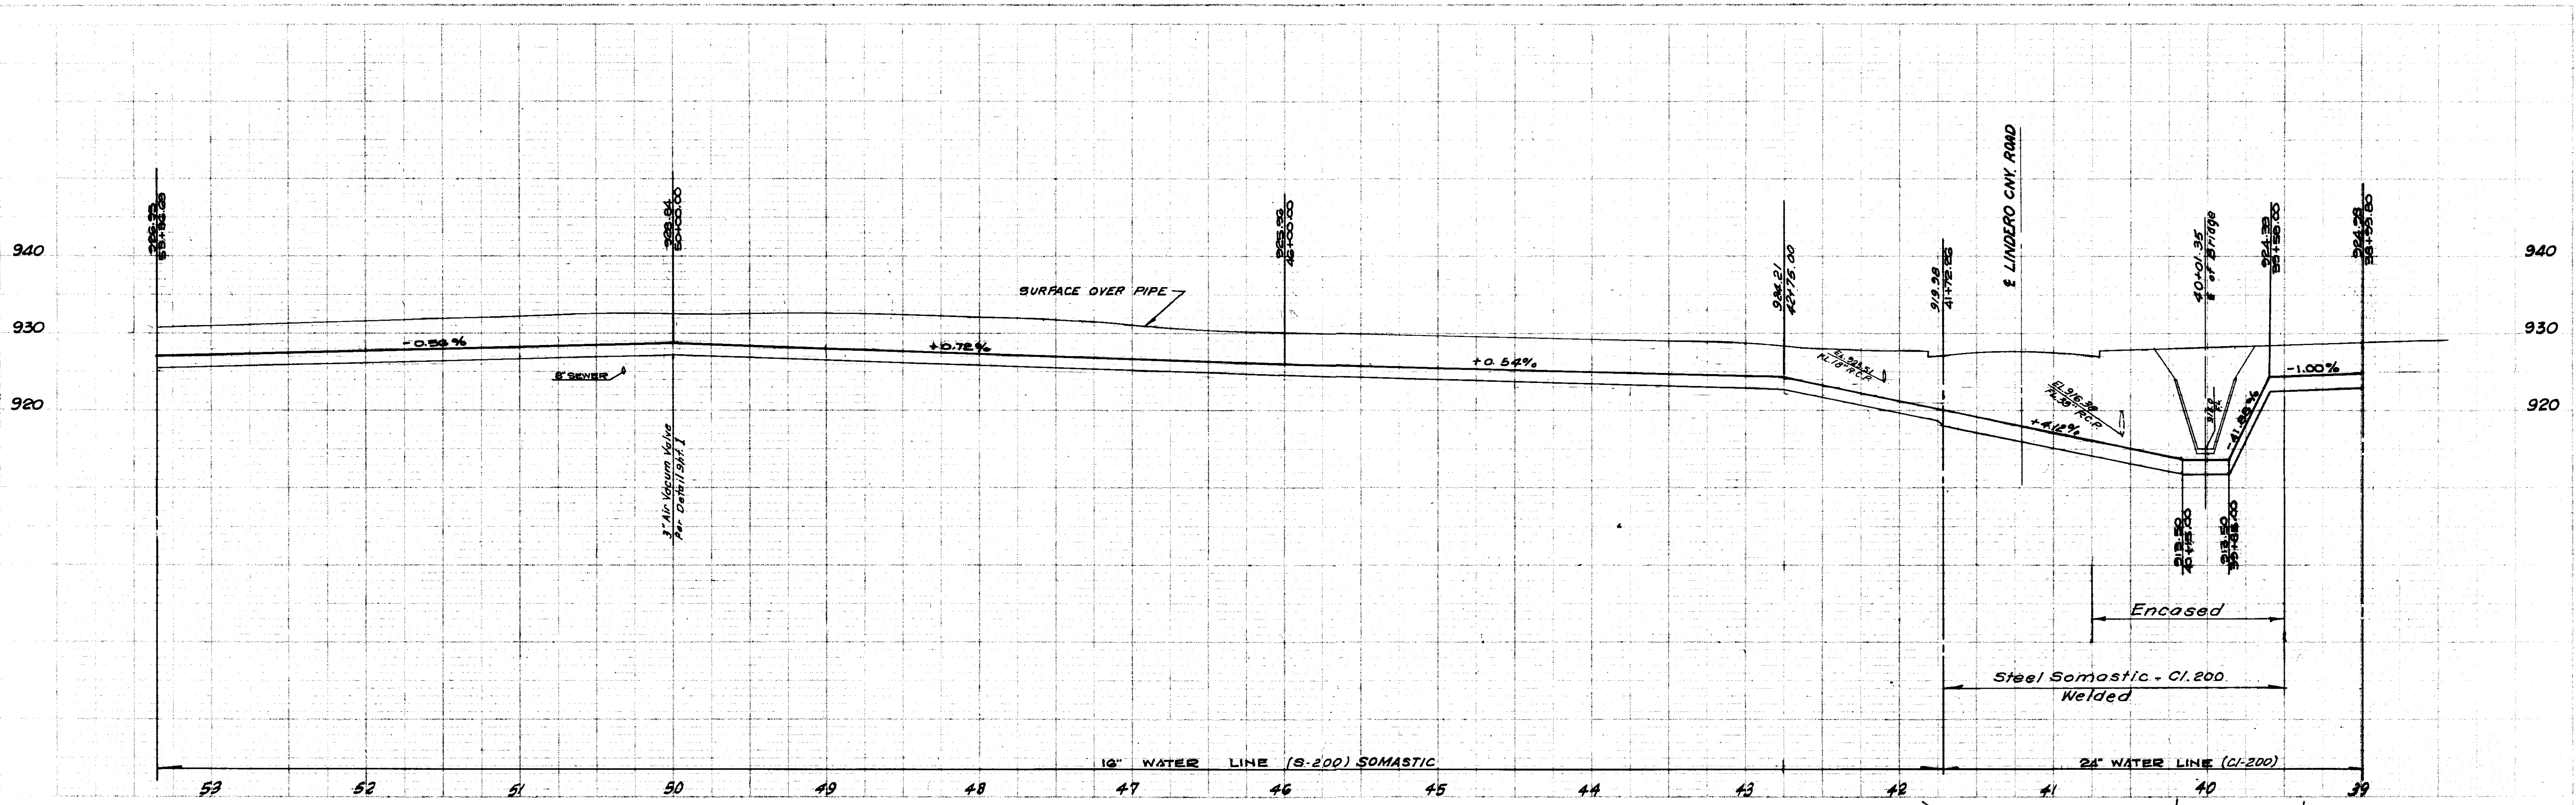

SCALE
 VERT. 1" = 10'
 HORIZ. 1" = 50'

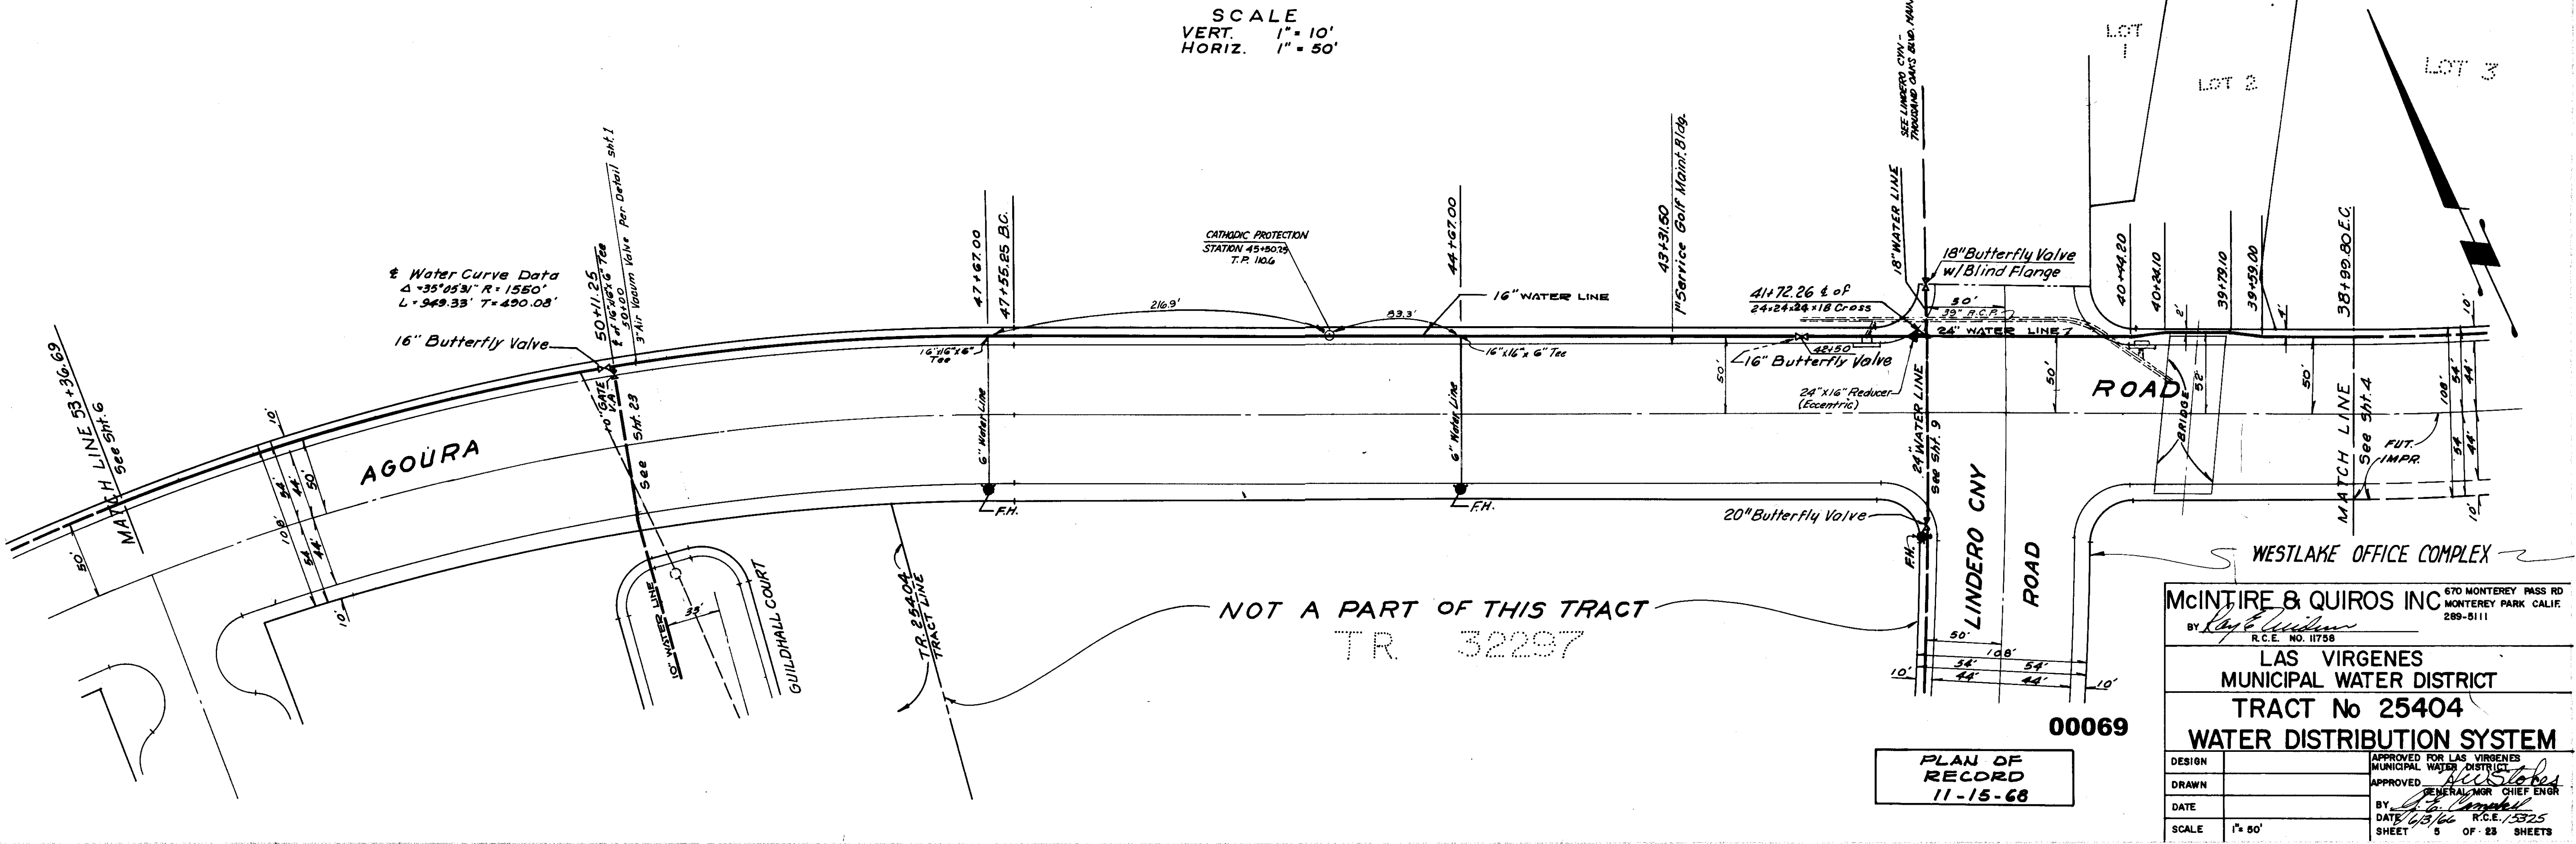

McINTIRE & QUIROS INC. 670 MONTEREY PASS RD. MONTEREY PARK CALIF. 289-5111

BY *Ray E. Quiros* R.C.E. NO. 11758

LAS VIRGENES MUNICIPAL WATER DISTRICT

TRACT No 25404

WATER DISTRIBUTION SYSTEM

DESIGN APPROVED FOR LAS VIRGENES MUNICIPAL WATER DISTRICT


DRAWN APPROVED *W. Stokas* GENERAL MGR CHIEF ENGR

DATE BY *W. Stokas* R.C.E. 15325


SCALE 1" = 80' SHEET 5 OF 23 SHEETS

00069

PLAN OF RECORD
 11-15-68

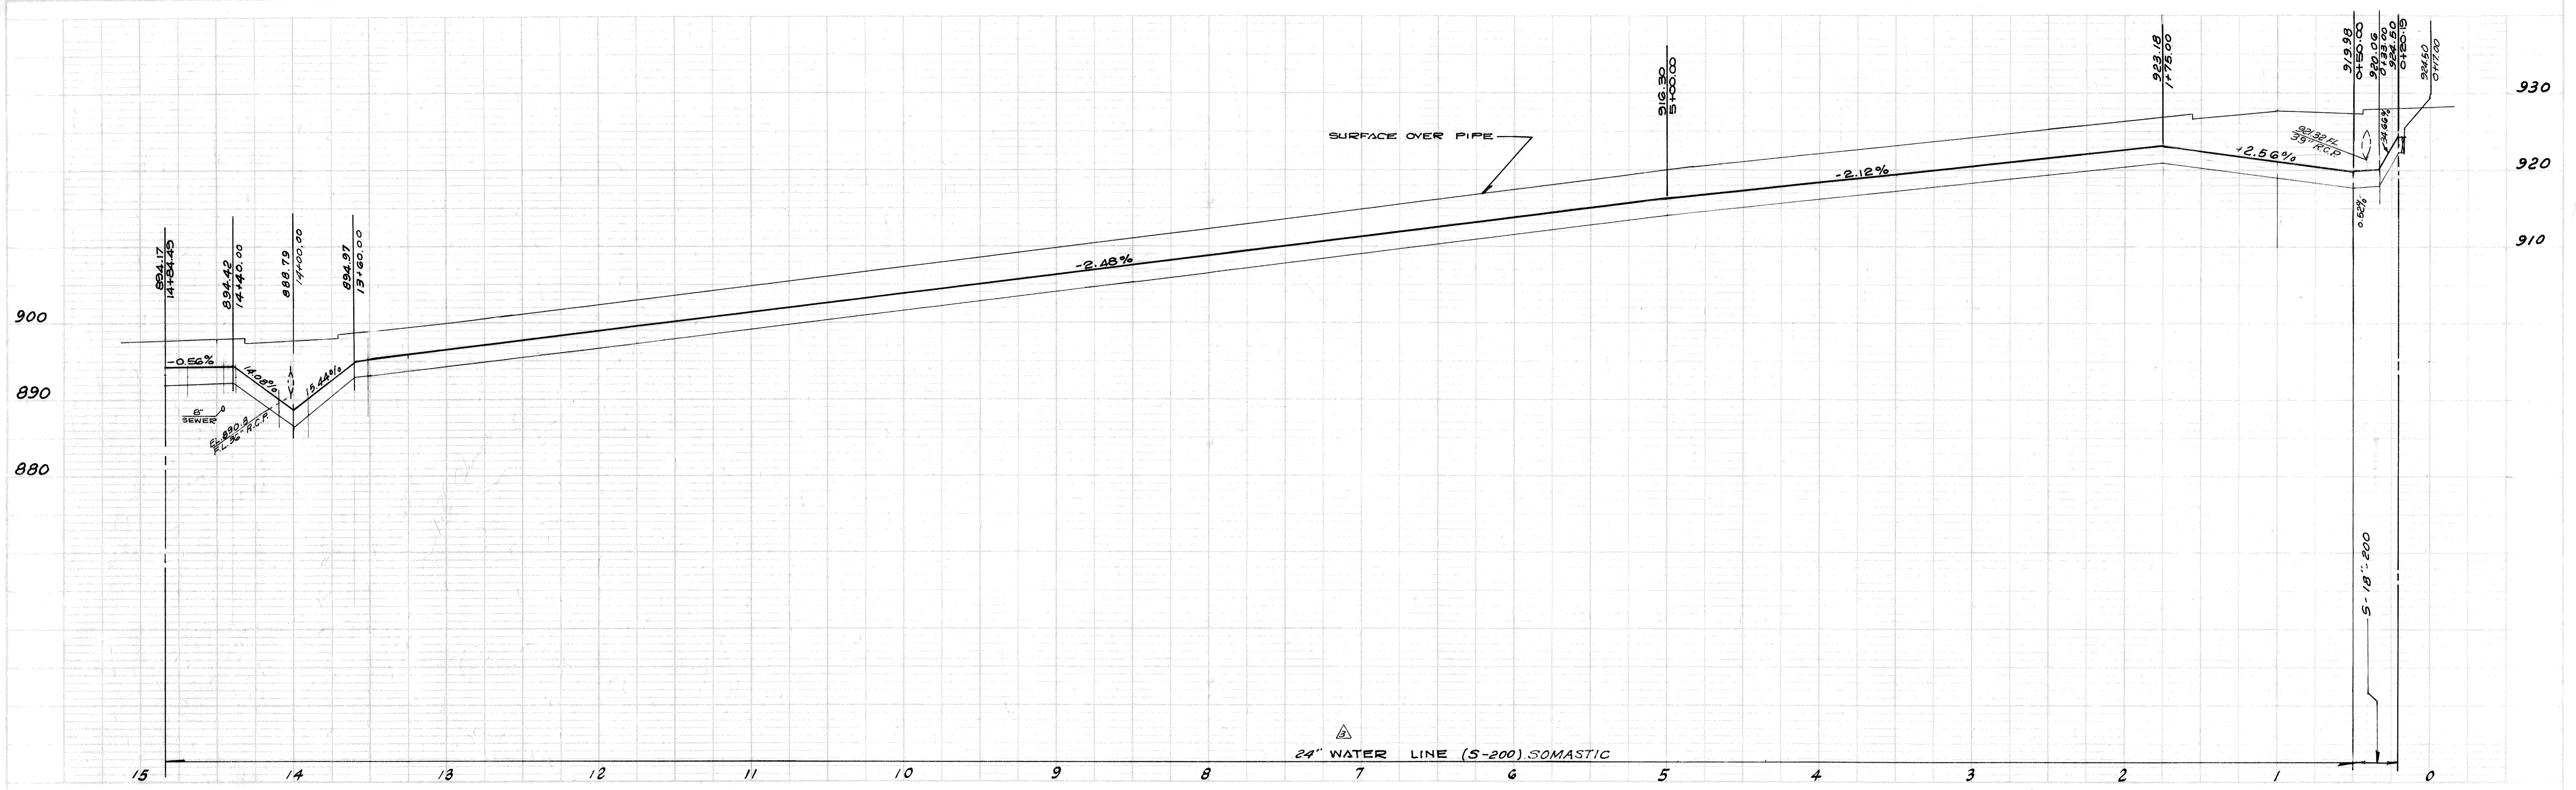

SCALE
 VERT. 1" = 10'
 HORIZ. 1" = 50'

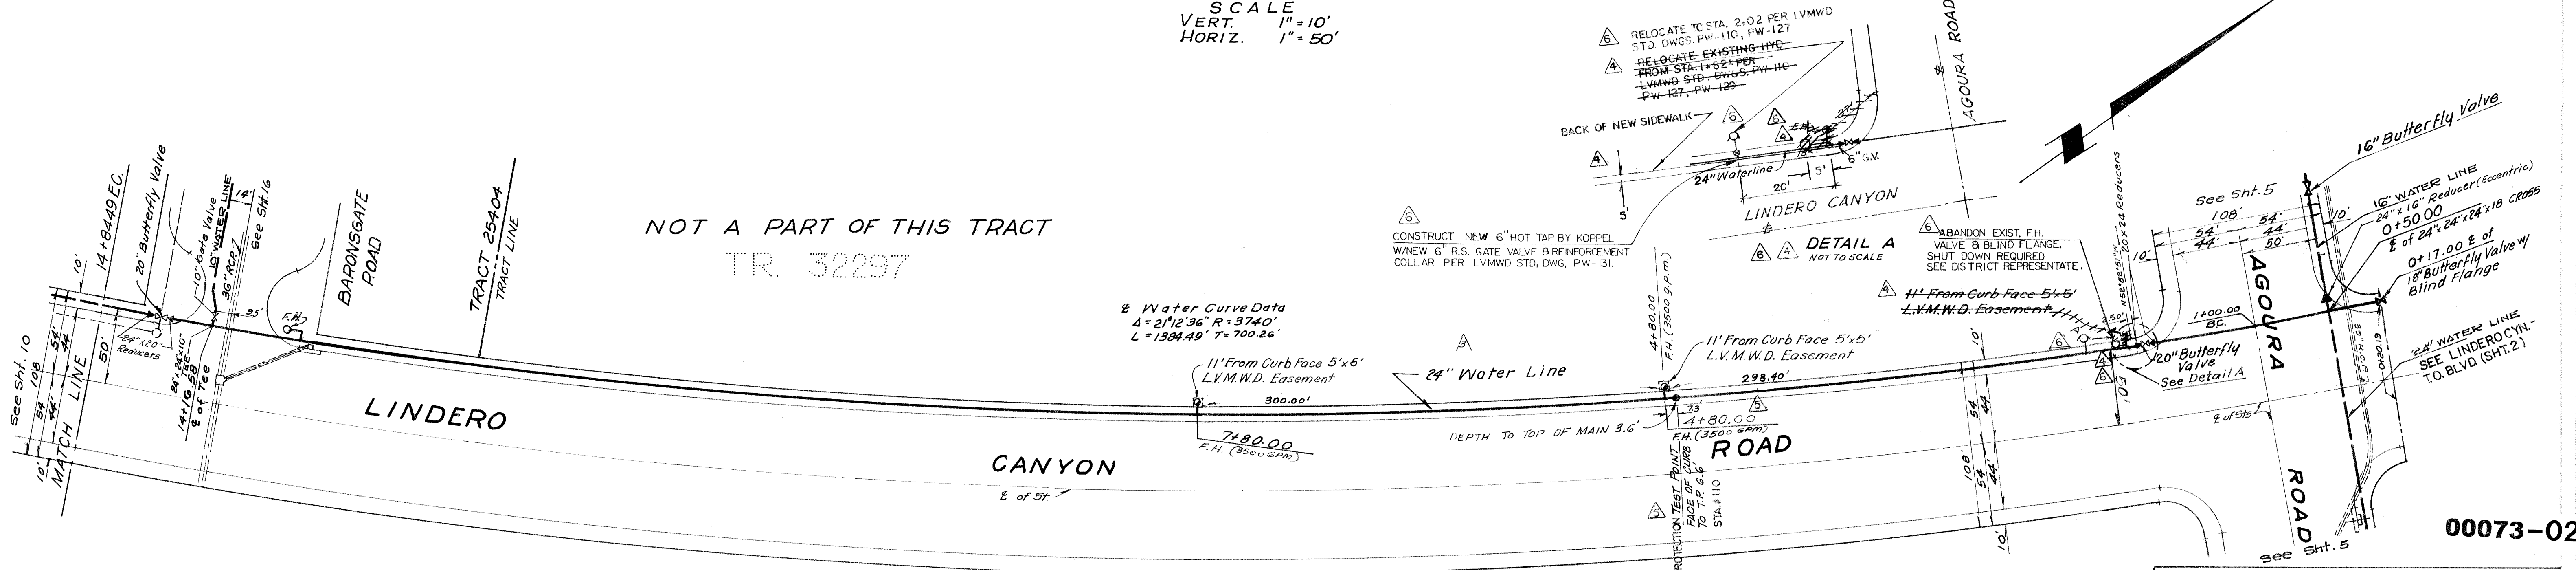

PLAN OF RECORD
 11-18-68

REVISION	No.	DESCRIPTION	BY	DATE	APPR. BY	DATE
	1	RELOC. EXIST. F.H. TO STA. 2+02		4-11-06	JAV.	
	2	CATH. PROT. T.P. STA. 4+80 NOT STA. 4+23				
	3	RELOC. EXIST. F.H. AT STA. 1+82 TO TEE 5 OFF EX. HYD. LAT.		2-2-06	JAV.	
	4	Changed 12" Water Main to 24"				

McINTIRE & QUIROS INC
 670 MONTEREY PASS RD.
 MONTEREY PARK, CALIF.
 289-5111

BY *[Signature]*
 R.C.E. NO. 11798

LAS VIRGENES
 MUNICIPAL WATER DISTRICT
 TRACT No 25404
 WATER DISTRIBUTION SYSTEM

APPROVED FOR LAS VIRGENES
 MUNICIPAL WATER DISTRICT
 APPROVED *[Signature]*
 GENERAL MGR. CHIEF ENGR.
 BY *[Signature]*
 DATE 8-18-06
 R.C.E. 15325

SCALE 1" = 50'
 SHEET 9 OF 23 SHEETS

00073-02

950




940

930





950

940

930

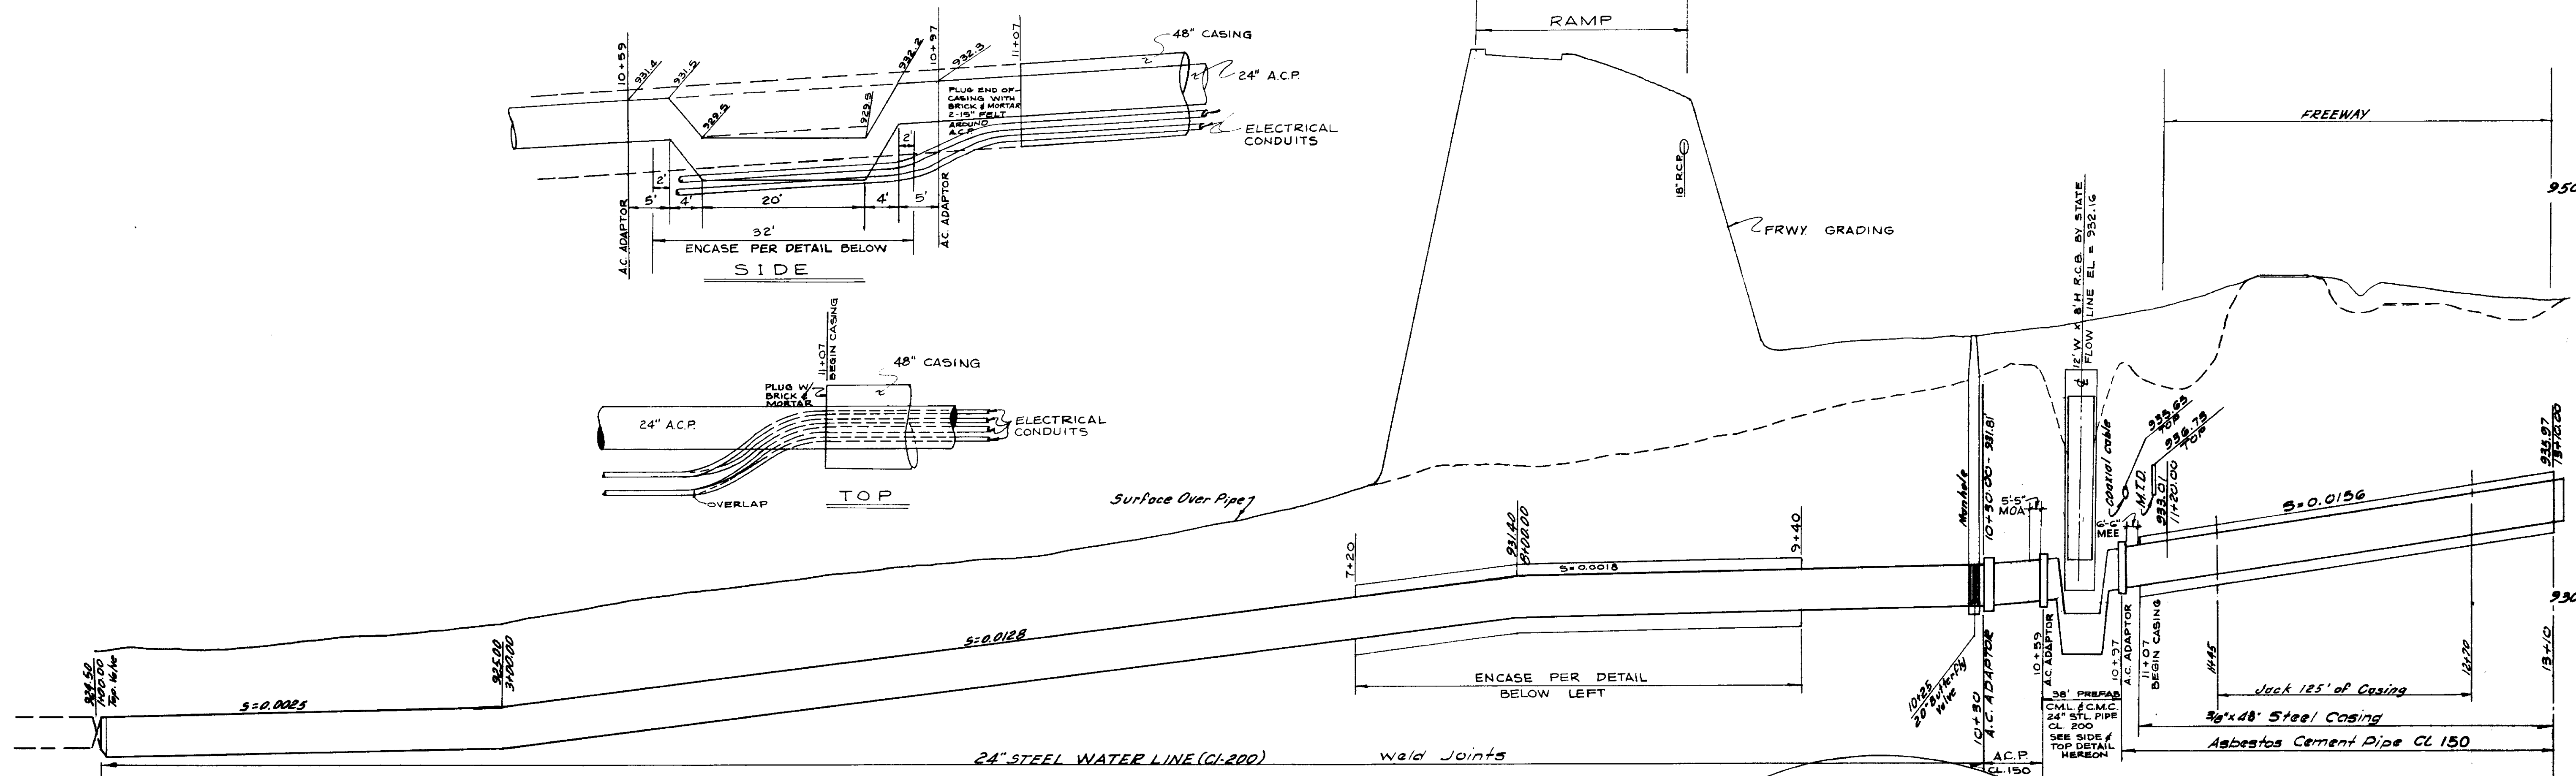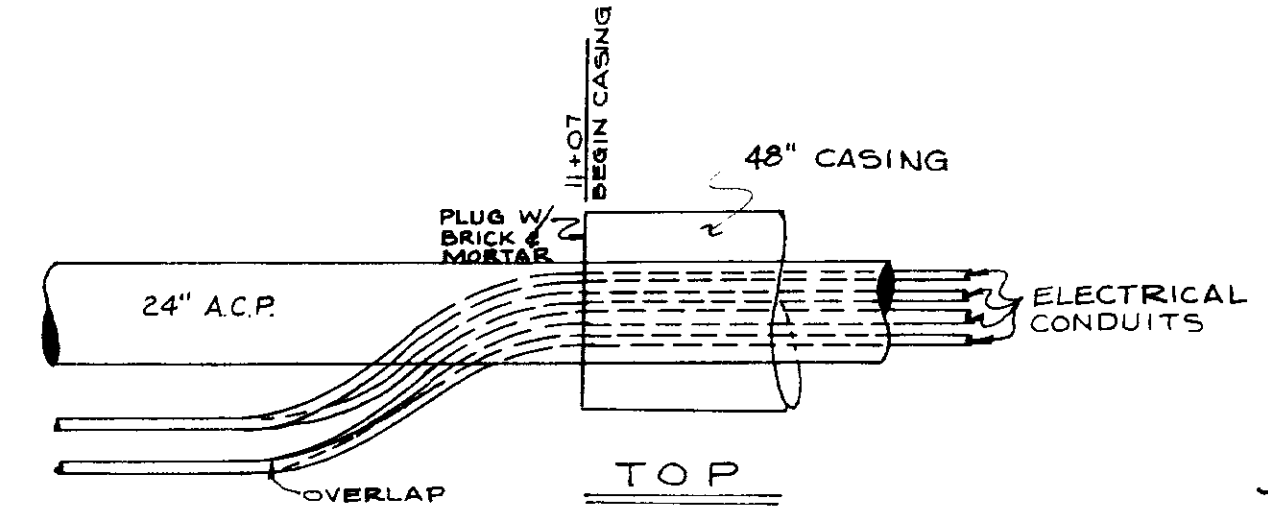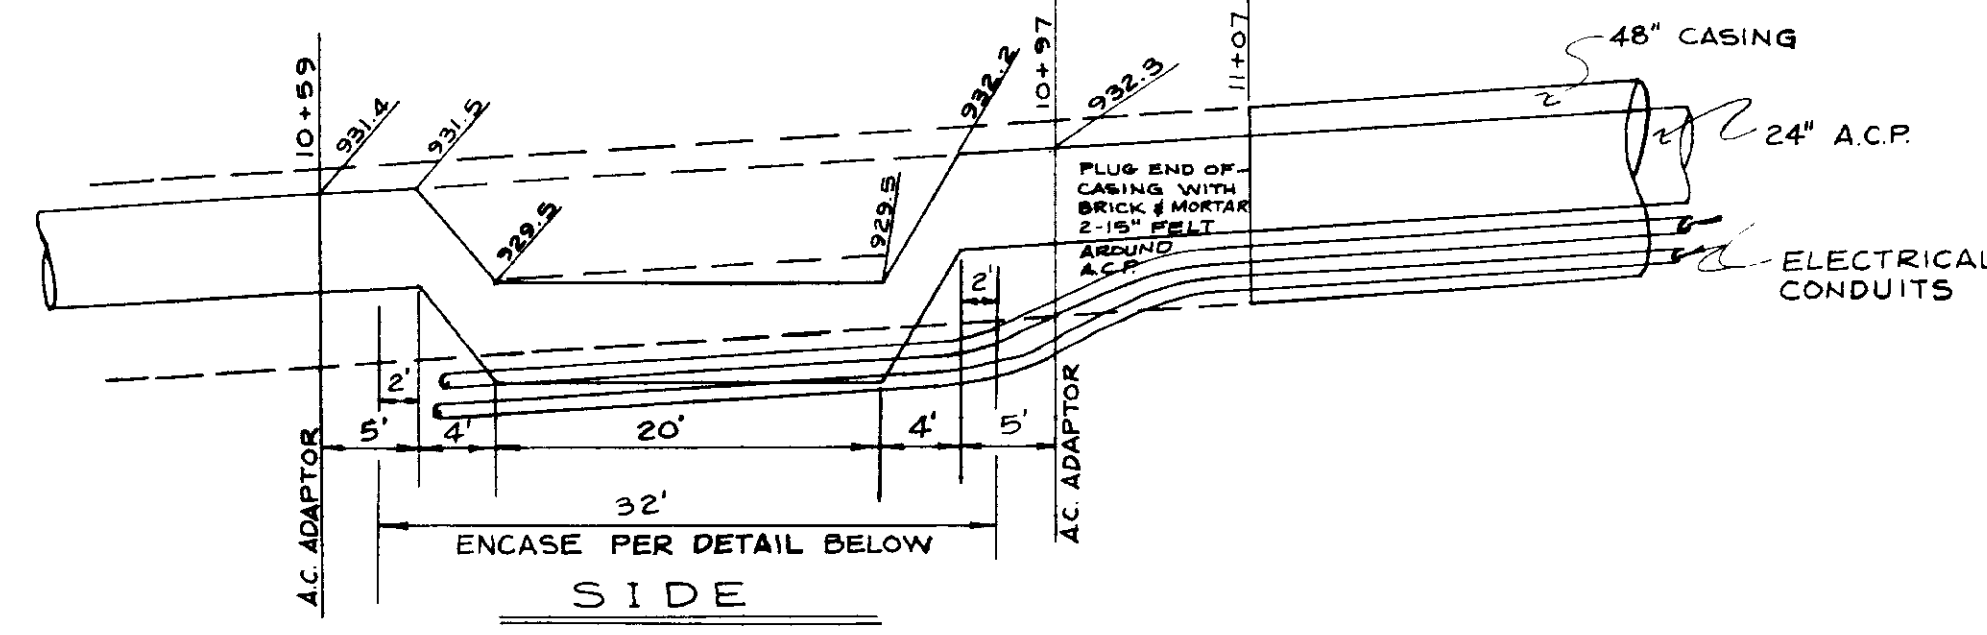

**LVMWD
FILE DRAWING
VERIFY HORIZONTAL AND
VERTICAL LOCATION OF
PIPELINES BEFORE CONSTRUCTION.**

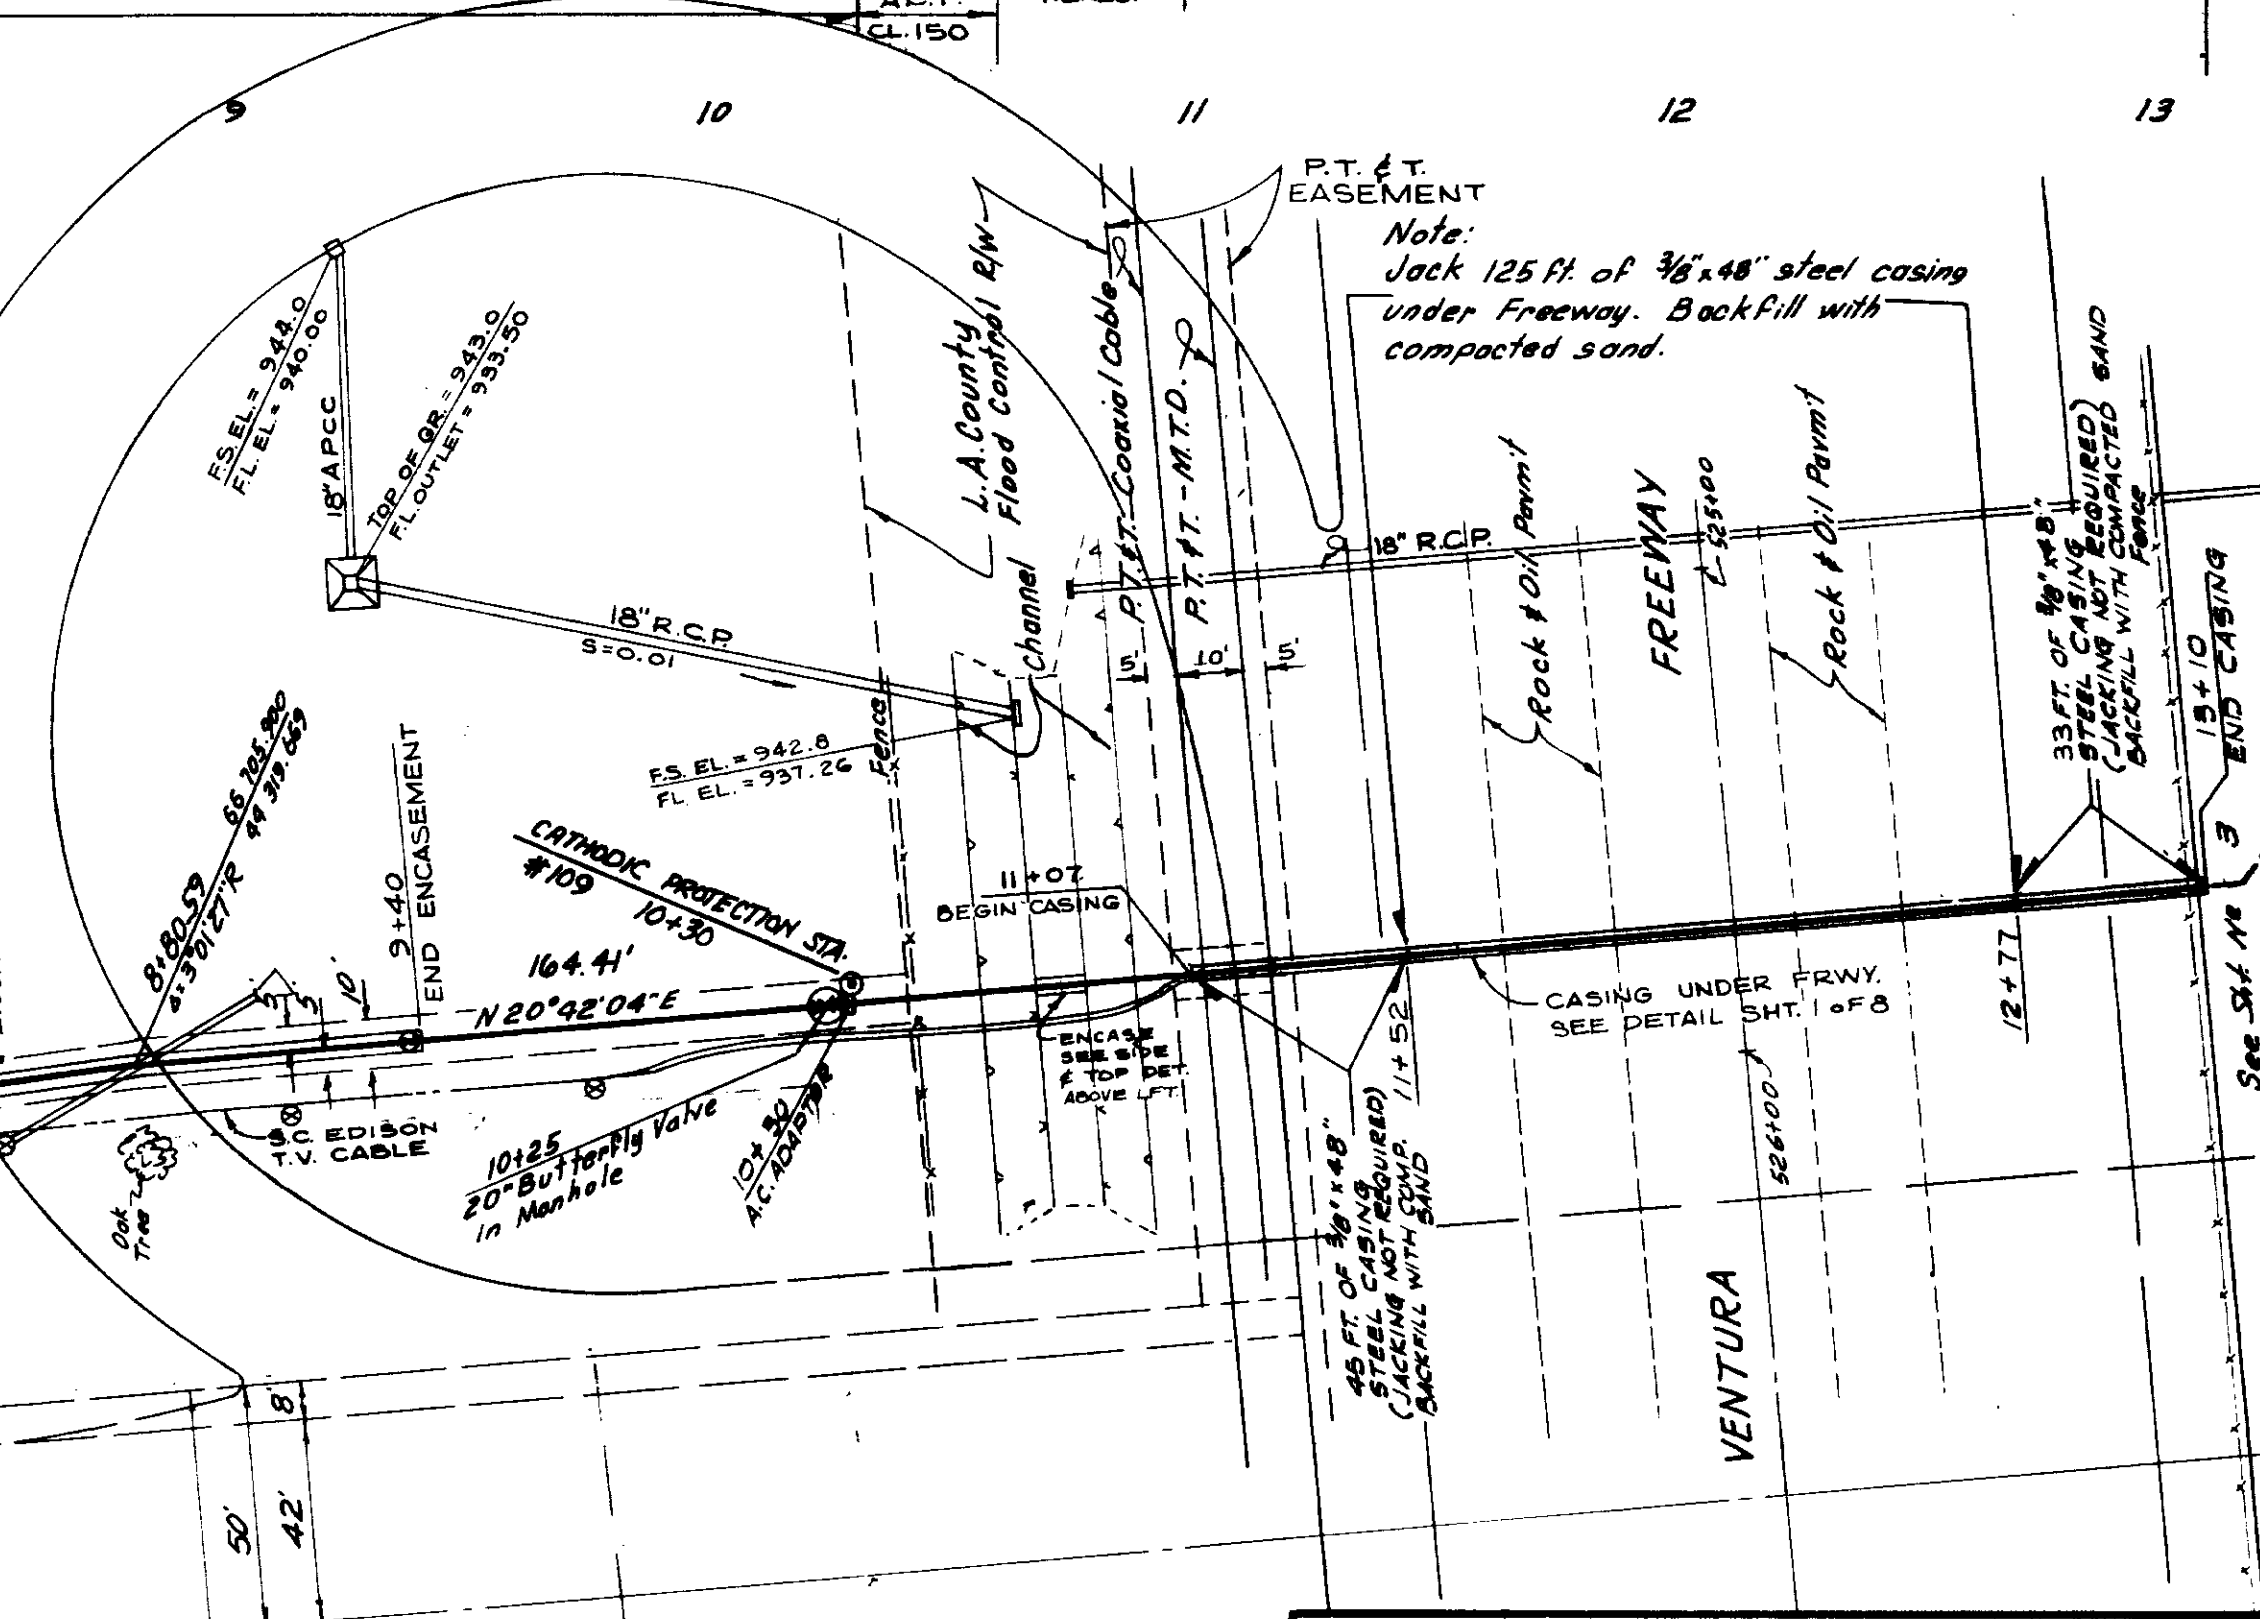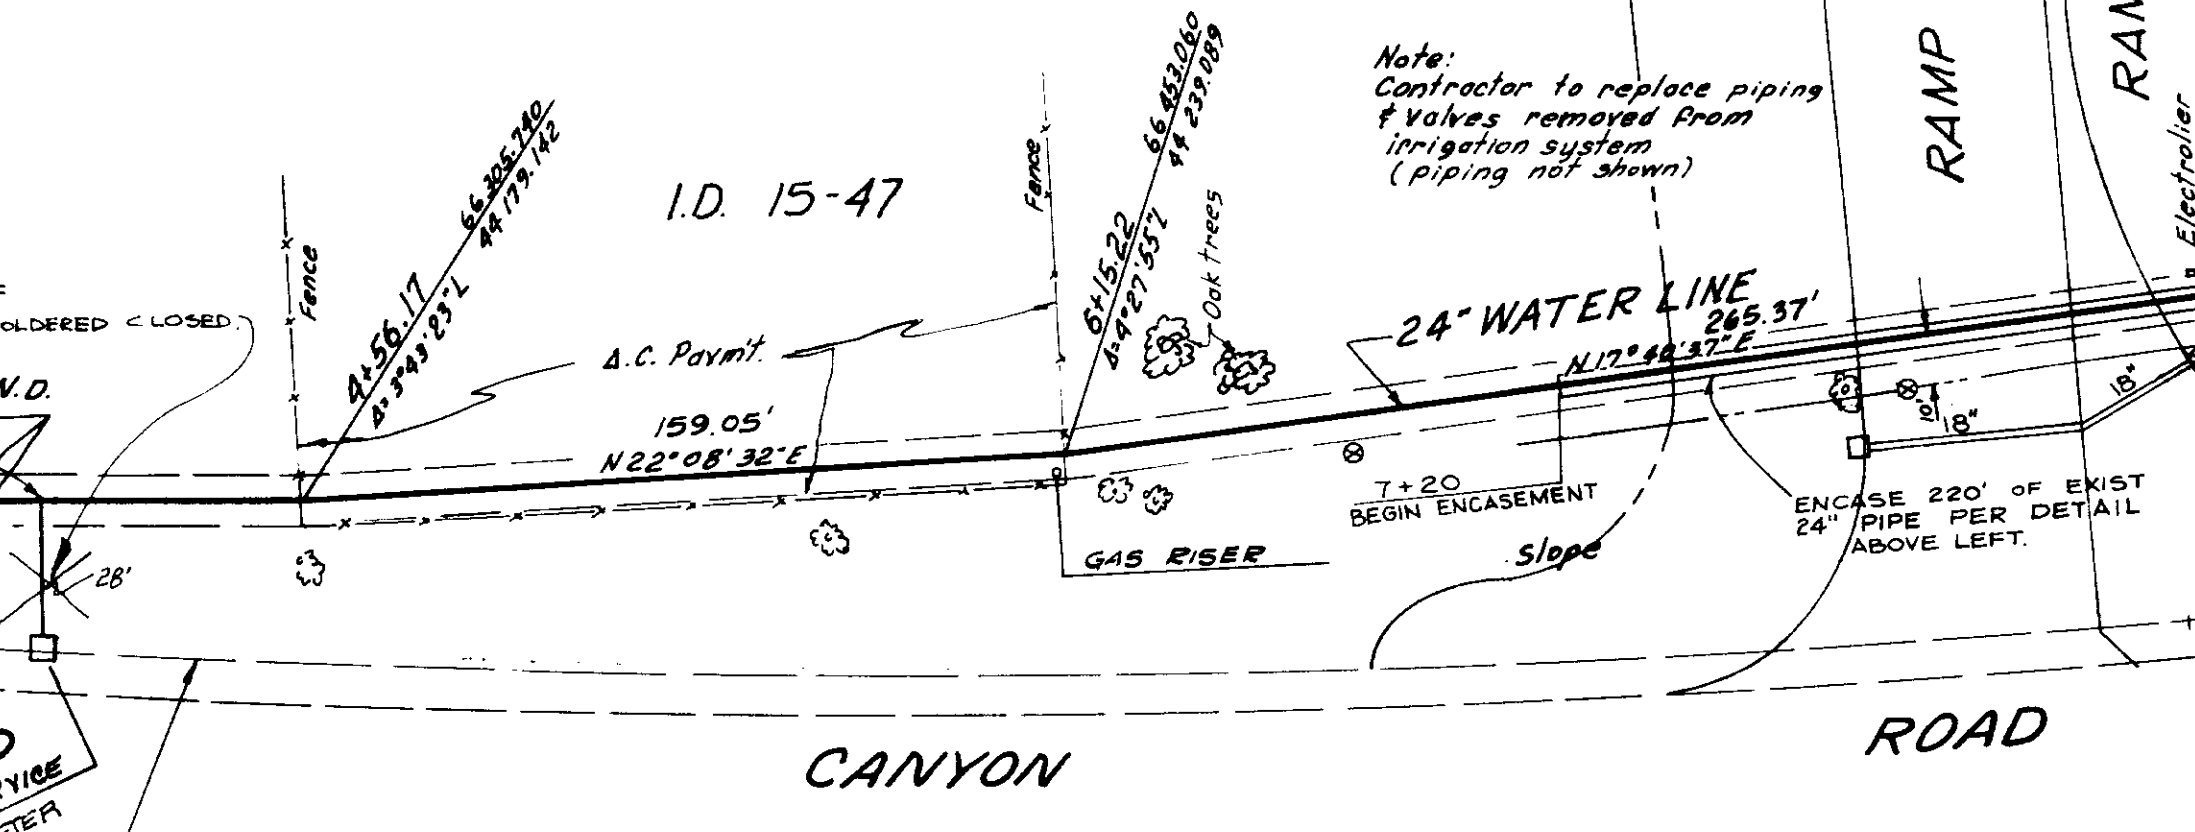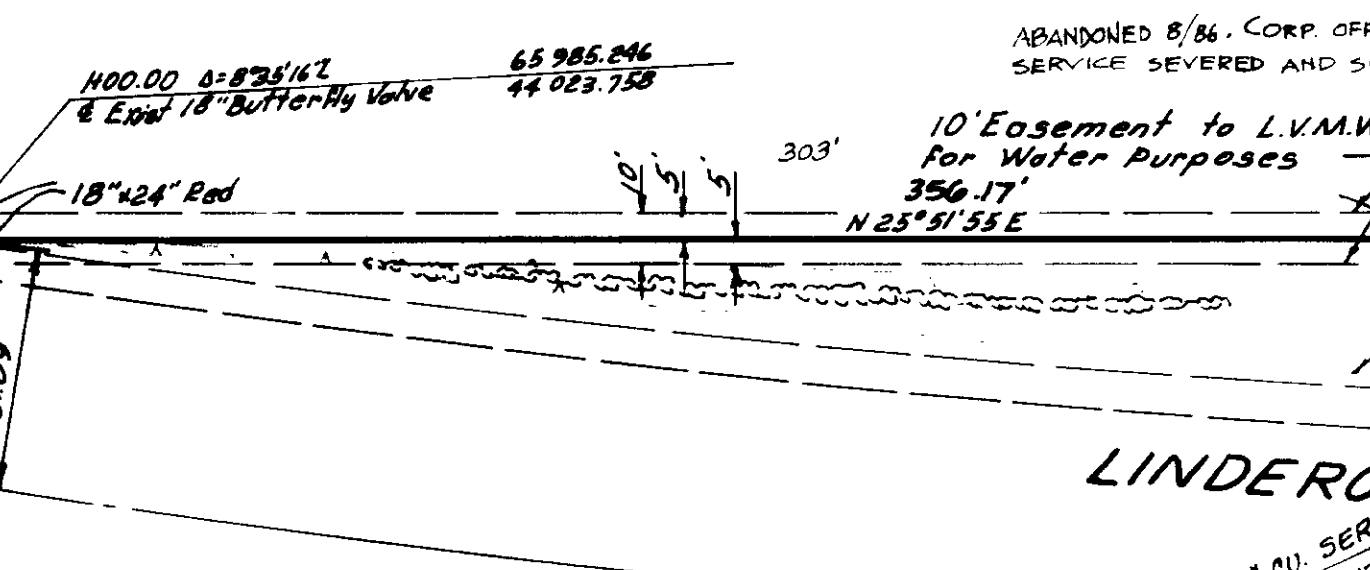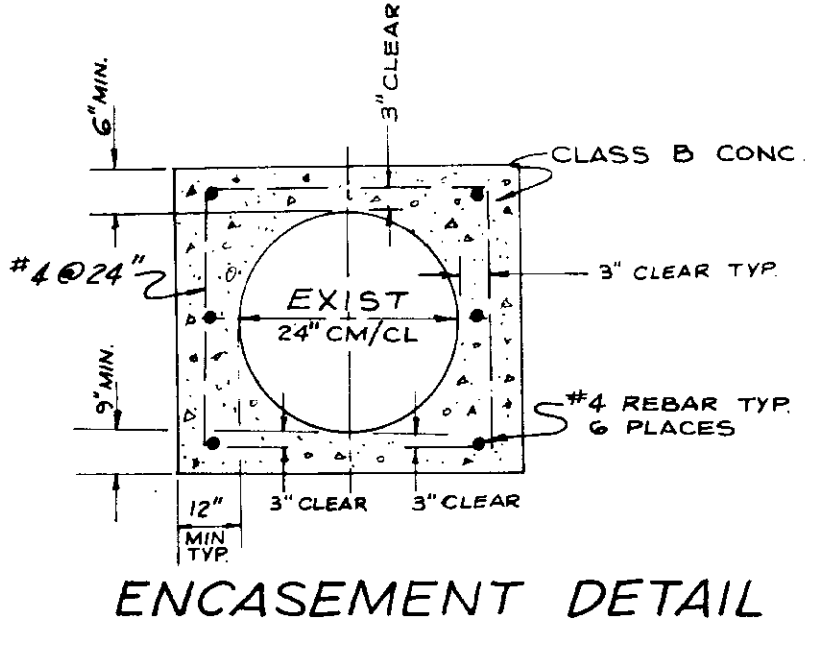

**PLAN OF
RECORD
10-23-68**

DATE: 1/19/78 REVISED TO SHOW FRWY RAMP AND ENCASEMENT DETAILS BY: [Signature] APP: [Signature]

McINTIRE & QUIROS INC. 670 MONTEREY PASS RD. MONTEREY PARK, CALIF. 92151
 BY: [Signature] P.E. NO. 13810
**LAS VIRGENES
MUNICIPAL WATER DISTRICT**
LINDERO CANYON - T.O. BLVD.

DESIGN	APPROVED FOR LAS VIRGENES MUNICIPAL WATER DISTRICT
DRAWN	APPROVED
DATE	GENERAL MGR. CHIEF ENGR.
SCALE	DATE
	SHEET 2 OF 8 SHEETS