


**SITE MAP**

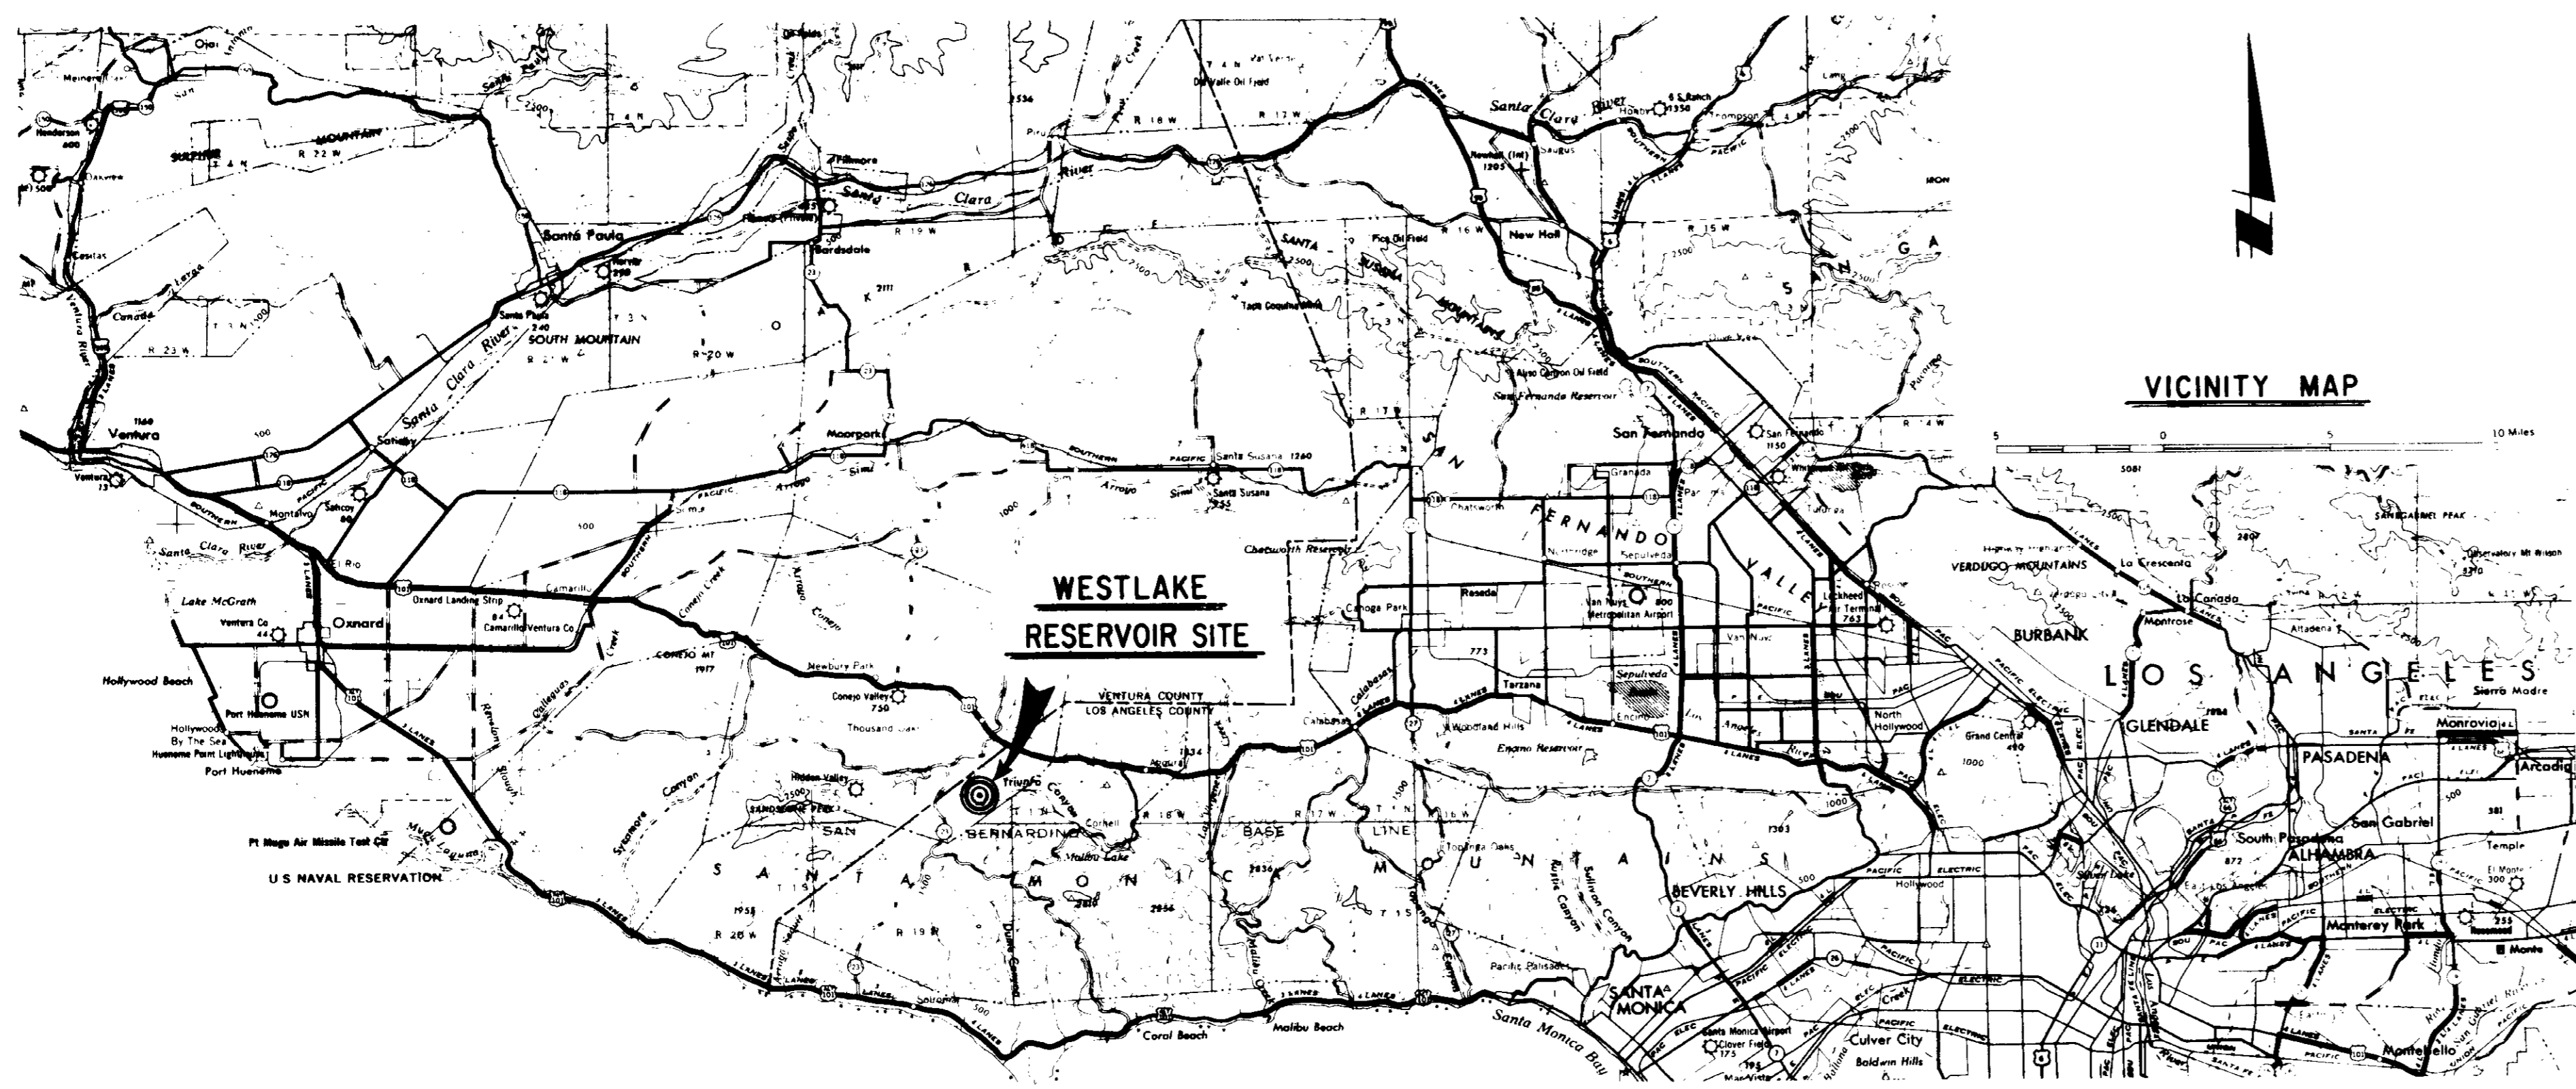

**VICINITY MAP**

**DRAWING LIST**

DRWG. NO.	TITLE	DRWG. NO.	TITLE
<b>GENERAL</b>			
1	Title Sheet	23	General Layout
2	Index Maps, Drawing List	23A	Excavated Foundation - Geologic Map
3	Reservoir Plan	24	Sections
3A	Monitoring Monuments Plan	<b>INTAKE-OUTLET CONDUIT</b>	
4	Horizontal Control Lines	25	Plan and Profile - Sheet 1 of 2
<b>SUBSURFACE EXPLORATION</b>			
5	Location of Exploration	26	Plan and Profile - Sheet 2 of 2
6	Geology, Logs of Exploration - Sheet 1 of 5	26A	Reinforcing Details
7	Geology, Logs of Exploration - Sheet 2 of 5	27	Details - Sheet 1 of 2
8	Geology, Logs of Exploration - Sheet 3 of 5	28	Details - Sheet 2 of 2
9	Geology, Logs of Exploration - Sheet 4 of 5	29	Log Boom
10	Geology, Logs of Exploration - Sheet 5 of 5	<b>SPILLWAY</b>	
11	Borrow Areas for Riprap & Zones 4 & 5	30	General Layout
12	Borrow Areas, Logs of Exploration - Sheet 1 of 2	31	Excavation
13	Borrow Areas, Logs of Exploration - Sheet 2 of 2	32	Concrete Outlines
14	Zone 1 Borrow Area, Plan and Logs of Exploration	33	Reinforcing - Sheet 1 of 2
15	Zone 1 Borrow Area, Logs of Exploration - Sheet 1 of 2	34	Reinforcing - Sheet 2 of 2
16	Zone 1 Borrow Area, Logs of Exploration - Sheet 2 of 2	35	Trash Barrier Details
<b>MAIN EMBANKMENT</b>			
17	General Layout		
17A	Excavated Foundation - Geologic Map		
18	Sections - Sheet 1 of 2		
19	Sections - Sheet 2 of 2		
20	Longitudinal Profiles Index - Grout Curtain Summary		
20A	Grout Hole Locations - Sheet 1 of 2		
20B	Grout Hole Locations - Sheet 2 of 2		
20C	Grout Curtain Summary - Sheet 1 of 9		
20D	Grout Curtain Summary - Sheet 2 of 9		
20E	Grout Curtain Summary - Sheet 3 of 9		
20F	Grout Curtain Summary - Sheet 4 of 9		
20G	Grout Curtain Summary - Sheet 5 of 9		
20H	Grout Curtain Summary - Sheet 6 of 9		
20I	Grout Curtain Summary - Sheet 7 of 9		
20J	Grout Curtain Summary - Sheet 8 of 9		
20K	Grout Curtain Summary - Sheet 9 of 9		
21	Details - Sheet 1 of 2		
22	Details - Sheet 2 of 2		

05250

**AS CONSTRUCTED**  
DATE 4/5/73 DFT H.H.R. CKD D.F.M.



ISSUED FOR CONSTRUCTION  
NO. DATE REVISIONS BY CHK. JOB PROJ. ENGR. ENGR. MGR.

**LAS VIRGENES MUNICIPAL WATER DISTRICT**

BOYLE ENGINEERING  
W. A. WAHLER & ASSOCIATES

WESTLAKE RESERVOIR  
**INDEX MAPS**  
**DRAWING LIST**


DESIGNED A.U.	DATE: 11-70	JOB: D.F.M.	PROJ. ENGR.:
DRAWN A.U.	CHECKED D.F.M.	R. C. E. 1988	DRAWING NUMBER: 2
SCALE AS SHOWN			REV.:

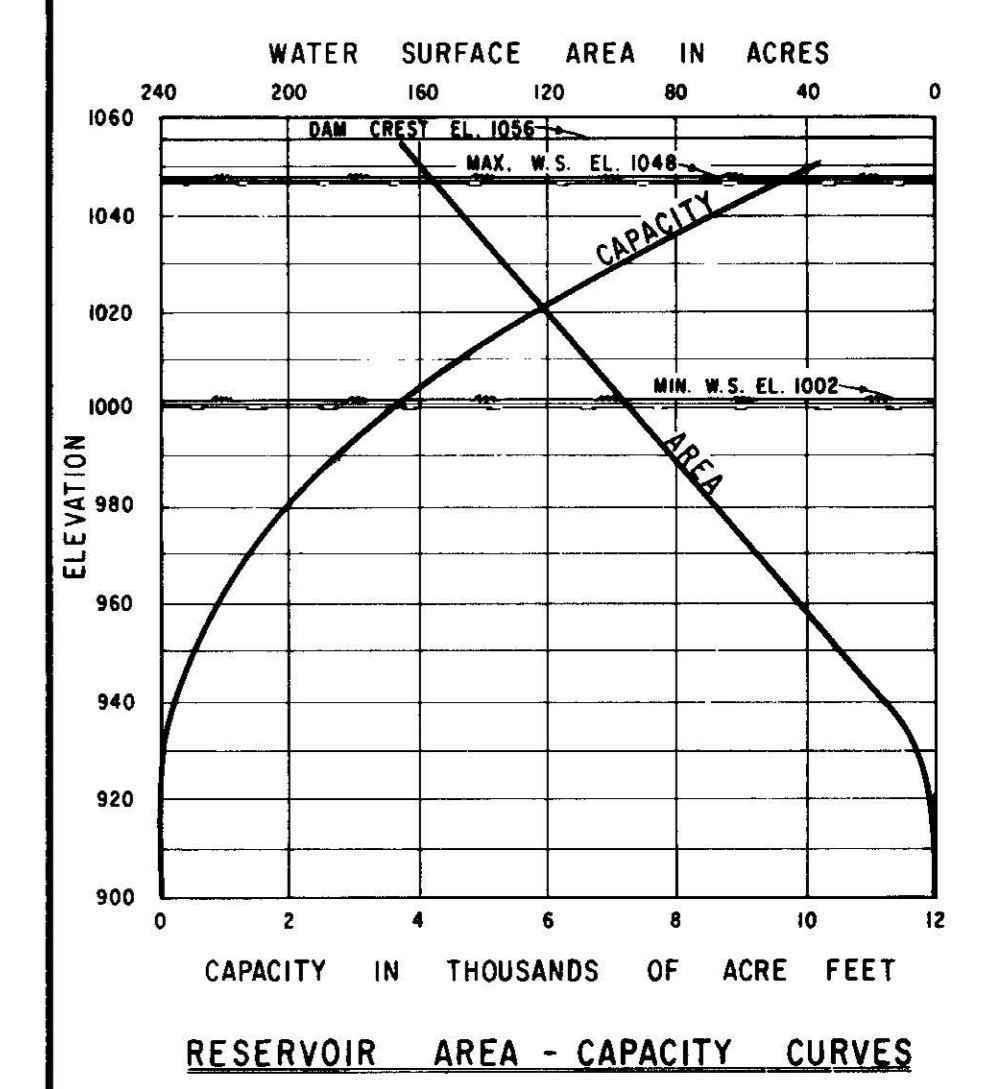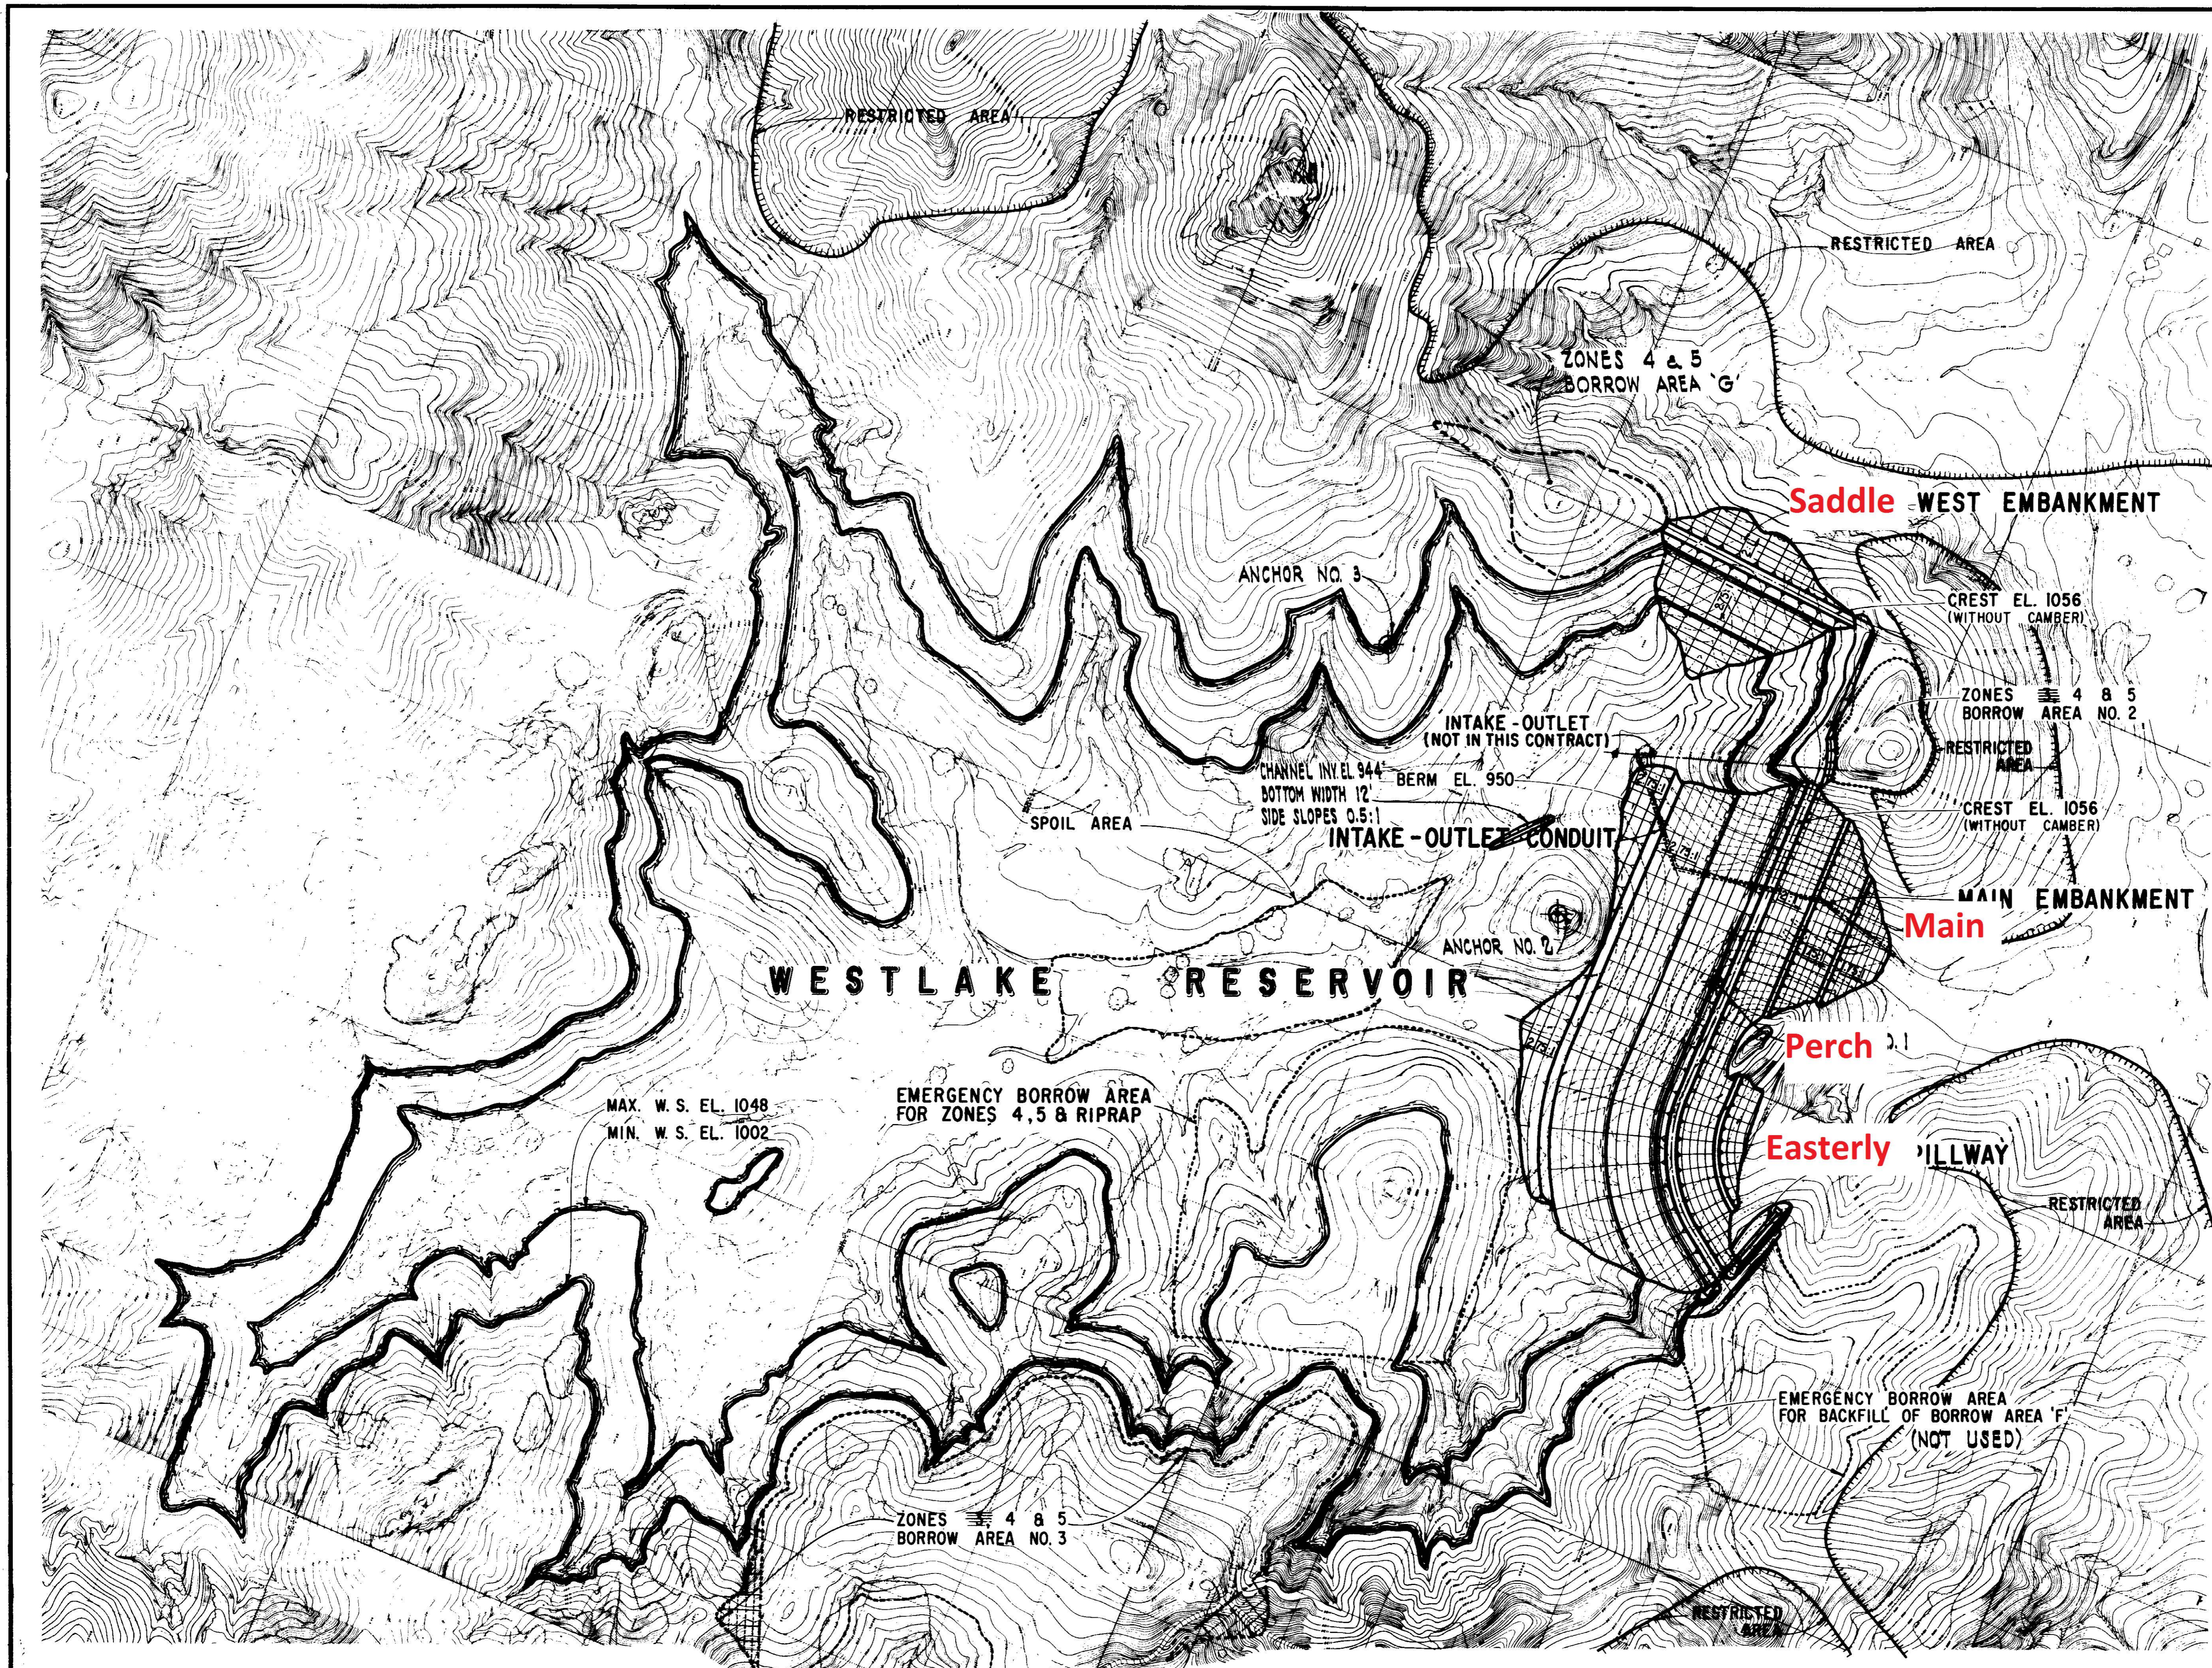

**NOTES**

1. Contractor shall not operate equipment of any kind within the designated restricted areas, or otherwise disturb the natural features, including trees, brush, ground cover and rock formations.

**AS CONSTRUCTED**  
 DATE 4/5/75 DFT H.N.R. CKD D.F.M.

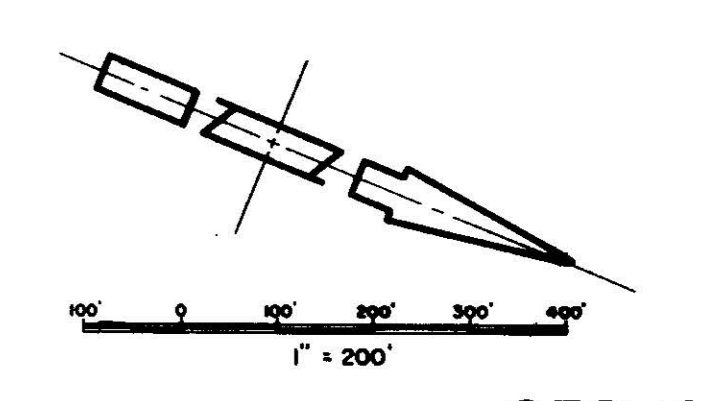

**05251**

NO.	DATE	REVISIONS	BY	CHK	JOB	PROJ.	ENCL.	NO.

**LAS VIRGENES MUNICIPAL WATER DISTRICT**

BOYLE ENGINEERING  
 W. A. WAHLER & ASSOCIATES


WESTLAKE RESERVOIR

**RESERVOIR PLAN**

DESIGNED BY	DATE: 11-70	CHK: D.F.M.	PROJ. ENCL.:	NO.
DRAWN BY				
CHECKED BY				
SCALE AS SHOWN				

DRAWING NUMBER **3**



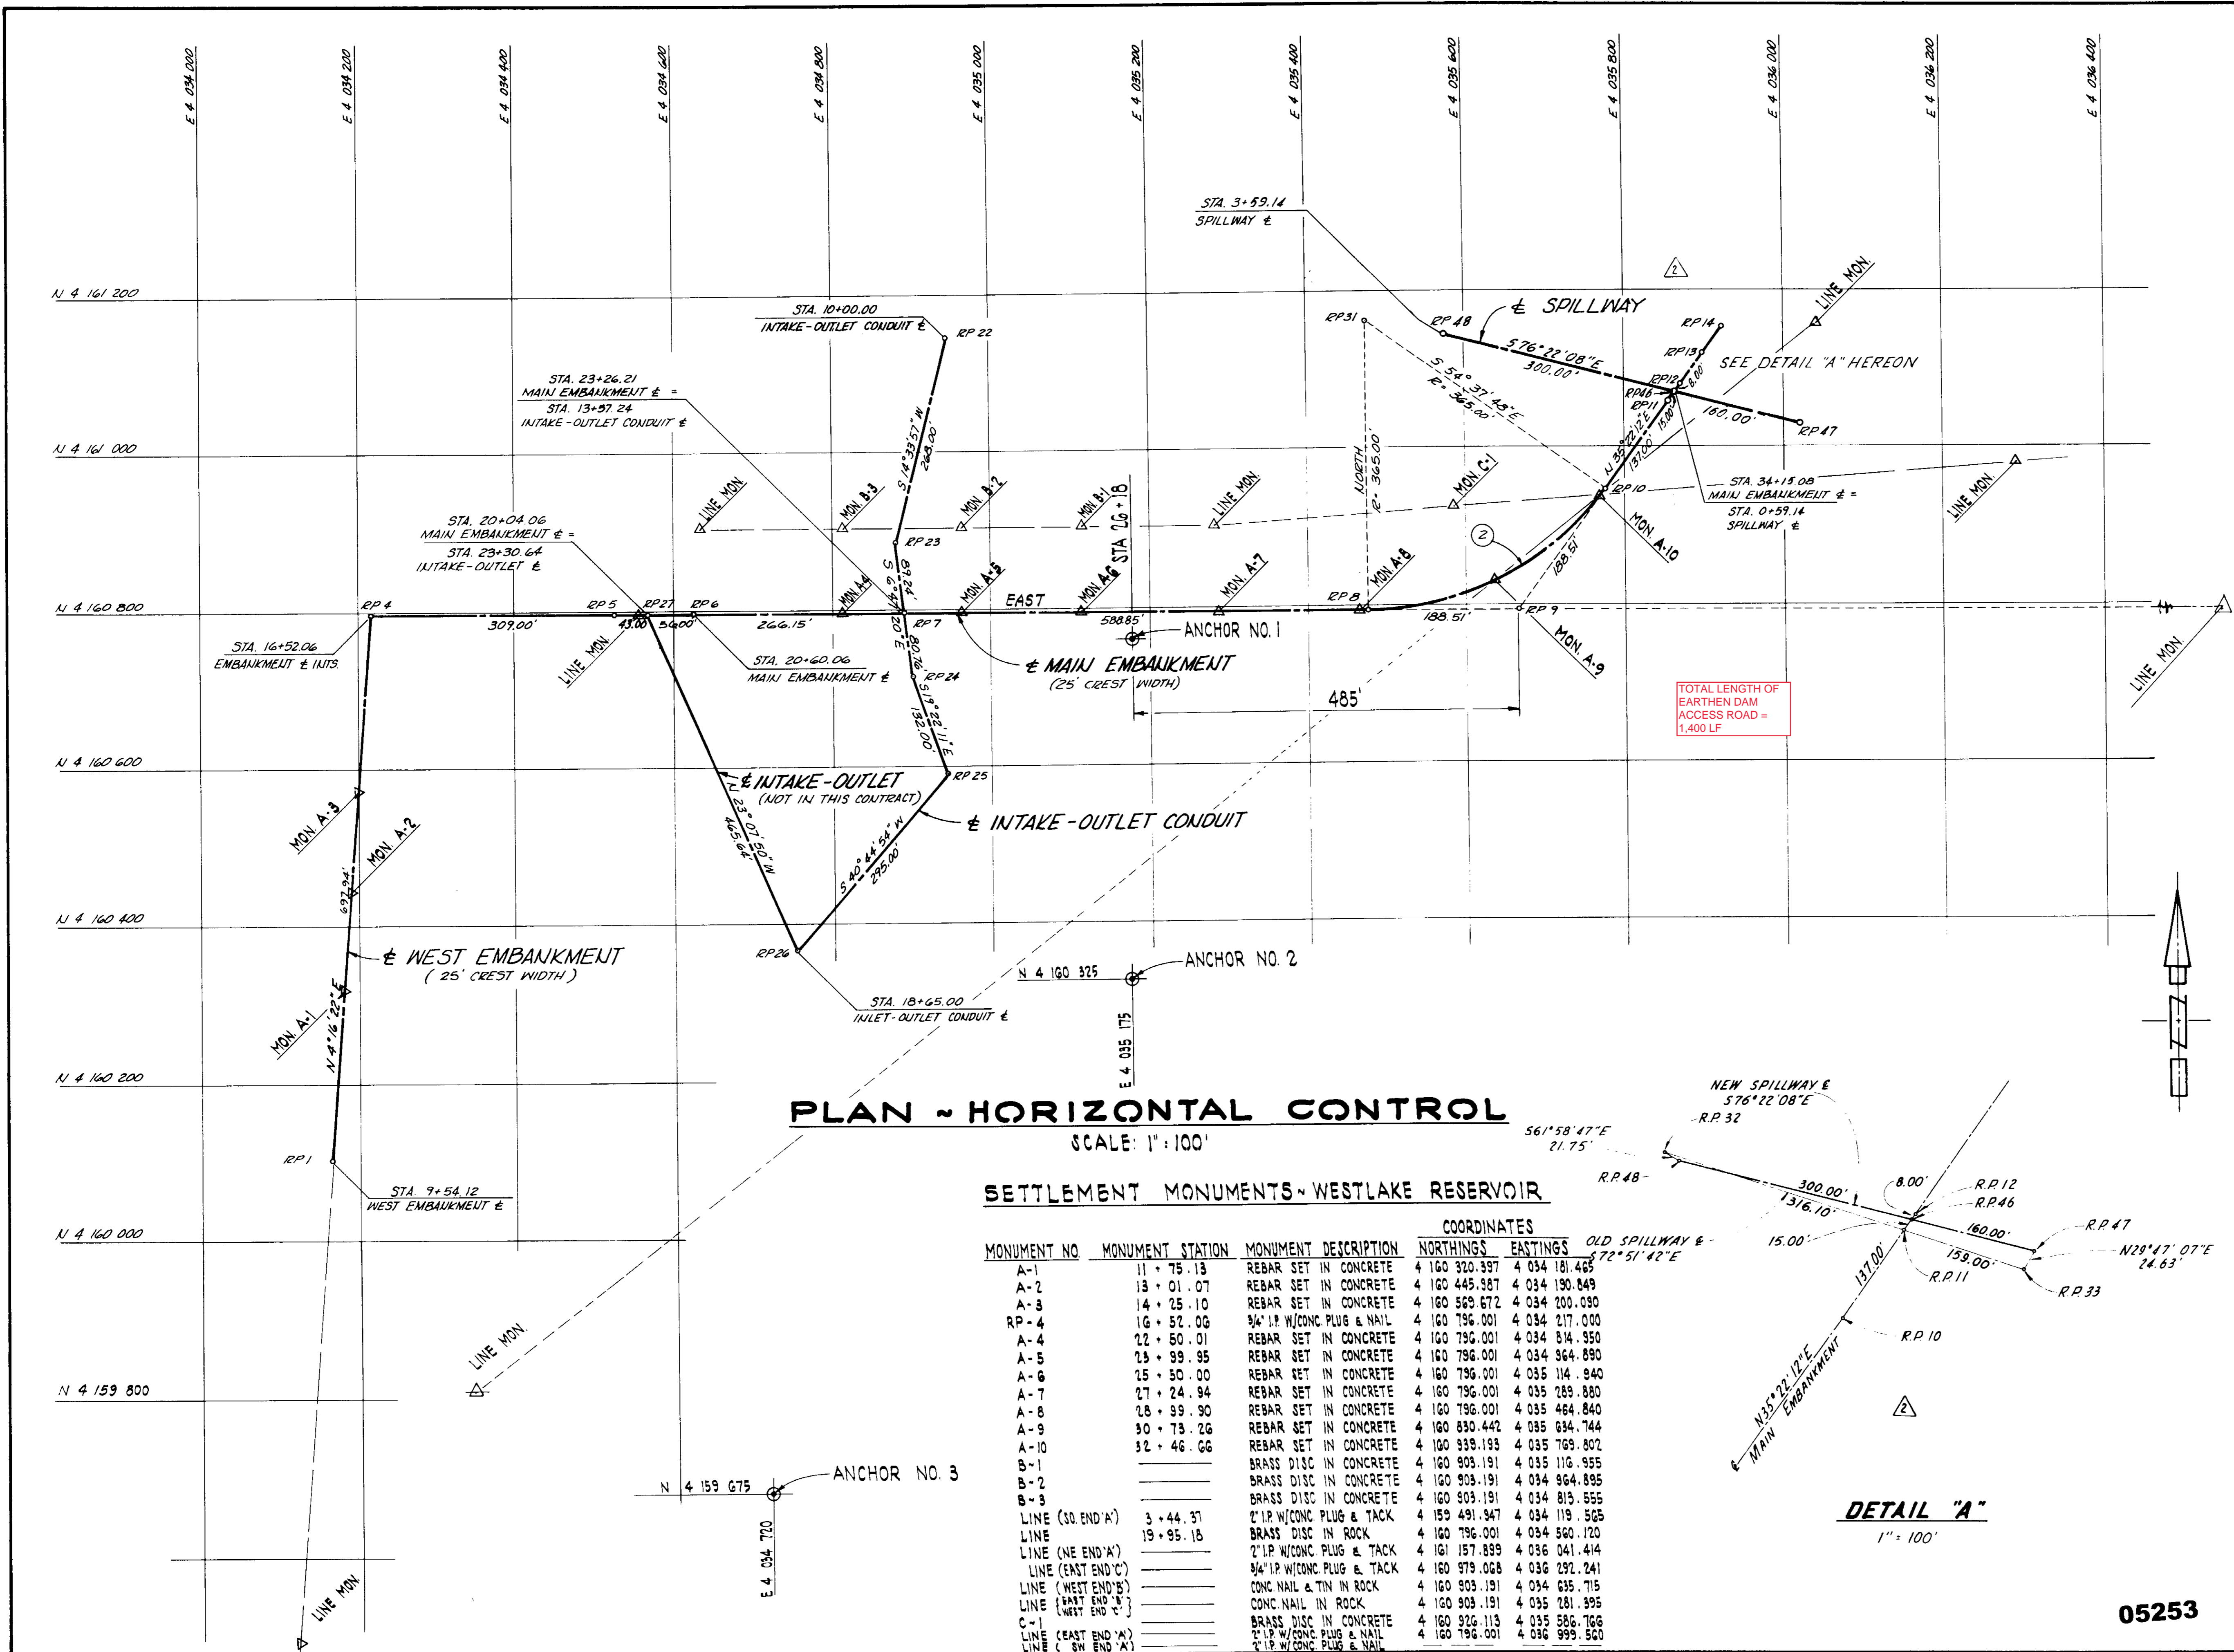


**PLAN - HORIZONTAL CONTROL**

SCALE: 1" = 100'

**SETTLEMENT MONUMENTS - WESTLAKE RESERVOIR**

MONUMENT NO	MONUMENT STATION	MONUMENT DESCRIPTION	COORDINATES	
			NORTHINGS	EASTINGS
A-1	11 + 75.13	REBAR SET IN CONCRETE	4 160 320.397	4 034 181.465
A-2	13 + 01.07	REBAR SET IN CONCRETE	4 160 445.387	4 034 190.849
A-3	14 + 25.10	REBAR SET IN CONCRETE	4 160 569.672	4 034 200.090
RP-4	16 + 52.06	3/4" I.P. W/CONC. PLUG & NAIL	4 160 796.001	4 034 217.000
A-4	22 + 50.01	REBAR SET IN CONCRETE	4 160 796.001	4 034 814.950
A-5	23 + 99.95	REBAR SET IN CONCRETE	4 160 796.001	4 034 964.890
A-6	25 + 30.00	REBAR SET IN CONCRETE	4 160 796.001	4 035 114.940
A-7	27 + 24.94	REBAR SET IN CONCRETE	4 160 796.001	4 035 289.880
A-8	28 + 39.90	REBAR SET IN CONCRETE	4 160 796.001	4 035 464.840
A-9	30 + 73.26	REBAR SET IN CONCRETE	4 160 830.442	4 035 634.744
A-10	32 + 46.66	REBAR SET IN CONCRETE	4 160 939.193	4 035 769.802
B-1		BRASS DISC IN CONCRETE	4 160 903.191	4 035 116.955
B-2		BRASS DISC IN CONCRETE	4 160 903.191	4 034 964.895
B-3		BRASS DISC IN CONCRETE	4 160 903.191	4 034 813.555
LINE (SO. END 'A')	3 + 44.37	2" I.P. W/CONC. PLUG & TACK	4 159 491.947	4 034 119.565
LINE (NE END 'A')	19 + 95.18	BRASS DISC IN ROCK	4 160 796.001	4 034 560.120
LINE (EAST END 'A')		2" I.P. W/CONC. PLUG & TACK	4 161 157.899	4 036 041.414
LINE (WEST END 'B')		3/4" I.P. W/CONC. PLUG & TACK	4 160 979.068	4 036 292.241
LINE (WEST END 'C')		CONC. NAIL & TIN IN ROCK	4 160 903.191	4 034 635.715
LINE (EAST END 'C')		CONC. NAIL IN ROCK	4 160 903.191	4 035 281.395
C-1		BRASS DISC IN CONCRETE	4 160 923.113	4 035 586.766
LINE (EAST END 'A')		2" I.P. W/CONC. PLUG & NAIL	4 160 796.001	4 036 999.560
LINE (SO. END 'A')		2" I.P. W/CONC. PLUG & NAIL		

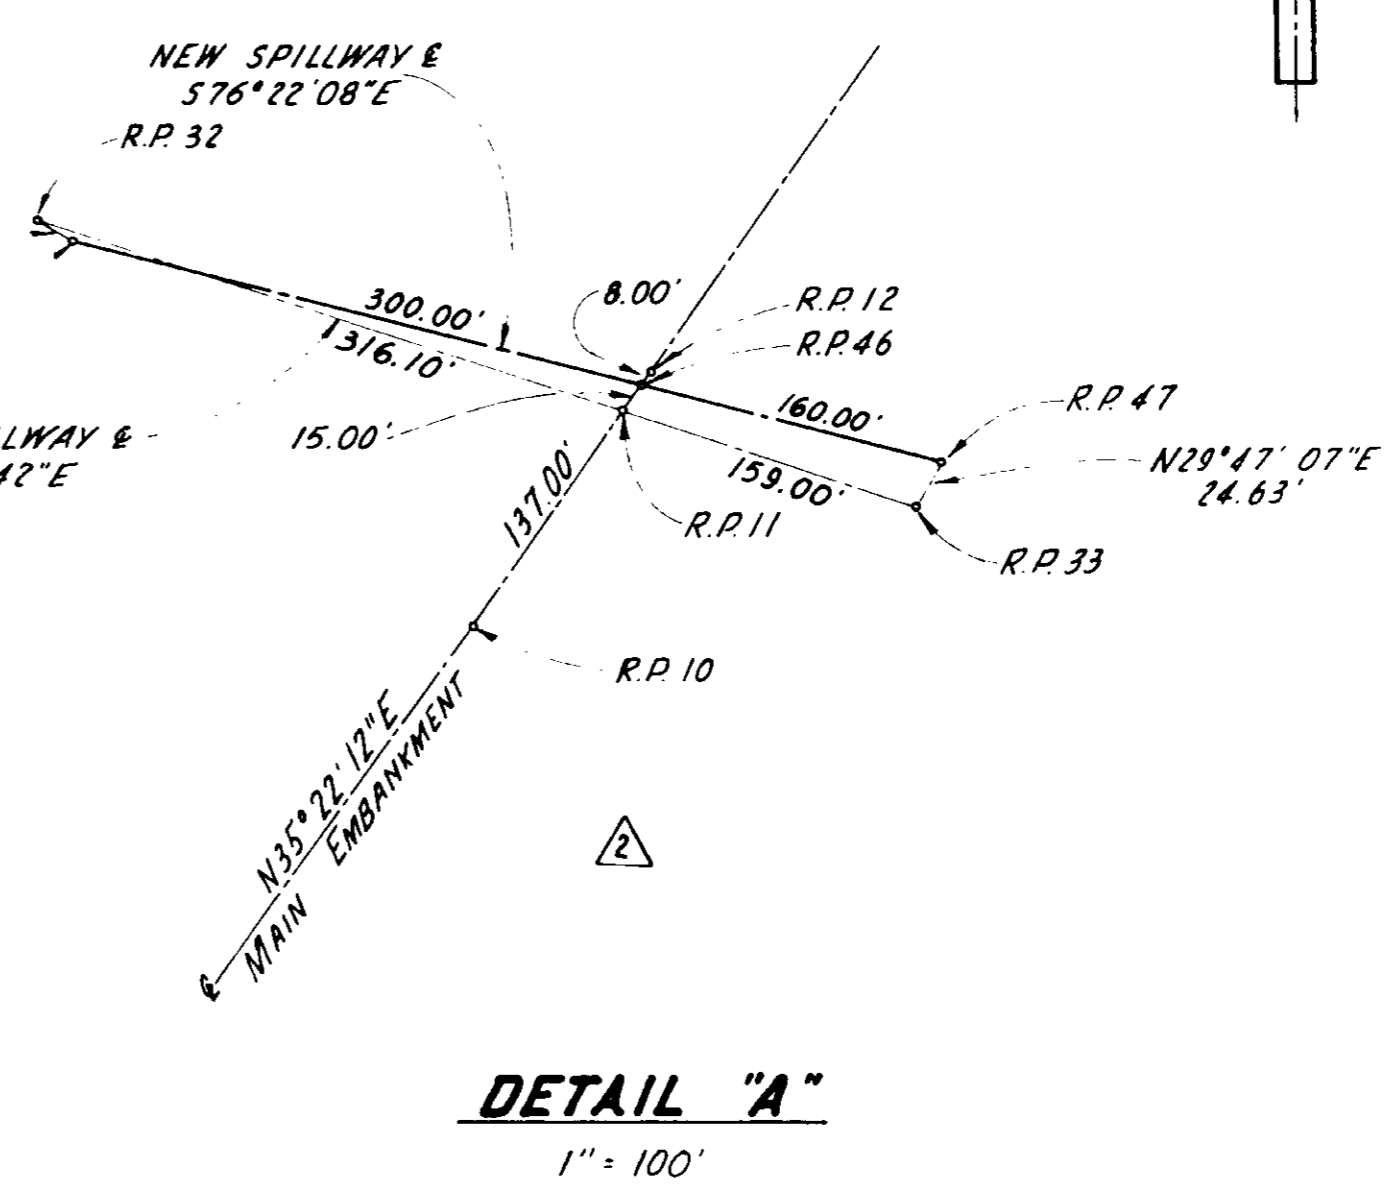


**TABLE OF REFERENCE POINTS**

R.P. NO.	COORDINATES	
	NORTHINGS	EASTINGS
1	4 160 100.000	4 034 165.000
2	4 160 270.396	4 034 183.782
3	4 160 478.163	4 034 225.937
4	4 160 796.001	4 034 217.000
5	4 160 796.001	4 034 526.000
6	4 160 796.001	4 034 625.000
7	4 160 796.001	4 034 891.149
8	4 160 796.001	4 035 479.998
9	4 160 796.001	4 035 628.510
10	4 160 949.720	4 035 777.631
11	4 161 061.434	4 035 856.934
12	4 161 080.189	4 035 870.248
13	4 161 119.214	4 035 897.951
14	4 161 153.576	4 035 972.345
15	4 160 281.099	4 034 101.458
16	4 160 253.693	4 034 266.105
17	4 160 218.895	4 034 437.610
18	4 160 461.469	4 034 308.160
19	4 160 386.893	4 034 675.771
20	4 160 769.206	4 034 525.000
21	4 160 596.001	4 034 825.000
22	4 161 144.000	4 034 948.000
23	4 160 884.614	4 034 860.600
24	4 160 715.806	4 034 900.696
25	4 160 591.217	4 034 944.475
26	4 160 367.190	4 034 151.918
27	4 160 196.001	4 034 569.000
28	4 160 522.699	4 035 894.891
29	4 160 958.438	4 036 192.641
30	4 161 000.001	4 036 220.934
31	4 161 161.001	4 035 479.998
32	4 161 154.582	4 035 554.070
33	4 161 014.580	4 036 008.074
34	4 161 058.482	4 035 900.027
35	4 161 082.981	4 035 929.210
36	4 161 143.413	4 035 999.248
37	4 161 022.745	4 035 981.629
38	4 161 025.898	4 036 049.167
39	4 161 076.548	4 036 066.341
40	4 161 120.713	4 036 135.238
41	4 161 036.859	4 036 081.975
42	4 161 038.982	4 036 139.413
43	4 161 043.701	4 036 231.793
44	4 160 993.144	4 036 141.755
45	4 160 967.282	4 036 179.674
46	4 161 073.665	4 035 865.617
47	4 161 035.958	4 036 021.110
48	4 161 144.366	4 035 574.067

**CURVE DATA**

CURVE NUMBER
①
Δ = 54° 31' 48"
R = 365.000'
T = 188.512'
L = 348.018'

**AS CONSTRUCTED**  
DATE 4/5/73 DFT H.H.R. CKD D.T.M.

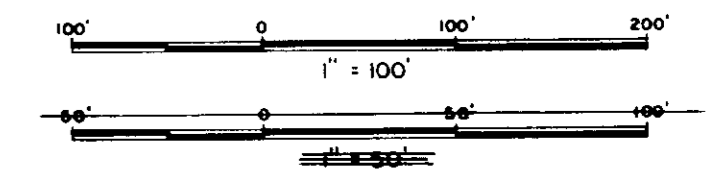

NO.	DATE	REVISIONS	BY	CHK	ENG.	PROJ. ENGR.	MGR.
1	11-70	ISSUED FOR CONSTRUCTION	W.R.				
2		REVISE SPILLWAY ALIGNMENT	H.H.R.				

**LAS VIRGENES MUNICIPAL WATER DISTRICT**

BOYLE ENGINEERING  
W. A. WAHLER & ASSOCIATES

WESTLAKE RESERVOIR

**HORIZONTAL CONTROL LINES**

DESIGNED BY: W.R. DATE: 11-70 JOB ENG. D.T.M. PROJ. ENG. W.A. WAHLER  
DRAWN BY: W.R. CHECKED BY: H.H.R. SCALE AS SHOWN  
DRAWING NUMBER: 4 REV.:

05253


**NOTES**

1. Additional exploratory borings and trenches, other than those shown on this drawing, have been made in the vicinity in connection with earlier investigations for a different site. Logs of such borings and trenches are not included in these plans and specifications.
2. Logs of trenches shown on this drawing are not included in these plans and specifications.

**KEY**

- ⊙ DIAMOND CORE BORING
- ⊙ SLANTED DIAMOND CORE BORING
- ▤ EXPLORATORY DOZER TRENCH

**SCALE**

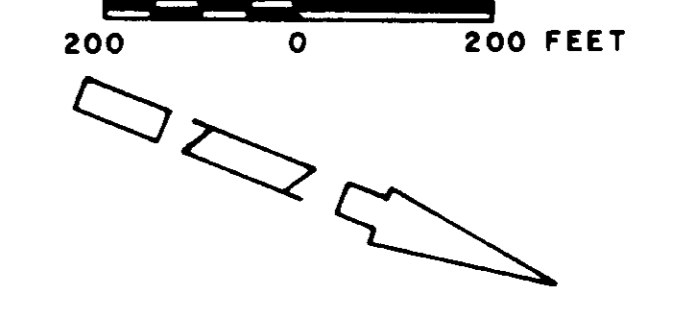



**REFERENCE DRAWINGS**

- 6 GEOLOGY, LOGS OF EXPLORATION - SHEET 1 OF 5
- 7 GEOLOGY, LOGS OF EXPLORATION - SHEET 2 OF 5
- 8 GEOLOGY, LOGS OF EXPLORATION - SHEET 3 OF 5
- 9 GEOLOGY, LOGS OF EXPLORATION - SHEET 4 OF 5
- 10 GEOLOGY, LOGS OF EXPLORATION - SHEET 5 OF 5
- 11 BORROW AREAS FOR RIPRAP AND ZONES 3, 4 & 5
- 12 ZONE 1 BORROW AREAS, LOGS OF EXPLORATION - SHEET 1 OF 2
- 13 ZONE 1 BORROW AREAS, LOGS OF EXPLORATION - SHEET 2 OF 2
- 14 ZONE 1 BORROW AREA 'F', PLAN AND LOGS OF EXPLORATION
- 15 ZONE 1 BORROW AREA, LOGS OF EXPLORATION - SHEET 1 OF 2
- 16 ZONE 1 BORROW AREA, LOGS OF EXPLORATION - SHEET 2 OF 2


**05254**

ISSUED FOR CONSTRUCTION		T.E.M. ENC. 8/27/70	
NO.	DATE	REVISIONS	BY CHK. ENCL. ENCL. MR.
<b>LAS VIRGENES MUNICIPAL WATER DISTRICT</b>			
BOYLE ENGINEERING W. A. WAHLER & ASSOCIATES			
WESTLAKE RESERVOIR			
<b>LOCATION OF EXPLORATION</b>			
DESIGNED D.H.	DATE: 11-70	JOB ENCL. C.W.P.	PROJ. ENCL. J.H.
DRAWN B.S.	CHECKED C.W.P. <i>R. Clayton</i>		DRAWING NUMBER
SCALE AS SHOWN			<b>5</b>

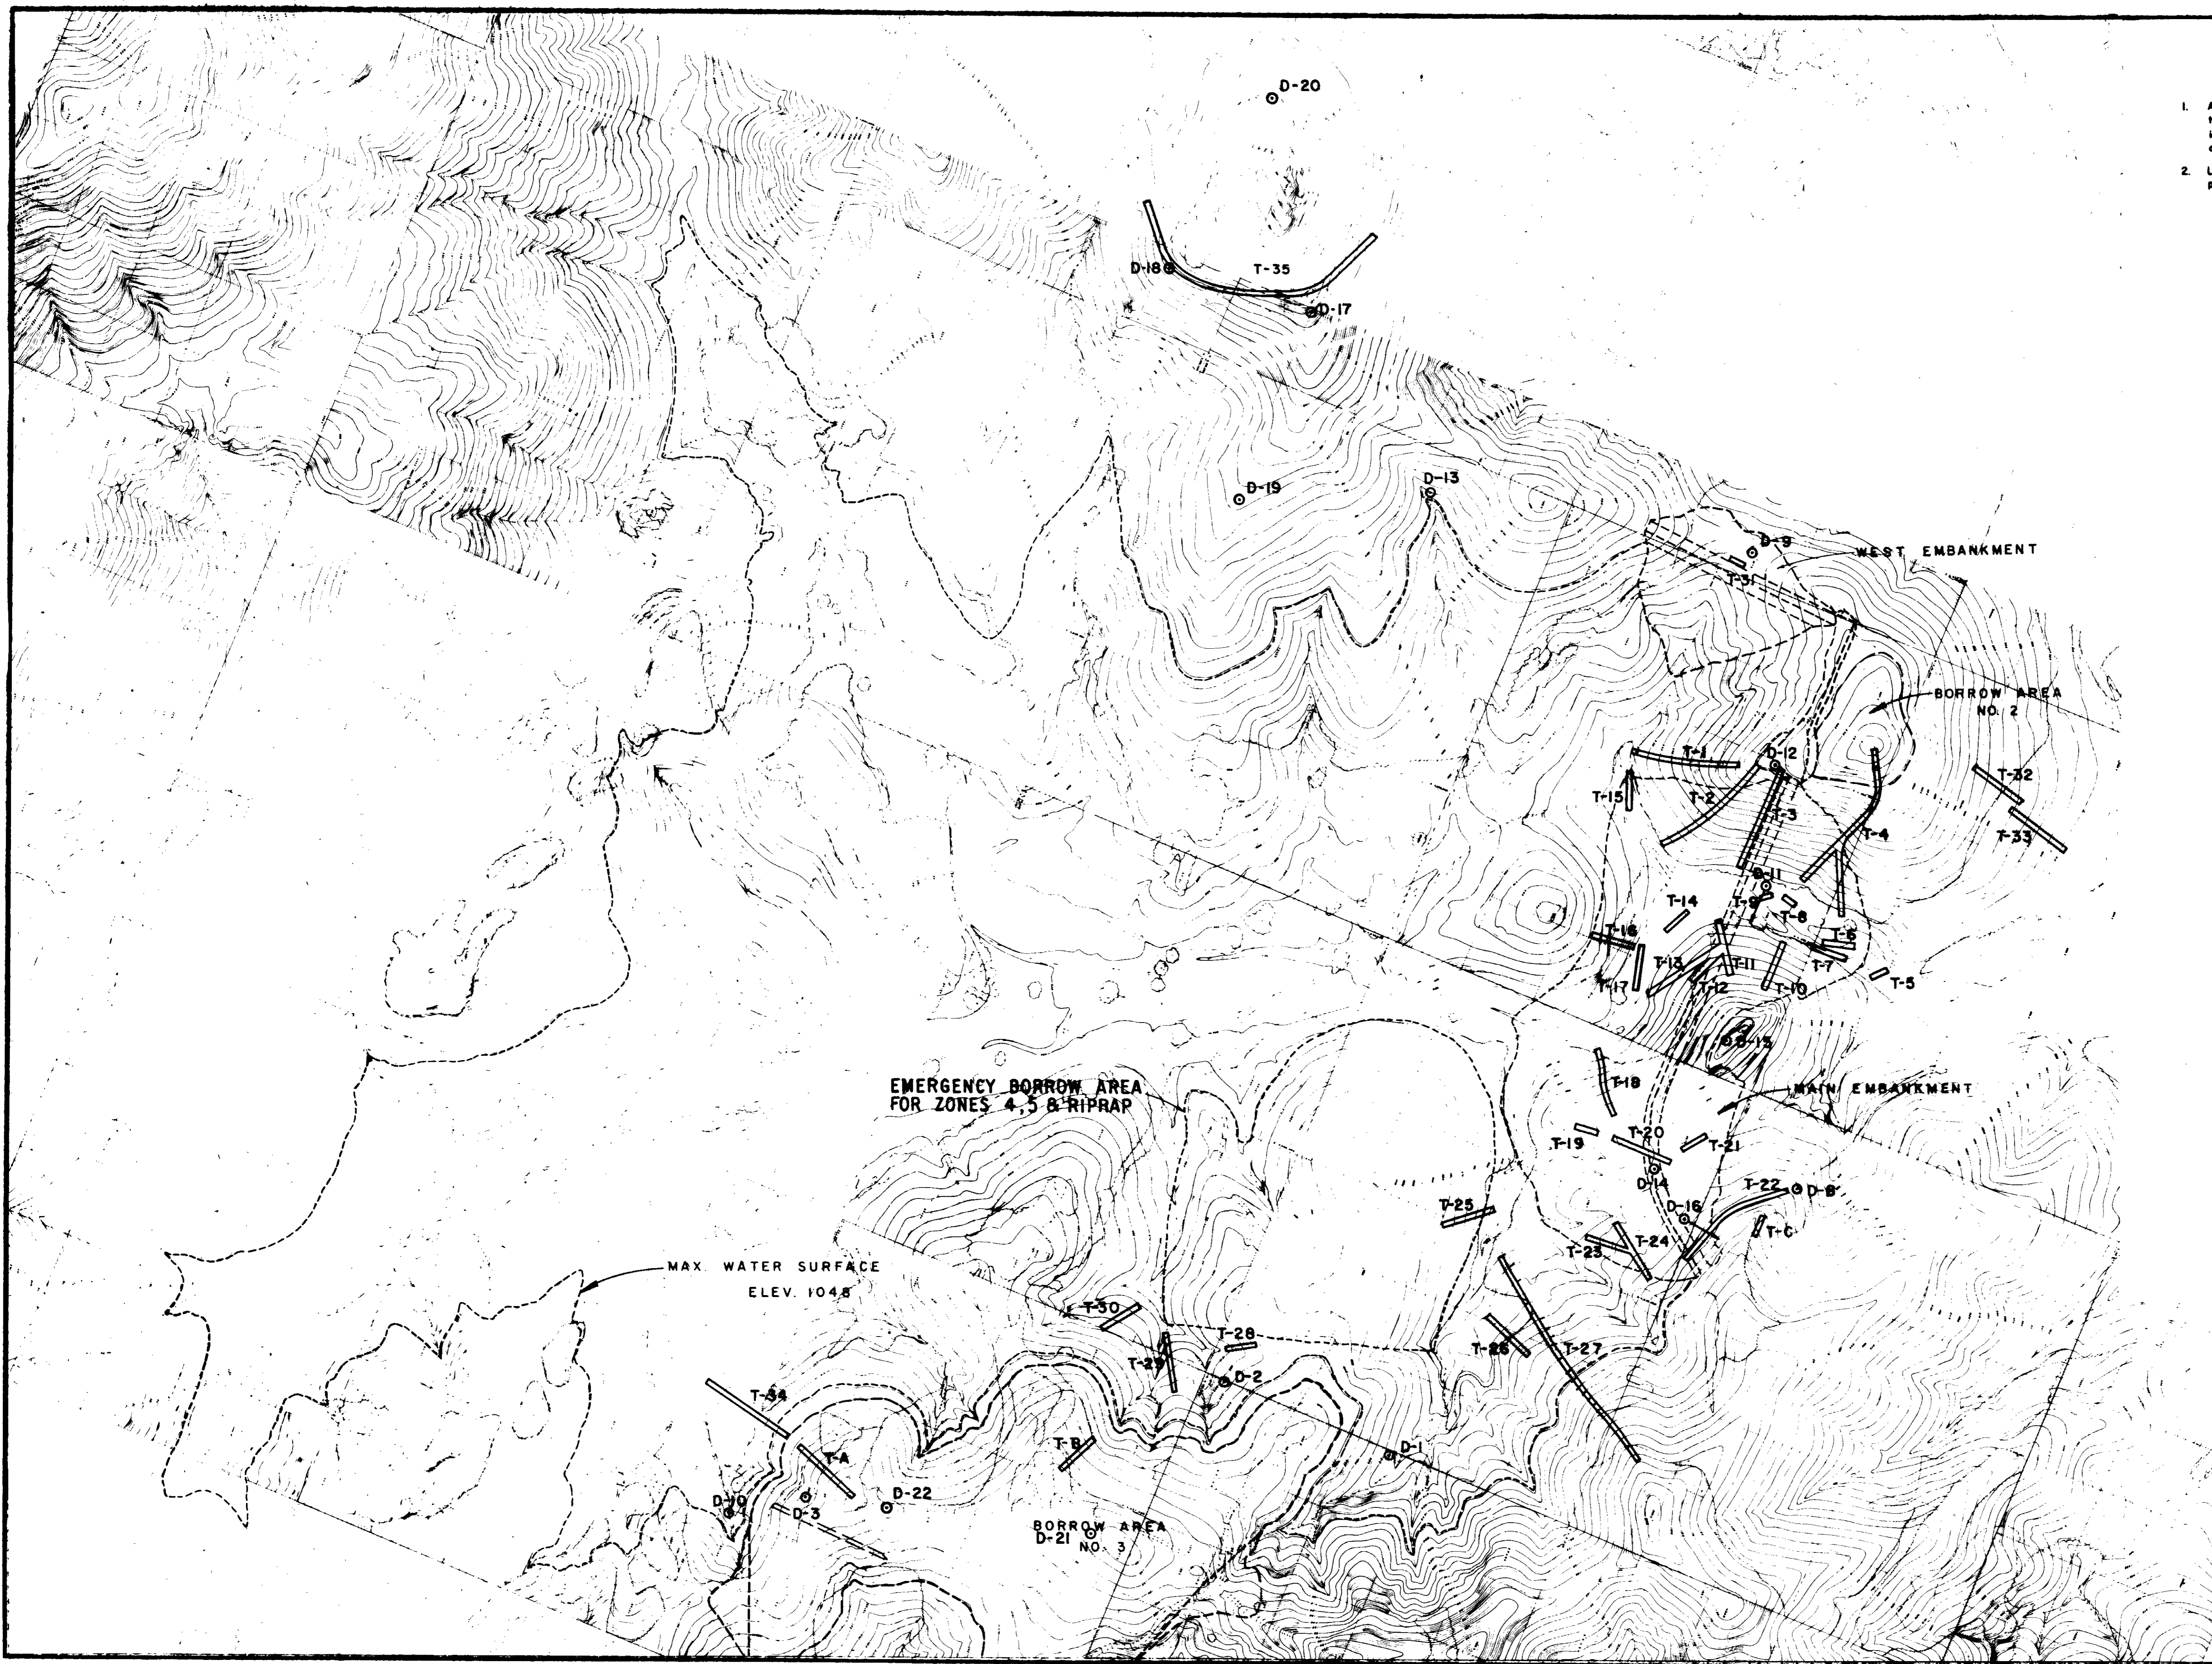


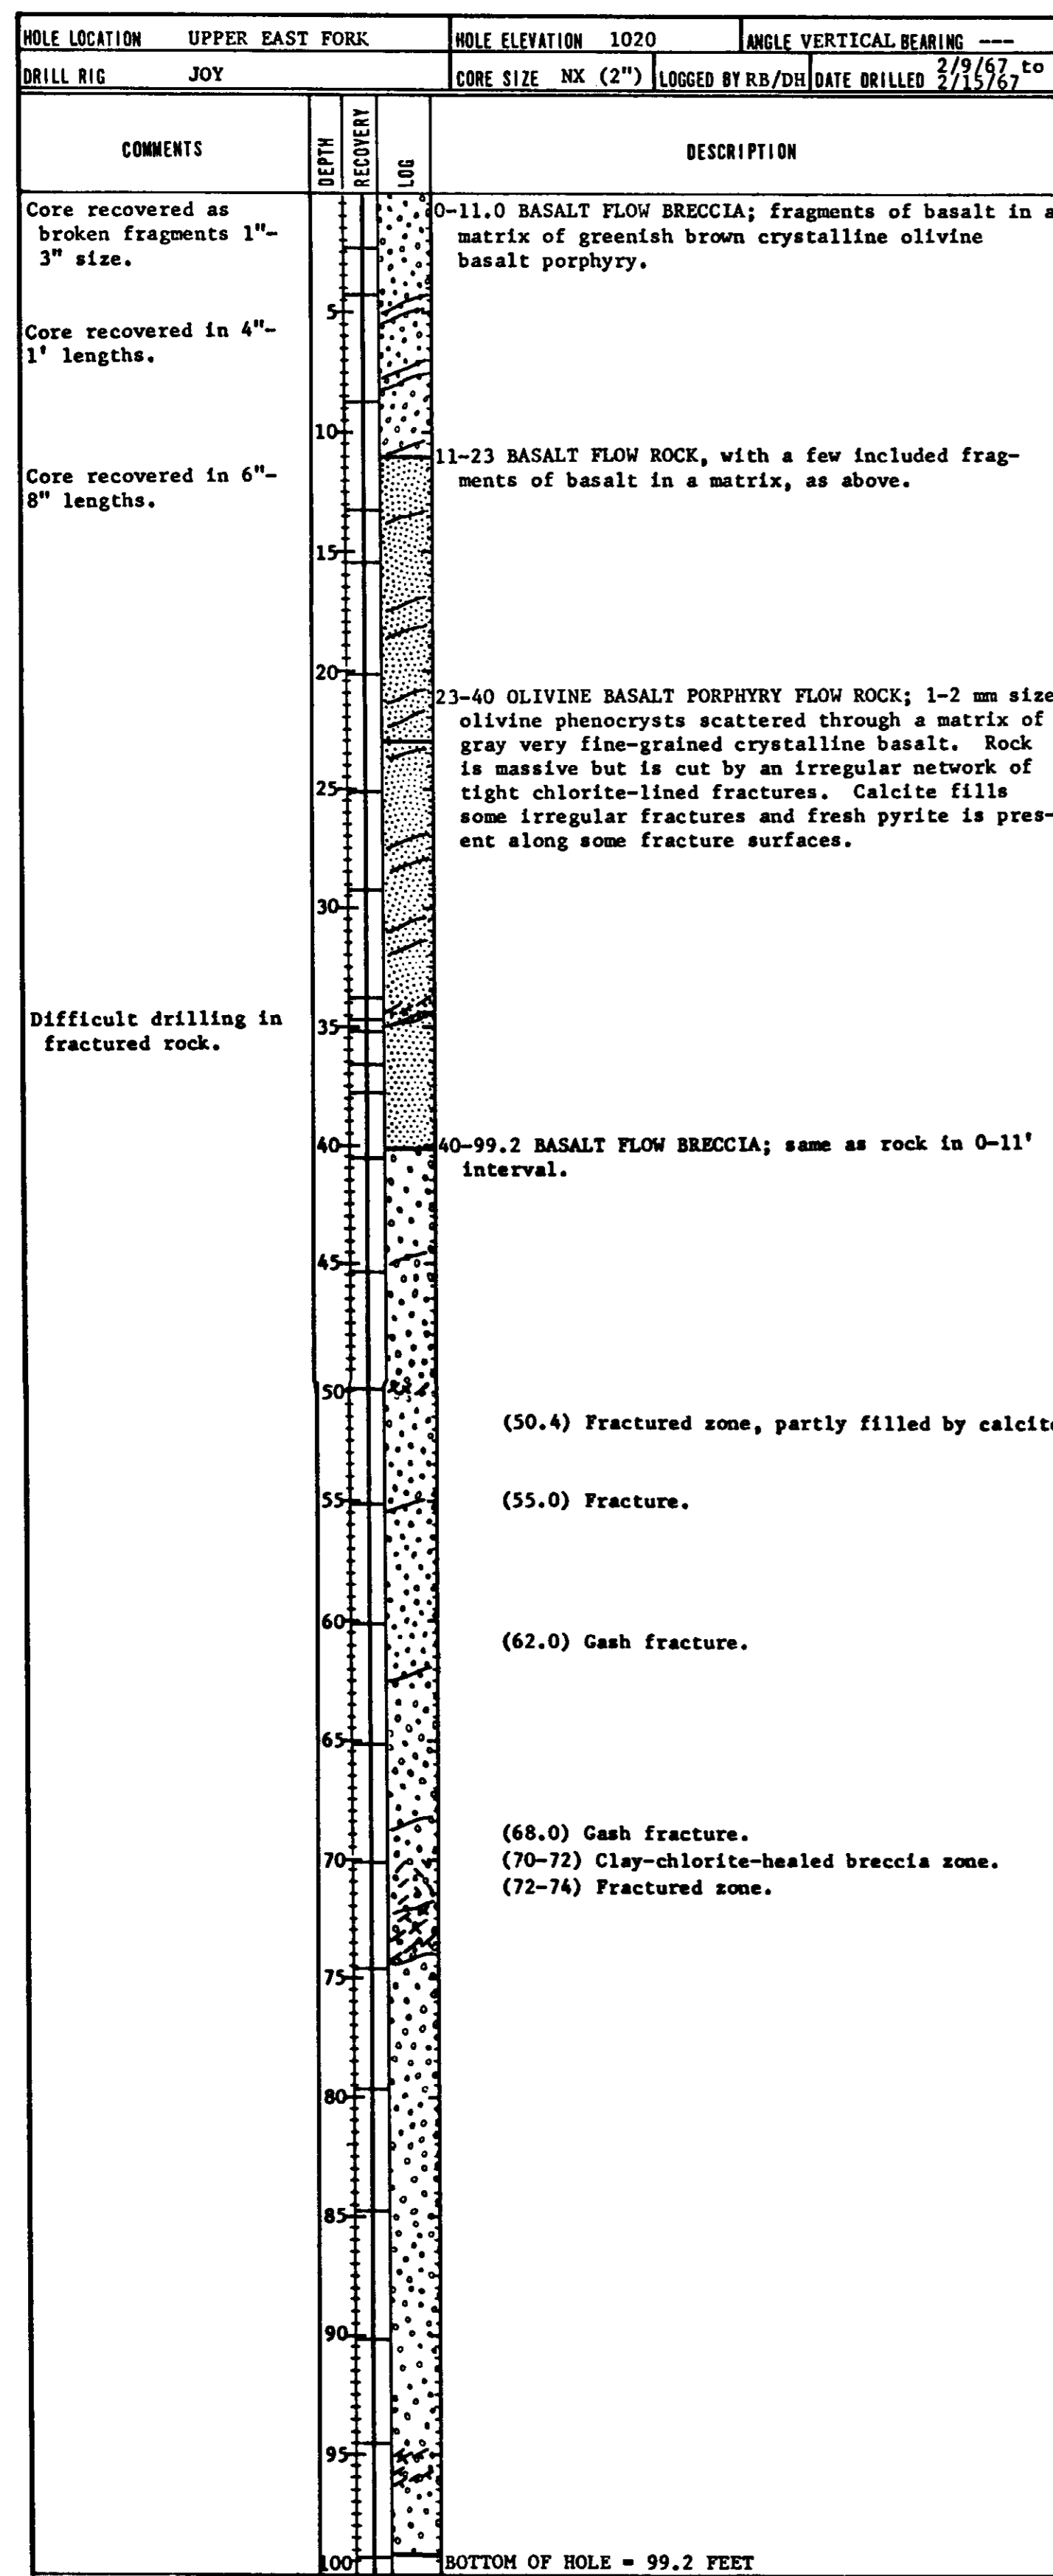

HOLE NO. D-1

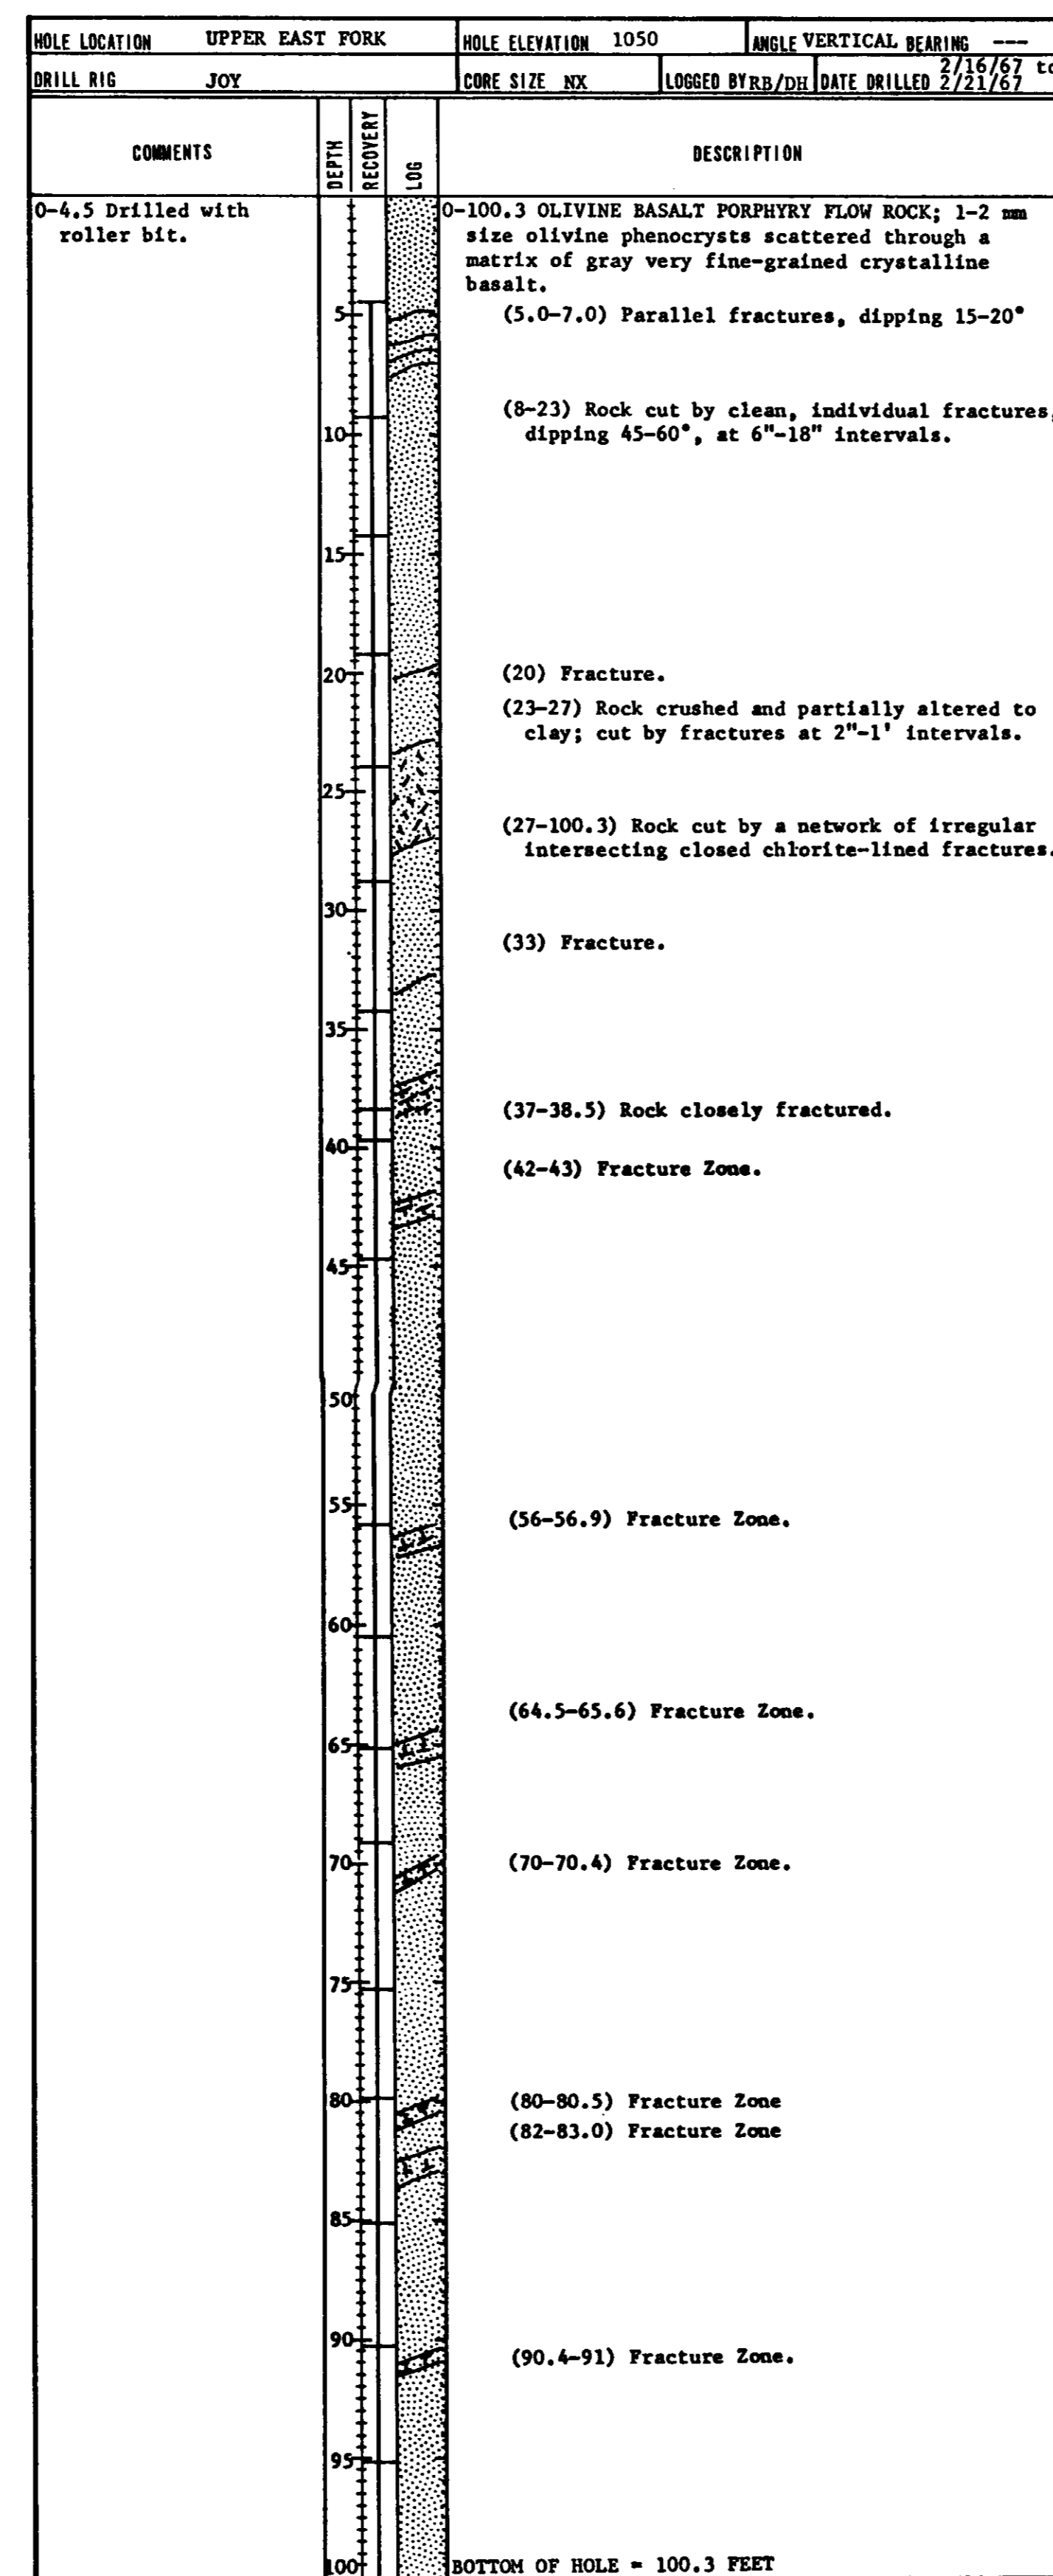

HOLE NO. D-2

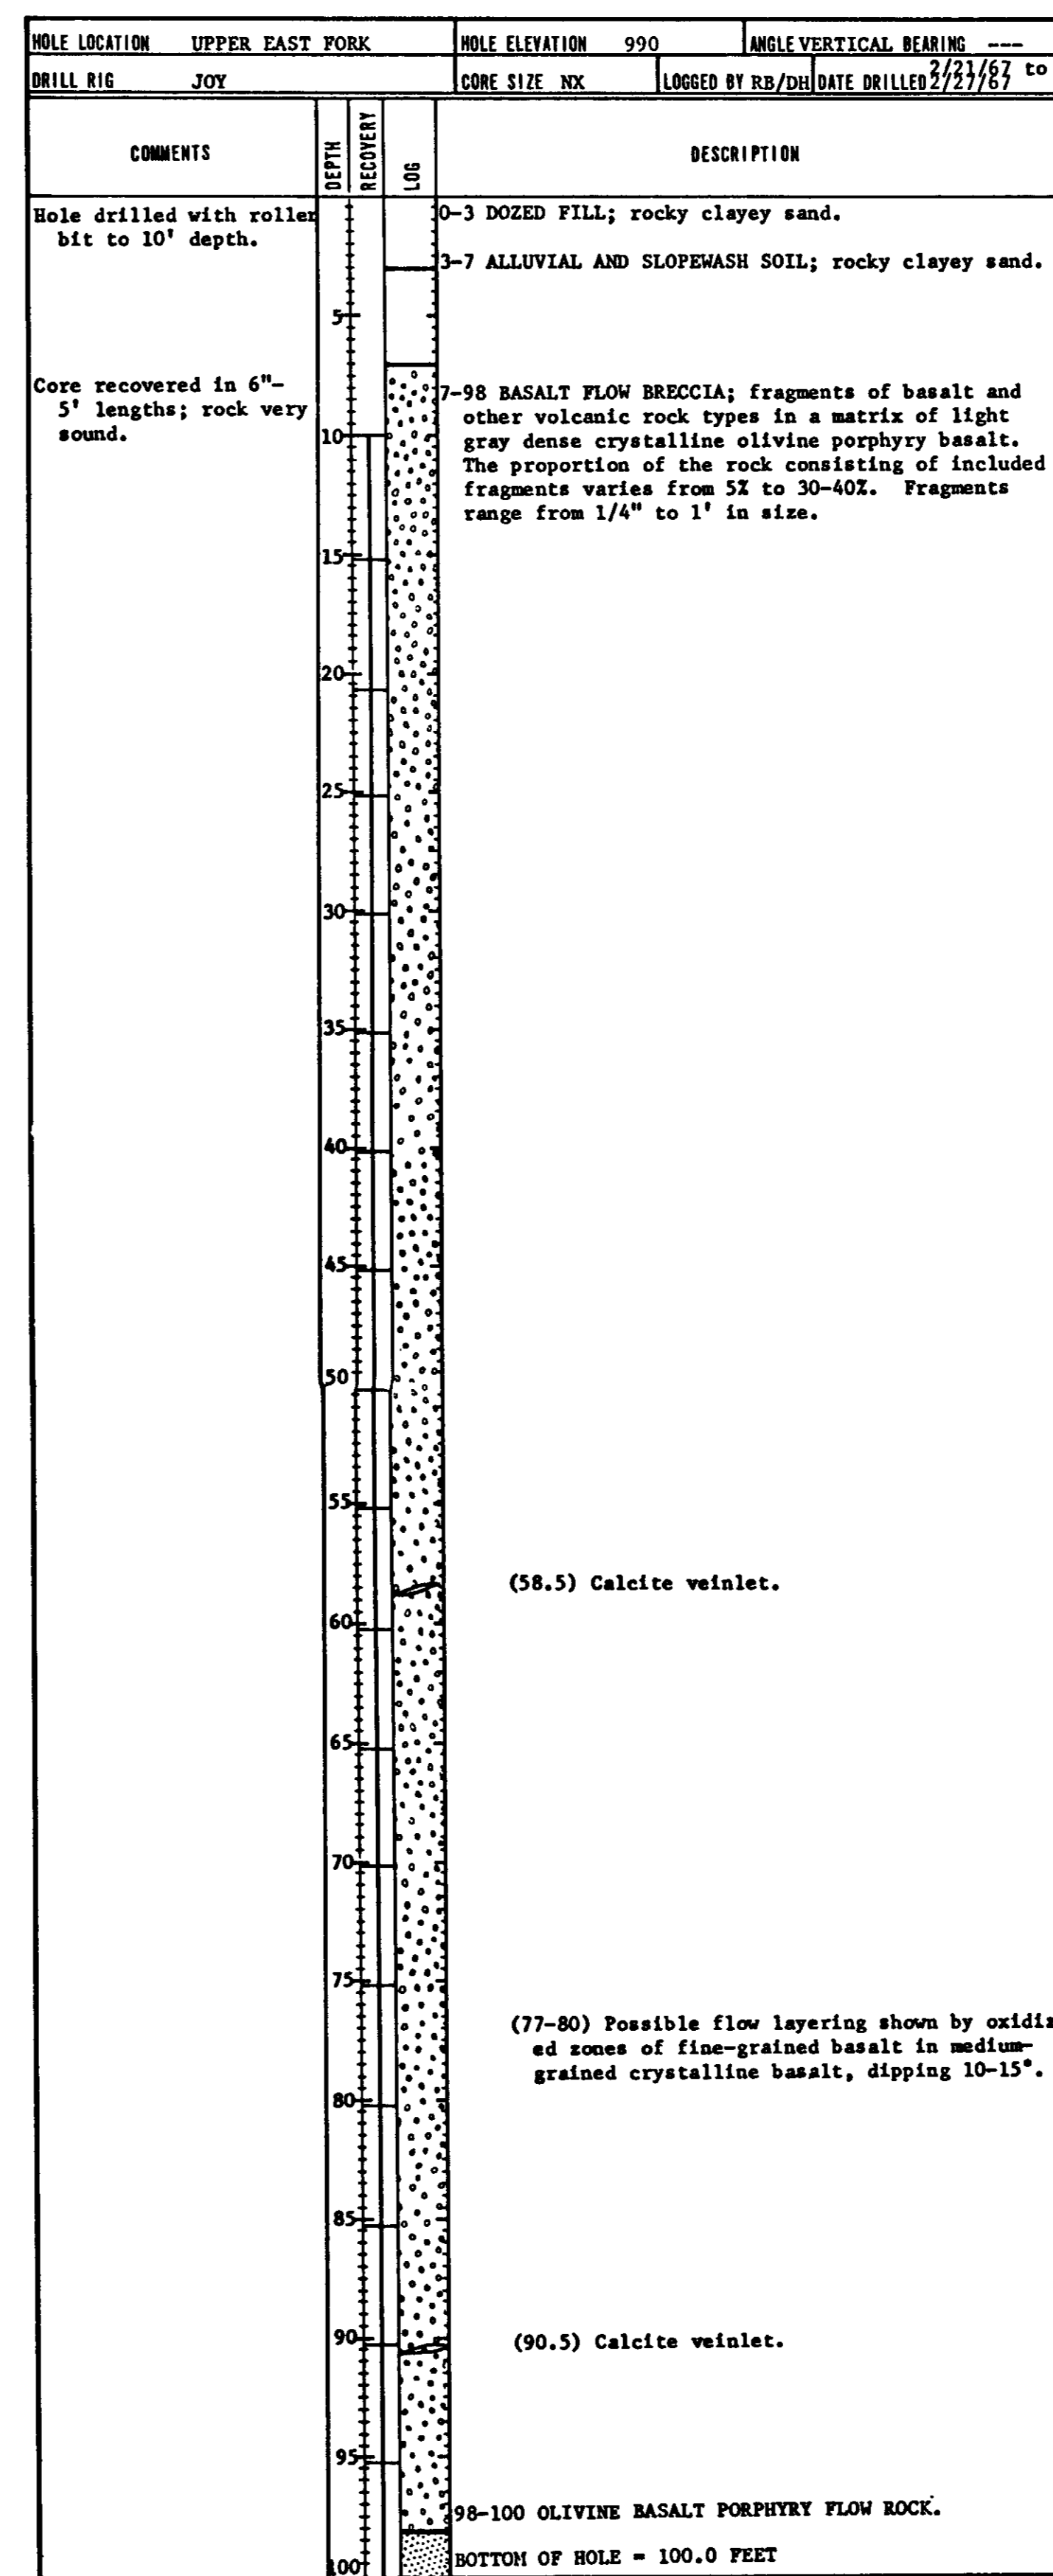

HOLE NO. D-3

NOTES

- The subsurface information shown in the hole logs presented on this drawing indicate conditions found only on the date and at the location of the hole. Users of this information are cautioned that the Engineer and W.A. Wahler and Associates, in no way warrant that that such information is representative of conditions at any other location, or at any other time. Strata, lithology, and other conditions may change between holes due to dipping of strata, folds and / or faults or other causes. Groundwater levels are subject to change with time, depending on precipitation and surface and subsurface runoff, etc.
- The subsurface exploration program was carried out to provide a basis for the design of the works presented in these plans and specifications. Reasonable continuity between points of known data was assumed for design purposes. If conditions differing substantially from those shown are encountered, the Engineer shall be notified to permit modified recommendations and / or designs to be made before work progress precludes such modifications.
- Only logs of borings shown on drawing number 5 are included in these plans.

05255


ISSUED FOR CONSTRUCTION	BY	CHK	ENG.	MR.
NO.	DATE	REVISIONS	BY	CHK

**LAS VIRGENES MUNICIPAL WATER DISTRICT**


BOYLE ENGINEERING  
W. A. WAHLER & ASSOCIATES

WESTLAKE RESERVOIR  
**GEOLOGY**  
LOGS OF EXPLORATION  
SHEET 1 OF 5


DESIGNED D.H.	DATE: 11-70	JOB ENG. C.W.P.	PROJ. ENG. <i>JH</i>
DRAWN B.S.		CHECKED C.W.P. <i>R.C.E.</i>	DRAWING NUMBER
			6
SCALE AS SHOWN			REV.

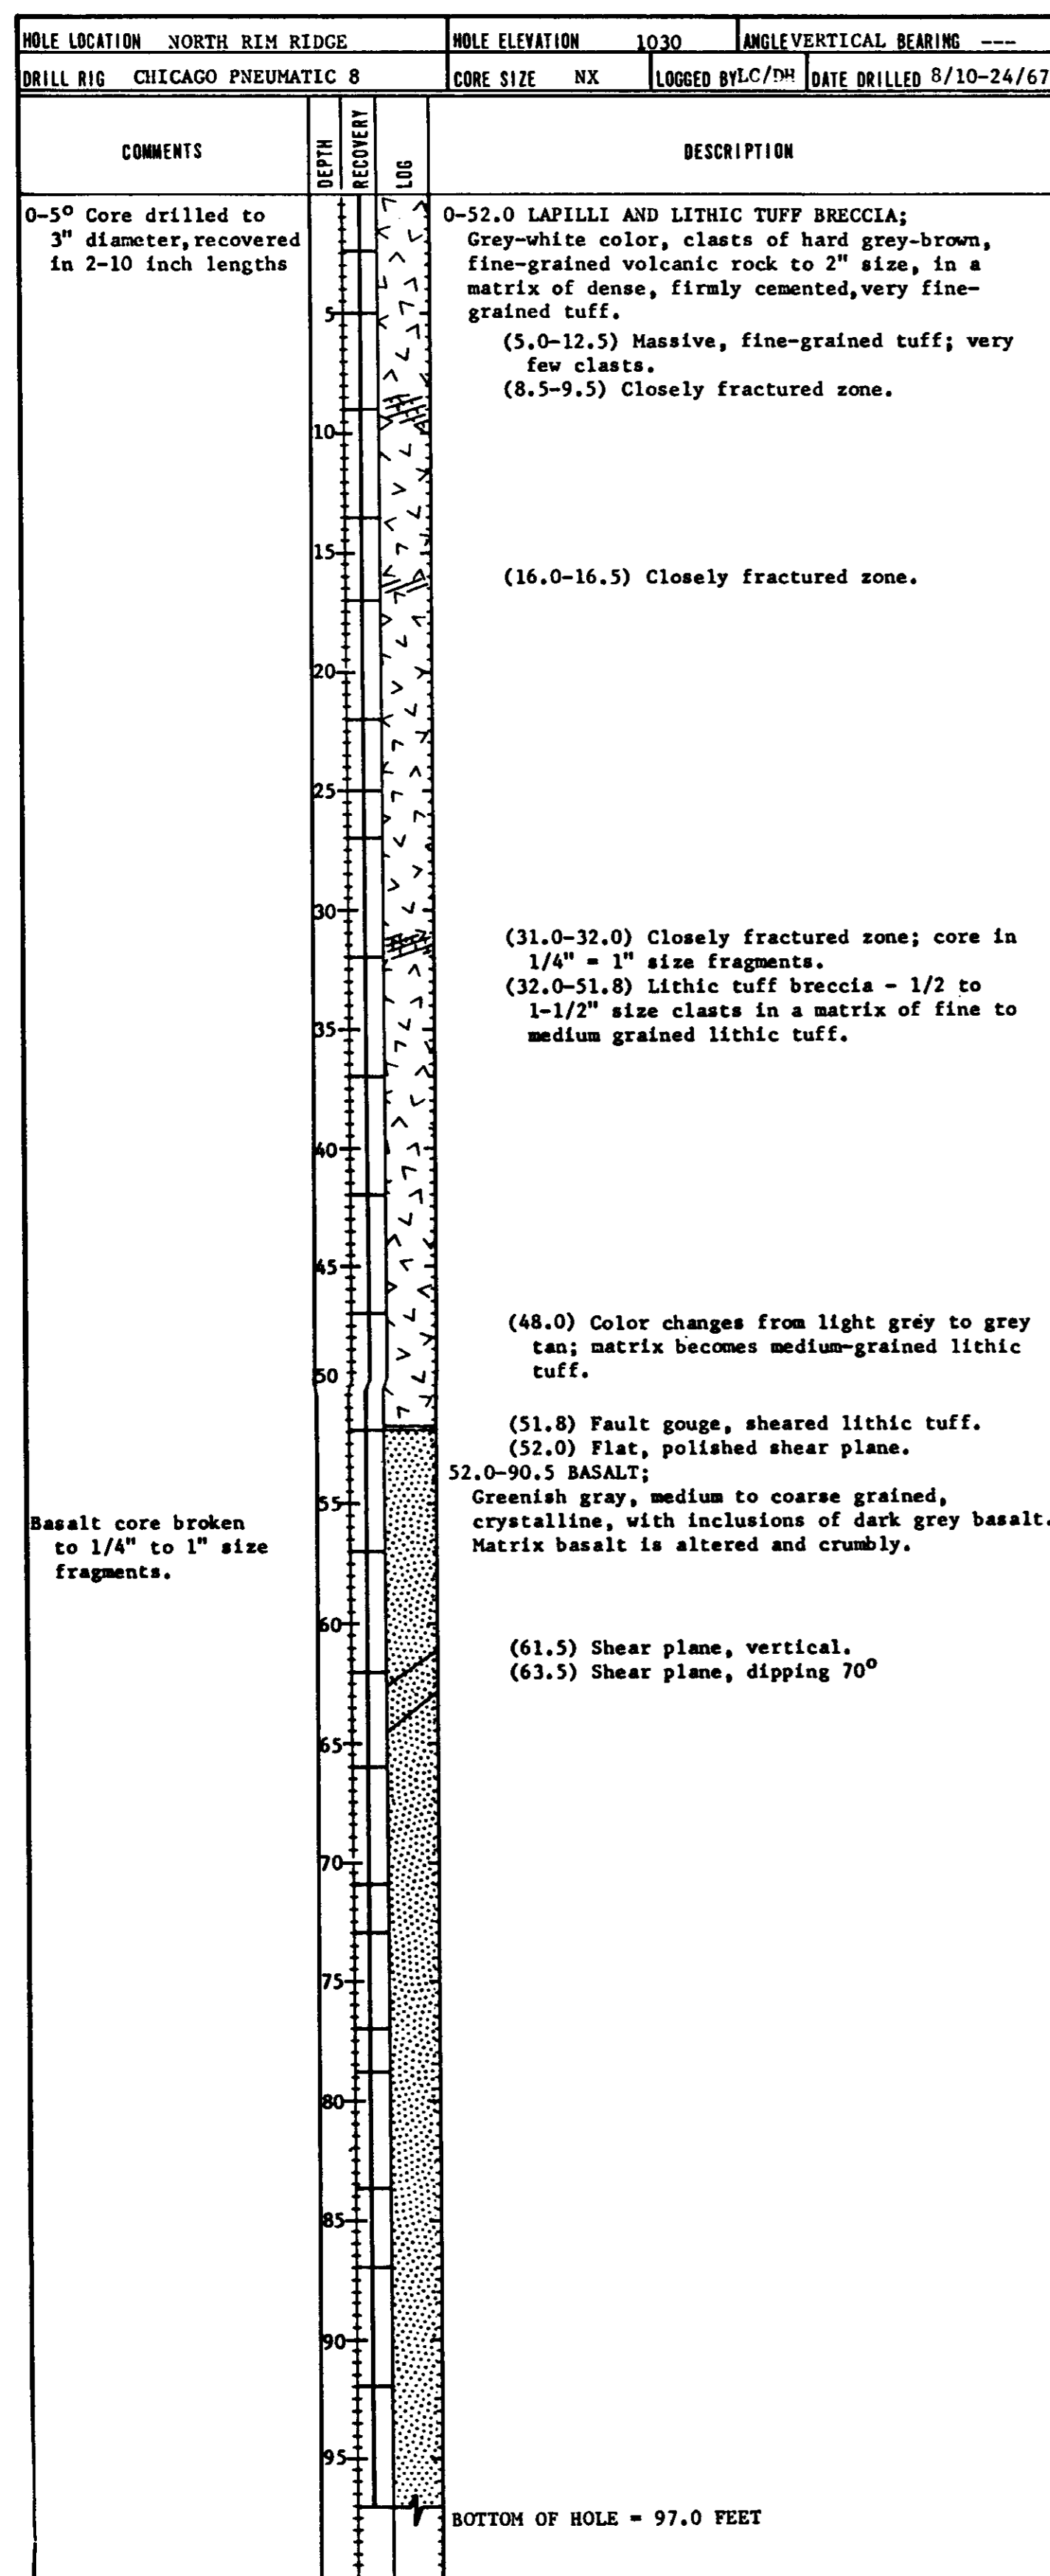

HOLE NO. D-8

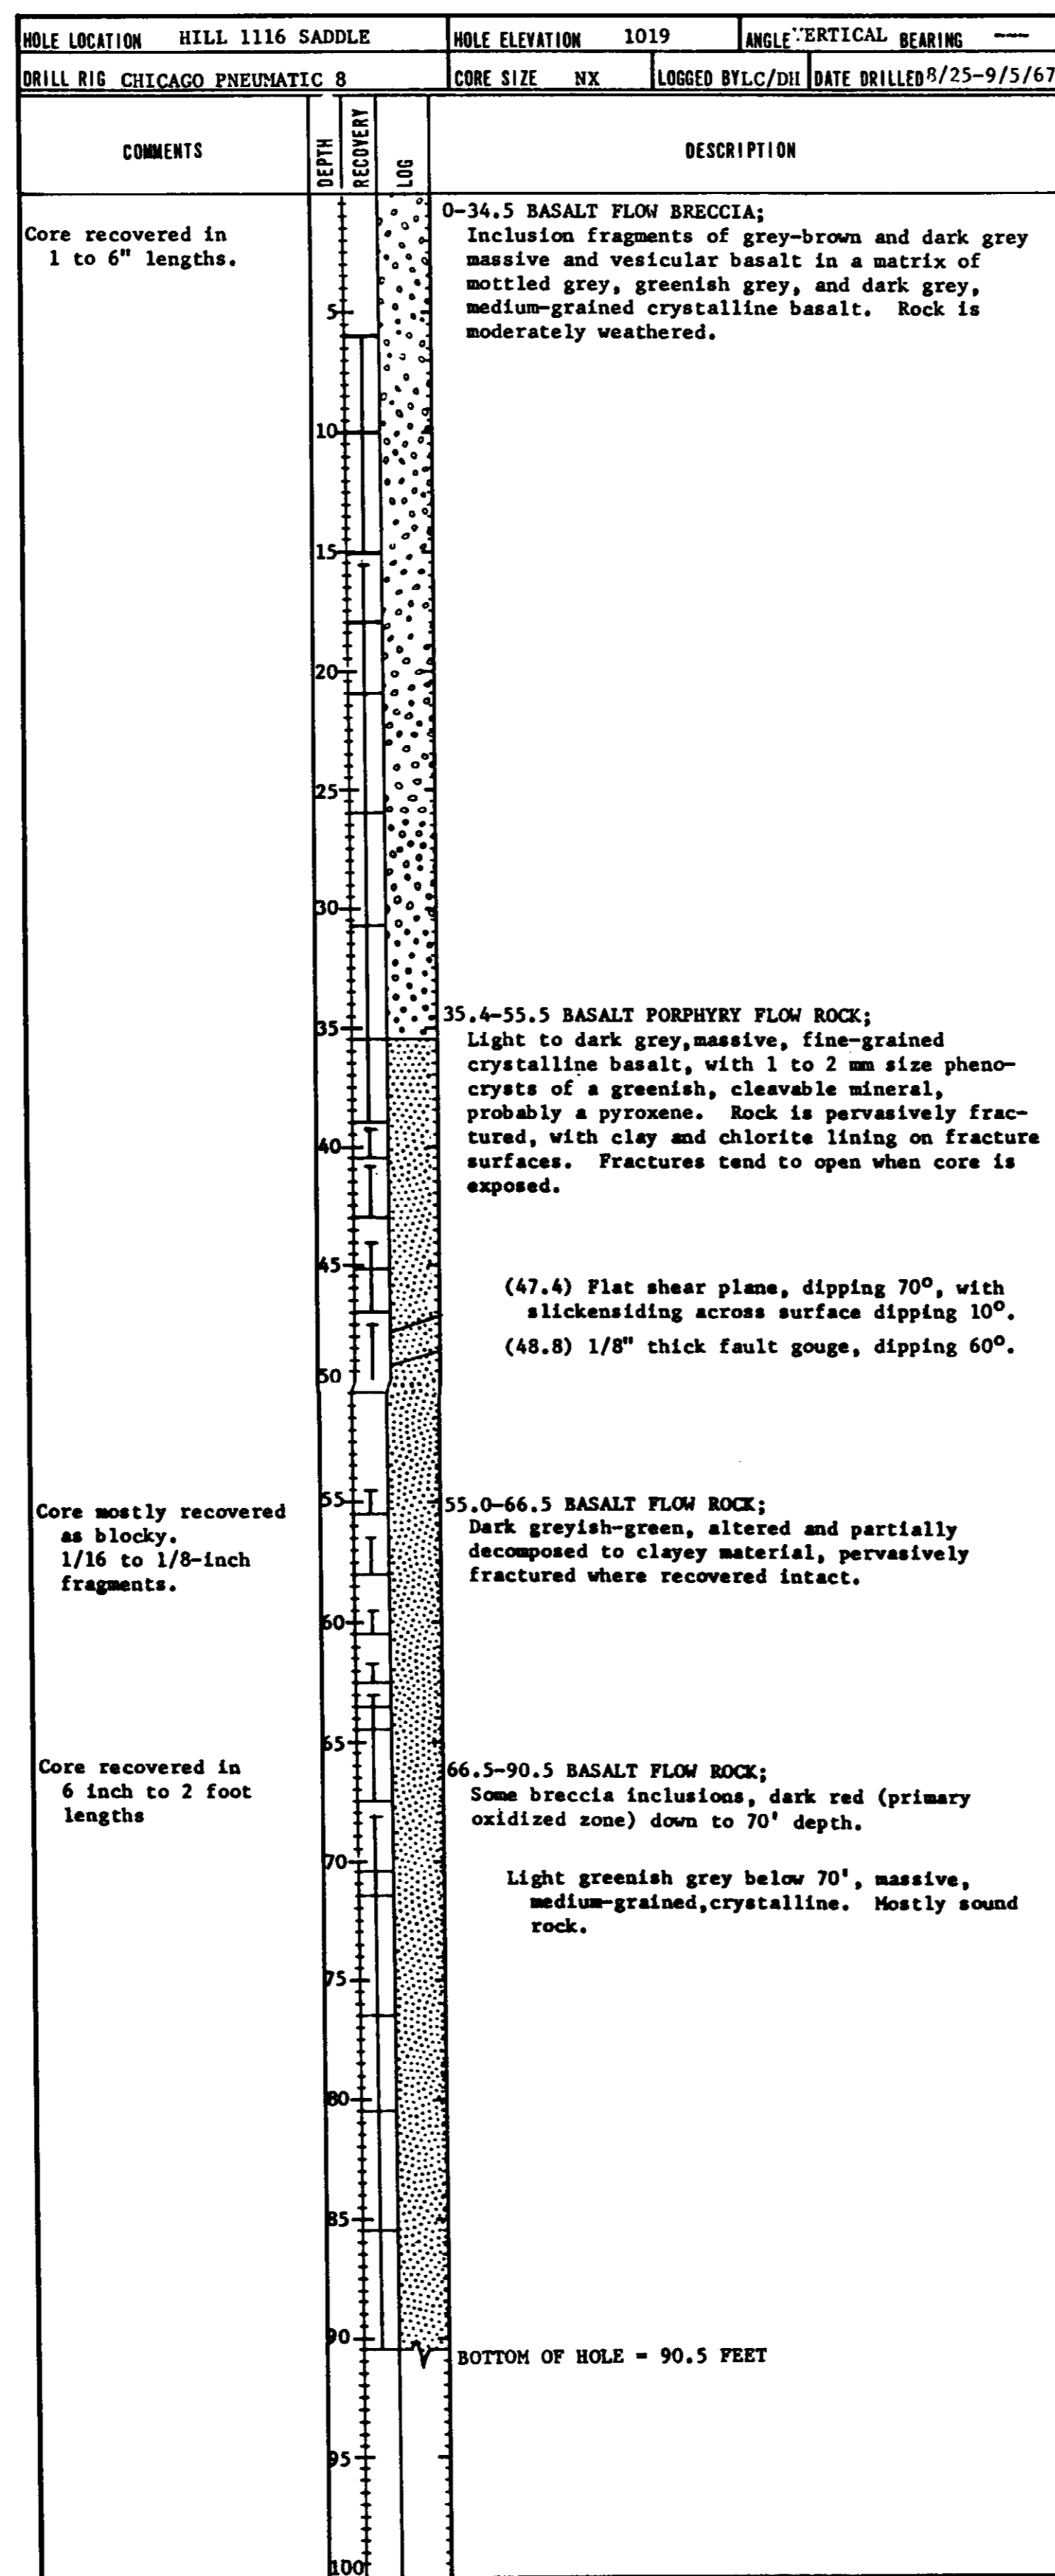

HOLE NO. D-9

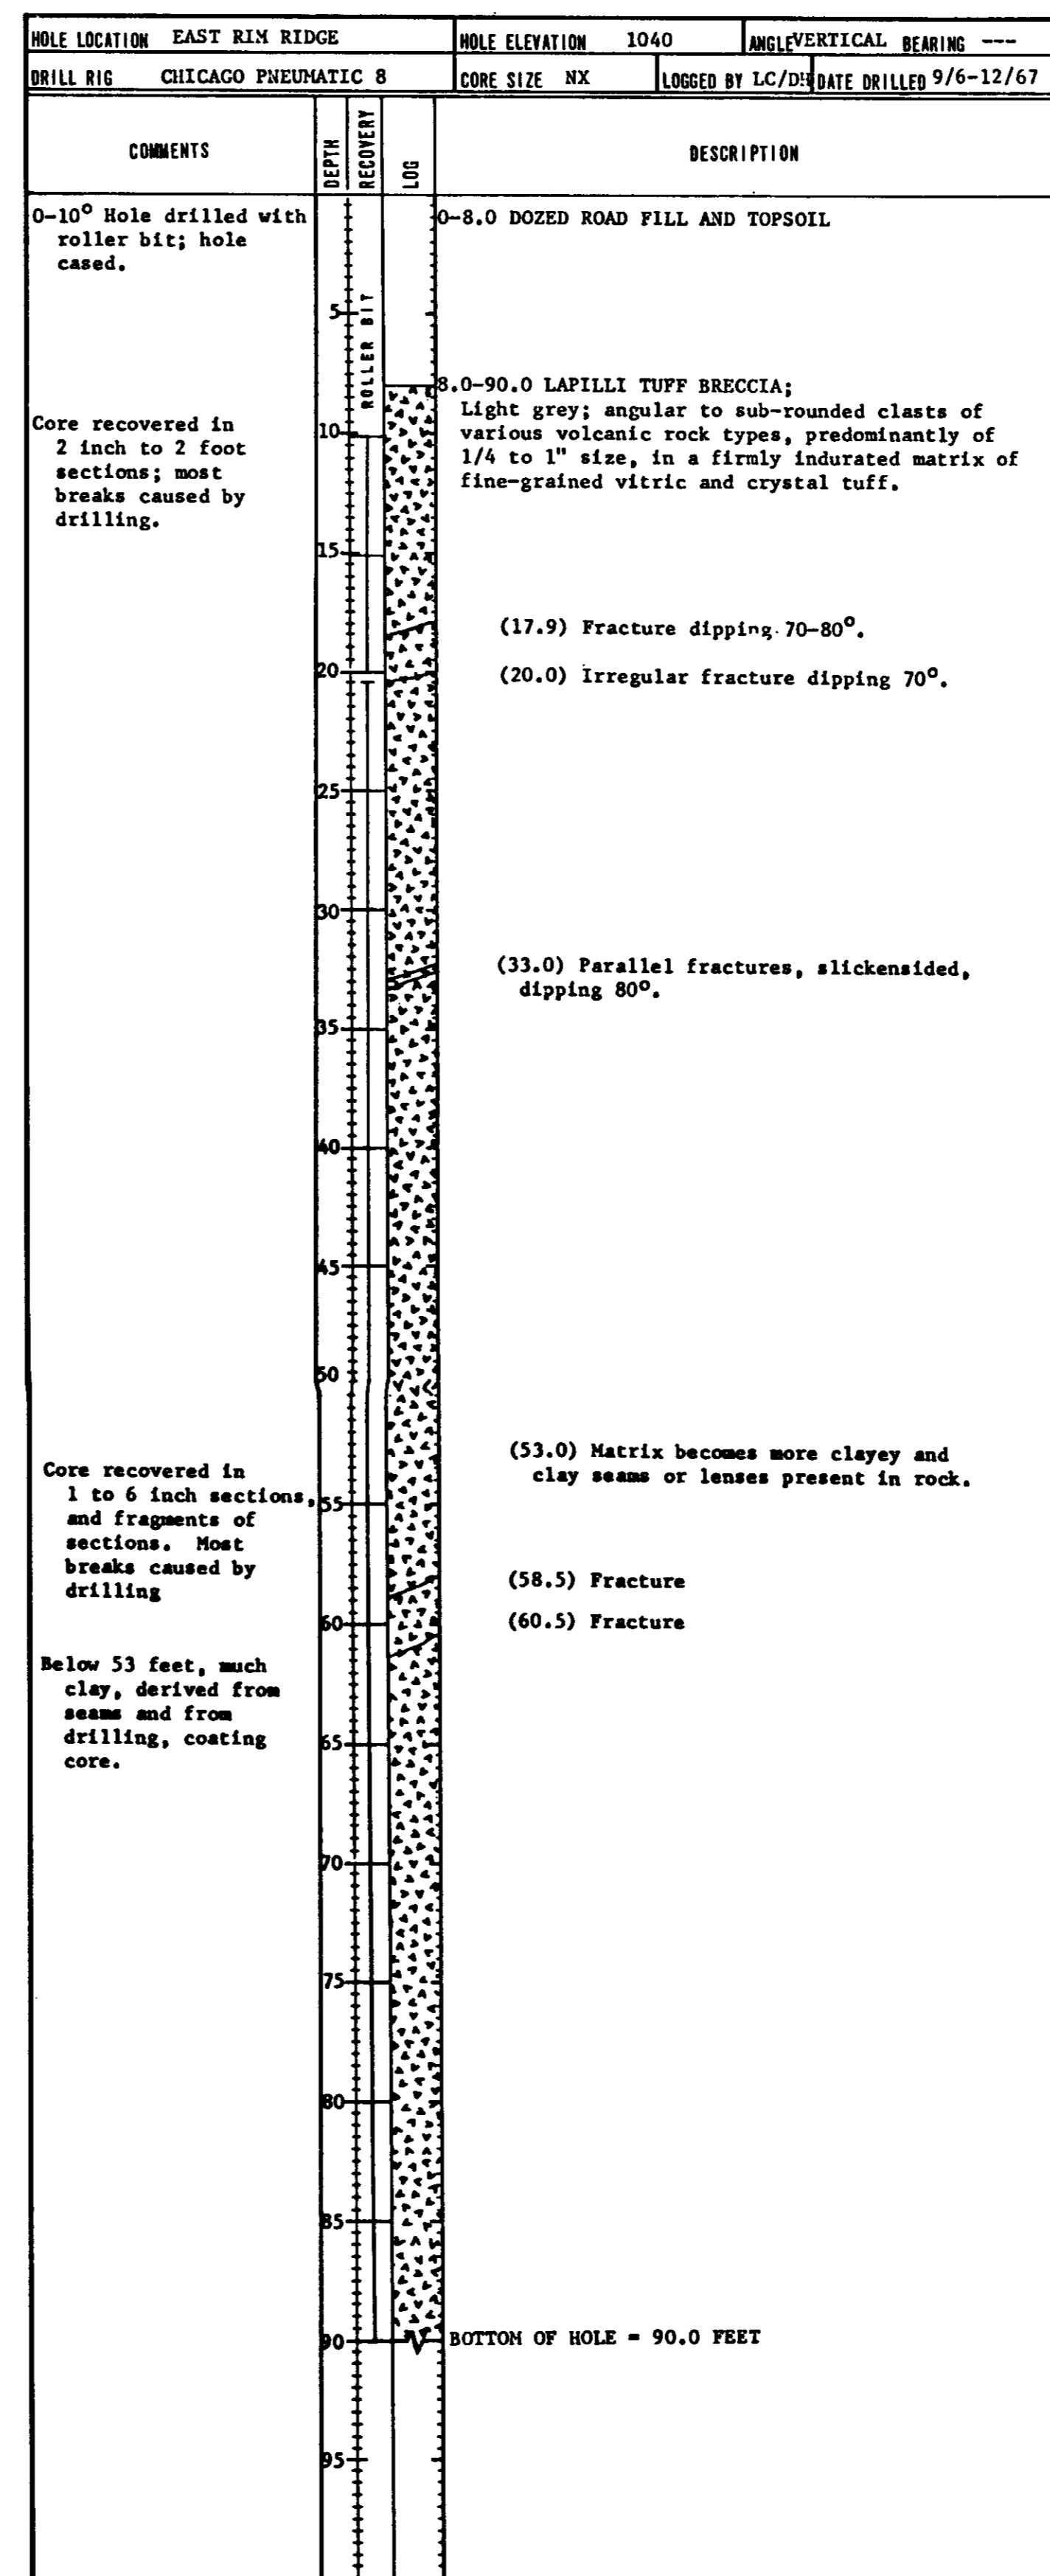

HOLE NO. D-10

NOTES

1. Notes 1, 2 and 3 on drawing number 6 apply to this drawing.

05256

NO.	DATE	REVISIONS	BY	CHKD.	PROJ. ENGR.	MON.
<b>LAS VIRGENES MUNICIPAL WATER DISTRICT</b> BOYLE ENGINEERING W. A. WAHLER & ASSOCIATES WESTLAKE RESERVOIR <b>GEOLOGY</b> LOGS OF EXPLORATION SHEET 2 OF 5						
DESIGNED D.H.	DATE: 11-70	JOB ENGR. C.W.P.	PROJ. ENGR. <i>[Signature]</i>			
DRAWN B.S.	CHECKED C.W.P. <i>[Signature]</i>		DRAWING NUMBER	REV.		
SCALE AS SHOWN	R. C. E. <i>[Signature]</i>		7			



HOLE LOCATION	Main Dam Foundation Area	HOLE ELEVATION	900 ±	ANGLE	50°	BEARING	Due E
DRILL RIG	Chicago Pneumatic 8	CORE SIZE	NX	LOGGED BY	LCC	DATE DRILLED	10/5-13/67
COMMENTS	DEPTH RECOVERY LOG	DESCRIPTION					
Cored with 2 7/8 inch O.D. Diamond bit.	0.0'-3.0'	Dozed fill - no core.					
	3.0'-19.0'	<b>BASALT:</b> Brown and green to dark gray, fine to medium-grained crystalline flow rock. Physical Condition: Moderately friable to moderately hard, massive with thin clay-chlorite lined fractures at 10.5 feet, 60 degrees and 75 degrees to core axis.					
Water Test #1 10'-20' No loss Water Test #2 10'-20' Loss due to jacking Water Test #3 10'-20' Loss due to rock heaving.	19.0'-43.5'	<b>BASALT FLOW BRECCIA:</b> Light gray, medium-grained, crystalline basalt matrix. Zones of dark gray, fine to coarse-grained flow rock at 20'-23', 25'-28', and 35'-38'. Quartz lens at 26.5'. Calcite lens 60 degrees to core axis at 36.5'.					
Water Test #4 20'-35' No loss Water Test #5 same interval as #4. Higher pressure, no loss Water Test #6 same interval as #5. Higher pressure, no loss Water Test #7, 8, 9, unable to seat packer. Water Test #10 35'-65' No loss Water Test #11 same interval as #10, higher pressure, no loss. Water Test #12 same interval as #11, higher pressure, no loss. Water Test #13 50'-65' No loss Water Test #14 same interval as #13, higher pressure, no loss. Water Test #15, same interval as #14, higher pressure, no loss.	43.5'-45.0'	<b>BASALT:</b> Brown to gray, microcrystalline with plagioclase phenocrysts. Physical Condition: Intensely fractured in angular, sharp 1/4" to 1" fragments.					
	45.0'-57.5'	<b>BASALT PORPHYRY:</b> Dark gray, microcrystalline, 1-2mm elongate white plagioclase phenocrysts in dark gray, hard, aphanitic groundmass. Physical Condition: Closely fractured with calcite veins in some fractures.					
	57.5'-61.5'	<b>BASALT:</b> Medium-grained flow rock, irregular calcite lensing and impregnation.					
	61.5'-68.0'	<b>BASALT:</b> Brown to gray, microcrystalline. Physical Condition: Intensely fractured in angular, sharp 1/4" to 1" fragments.					
	68.0'-73.0'	<b>BASALT:</b> Fine to medium-grained flow rock, massive.					
	73.0'-85.0'	<b>BASALT FLOW BRECCIA:</b> Grading in places to flow rock. Gray, medium-grained, crystalline, massive.					
	85.0'-91.7'	<b>BASALT PORPHYRY:</b> Fine to medium-grained with 1mm light gray plagioclase phenocrysts.					
	91.7'-95.0'	<b>BASALT PORPHYRY:</b> Dark gray, aphanitic flow rock with 2-3mm white, tabular, plagioclase phenocrysts.					
Water Test #19 90'-110' Loss approximately 2gpm Water Test #20 same interval as #19, higher pressure, loss approximately 4.5gpm. Fractures slightly jacked. Water Test #21 same interval as #20, higher pressure, loss	95.0'-103.5'	<b>BASALT PORPHYRY:</b> Fine to medium-grained flow rock with 1mm light gray plagioclase phenocrysts. Dark inclusion at 103.5 feet. Physical Condition: Closely fractured, moderately weathered.					

HOLE LOCATION	Main Dam Foundation Area	HOLE ELEVATION	900 ±	ANGLE	50°	BEARING	Due E
DRILL RIG	Chicago Pneumatic 8	CORE SIZE	NX	LOGGED BY	LCC	DATE DRILLED	10/5-13/67
COMMENTS	DEPTH RECOVERY LOG	DESCRIPTION					
approximately 4.5 gpm, additional jacking.	103.5'-108.0'	<b>BASALT PORPHYRY:</b> Dark gray, aphanitic flow rock with 2.3mm white, tabular, plagioclase phenocrysts. Physical Condition: Moderate, incipient fractures, little weathering.					
Water Test #22 110'-130 Loss approximately 1 gpm, some jacking.	108.0'-131.0'	<b>BASALT:</b> Coarse-grained, crystalline flow rock, massive. Physical Condition: Deeply weathered to green and maroon chlorite and clay minerals, low hardness, moderately to intensely fractured. Crushed from 125.0 feet to 130.0 feet.					
Water Test #23 same interval as #22, higher pressure, loss approximately 3.5 gpm, additional jacking.	131.0'-147.0'	<b>BASALT:</b> Light gray, fine to medium-grained, crystalline, flow rock. Physical Condition: Closely fractured at 30 and 45 degrees to core axis. Little weathering.					
Water Test #24 same interval as #23, higher pressure, loss approximately 4.5 gpm, significant additional jacking.	146.7'-147.0'	Breccia gouge zone, 1/8" to 1/4" angular fragments in gray clay.					
Water Test #25 110'-147' Loss approximately 2 gpm. Fractures slightly jacked.	BOTTOM OF HOLE = 147.0 FEET						

HOLE NO. D-11

HOLE LOCATION	Dam Left Abutment	HOLE ELEVATION	1053	ANGLE	Vert.	BEARING	
DRILL RIG	Cannon Drilling Co. Joy R-12 Rig	CORE SIZE	NX	LOGGED BY	RCH	DATE DRILLED	10/10-18/68
COMMENTS	DEPTH RECOVERY COMPOSITION LITHOLOGY	DESCRIPTION					
Cored with 2 7/8" O.D. diamond bit.	0.0'-43.4'	<b>BASALT PORPHYRY:</b> Fine-grained to microcrystalline matrix, phenocrysts mainly pyroxene and plagioclase, dense, massive. Closely to little fractured; very thin clay coatings on some fractures; calcite coatings on most; hard; strong; deeply weathered to 22 feet, moderately weathered below 22 feet.					
Water Test #1 11.5'-23.4'.	43.4'-111.3'	<b>BASALT FLOW BRECCIA:</b> Fine-grained porphyritic basalt with slightly coarser-grained porphyritic inclusions; inclusions are angular to rounded, sand to cobble size with corroded and resilted boundaries, phenocrysts mainly pyroxene, olivine and plagioclase. Closely to little fractured; no clay coatings; scattered calcite veinlets and vug fillings; moderately hard, weak to moderately strong; moderately to little weathered.					
Water Test #2 21.2'-33.1'.	111.3'-142.0'	<b>BASALT PORPHYRY:</b> Similar to above porphyry; phenocrysts finer grained, contacts are gradational top and bottom, no sharp boundaries. Closely to little fractured; calcite coatings on most fractures, probably tight in place; hard, strong, moderately weathered.					
Water Test #3 31.3'-43.2'.	142'-152.1'	<b>BASALT FLOW BRECCIA:</b> Same as above, little fractured, hard, strong, little weathered.					
Water Test #4 41.5'-53.4'.	BOTTOM OF HOLE = 152.1 FEET						
Water Test #5 51.5'-63.4'.							
Water Test #6 61.5'-73.4'.							
Water Test #7 71.5'-83.4'.							
Water Test #8 82.1'-94.0'.							

HOLE NO. D-12

HOLE LOCATION	Dam Left Abutment	HOLE ELEVATION	1053	ANGLE	Vert.	BEARING	
DRILL RIG	Cannon Drilling Co. Joy R-12 Rig	CORE SIZE	NX	LOGGED BY	RCH	DATE DRILLED	10/10-18/68
COMMENTS	DEPTH RECOVERY COMPOSITION LITHOLOGY	DESCRIPTION					
Water Test #9 92.1'-104.0'.	43.4'-111.3'	<b>BASALT FLOW BRECCIA (cont.)</b>					
Loss approximately 5 GPM, from fracture at 103.8'.	105.5'-106.6'	Vesicular basalt, most vugs filled with calcite.					
Water Test #10 101.3'-113.2'.	111.3'-142.0'	<b>BASALT PORPHYRY:</b> Similar to above porphyry; phenocrysts finer grained, contacts are gradational top and bottom, no sharp boundaries. Closely to little fractured; calcite coatings on most fractures, probably tight in place; hard, strong, moderately weathered.					
Loss approximately 10 GPM.	142'-152.1'	<b>BASALT FLOW BRECCIA:</b> Same as above, little fractured, hard, strong, little weathered.					
Probably loss from fractures at 103.8' and 108'.	BOTTOM OF HOLE = 152.1 FEET						
Water Test #11 111.1'-123.0'.							
No loss							
Water Test #12 same interval as #11, higher pressure, no loss.							
Water Test #13 92.1'-123.0'.							
Retest of #9 and #10 intervals.							
Loss approximately 15 GPM.							
Water Test #14 120.2'-132.1'.							
No loss							
Water Test #15 100.2'-132.1'.							
Retest of 32' interval.							
Loss approximately 15 GPM.							
Water Test #16 130.2'-142.1'.							
No loss							
Water Test #17 130.2'-142.1'.							
No loss, same interval higher pressure							
Water Test #18 140.2 Terminated hole at 152.1 feet.							

NOTES

1. Notes 1, 2 and 3 on drawing number 6 apply to this drawing.

05257

ISSUED FOR CONSTRUCTION

LAS VIRGENES MUNICIPAL WATER DISTRICT

BOYLE ENGINEERING  
W. A. WAHLER & ASSOCIATES

WESTLAKE RESERVOIR  
GEOLOGY  
LOGS OF EXPLORATION  
SHEET 3 OF 5

DESIGNED D. H.	DATE: 11-70	FOR C.W.P.	PROJ. ENG.	REV.
DRAWN B. S.			DRAWING NUMBER	
CHECKED C.W.P.			8	
SCALE AS SHOWN				

Draw below Saddle Hill 1027		HOLE LOCATION South of West Embankment		HOLE ELEVATION 1052		ANGLE Vert. BEARING	
Cannon Drilling Co.		CORE SIZE NX		LOGGED BY RCH		DATE DRILLED 10/21-25/68	
COMMENTS	DEPTH	RECOVERY	DESCRIPTION	COMMENTS	DEPTH	RECOVERY	DESCRIPTION
Cored with 2 7/8" O.D. diamond bit, surface casing to 5.0 feet.	0		<b>0'-90.1' BASALT PORPHYRY FLOW BRECCIA:</b> Fine-grained porphyritic basalt containing angular, rounded and streaked out inclusions of slightly coarser grained basalt porphyry; phenocrysts in both matrix and inclusions are predominantly pyroxene and plagioclase laths; borders of many inclusions are corroded and partially remelted; contains scattered small veinlets of calcite.  Closely to little fractured; clay fillings on fractures in deeply weathered zone, no fillings below deeply weathered zone, hard and moderately strong; deeply weathered to 16 feet, moderately weathered 16 feet to 70 feet, little weathered below 70 feet.				
Water Test #1 8.4'-15.3'. Loss approximately 7 to 8 GPM, probably from fractures at 9.7' and 14.5'. Cased hole to 15 feet, drilling water muddy.	15			Water Test #1 7.6'-14.5'. Loss about 4 GPM. Attempted Water Test #2 packer would not pass 10 feet, set casing to 15 feet	15		
Water Test #2 18.1'-25.0'. No loss	25			Water Test #2 18.5'-25.4'. No loss No circulation loss while coring.	25		
Water Test #3 22.5'-34.4'. No loss	35			Water Test #3 23.1'-35.0'. No loss	35		
Water Test #4 31.5'-43.4'. No loss	45			Water Test #4 32.3'-44.2'. No loss	45		
Water Test #5 40.5'-52.4'. 0.1 GPM loss, possibly leak in fittings. Difficult drilling	55			Water Test #5 43.3'-55.2'. No loss	55		
Water Test #6 48.5'-60.4'. No loss Difficult drilling 60'-63', rig chattering, water loss at 62'. At 63', hole appears to be producing water at rate of 2 GPM.	65			Water Test #6 53.3'-65.2'. No loss	65		
Water Test #7 58.5'-70.4'. Loss approximately 18 GPM with small amount leaking around packer.	75			Water Test #6a 63.1'-75.0'. No loss	75		
Water Test #8 58.5'-70.4'. Retest, loss 19 to 20 GPM, some leaking past packer.	80			Water Test #7 73.1'-85.0'. No loss	85		
Water Test #9 68.1'-80.0'. Loss about 18 to 20 GPM some leaking past packer.	85			Water Test #8 78.3'-90.2'. No loss Terminated hole at 90.2 feet.	90		
Water probably leaking between 60' and 70'. Water Test #10 78.2'-90.1'. No loss Terminated hole at 90.1 feet.	90						
			BOTTOM OF HOLE = 90.1 FEET				

HOLE NO. D-13

Dam Right Abutment, Saddle Hill 1027		HOLE LOCATION Saddle Hill 1027		HOLE ELEVATION 982		ANGLE Vert. BEARING	
Cannon Drilling Co.		CORE SIZE NX		LOGGED BY DHH		DATE DRILLED 10/28-31/68	
COMMENTS	DEPTH	RECOVERY	DESCRIPTION	COMMENTS	DEPTH	RECOVERY	DESCRIPTION
Roller rock bit to 5.0' Set surface casing to 5.0 feet. Cored with 3 1/2" O.D. diamond bit. Lost circulation at 9.0 feet.	0		<b>5.0'-51.6' BASALT FLOW BRECCIA:</b> Basalt clasts 1/8" to 2" size in matrix of medium grained crystalline basalt. Closely to moderately fractured, minimum 0.1 foot, maximum 0.7 foot, moderately weathered.				
Water Test #1 7.6'-14.5'. Loss about 4 GPM. Attempted Water Test #2 packer would not pass 10 feet, set casing to 15 feet	15		10.0'-12.0' Soft, disintegrated zone, intensely fractured.	Water Test #1 8.2'-15.1'. No loss	15		
Water Test #2 18.5'-25.4'. No loss No circulation loss while coring.	25		13.2'-51.6' Clasts of grey fine grained to medium grained basalt in dark gray, medium grained, massive, uniform crystalline basalt, many fractures cutting this interval are confined to the larger fine grained basalt clasts and to zones where rock grades to fine grained basalt. Closely to little fractured, minimum 0.1 foot, maximum 3.0 feet, most breaks slightly rough and clean, probably closed at depth; hard; little weathered.	Water Test #2 13.5'-25.4'. No loss	25		
Water Test #3 23.1'-35.0'. No loss	35		25.3'-26.0' Moderately soft zone, affected by partial granular disintegration.	Water Test #3 23.1'-35.0'. No loss	35		
Water Test #4 32.3'-44.2'. No loss	45		37.0'-38.0' Rock grades to fine grained light gray then back to medium grained, dark gray basalt.	Water Test #4 33.5'-45.4'. No loss	45		
Water Test #5 43.3'-55.2'. No loss	55		42.0' and 46.0' Olivine basalt porphyry flow rock inclusions in medium grained basalt, fairly sharp contacts, slightly resorbed.	Water Test #5 42.7'-54.6'. No loss	55		
Water Test #6 53.3'-65.2'. No loss	65		51.6'-70.2' <b>OLIVINE BASALT PORPHYRY FLOW ROCK:</b> Light gray with light reddish alteration streaks; fine-grained groundmass with abundant, evenly disseminated, 1 to 2 mm size weathered olivine phenocrysts; laced with irregular closed chlorite filled fractures, more planar fractures lined with plates of shear polished chlorite. Closely fractured, mostly 0.1 foot to 0.5 foot, some intervals intensely fractured; hard, strong, little weathered.	Water Test #6 53.5'-65.4'. No loss	65		
Water Test #6a 63.1'-75.0'. No loss	75		70.2'-90.2' <b>BASALT FLOW BRECCIA AND FLOW ROCK:</b> Medium dark gray; massive with scattered inclusions of subangular to angular basalt clasts. Moderately fractured to massive; hard; strong.	Water Test #7 73.1'-85.0'. No loss	85		
Water Test #7 73.1'-85.0'. No loss	85		75.6'-76.1' Inclusions of gray basalt porphyry, slightly resorbed gradational contacts.	Water Test #8 78.3'-90.2'. No loss Terminated hole at 90.2 feet.	90		
Water Test #8 78.3'-90.2'. No loss Terminated hole at 90.2 feet.	90						
			BOTTOM OF HOLE = 90.2 FEET				

HOLE NO. D-14

Dam Right Abutment, Saddle Hill 1027		HOLE LOCATION Hill 1027		HOLE ELEVATION 1037		ANGLE Vert. BEARING	
Cannon Drilling Co.		CORE SIZE NX		LOGGED BY RCH		DATE DRILLED 11/4-8/68	
COMMENTS	DEPTH	RECOVERY	DESCRIPTION	COMMENTS	DEPTH	RECOVERY	DESCRIPTION
Cored with 3 1/2 inch O.D. diamond bit. Set casing to 5.0 feet	0		<b>0'-78.0' BASALT PORPHYRY FLOW ROCK:</b> Massive, fine-grained rock with scattered phenocrysts of light green weathered olivine in a dense crystalline groundmass aggregate of plagioclase and dark minerals. Rock is brownish tan on surface of core, purplish gray-brown on freshly broken surfaces. Aspect of pitted surface mostly results from weathering out of olivine phenocrysts, core breaks on intersecting 45 degrees to 60 degrees dipping fractures. Generally moderately fractured to massive; moderately hard; deeply to moderately weathered.				
Water Test #1 8.2'-15.1'. No loss	15		0.0'-4.0' Core in 1/2 inch to 2 inches fragments, rounded by drilling action.	Water Test #1 8.2'-15.1'. No loss	15		
Water Test #2 13.5'-25.4'. No loss	25		4.0'-5.0' Closely fractured.	Water Test #2 13.5'-25.4'. No loss	25		
Water Test #3 23.1'-35.0'. No loss	35		5.0'-7.0' Closely to moderately fractured, intersecting 60 degrees dipping fractures with clay coatings and iron oxide stains.	Water Test #3 23.1'-35.0'. No loss	35		
Driller reports mud on bit at 45.4 feet. Water Test #4 33.5'-45.4'. No loss	45		12.5'-15.5' Zone of close spaced, sheeted and intersecting fractures, clay and chlorite coated surfaces.	Water Test #4 33.5'-45.4'. No loss	45		
Water Test #5 42.7'-54.6'. No loss	55		20.5'-21.5' Irregular, rough surfaced fractures.	Water Test #5 42.7'-54.6'. No loss	55		
Hole caved from undetermined depth after run to 60.4', 5' of core retrieved in next run.	60		40.0'-41.2' & 45.4'-47.5' Zone of irregular, closed, chlorite-filled fractures in gray basalt porphyry.	Water Test #6 53.5'-65.4'. No loss	65		
Water Test #6 53.5'-65.4'. No loss	65		61.5'-63.0' Interval of flow breccia, light gray basalt porphyry angular fragments in dark brown-gray medium grained basalt matrix.	Water Test #7 63.5'-75.4'. No loss	75		
Core blocking and grinding at 75 feet due to blocky nature of rock. Water Test #7 63.5'-75.4'. No loss	75		Most fracture breaks very narrow with only staining of Fe <sub>2</sub> O <sub>3</sub> on surfaces.	Water Test #8 73.2'-85.1'. Loss approximately 2 GPM, Core looks tight, drills smooth and fast, possible leak at 75' or contact?	85		
Water Test #8 73.2'-85.1'. Loss approximately 2 GPM, Core looks tight, drills smooth and fast, possible leak at 75' or contact?	85		78.0'-102.7' <b>BASALT FLOW BRECCIA:</b> Reddish brown (dark brick red) color with varying concentrations of basalt clast inclusions, in a matrix of fine to medium-grained crystalline basalt. Rock is hard, cannot be scratched deeply with knife.	Water Test #9 83.3'-95.2'. No loss	95		
Water Test #9 83.3'-95.2'. No loss	95		Contact Zone Angular fragments of fine-grained gray basalt porphyry in matrix of reddish medium grained basalt, (78'-79'). Massive; hard.				

Dam Right Abutment, Saddle Hill 1027		HOLE LOCATION Hill 1027		HOLE ELEVATION 1037		ANGLE Vert. BEARING	
Cannon Drilling Co.		CORE SIZE NX		LOGGED BY RCH		DATE DRILLED 11/4-8/68	
COMMENTS	DEPTH	RECOVERY	DESCRIPTION	COMMENTS	DEPTH	RECOVERY	DESCRIPTION
Water Test #10 93.2'-105.1'. Loss 10-11 GPM, probably in fractures near contact, pressure buildup in formation with backsurge after releasing packer.	105		102.7'-108.7' <b>BASALT PORPHYRY FLOW ROCK:</b> Gray, massive, as in 0'-78' interval. Contact zone, fragments of gray basalt porphyry in reddish medium-grained basalt. Rock cut by many planar and irregular closed, chlorite-filled fractures.	Water Test #10 93.2'-105.1'. Loss 10-11 GPM, probably in fractures near contact, pressure buildup in formation with backsurge after releasing packer.	105		
Water Test #11 103.1'-115.0'. Loss 2-3 GPM, probably from 115.0 feet.	115		108.7'-129.0' <b>BASALT FLOW BRECCIA:</b> Reddish brown massive, medium-grained, with clasts of darker brown but generally similar basalt as inclusions, same as rock above 102.7 feet. Contact; gray basalt porphyry in direct contact with reddish medium-grained basalt. Contact surface irregular, but appears normal to core axis.	Water Test #11 103.1'-115.0'. Loss 2-3 GPM, probably from 115.0 feet.	115		
Water Test #12 113.5'-125.4'. Loss approximately 19 GPM, probably from several fractures, used 450 gallons of water coring this interval.	125		129.0'-134.4' <b>BASALT PORPHYRY FLOW ROCK:</b> As before. Contact; angular fragments of gray basalt porphyry in reddish medium-grained basalt.	Water Test #12 113.5'-125.4'. Loss approximately 19 GPM, probably from several fractures, used 450 gallons of water coring this interval.	125		
Water Test #13 123.5'-135.4'. Loss approximately 3 GPM, from fractures near contact (?), used 600 gallons coring this interval.	135		134.4'-155.4' <b>BASALT FLOW BRECCIA:</b> Reddish brown, as before. Contact at drilling break, not recovered.	Water Test #13 123.5'-135.4'. Loss approximately 3 GPM, from fractures near contact (?), used 600 gallons coring this interval.	135		
Water Test #14 133.4'-145.3'. Loss approximately 5-6 GPM, probably from fractures at 134' & 141'	145			Water Test #14 133.4'-145.3'. Loss approximately 5-6 GPM, probably from fractures at 134' & 141'	145		
Water Test #15 143.5'-155.4'. No loss Terminated hole at 155.4 feet.	155			Water Test #15 143.5'-155.4'. No loss Terminated hole at 155.4 feet.	155		
			BOTTOM OF HOLE = 155.4 FEET				

HOLE NO. D-15

**NOTES**

1. Notes 1, 2 and 3 on drawing number 6 apply to this drawing.

NO.	DATE	REVISIONS	BY	CHKD.	JOB ENG.	PROJ. ENG.	MON.

**LAS VIRGENES MUNICIPAL WATER DISTRICT**

**BOYLE ENGINEERING  
W. A. WAHLER & ASSOCIATES**

**WESTLAKE RESERVOIR  
GEOLOGY  
LOGS OF EXPLORATION  
SHEET 4 OF 5**

DESIGNED D.H. DATE: 11-70 JOB ENG. C.W.P. PROJ. ENG. *JH*

DRAWN B.S. CHECKED C.W.P. *R.C.E.* SCALE AS SHOWN

DRAWING NUMBER **9** REV.

05258

NOTES

1. Notes 1,2 and 3 on drawing number 6 apply to this drawing.

05259

ISSUED FOR CONSTRUCTION		REVISIONS	BY	CHKD	JOB	PROJ	ENG	ENGR	MR.
NO.	DATE								

LAS VIRGENES MUNICIPAL WATER DISTRICT

BOYLE ENGINEERING  
W. A. WAHLER & ASSOCIATES

WESTLAKE RESERVOIR  
GEOLOGY  
LOGS OF EXPLORATION  
SHEET 5 OF 5

DESIGNED D.H.	DATE: 11-70	JOB ENG. C.W.P.	PROJ. ENG. <i>JA</i>
DRAWN B.S.	<i>R. C. E.</i>	DRAWING NUMBER	REV.
CHECKED C.W.P.	<i>R. C. E.</i>	10	
SCALE AS SHOWN	R.C.E. 1970		

HOLE LOCATION	Dam Right Abutment	HOLE ELEVATION	1008	ANGLE	45°	BEARING	NO8E
DRILL RIG	Cannon Drilling Co. Joy B-12 Rig	CORE SIZE	NX	LOGGED BY	RCH	DATE DRILLED	11/16-20/68
COMMENTS	DEPTH	RECOVERY	CONDITION	DESCRIPTION			
	0'-13.0'			<b>BASALT PORPHYRY BRECCIA:</b> Pale purple, fragments of porphyritic basalt in auto-brecciated matrix; phenocrysts are mainly white plagioclase laths. Closely to moderately fractured; no clay fillings in fractures, oxide staining on some; hard; moderately strong; moderately weathered.			
	13.0'-49.0'			<b>BASALT FLOW BRECCIA:</b> Angular fragments in microcrystalline matrix; fragments are sand to cobble size, closely packed to scattered. Moderately fractured; no clay fillings; hard; strong; little weathered.			
Water Test #10 93.1'-105.0'. Loss 0.3-0.4 GPM.	105.0'			94.0'-134.1' <b>INTERBEDDED BASALT and TUFF BRECCIA (Cont.)</b> Closely to little fractured, very thin clay coatings with slickensides on some fractures, calcite coatings on some with scattered calcite veinlets; basalt is hard and strong; tuff matrix is moderately hard and weak; little weathered.			
Slow drilling.	110'						
Water Test #11 101.6'-113.5'. Loss 0.5-0.7 GPM.	113.5'						
Water Test #12 111.4'-123.3'. Loss 2.8 GPM, probably in fracture at 117'.	123.3'			123.0'-134.1' Basalt is moderately weathered, intensely to closely fractured with abundant thin shear planes, clay fillings in fractures are more numerous.			
Water Test #13 120.7'-132.6'. Loss 0.4-0.6 GPM, numerous fractures.	132.6'			BOTTOM OF HOLE = 134.1 FEET			
Terminated hole at 134.1 feet	134.1'						
HOLE NO. D-16							

HOLE LOCATION	Dam Right Abutment	HOLE ELEVATION	1008	ANGLE	45°	BEARING	NO8E
DRILL RIG	Cannon Drilling Co. Joy B-12 Rig	CORE SIZE	NX	LOGGED BY	RCH	DATE DRILLED	11/16-20/68
COMMENTS	DEPTH	RECOVERY	CONDITION	DESCRIPTION			
Cored with 3 1/8" O.D. diamond bit, set casing to 5.0 feet.	5.0'			0'-13.0' <b>BASALT PORPHYRY BRECCIA:</b> Pale purple, fragments of porphyritic basalt in auto-brecciated matrix; phenocrysts are mainly white plagioclase laths. Closely to moderately fractured; no clay fillings in fractures, oxide staining on some; hard; moderately strong; moderately weathered.			
Water Test #1 8.1'-15.0'. Water loss 7-8 GPM many fractures.	15.0'			13.0'-49.0' <b>BASALT FLOW BRECCIA:</b> Angular fragments in microcrystalline matrix; fragments are sand to cobble size, closely packed to scattered. Moderately fractured; no clay fillings; hard; strong; little weathered.			
High drill water loss while coring.	20'						
Water Test #2 13.1'-25.0'. Water loss 2-3 GPM numerous fractures.	25.0'						
Water Test #3 23.1'-35.0'. No loss	35.0'			37.0'-39.0' Thin shear fracture, slickensided gouge 1/2 to 1 inch thick, oriented about 3 degrees to core axis.			
Water Test #4 32.5'-44.4'. No loss	44.4'			49.0'-55.6' <b>SHEAR ZONE:</b> Slickensided gouge and fragmented basalt; most shear planes within zone are 30 degrees to 50 degrees to core axis, slickensides are variously oriented.			
Water Test #5 42.5'-54.4'. No loss	54.4'			55.6'-94.0' <b>BASALT FLOW BRECCIA:</b> Angular fragments of basalt in fine-grained crystalline matrix; fragments generally sand to gravel size and range from closely packed to scattered in matrix. Closely to little fractured; no clay fillings in fractures, slickensides on some; moderately hard; moderately strong; moderately weathered.			
Water Test #6 52.3'-64.2'. No loss	64.2'						
Water Test #7 62.7'-74.6'. No loss Erratic drilling rates, slow to fast.	74.6'						
Water Test #8 72.5'-84.4'. No loss 600 gallons of water used in coring 64 to 93 feet.	84.4'						
Water Test #9 82.0'-93.9'. No loss	93.9'			94.0'-134.1' <b>INTERBEDDED BASALT and TUFF BRECCIA:</b> Porphyritic basalt with phenocrysts of olivine and pyroxene (?) altered to chlorite in dense microcrystalline matrix; tuff breccia consists of various textured basalt clasts, gravel to cobble size, angular; in fine-grained tuff matrix.			



HOLE LOCATION BORROW AREA 1		HOLE ELEVATION 1240' (TOPO)	ANGLE 90°	BEARING
DRILL RIG JOY 12B--Fred Cannon Co.		CORE SIZE N <sub>x</sub>	LOGGED BY RET	DATE DRILLED 1/19-21/70
COMMENTS	DEPTH RECOVERY LOG	DESCRIPTION		
	0	0.0-60.0 BASALT FLOW BRECCIA; angular to sub-angular fragments of BASALT and olivine BASALT in a matrix of fine-grained BASALT. Matrix is generally darker, finer-grained, and less altered than the breccia fragments. Rock is purplish brown to gray on fresh surfaces, tan to greenish brown where weathered. Moderately to closely fractured; fractures dip 30° or less, and nearly vertical. Moderately hard and strong, moderately to severely weathered.		
	5	(0.0-4.0) Massive BASALT flow unit, purplish gray, moderately hard and strong, fracture spacing 0.1 to 0.6 foot, crush zone at 2.1-2.5 feet.		
	10	(4.0-37.5) BASALT flow breccia, mottled green and purplish brown. Moderately hard and strong, moderately weathered (locally severely weathered). Fracture spacing 0.1 to 1.2 feet, averages 0.3 foot. Most fractures have patchy oxide coatings; a few have mud-like fillings to 1/16 inch thick.		
	15	(7.0-7.1) Crush zone		
	20	(13.2-13.5) Crush zone.		
	25	(26.3) Calcite vein 1/8-inch thick.		
	30	(37.5-60.0) BASALT flow breccia, purplish gray and greenish gray. Moderately hard and strong, moderately weathered. Fracture spacing 0.1 to 2.0 feet; average fracture spacing 0.5 foot. Fractures generally uncoated; a few have patchy oxide coatings.		
	35	(46.0-47.2) Altered zone, brown, weak.		
	40	(55.2) Thin crush zone, nearly horizontal.		
	45			
	50			
	55			
	60	BOTTOM OF HOLE = 60.0 FEET		
NOTES: 1. Collar is about 2 feet below original ground. 2. Average rock hardness 3.5-4.5 on Moh's scale, 1-28-70. 3. Water level 35.9 feet. 4. Fluid take during drilling was very low--250 gallons used for entire hole. BOX 1 of 4: 0.0-17.6 2 of 4: 17.6-36.1 3 of 4: 36.1-55.3 4 of 4: 55.3-60.0				

HOLE NO. D-17

HOLE LOCATION BORROW AREA 1		HOLE ELEVATION 1222' (TOPO)	ANGLE 90°	BEARING
DRILL RIG JOY 12B--Fred Cannon Co.		CORE SIZE N <sub>x</sub>	LOGGED BY RET	DATE DRILLED 1/22-26/70
COMMENTS	DEPTH RECOVERY LOG	DESCRIPTION		
	0	0.0-15.1 BASALT; hard, fresh, fine-grained BASALT with about 1% scattered, altered olivine phenocrysts up to 1/8-inch diameter. Rock is blue-gray on cored surface, black on freshly broken surface. Fracture spacing 0.1 foot to 0.6 foot, averages 0.4 foot. Most fractures have extensive oxide and mud-like coatings; a few have crushed rock fillings up to 1/10-inch thick. Fractures dip 0°-20°, 45°, and nearly vertically in core. Slickensides present on some fracture coatings. Massive--no flow structure apparent.		
	5	(10.0) specific gravity = 2.61		
	10			
	15	15.1-70.0 BASALT FLOW BRECCIA; angular to sub-angular fragments of BASALT and olivine BASALT in a matrix of fine- to medium-grained BASALT. Matrix material (about 60% of total volume) is purplish gray, medium hard, and moderately weathered. Breccia fragments are fine to coarse grained, gray and greenish-gray, basaltic rock, medium hard and moderately weathered, but locally are altered and distinctly weaker than the matrix.		
	20	Fractures dip at 0°-20° and 45°-60°; a few are nearly vertical. Fractures pass through matrix and included fragments directly; no preference shown towards breaking around inclusions. Fracture spacing 0.1 to 1.9 feet, average spacing about 0.8 foot.		
	25	(15.1-19.1) Most fractures have thin sand, clay, or oxide coatings.		
	30	(19.1-49.0) Fractures clean or have patchy mud or caliche coatings.		
	35	(19.5-19.8) Crush zone, dips 60°.		
	40	(36.8-37.2) Crush zone.		
	45	(37.5) 1/4" Calcite vein.		
	50	(41.5-41.9) Crush zone.		
	55	(49.0-70.0) Fractures generally clean; some have thin clay coatings or fillings to 1/10-inch thick, and show slickensides.		
	60	(58.5) Trace of iron sulfide (Pyrite?)		
	65	(58.7) Flow structure, dips 30°.		
	70	(63.0) Thin crush zone.		
		(65.4-65.8) Alteration and crush zone.		
		(59.0) Specific gravity = 2.35		
		BOTTOM OF HOLE = 70.0 FEET		
NOTES: 1. Hole caved at 2 feet, 1/28/70. 2. Collar is approximately 8 feet below original ground. 3. Average rock hardness 3.5-4.5 on Moh's scale. 4. Rock is of light heft throughout. 5. 500 gallons of drilling water used for entire hole. 6. Boundaries between FLOW BRECCIA units are indistinct, but individual flows appear to range from 5 to 25 feet thick. BOX 1 of 4: 0.0-19.1 2 of 4: 19.1-37.4 3 of 4: 37.4-54.4 4 of 4: 54.4-70.0				

HOLE NO. D-18

HOLE LOCATION BORROW AREA 1		HOLE ELEVATION 1144' (TOPO)	ANGLE 90°	BEARING
DRILL RIG JOY 12B--Fred Cannon Co.		CORE SIZE N <sub>x</sub>	LOGGED BY RET	DATE DRILLED 1/24-26/70
COMMENTS	DEPTH RECOVERY LOG	DESCRIPTION		
	0	0.0-50.0 BASALT FLOW BRECCIA; angular to subangular fragments of BASALT and ANDESITE in a matrix of fine-grained BASALT. Matrix material is about 2/3 of total volume. Included fragments vary in size from 1/4-inch to about 1 foot in diameter apparent in the core. Bedding or flow structure lacking.		
	5	(0.0-13.6) Tan, moderately to severely weathered, many inclusions altered, core has a pock-marked appearance due to voids where olivine crystals have weathered away. Fracture spacing 0.1 to 0.6 foot; fractures have mud and oxide coatings. 1/2-inch crush zone at 4 feet. Closely fractured at about 13 feet.		
	10	(13.6-50.0) Blue-gray matrix with greenish inclusions. Moderately weathered, moderately hard and strong. Fracture spacing 0.1 to 3.0 feet, average 0.8 foot. Most fractures are clean; some have patch clay and/or oxide coatings. Most fractures are either nearly horizontal or nearly vertical.		
	15	(34.8-50.0) Rock appears to be slightly altered, but is moderately hard and strong.		
	20	(35.8) 2" alteration and crush zone.		
	25	(38.6) 1" crush zone, horizontal.		
	30	(40.2) 1" crush zone, horizontal.		
	35	(49.0) Thin shear zone, dips 45°.		
	40	NOTES: 1. Fluid level 1/31/70: 27.5 feet.		
	45	2. Hole took about 500 gallons of water per day. Most of the water seemed to go into fractures at 13 feet and 35 feet.		
	50	3. Collar is approximately 1 foot below original ground.		
		BOTTOM OF HOLE = 50.0 FEET		

HOLE NO. D-19

NOTES

1. Notes 1.2 and 3 of drawings number 8 apply to this drawing.

05261

ISSUED FOR CONSTRUCTION				REVISIONS	BY	CHK	ENG.	PROJ. ENGR.	MGR.	
LAS VIRGENES MUNICIPAL WATER DISTRICT										
BOYLE ENGINEERING W. A. WAHLER & ASSOCIATES										
WESTLAKE RESERVOIR BORROW AREAS										
LOGS OF EXPLORATION - SHEET 1 OF 2										
DESIGNED F.K.	DATE 11-70	JOB ENG. C.W.P.	PROJ. ENG.	DRAWING NUMBER 12						REV.
DRAWN B.S.	CHECKED C.W.P.		SCALE AS SHOWN							

HOLE LOCATION BORROW AREA No. 1		HOLE ELEVATION 1313' (TOPO)	ANGLE 90°	BEARING
DRILL RIG Joy 12B-Fred Cannon Co.		CORE SIZE NX	LOGGED BY RET	DATE DRILLED 1/27-2/2/70
COMMENTS	DEPTH RECOVERY LOG	DESCRIPTION		
	0	0.0-80.0 BASALT FLOW AND FLOW BRECCIA; fine to coarse-grained with about 5% scattered, olivine crystals to 1/8-inch diameter. The olivine is altered throughout the hole, and locally was washed away by the drilling. The matrix of the flow breccia is as described above; about 2/3 of the flow breccia is angular to sub-rounded fragments of basaltic rock up to 1 foot long in the core. Fractures throughout dip nearly horizontally, nearly vertically, and at 25°-30° (parallel to bedding or flow structure). Individual flow units are about 2 to 15 ft. thick; boundaries are vague.		
	5			
	10			
	15	(0.0-2.0?) BASALT FLOW (?), severely weathered, weak to moderately hard, maximum core length recovered 0.3 ft.		
	20	(2.0(?) - 6.4) SANDSTONE, fine to medium-grained, thin-bedded, weak, bedding chips 25°. Fracture spacing 0.2 ft., fractures coated with oxides.		
	25	(6.4-16.0) BASALT FLOW ROCK, highly altered, greenish-gray, weak to moderately hard and strong. Fracture spacing 0.1 to 0.4 ft., averages 0.2 ft. Fractures coated with clay or alteration products.		
	30	(16.0-21.0) BASALT FLOW ROCK, moderately weathered, moderately hard and strong, locally altered and weak. 1/2-inch chalcedony vein @ 16.5-18.5.		
	35	(21.0-47.0) BASALT FLOW BRECCIA, generally slightly to moderately weathered.		
	40			
	45			
	50			
	55	(21.0-47.0) BASALT FLOW BRECCIA--Cont., moderately hard and strong. Fracture spacing 0.1 to 2.3 ft., averages 0.5 ft. Most fractures have patch clay or oxide coatings.		
	60	(47.0-65.5) BASALT FLOW ROCK, slightly to moderately weathered, moderately hard and strong, gray to reddish gray. Fracture spacing 0.2 to 2.3 ft., averages 1 foot. Fractures clean or have patchy clay coatings. Contains a few scattered inclusions.		
	65	(65.5-80.0) BASALT FLOW BRECCIA, slightly to moderately weathered, moderately hard and strong. Fracture spacing 0.1 to 2.3 ft., averages 0.8 ft. Most fractures have patchy clay coatings.		
	70			
	75			
	80	BOTTOM OF HOLE = 80.0 FEET		
		NOTES: 1. Fluid level 2/2/70: 13.8 feet. 2. Elevations are unsurveyed. 3. Fluid take was low during drilling. 4. Collar is approximately 3 feet below original ground.		

HOLE NO. D-20

HOLE LOCATION BORROW AREA No. 3		HOLE ELEVATION 1145 (TOPO)	ANGLE 90°	BEARING
DRILL RIG Joy 12B--Fred Cannon Co.		CORE SIZE NX	LOGGED BY RET	DATE DRILLED 2/4-6/70
COMMENTS	DEPTH RECOVERY LOG	DESCRIPTION		
	0	0-2.0 SOIL; Silty SAND		
	5	2.0-55.0 BASALT FLOW BRECCIA; Angular to sub-rounded fragments of BASALT and ANDESITE in a matrix of fine-to coarse-grained BASALT. Included fragments (1/16-inch to 1 foot diameter) make up about 75% of the rock; the matrix is about 25% of the rock, color greenish to purplish gray. Moderately to closely fractured, fractures dip 30° and nearly horizontal.		
	10	(2.0-16.0) BASALT FLOW BRECCIA, severely to moderately weathered, weak to moderately hard and strong. Fracture spacing 0.05 to 0.8ft. Fractures generally have thin or clay fillings. May include some sedimentary breccia.		
	15	(16.0-55.0) BASALT FLOW BRECCIA, moderately to slightly weathered, moderately hard and strong. Fracture spacing 0.1 to 2.5 ft., averages about 1 ft. Fracture surfaces clean or have thin to patchy clay coatings.		
	20			
	25	Cemented interval 20.0-23.0 to stop water loss at 22.6 ft.		
	30			
	35			
	40			
	45			
	50			
	55	BOTTOM OF HOLE = 55.0 FEET		
		NOTES: 1. Water level 2/10/70: 7 feet. 2. Collar and original ground elevations are the same.		

HOLE NO. D-21

HOLE LOCATION BORROW AREA No. 3		HOLE ELEVATION 1125 (TOPO)	ANGLE 90°	BEARING
DRILL RIG Joy 12B--Fred Cannon Co.		CORE SIZE NX	LOGGED BY RET	DATE DRILLED 2/8-10/70
COMMENTS	DEPTH RECOVERY LOG	DESCRIPTION		
	0	0.0-27.8 BASALT FLOW ROCK; generally fine-grained with about 2% disseminated phenocrysts of altered olivine. Moderately hard and strong, to hard and locally brittle. Fracture spacing 0.6 to 0.05 ft., averages 0.3ft. Fractures dip 15°, 60°, and nearly vertical. Fractures have clay or oxide coatings, many show slickensides. Flow structure vague, apparently parallels fractures dipping @ 15°.		
	5			
	10	(0.0-5.0) Moderately weathered, medium-grained.		
	15	(5.0-27.8) Moderately to slightly weathered; hard and strong.		
	20			
	25			
	30	27.8-39.5 BASALT FLOW BRECCIA; angular to sub-rounded fragments of BASALT and olivine BASALT in a matrix of fine-to medium-grained BASALT. Green where altered, dark gray where fresh or moderately weathered. Fracture spacing 0.3 to 1.0 ft., averages about 0.6 ft. Most fractures have patchy to extensive thin clay coatings which show slickensides.		
	35			
	40	39.5-45.0 BASALT FLOW ROCK; Similar to interval 0.0-27.8. Severely to moderately weathered, moderately hard and strong. Fracture spacing 0.05 to 0.5 ft. Fractures dip 25° and 70-90°. Most fractures have clay fillings up to 1/10-inch thick and show oblique-slip slickensides.		
	45			
	50	BOTTOM OF HOLE = 45.0 FEET		
		NOTES: 1. Water level 2/11/70: 5 feet 2. original ground elevation 1130 (TOPO)		


HOLE NO. D-22

NOTES

1. Notes 1.2 and 3 of drawings number 8 apply to this drawing.


05262

ISSUED FOR CONSTRUCTION				T.E.M. R.E. E.T.M. S.H. J.V.	
NO.	DATE	REVISIONS	BY	CHK.	PROJ. ENGR. ENGR. IN CH. MGR.
<b>LAS VIRGENES MUNICIPAL WATER DISTRICT</b>					
BOYLE ENGINEERING W. A. WAHLER & ASSOCIATES					
WESTLAKE RESERVOIR <b>BORROW AREAS</b>					
LOGS OF EXPLORATION - SHEET 2 OF 2					
DESIGNED F.K.	DATE: 11-70	JOB ENGR. C.W.P.	PROJ. ENGR.	9/1	
DRAWN B.S.	R. C. E. 1/76		DRAWING NUMBER	13	
CHECKED C.W.P.			SCALE AS SHOWN		

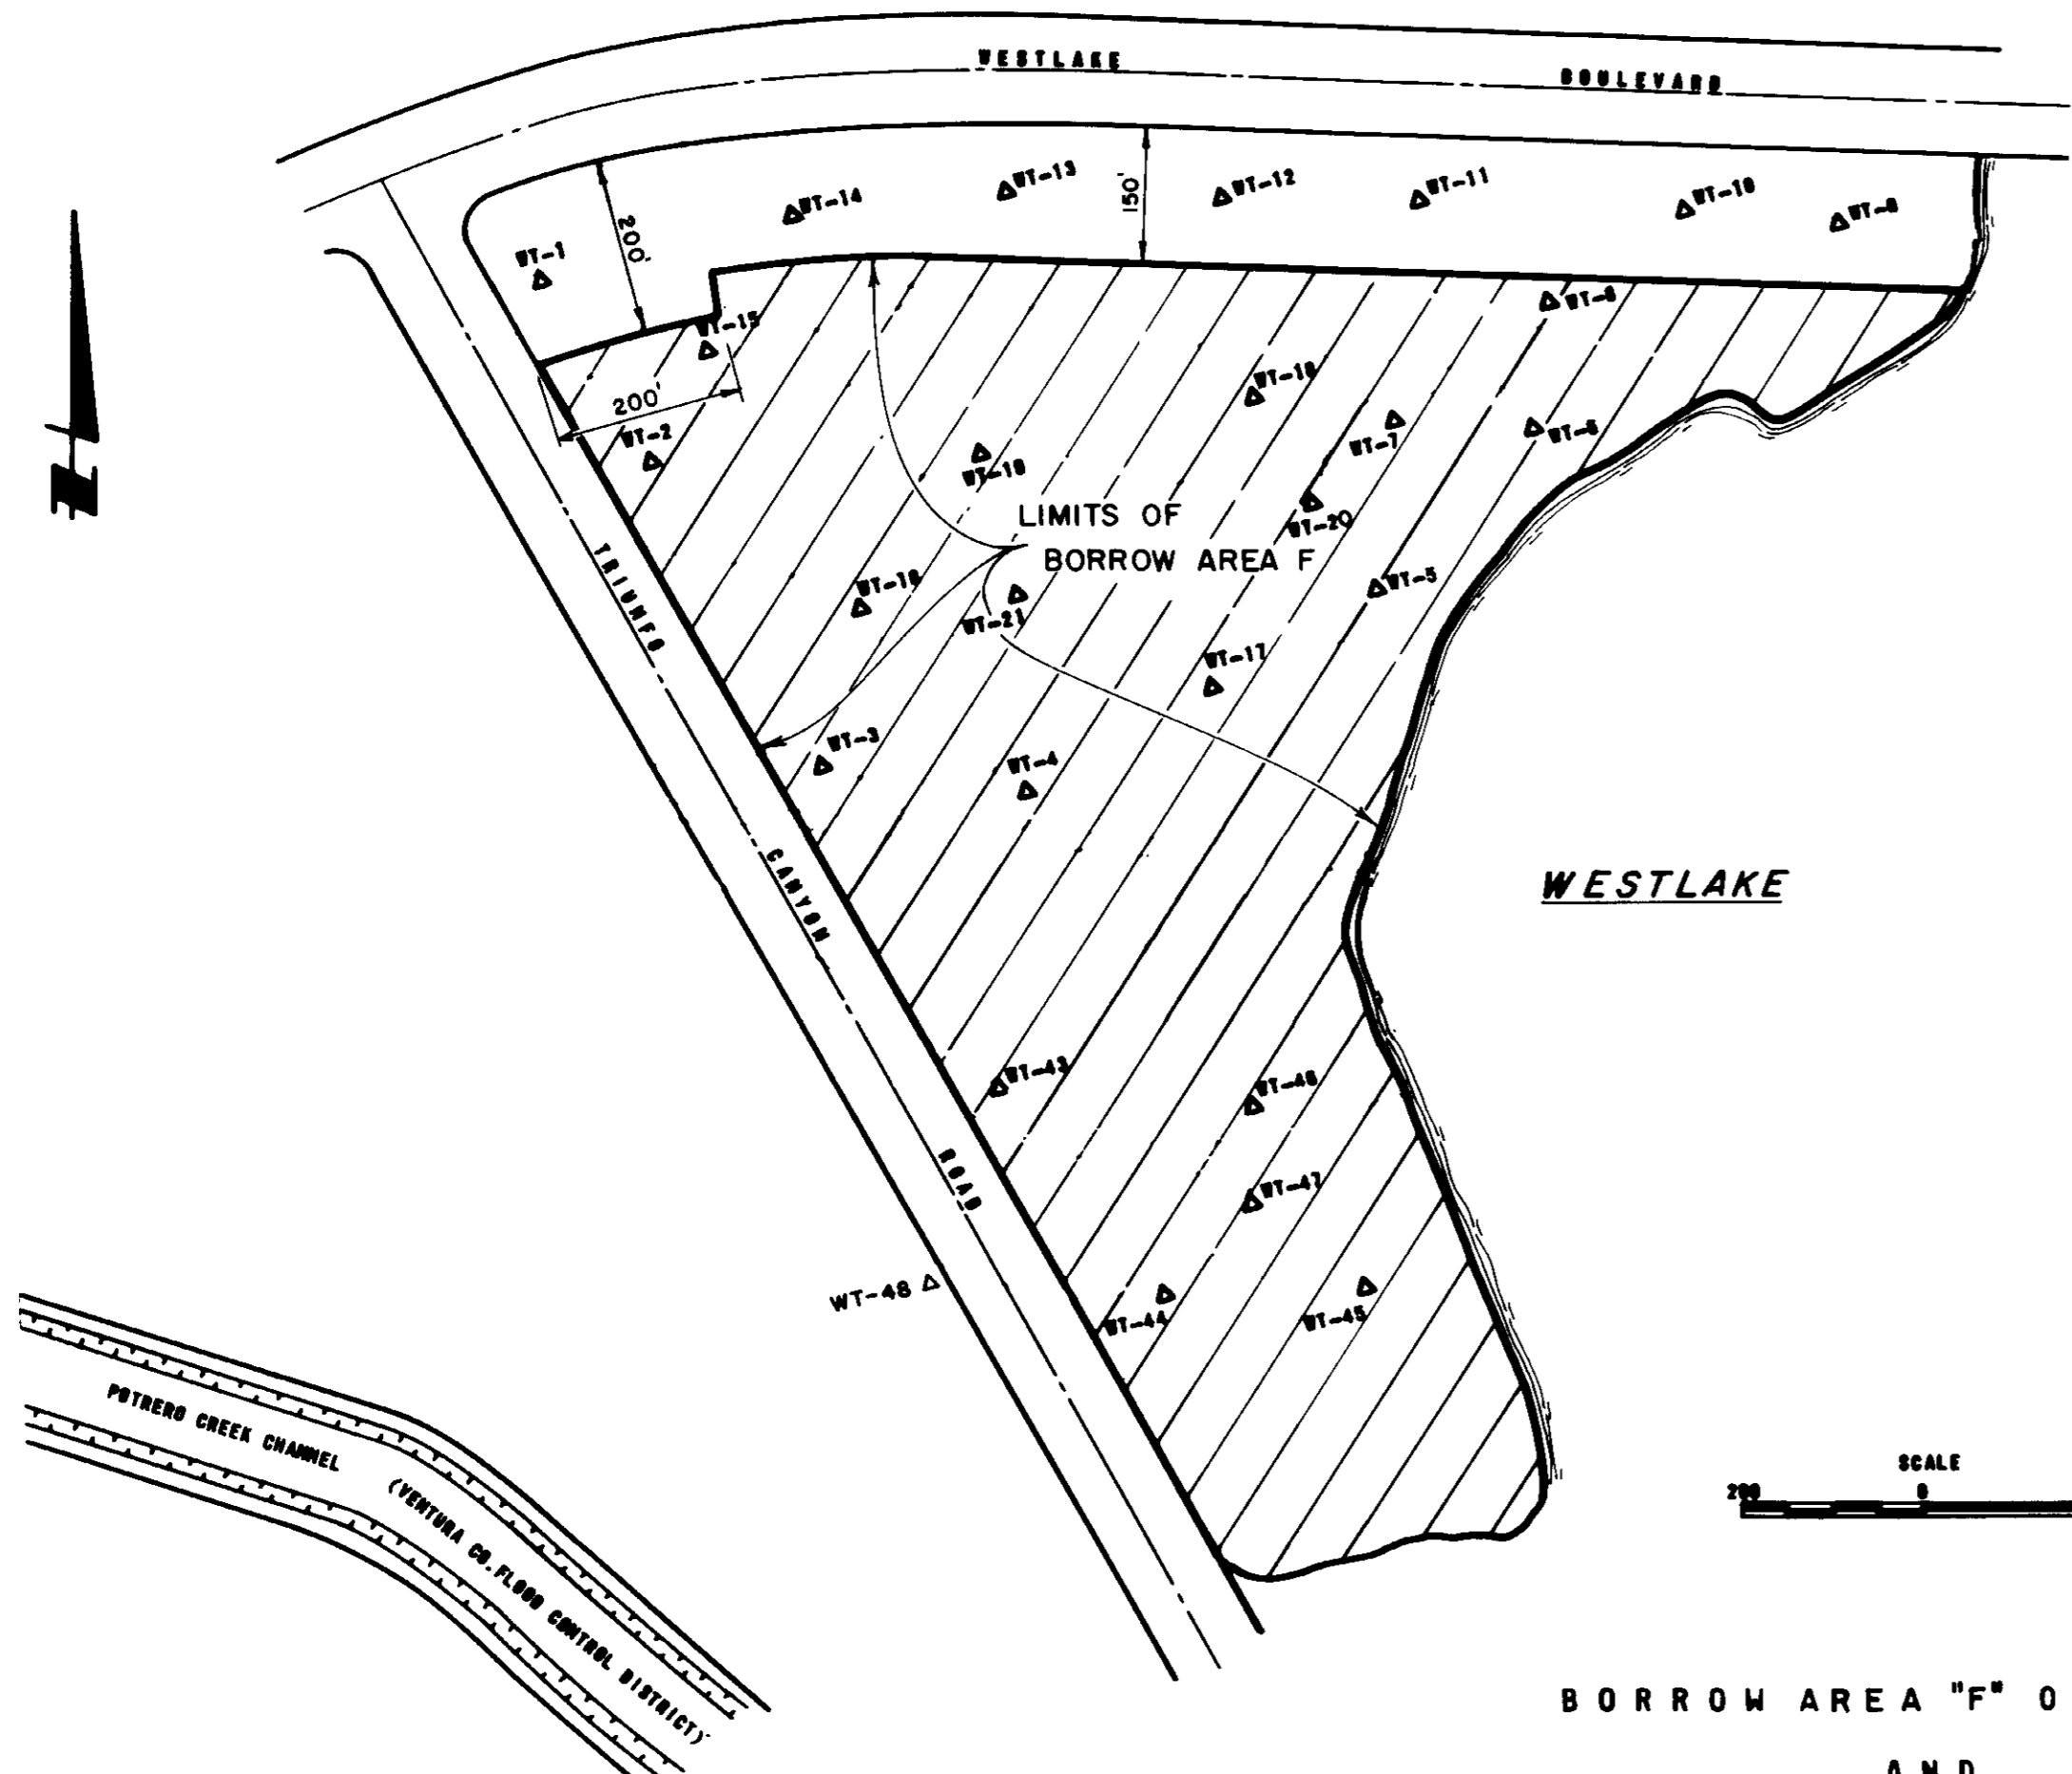


BORROW AREA "F" OUTLINE AND TRENCH LOCATION MAP


TRENCH WT-1

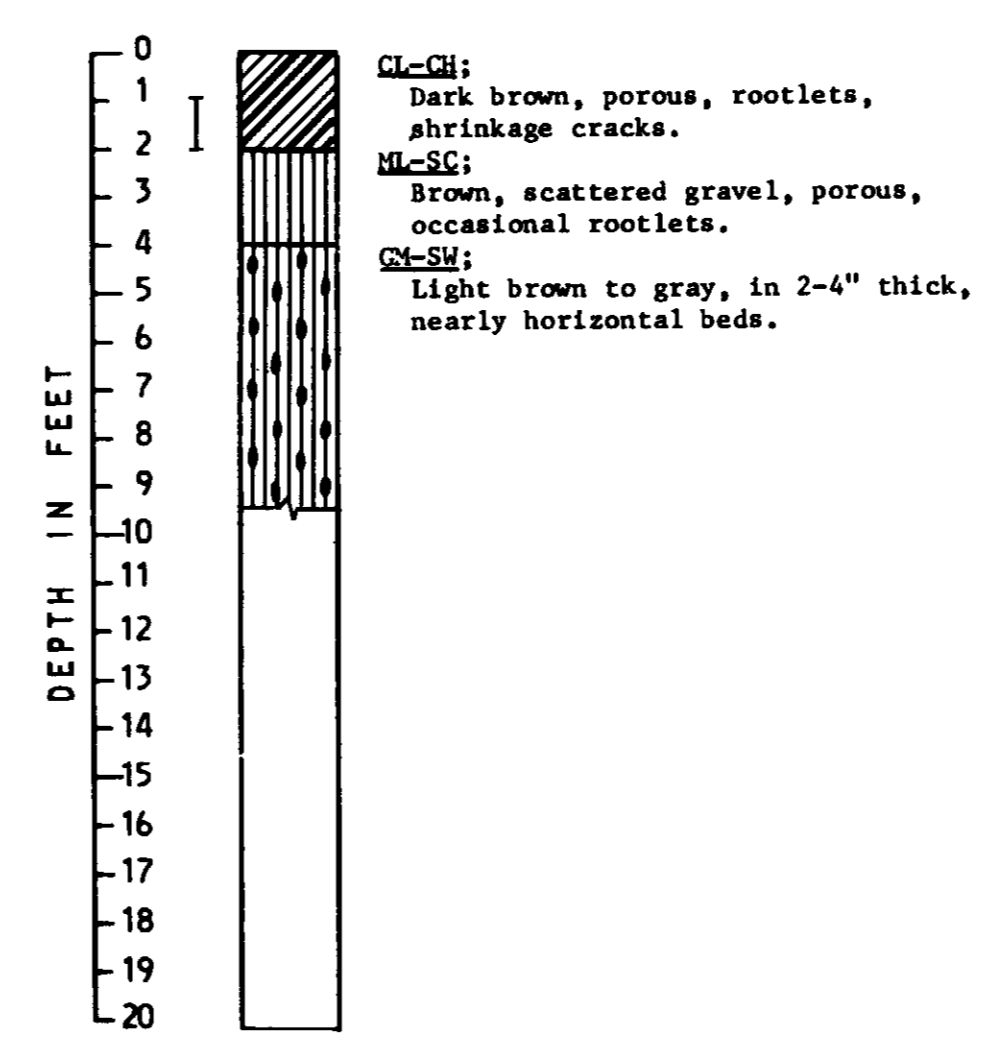

TRENCH WT-2

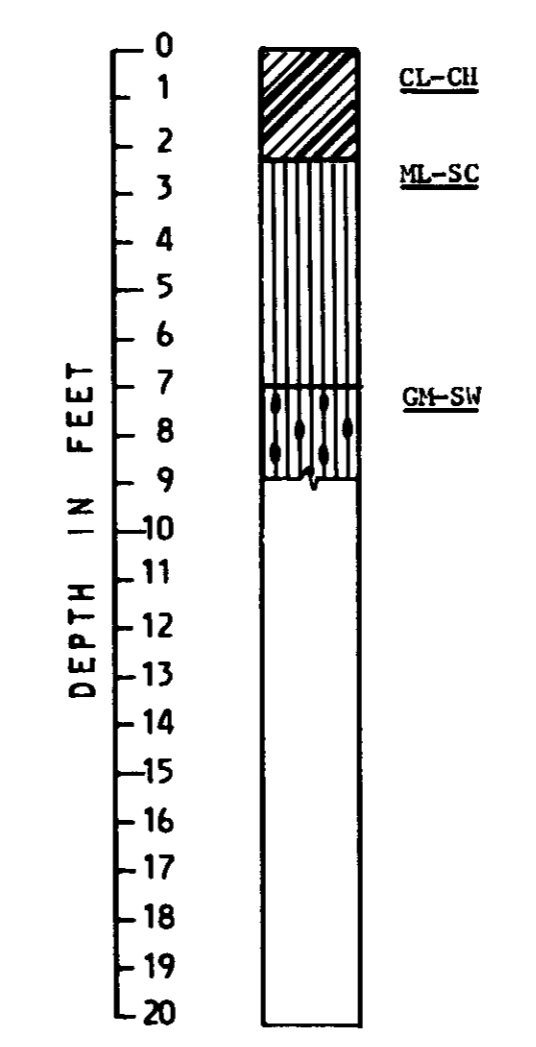

TRENCH WT-3

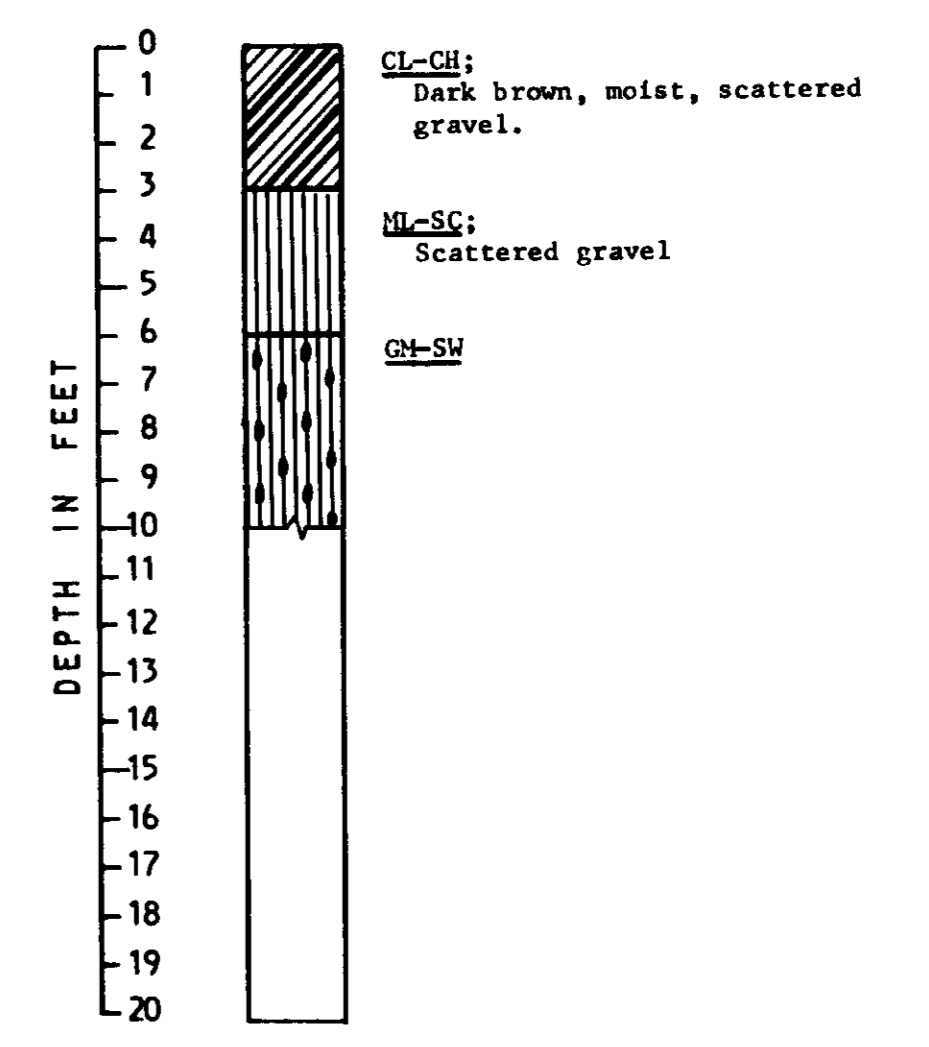


NOTES


- The subsurface information shown in the trench logs presented on this drawing indicate conditions found only at the date and location of the trench. Users of this information are cautioned that the Engineer and W.A. Wahler and Associates in no way warrant that such information is representative of conditions at any other location, or at any other time. Strata, lithology and other conditions may change between trenches due to lensing or discontinuity of formation or due to dipping of strata or other causes. Groundwater levels are subject to change with time, depending on precipitation and subsurface runoff, etc.
- The subsurface exploration program was carried out to provide a basis for the design of the works presented in these plans. Reasonable continuity between points of known data was assumed for design purposes. If conditions differing substantially from those shown are encountered, the Engineer shall be notified to permit modified recommendations and/or design to be made.
- Additional trenches, other than those shown on Trench Location Map, have been excavated in the vicinity. These additional trenches were outside the limits of Borrow Area F, and are therefore not shown. Only the logs of trenches shown on the Trench Location Map are included in these plans.
- Soil classifications shown on logs are field classifications based on Unified Soils Classification System.
- Where soil is gradational between clay, silt, sand, and/or gravel, log representation has been patterned with symbol for predominant soil type.
- See Drawing number 16 for key to soil classification patterning in the trench logs.
- Trenches were made in November 1968.

05263


TRENCH WT-4

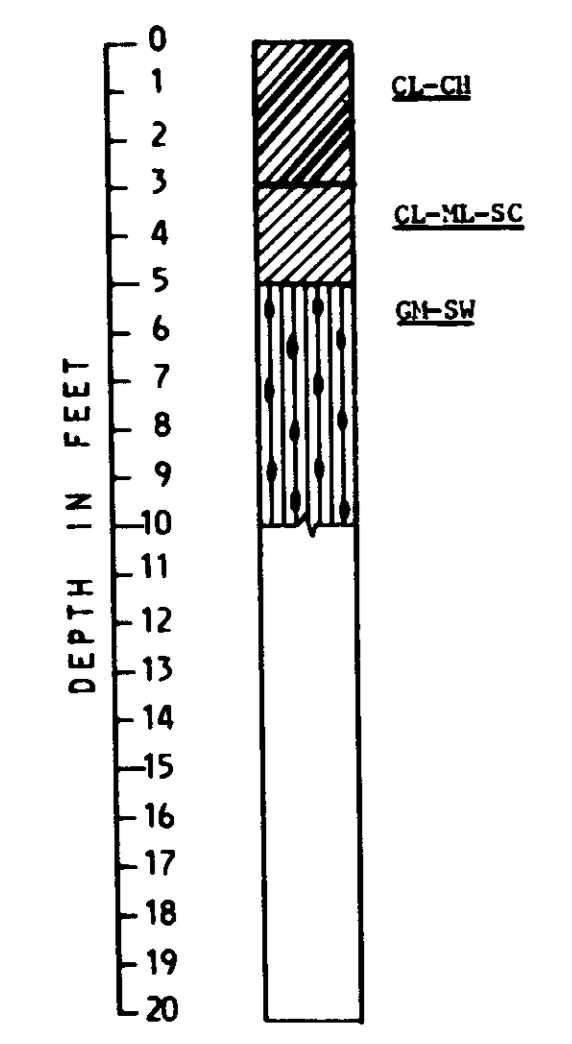


TRENCH WT-5

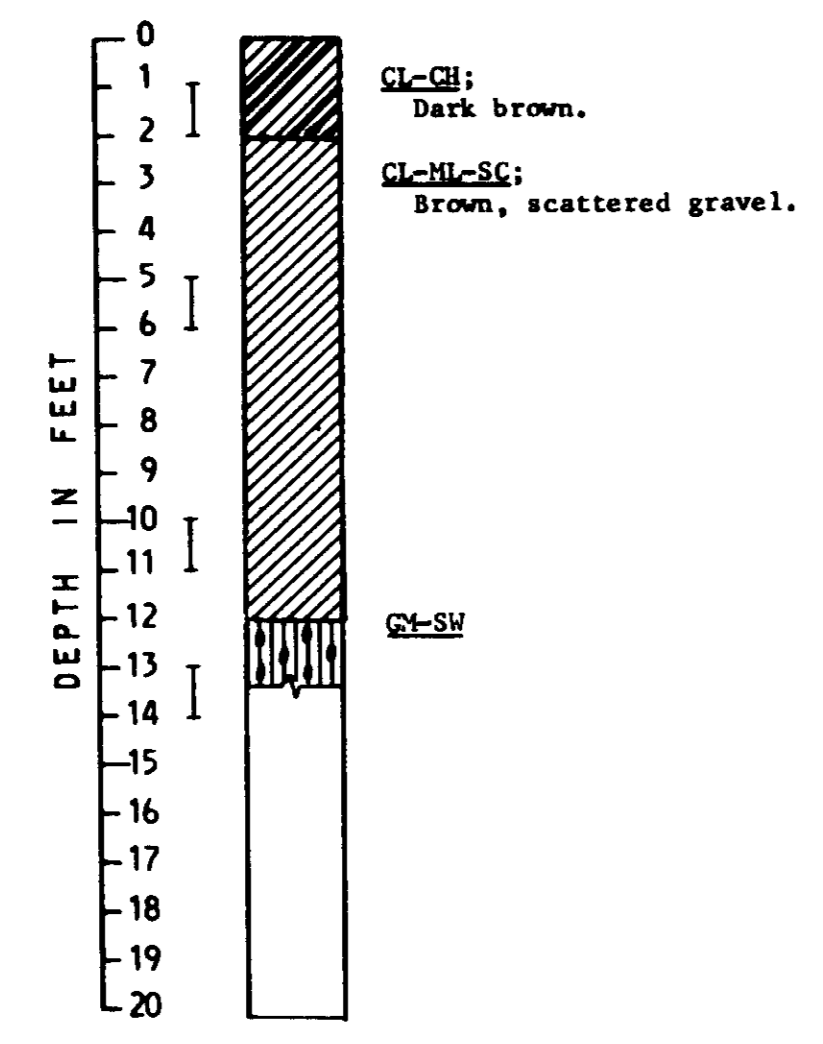


TRENCH WT-6

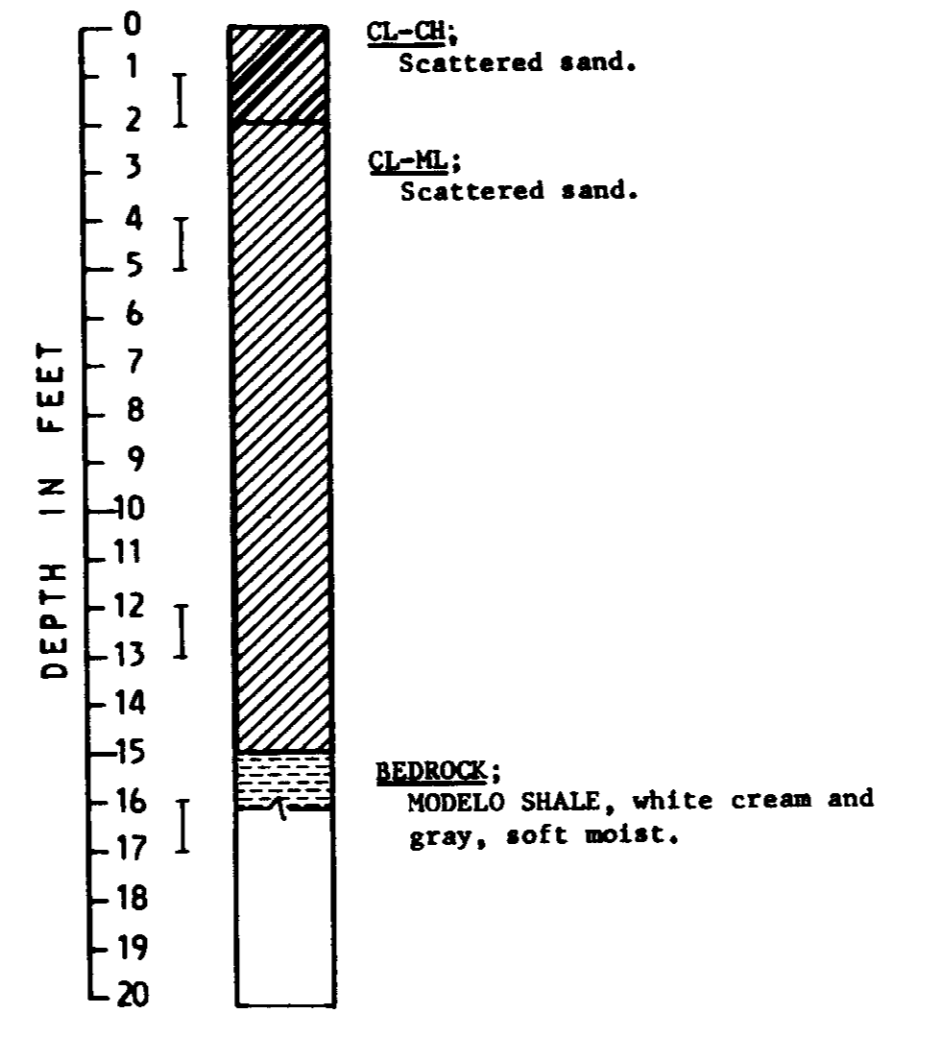

TRENCH WT-7

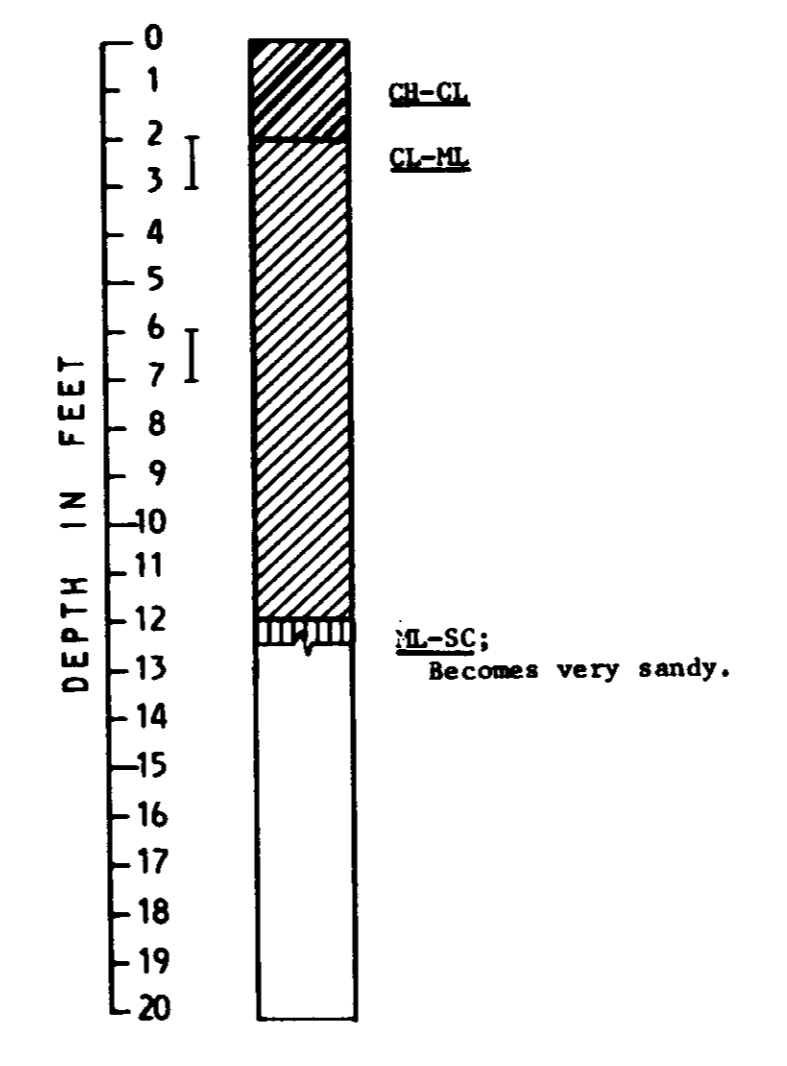

TRENCH WT-8

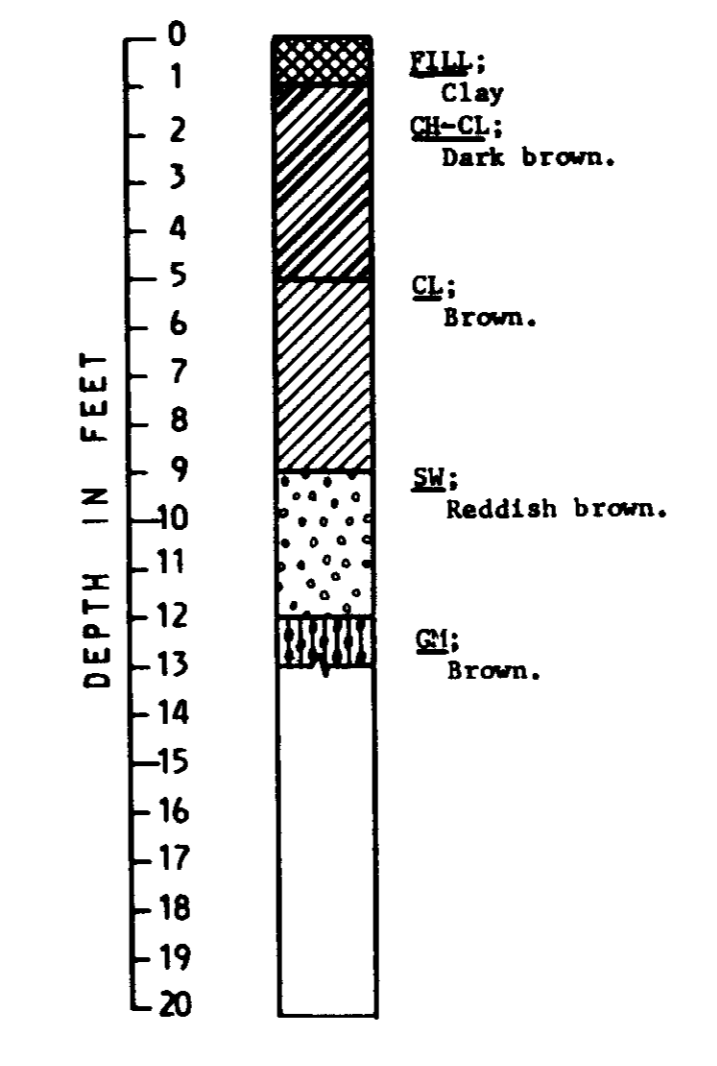

NO.	DATE	REVISIONS	BY	CHK	ENGR	PROJ	ENGR	MDR
ISSUED FOR CONSTRUCTION								


**LAS VIRGENES MUNICIPAL WATER DISTRICT**

BOYLE ENGINEERING  
W. A. WAHLER & ASSOCIATES


WESTLAKE RESERVOIR  
**ZONE I - BORROW AREA "F"**  
PLAN AND LOGS OF EXPLORATION

DESIGNED D.H.	DATE: 11-70	JOB ENGR. C.W.P.	PROJ. ENGR. [Signature]
DRAWN B.S.	CHECKED C.W.P.	[Signature]	DRAWING NUMBER 14
SCALE AS SHOWN		R. C. E. 1968	REV.


TRENCH WT-9

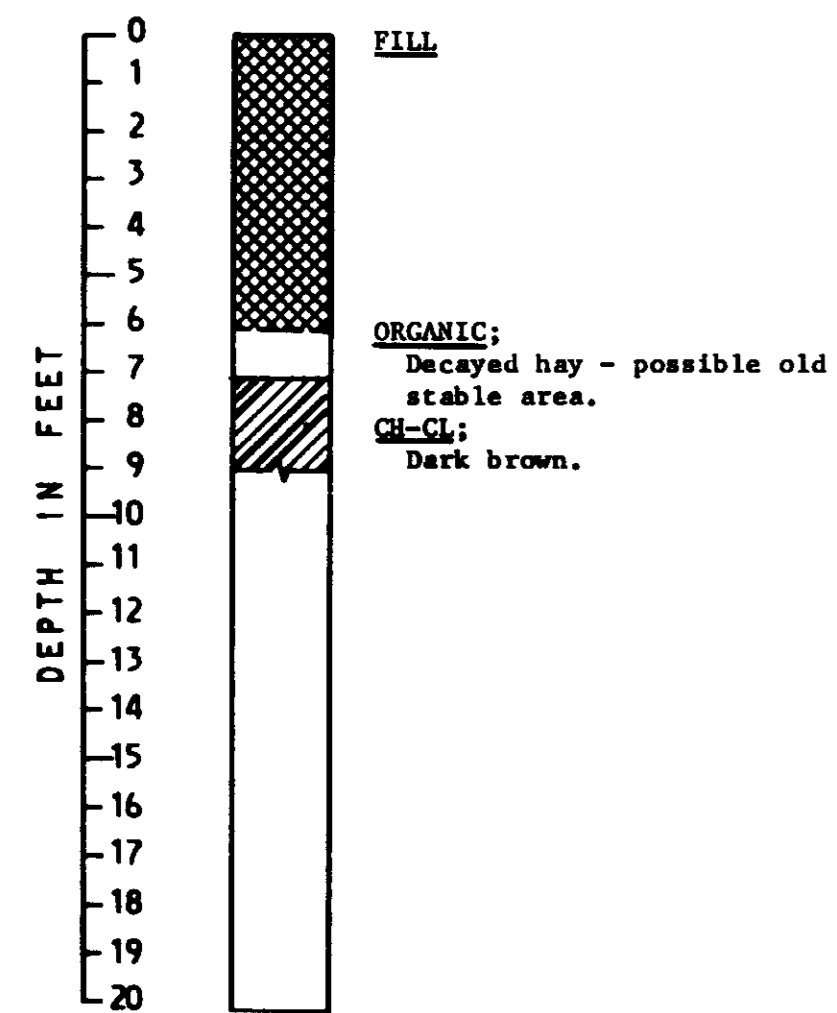


TRENCH WT-10

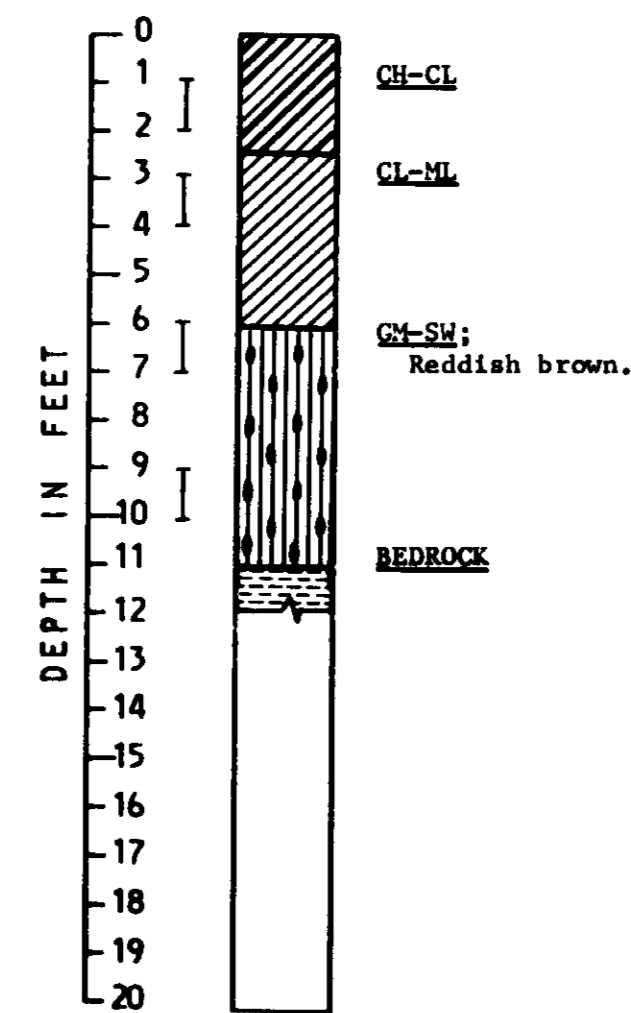


TRENCH WT-11

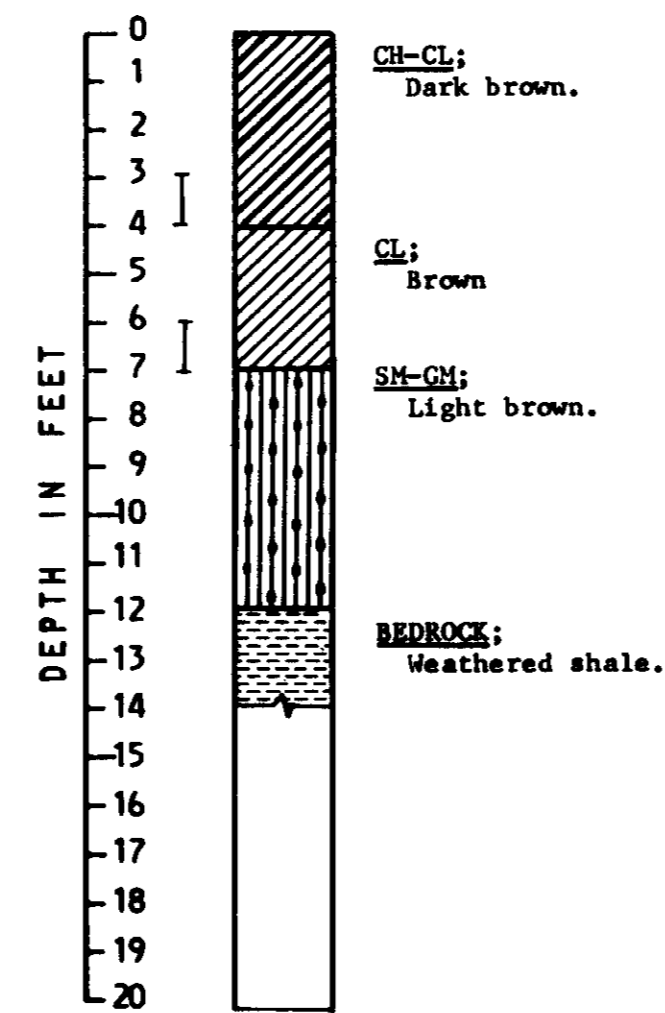


TRENCH WT-12

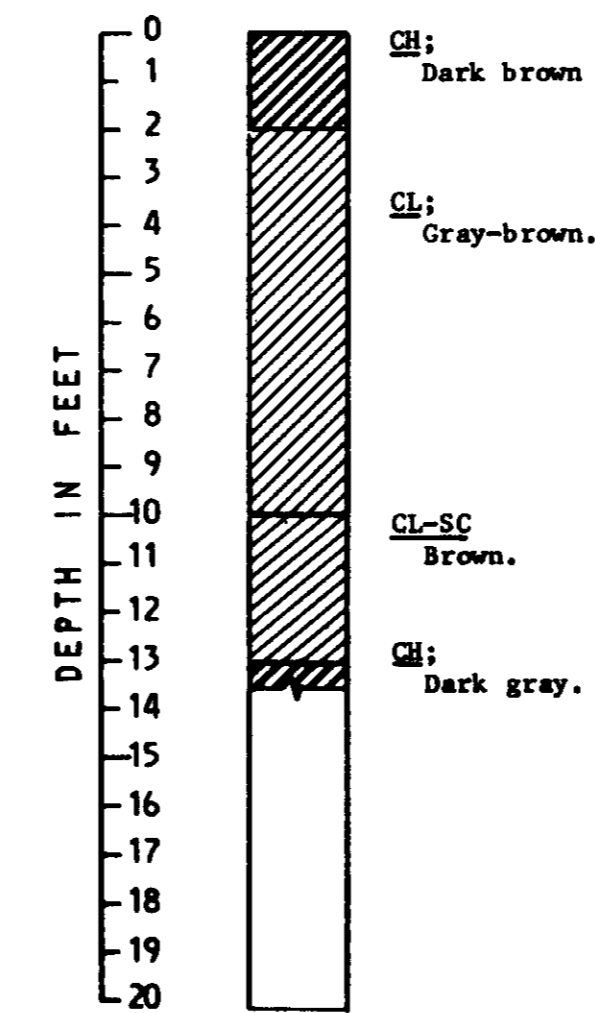


TRENCH WT-13

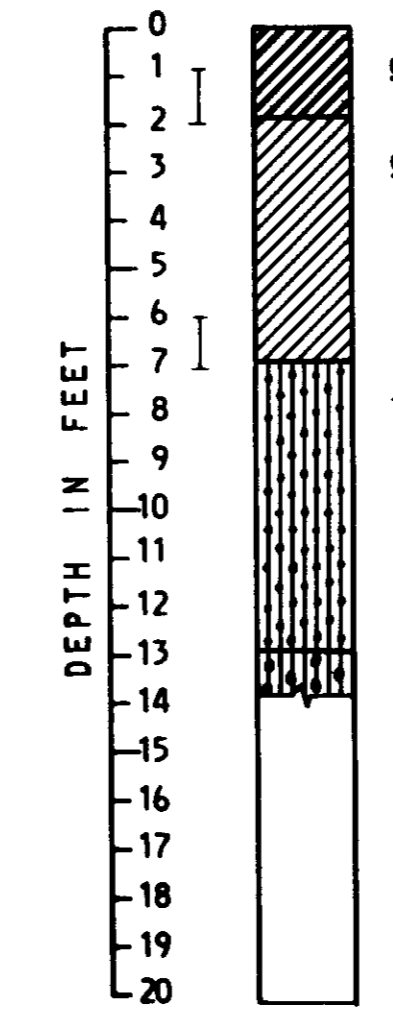


TRENCH WT-14

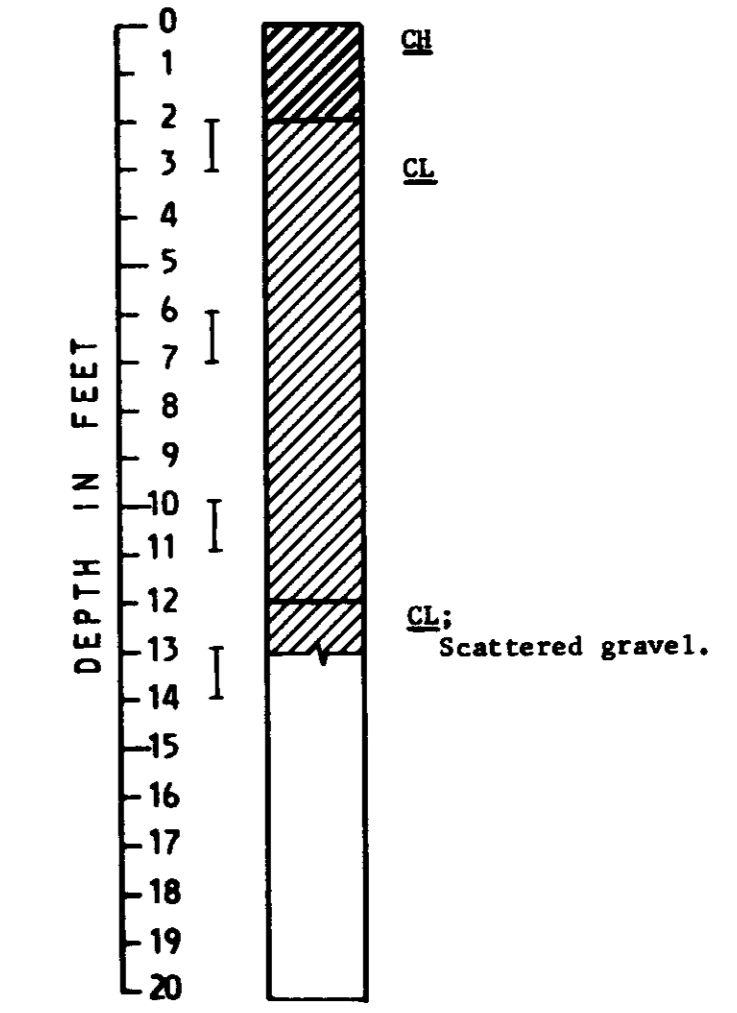


TRENCH WT-15

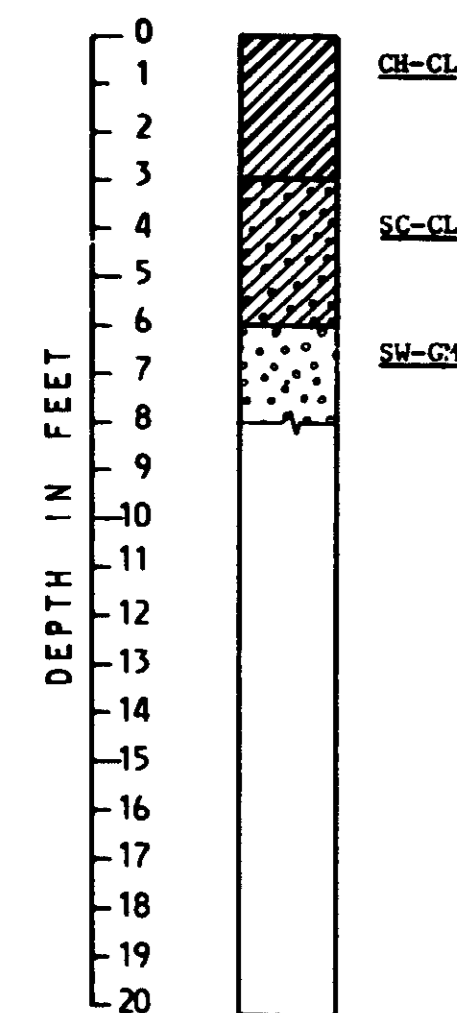


TRENCH WT-16

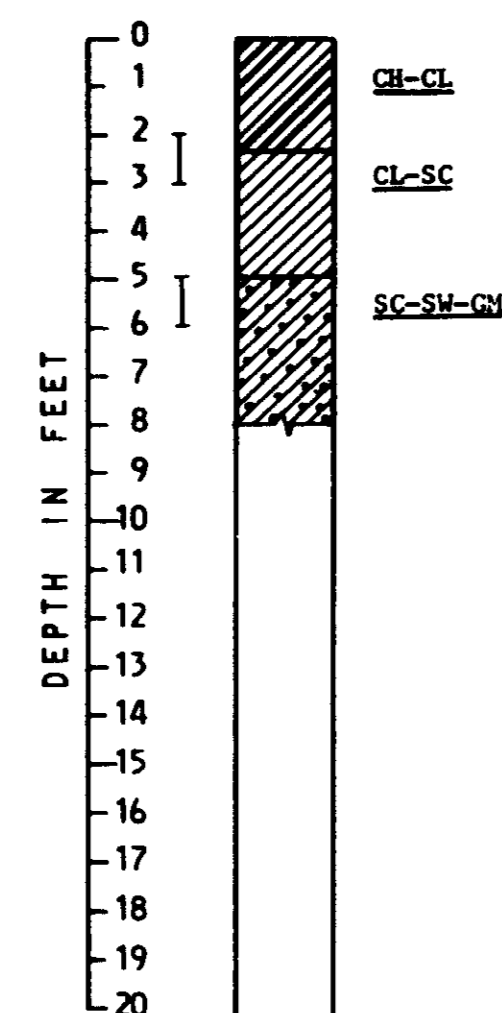


TRENCH WT-17

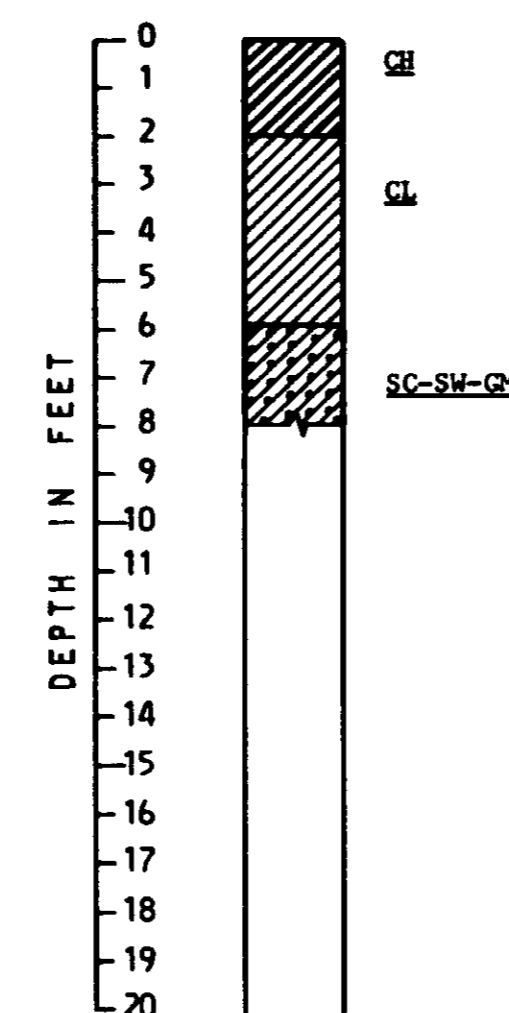

TRENCH WT-18

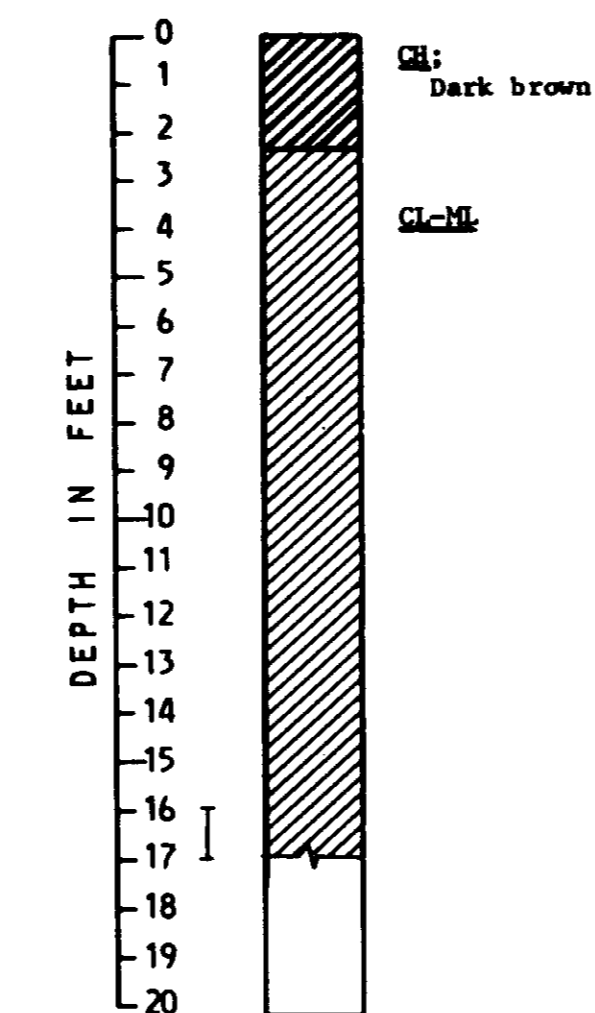

TRENCH WT-19

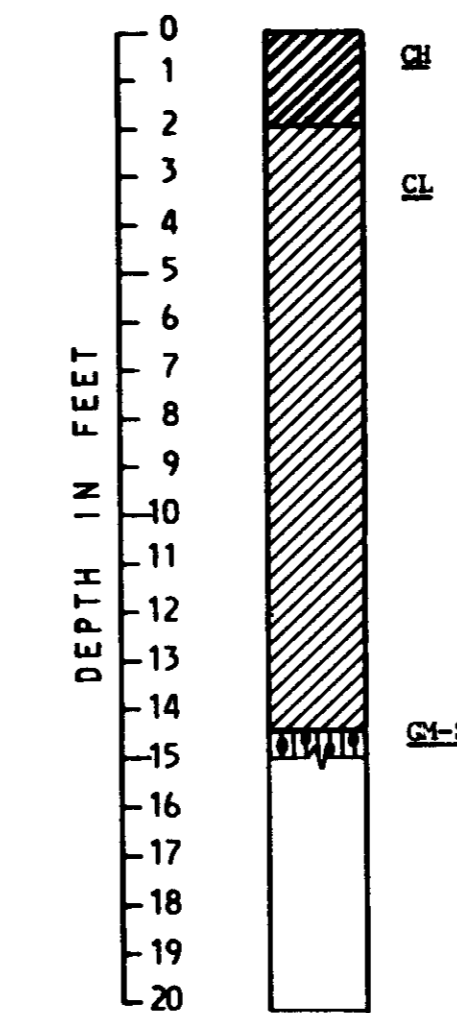

NOTES

- Notes 1 through 6 on Drawing number 14 apply to this drawing.
- See Drawing number 14 for borrow area outline and trench location map.

05264

NO.	DATE	REVISIONS	BY	CHK	ENG.	PROJ. ENG.	DR.

LAS VIRGENES MUNICIPAL WATER DISTRICT

BOYLE ENGINEERING  
W. A. WAHLER & ASSOCIATES

WESTLAKE RESERVOIR  
ZONE 1 - BORROW AREA  
LOGS OF EXPLORATION - SHEET 1 OF 2


DESIGNED D.H.	DATE: 11-70	JOB ENG. C.W.P.	PROJ. ENG.
DRAWN B.S.			
CHECKED C.W.P.			
SCALE AS SHOWN		DRAWING NUMBER	REV.
		15	




KEY TO FIELD CLASSIFICATION OF SOIL TYPE

MAJOR DIVISIONS	LETTER	SYM-BOL	DESCRIPTION
COARSE GRAINED SOILS	GRAVEL AND GRAVELLY SOILS	GW	Well-graded gravel-sand mixtures, little or no fines.
		GP	Poorly-graded gravels or gravel-sand-silt mixtures.
		GM	Silty gravels, gravel-sand-silt mixtures.
	SAND AND SANDY SOILS	GC	Clayey gravels, gravel-sand-clay mixtures.
		SW	Well-graded sand, little or no fines.
		SM	Silty sands, sand-silt mixtures.
FINE GRAINED SOILS	SILTS AND CLAYS LL < 50	ML	Inorganic silts and very fine sands, silty to clayey fine sands or clayey silts with slight plasticity.
		CL	Inorganic clays of low to medium plasticity, gravelly clays, sandy clays, silty clays, lean clays.
	CLAYS WHERE LL > 50	CL-CH CH-CL	Inorganic clays and silty clays of medium to high plasticity
	SILTS AND CLAYS LL > 50	MH	Inorganic silts, micaceous or diatomaceous, fine sandy or silty soils, elastic silts.
		CH	Inorganic clays of high plasticity, fat clays.
BEDROCK		Modelo Formation shale, siltstone, and minor diatomite.	
FILL		Artificial fill, gravelly soil and debris.	


TRENCH WT-20

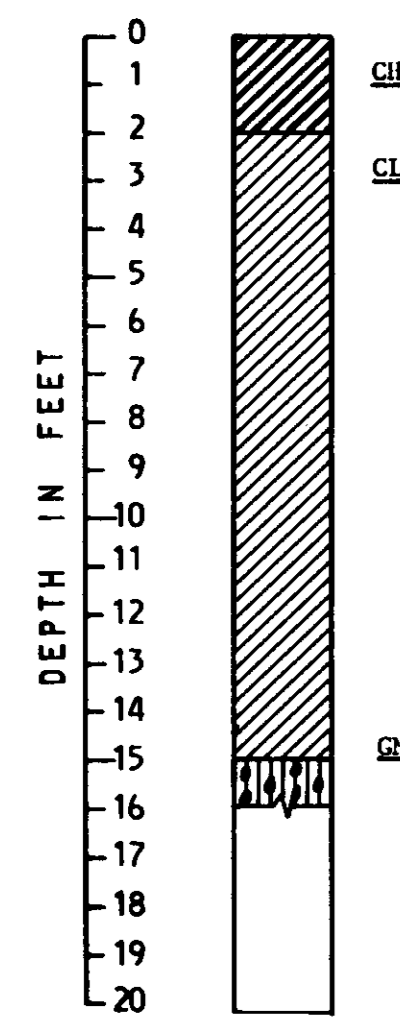


TRENCH WT-21

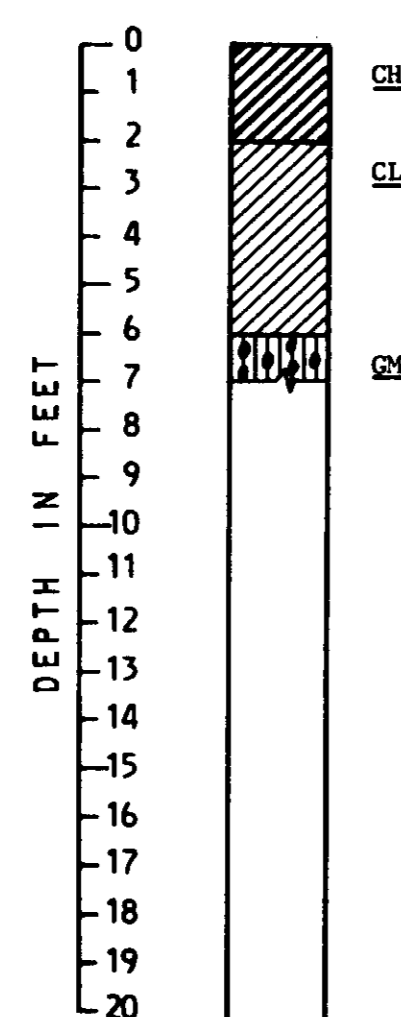


TRENCH WT-43

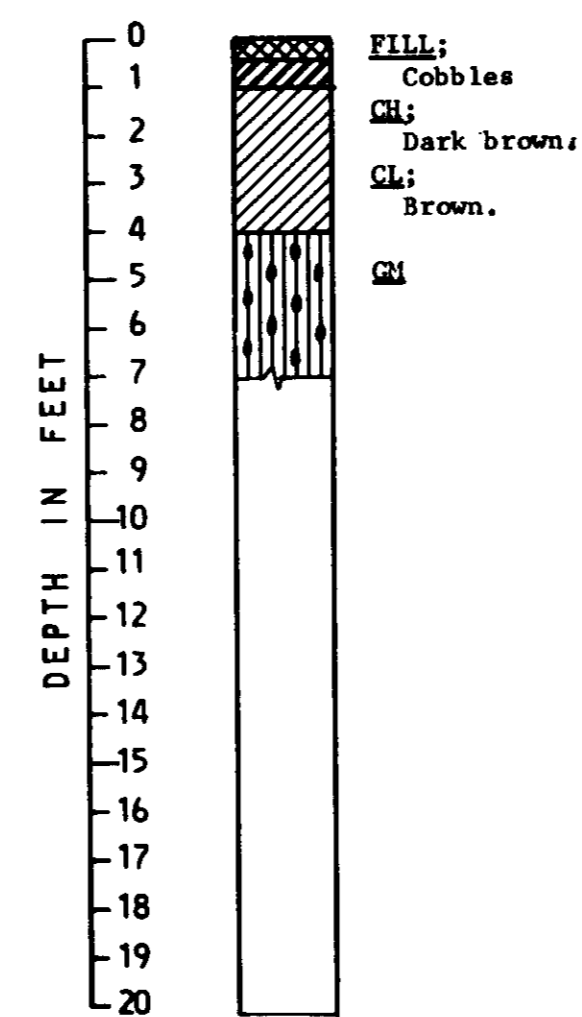


TRENCH WT-44

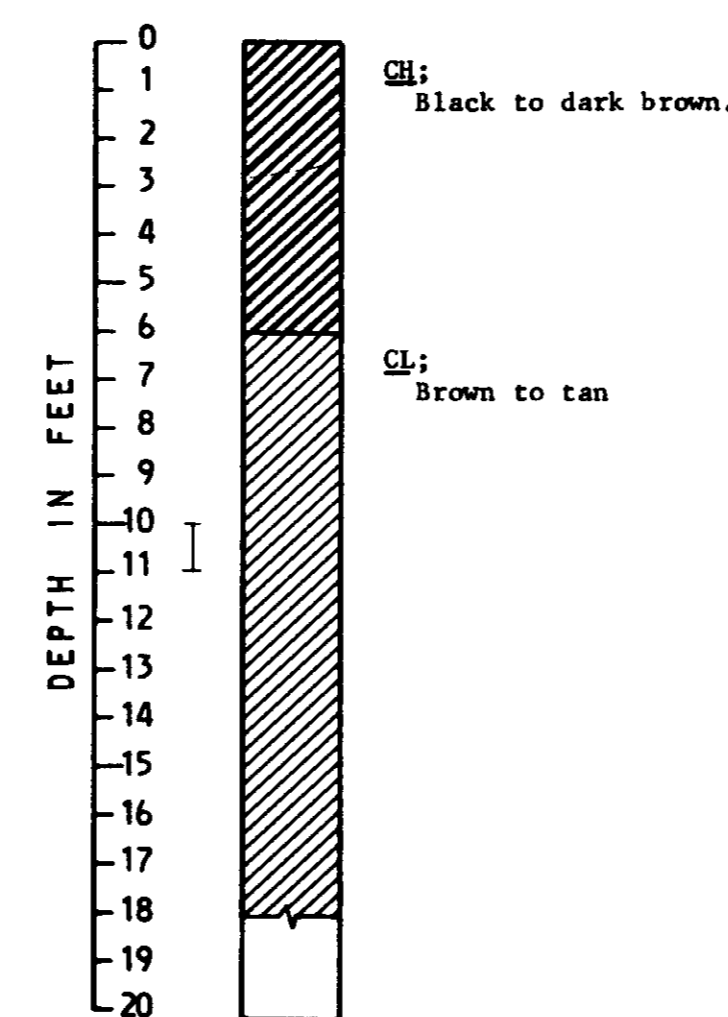


TRENCH WT-45

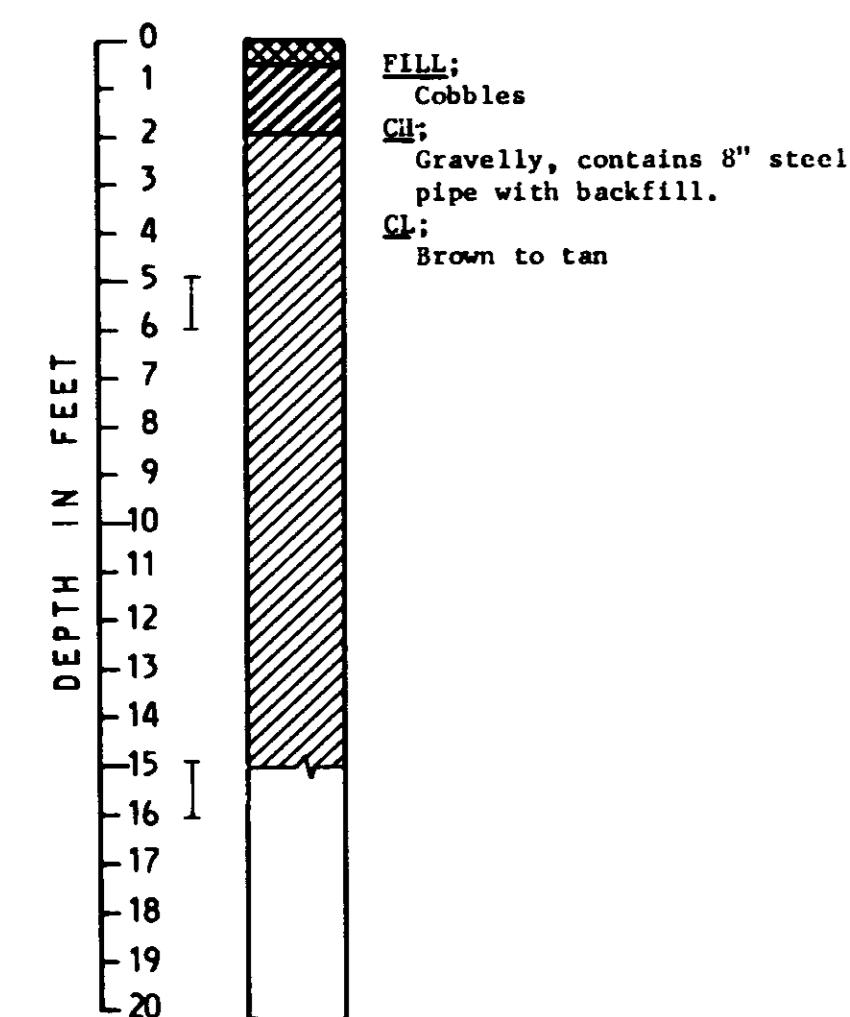


TRENCH WT-46

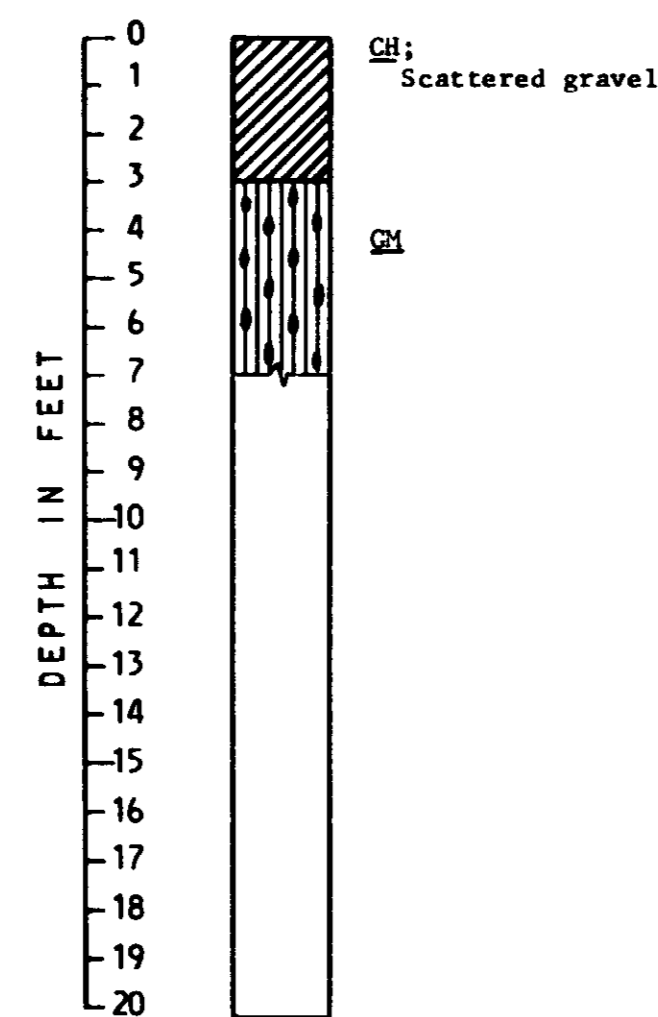

TRENCH WT-47

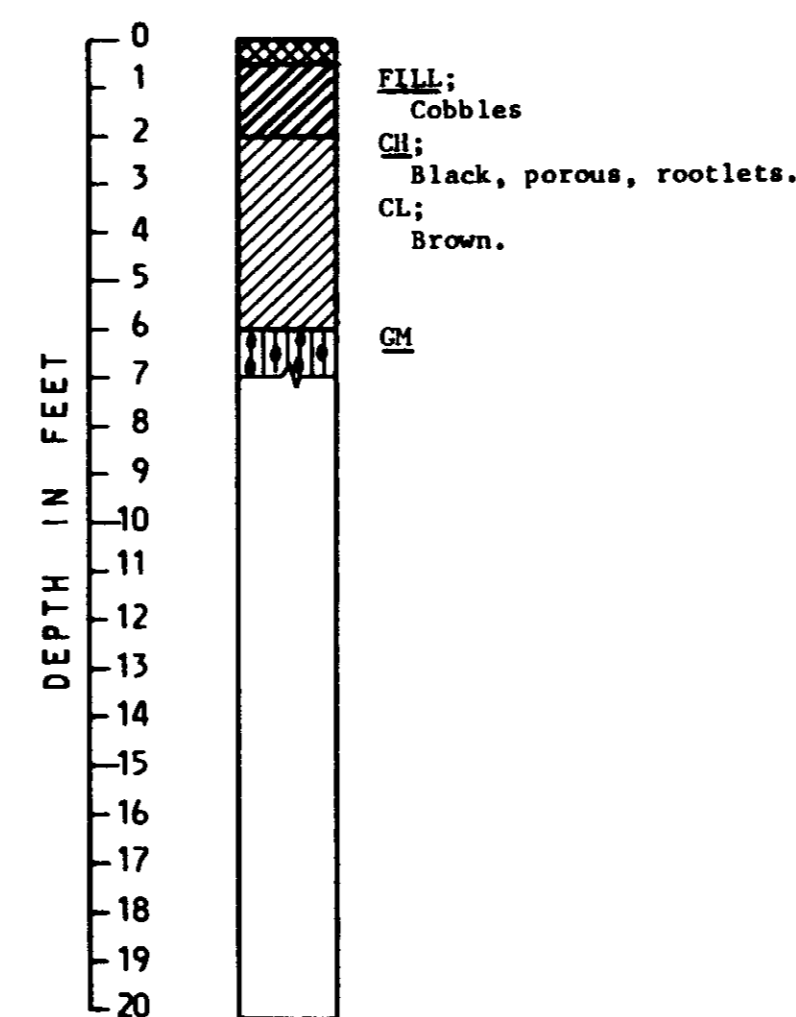

TRENCH WT-48

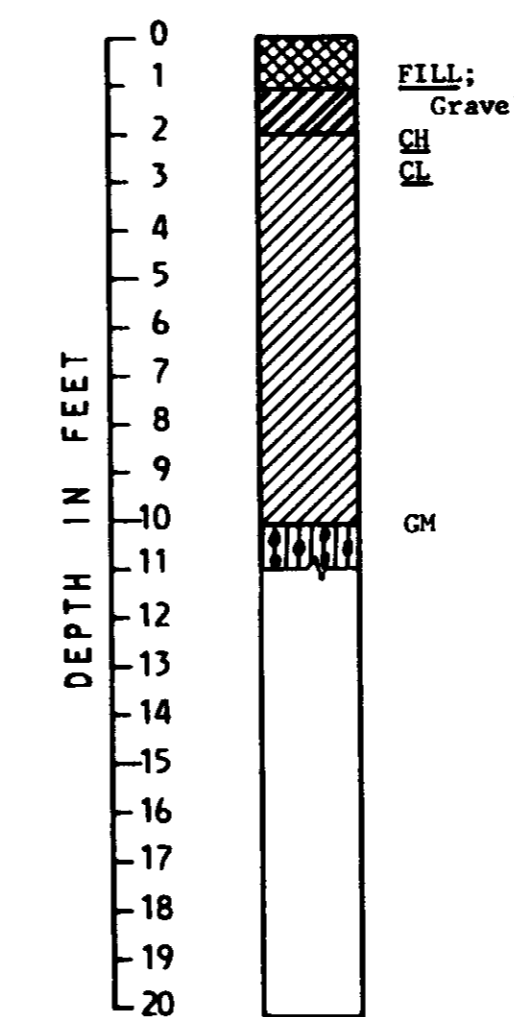

I DISTURBED SAMPLE

NOTES

- Notes 1 through 6 on Drawing number 14 apply to this drawing.
- See Drawing number 14 for borrow area outline and trench location map.

05265


NO.	DATE	REVISIONS	BY	CHK	ENG.	PROJ.	ENR.	MOR.	

LAS VIRGENES MUNICIPAL WATER DISTRICT

BOYLE ENGINEERING  
W. A. WAHLER & ASSOCIATES

WESTLAKE RESERVOIR  
ZONE 1 - BORROW AREA  
LOGS OF EXPLORATION - SHEET 2 OF 2

DESIGNED D.H.	DATE: 11-70	JOB ENG. C.W.P.	PROJ. ENG. <i>[Signature]</i>
DRAWN B.S.		DRAWING NUMBER	REV.
CHECKED C.W.P.	<i>[Signature]</i>	16	
SCALE AS SHOWN	R. C. E. 1970		

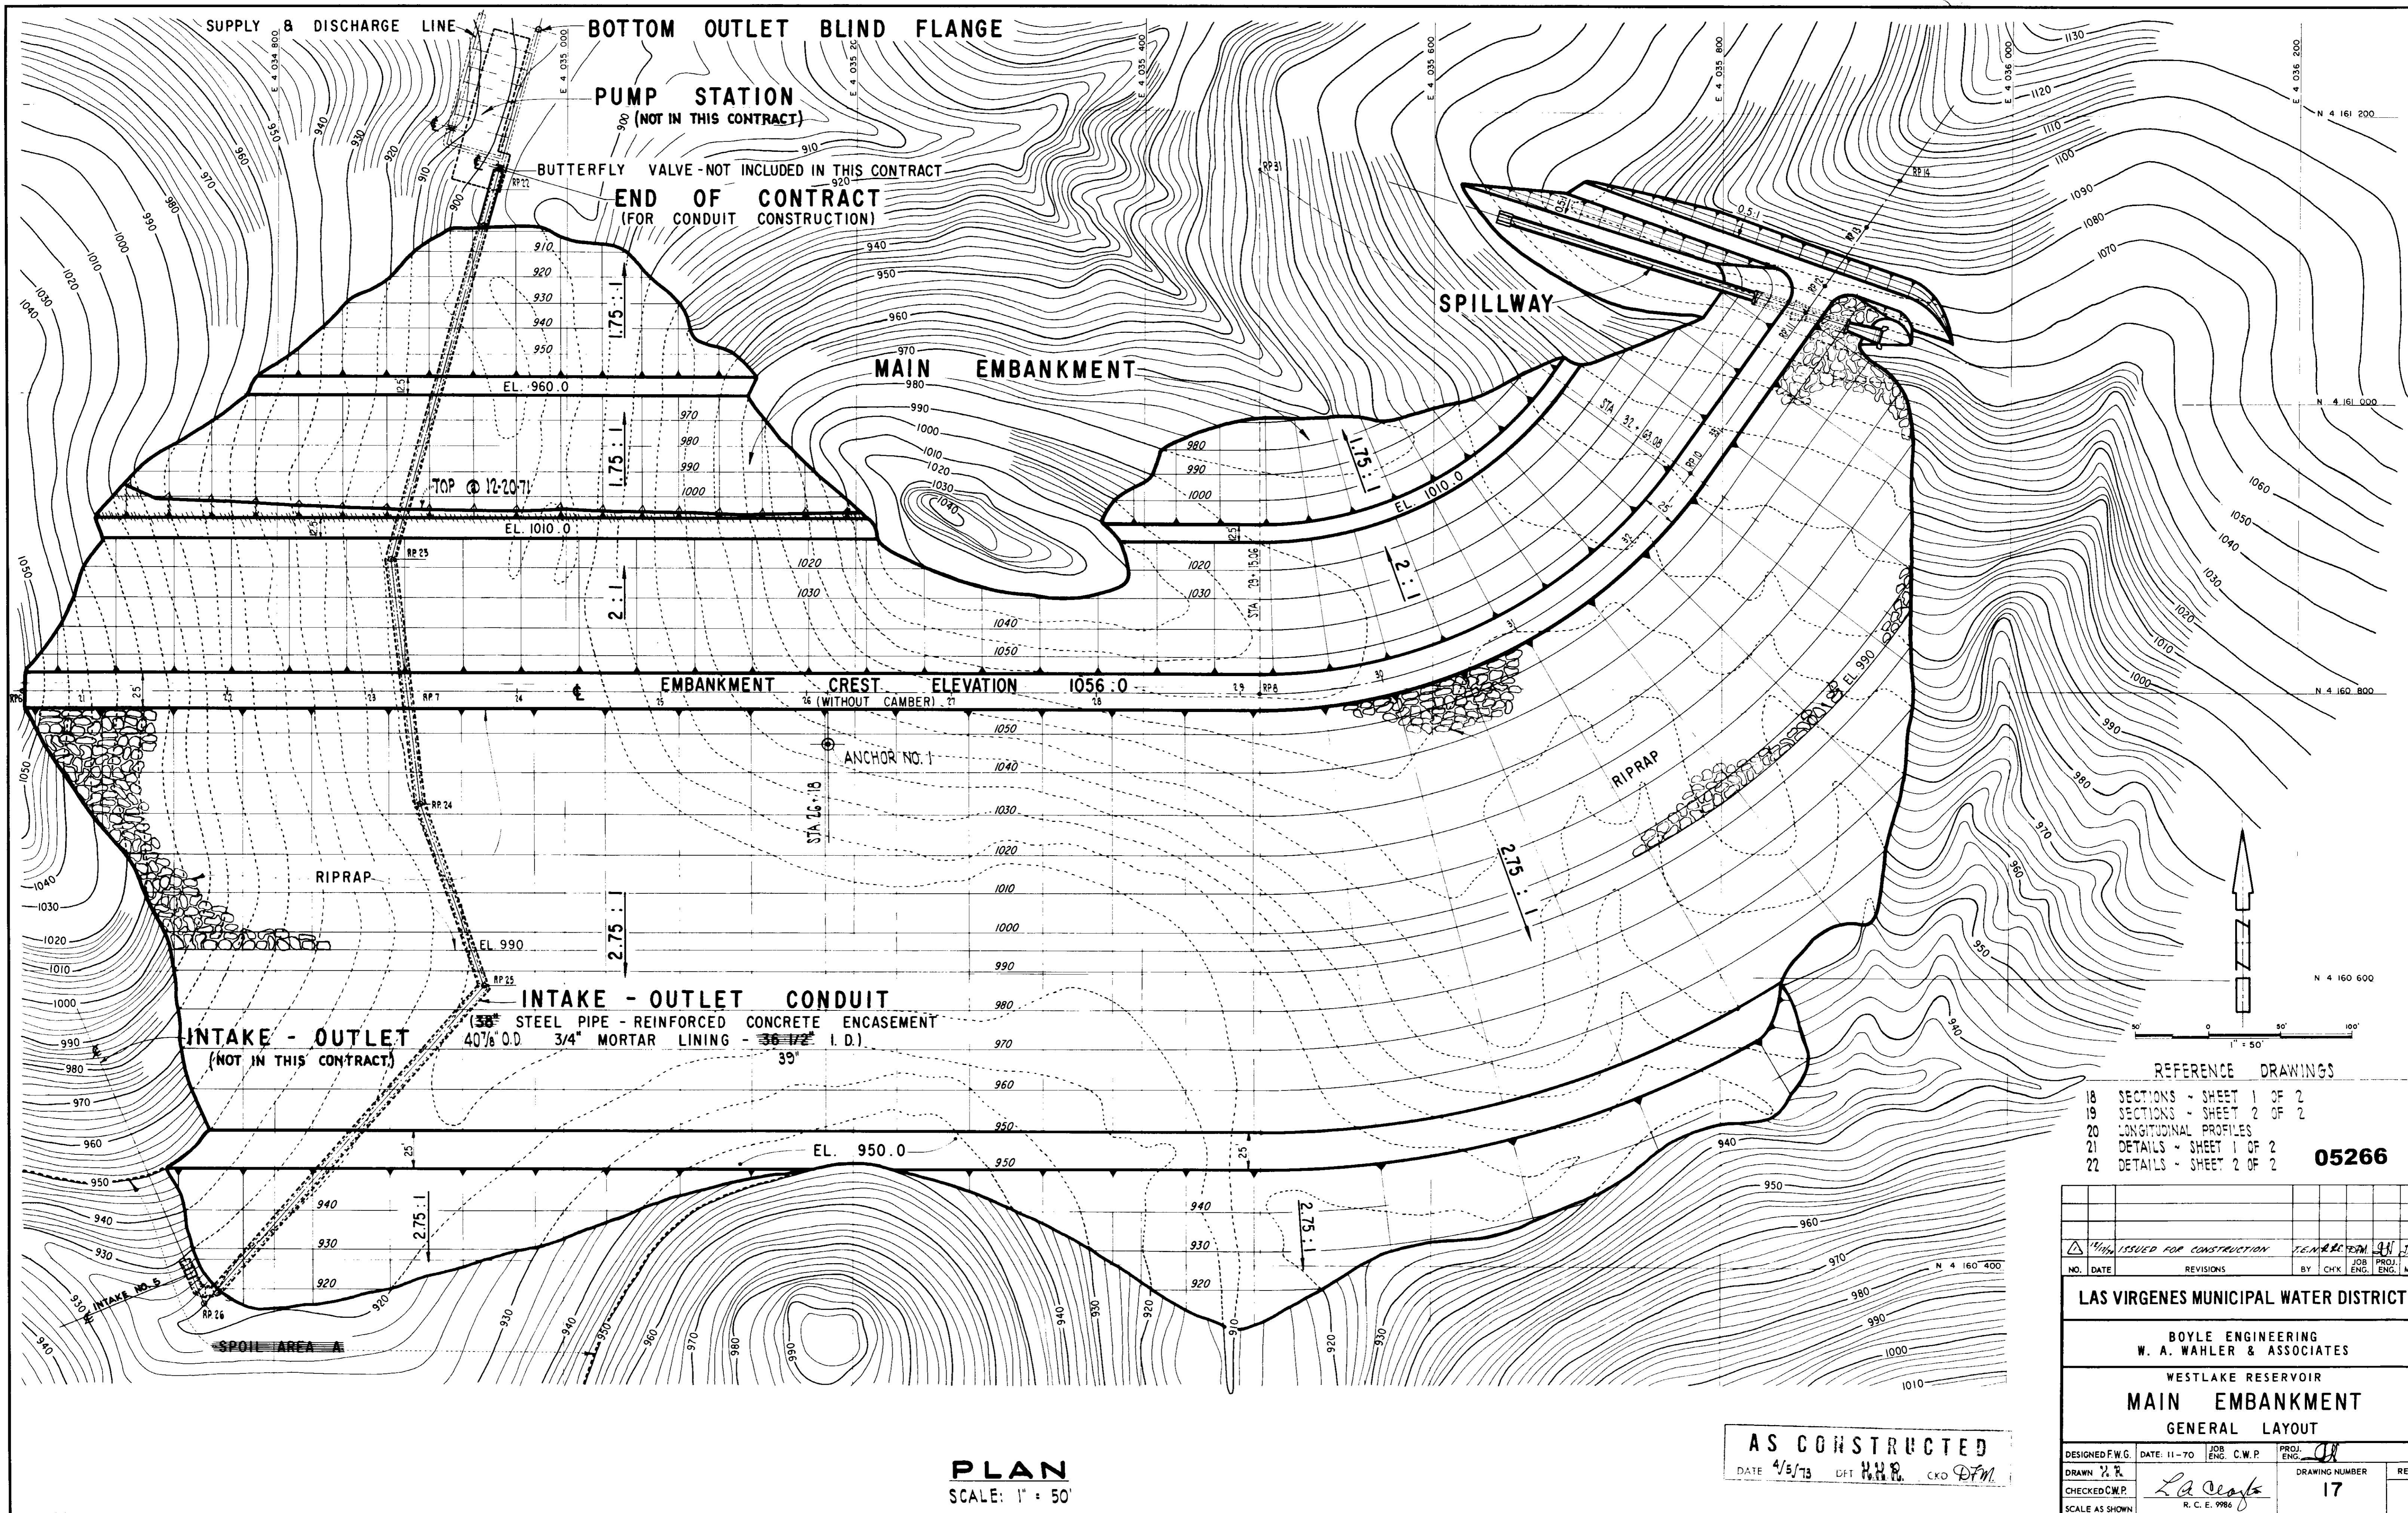

REFERENCE DRAWINGS

- 18 SECTIONS - SHEET 1 OF 2
- 19 SECTIONS - SHEET 2 OF 2
- 20 LONGITUDINAL PROFILES
- 21 DETAILS - SHEET 1 OF 2
- 22 DETAILS - SHEET 2 OF 2

05266

NO.	DATE	REVISIONS	BY	CHK	ENG.	PROJ. ENGR.	MGR.
<p>ISSUED FOR CONSTRUCTION</p>							

**LAS VIRGENES MUNICIPAL WATER DISTRICT**

BOYLE ENGINEERING  
W. A. WAHLER & ASSOCIATES

WESTLAKE RESERVOIR  
**MAIN EMBANKMENT**  
GENERAL LAYOUT



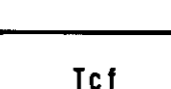
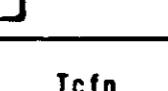
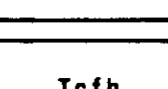
DESIGNED F.W.G.	DATE: 11-70	JOB ENG. C.W.P.	PROJ. ENGR.
DRAWN: P.R.	CHECKED C.W.P.	DATE: 4/5/73	DFT: H.H.R. CKD: D.F.M.
SCALE AS SHOWN			DRAWING NUMBER: 17

**PLAN**  
SCALE: 1" = 50'





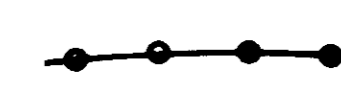
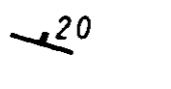
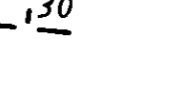

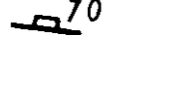
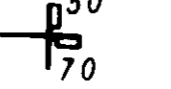
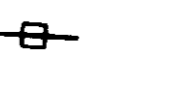
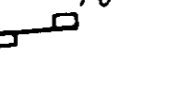
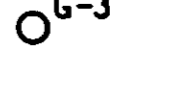
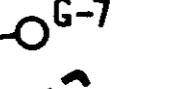

**AS CONSTRUCTED**

# KEY

## TERTIARY ROCK UNITS

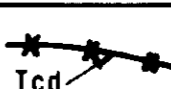-  INTRUSIVE IGNEOUS ROCKS: DIKES OF BASALTIC OR ANDESITIC COMPOSITION
  -  TUFF BRECCIA
  -  BASALT FLOW AND FLOW BRECCIA ROCK: UNDIFFERENTIATED
  -  BASALT PORPHYRY
  -  FLOW BRECCIA, MASSIVE: INCLUDES CLASTS OF BASALTIC ROCK IN BASALTIC MATRIX, IN MANY CASES AUTOBRECCIATED.
- MEMBER OF TOPANGA FORMATION

## SYMBOLS

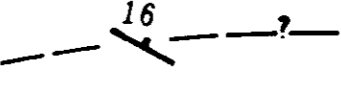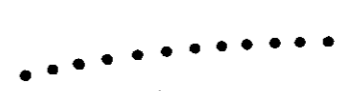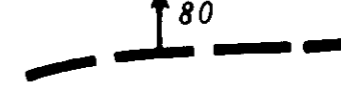-  CONTACT BETWEEN UNITS OF DIFFERENT LITHOLOGY, APPROXIMATELY LOCATED, SHOWING ATTITUDE; QUESTIONED WHERE CONJECTURAL.
-  CONTACT BETWEEN FLOWS OF SIMILAR LITHOLOGY, APPROXIMATELY LOCATED
-  FAULT, APPROXIMATE LOCATION, SHOWING ATTITUDE; QUESTIONED WHERE EXTENSION IS DOUBTFUL.
-  FAULT ZONE, WIDTH TO SCALE, SHOWING ATTITUDE; DASHED WHERE APPROXIMATELY LOCATED.
-  ALTERATION ZONE, STEEPLY DIPPING; POSSIBLE FAULT
-  ATTITUDE OF CONTACT OR FLOW STRUCTURE
-  APPROXIMATE OR GENERALIZED ATTITUDE OF FLOW STRUCTURE
-  STRIKE OF VERTICAL FAULT
-  ATTITUDE OF JOINT
-  ATTITUDES OF INTERSECTING JOINTS
-  STRIKE OF VERTICAL JOINT
-  JOINT SET WITH SAME STRIKE AND DIFFERENT DIPS
-  DIAMOND CORE HOLE (VERTICAL)
-  DIAMOND CORE HOLE (INCLINED)
-  OUTLINE OF DAM AND RESERVOIR

05267

AS CONSTRUCTED  
DATE 12-15-73 DFT H.H.R. over D.H.


NO.	DATE	REVISIONS	BY	CHK	JOB ENG.	PROJ. ENG.	MR.


**LAS VIRGENES MUNICIPAL WATER DISTRICT**  
BOYLE ENGINEERING  
W. A. WAHLER & ASSOCIATES  
WESTLAKE RESERVOIR  
EXCAVATED FOUNDATION  
GEOLOGIC MAP  
RAIN EMBANKMENT

DESIGNED <i>l.e.g.</i>	DATE 6/72	JOB ENG. <i>Wahler</i>	PROJ. ENG. <i>J.H.</i>
DRAWN <i>B.S.</i>	CHECKED <i>C.S.</i>	SCALE AS SHOWN	DRAWING NUMBER 17-A


NOTE: A PLUS SIGN BY THE AMOUNT OF DIP, E.G. 70°, MEANS THE DIP VARIES FROM THE INDICATED AMOUNT UP TO VERTICAL OVER SHORT DISTANCES.

SCALE  
0 50 100 FEET  
CONTOUR INTERVAL 2 FEET

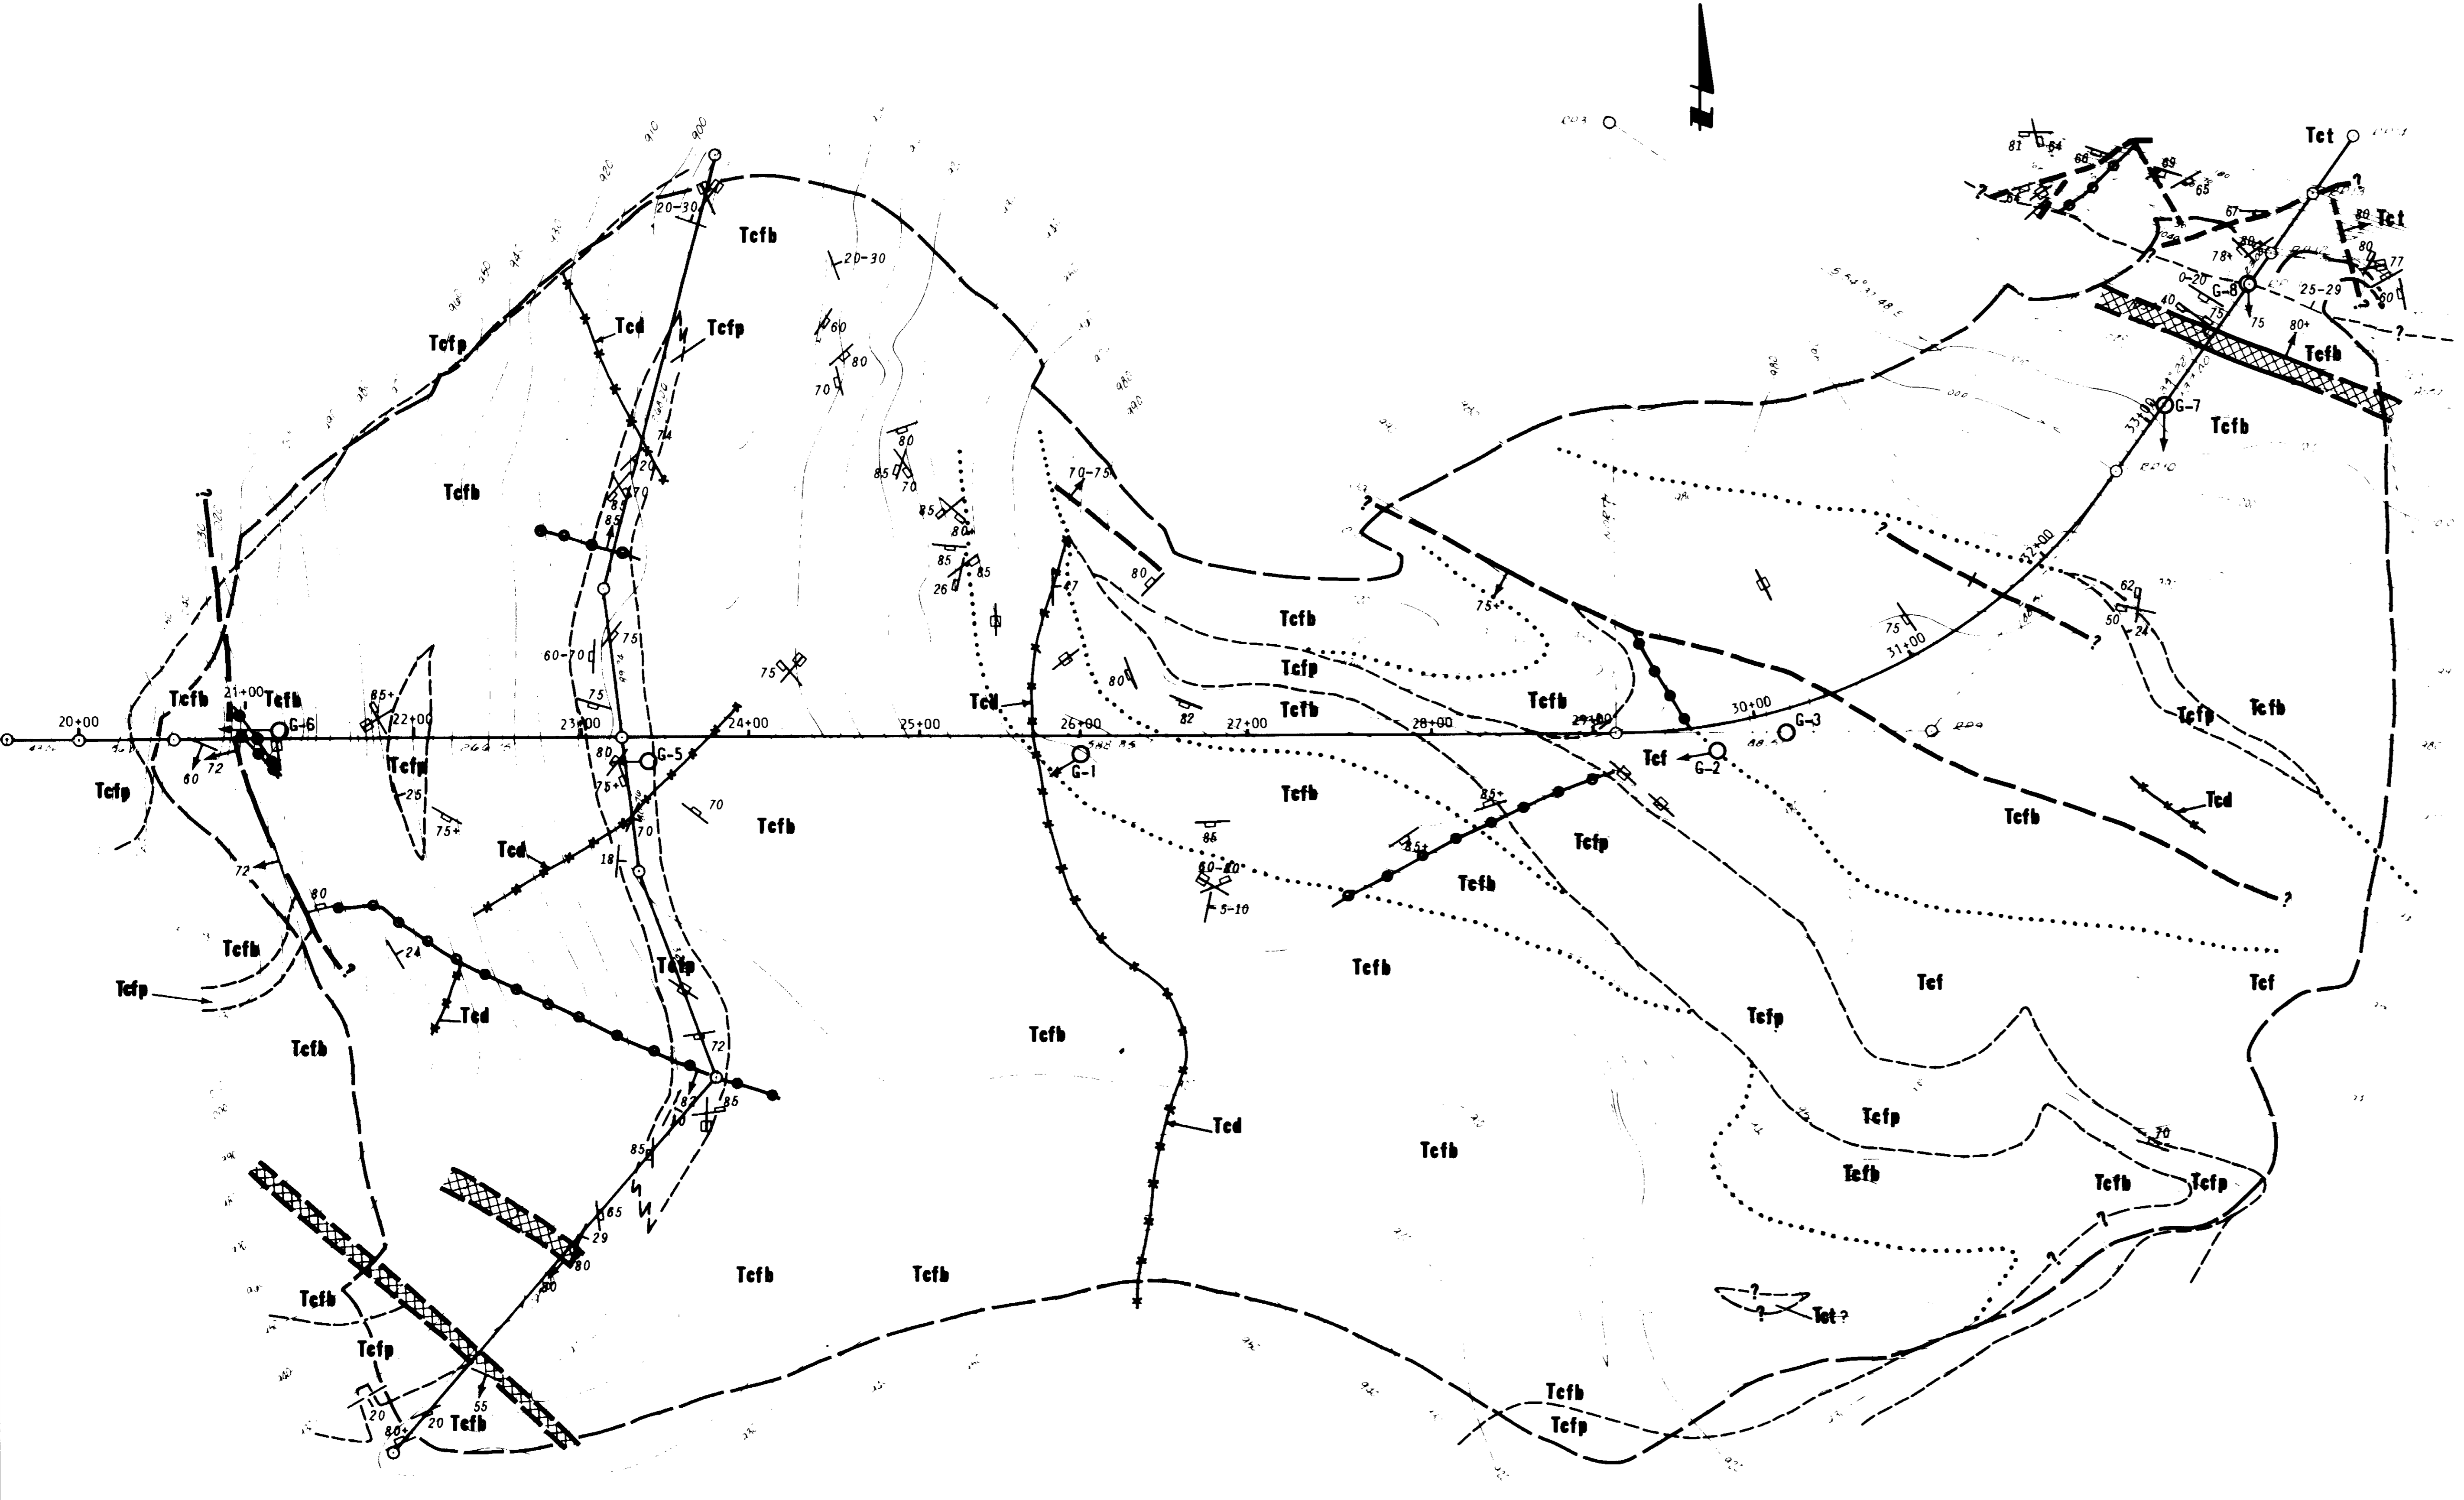


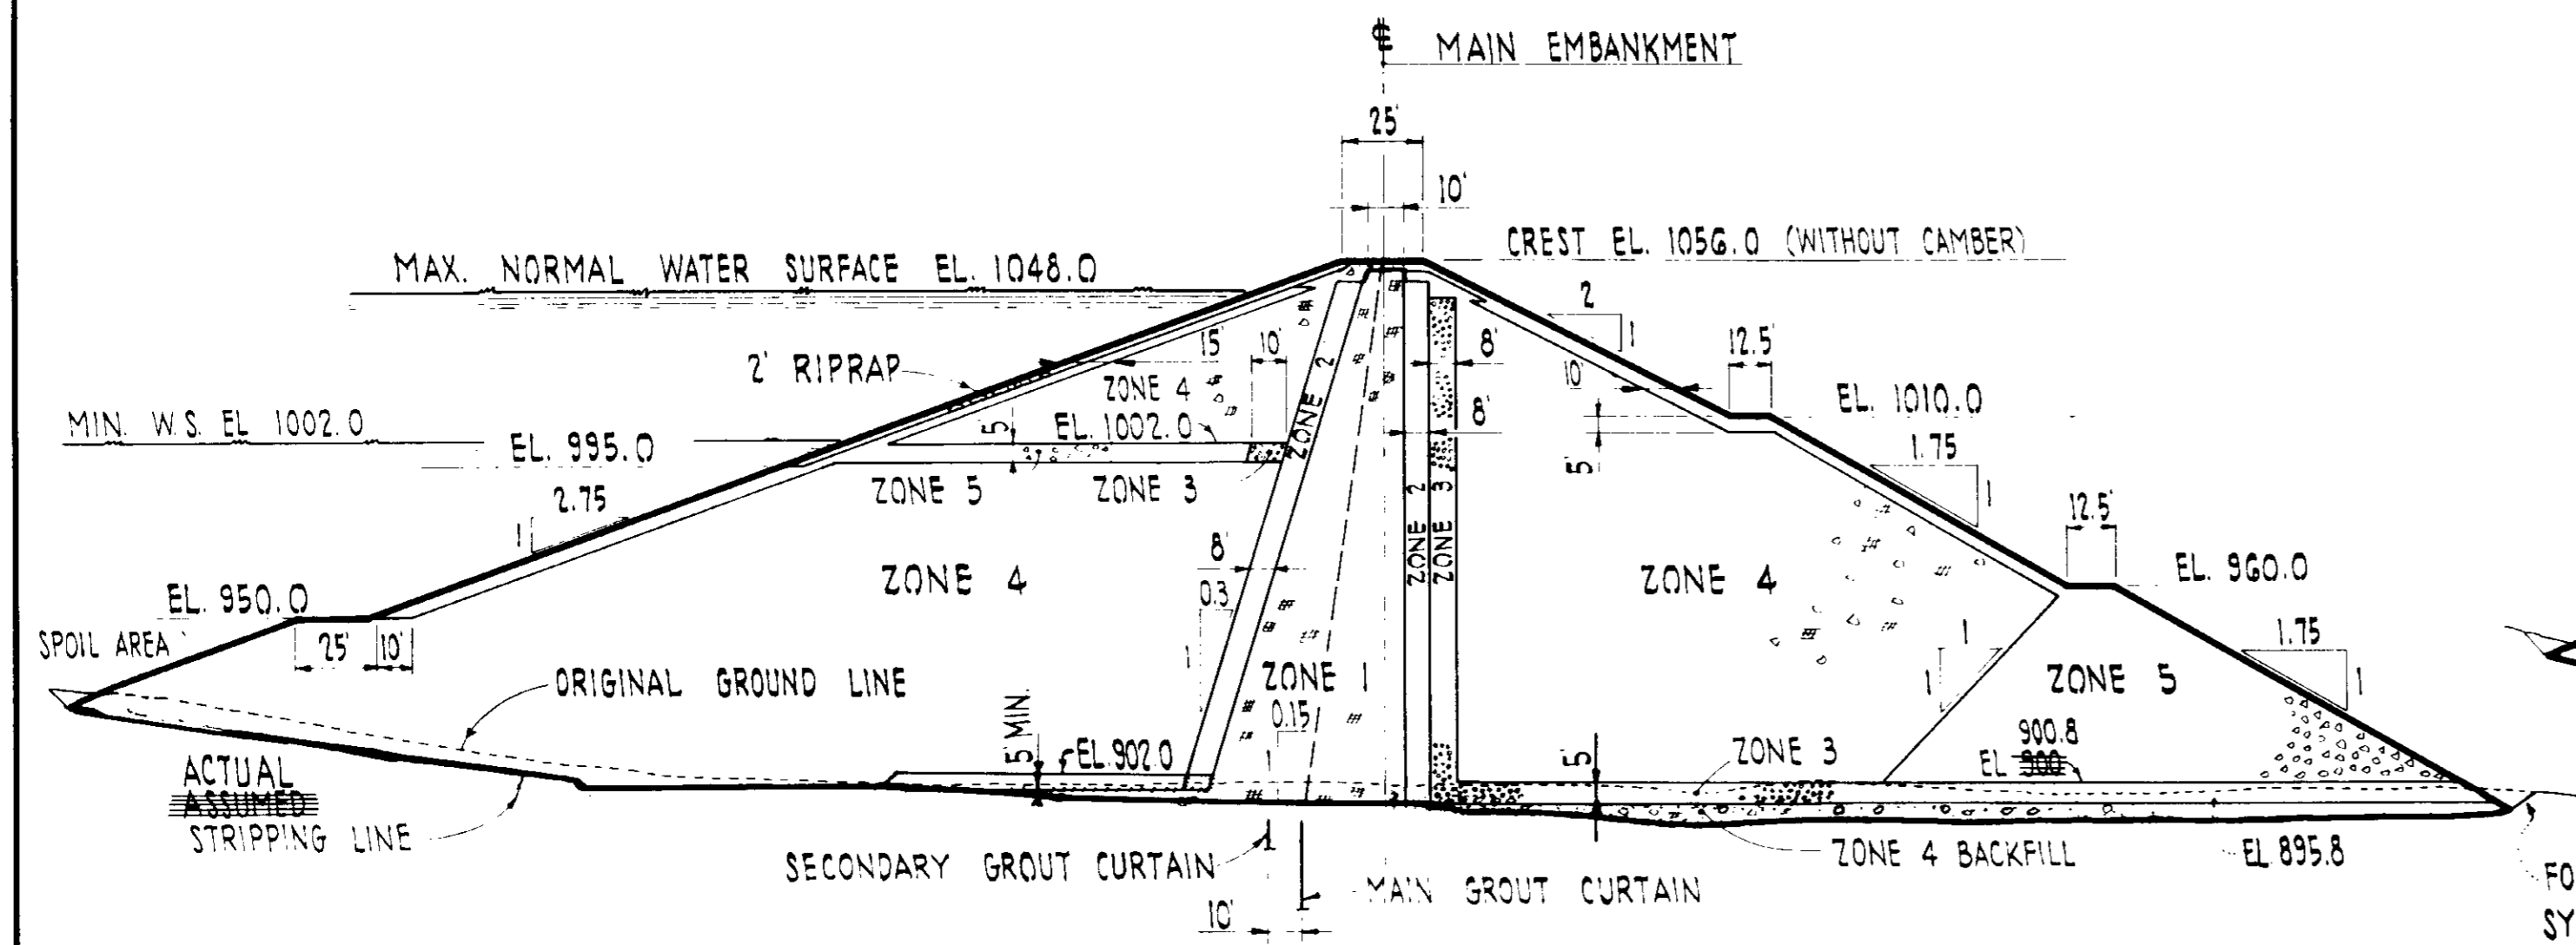


**SECTION AT STA. 24+00**

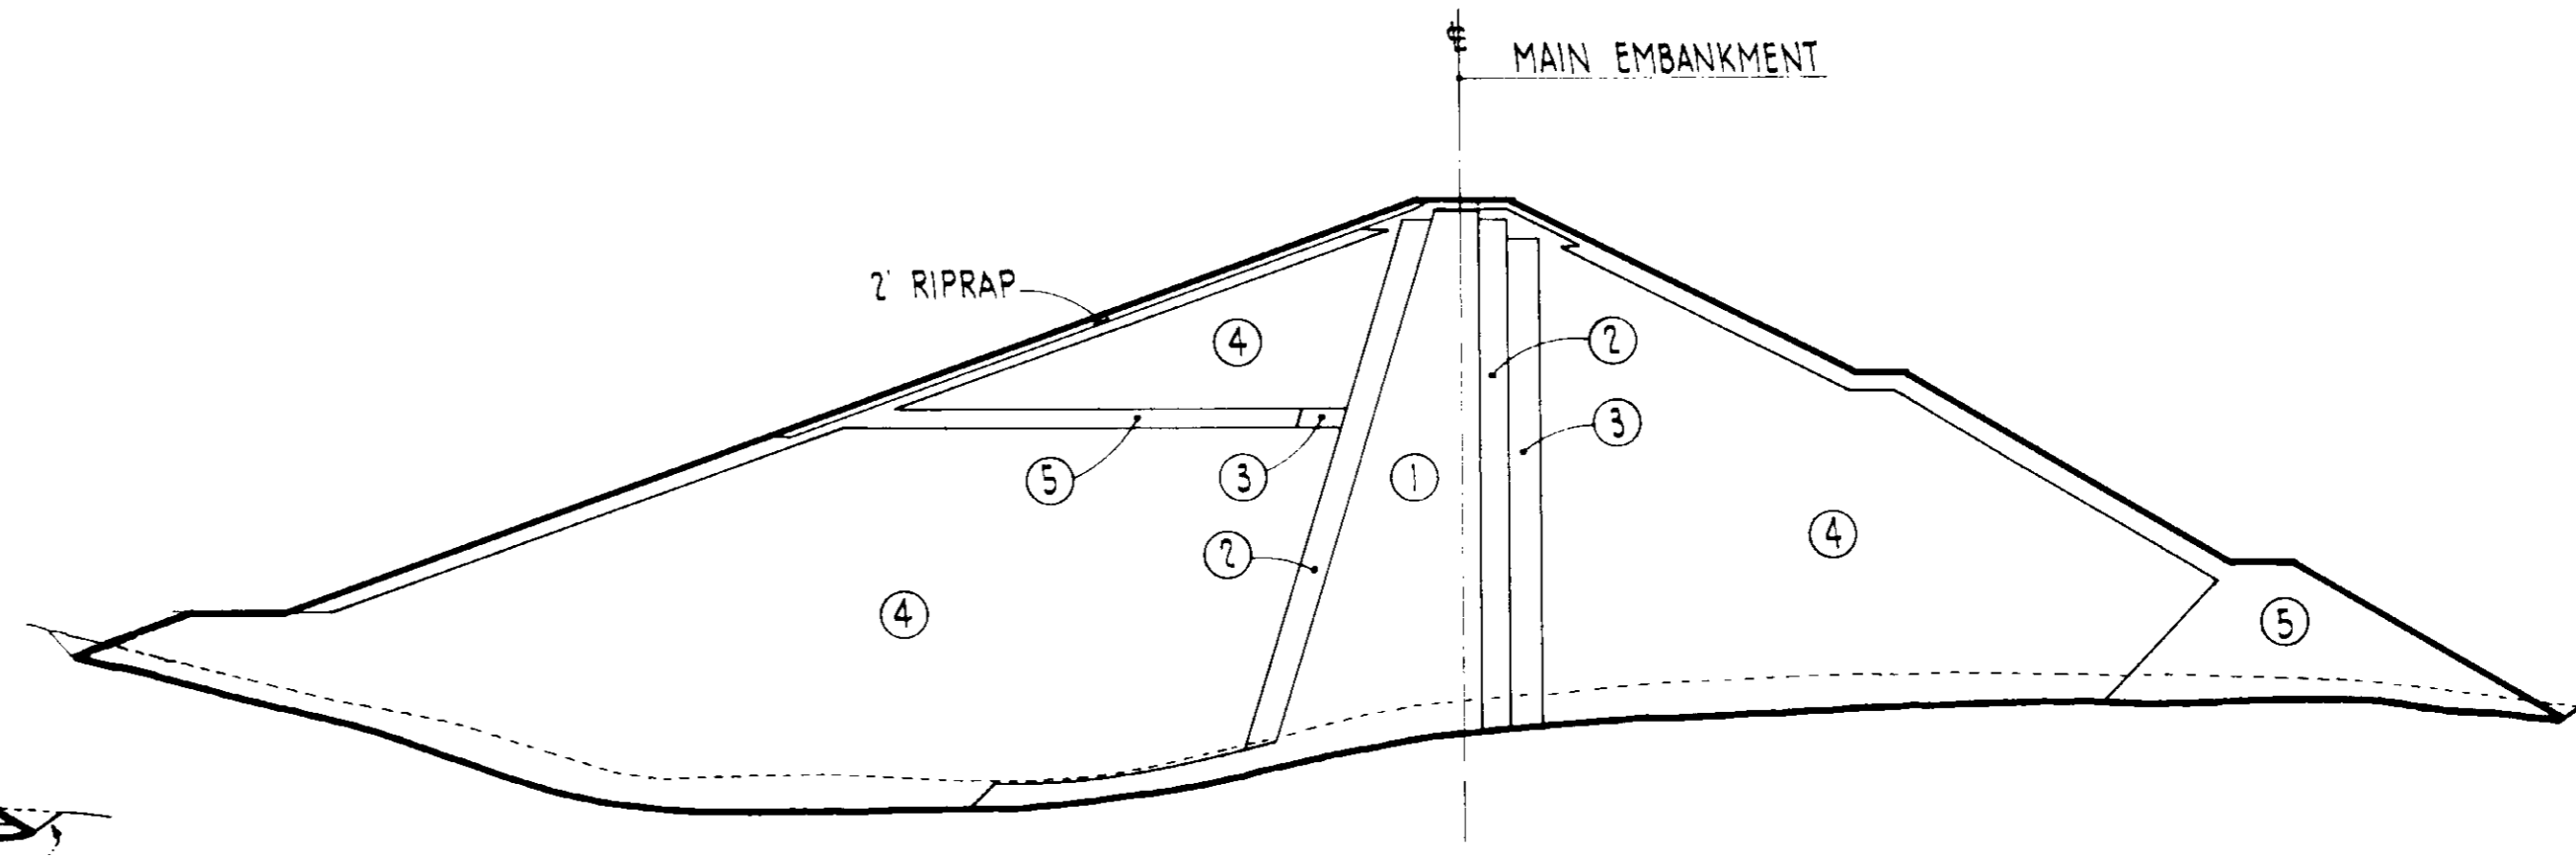


**SECTION AT STA. 25+00**

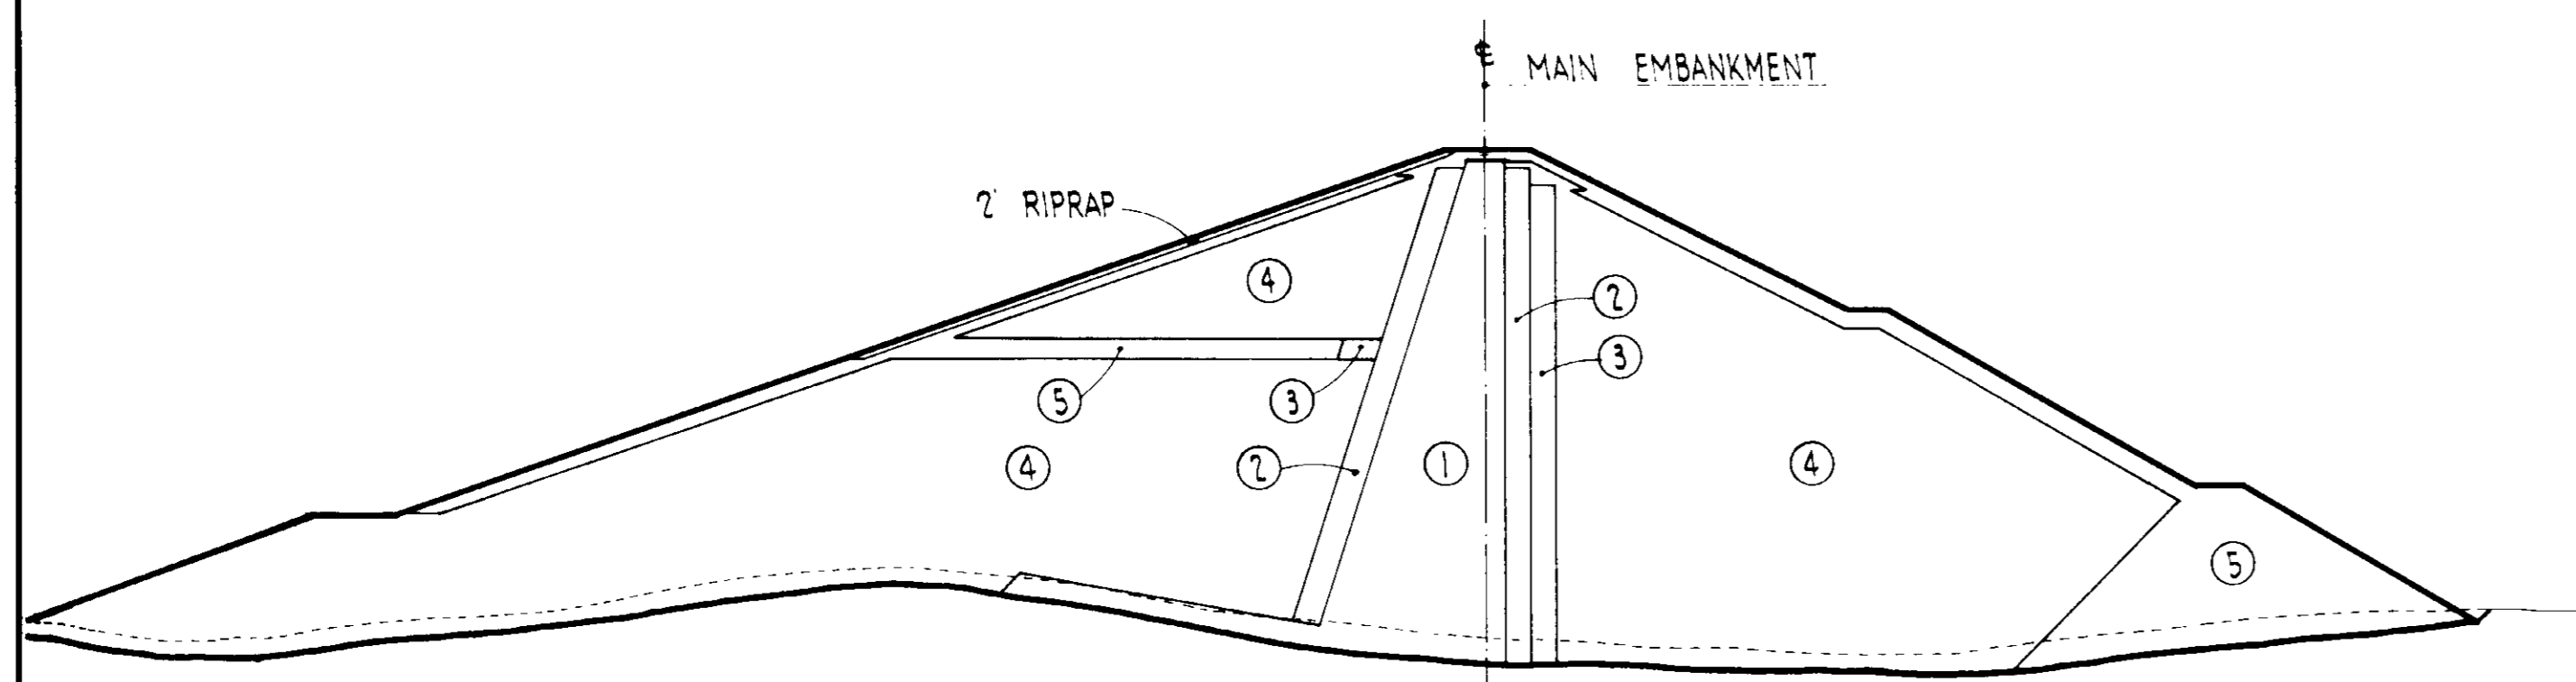


**SECTION AT STA. 23+00**

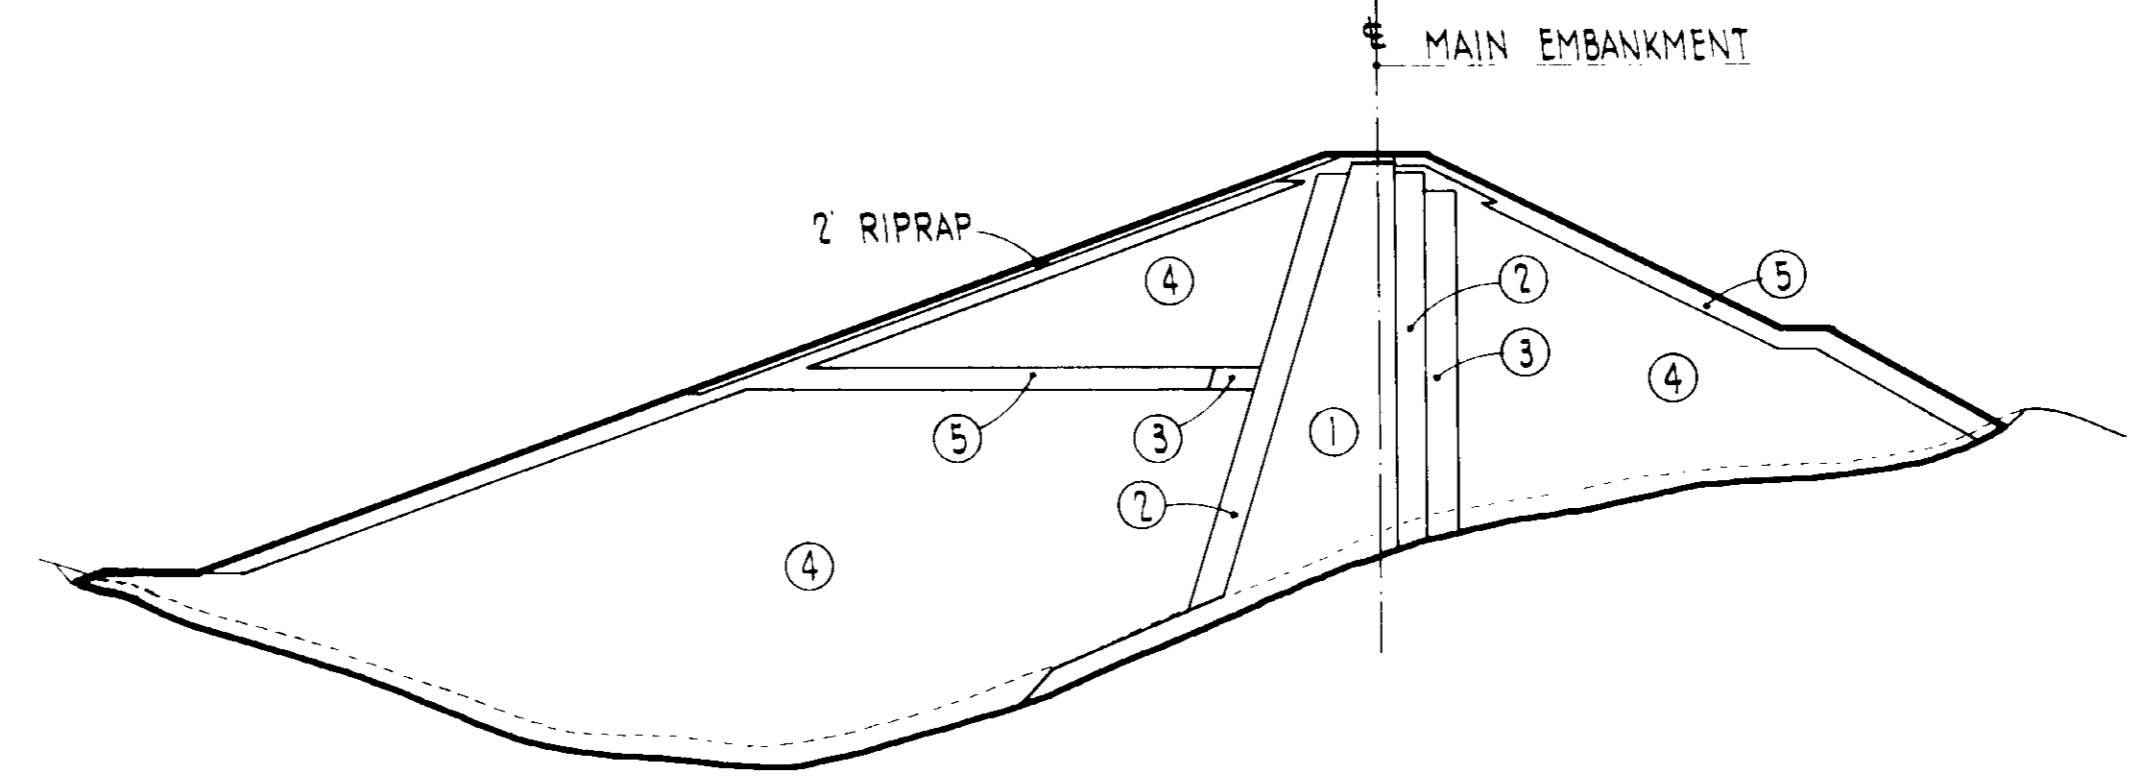


**SECTION AT STA. 26+00**

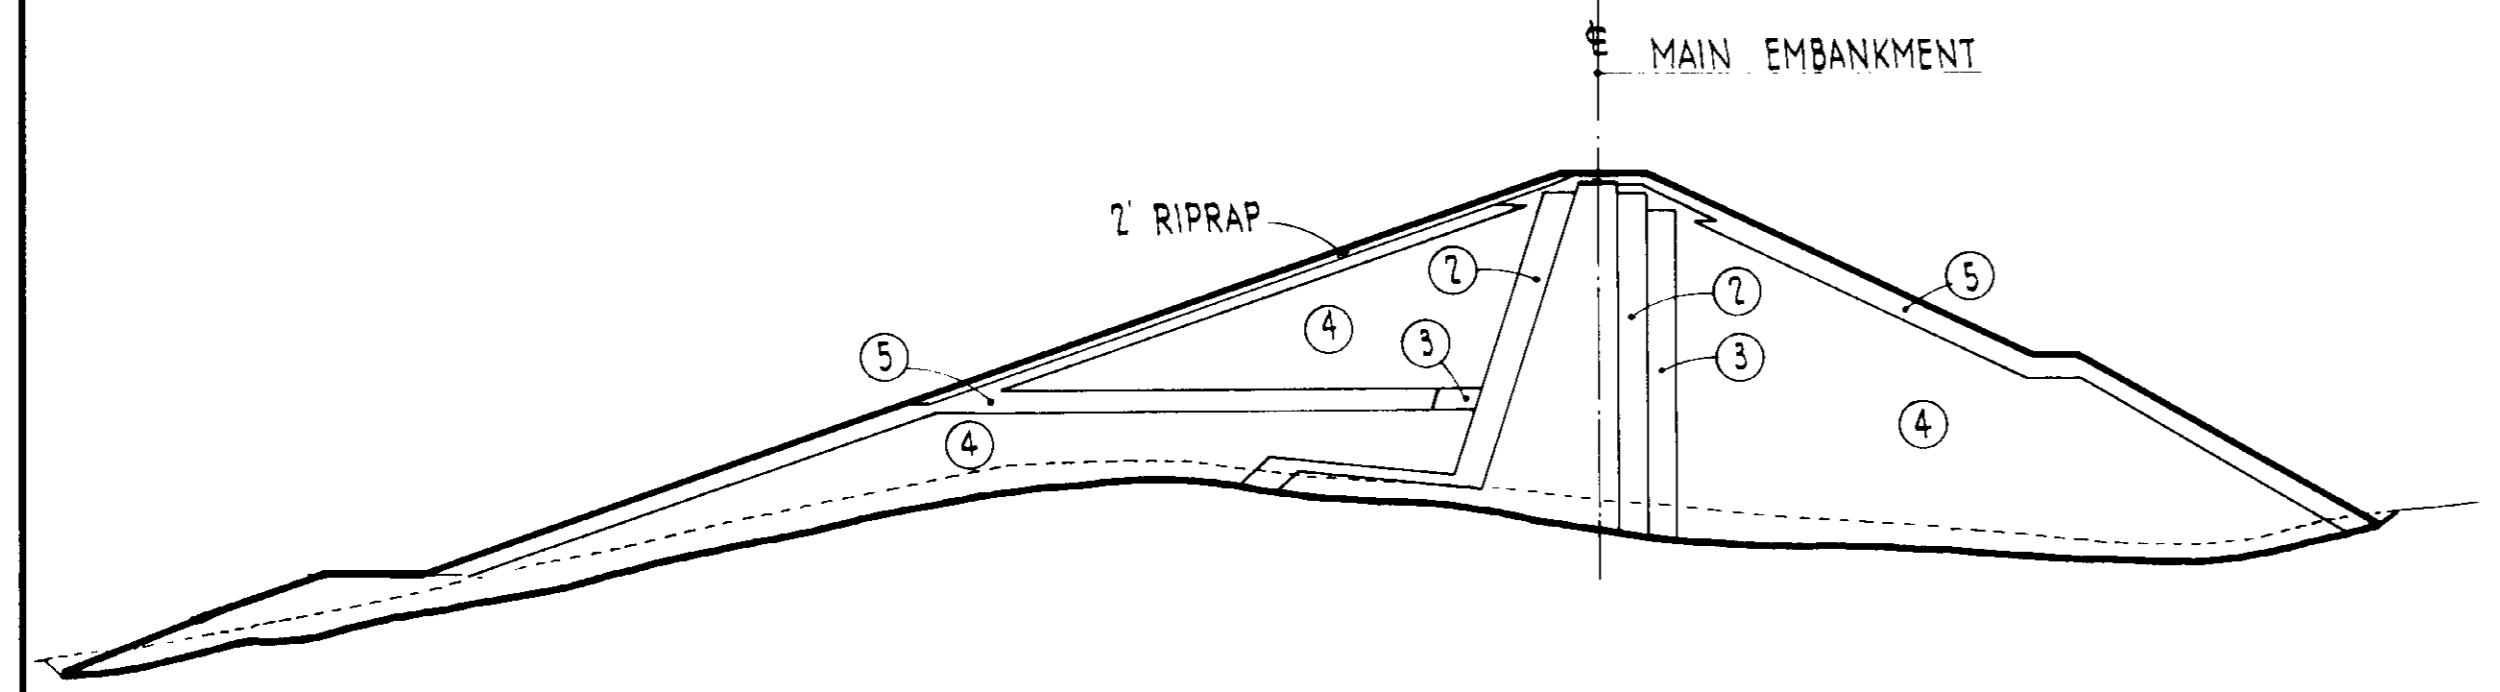

**SECTION AT STA. 22+00**

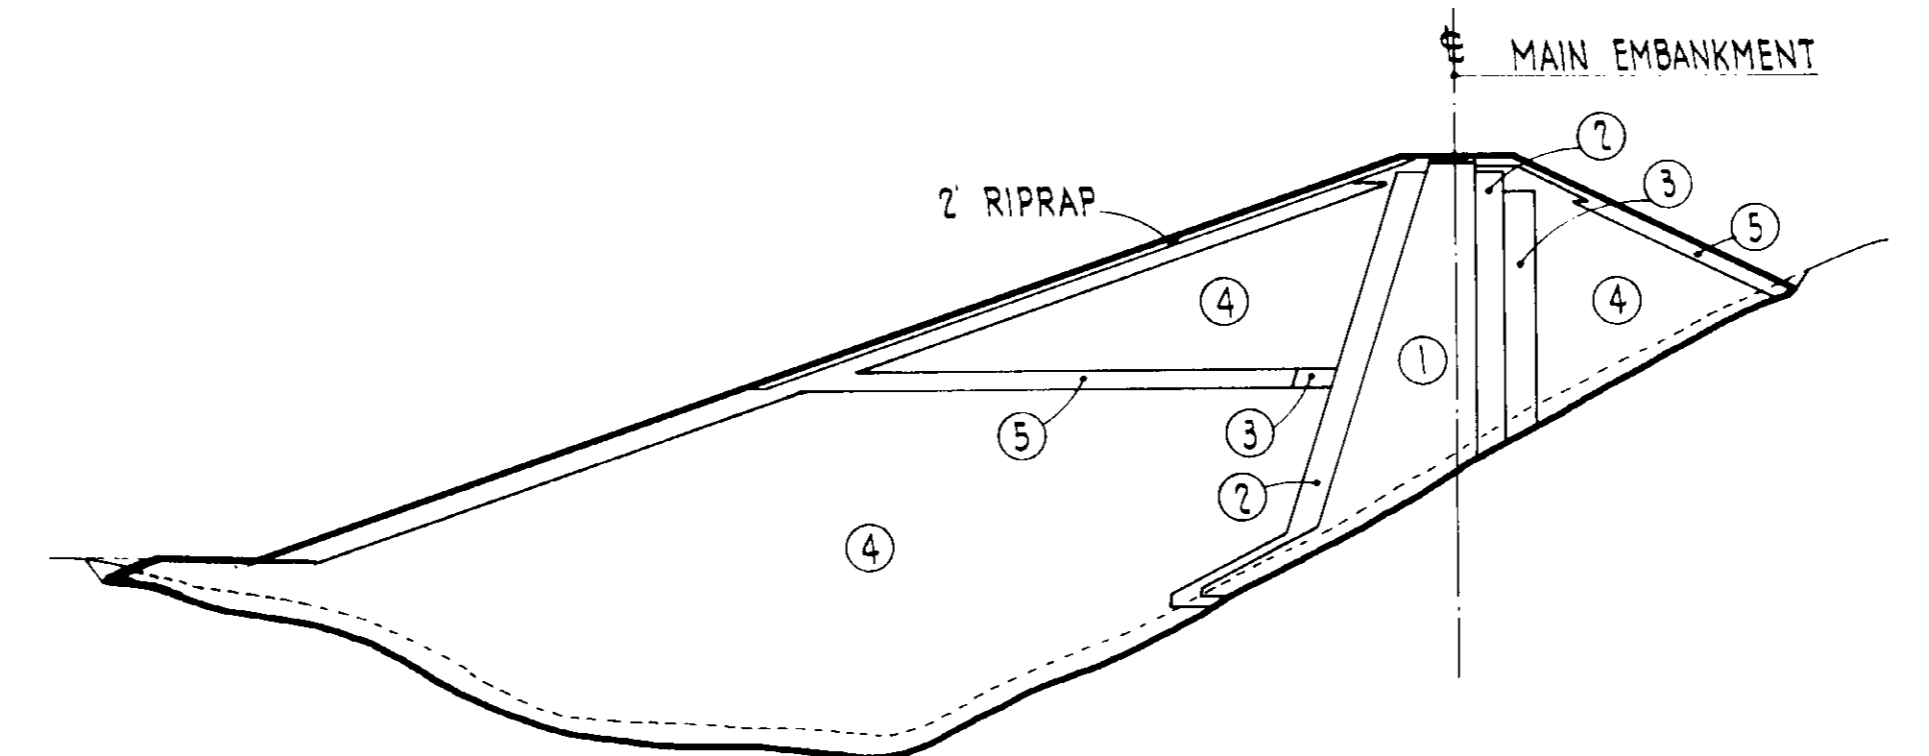


**SECTION AT STA. 27+00**

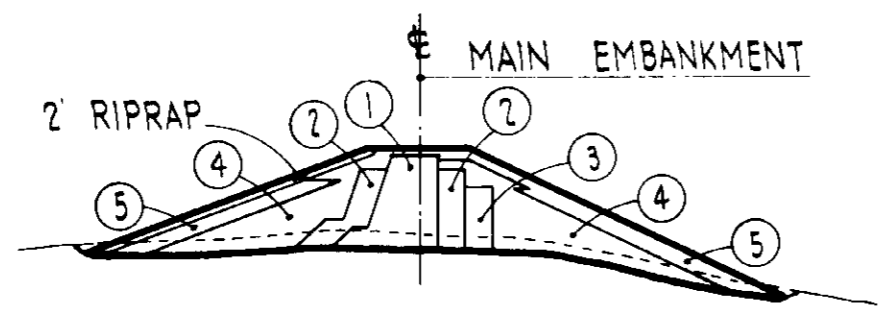

**SECTION AT STA. 21+00**

SCALE: 1" = 50'

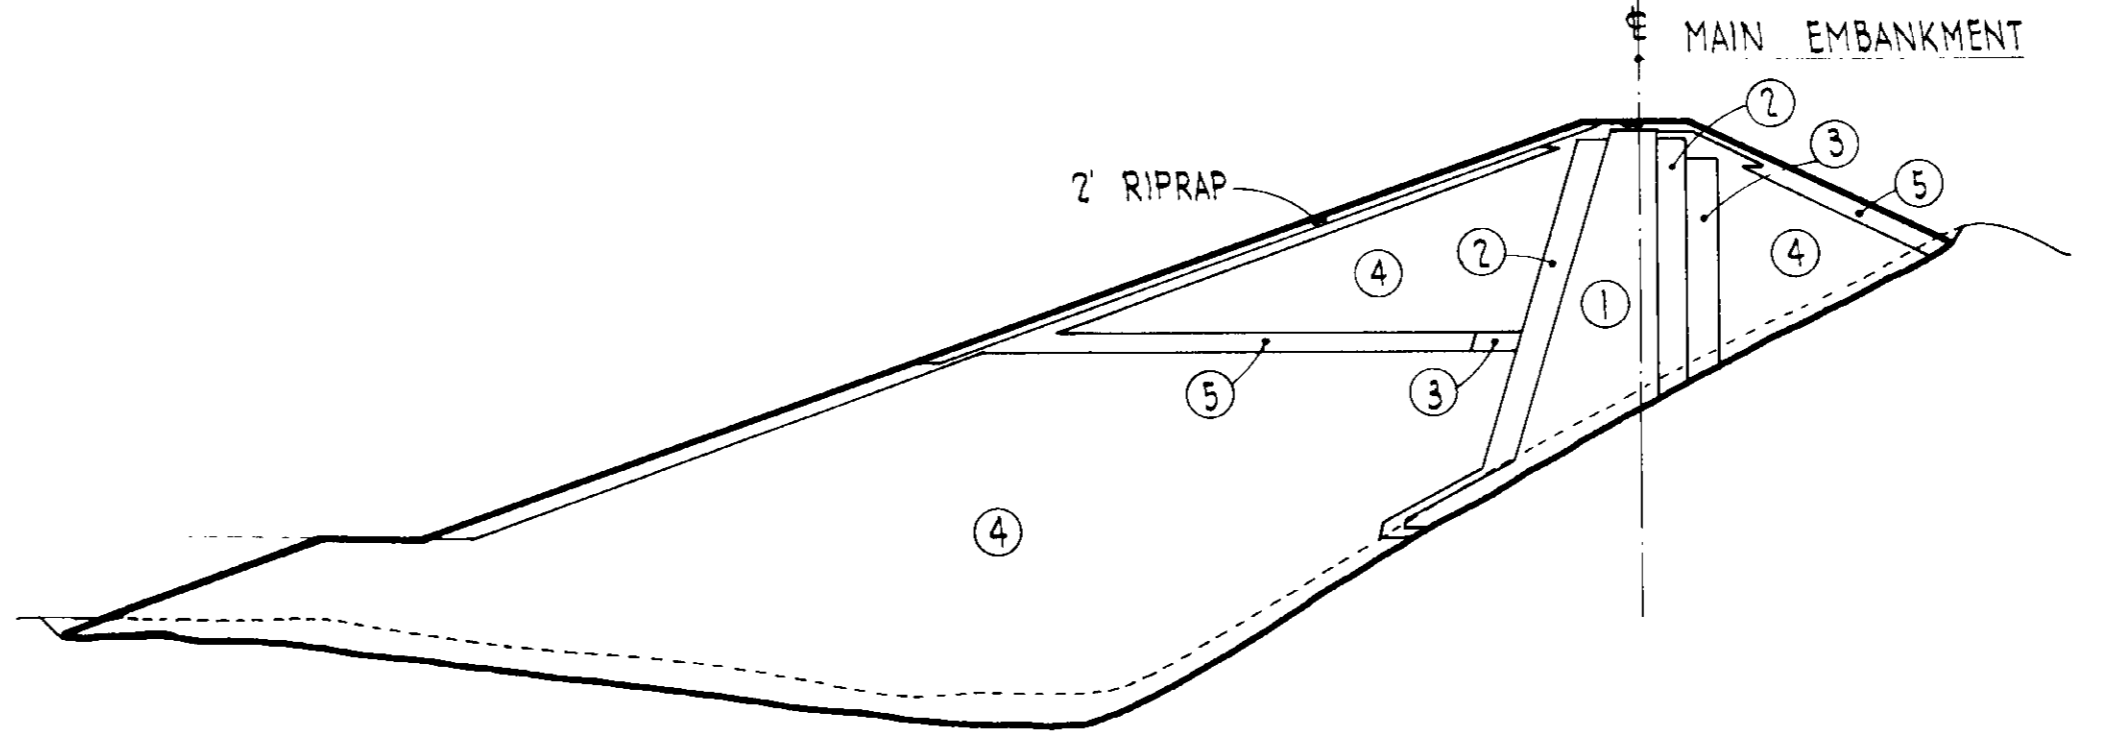

**SECTION AT STA. 28+00**

SCALE: 1" = 50'


FOR DRAIN COLLECTION SYSTEM SEE SHEET 3 OF PUMP STA. DRAWINGS

**NOTES**

1. Main and secondary grout curtains are shown only on Sections at Sta. 24+00. Criteria for grout curtain locations over remainder of dam alignment are as shown on that section.

**05268**

REFERENCE DRAWINGS  
FOR REFERENCE DRAWINGS SEE DRAWING NO. 17

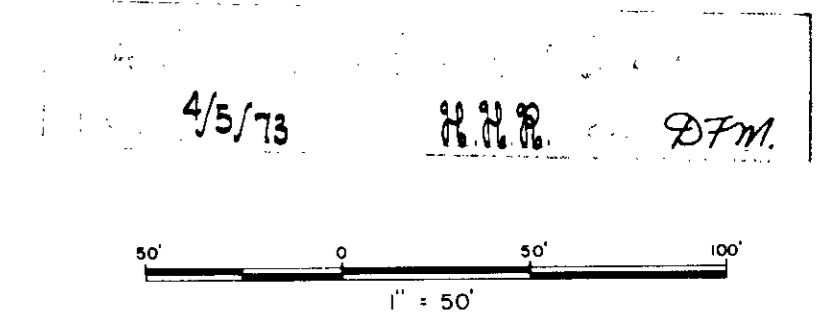


ISSUED FOR CONSTRUCTION		TEMPORARY		JOB		PROJ.	
NO.	DATE	REVISIONS	BY	CHK.	JOB ENG.	PROJ. ENG.	INGR.

**LAS VIRGENES MUNICIPAL WATER DISTRICT**


**BOYLE ENGINEERING  
W. A. WAHLER & ASSOCIATES**

**WESTLAKE RESERVOIR  
MAIN EMBANKMENT  
SECTIONS - SHEET 1 OF 2**


DESIGNED F.W.G.	DATE: 11-70	JOB ENG. C.W.P.	PROJ. ENG. <i>W</i>
DRAWN <i>W.B.</i>	CHECKED C.W.P.	DRAWING NUMBER	REV.
SCALE AS SHOWN	<i>R. C. E. 1986</i>	<b>18</b>	

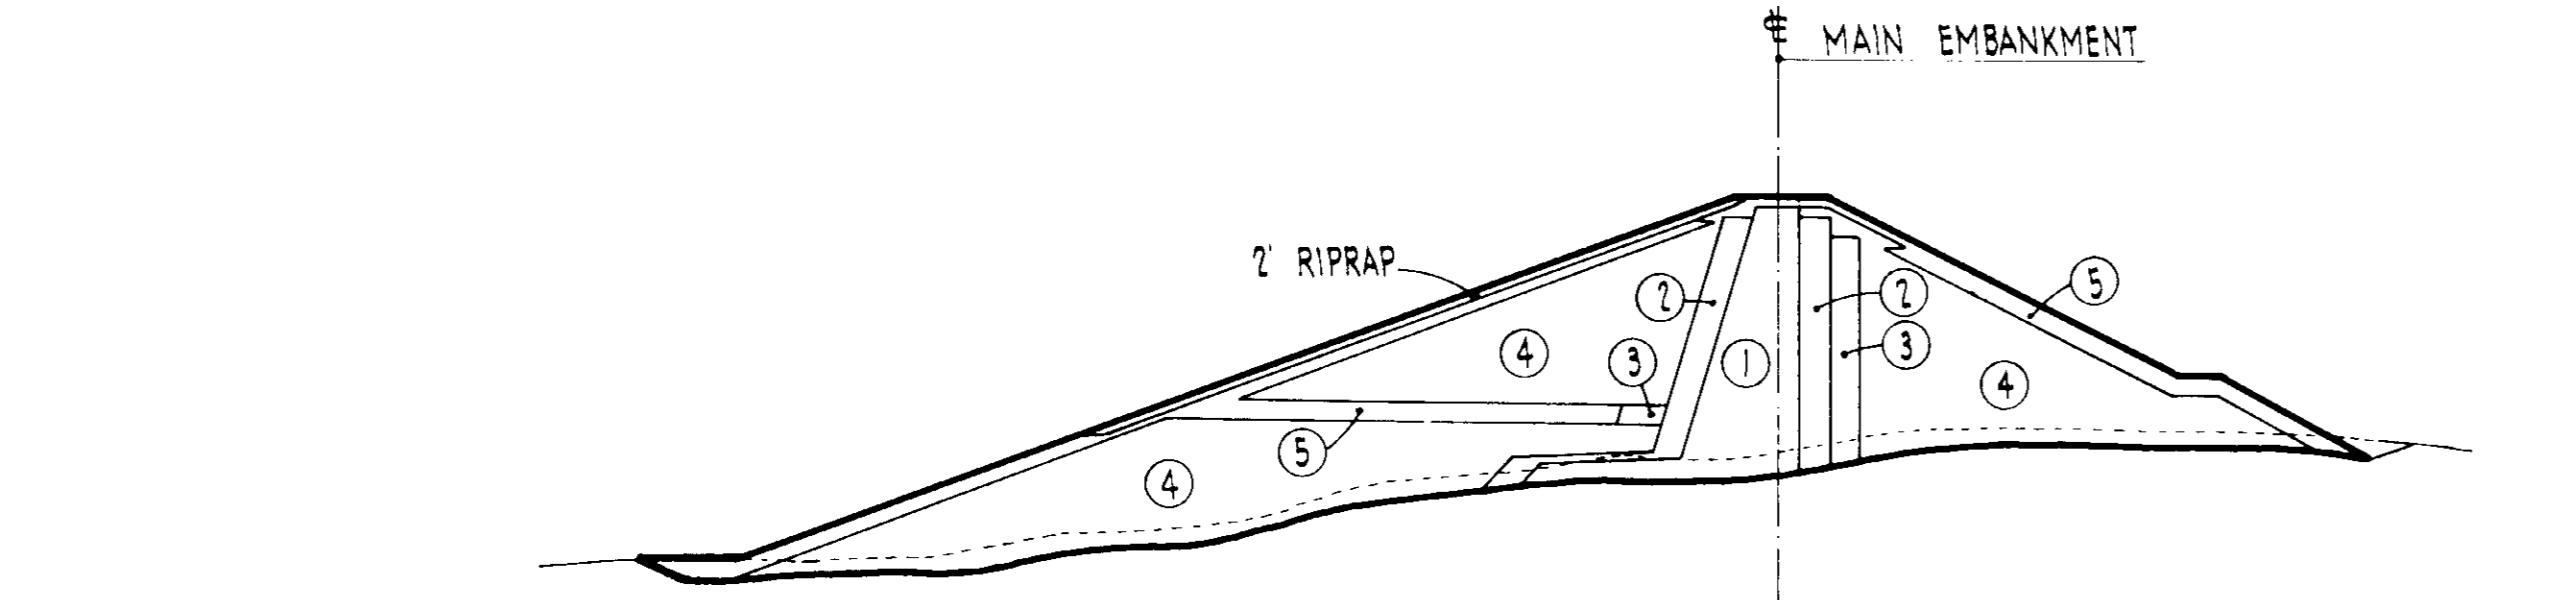


**SECTION AT STA. 32 + 00**

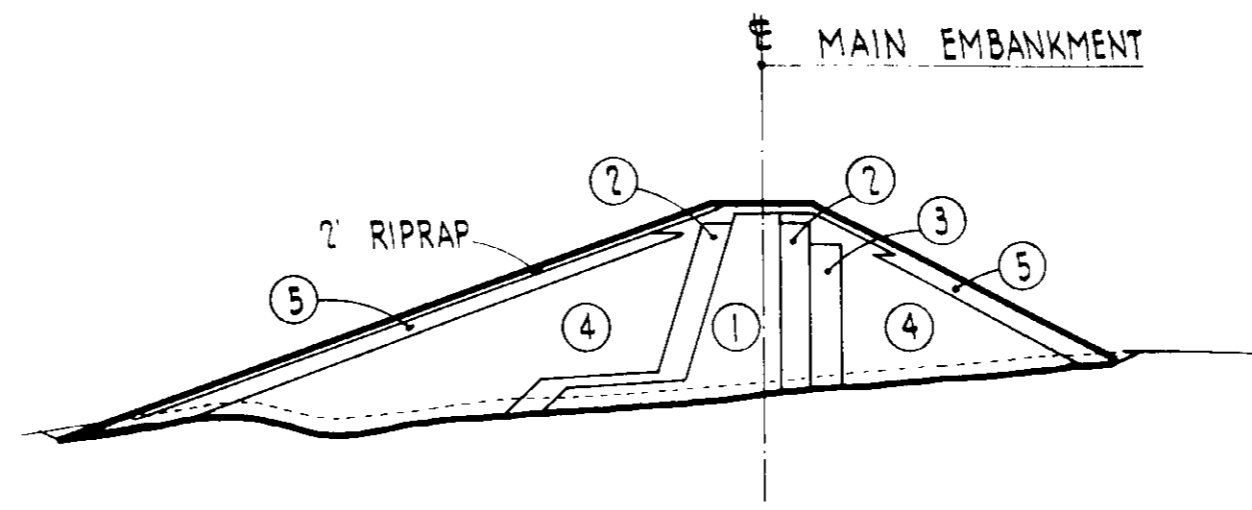


**SECTION AT STA. 33 + 00**

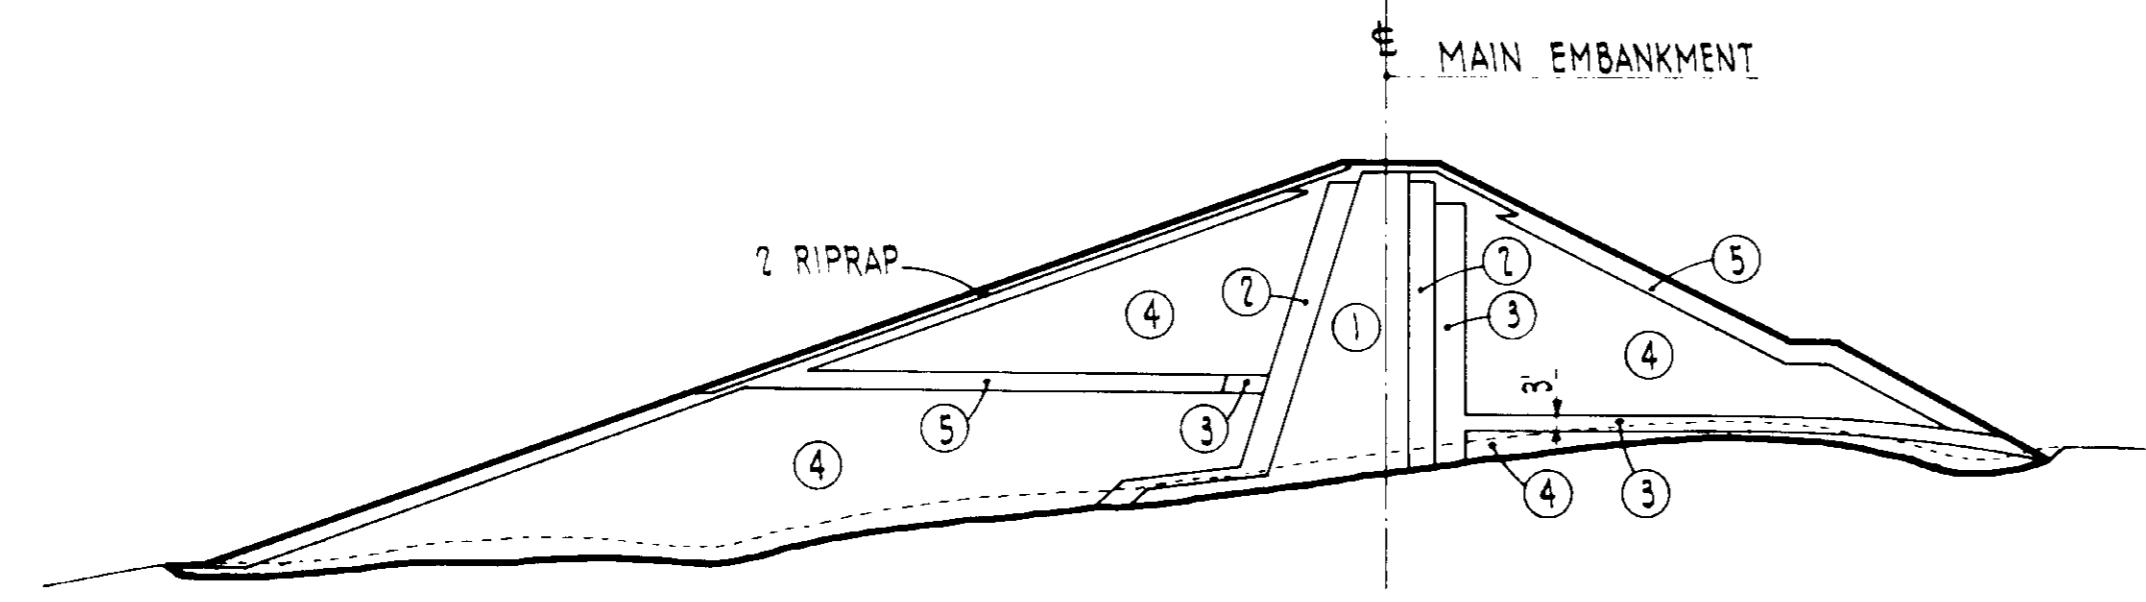

**SECTION AT STA. 31 + 00**

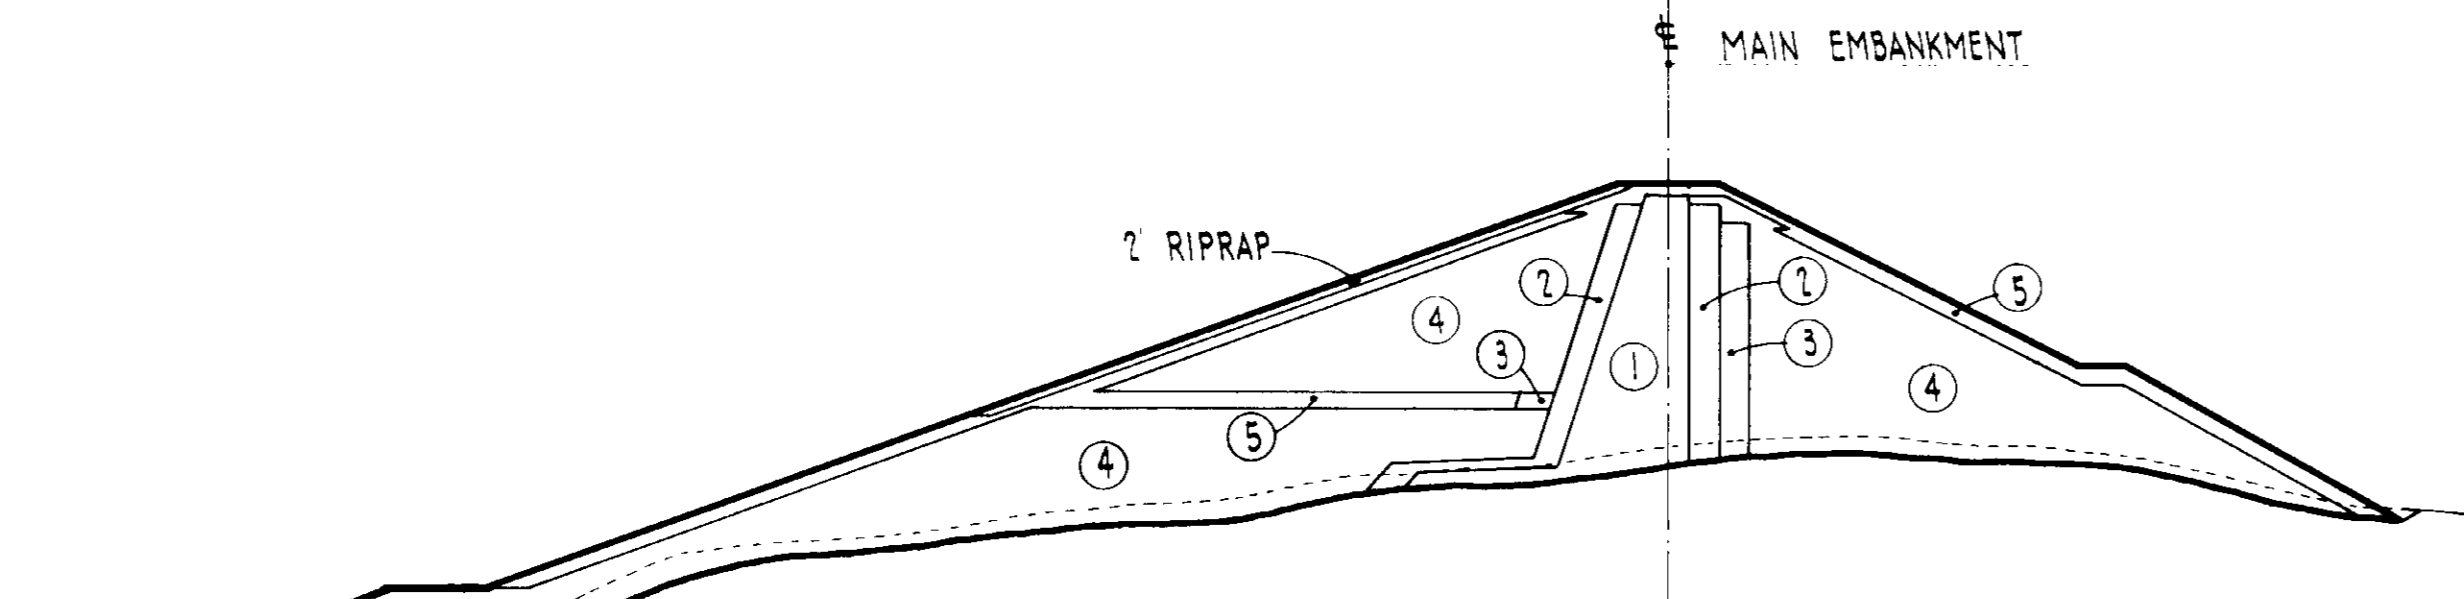

**SECTION AT STA. 30 + 00**

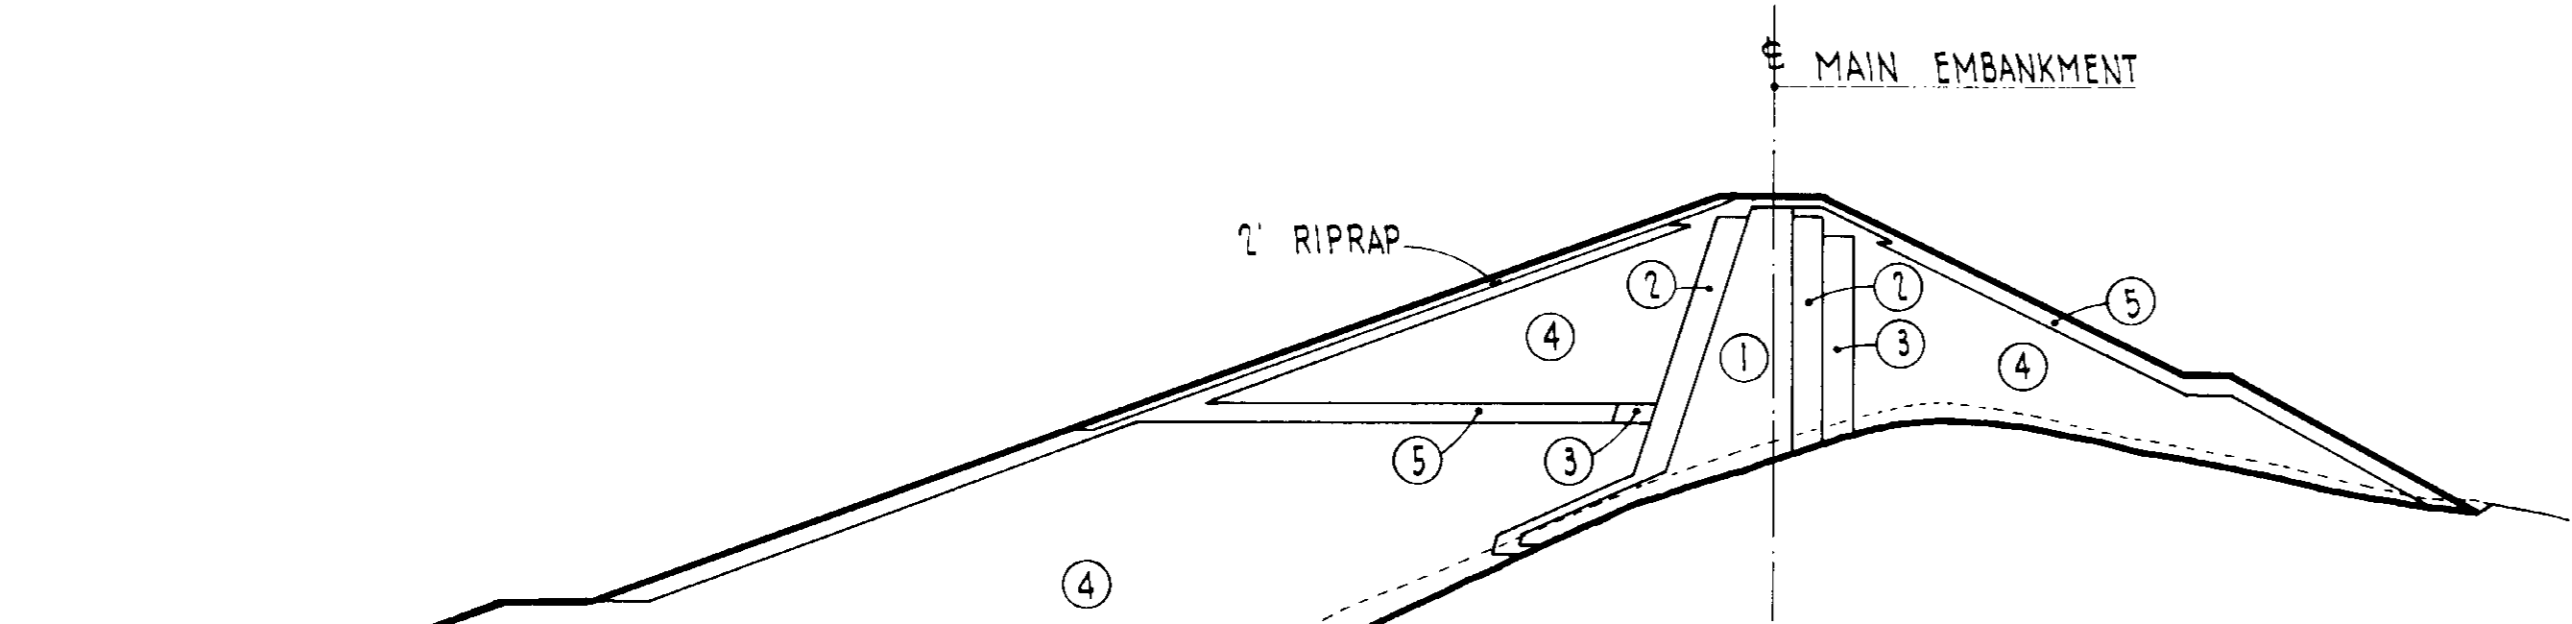

**SECTION AT STA. 29 + 00**

SCALE: 1" = 50'

**NOTES**


- 1 See note 1 on drawing number 18 for detail.
- 2 Vertical control of the 3 foot thick section of Zone 3 material, shown by section at station 31+00, will be determined in the field. The bottom of the 3 foot thick Zone 3 section shall not be more than 2 feet above the crest of the ridge after the stripping.

**05269**

**REFERENCE DRAWINGS**

FOR REFERENCE DRAWINGS SEE DRAWING NO. 17

**AS CONSTRUCTED**  
 DATE 4/5/73 DFT W.A.W. C.P.D. JFM

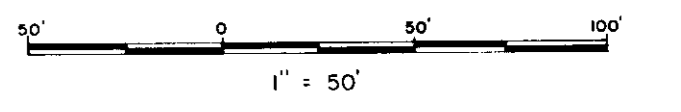

NO.	DATE	REVISIONS	BY	CHK	JOB PROJ. ENG.	DR. ENGR. MGR.
1	4/5/73	ISSUED FOR CONSTRUCTION	J.E.W.	DFM	JFM	JFM


**LAS VIRGENES MUNICIPAL WATER DISTRICT**

**BOYLE ENGINEERING  
 W. A. WAHLER & ASSOCIATES**

**WESTLAKE RESERVOIR**


**MAIN EMBANKMENT  
 SECTIONS - SHEET 2 OF 2**

DESIGNED F.W.G.	DATE: 11-70	JOB ENG. C.W.P.	PROJ. ENG. JFM
DRAWN W.A.W.	CHECKED C.W.P.	SCALE AS SHOWN	DRAWING NUMBER 19

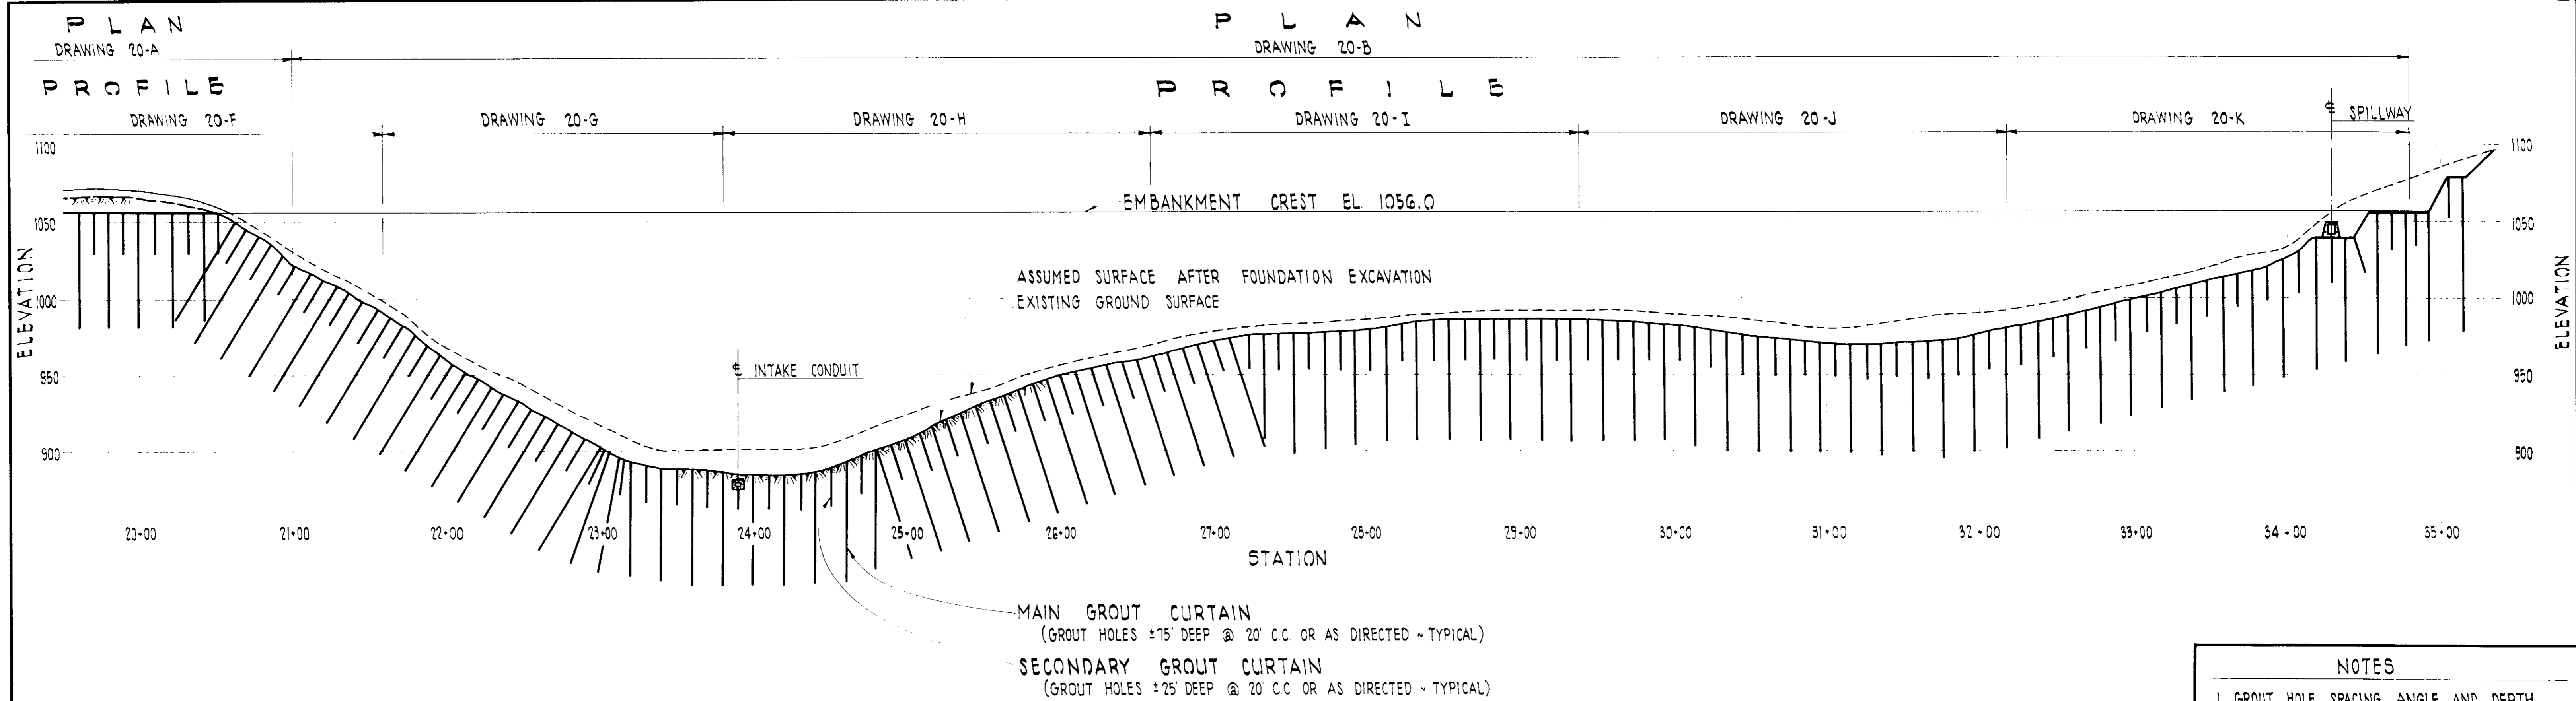

**MAIN EMBANKMENT - LONGITUDINAL PROFILE**

SCALE: 1" = 50'

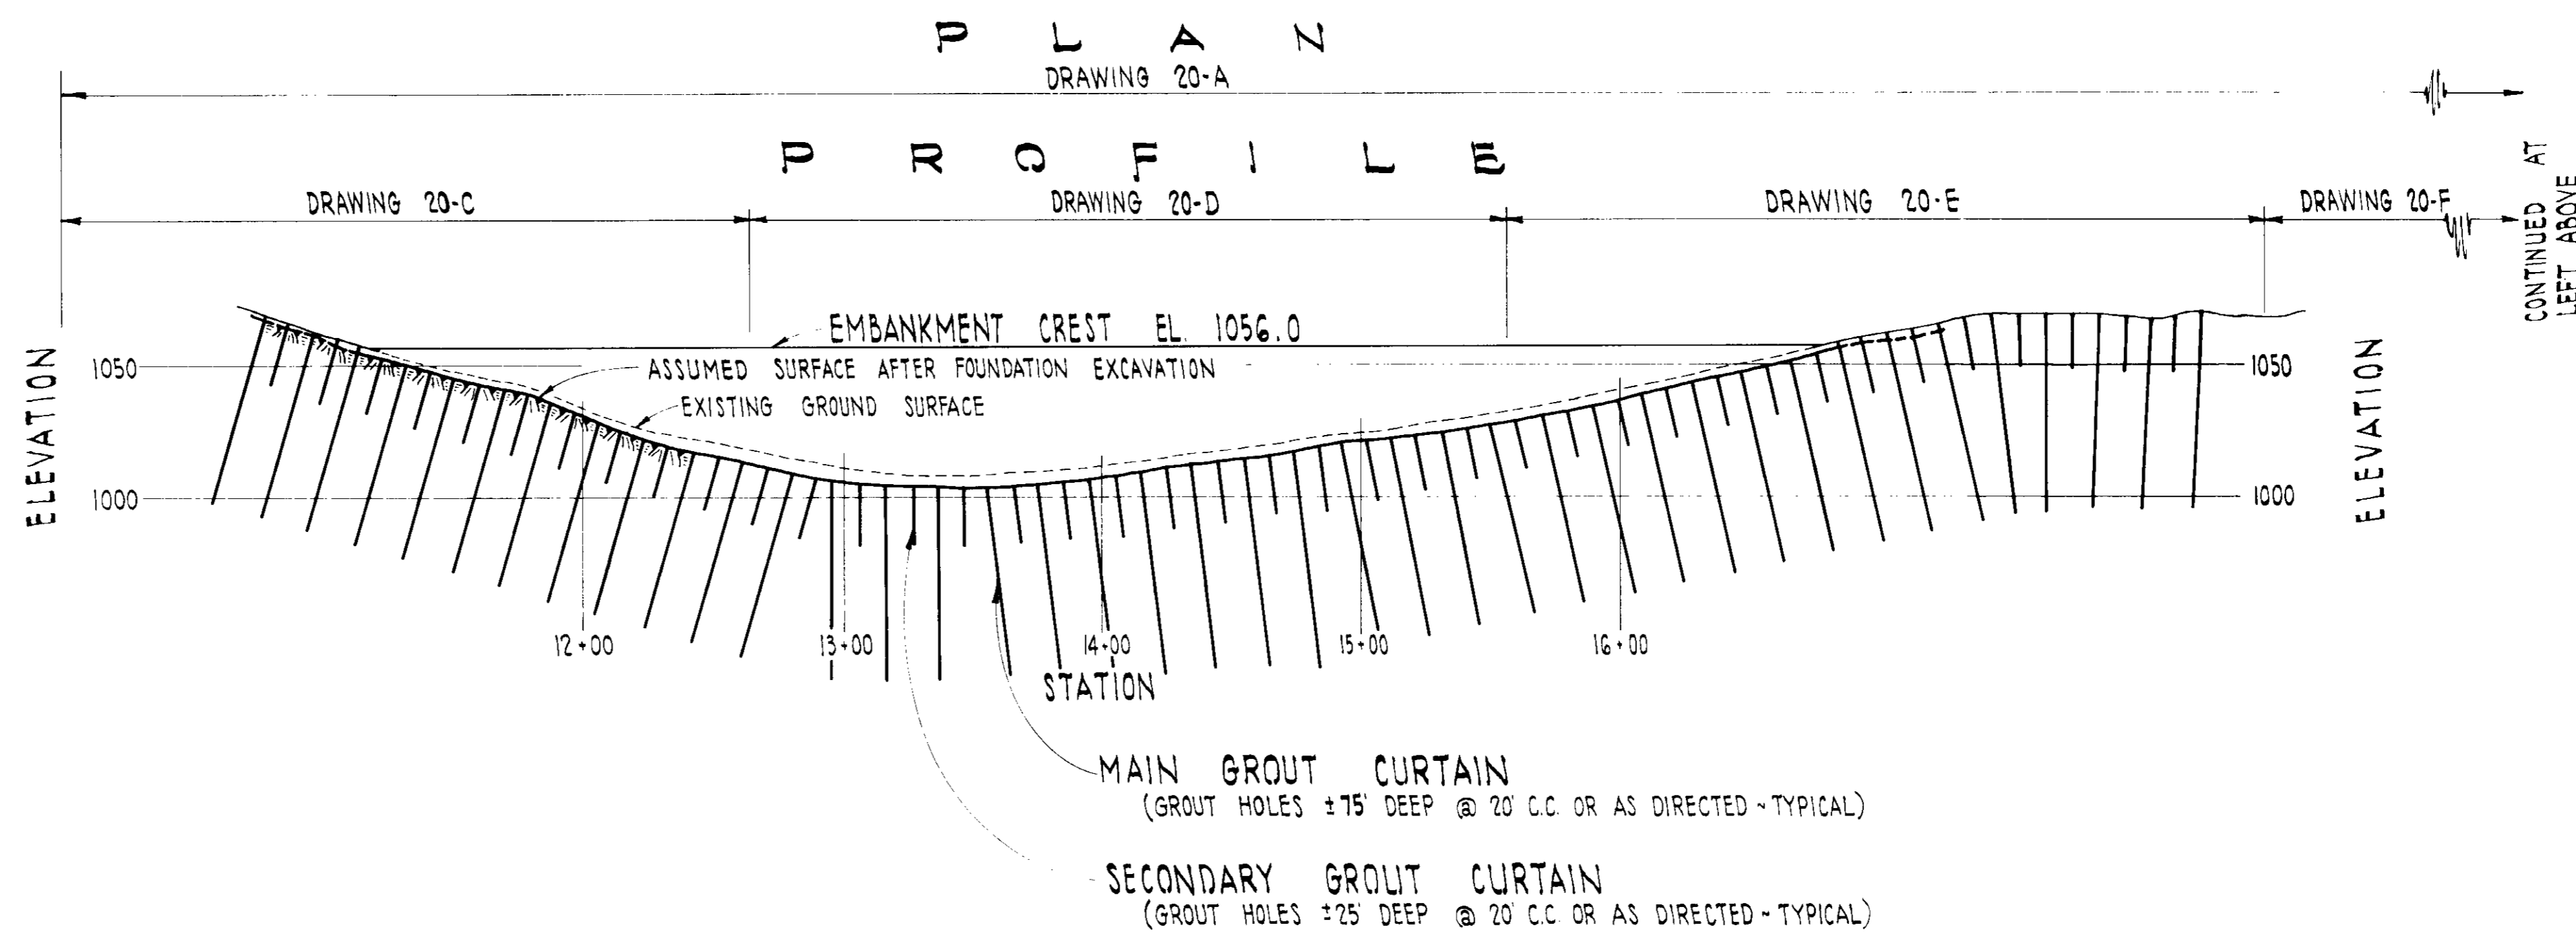

**WEST EMBANKMENT - LONGITUDINAL PROFILE**

SCALE: 1" = 50'


**INDEX ~ GROUT CURTAIN SUMMARY**

**NOTES**  
 1. GROUT HOLE SPACING, ANGLE AND DEPTH SHOWN ON THIS SHEET FOR BIDDING PURPOSES ONLY. SEE DRAWINGS INDICATED ON THIS INDEX FOR 'AS CONSTRUCTED' DATA.

**05270**

**REFERENCE DRAWINGS**  
 FOR REFERENCE DRAWINGS SEE DRAWING NO. 17 AND DRAWING NO. 23

**AS CONSTRUCTED**  
 DATE 4/13/73 DFT [Signature] CKD [Signature]

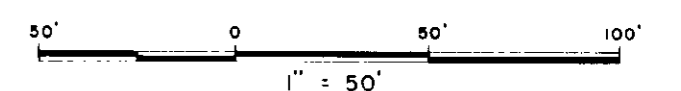


ISSUED FOR CONSTRUCTION		REVISIONS		BY	CHK	JOB	PROJ.	ENGR.	MGR.
NO.	DATE								



**LAS VIRGENES MUNICIPAL WATER DISTRICT**

**BOYLE ENGINEERING  
 W. A. WAHLER & ASSOCIATES**

**WESTLAKE RESERVOIR  
 MAIN & WEST EMBANKMENTS  
 LONGITUDINAL PROFILES**

DESIGNED E.W.G.	DATE: 11-70	JOB ENG. C.W.P.	PROJ. ENGR. [Signature]
DRAWN [Signature]	CHECKED C.W.P.	[Signature]	R. C. E. 9996
DRAWING NUMBER		REV.	
20			

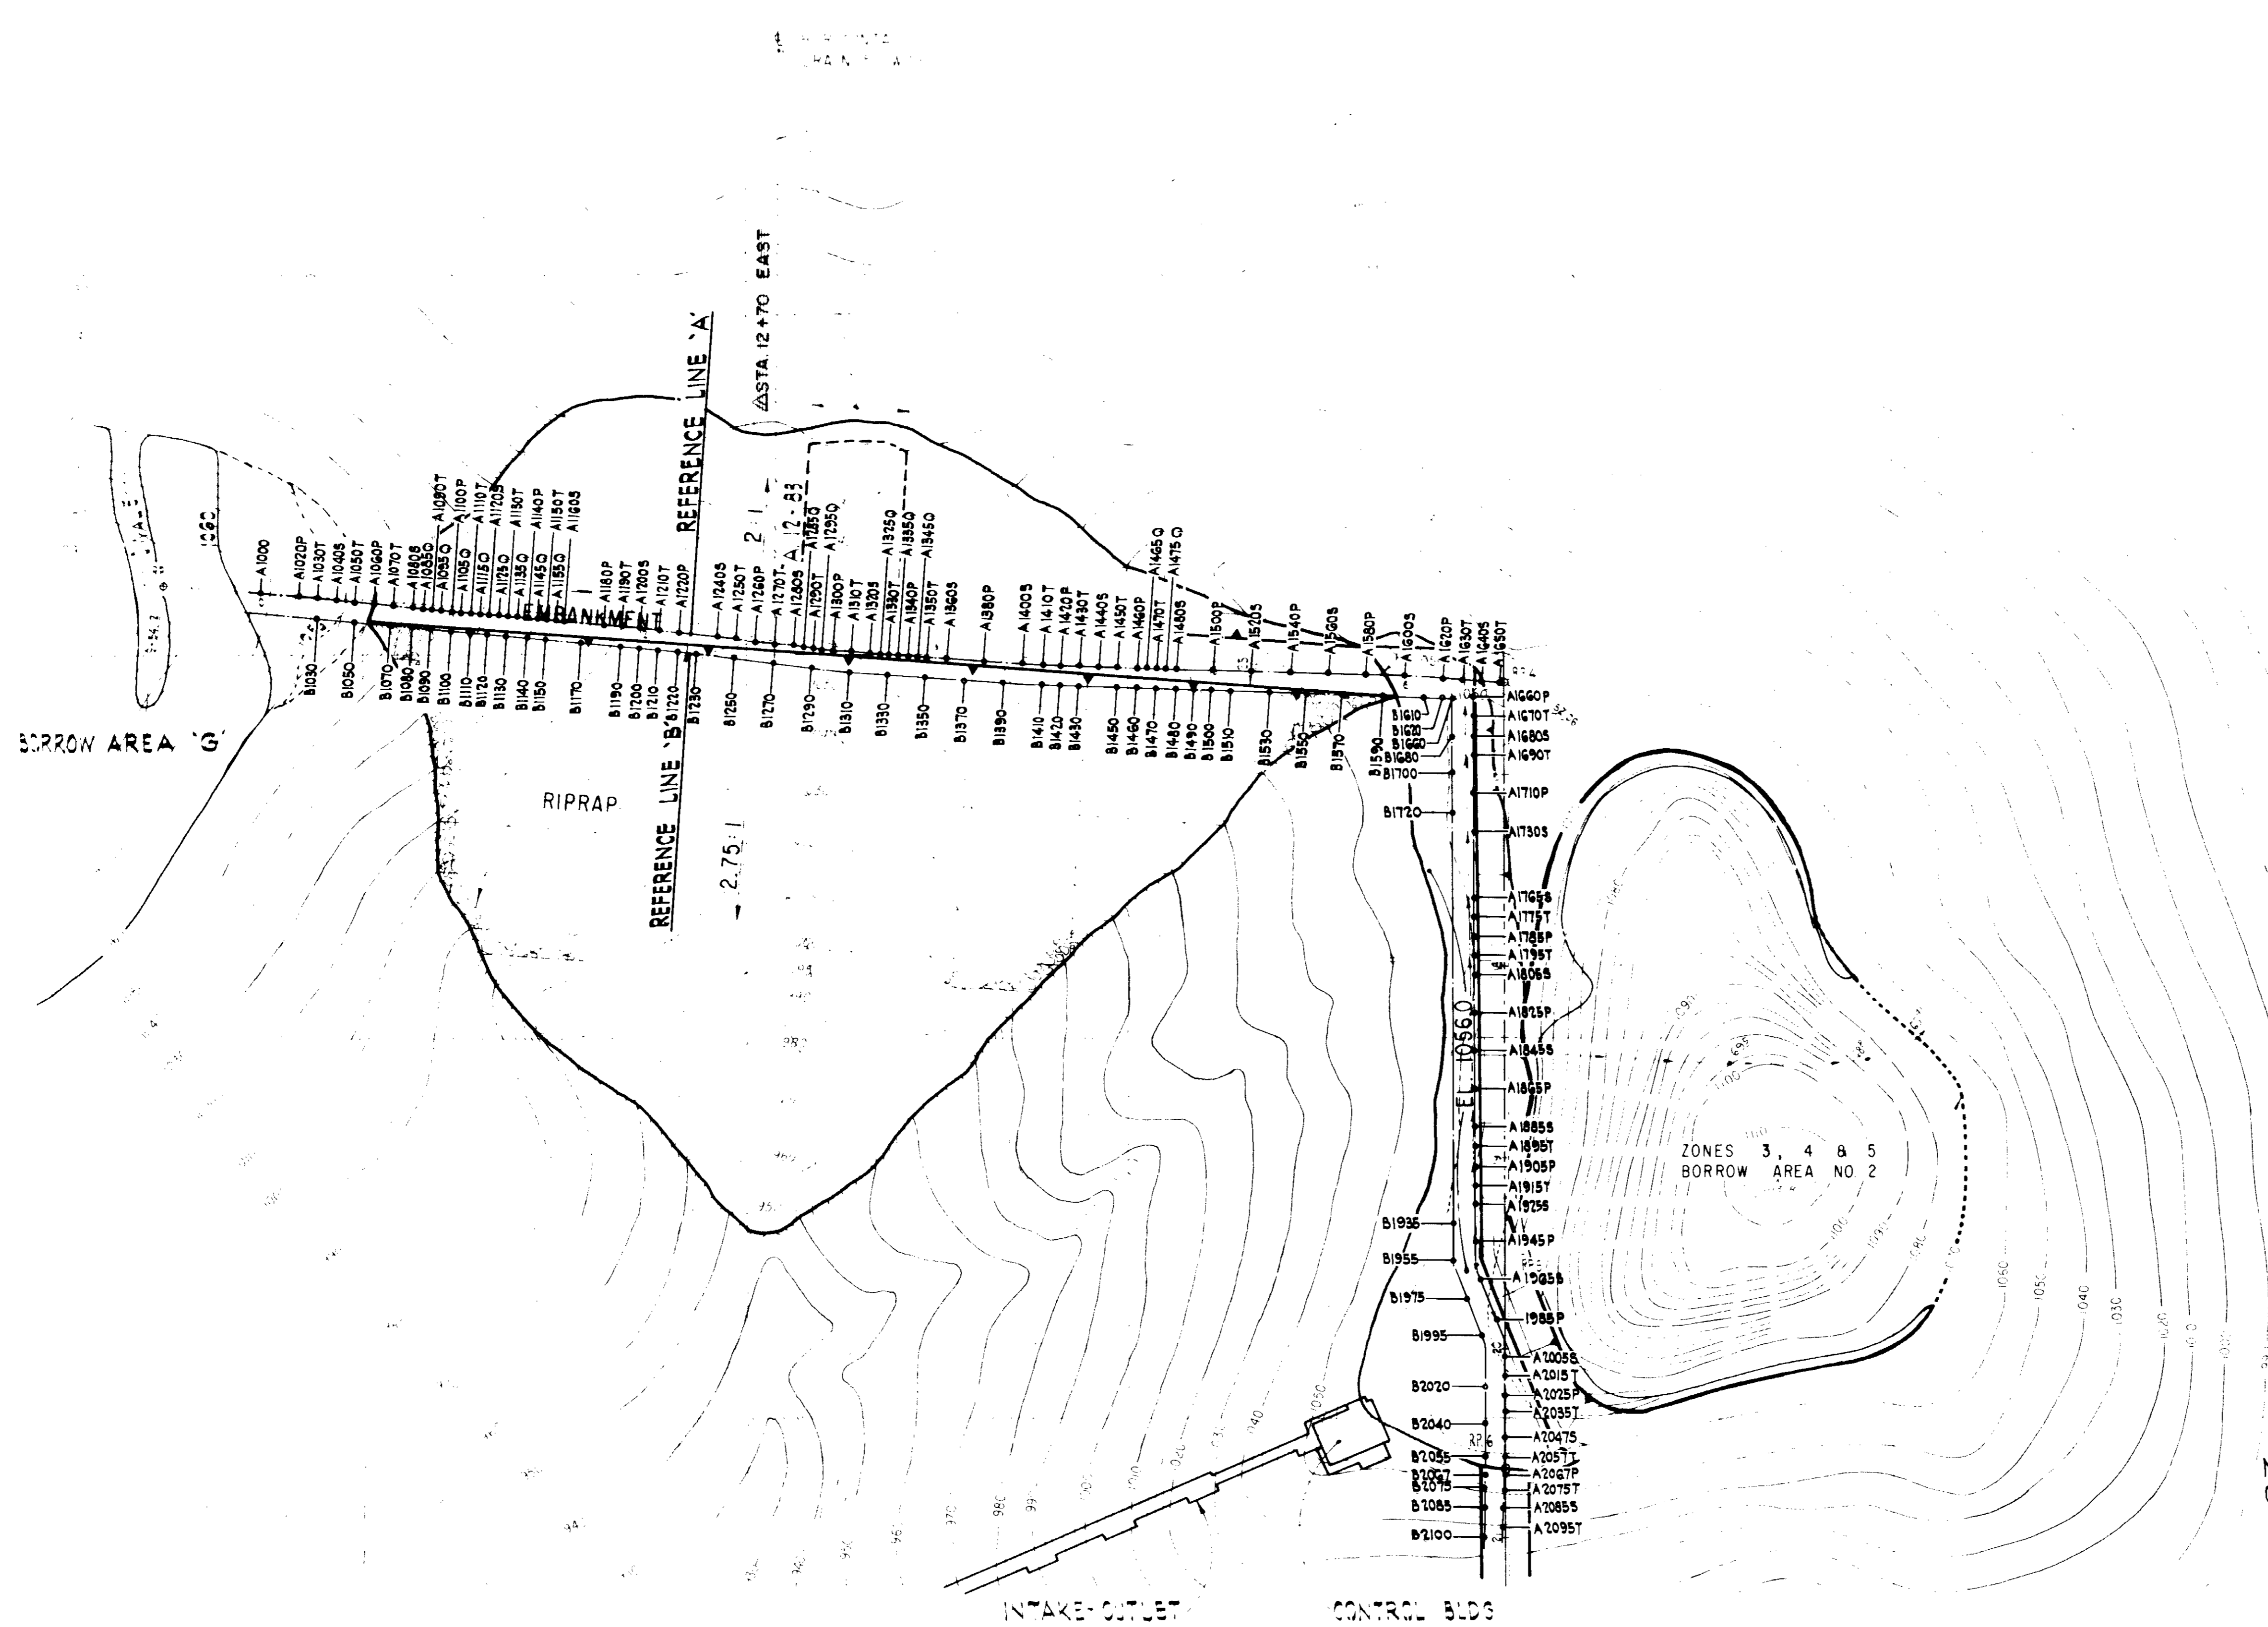


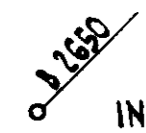 INDICATES GROUT HOLE LOCATION UP TO 25' IN DEPTH.  
 INDICATES GROUT HOLE LOCATION OVER 25' IN DEPTH.

**AS CONSTRUCTED**  
 DATE 4/5/73 DFT R.H.R. CKD D.F.W.

REFERENCE DRAWINGS  
 20 LONGITUDINAL PROFILES  
 24 SECTIONS

05271

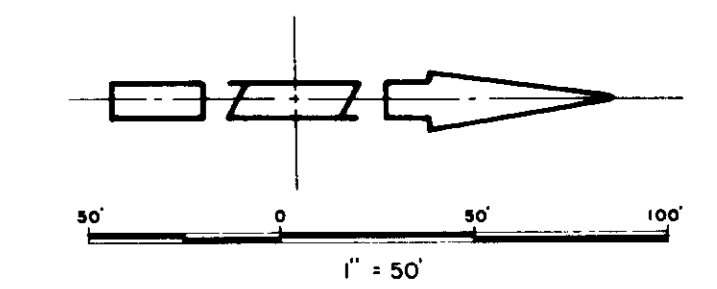


NOTE: ALL CONTOURS INDICATED ARE ORIGINAL BEFORE STRIPPING.

**PLAN**  
 SCALE 1" = 50'

SEE SHEET 20-B FOR CONTINUATION OF GROUT HOLE LOCATIONS.

Issued For Construction <i>J.E.M. R.H.R. D.F.W.</i>						
NO.	DATE	REVISIONS	BY	CHK.	JOB PROJ. ENG.	PROJ. MGR.
LAS VIRGENES MUNICIPAL WATER DISTRICT						
BOYLE ENGINEERING W. A. WAHLER & ASSOCIATES						
WESTLAKE RESERVOIR <b>WEST EMBANKMENT</b> GROUT HOLE LOCATIONS - SHEET 1 OF 2						
DESIGNED F.W.G.	DATE: 11-70	JOB ENG. C.W.P.	PROJ. ENG.	<i>J.H.</i>		
DRAWN <i>R.P.</i>	CHECKED <i>C.W.P.</i>		DRAWING NUMBER <b>20-A</b>		REV.	
SCALE AS SHOWN						

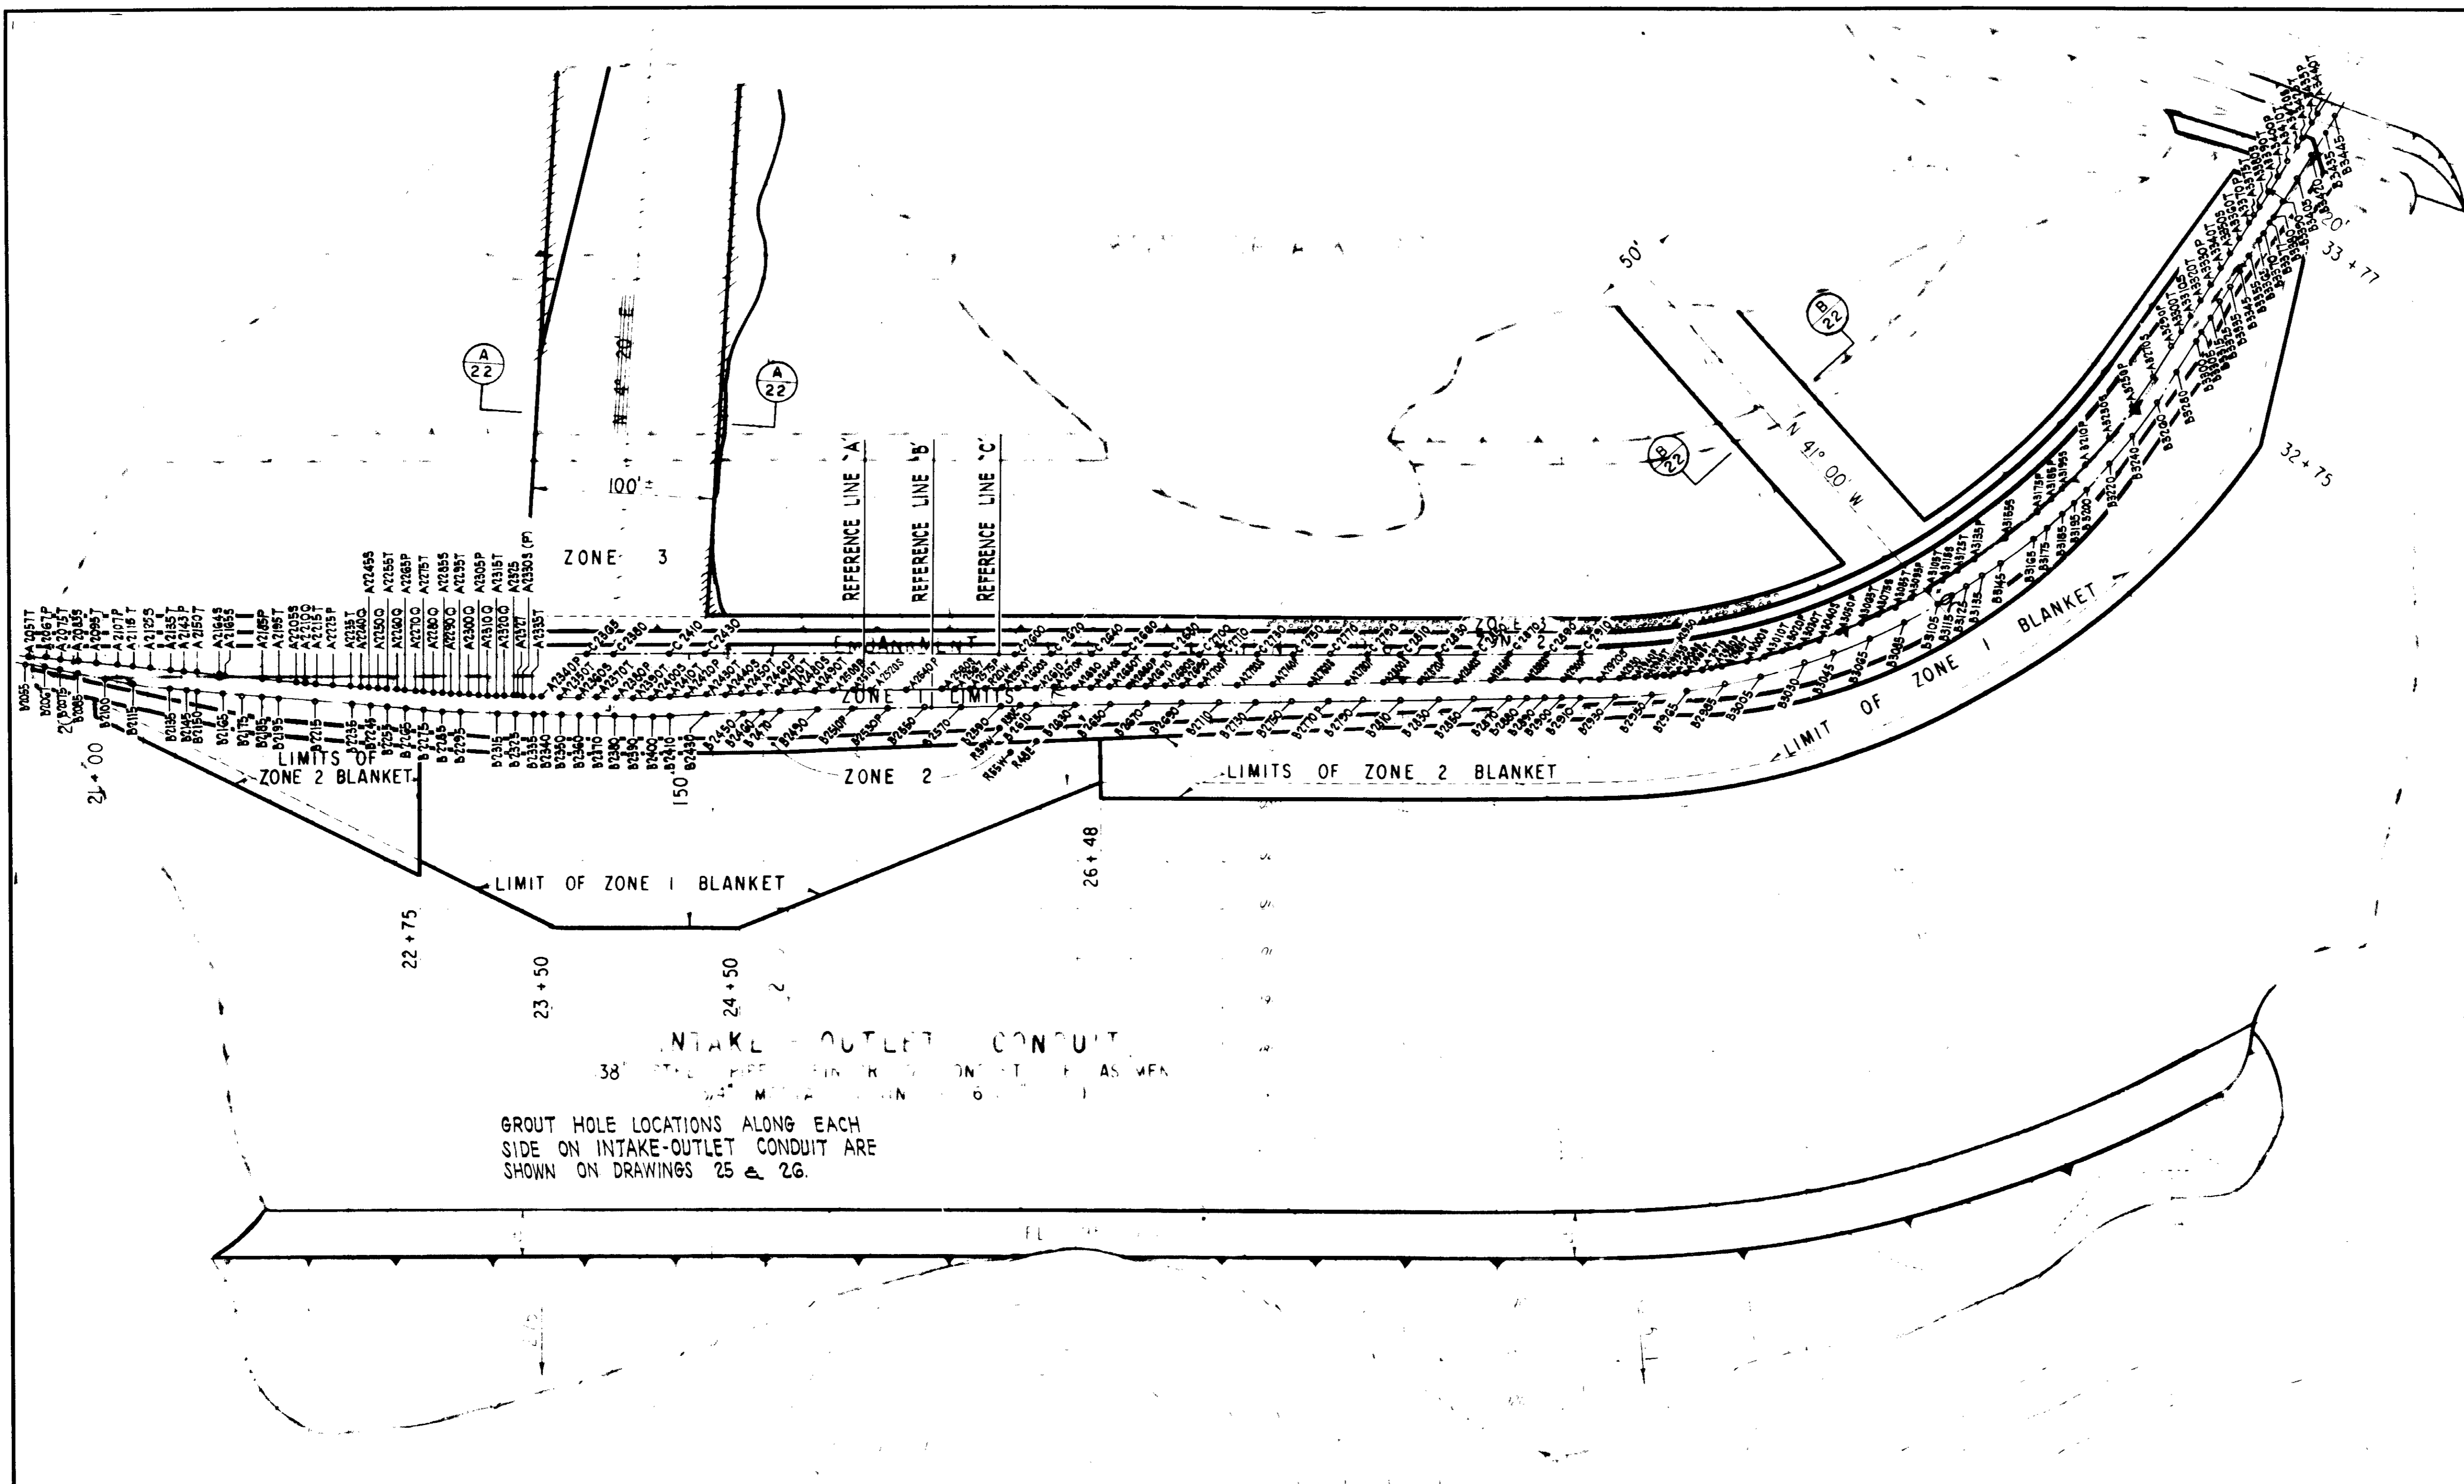

INTAKE-OUTLET CONDUIT  
 38' DIAMETER  
 GROUT HOLE LOCATIONS ALONG EACH  
 SIDE ON INTAKE-OUTLET CONDUIT ARE  
 SHOWN ON DRAWINGS 25 & 26.

**PLAN - AT FOUNDATION CONTACT**  
 SCALE: 1" = 50'

NOTE: ALL CONTOURS INDICATED ARE ORIGINAL BEFORE STRIPPING.

REFERENCE DRAWINGS  
 FOR REFERENCE DRAWINGS SEE DRAWING NO. 17

**05272**

NO.	DATE	REVISIONS	BY	CHK	JOB	PROJ.	ENC.	ENC.	MGR.


LAS VIRGENES MUNICIPAL WATER DISTRICT

BOYLE ENGINEERING  
 W. A. WAHLER & ASSOCIATES

WESTLAKE RESERVOIR  
**MAIN EMBANKMENT**  
 GROUT HOLE LOCATIONS - SHEET 2 OF 2

DESIGNED F.W.G.	DATE: 11-70	JOB ENG. C.W.P.	PROJ. ENC. <i>W.A.</i>
DRAWN <i>S.R.</i>		CHECKED C.W.P.	DRAWING NUMBER
			<b>20-B</b>
			REV.

SCALE AS SHOWN

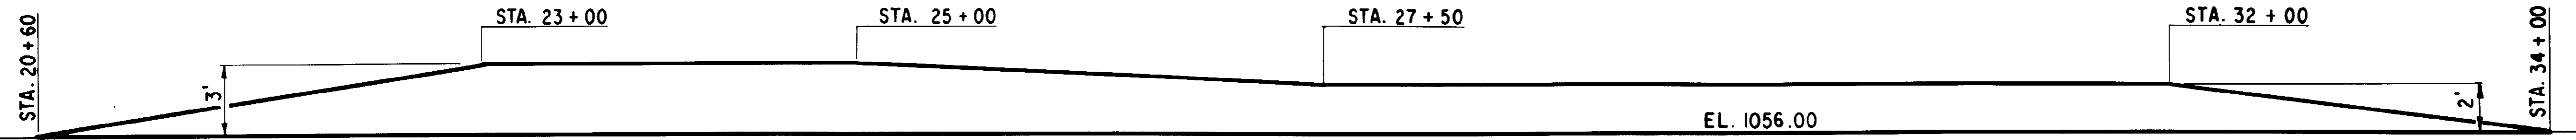

**CAMBER DIAGRAM**


HORIZ. SCALE: 1" = 20'  
 VERT. SCALE: 1" = 4'

**AS CONSTRUCTED**  
 DATE: 4/5/73 DFT: *W.A.W.* CAD: *DFM*



ELEVATION

ELEVATION

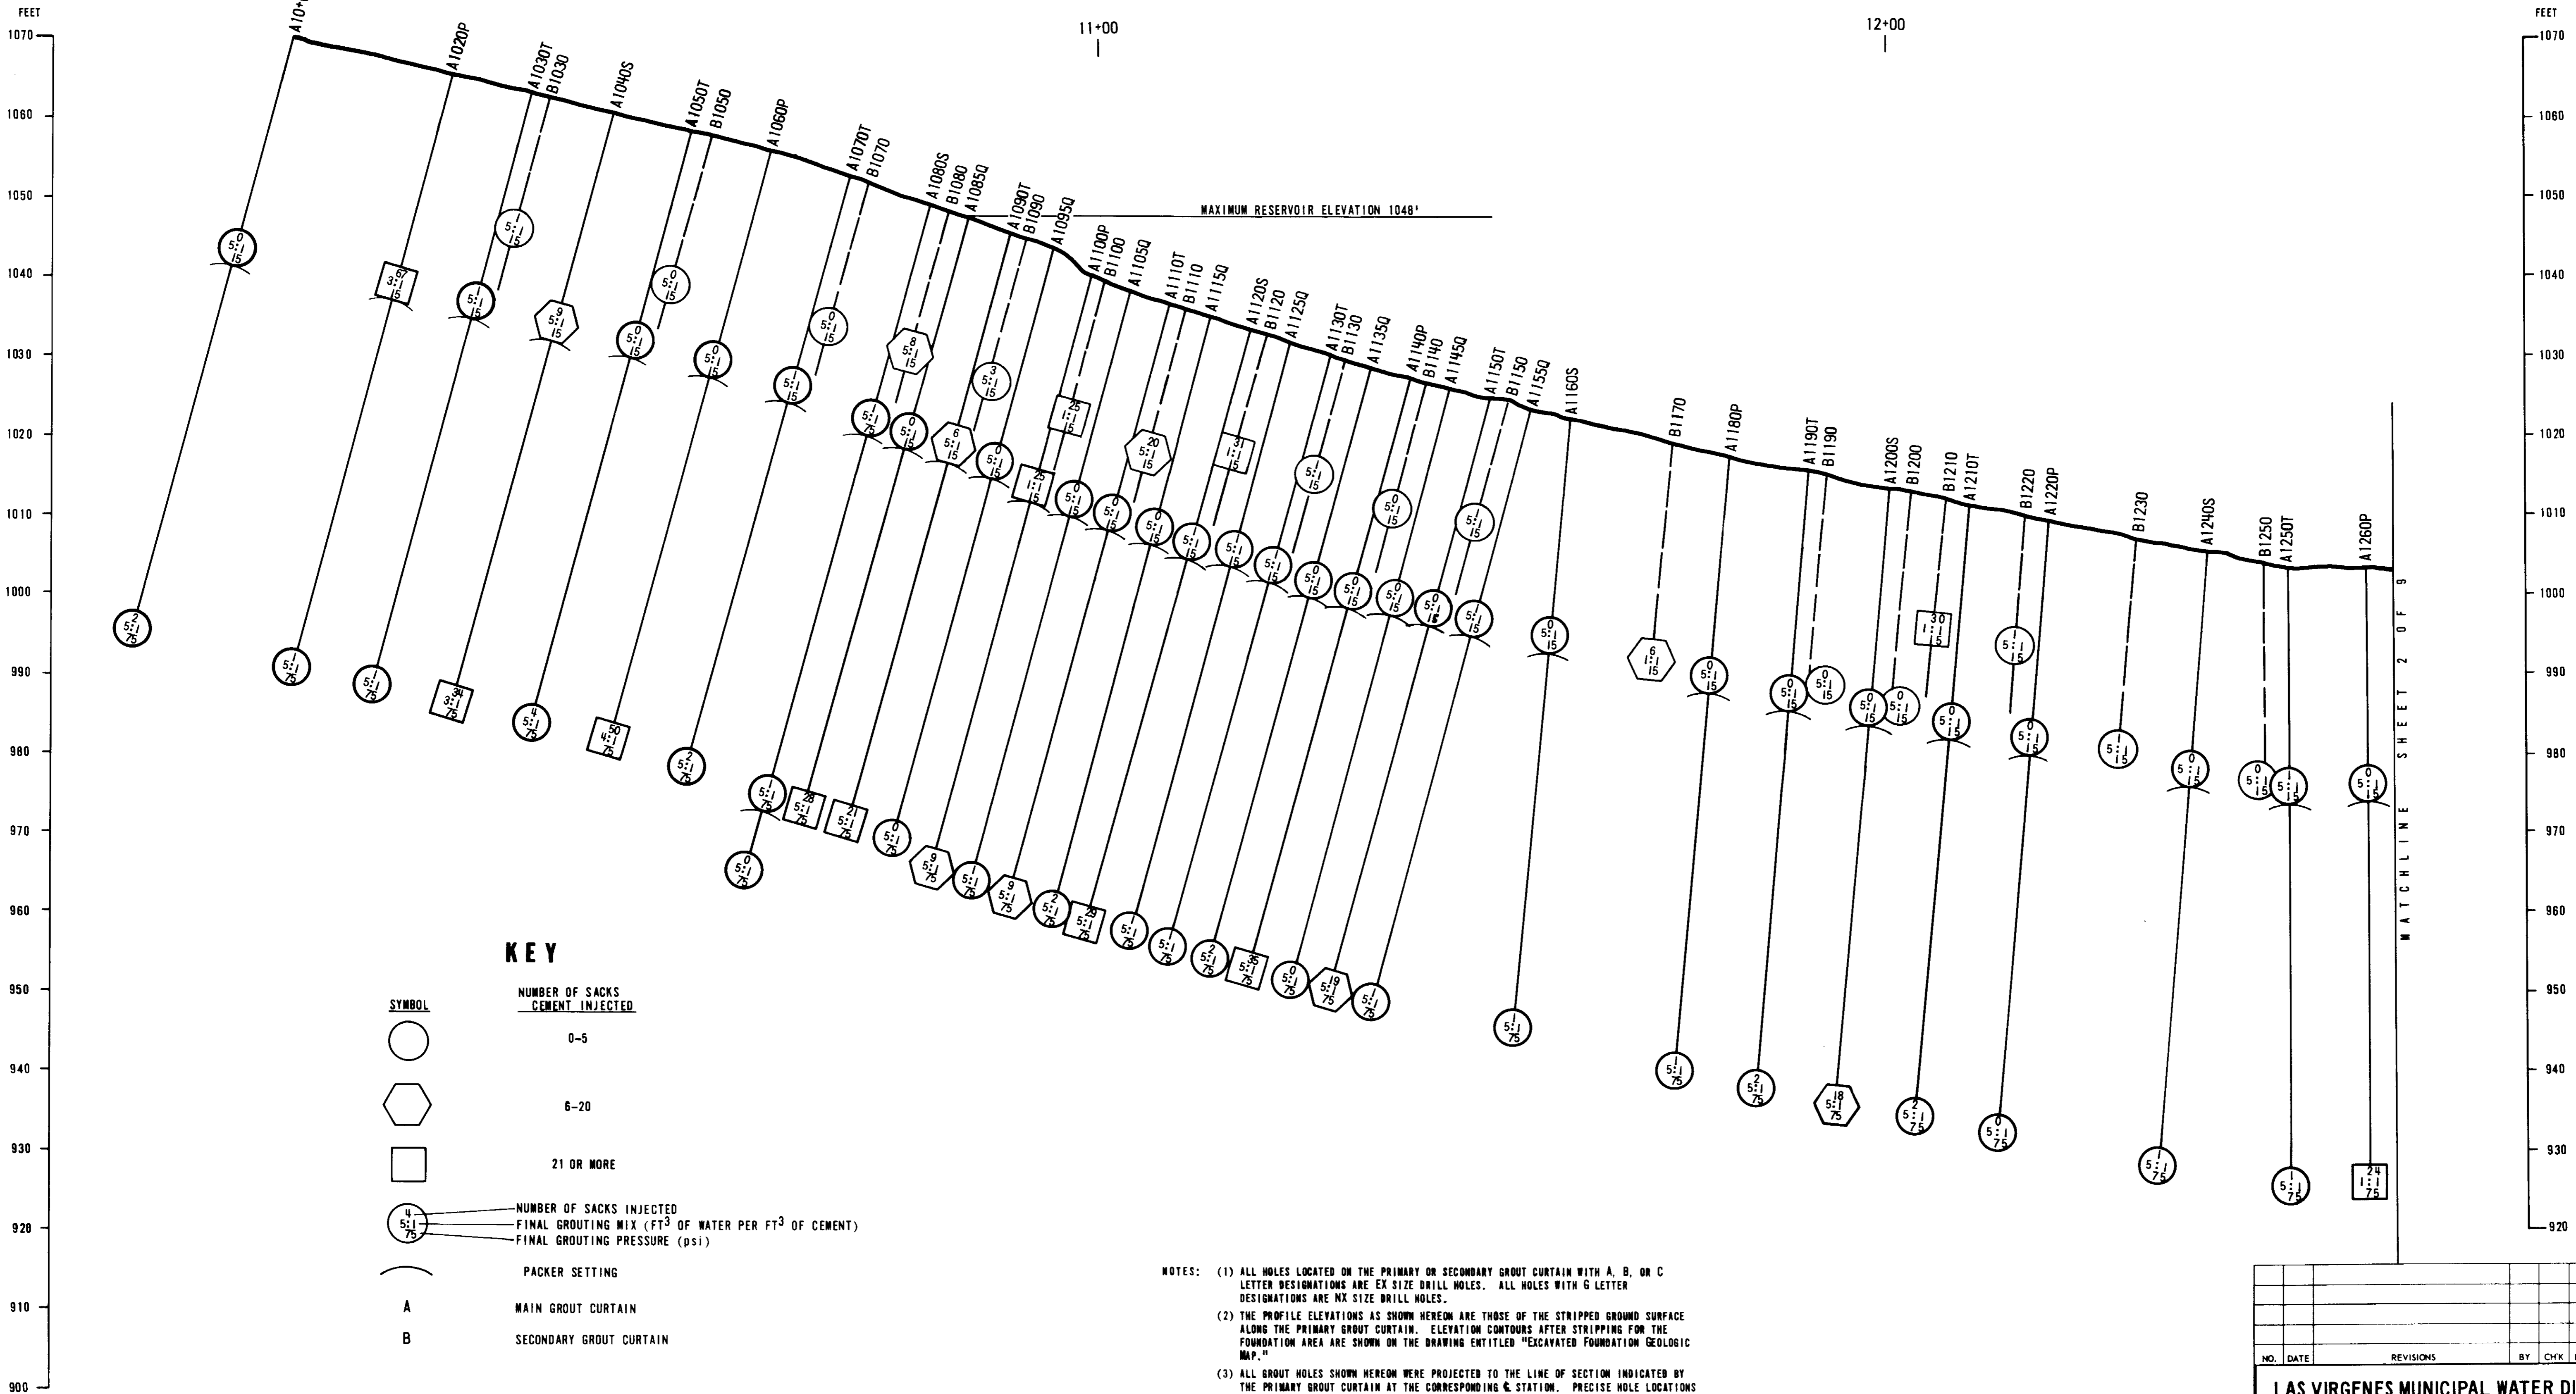

**KEY**

<b>SYMBOL</b>	<b>NUMBER OF SACKS CEMENT INJECTED</b>
○	0-5
⬡	6-20
□	21 OR MORE
○ 4 5:1 75	NUMBER OF SACKS INJECTED FINAL GROUTING MIX (FT <sup>3</sup> OF WATER PER FT <sup>3</sup> OF CEMENT) FINAL GROUTING PRESSURE (psi)
( )	PACKER SETTING
A	MAIN GROUT CURTAIN
B	SECONDARY GROUT CURTAIN

- NOTES:**
- (1) ALL HOLES LOCATED ON THE PRIMARY OR SECONDARY GROUT CURTAIN WITH A, B, OR C LETTER DESIGNATIONS ARE EX SIZE DRILL HOLES. ALL HOLES WITH G LETTER DESIGNATIONS ARE NX SIZE DRILL HOLES.
  - (2) THE PROFILE ELEVATIONS AS SHOWN HEREON ARE THOSE OF THE STRIPPED GROUND SURFACE ALONG THE PRIMARY GROUT CURTAIN. ELEVATION CONTOURS AFTER STRIPPING FOR THE FOUNDATION AREA ARE SHOWN ON THE DRAWING ENTITLED "EXCAVATED FOUNDATION GEOLOGIC MAP."
  - (3) ALL GROUT HOLES SHOWN HEREON WERE PROJECTED TO THE LINE OF SECTION INDICATED BY THE PRIMARY GROUT CURTAIN AT THE CORRESPONDING STATION. PRECISE HOLE LOCATIONS FOR ALL GROUT HOLES ARE SHOWN ON THE DRAWING ENTITLED "GROUT HOLE LOCATIONS."

MATCHLINE SHEET 2 OF 3

**05273**

DATE 12-15-73 H.N.R. CKD D.M.

NO.	DATE	REVISIONS	BY	CHK	JOB ENG.	PROJ. ENG.	MGR.	
<b>LAS VIRGENES MUNICIPAL WATER DISTRICT</b>								
BOYLE ENGINEERING W. A. WAHLER & ASSOCIATES								
WESTLAKE RESERVOIR GROUT CURTAIN SUMMARY WEST EMBANKMENT STA. 10+00 - STA. 12+60								
DESIGNED	REV	DATE: 6/72	JOB ENG. <i>W. A. Wahler</i>	PROJ. ENG. <i>J. N.</i>				
DRAWN	<i>W. A. Wahler</i>			DRAWING NUMBER	REV.			
CHECKED	<i>R. C. Causton</i>			20-C				
SCALE AS SHOWN R. C. E. 1986								

13+00

14+00

15+00

### KEY

- SYMBOL**
- NUMBER OF SACKS OF CEMENT INJECTED: 0-5
  - ⬡ NUMBER OF SACKS OF CEMENT INJECTED: 6-20
  - NUMBER OF SACKS OF CEMENT INJECTED: 21 OR MORE
  - ⊙ NUMBER OF SACKS INJECTED, FINAL GROUTING MIX (FT<sup>3</sup> OF WATER PER FT<sup>3</sup> OF CEMENT), FINAL GROUTING PRESSURE (psi)
  - ( ) PACKER SETTING
  - A MAIN GROUT CURTAIN
  - B SECONDARY GROUT CURTAIN


ELEVATION

ELEVATION

MATCHLINE SHEET 3 OF 9

MATCHLINE SHEET 3 OF 9

05274

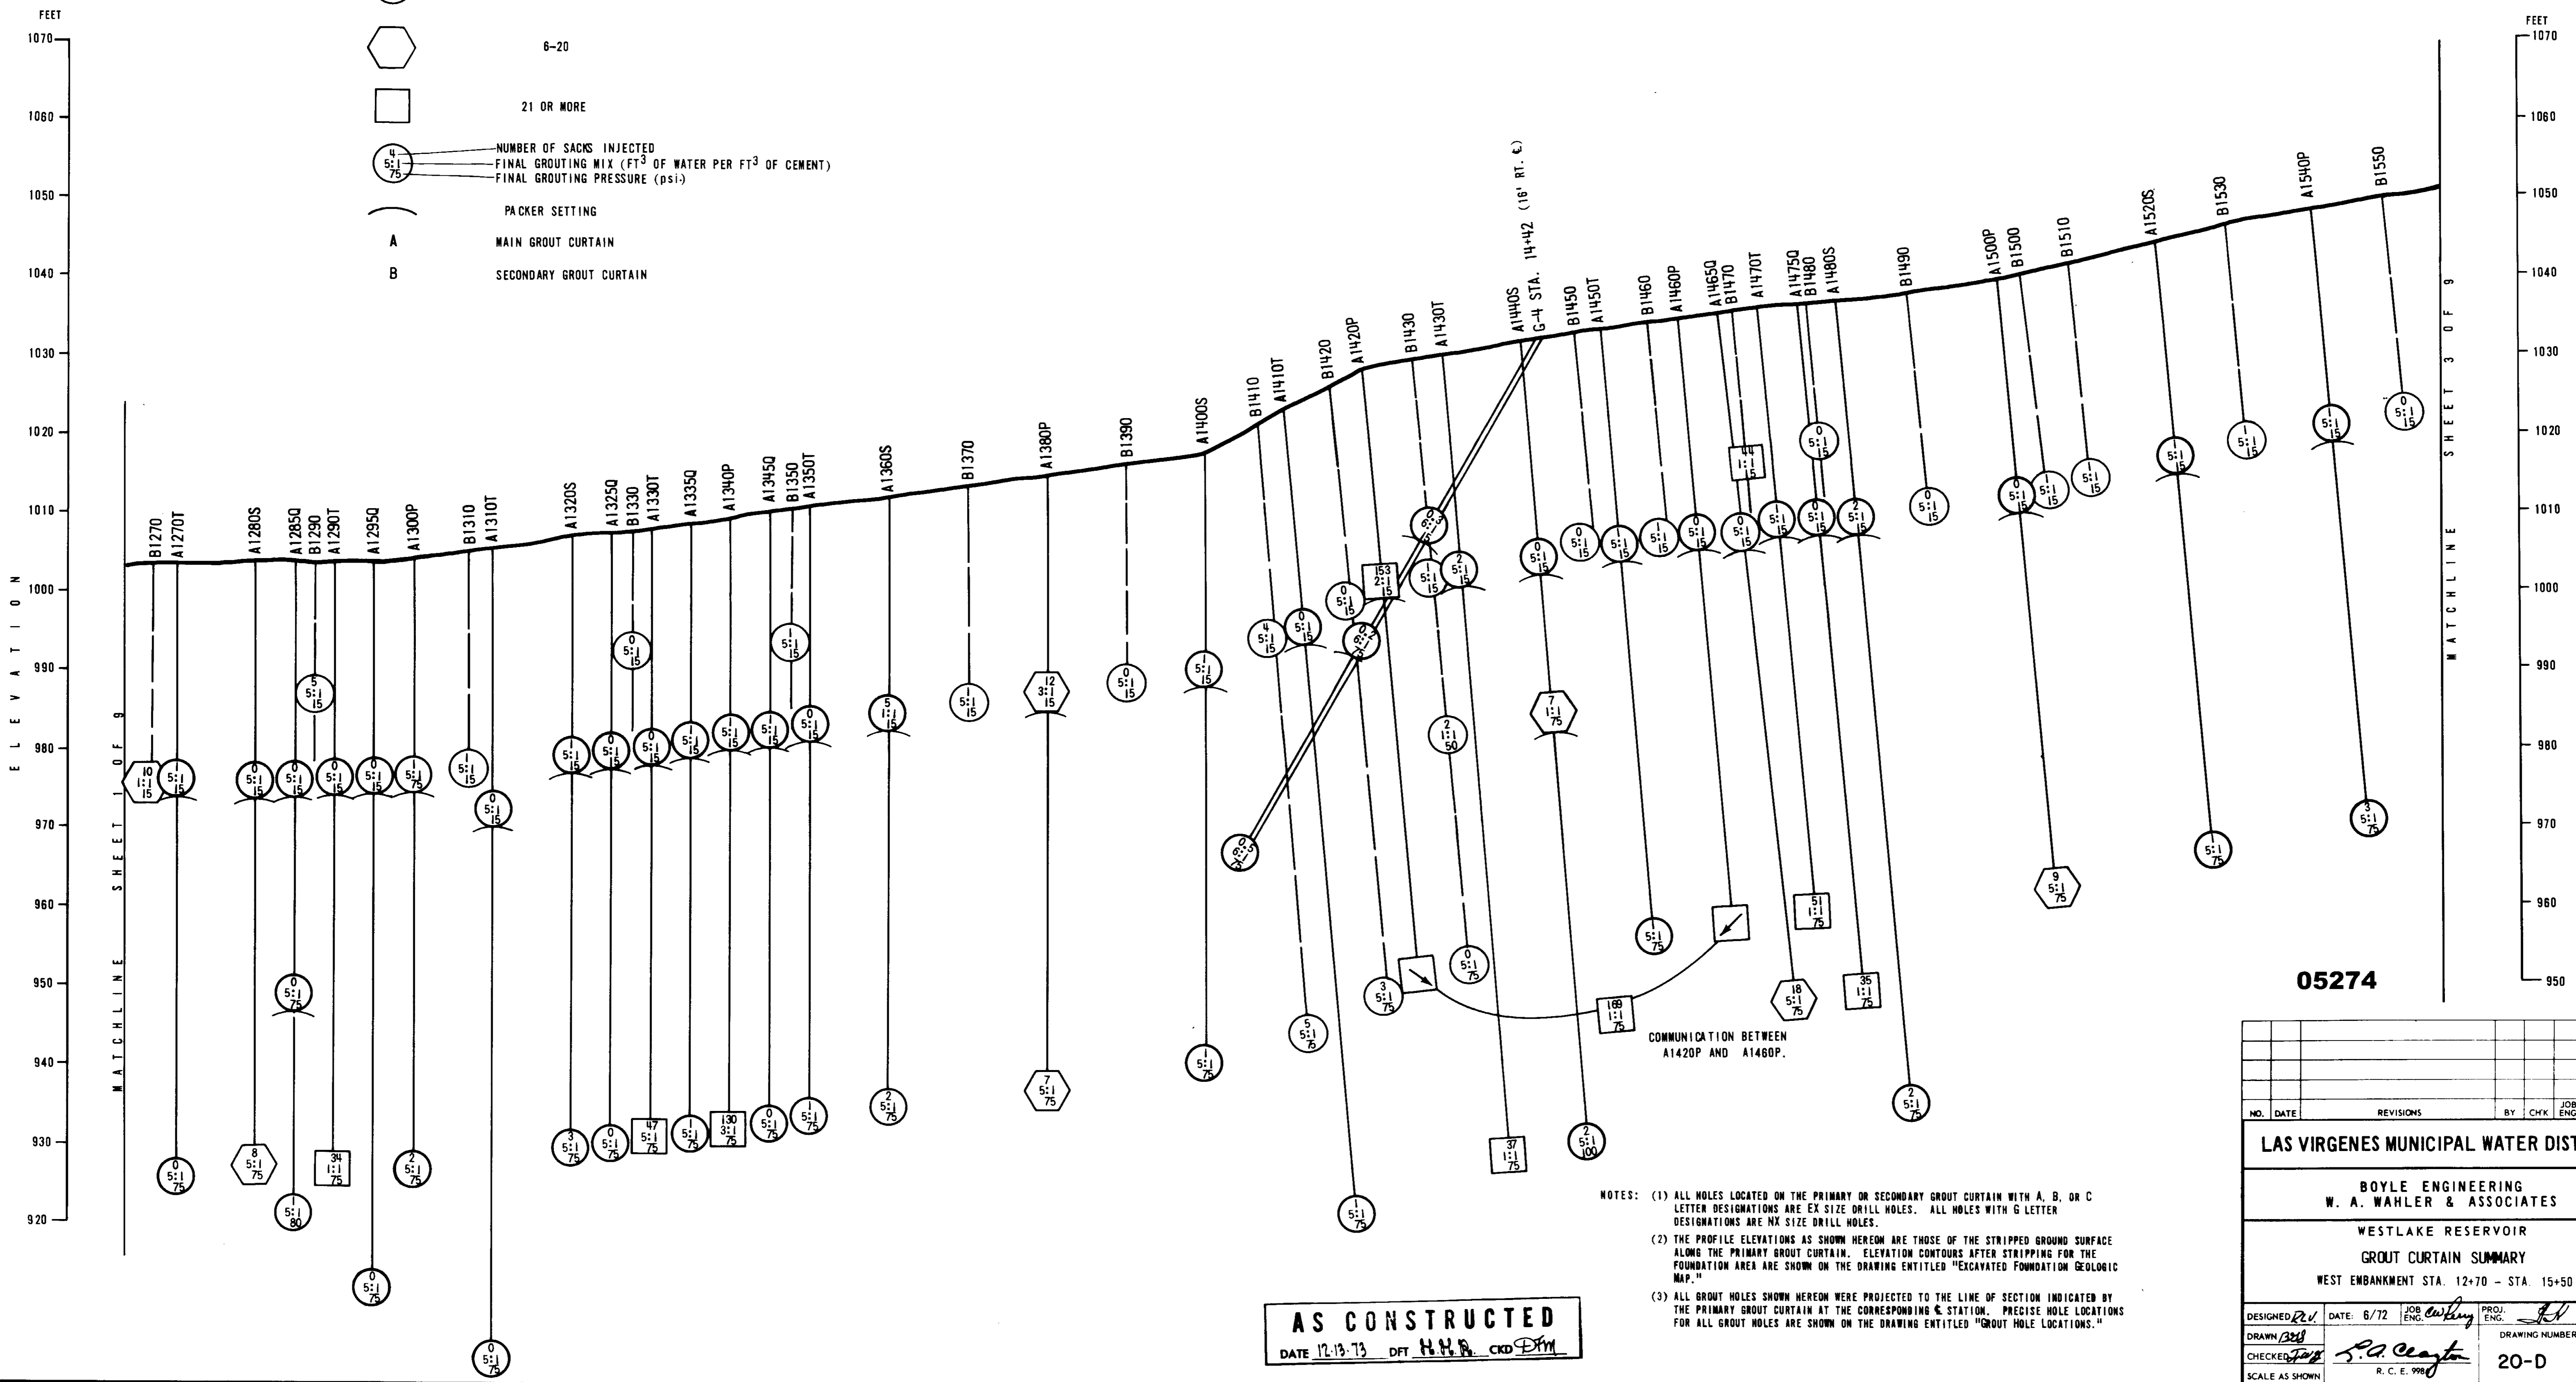

- NOTES:
- (1) ALL HOLES LOCATED ON THE PRIMARY OR SECONDARY GROUT CURTAIN WITH A, B, OR C LETTER DESIGNATIONS ARE EX SIZE DRILL HOLES. ALL HOLES WITH G LETTER DESIGNATIONS ARE NX SIZE DRILL HOLES.
  - (2) THE PROFILE ELEVATIONS AS SHOWN HEREON ARE THOSE OF THE STRIPPED GROUND SURFACE ALONG THE PRIMARY GROUT CURTAIN. ELEVATION CONTOURS AFTER STRIPPING FOR THE FOUNDATION AREA ARE SHOWN ON THE DRAWING ENTITLED "EXCAVATED FOUNDATION GEOLOGIC MAP."
  - (3) ALL GROUT HOLES SHOWN HEREON WERE PROJECTED TO THE LINE OF SECTION INDICATED BY THE PRIMARY GROUT CURTAIN AT THE CORRESPONDING STATION. PRECISE HOLE LOCATIONS FOR ALL GROUT HOLES ARE SHOWN ON THE DRAWING ENTITLED "GROUT HOLE LOCATIONS."


**AS CONSTRUCTED**  
 DATE 12-13-73 DFT H.W.B. CKD D.M.

NO.	DATE	REVISIONS	BY	CHK	JOB	PROJ.	MGR.
<b>LAS VIRGENES MUNICIPAL WATER DISTRICT</b>							
BOYLE ENGINEERING W. A. WAHLER & ASSOCIATES							
WESTLAKE RESERVOIR GROUT CURTAIN SUMMARY WEST EMBANKMENT STA. 12+70 - STA. 15+50							
DESIGNED	DATE: 6/72	JOB	PROJ.				
DRAWN	ENG.	ENG.	ENG.	DRAWING NUMBER	REV.		
CHECKED	R. C. E. 998		20-D				
SCALE AS SHOWN							

16+00

17+00

18+00

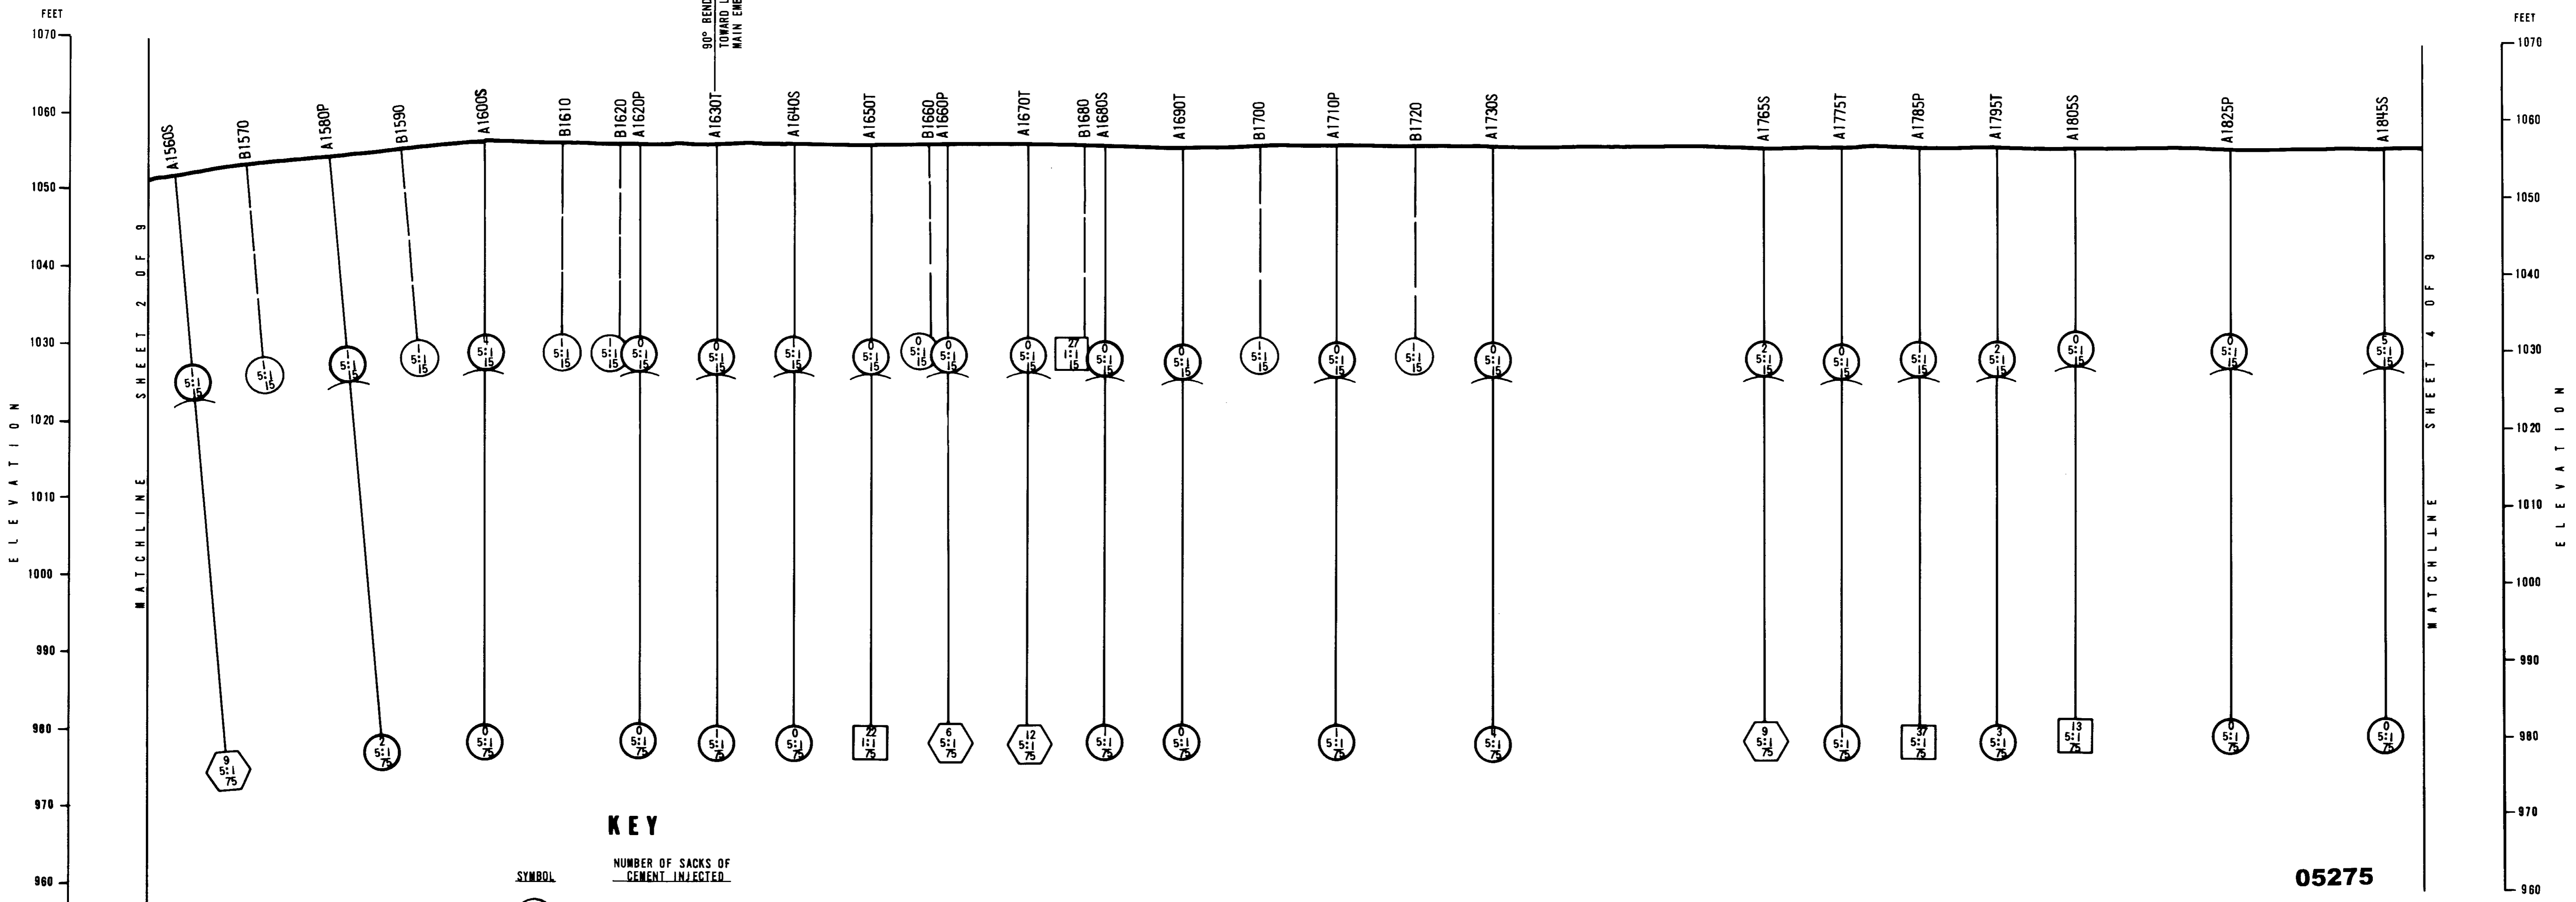

**KEY**

- SYMBOL**
- NUMBER OF SACKS OF CEMENT INJECTED: 0-5
  - ⬡ NUMBER OF SACKS INJECTED: 6-20
  - NUMBER OF SACKS INJECTED: 21 OR MORE
  - (with numbers) NUMBER OF SACKS INJECTED
  - (with numbers) FINAL GROUTING MIX (FT<sup>3</sup> OF WATER PER FT<sup>3</sup> OF CEMENT)
  - (with numbers) FINAL GROUTING PRESSURE (psi)
  - ( ) PACKER SETTING
  - A MAIN GROUT CURTAIN
  - B SECONDARY GROUT CURTAIN

- NOTES:**
- (1) ALL HOLES LOCATED ON THE PRIMARY OR SECONDARY GROUT CURTAIN WITH A, B, OR C LETTER DESIGNATIONS ARE EX SIZE DRILL HOLES. ALL HOLES WITH G LETTER DESIGNATIONS ARE NX SIZE DRILL HOLES.
  - (2) THE PROFILE ELEVATIONS AS SHOWN HEREON ARE THOSE OF THE STRIPPED GROUND SURFACE ALONG THE PRIMARY GROUT CURTAIN. ELEVATION CONTOURS AFTER STRIPPING FOR THE FOUNDATION AREA ARE SHOWN ON THE DRAWING ENTITLED "EXCAVATED FOUNDATION GEOLOGIC MAP."
  - (3) ALL GROUT HOLES SHOWN HEREON WERE PROJECTED TO THE LINE OF SECTION INDICATED BY THE PRIMARY GROUT CURTAIN AT THE CORRESPONDING C. STATION. PRECISE HOLE LOCATIONS FOR ALL GROUT HOLES ARE SHOWN ON THE DRAWING ENTITLED "GROUT HOLE LOCATIONS."

05275

**AS CONSTRUCTED**  
 DATE 11-19-73 DFT H.N.R. CKD D.F.M.

NO.	DATE	REVISIONS	BY	CHK	JOB ENG.	PROJ. ENG.	MGR.
<b>LAS VIRGENES MUNICIPAL WATER DISTRICT</b>							
<b>BOYLE ENGINEERING W. A. WAHLER &amp; ASSOCIATES</b>							
<b>WESTLAKE RESERVOIR GROUT CURTAIN SUMMARY</b>							
RESERVOIR RIM STA. 15+60 - STA. 18+45.							
DESIGNED	DATE: 6/72	JOB	PROJ.				
DRAWN		ENG.	ENG.	DRAWING NUMBER	REV.		
CHECKED				20-E			
SCALE AS SHOWN							

19+00

20+00

21+00

FEET

1070

1060

1050

FEET

1070

1060

1050

1040

1030

1020

1010

1000

990

980

970

960

950

MATCHLINE SHEET 3 OF 8

MATCHLINE SHEET 5 OF 8

KEY

SYMBOL	NUMBER OF SACKS OF CEMENT INJECTED
○	0-5
⬡	6-20
□	21 OR MORE
○ 4 5:1 75	NUMBER OF SACKS INJECTED FINAL GROUTING MIX (FT <sup>3</sup> OF WATER PER FT <sup>3</sup> OF CEMENT) FINAL GROUTING PRESSURE (psi)
—	PACKER SETTING
A	MAIN GROUT CURTAIN
B	SECONDARY GROUT CURTAIN

- NOTES:
- (1) ALL HOLES LOCATED ON THE PRIMARY OR SECONDARY GROUT CURTAIN WITH A, B, OR C LETTER DESIGNATIONS ARE EX SIZE DRILL HOLES. ALL HOLES WITH G LETTER DESIGNATIONS ARE NX SIZE DRILL HOLES.
  - (2) THE PROFILE ELEVATIONS AS SHOWN HEREON ARE THOSE OF THE STRIPPED GROUND SURFACE ALONG THE PRIMARY GROUT CURTAIN. ELEVATION CONTOURS AFTER STRIPPING FOR THE FOUNDATION AREA ARE SHOWN ON THE DRAWING ENTITLED "EXCAVATED FOUNDATION GEOLOGIC MAP."
  - (3) ALL GROUT HOLES SHOWN HEREON WERE PROJECTED TO THE LINE OF SECTION INDICATED BY THE PRIMARY GROUT CURTAIN AT THE CORRESPONDING E. STATION. PRECISE HOLE LOCATIONS FOR ALL GROUT HOLES ARE SHOWN ON THE DRAWING ENTITLED "GROUT HOLE LOCATIONS."

AS CONSTRUCTED  
DATE 12-19-73 DPT H.H.R. AND D.F.M.

05276

LAS VIRGENES MUNICIPAL WATER DISTRICT

BOYLE ENGINEERING  
W. A. WAHLER & ASSOCIATES


WESTLAKE RESERVOIR

GROUT CURTAIN SUMMARY  
MAIN EMBANKMENT STA. 18+85 - STA. 21+50

DESIGNED: <i>REV</i>	DATE: 6/72	JOB: <i>W. A. Wahler</i>	PROJ. ENG.:
DRAWN: <i>REV</i>	CHECKED: <i>REV</i>	SCALE AS SHOWN	R. C. E. 1986
DRAWING NUMBER			REV.
20-F			

ELEVATION  
1000  
990  
980  
ELEVATION  
1000  
990  
980  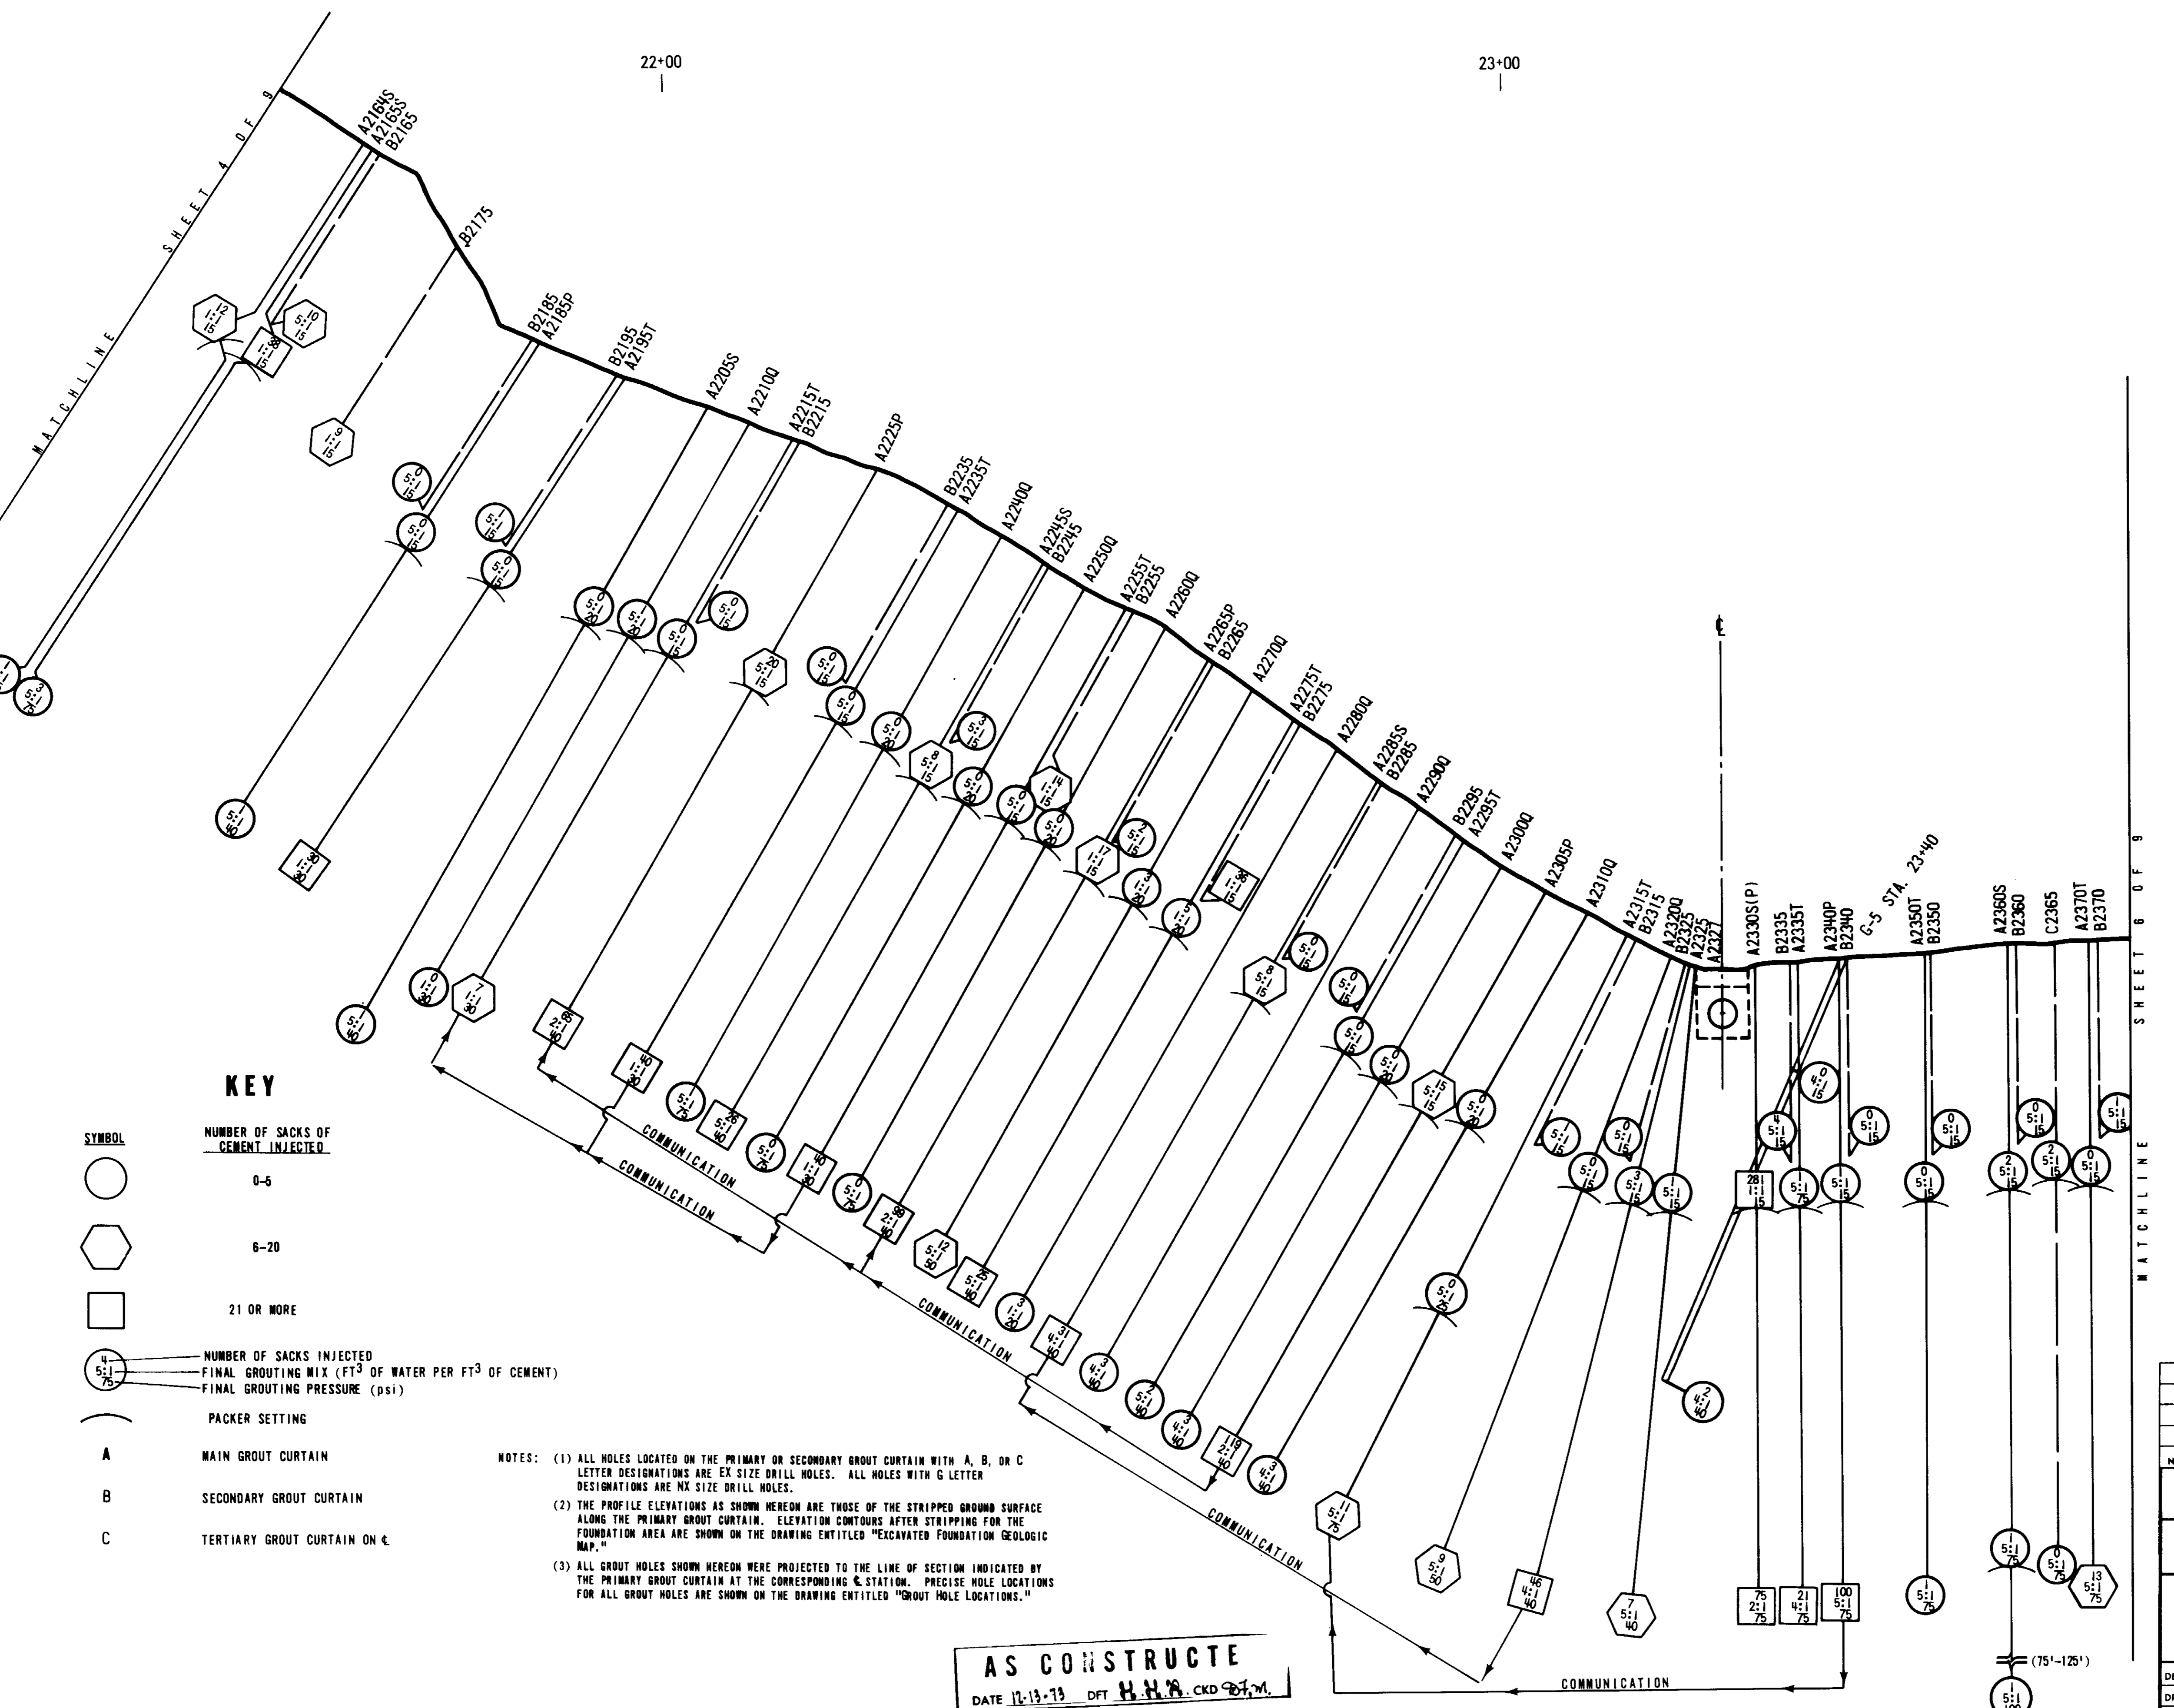
**KEY**

**SYMBOL**

- 0-5
- ⬡ 6-20
- 21 OR MORE
- with numbers: NUMBER OF SACKS INJECTED, FINAL GROUTING MIX (FT<sup>3</sup> OF WATER PER FT<sup>3</sup> OF CEMENT), FINAL GROUTING PRESSURE (psi)
- ( ) PACKER SETTING

**A** MAIN GROUT CURTAIN  
**B** SECONDARY GROUT CURTAIN  
**C** TERTIARY GROUT CURTAIN

**NOTES:**

- (1) ALL HOLES LOCATED ON THE PRIMARY OR SECONDARY GROUT CURTAIN WITH A, B, OR C LETTER DESIGNATIONS ARE EX SIZE DRILL HOLES. ALL HOLES WITH G LETTER DESIGNATIONS ARE NX SIZE DRILL HOLES.
- (2) THE PROFILE ELEVATIONS AS SHOWN HEREON ARE THOSE OF THE STRIPPED GROUND SURFACE ALONG THE PRIMARY GROUT CURTAIN. ELEVATION CONTOURS AFTER STRIPPING FOR THE FOUNDATION AREA ARE SHOWN ON THE DRAWING ENTITLED "EXCAVATED FOUNDATION GEOLOGIC MAP."
- (3) ALL GROUT HOLES SHOWN HEREON WERE PROJECTED TO THE LINE OF SECTION INDICATED BY THE PRIMARY GROUT CURTAIN AT THE CORRESPONDING STATION. PRECISE HOLE LOCATIONS FOR ALL GROUT HOLES ARE SHOWN ON THE DRAWING ENTITLED "GROUT HOLE LOCATIONS."

**AS CONSTRUCTE**  
DATE 11-13-79 DFT H.H.A. CKD J.F.M.

05277

NO.	DATE	REVISIONS	BY	CHK	JOB ENG.	PROJ. ENG.	MGR.

**LAS VIRGENES MUNICIPAL WATER DISTRICT**

**BOYLE ENGINEERING  
W. A. WAHLER & ASSOCIATES**

**WESTLAKE RESERVOIR**

**GROUT CURTAIN SUMMARY**


MAIN EMBANKMENT STA. 21+64 - STA. 23+70

DESIGNED: *[Signature]* DATE: 8/72 JOB ENG.: *[Signature]* PROJ. ENG.: *[Signature]*

DRAWN: *[Signature]* CHECKED: *[Signature]* SCALE AS SHOWN

DRAWING NUMBER: **20-G** REV.:

R. C. E. 9986

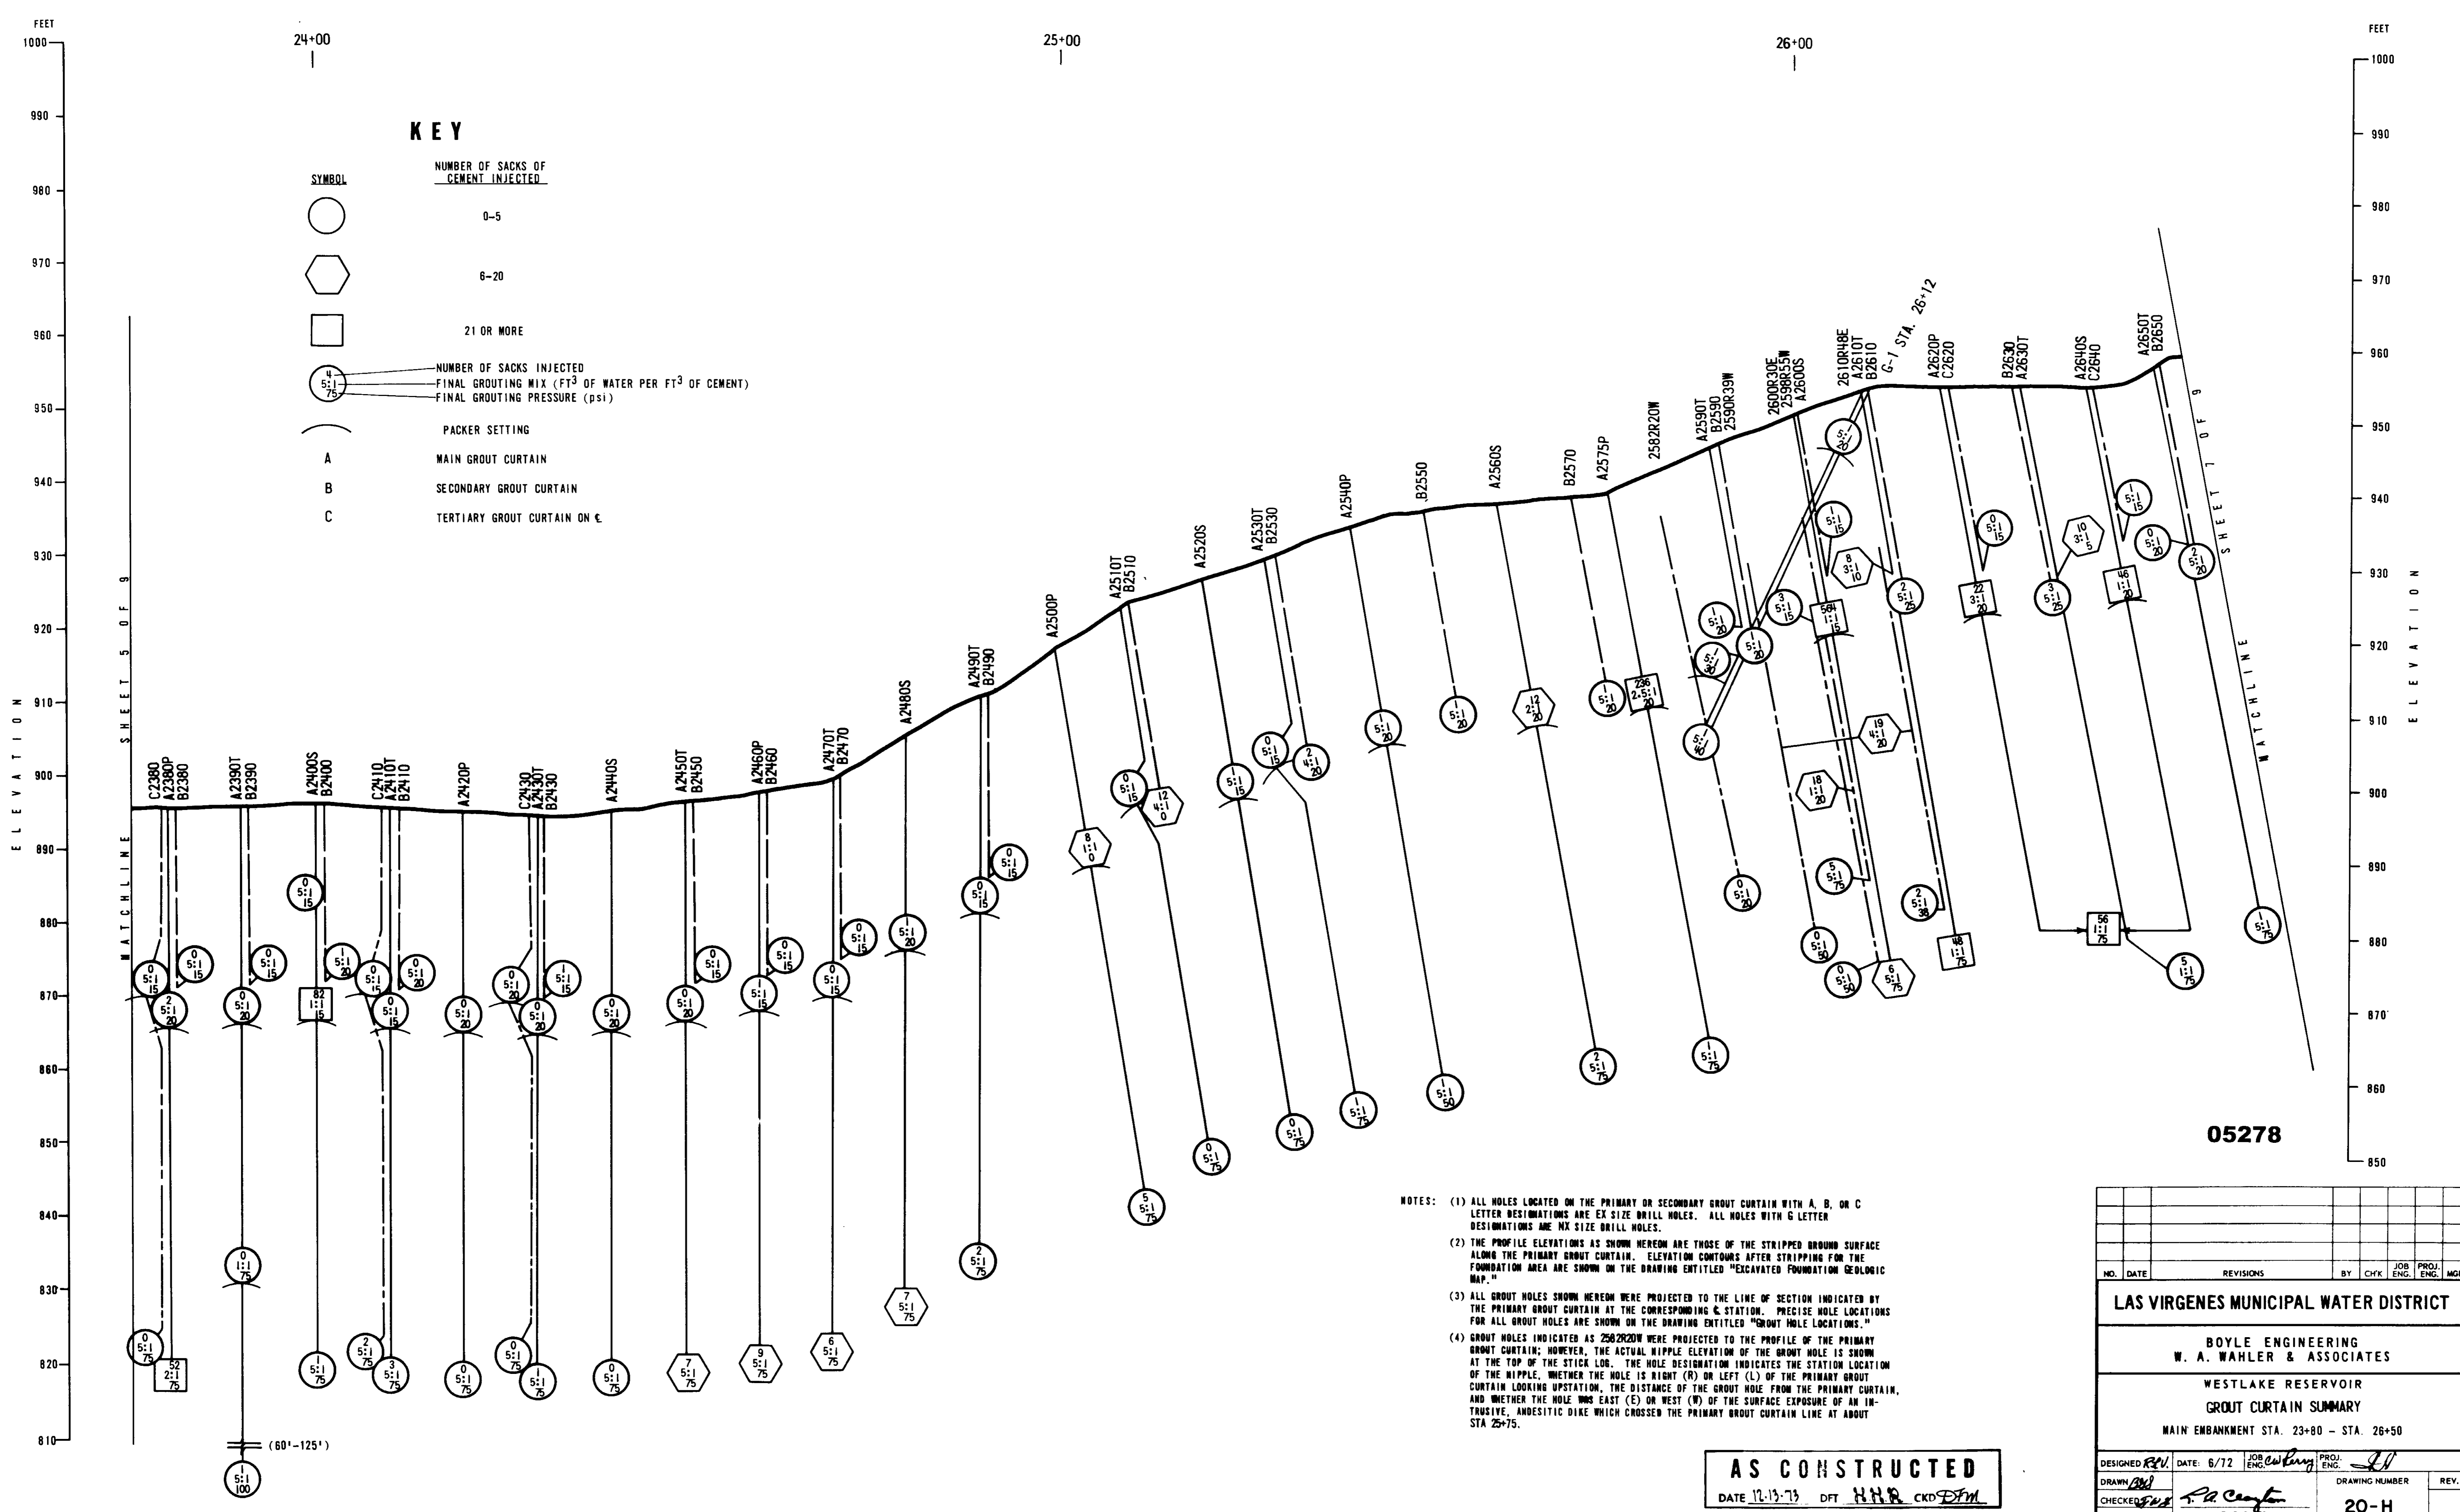


**KEY**

- SYMBOL**
- 0-5
  - ⬡ 6-20
  - 21 OR MORE
  - ⊙ (4/5:1/75) NUMBER OF SACKS INJECTED  
FINAL GROUTING MIX (FT<sup>3</sup> OF WATER PER FT<sup>3</sup> OF CEMENT)  
FINAL GROUTING PRESSURE (psi)
  - ( ) PACKER SETTING
  - A MAIN GROUT CURTAIN
  - B SECONDARY GROUT CURTAIN
  - C TERTIARY GROUT CURTAIN ON E

- NOTES:**
- (1) ALL HOLES LOCATED ON THE PRIMARY OR SECONDARY GROUT CURTAIN WITH A, B, OR C LETTER DESIGNATIONS ARE EX SIZE DRILL HOLES. ALL HOLES WITH G LETTER DESIGNATIONS ARE NX SIZE DRILL HOLES.
  - (2) THE PROFILE ELEVATIONS AS SHOWN HEREON ARE THOSE OF THE STRIPPED GROUND SURFACE ALONG THE PRIMARY GROUT CURTAIN. ELEVATION CONTOURS AFTER STRIPPING FOR THE FOUNDATION AREA ARE SHOWN ON THE DRAWING ENTITLED "EXCAVATED FOUNDATION GEOLOGIC MAP."
  - (3) ALL GROUT HOLES SHOWN HEREON WERE PROJECTED TO THE LINE OF SECTION INDICATED BY THE PRIMARY GROUT CURTAIN AT THE CORRESPONDING STATION. PRECISE HOLE LOCATIONS FOR ALL GROUT HOLES ARE SHOWN ON THE DRAWING ENTITLED "GROUT HOLE LOCATIONS."
  - (4) GROUT HOLES INDICATED AS 2582R20W WERE PROJECTED TO THE PROFILE OF THE PRIMARY GROUT CURTAIN; HOWEVER, THE ACTUAL HOLE ELEVATION OF THE GROUT HOLE IS SHOWN AT THE TOP OF THE STICK LOG. THE HOLE DESIGNATION INDICATES THE STATION LOCATION OF THE HIPPLE. WHETHER THE HOLE IS RIGHT (R) OR LEFT (L) OF THE PRIMARY GROUT CURTAIN LOOKING UPSTATION. THE DISTANCE OF THE GROUT HOLE FROM THE PRIMARY CURTAIN, AND WHETHER THE HOLE WAS EAST (E) OR WEST (W) OF THE SURFACE EXPOSURE OF AN INTRUSIVE, ANDESITIC DIKE WHICH CROSSED THE PRIMARY GROUT CURTAIN LINE AT ABOUT STA 25+75.

**AS CONSTRUCTED**  
DATE 12-13-73 DFT H.N.R. CKD D.M.

NO. DATE REVISIONS BY CHK'G JOB PROJ. ENGR. MGR.			
<b>LAS VIRGENES MUNICIPAL WATER DISTRICT</b>			
BOYLE ENGINEERING W. A. WAHLER & ASSOCIATES			
WESTLAKE RESERVOIR GROUT CURTAIN SUMMARY MAIN EMBANKMENT STA. 23+80 - STA. 26+50			
DESIGNED <i>REV</i>	DATE: 6/72	JOB ENGR. <i>ew</i>	PROJ. ENGR. <i>JD</i>
DRAWN <i>BD</i>	CHECKED <i>R.C.E.</i>		DRAWING NUMBER
SCALE AS SHOWN			<b>20-H</b>

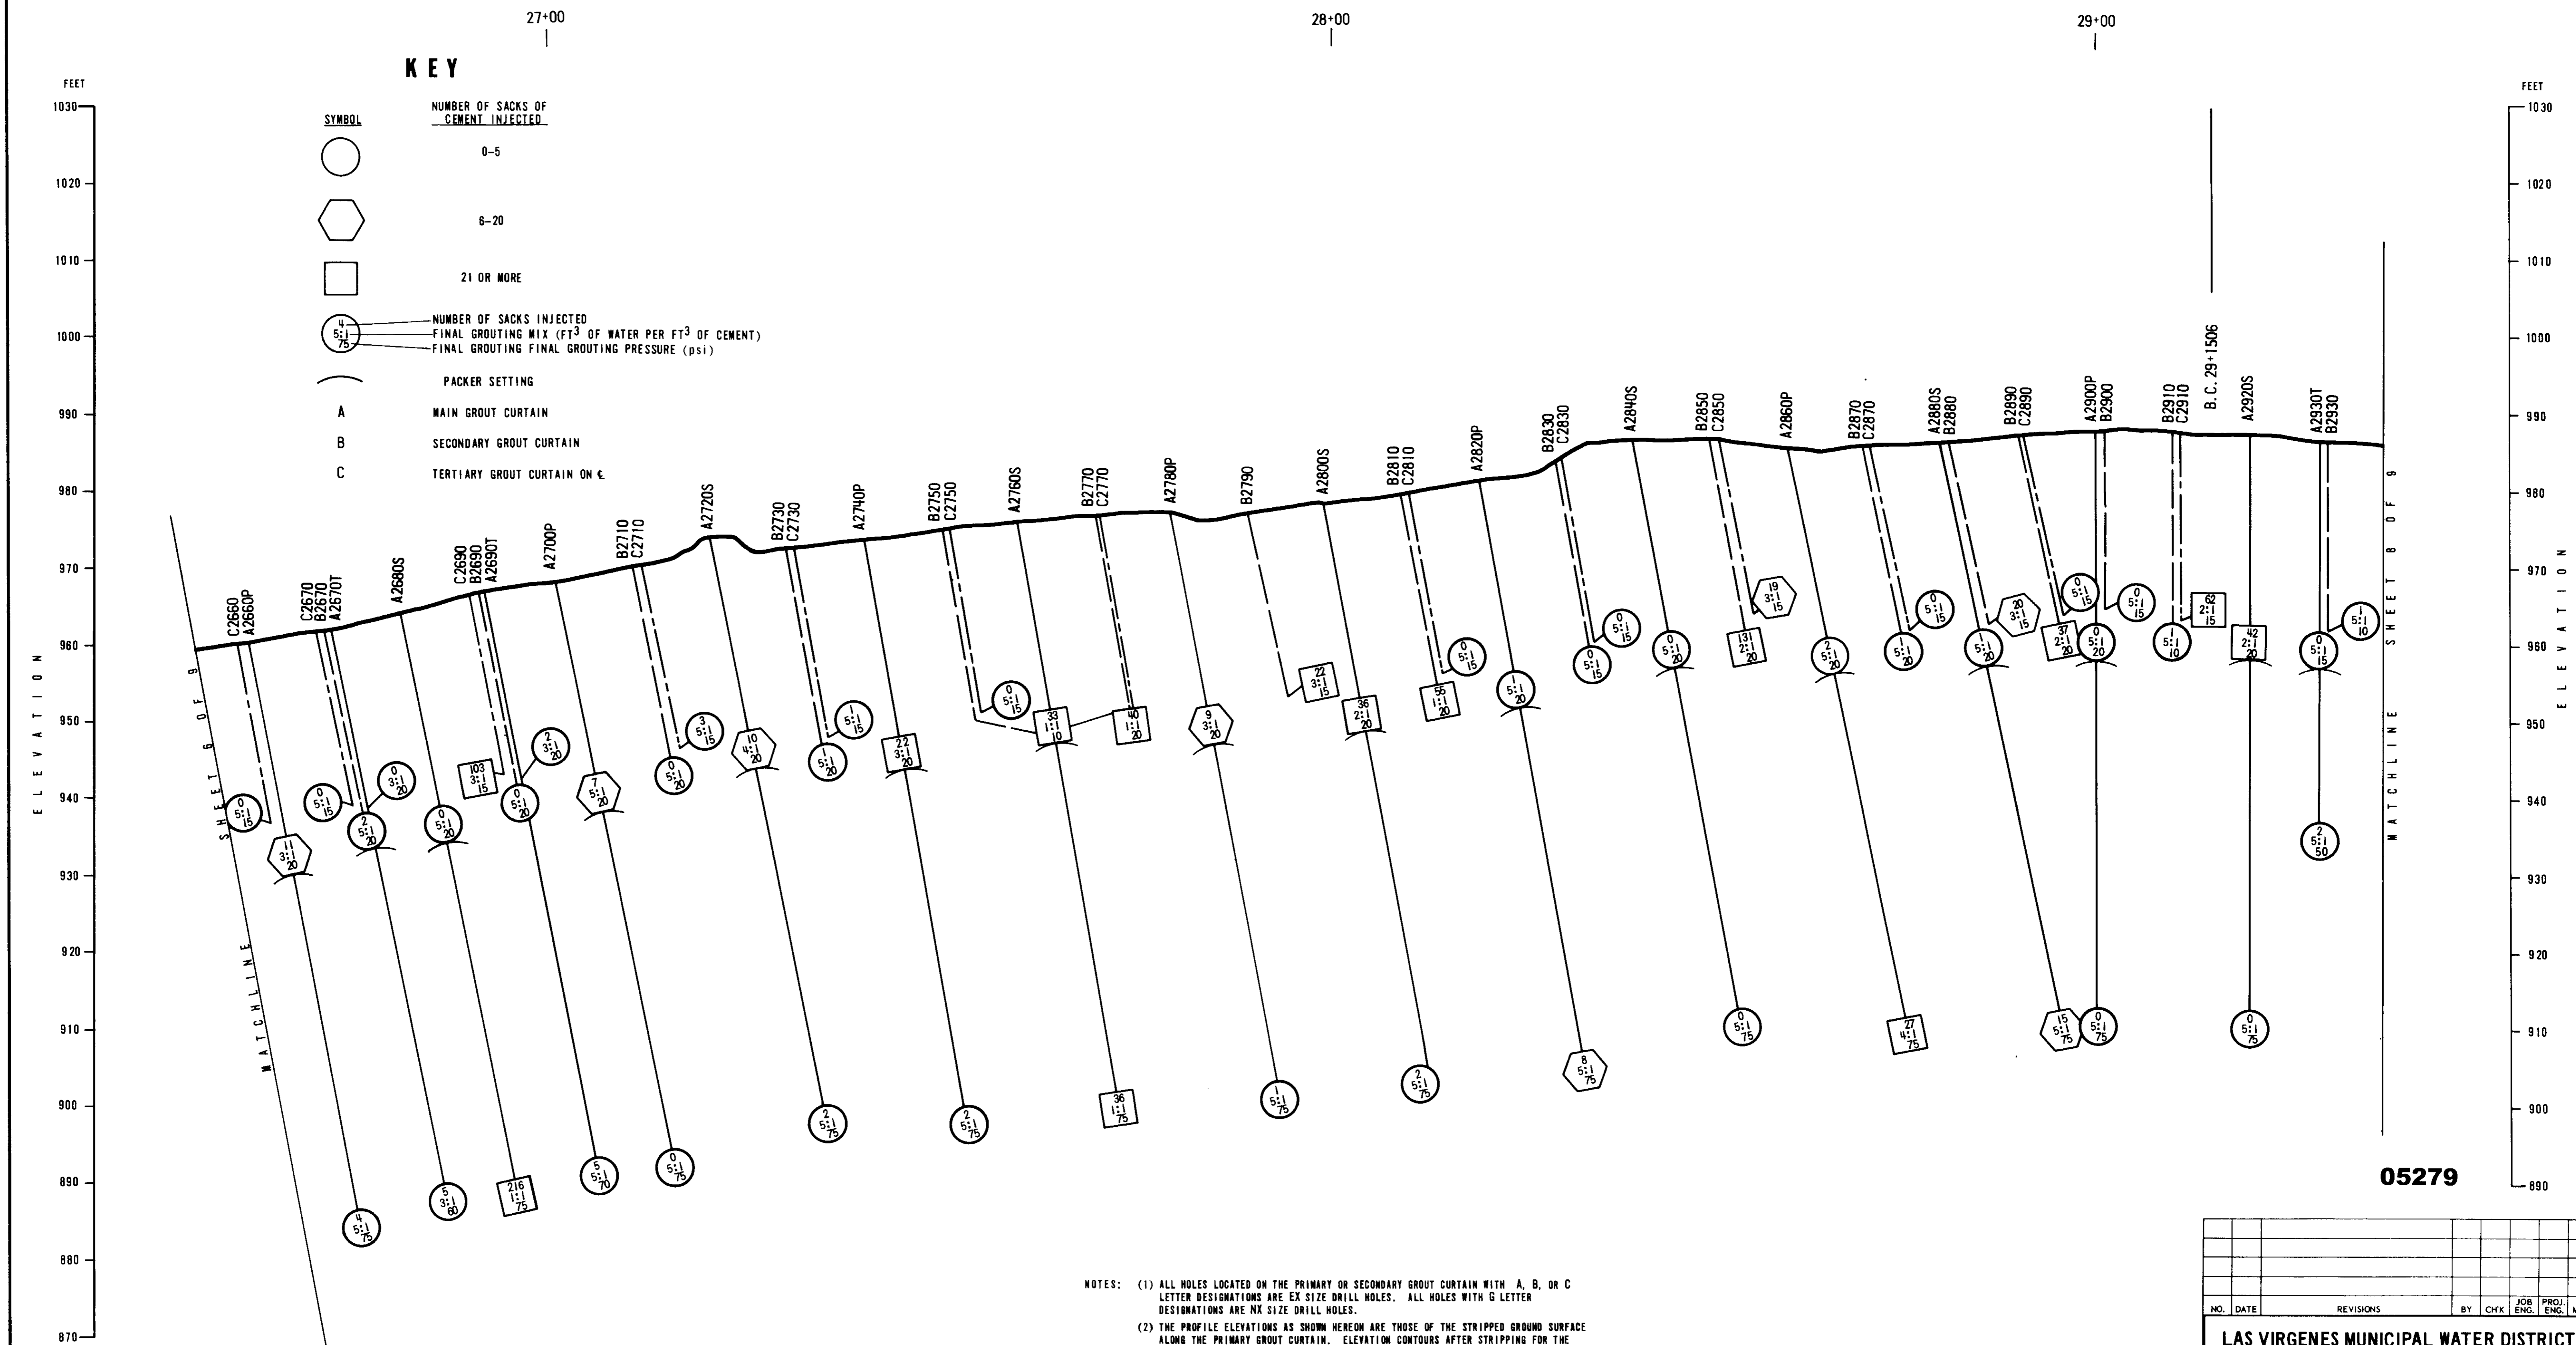

**KEY**

- |                     |                                                                                                                                                         |
|---------------------|---------------------------------------------------------------------------------------------------------------------------------------------------------|
| <b>SYMBOL</b>       | <b>NUMBER OF SACKS OF CEMENT INJECTED</b>                                                                                                               |
| ○                   | 0-5                                                                                                                                                     |
| ⬡                   | 6-20                                                                                                                                                    |
| □                   | 21 OR MORE                                                                                                                                              |
| ○<br>4<br>5:1<br>75 | NUMBER OF SACKS INJECTED<br>FINAL GROUTING MIX (FT <sup>3</sup> OF WATER PER FT <sup>3</sup> OF CEMENT)<br>FINAL GROUTING FINAL GROUTING PRESSURE (psi) |
| (                   | PACKER SETTING                                                                                                                                          |
| A                   | MAIN GROUT CURTAIN                                                                                                                                      |
| B                   | SECONDARY GROUT CURTAIN                                                                                                                                 |
| C                   | TERTIARY GROUT CURTAIN ON C                                                                                                                             |

- NOTES: (1) ALL HOLES LOCATED ON THE PRIMARY OR SECONDARY GROUT CURTAIN WITH A, B, OR C LETTER DESIGNATIONS ARE EX SIZE DRILL HOLES. ALL HOLES WITH G LETTER DESIGNATIONS ARE NX SIZE DRILL HOLES.
- (2) THE PROFILE ELEVATIONS AS SHOWN HEREON ARE THOSE OF THE STRIPPED GROUND SURFACE ALONG THE PRIMARY GROUT CURTAIN. ELEVATION CONTOURS AFTER STRIPPING FOR THE FOUNDATION AREA ARE SHOWN ON THE DRAWING ENTITLED "EXCAVATED FOUNDATION GEOLOGIC MAP."
- (3) ALL GROUT HOLES SHOWN HEREON WERE PROJECTED TO THE LINE OF SECTION INDICATED BY THE PRIMARY GROUT CURTAIN AT THE CORRESPONDING STATION. PRECISE HOLE LOCATIONS FOR ALL GROUT HOLES ARE SHOWN ON THE DRAWING ENTITLED "GROUT HOLE LOCATIONS."


05279

**AS CONSTRUCTED**  
DATE 12-13-73 DFT H.H.A. CKD D.H.

NO.	DATE	REVISIONS	BY	CHK	JOB ENG.	PROJ. ENG.	MGR.
<b>LAS VIRGENES MUNICIPAL WATER DISTRICT</b>							
BOYLE ENGINEERING W. A. WAHLER & ASSOCIATES							
WESTLAKE RESERVOIR							
GROUT CURTAIN SUMMARY MAIN EMBANKMENT STA. 26+60 - STA. 29+30							
DESIGNED	DATE: 6/72	JOB ENG.	PROJ. ENG.				
DRAWN	BY	BY	BY				
CHECKED	BY	BY	BY				
SCALE AS SHOWN	R. C. E. 1986	DRAWING NUMBER		REV.			
			20 - I				





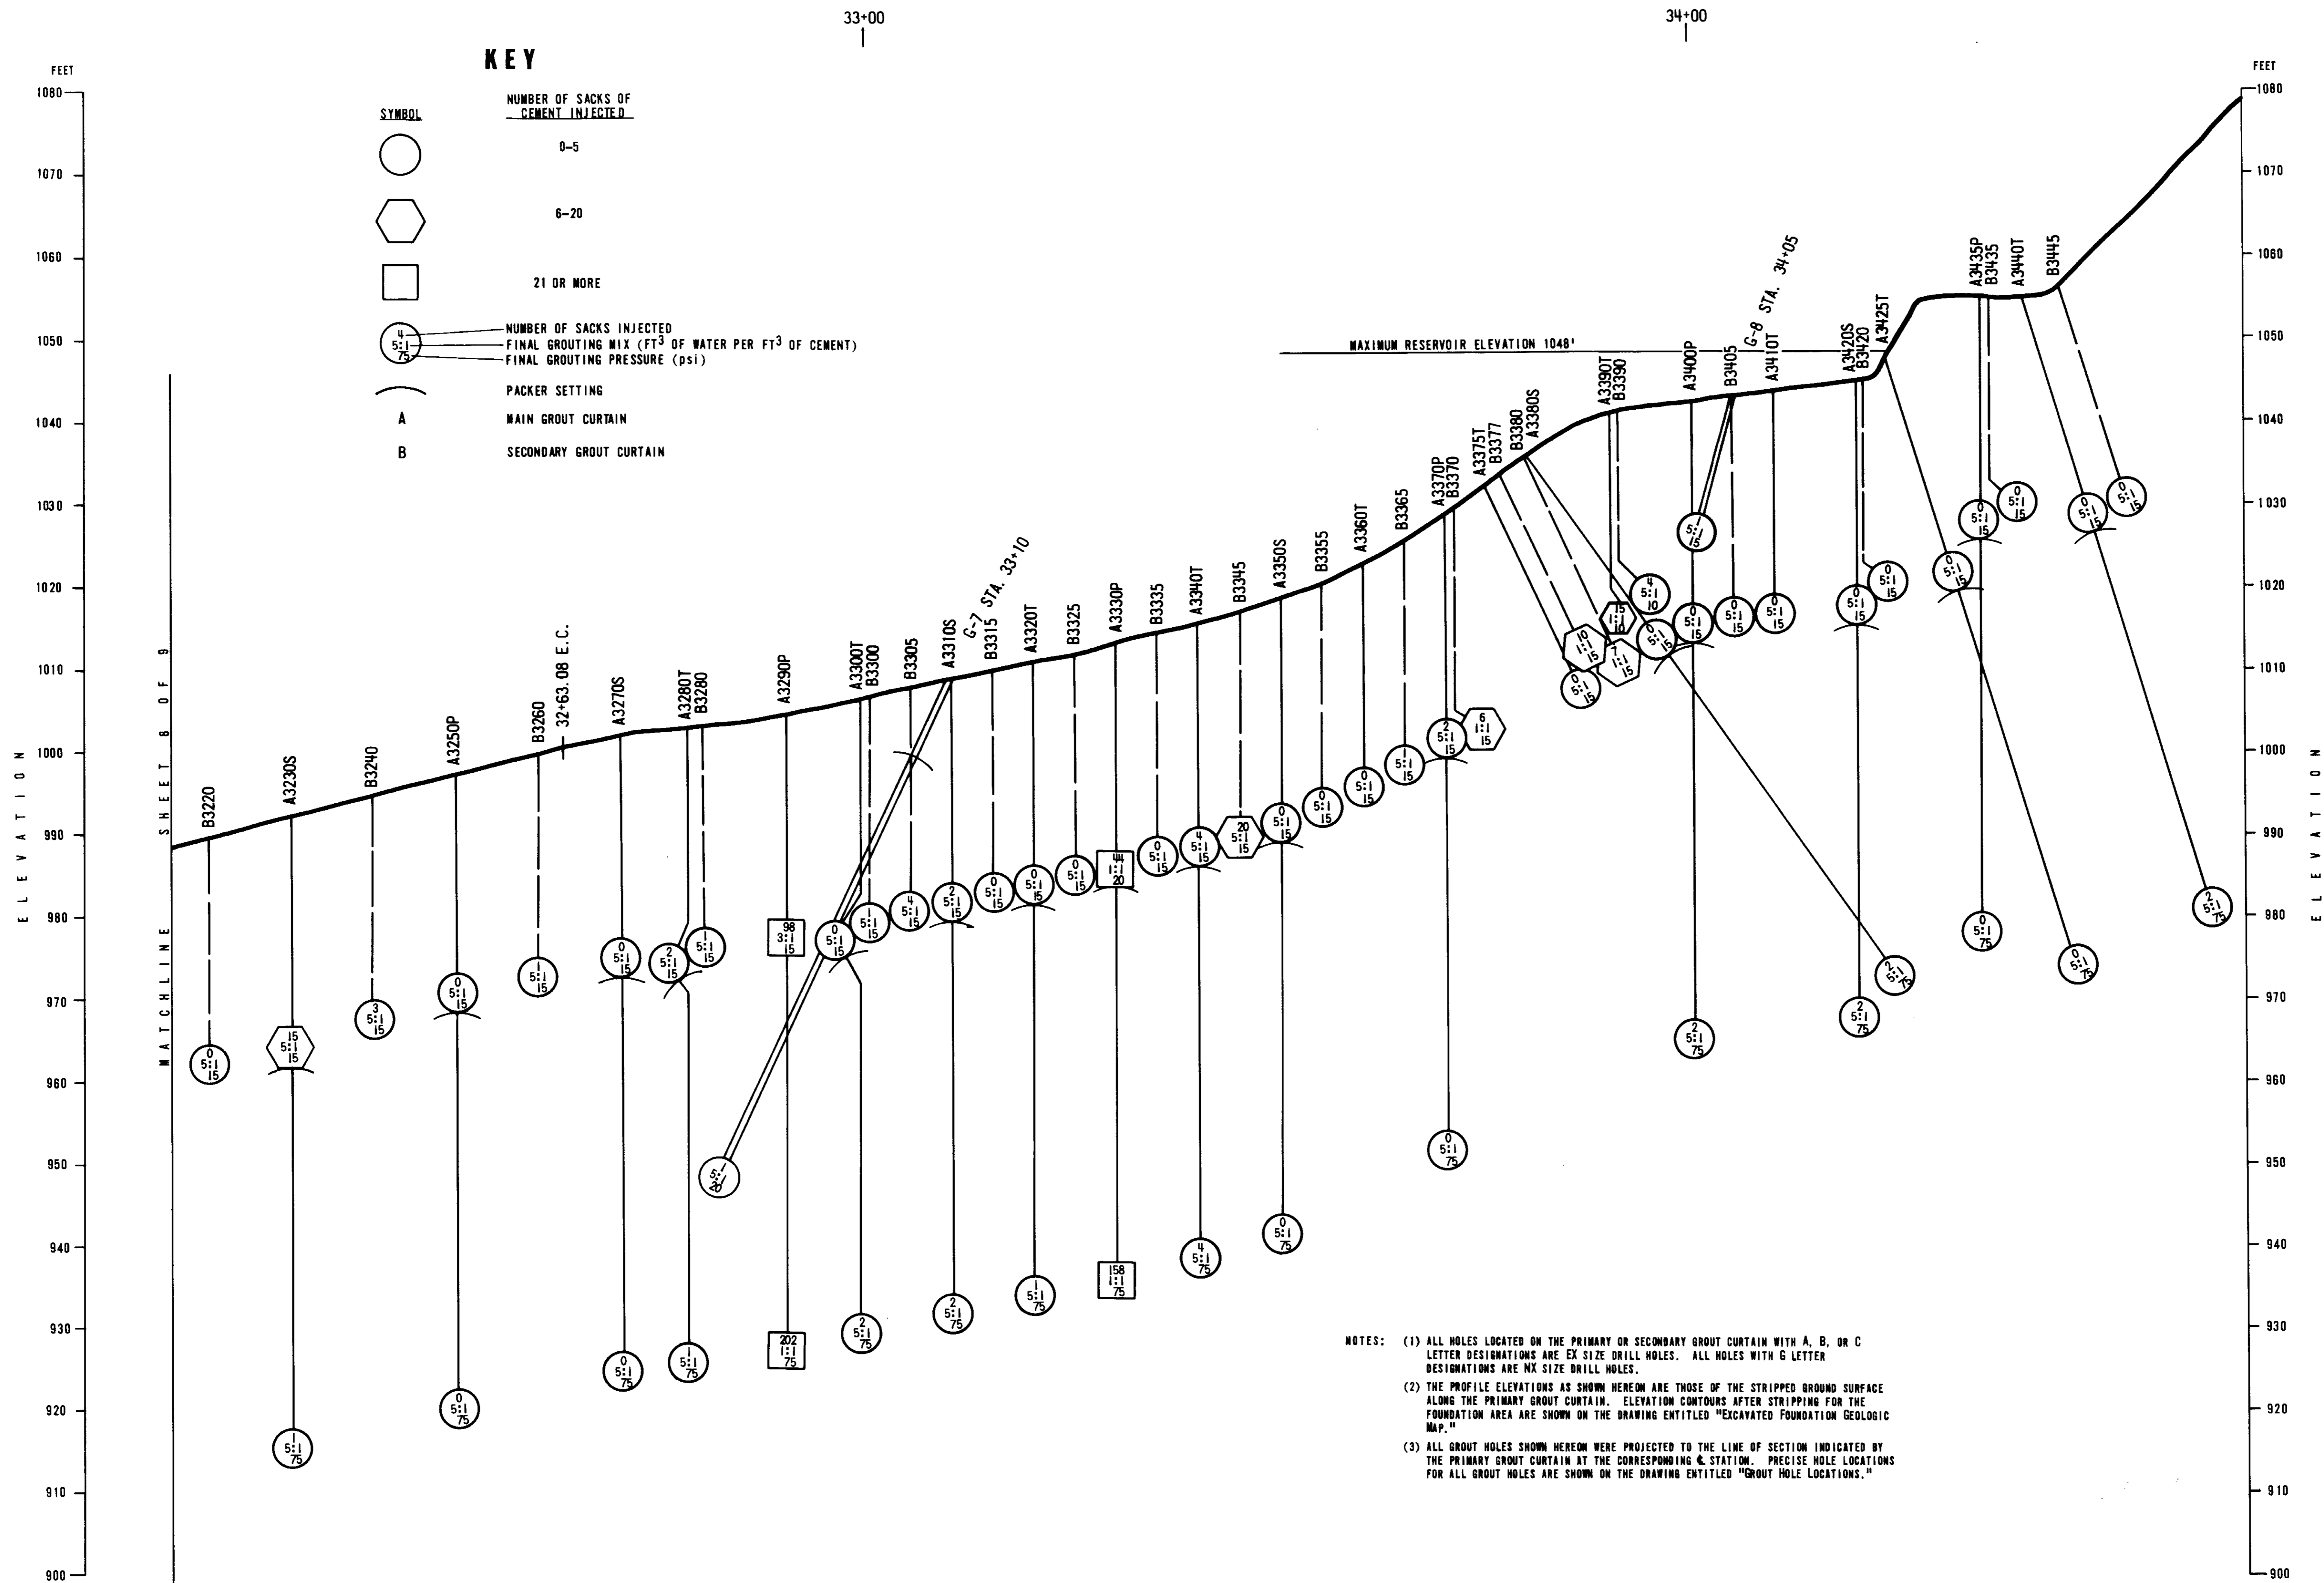

**KEY**

SYMBOL	NUMBER OF SACKS OF CEMENT INJECTED
○	0-5
⬡	6-20
□	21 OR MORE

○ NUMBER OF SACKS INJECTED  
 5:1 FINAL GROUTING MIX (FT<sup>3</sup> OF WATER PER FT<sup>3</sup> OF CEMENT)  
 75 FINAL GROUTING PRESSURE (psi)

( ) PACKER SETTING

A MAIN GROUT CURTAIN  
 B SECONDARY GROUT CURTAIN

NOTES: (1) ALL HOLES LOCATED ON THE PRIMARY OR SECONDARY GROUT CURTAIN WITH A, B, OR C LETTER DESIGNATIONS ARE EX SIZE DRILL HOLES. ALL HOLES WITH G LETTER DESIGNATIONS ARE NX SIZE DRILL HOLES.


(2) THE PROFILE ELEVATIONS AS SHOWN HEREON ARE THOSE OF THE STRIPPED GROUND SURFACE ALONG THE PRIMARY GROUT CURTAIN. ELEVATION CONTOURS AFTER STRIPPING FOR THE FOUNDATION AREA ARE SHOWN ON THE DRAWING ENTITLED "EXCAVATED FOUNDATION GEOLOGIC MAP."

(3) ALL GROUT HOLES SHOWN HEREON WERE PROJECTED TO THE LINE OF SECTION INDICATED BY THE PRIMARY GROUT CURTAIN AT THE CORRESPONDING STATION. PRECISE HOLE LOCATIONS FOR ALL GROUT HOLES ARE SHOWN ON THE DRAWING ENTITLED "GROUT HOLE LOCATIONS."

05281


**AS CONSTRUCTED**  
 DATE 12-13-73 DFT H.H.R. CRO BFM

NO.	DATE	REVISIONS	BY	CHK	JOB ENG.	PROJ. ENG.	MGR.
<b>LAS VIRGENES MUNICIPAL WATER DISTRICT</b>							
BOYLE ENGINEERING W. A. WAHLER & ASSOCIATES							
WESTLAKE RESERVOIR GROUT CURTAIN SUMMARY MAIN EMBANKMENT STA. 32+20 - STA 34+45							
DESIGNED	DATE	JOB ENG.	PROJ. ENG.				
DRAWN	12/13/73	H.H.R.	CRO				
CHECKED	R.A. Cantor		N. C. E. 1968				
SCALE AS SHOWN					DRAWING NUMBER	REV.	
					20-K		

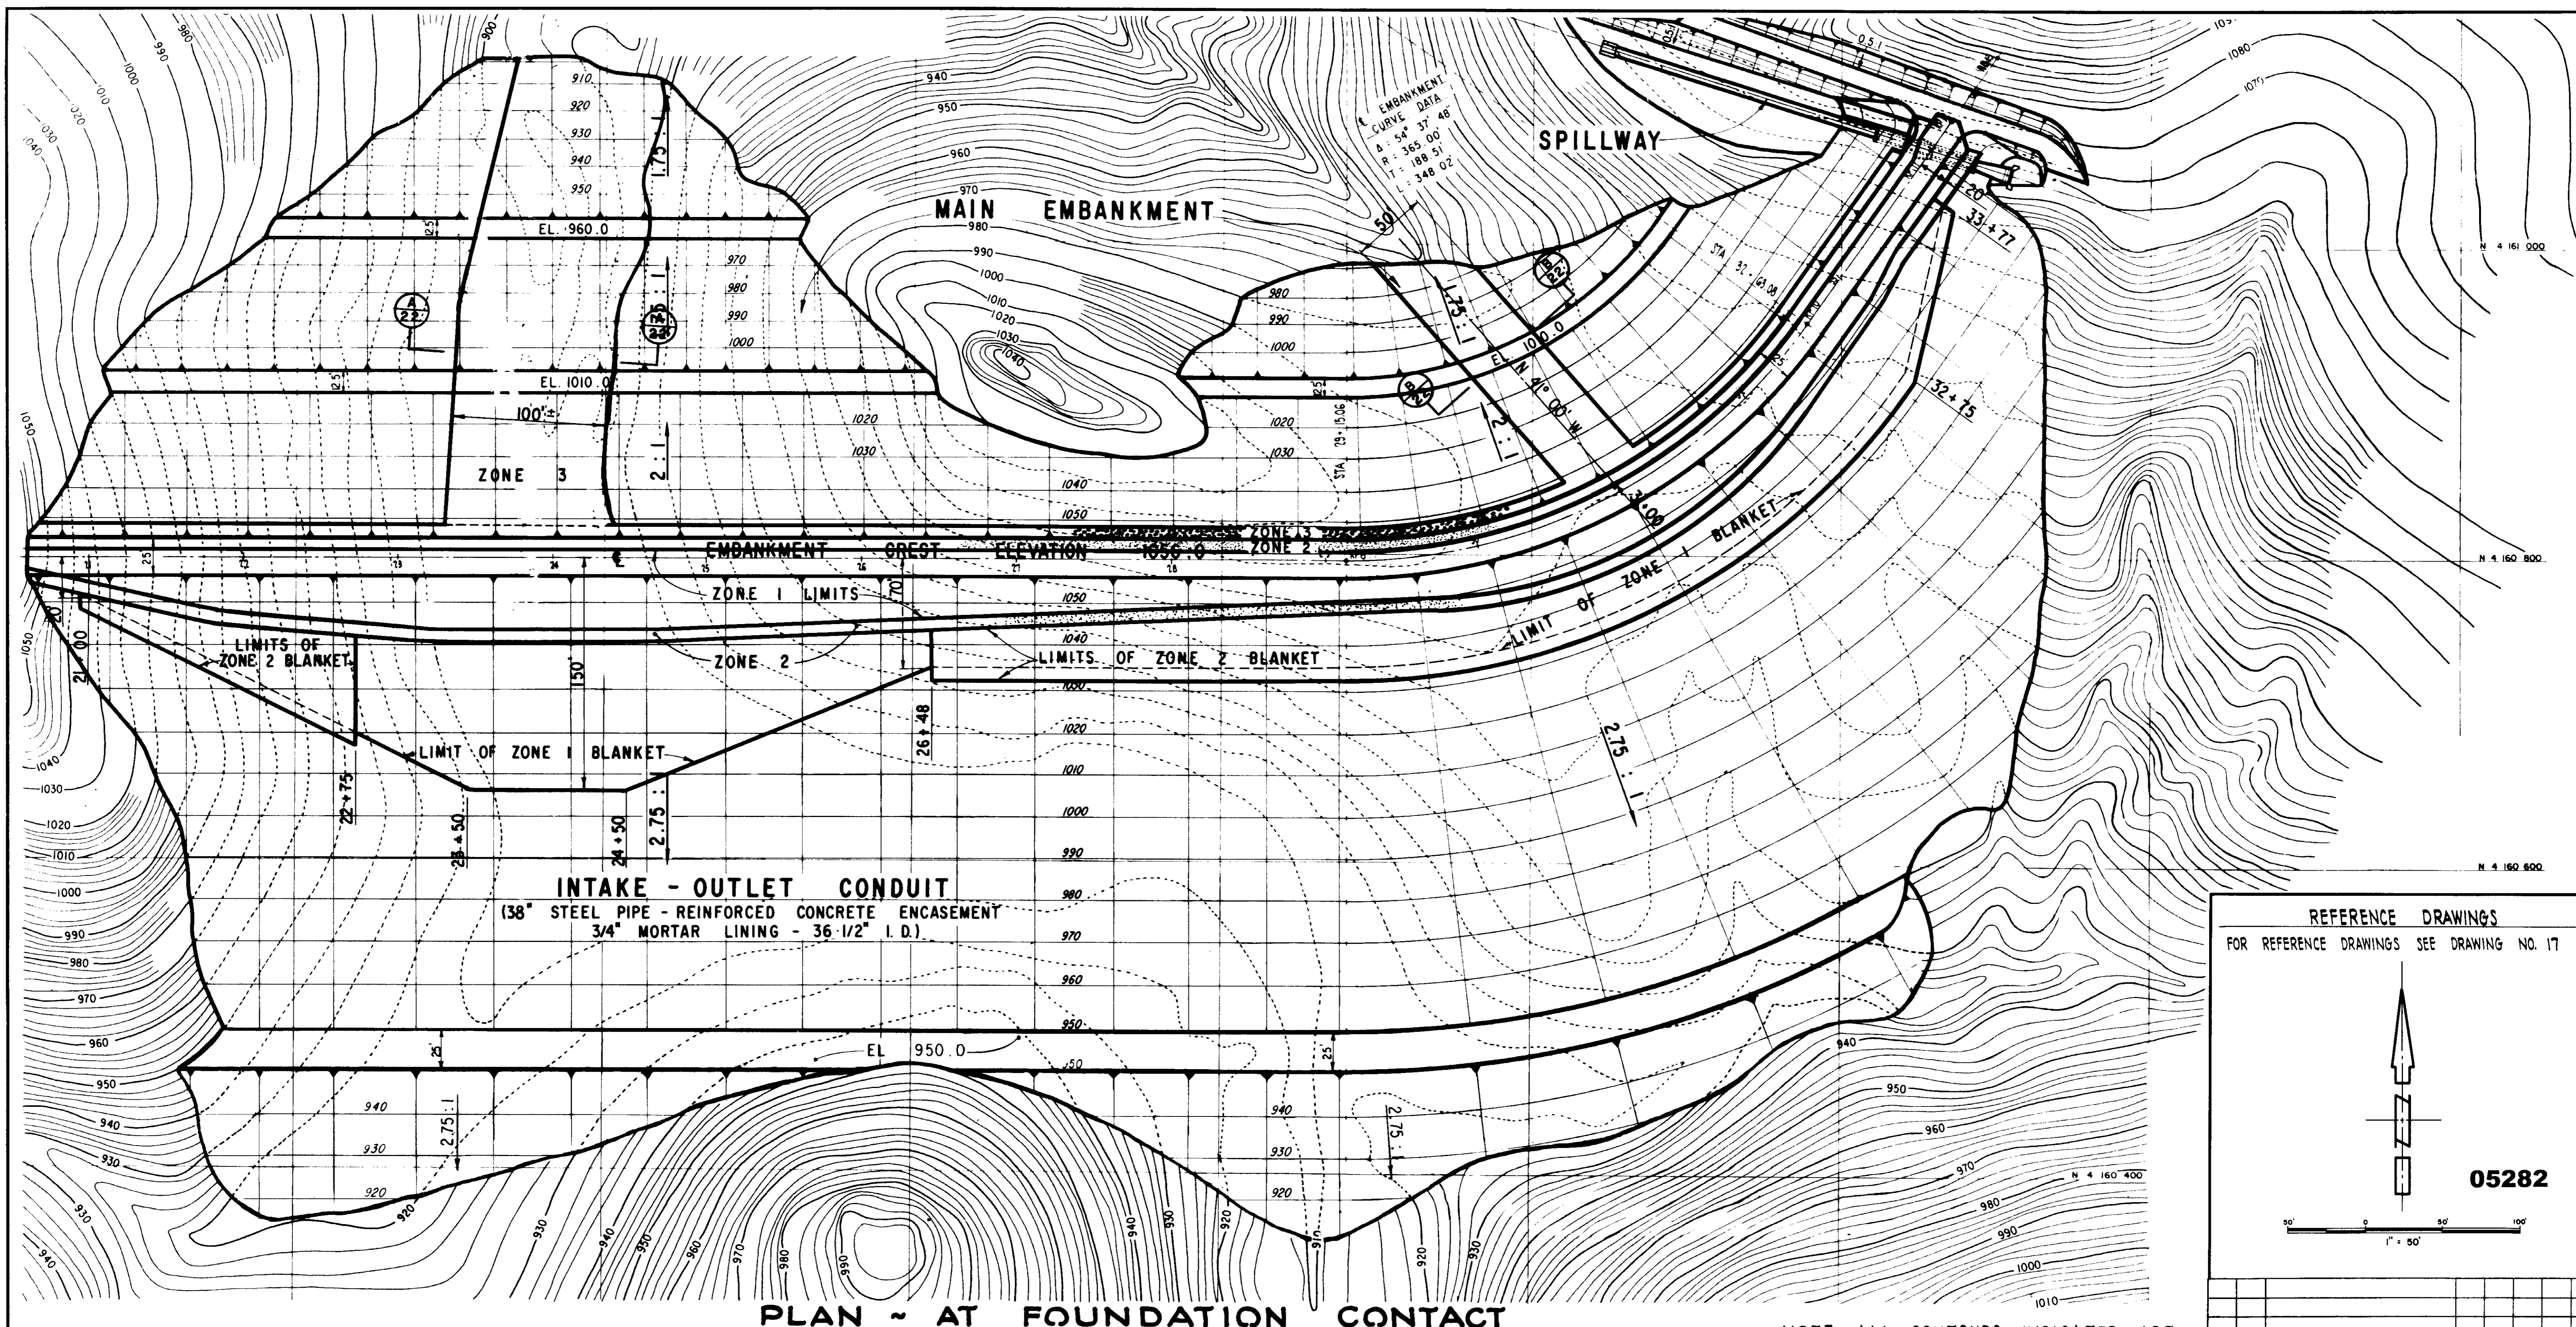

**PLAN - AT FOUNDATION CONTACT**  
SCALE: 1" = 50'

NOTE: ALL CONTOURS INDICATED ARE ORIGINAL BEFORE STRIPPING.

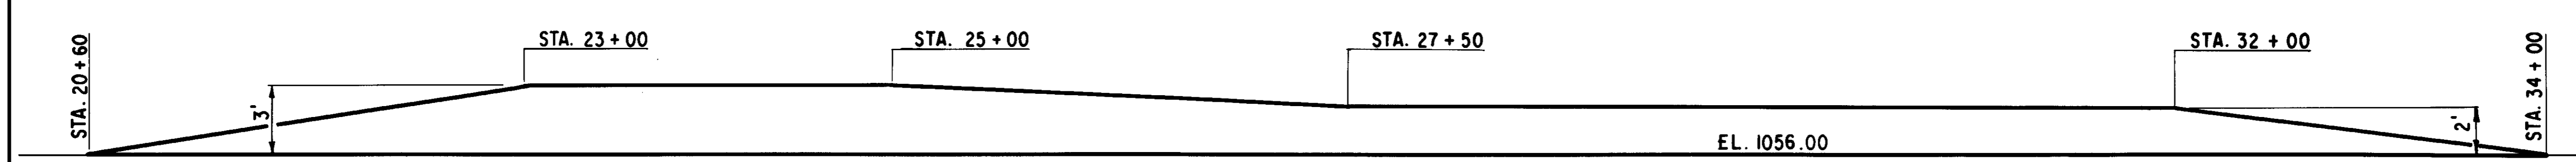

**CAMBER DIAGRAM**  
HORIZ. SCALE: 1" = 20'  
VERT. SCALE: 1" = 4'

**AS CONSTRUCTED**  
DATE 4/15/73 DFT S.H.P. CKD DTM

**REFERENCE DRAWINGS**  
FOR REFERENCE DRAWINGS SEE DRAWING NO. 17

05282

1" = 50'

NO.	DATE	REVISIONS	BY	CHK	JOB ENG.	PROJ. ENG.	MGR.


**LAS VIRGENES MUNICIPAL WATER DISTRICT**

BOYLE ENGINEERING  
W. A. WAHLER & ASSOCIATES

WESTLAKE RESERVOIR


**MAIN EMBANKMENT**  
DETAILS - SHEET 1 OF 2

DESIGNED F.W.G.	DATE: 11-70	JOB ENG. C.W.P.	PROJ. ENG. <i>[Signature]</i>
DRAWN <i>[Signature]</i>		CHECKED C.W.P.	DRAWING NUMBER
		<i>[Signature]</i>	21
SCALE AS SHOWN		R. C. E. 1986	REV.

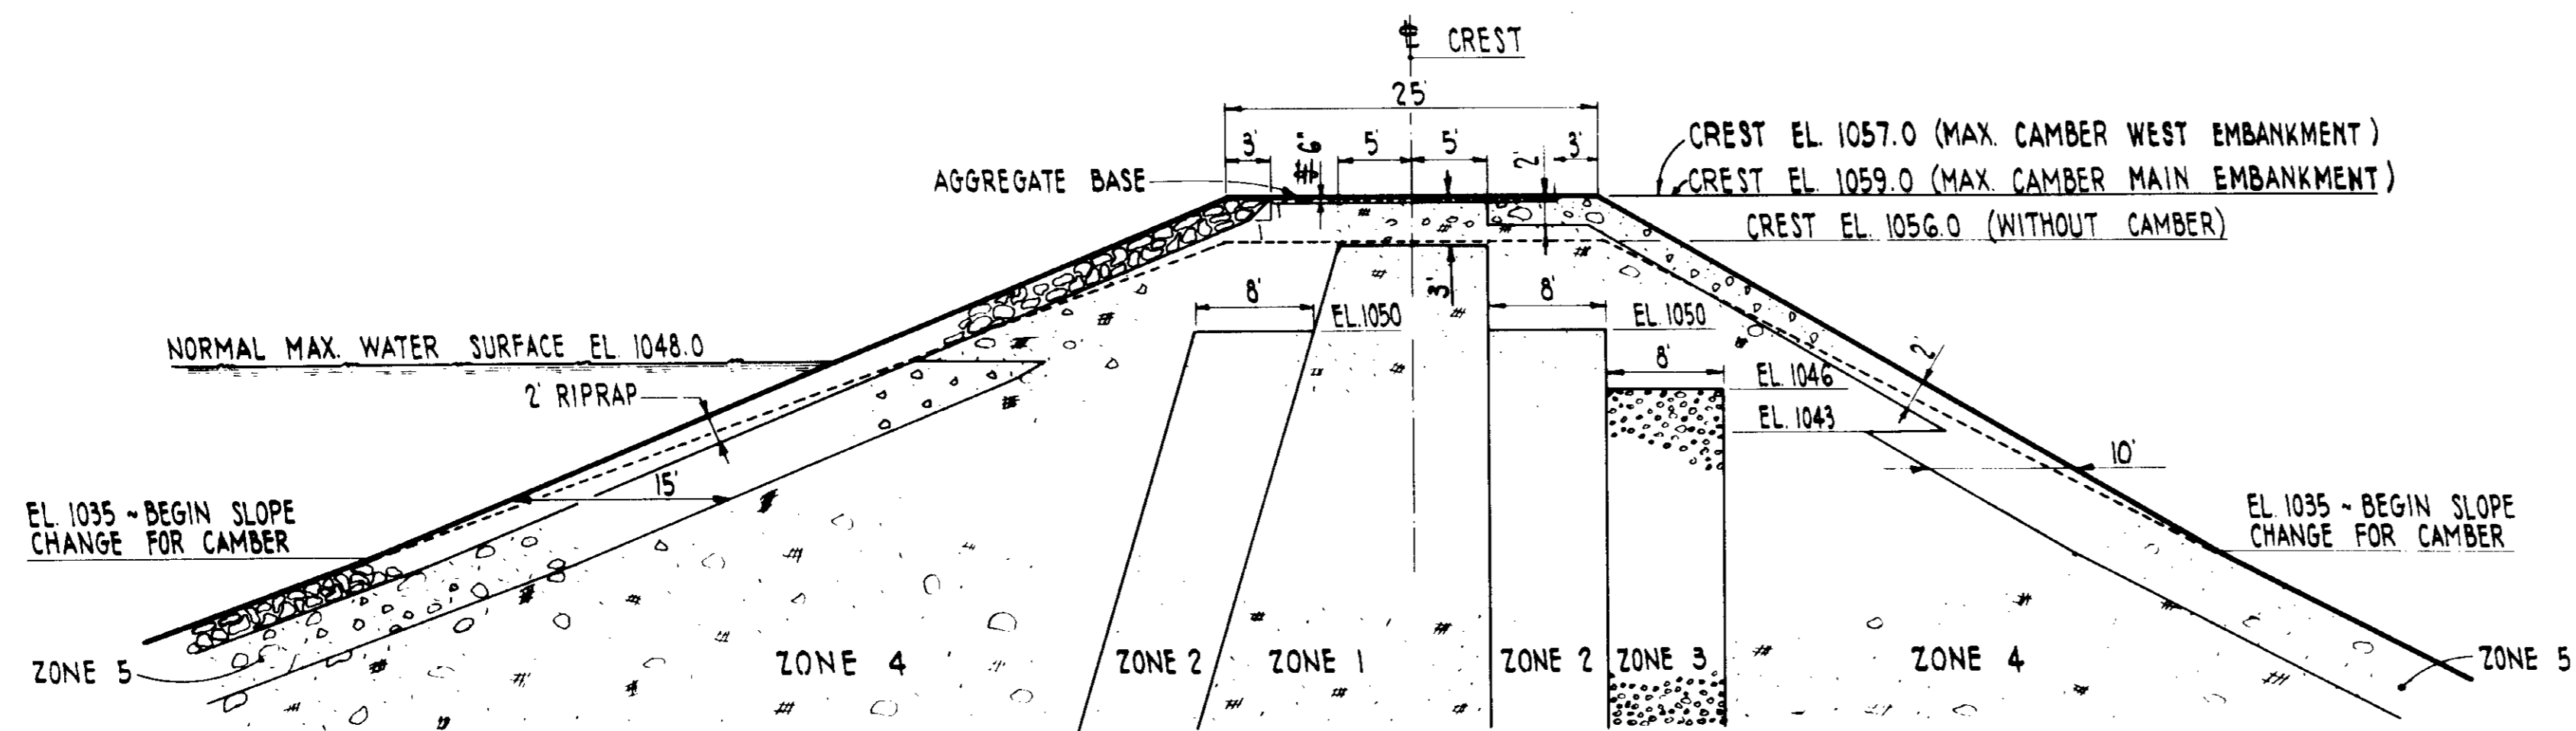


**WEST & MAIN EMBANKMENT CREST DETAIL**


SCALE: 1" = 10'

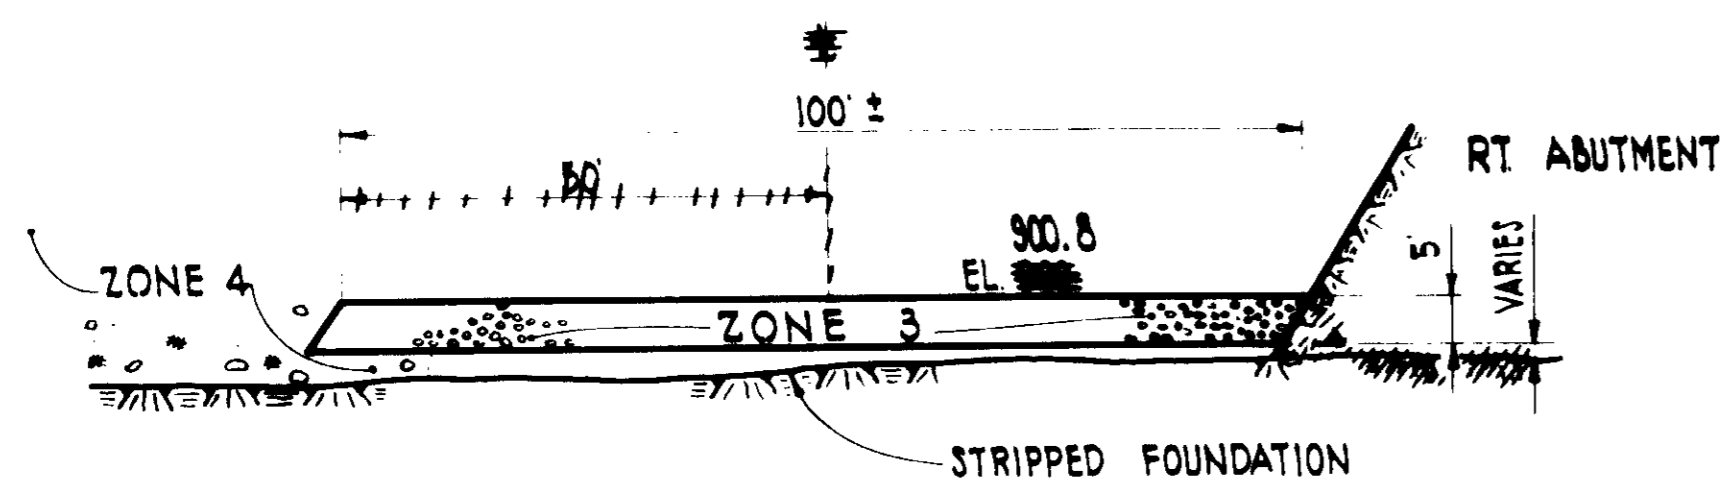


**SECTION A**  
SCALE: NONE

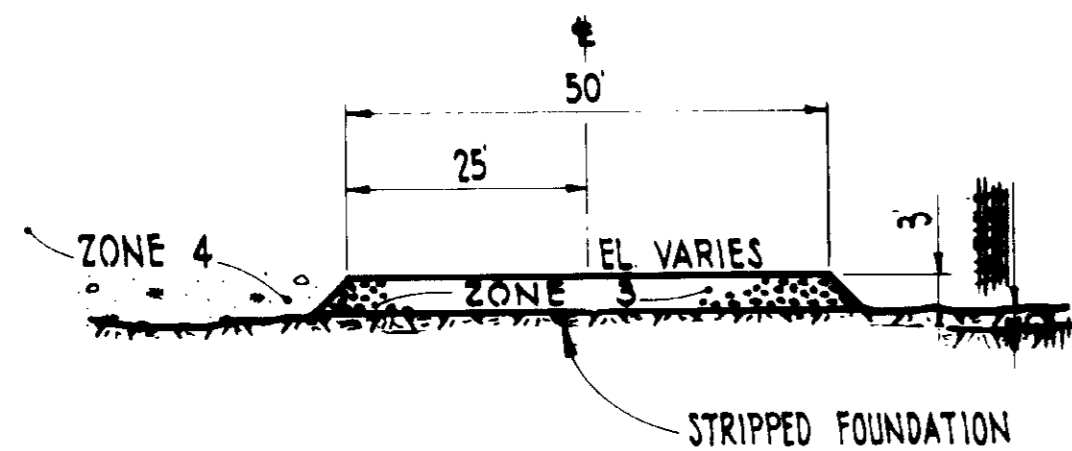

**SECTION B**  
SCALE: NONE

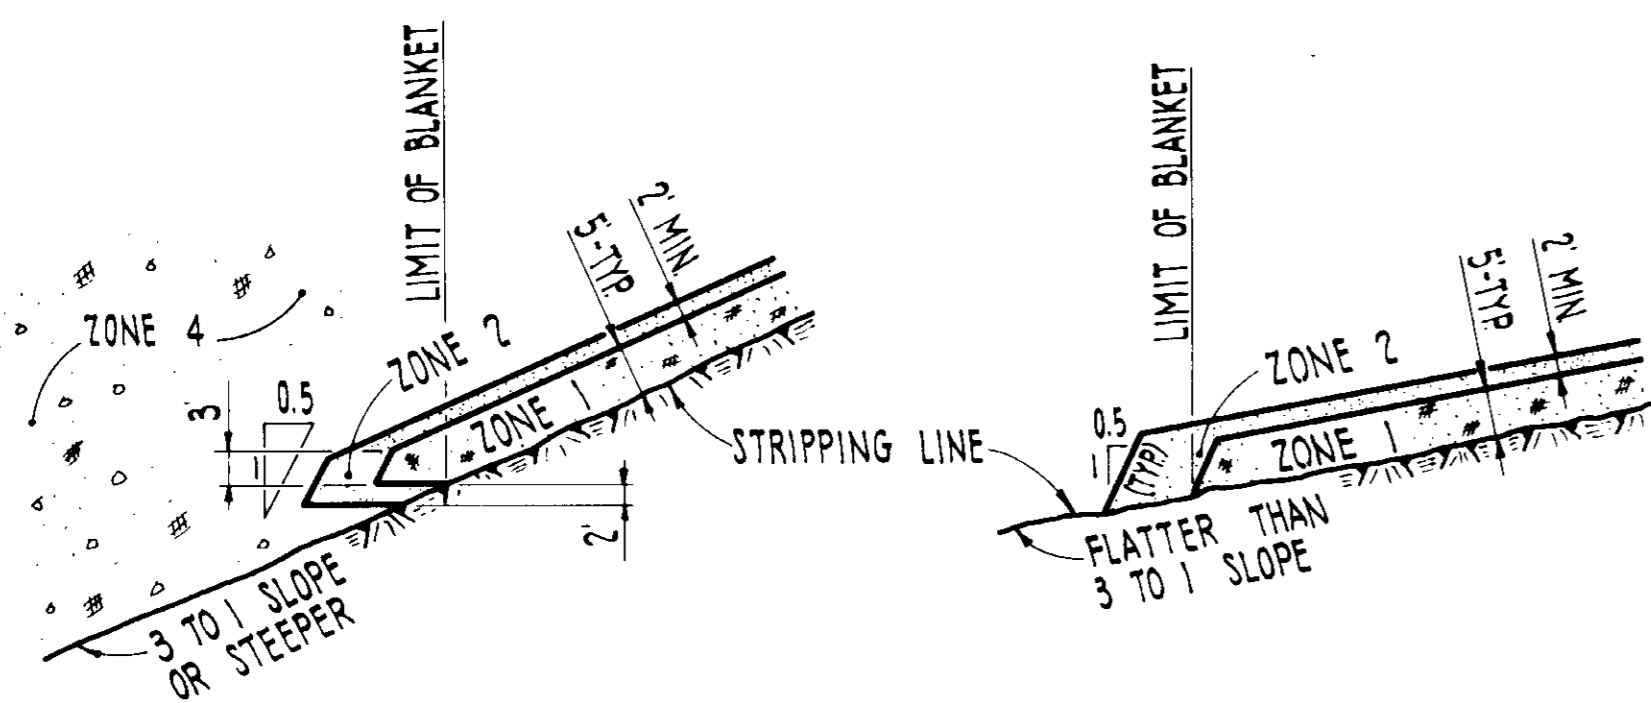


**UPSTREAM BLANKET DETAILS C**  
SCALE: NONE

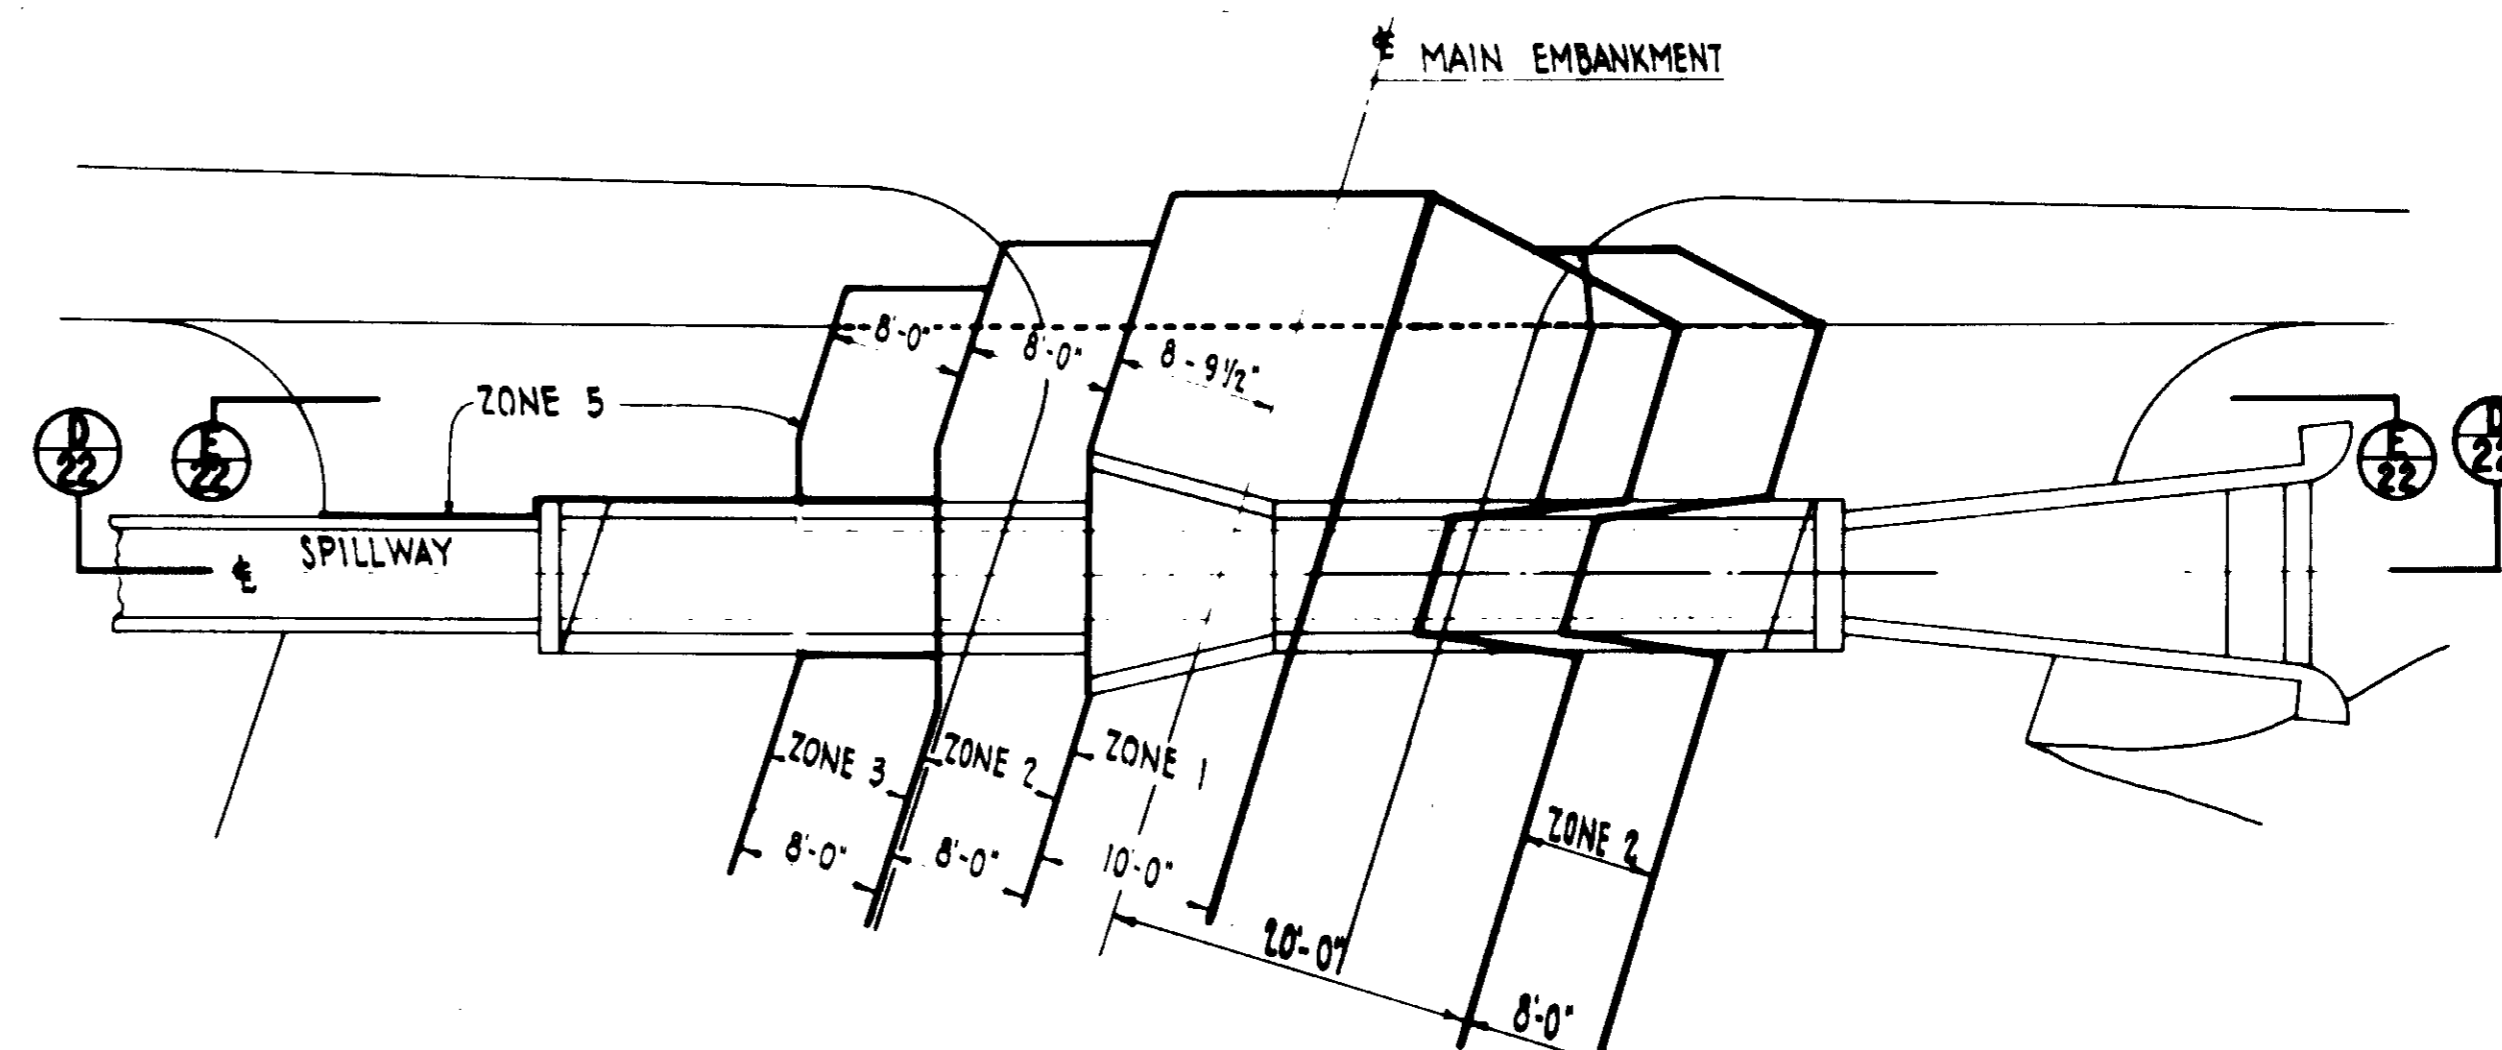


**PLAN - EMBANKMENT FILLS AT SPILLWAY**

SCALE: 3/32" = 1'-0"

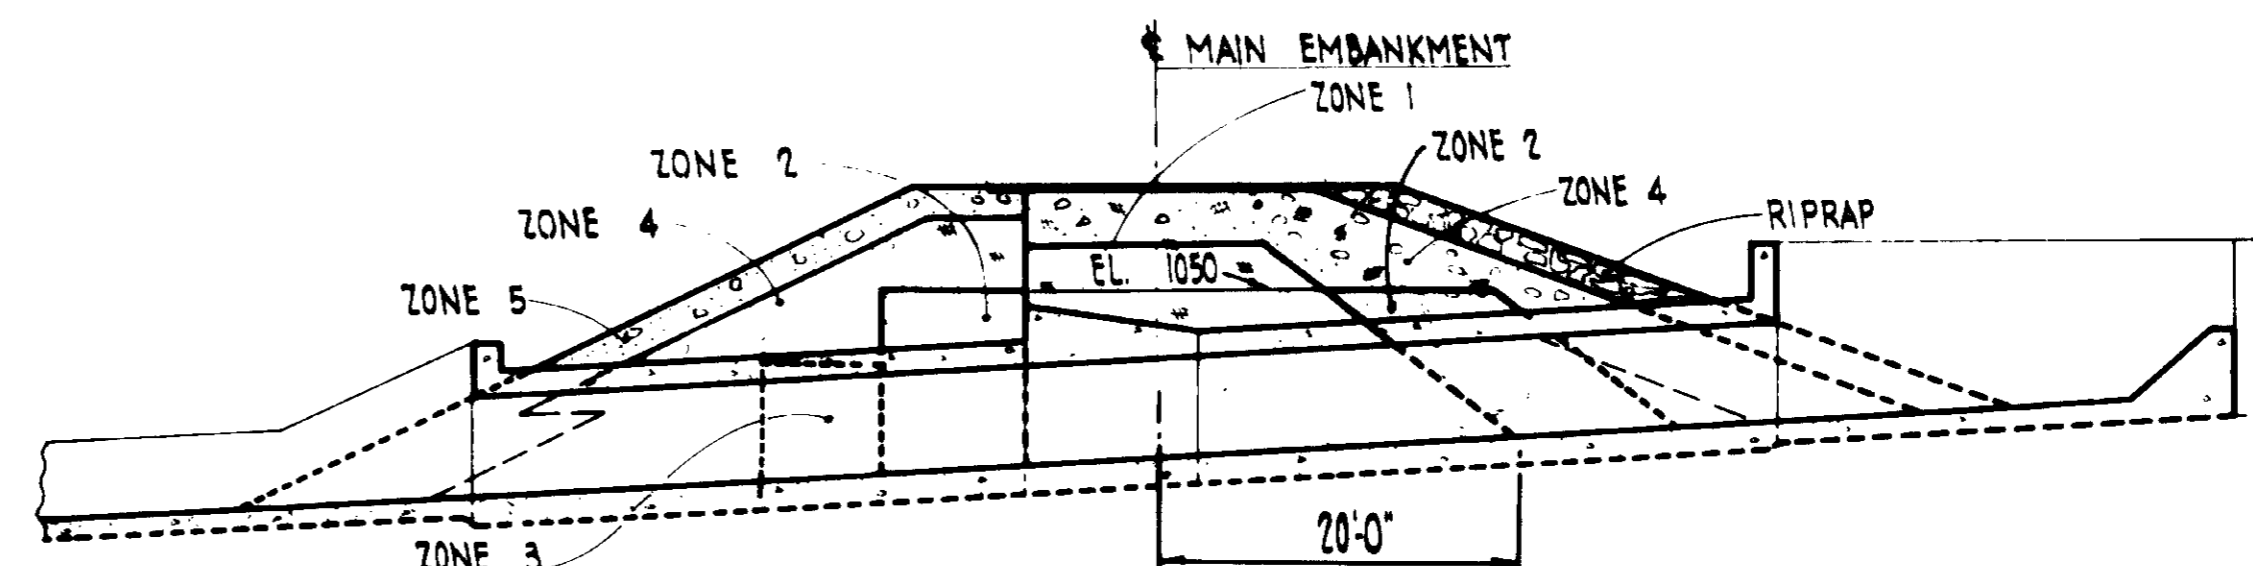

**SECTION D**  
SCALE: 3/32" = 1'-0"

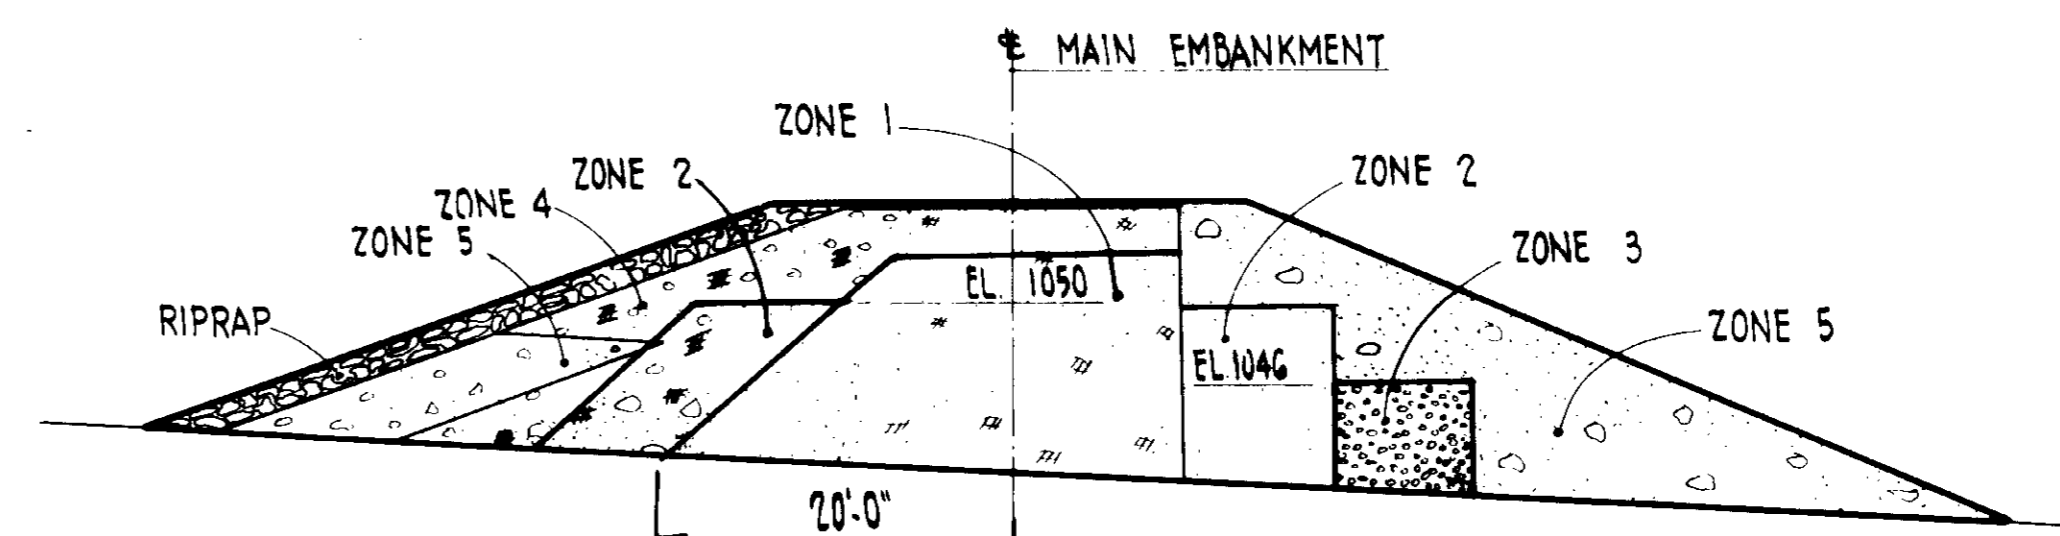

**SECTION E**  
SCALE: 3/32" = 1'-0"


**AS CONSTRUCTED**  
DATE 4/5/79 DFT H.R.R. CKD D.P.M.

**NOTES**


- Aggregate base shall meet Class 2 gradation as required by State of California Specification.

**REFERENCE DRAWINGS**


FOR REFERENCE DRAWINGS SEE DRAWING NO 17

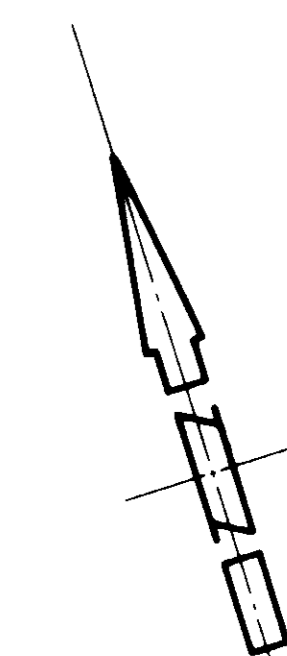

**05283**

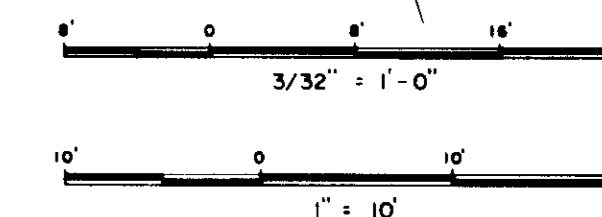

ISSUED FOR CONSTRUCTION				J.E.M.B.E.		D.P.M.		A.H.	
NO.	DATE	REVISIONS	BY	CHK	JOB	PROJ.	ENG.	ENG.	MGR.
<b>LAS VIRGENES MUNICIPAL WATER DISTRICT</b>									
BOYLE ENGINEERING W. A. WAHLER & ASSOCIATES									
WESTLAKE RESERVOIR <b>WEST &amp; MAIN EMBANKMENT</b> DETAILS - SHEET 2 OF 2									
DESIGNED F.W.G.	DATE: 11-70	JOB	ENG. C.W.P.	PROJ.	ENG.	A.H.			
DRAWN R.R.									
CHECKED C.W.P.									
SCALE AS SHOWN									
L.A. Clayton R.C.E. 196								DRAWING NUMBER	REV.
								22	

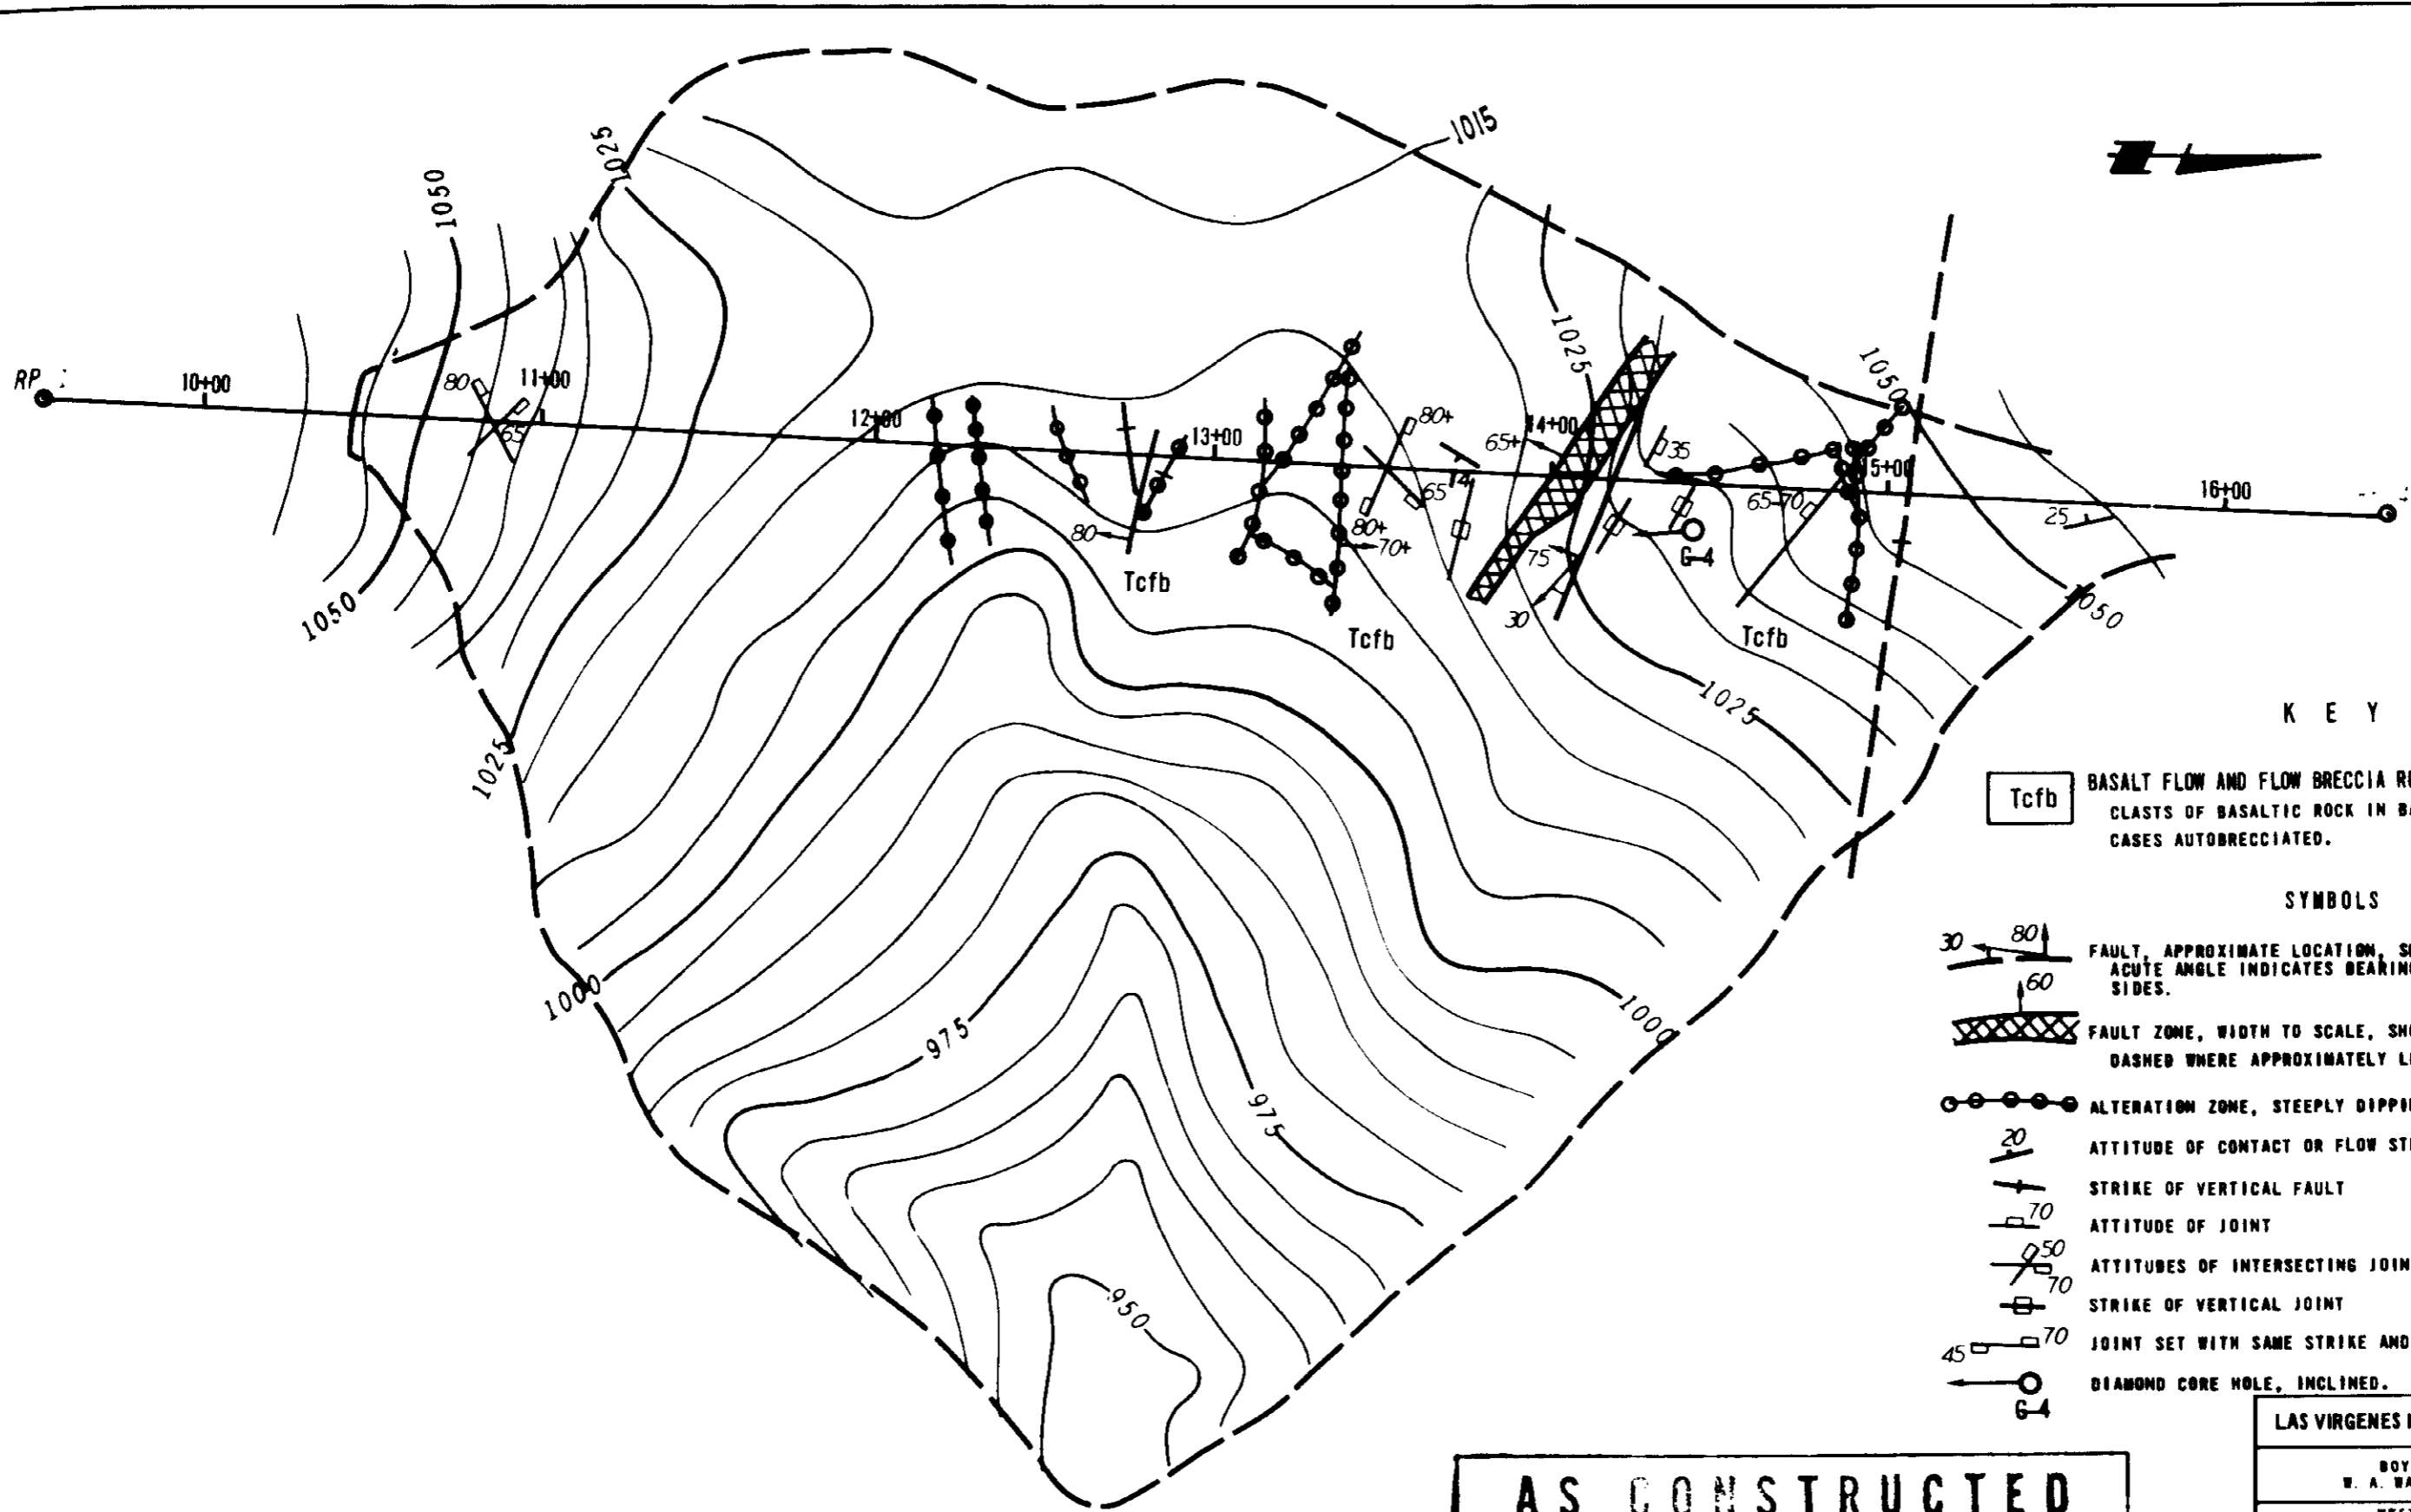


**K E Y**

**Tcfb** BASALT FLOW AND FLOW BRECCIA ROCK, MASSIVE: INCLUDES CLASTS OF BASALTIC ROCK IN BASALTIC MATRIX, IN MANY CASES AUTOBRECCIATED.

**SYMBOLS**


- FAULT, APPROXIMATE LOCATION, SHOWING ATTITUDE; ARROW AT ACUTE ANGLE INDICATES BEARING AND PLUNGE OF SLICKENSIDES.
- FAULT ZONE, WIDTH TO SCALE, SHOWING ATTITUDE; DASHED WHERE APPROXIMATELY LOCATED.
- ALTERATION ZONE, STEEPLY DIPPING; POSSIBLE FAULT
- ATTITUDE OF CONTACT OR FLOW STRUCTURE
- STRIKE OF VERTICAL FAULT
- ATTITUDE OF JOINT
- ATTITUDES OF INTERSECTING JOINTS
- STRIKE OF VERTICAL JOINT
- JOINT SET WITH SAME STRIKE AND DIP
- DIAMOND CORE HOLE, INCLINED.

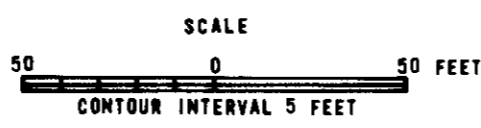

**AS CONSTRUCTED**  
DATE 12-13-73 DFT H.H.R. CKD DFM

**05284**

LAS VIRGENES MUNICIPAL WATER DISTRICT	
BOYLE ENGINEERING W. A. WAHLER & ASSOCIATES	
WESTLAKE RESERVOIR EXCAVATED FOUNDATION GEOLOGIC MAP WEST EMBANKMENT	
DESIGNED BY	DATE 6/72
DRAWN BY	CHECKED BY
SCALE AS SHOWN	DRAWING NUMBER
	<b>23-A</b>

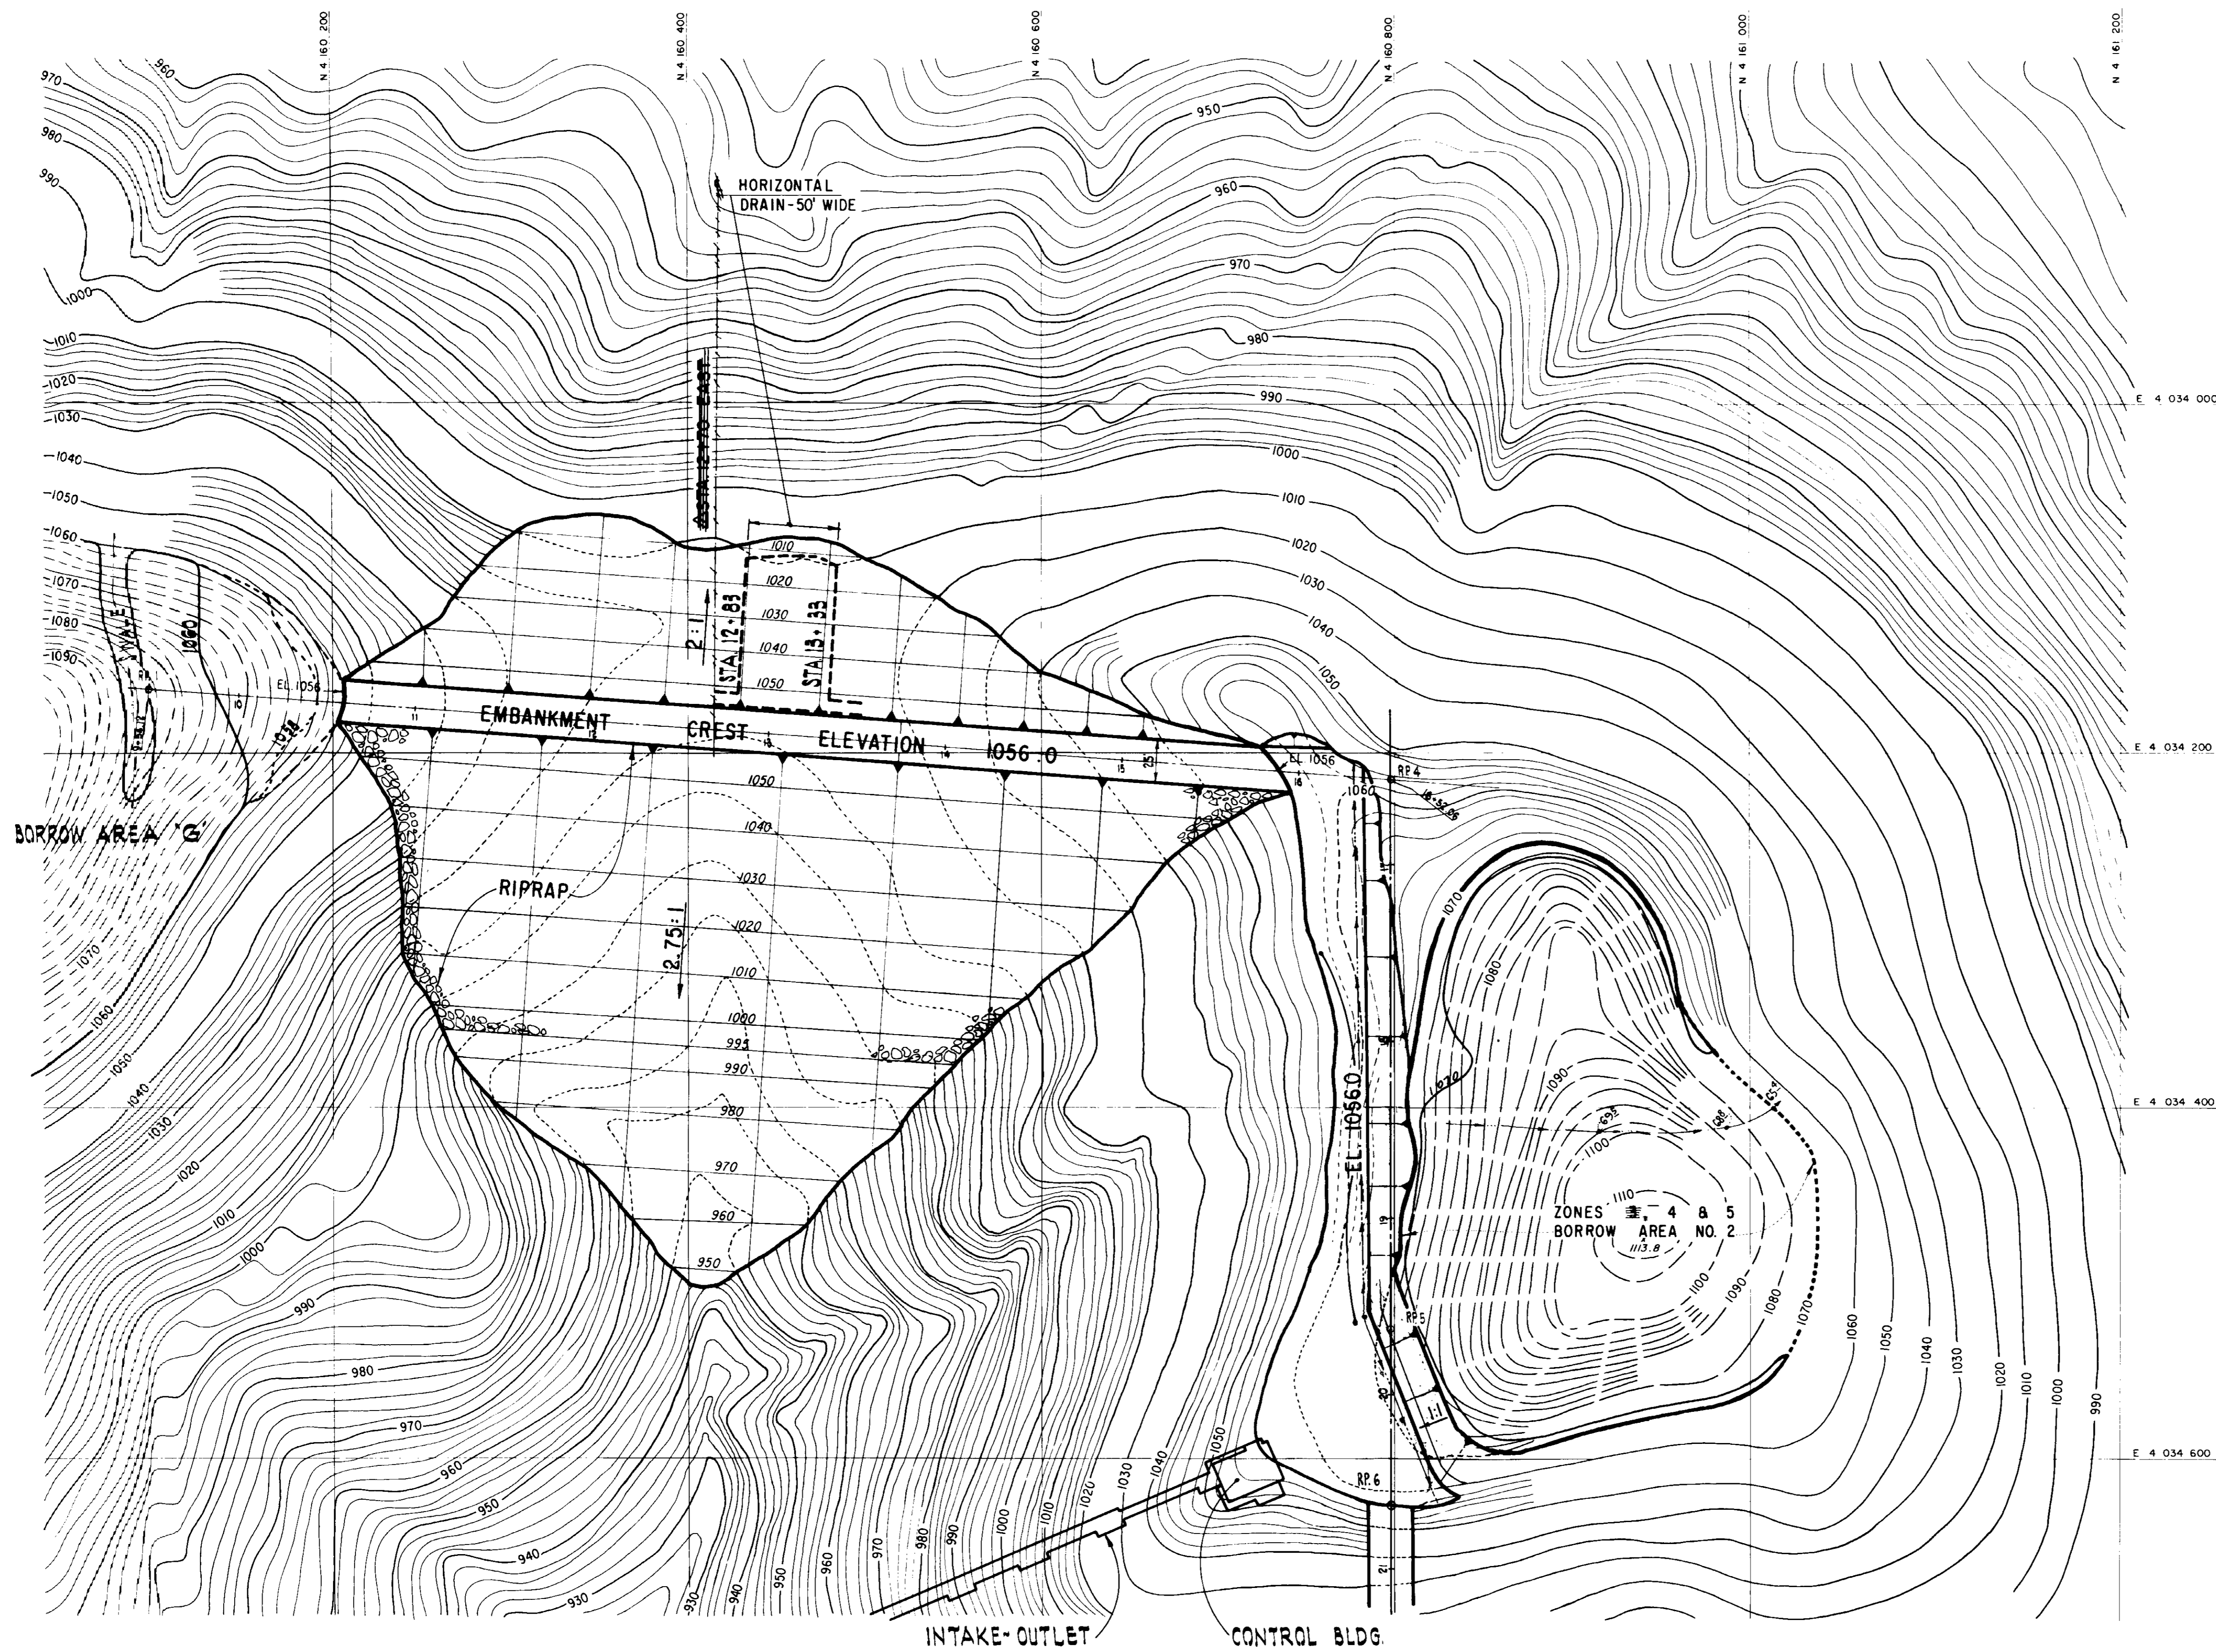


**PLAN**  
SCALE: 1" = 50'

NOTES

**AS CONSTRUCTED**  
DATE 4/5/73 DFT [Signature] CKD [Signature]

- REFERENCE DRAWINGS  
20 LONGITUDINAL PROFILES  
24 SECTIONS

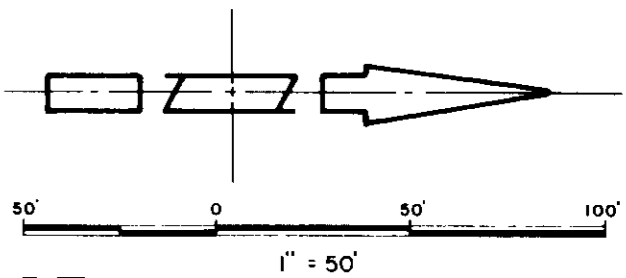

**05285**


Issued For Construction				T.E.M. AND D.E.M.		[Signature]	
NO.	DATE	REVISIONS	BY	CHK	JOB PROJ. ENG.	ENG.	MGR.

**LAS VIRGENES MUNICIPAL WATER DISTRICT**

BOYLE ENGINEERING  
W. A. WAHLER & ASSOCIATES


WESTLAKE RESERVOIR  
**WEST EMBANKMENT**  
GENERAL LAYOUT

DESIGNED F.W.G.	DATE: 11-70	JOB ENG. C.W.P.	PROJ. ENG. [Signature]
DRAWN [Signature]	CHECKED C.W.P. [Signature]	SCALE AS SHOWN	DRAWING NUMBER <b>23</b>

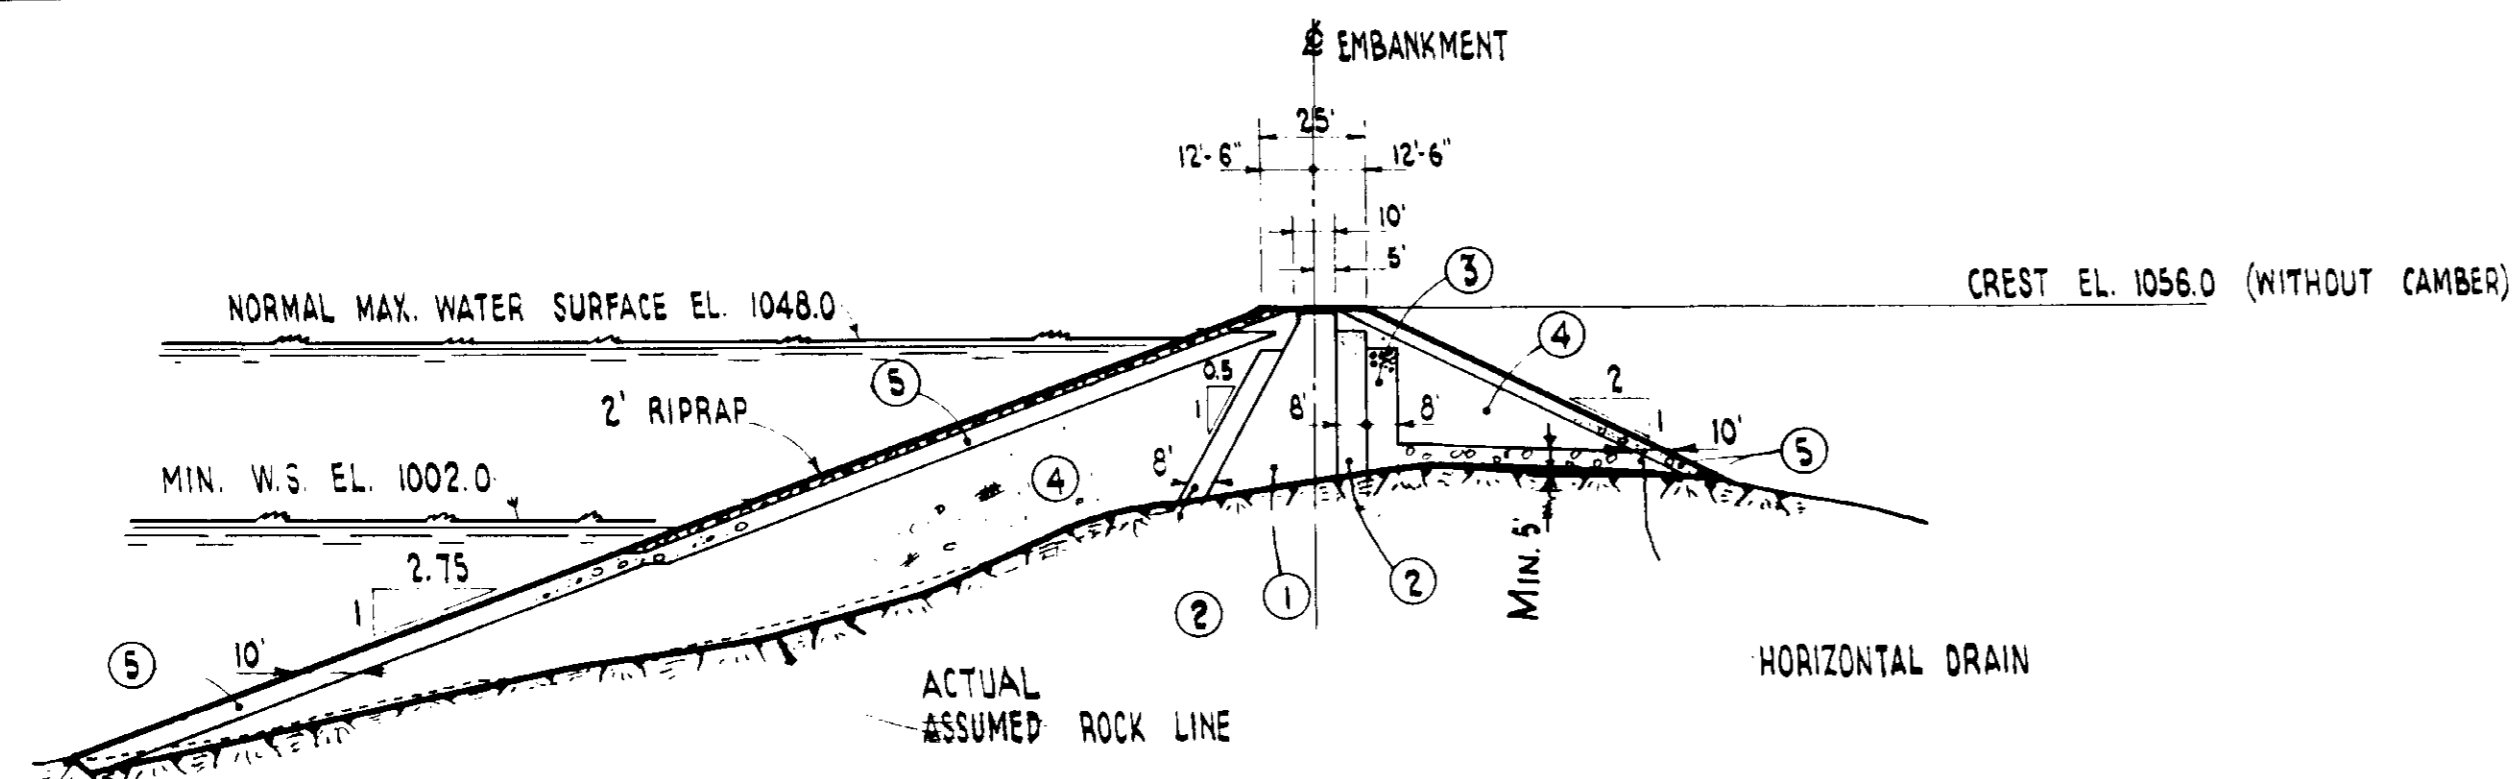


**SECTION AT STA. 13 + 00**

SCALE: 1" = 50'

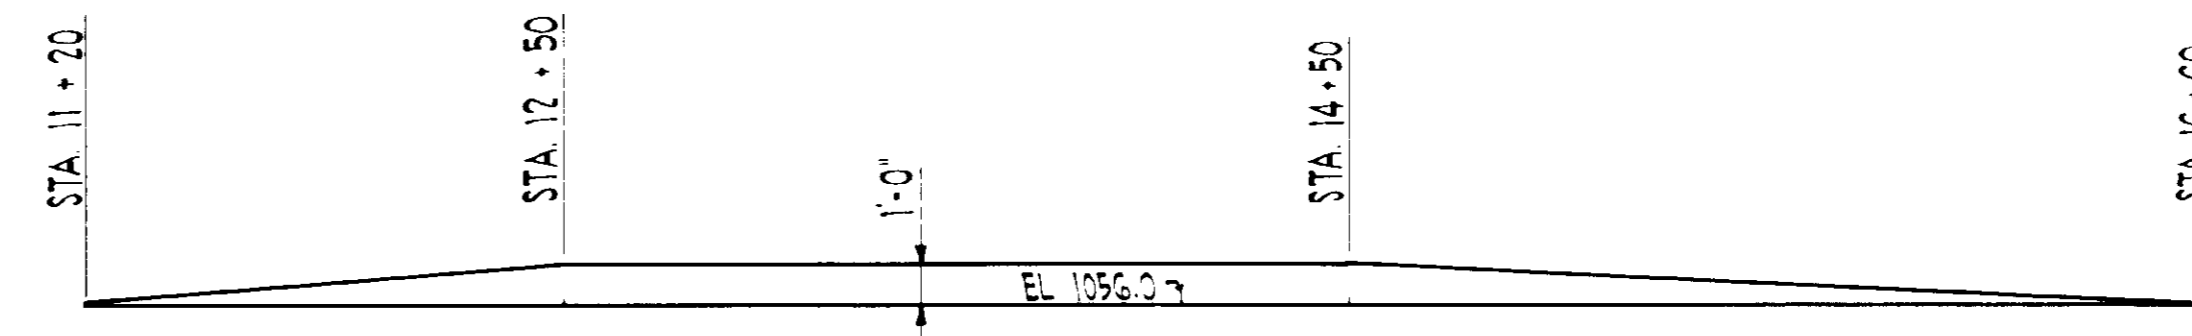

**CAMBER DIAGRAM AT  $\frac{1}{2}$  OF CREST**

HORIZ. SCALE: 1" = 50'  
VERT. SCALE: 1" = 5'

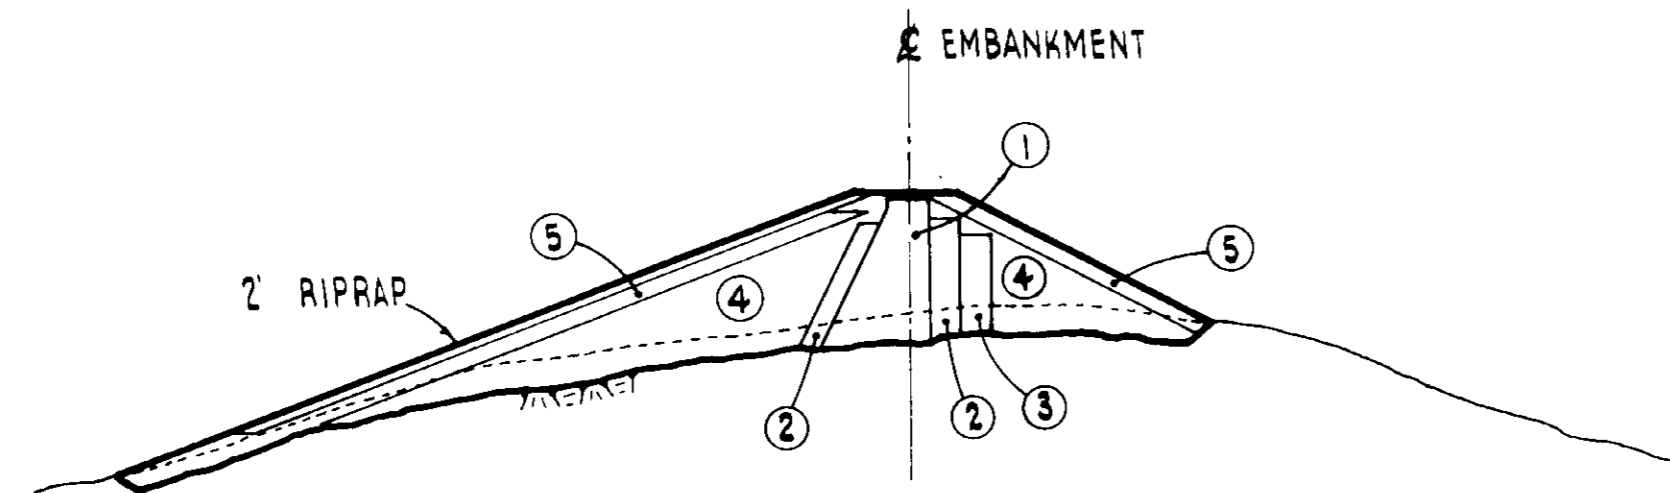

**SECTION AT STA. 14 + 00**

SCALE: 1" = 50'

**NOTES**


- Aggregate base shall meet Class 2 gradation as required by State of California Specification.

**AS CONSTRUCTED**  
DATE: 4/8/73 BY: HNR. CRO: DFM.

**REFERENCE DRAWINGS**

FOR REFERENCE DRAWINGS SEE DRAWING NO. 23

**05286**

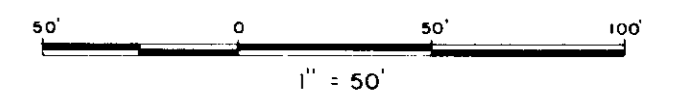


Issued for Construction		T.E.M. C.W.P.		J.H. J.C.	
NO.	DATE	REVISIONS	BY	CHK	PROJ. ENGR. MGR.

**LAS VIRGENES MUNICIPAL WATER DISTRICT**


**BOYLE ENGINEERING  
W. A. WAHLER & ASSOCIATES**

**WESTLAKE RESERVOIR  
WEST EMBANKMENT  
SECTIONS**

DESIGNED F.W.G.	DATE: 11-70	JOB ENG. C.W.P.	PROJ. ENGR. <i>DT</i>
DRAWN <i>W.B.</i>		CHECKED C.W.P. <i>R.C.E.</i>	DRAWING NUMBER: <b>24</b>
SCALE AS SHOWN			REV.

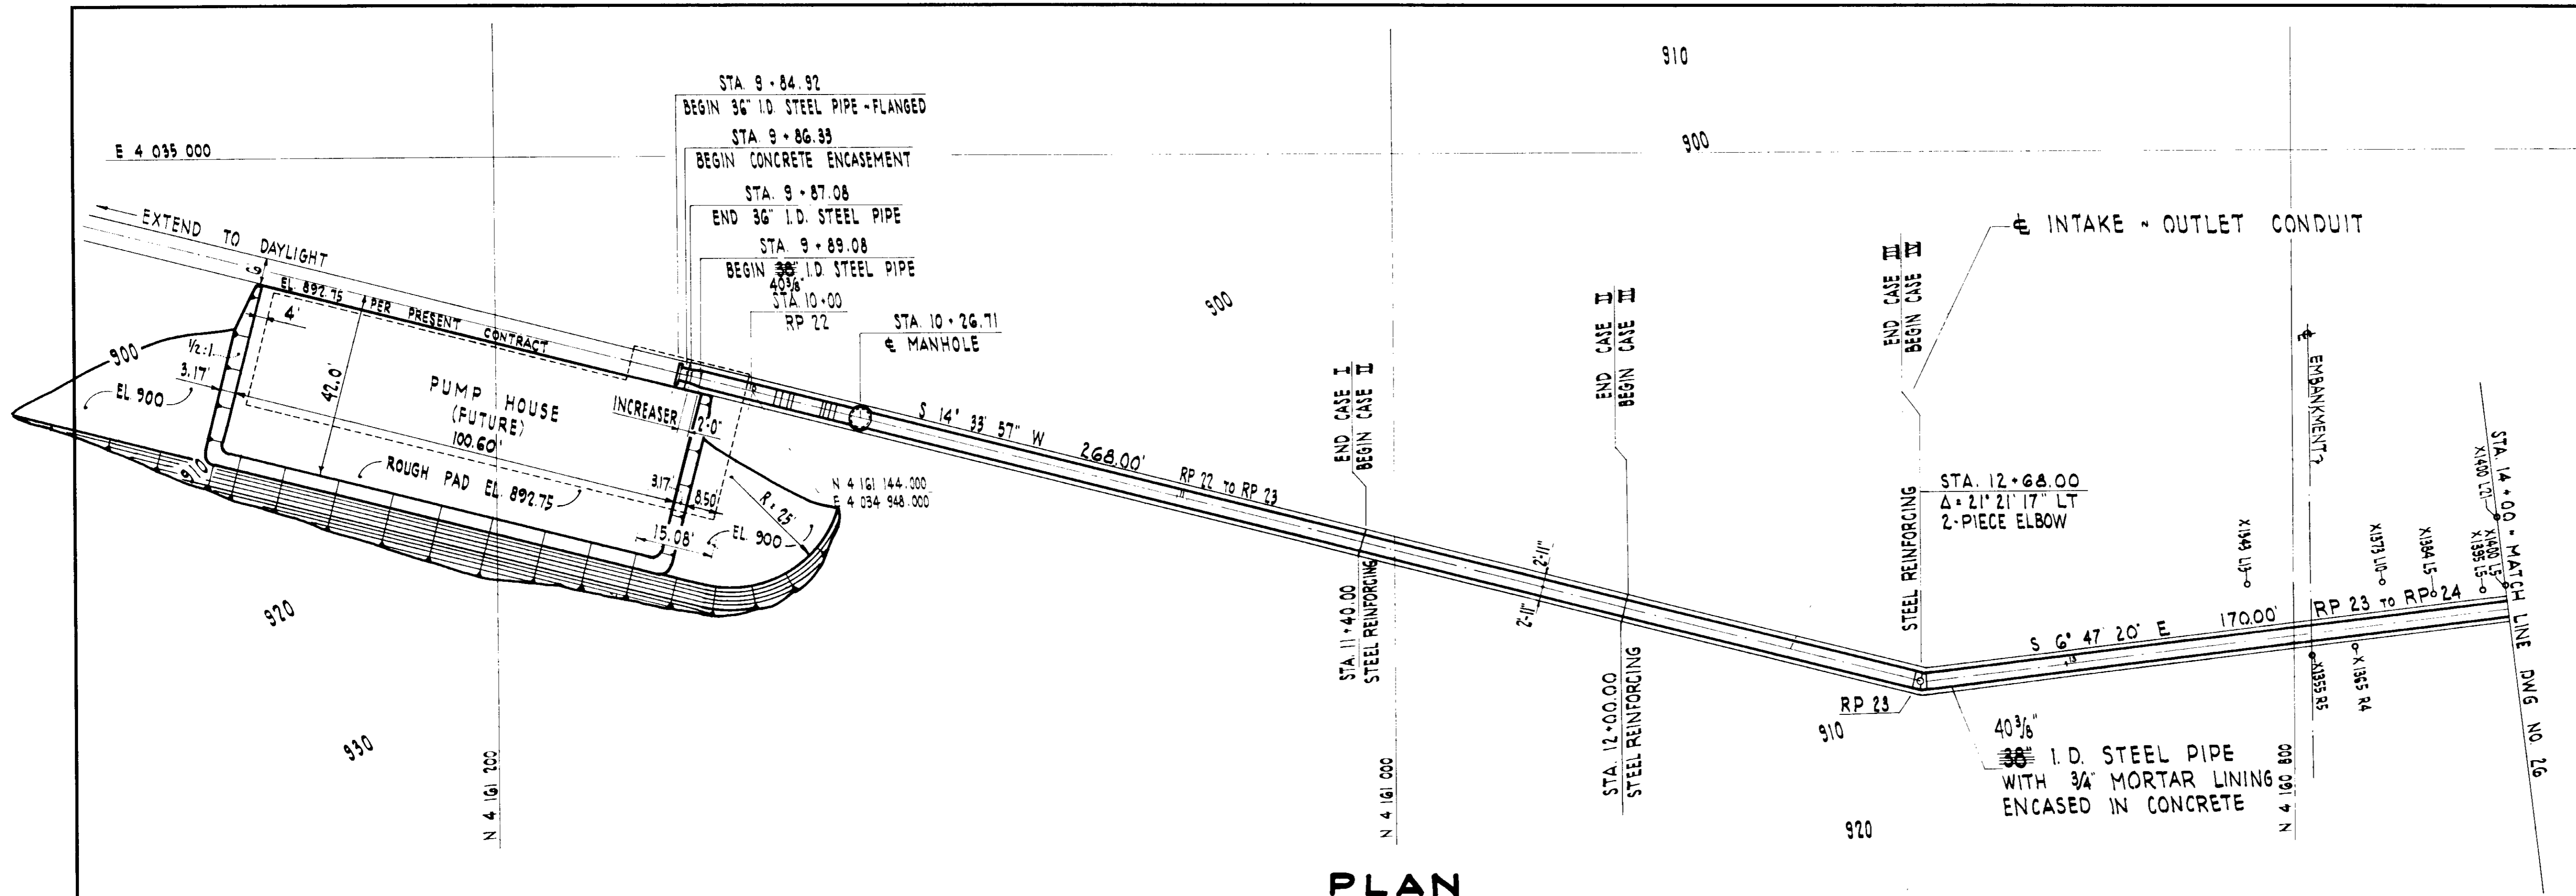

**PLAN**  
SCALE: 1" = 20'

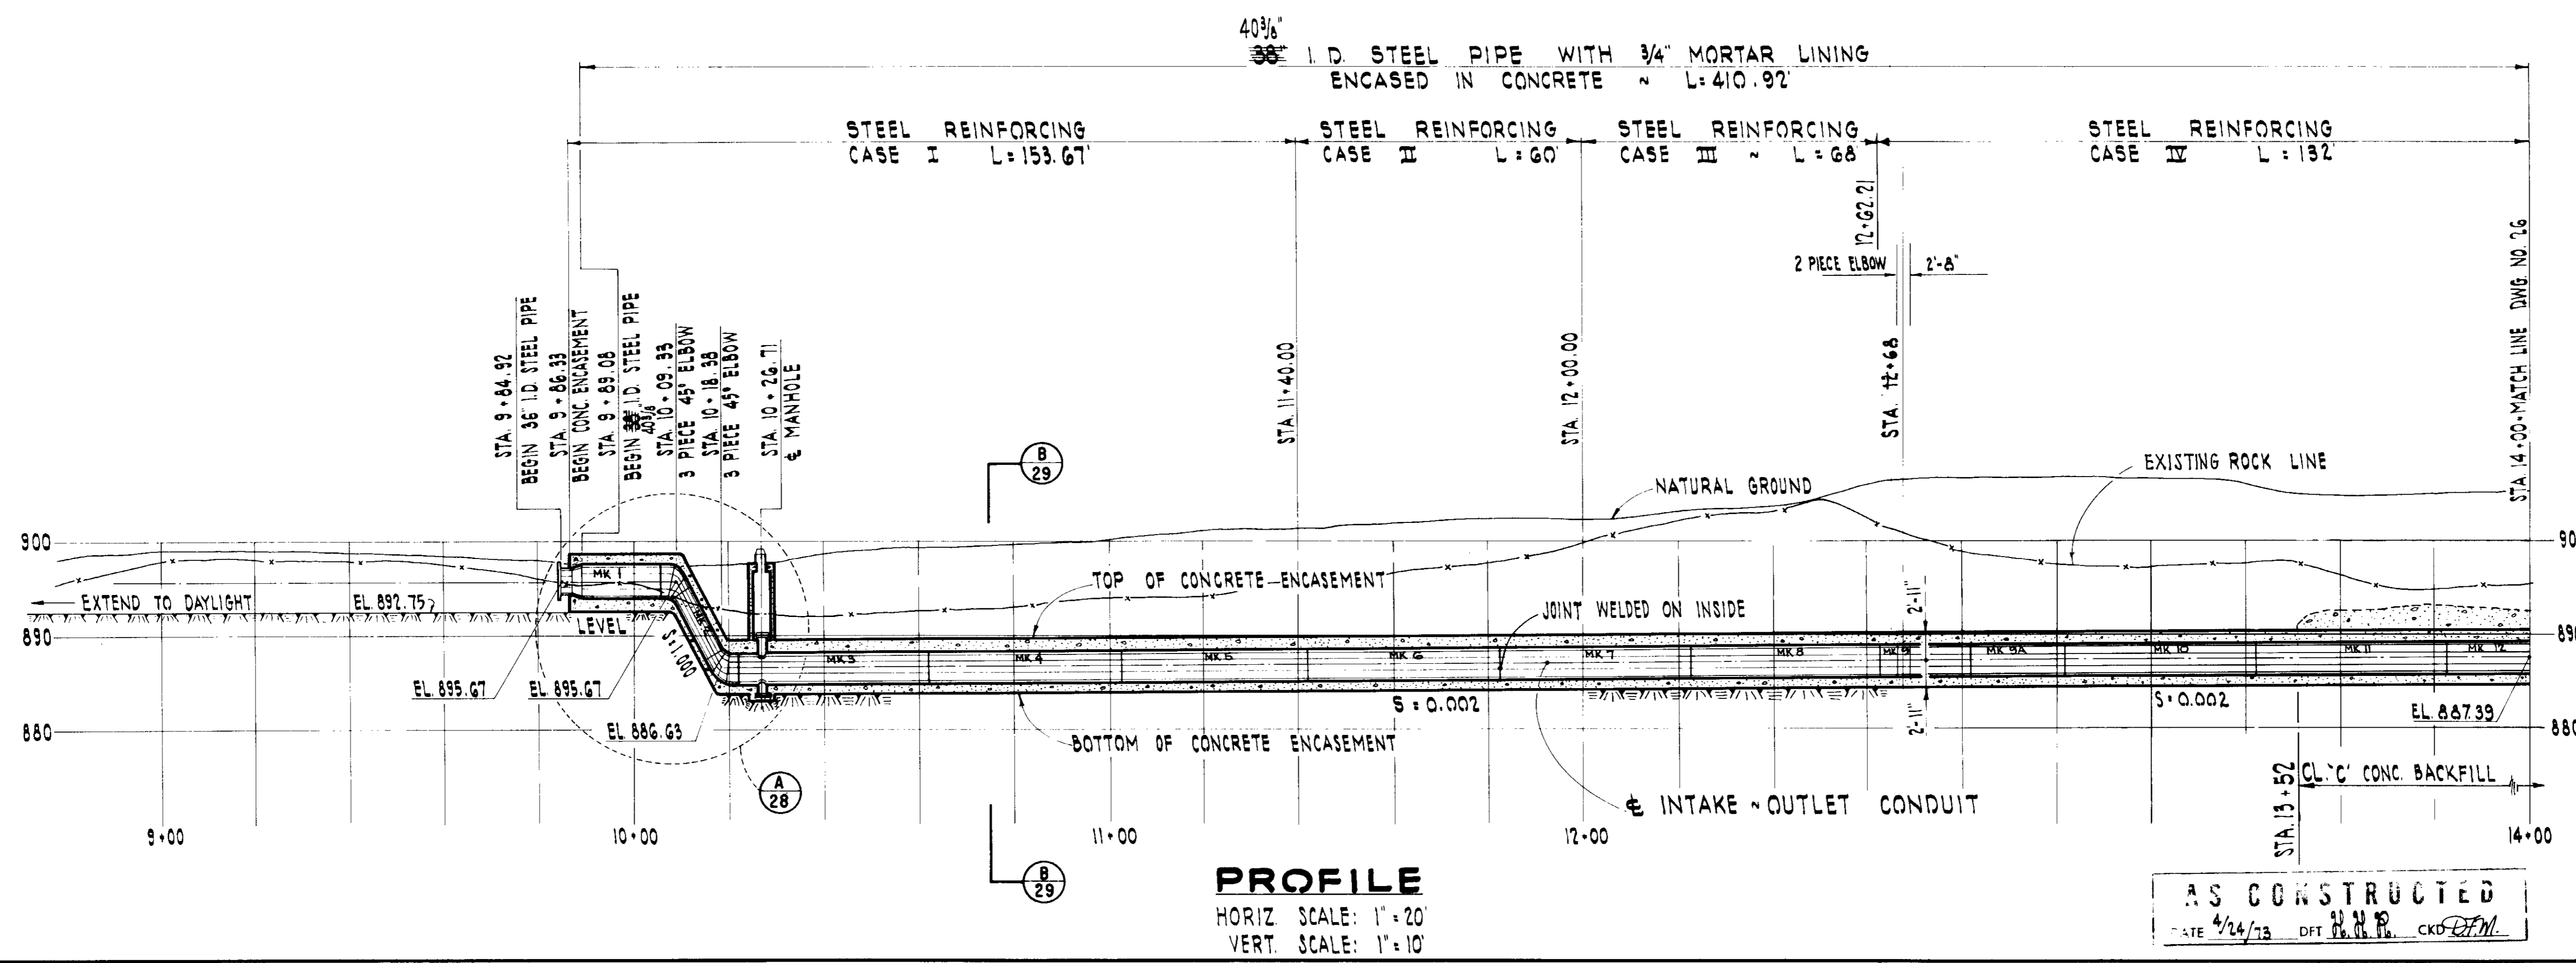

**PROFILE**  
HORIZ SCALE: 1" = 20'  
VERT. SCALE: 1" = 10'


**NOTES**

1. The vertical alignment shown on these drawings is based on an assumed rock surface. After the embankment foundation is completed, the vertical alignment may be changed to fit existing rock conditions.
2. Steel pipe shall have a minimum wall thickness of 1/4" except where otherwise shown.
3. Steel pipe shall have one coat of rust inhibitant paint applied in the shop, and shall have a 3/4" thick mortar lining.
4. For General Concrete Notes see Drawing No. 28.

INDICATES PRESSURE GROUT HOLE UP TO 25' IN DEPTH

**REFERENCE DRAWINGS**

- 26 PLAN AND PROFILE - SHEET 2 OF 2
- 27 DETAILS - SHEET 1 OF 2
- 28 DETAILS - SHEET 2 OF 2

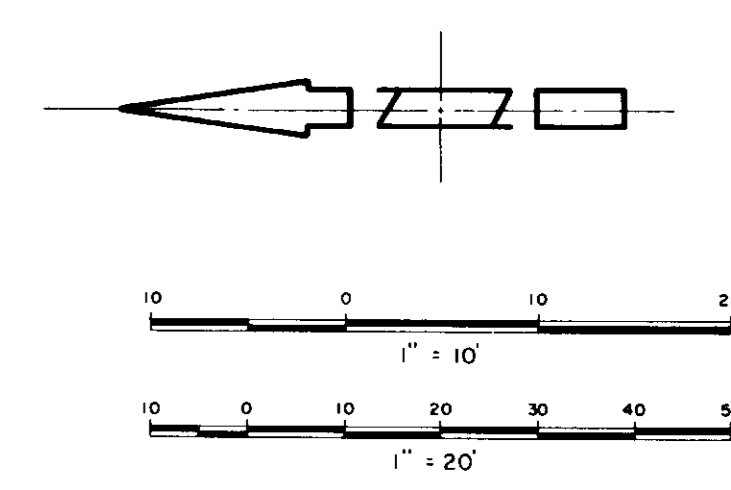

**05287**

NO.	DATE	REVISIONS	BY	CHK	ENG	PROJ	MGR.

**LAS VIRGENES MUNICIPAL WATER DISTRICT**

BOYLE ENGINEERING  
W. A. WAHLER & ASSOCIATES

WESTLAKE RESERVOIR




**INTAKE-OUTLET CONDUIT**  
PLAN AND PROFILE - SHEET 1 OF 2

DESIGNED: *MW* DATE: 11-70 JOB: *DFM* PROJ. ENG.: *JA*

DRAWN: *W.F.* CHECKED: *DFM* SCALE AS SHOWN

DATE: 4/24/73 DFT: *R.C.E.* CKD: *DFM*

DRAWING NUMBER: **25**

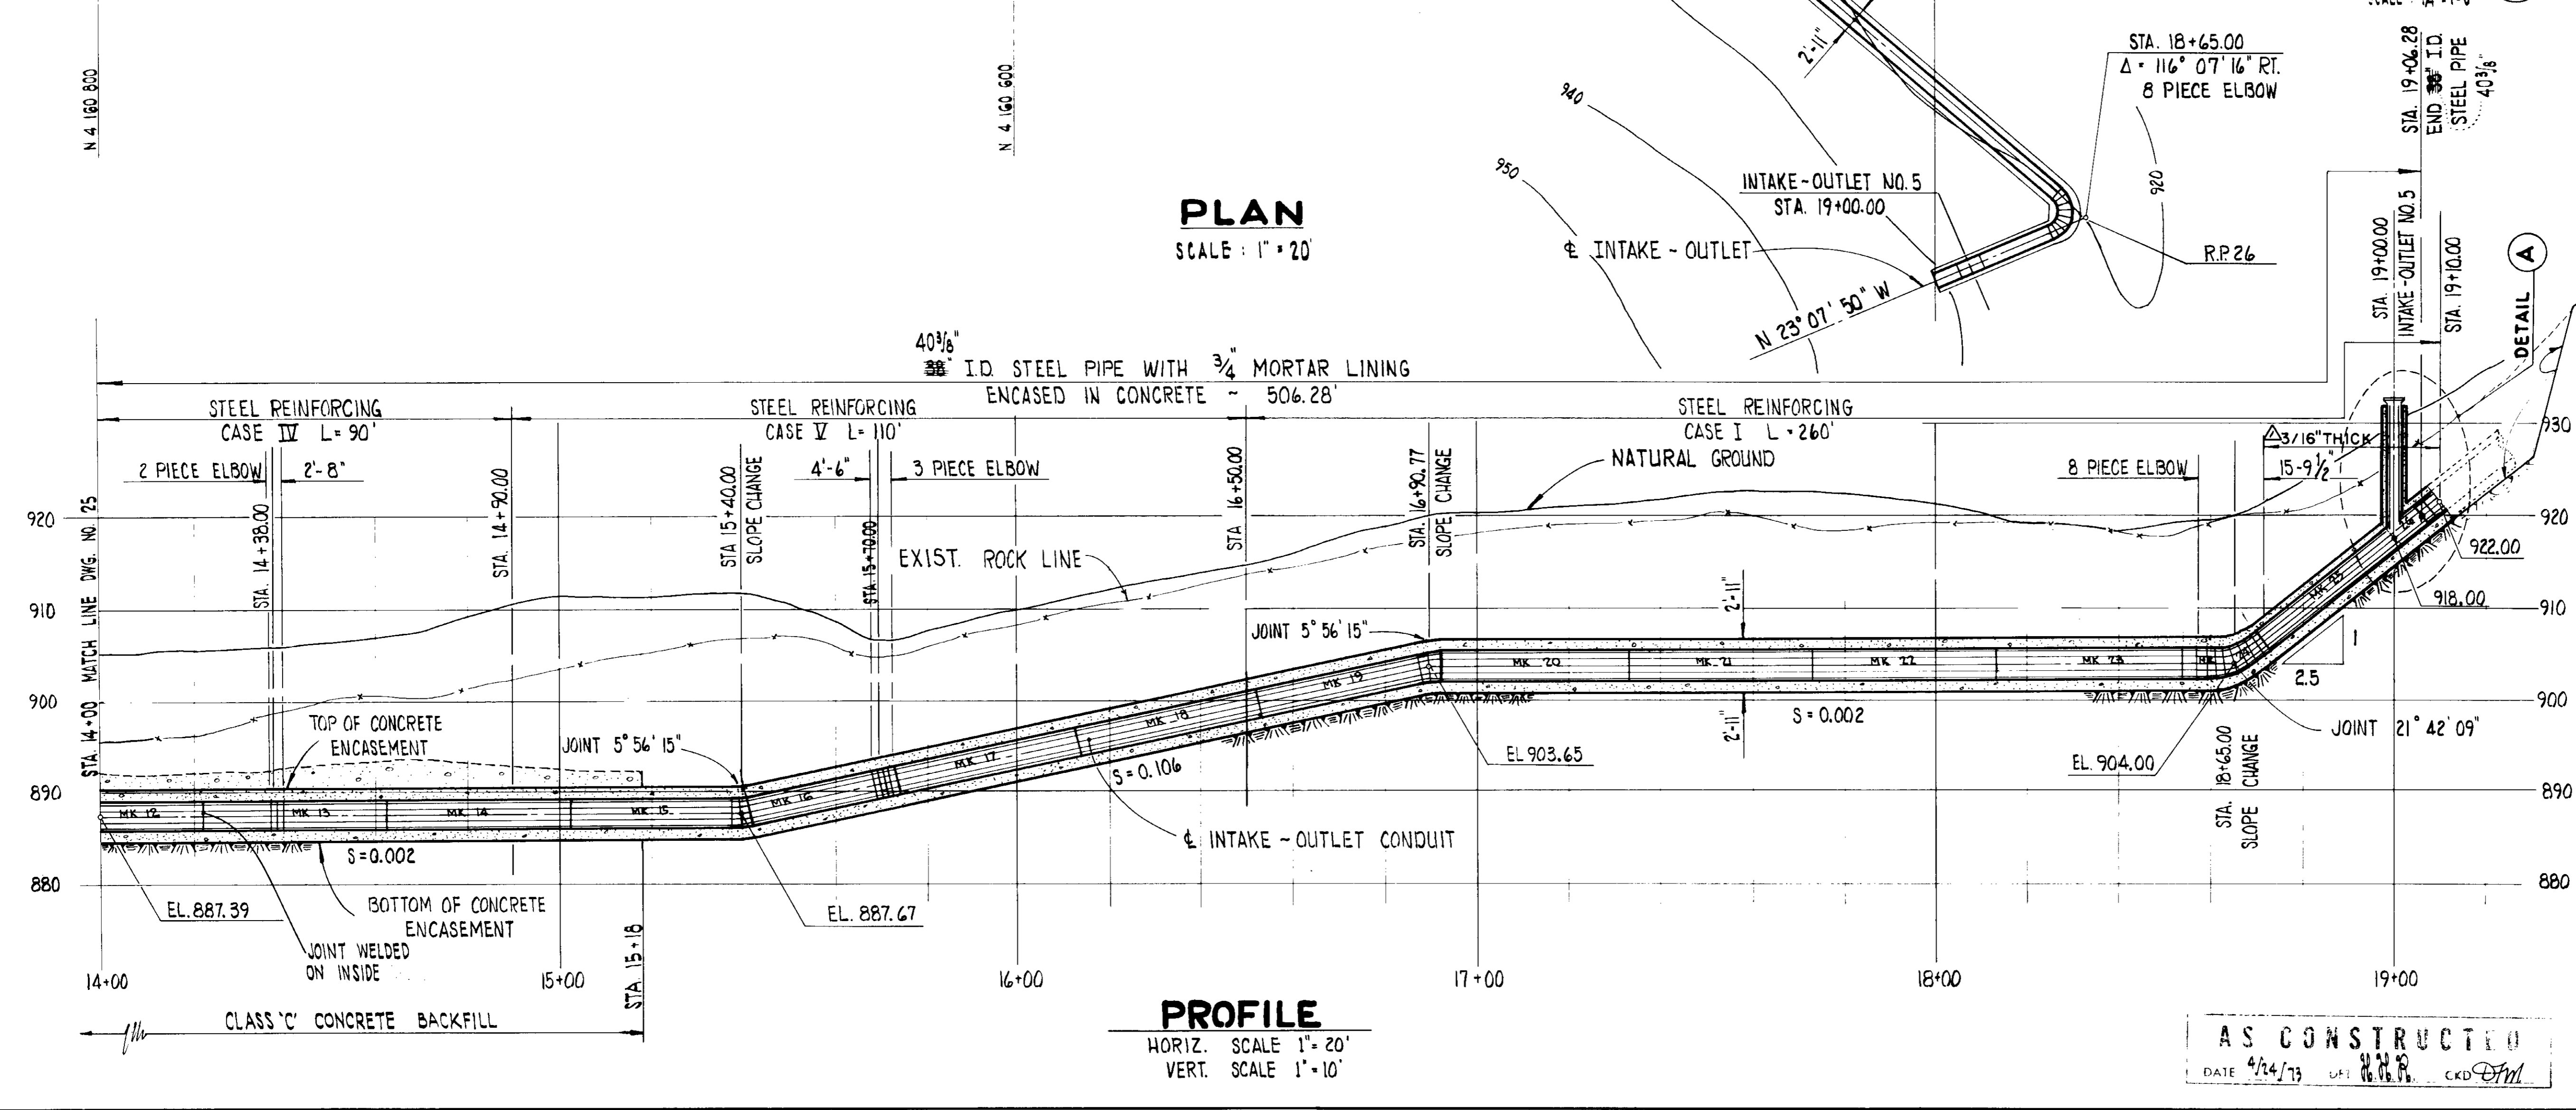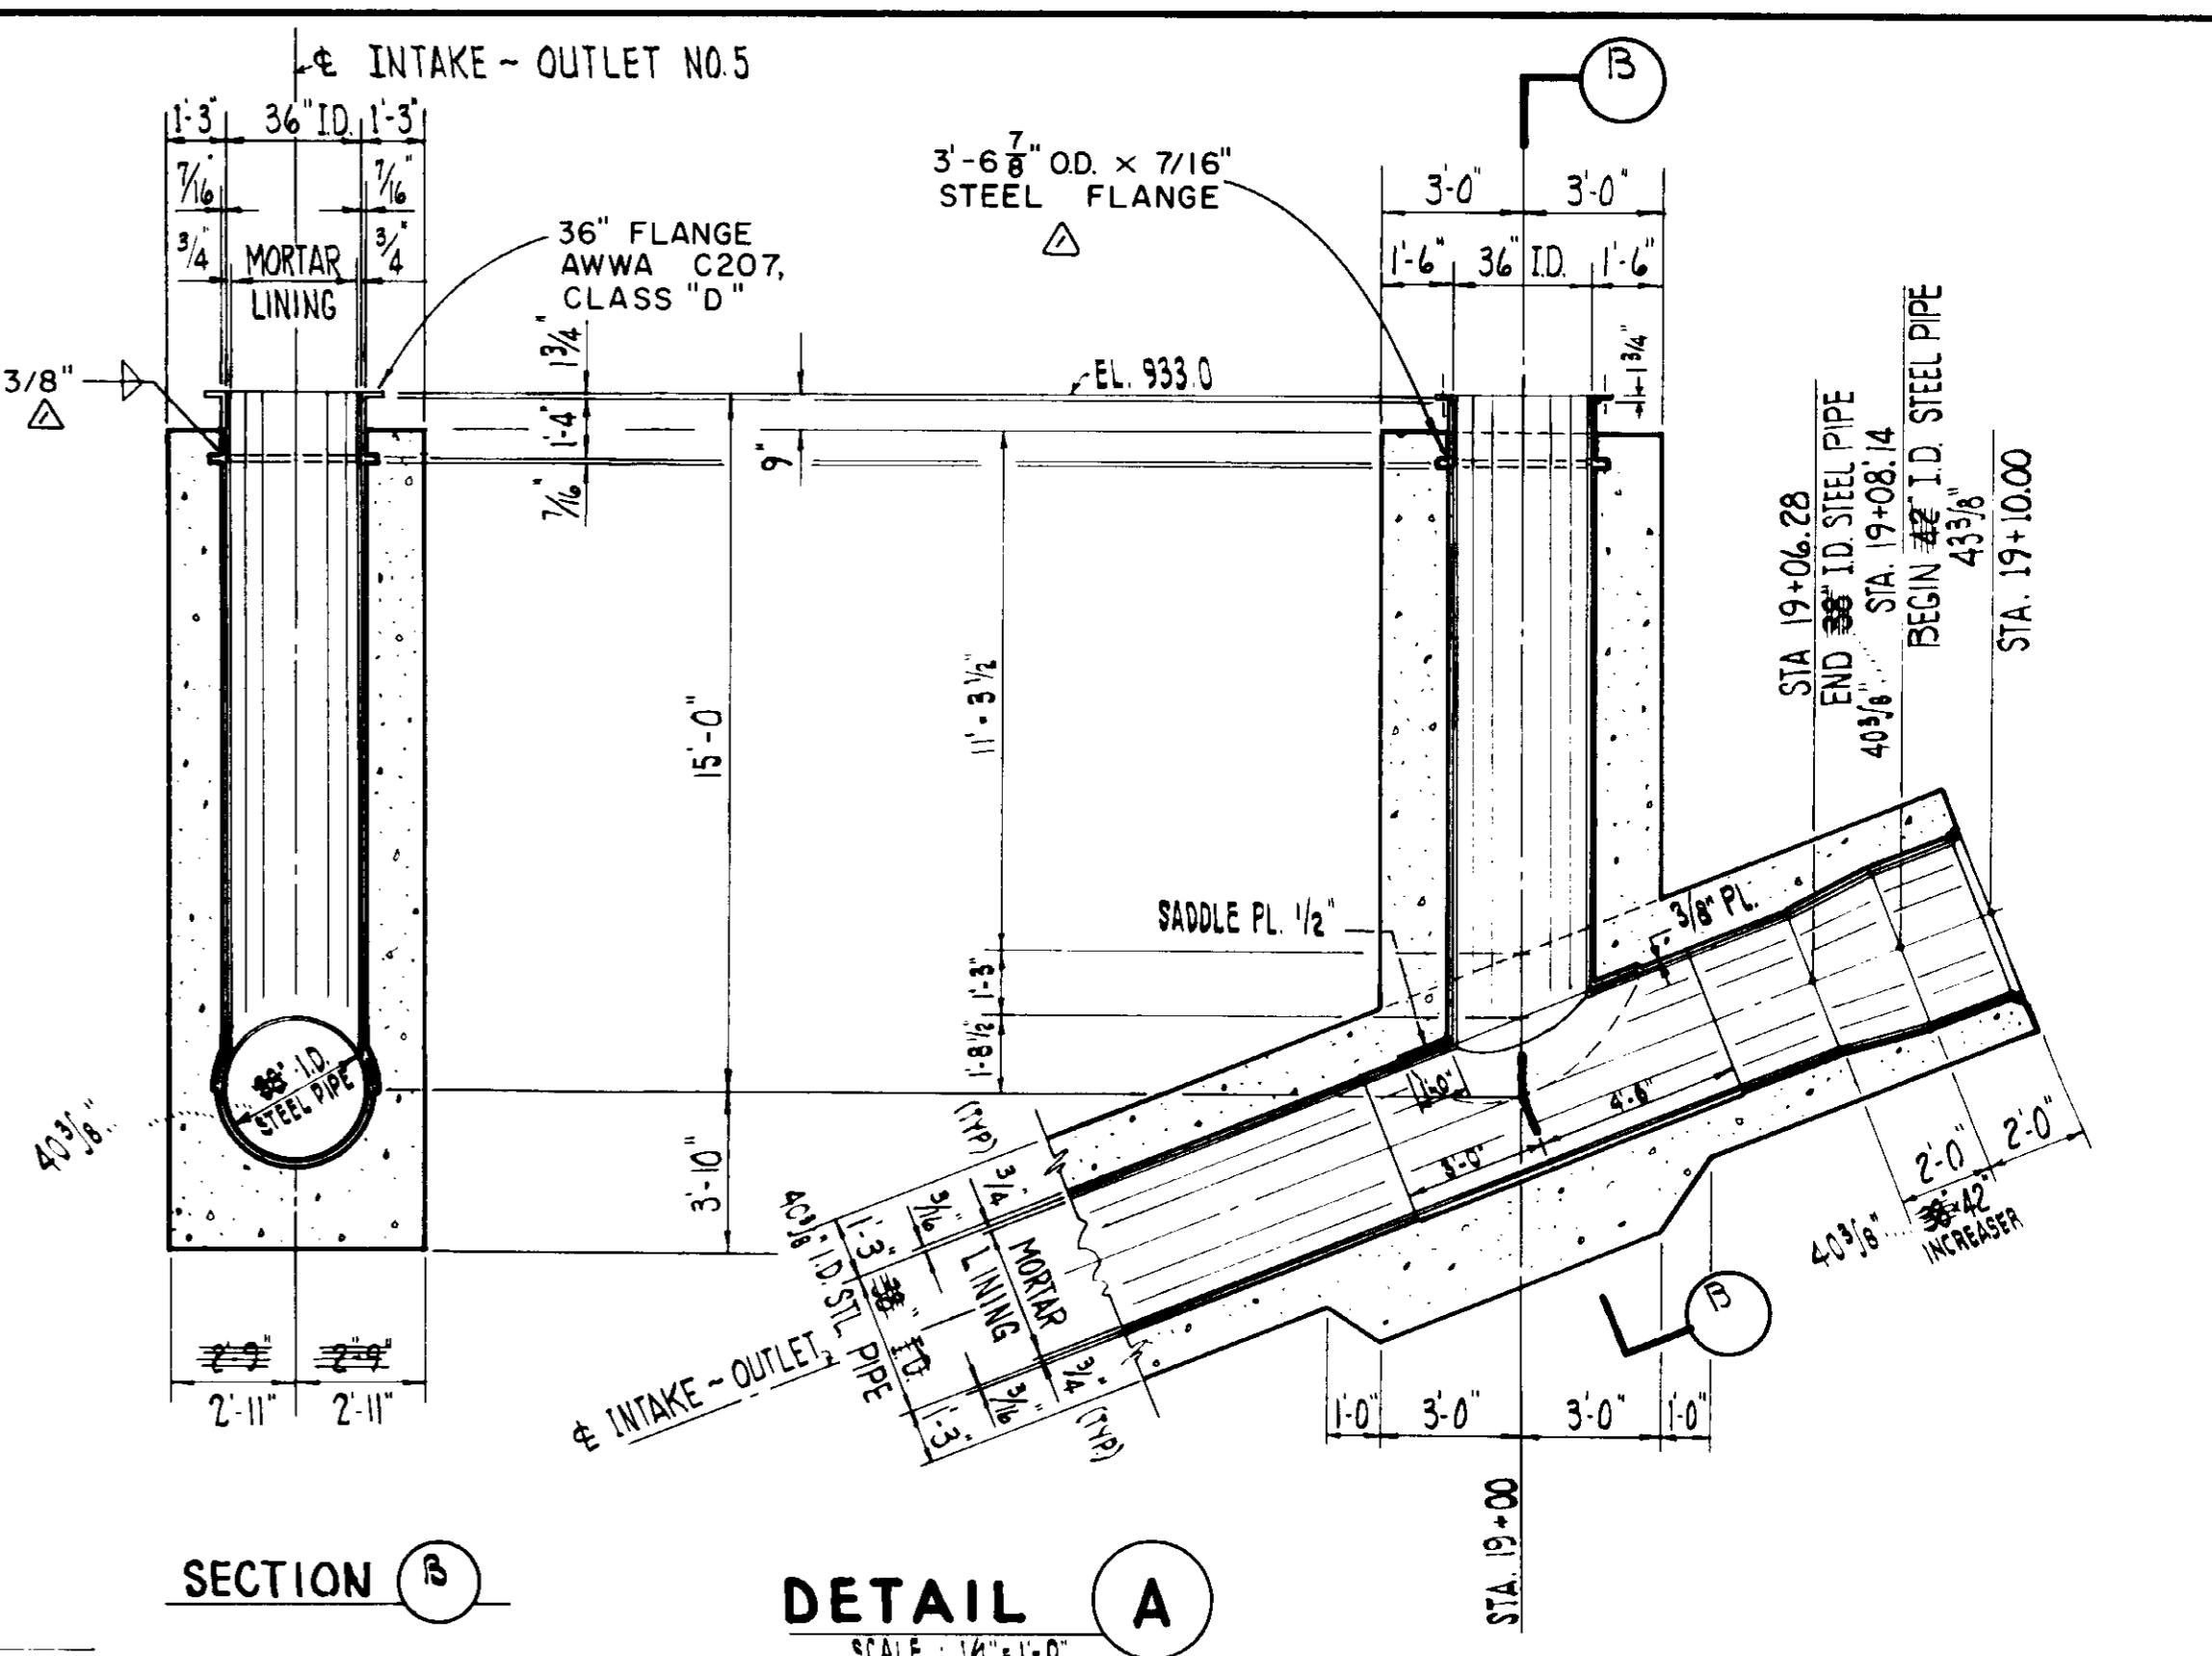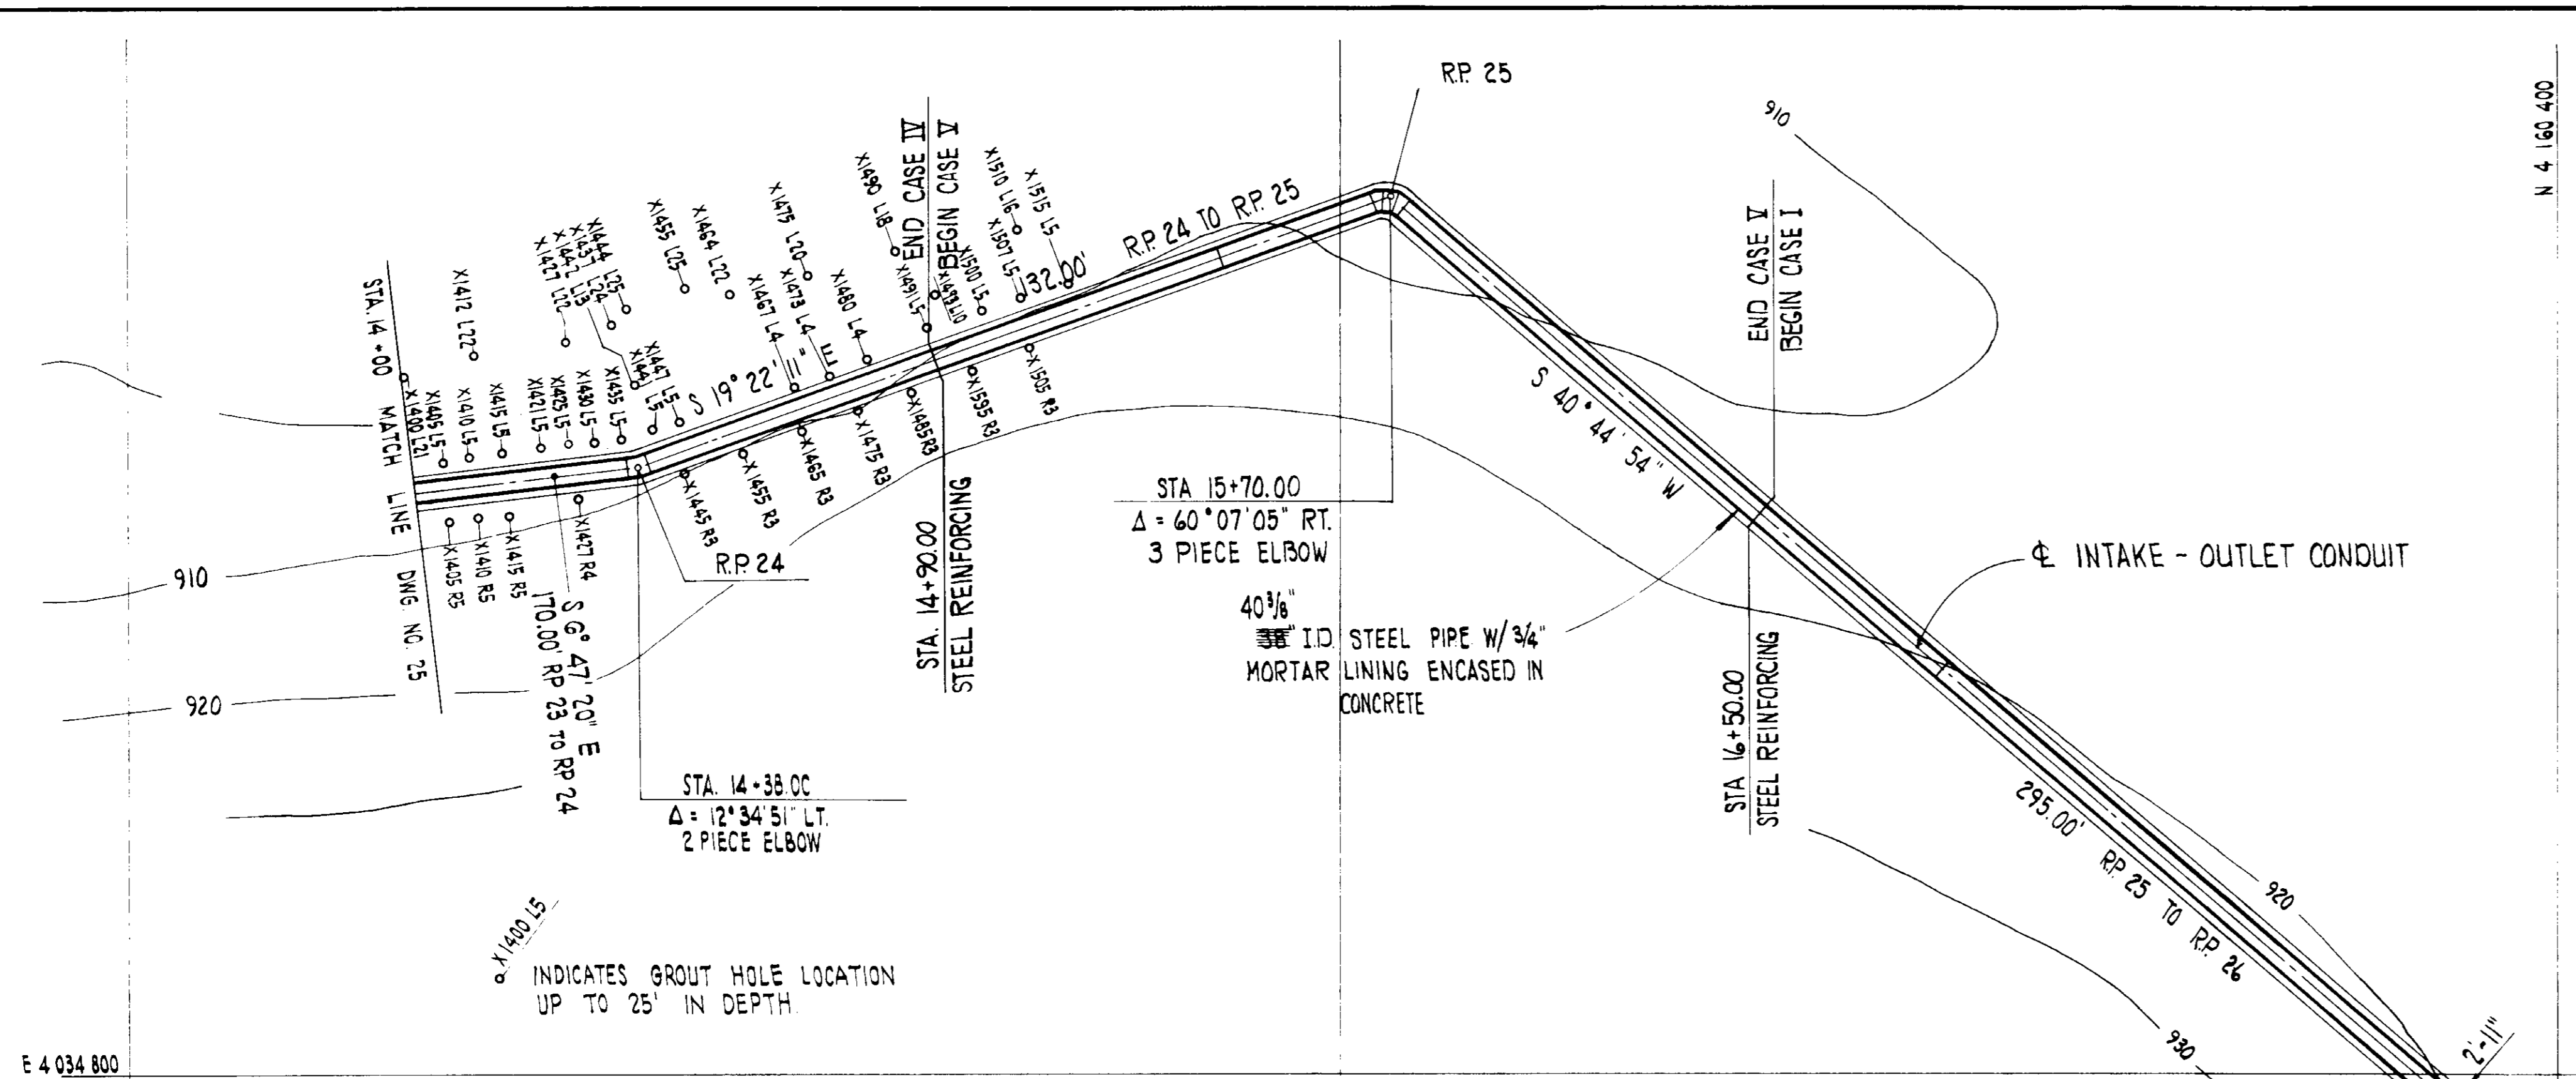

**PLAN**  
SCALE: 1" = 20'

**PROFILE**  
HORIZ. SCALE 1" = 20'  
VERT. SCALE 1" = 10'

**SECTION B**

**DETAIL A**  
SCALE: 1/4" = 1'-0"

**REFERENCE DRAWINGS**  
FOR REFERENCE DRAWINGS SEE DRAWING NO. 25

ADDITIONAL EXCAVATION TO ACCOMMODATE FUTURE EXTENSION OF PIPE. (SEE INTAKE-OUTLET DRAWINGS FOR CONTINUATION)

05288

NO.	DATE	REVISIONS	BY	CHK	JOB	PROJ.	ENG.	MGR.

**LAS VIRGENES MUNICIPAL WATER DISTRICT**

BOYLE ENGINEERING  
W. A. WAHLER & ASSOCIATES

WESTLAKE RESERVOIR

**INTAKE-OUTLET CONDUIT**  
PLAN AND PROFILE - SHEET 2 OF 2

DESIGNED: *MMW* DATE: 11-70 JOB: *D.F.M.* PROJ. ENG.: *JH*


DRAWN: *T.E.N.* CHECKED: *S.F.M.* SCALE AS SHOWN

DATE: 4/24/73


AS CONSTRUCTED

DRAWING NUMBER: 26




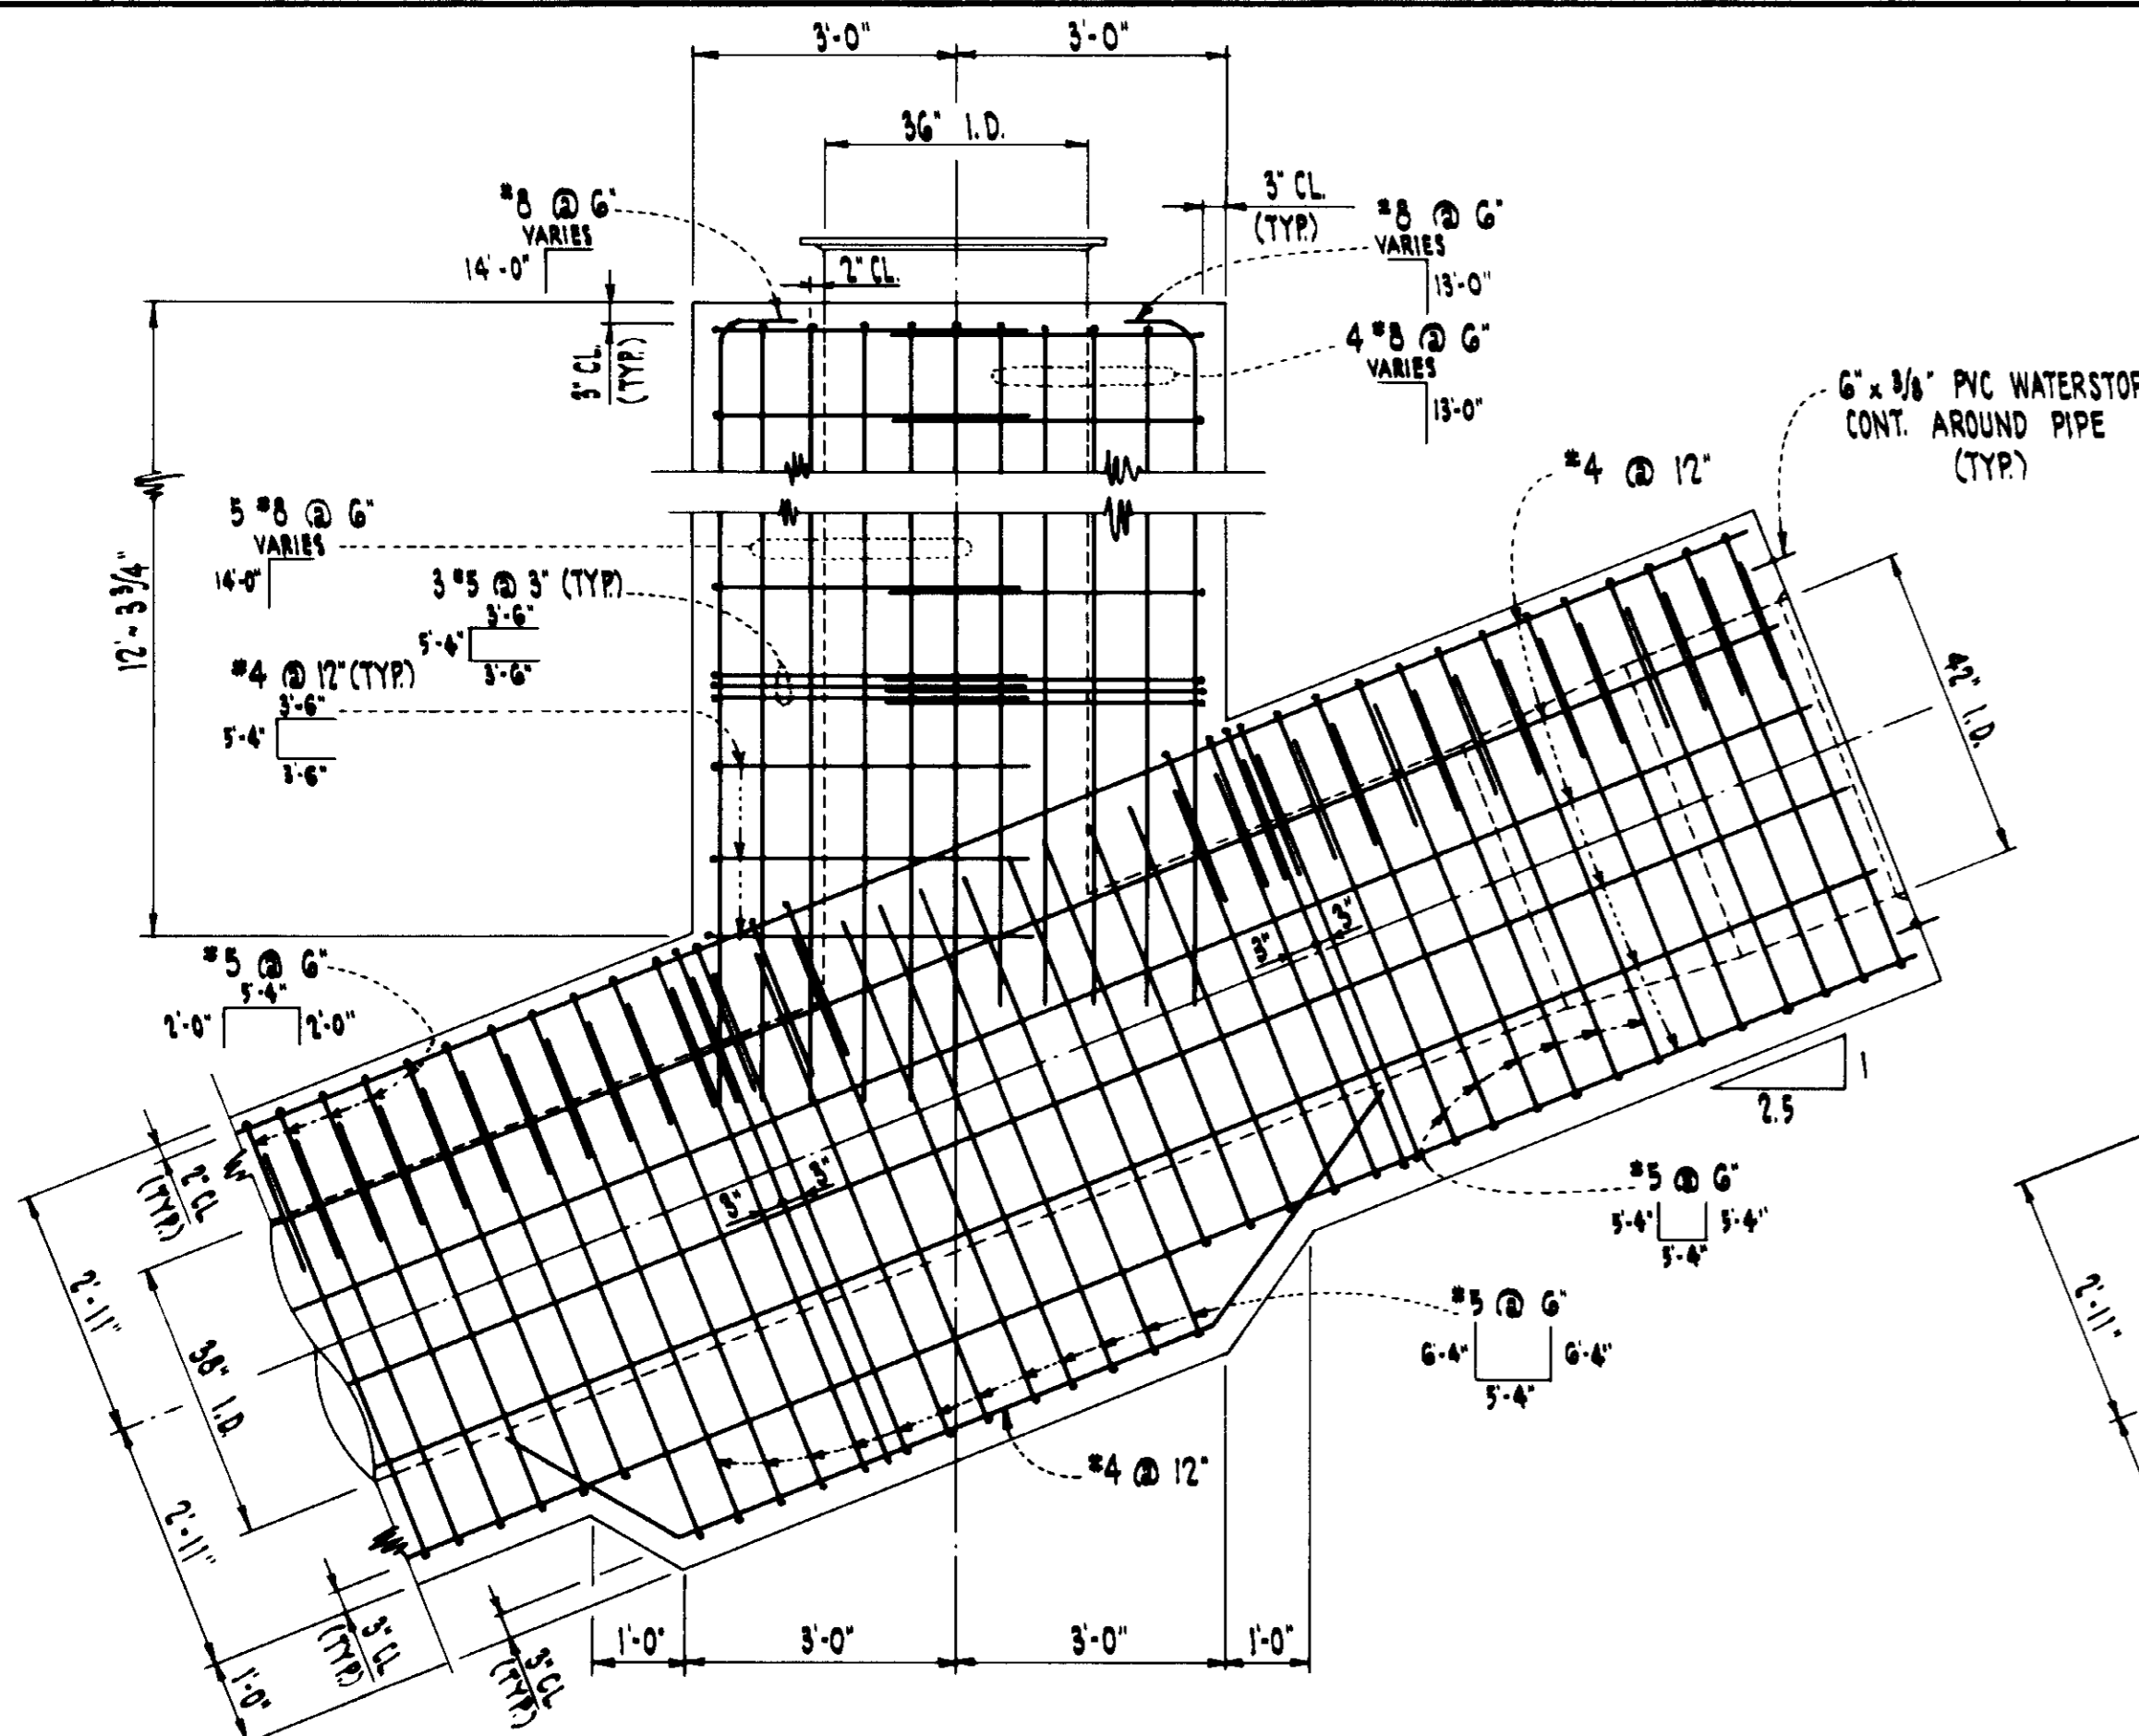


**ELEVATION - OUTSIDE LAYER REINFORCEMENT**  
**INTAKE - OUTLET NO. 5**  
 SCALE: 1/2" = 1'-0"

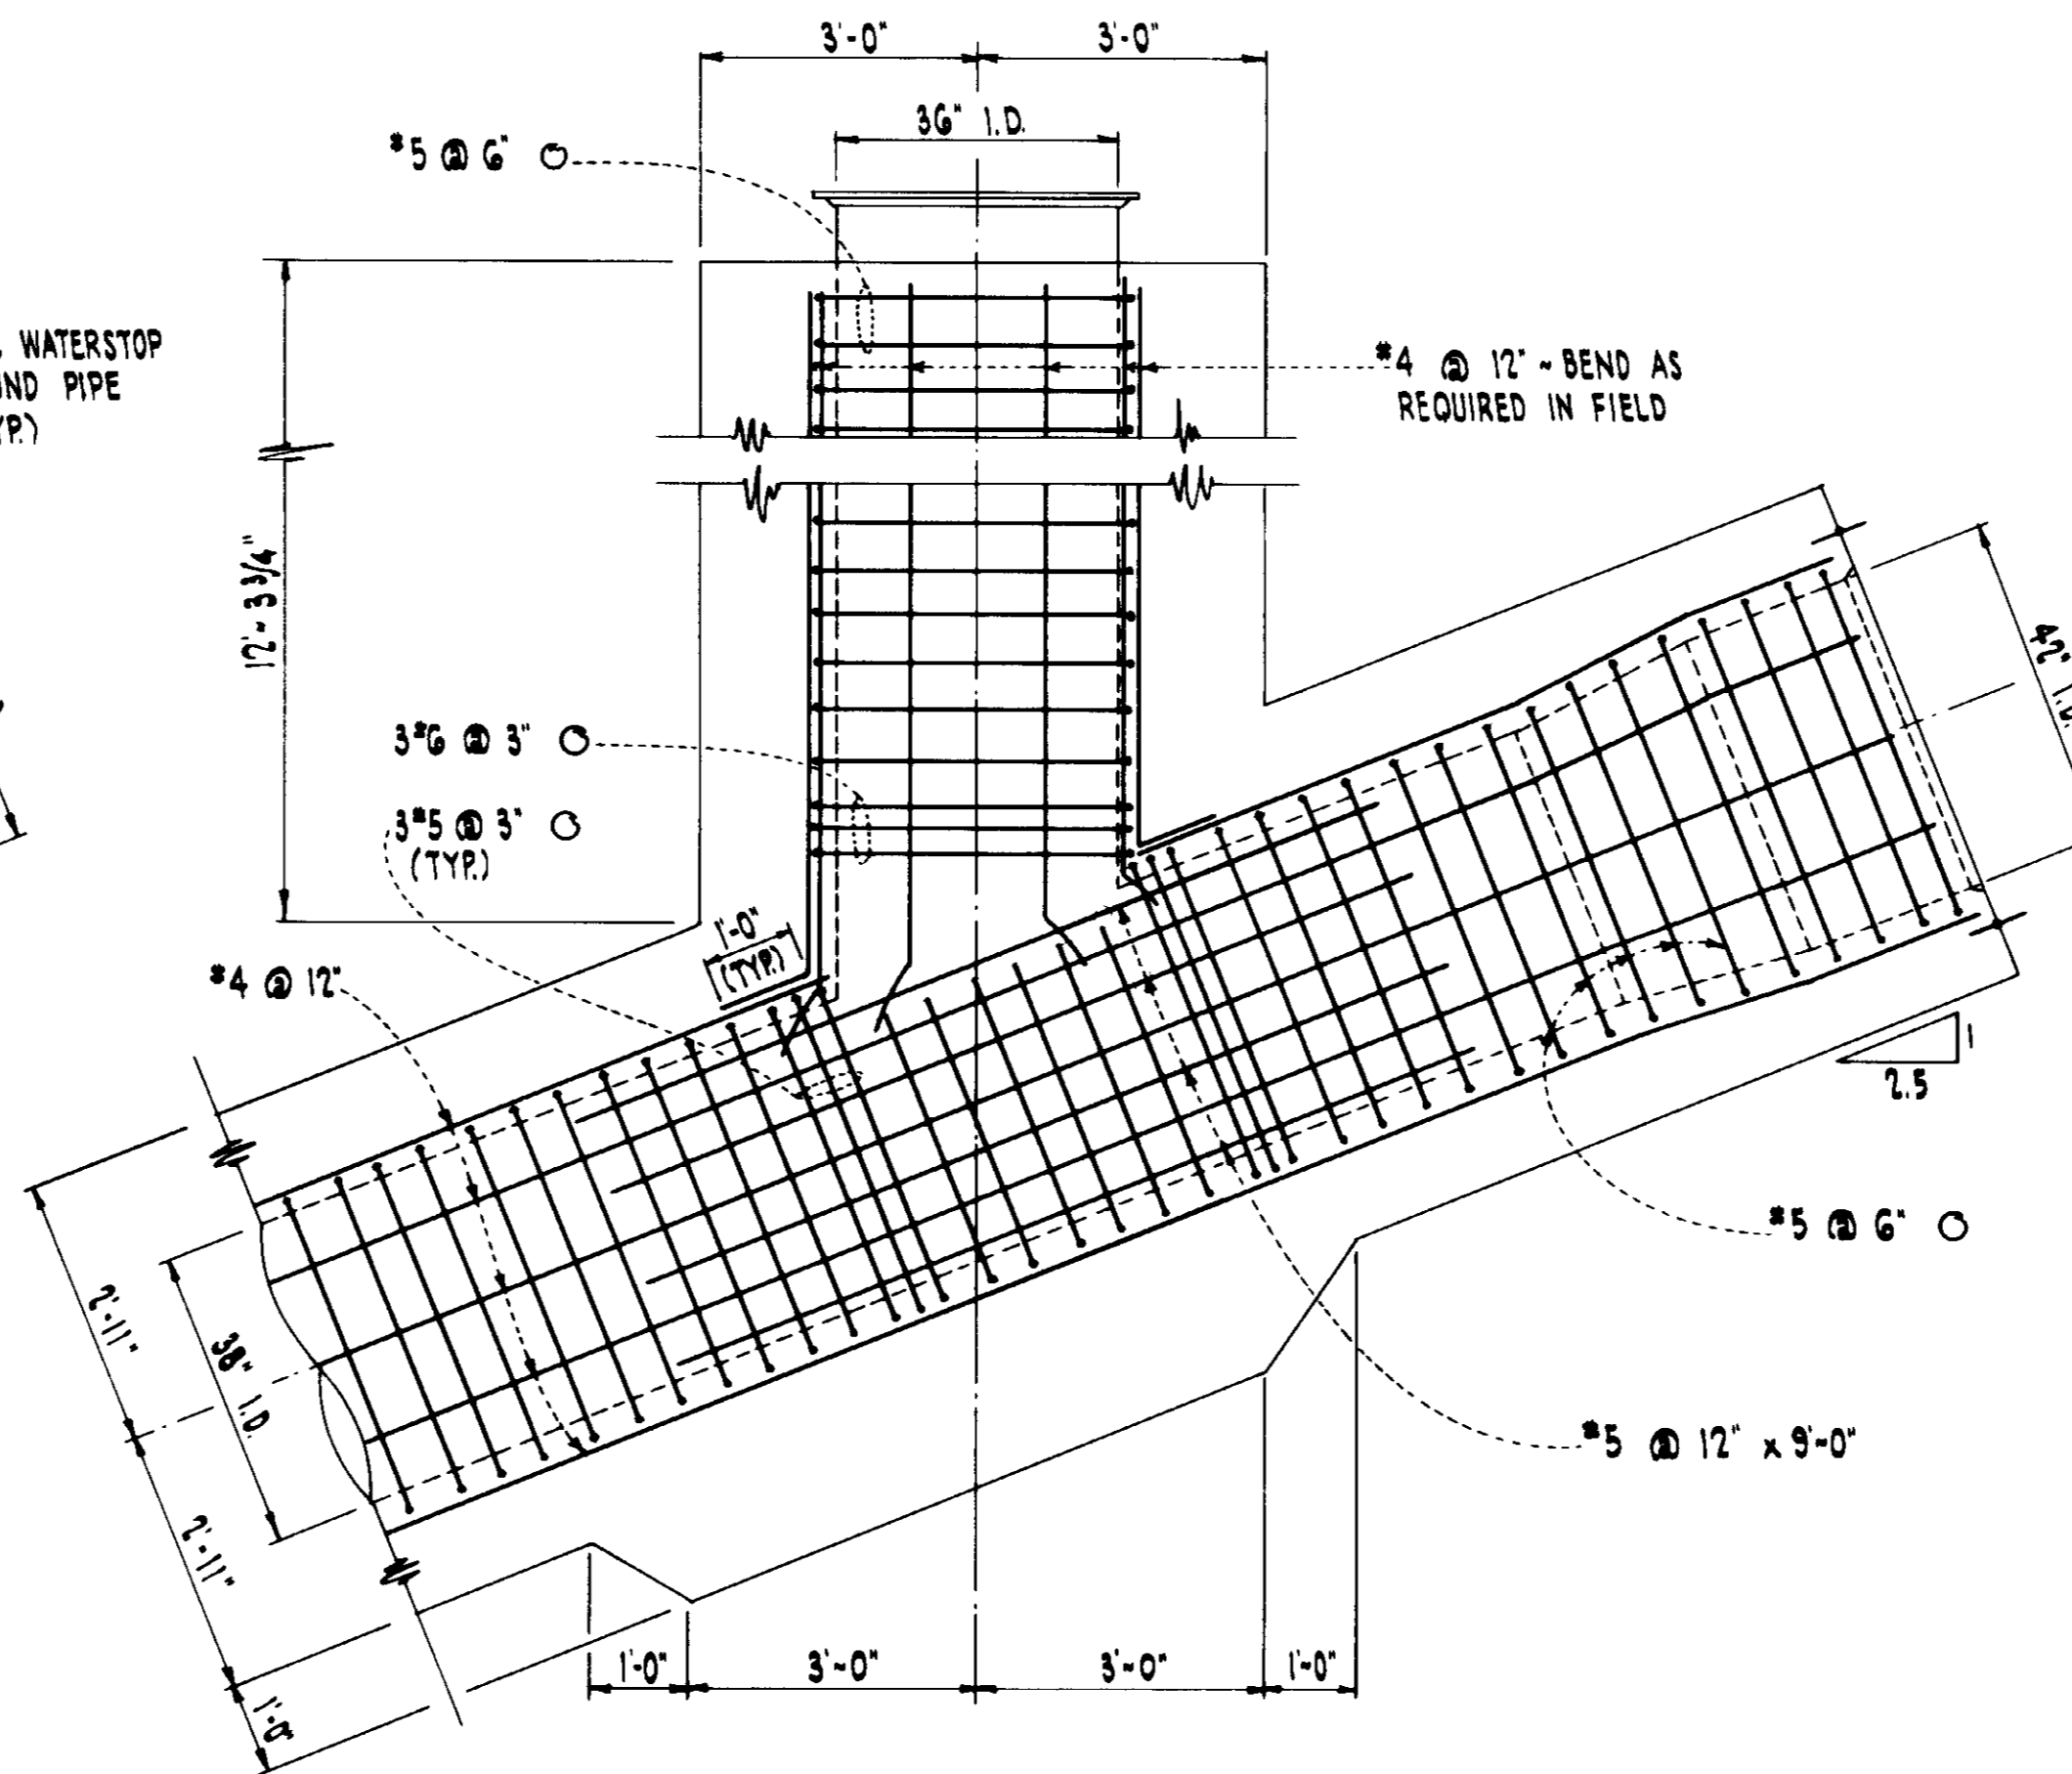

**ELEVATION - INSIDE LAYER REINFORCEMENT**  
**INTAKE - OUTLET NO. 5**  
 SCALE: 1/2" = 1'-0"

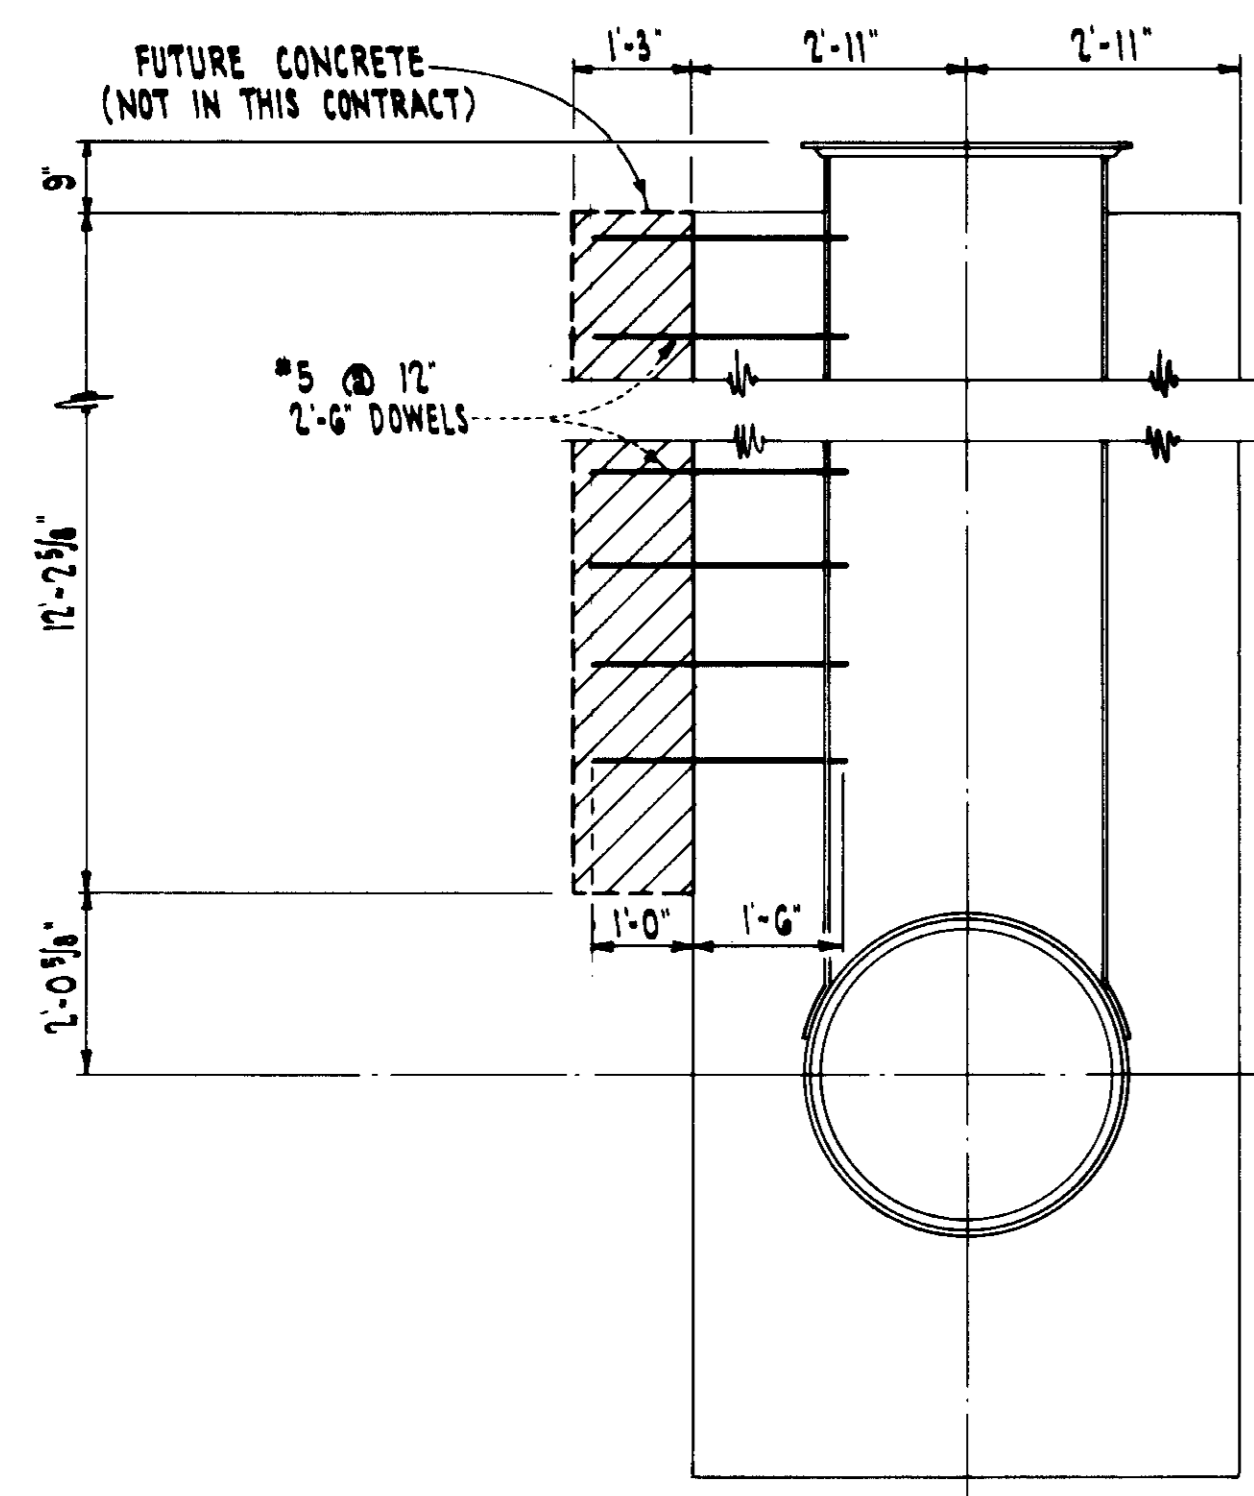

**SECTION - SECOND STAGE REINFORCEMENT**  
**INTAKE - OUTLET NO. 5**  
 SCALE: 1/2" = 1'-0"

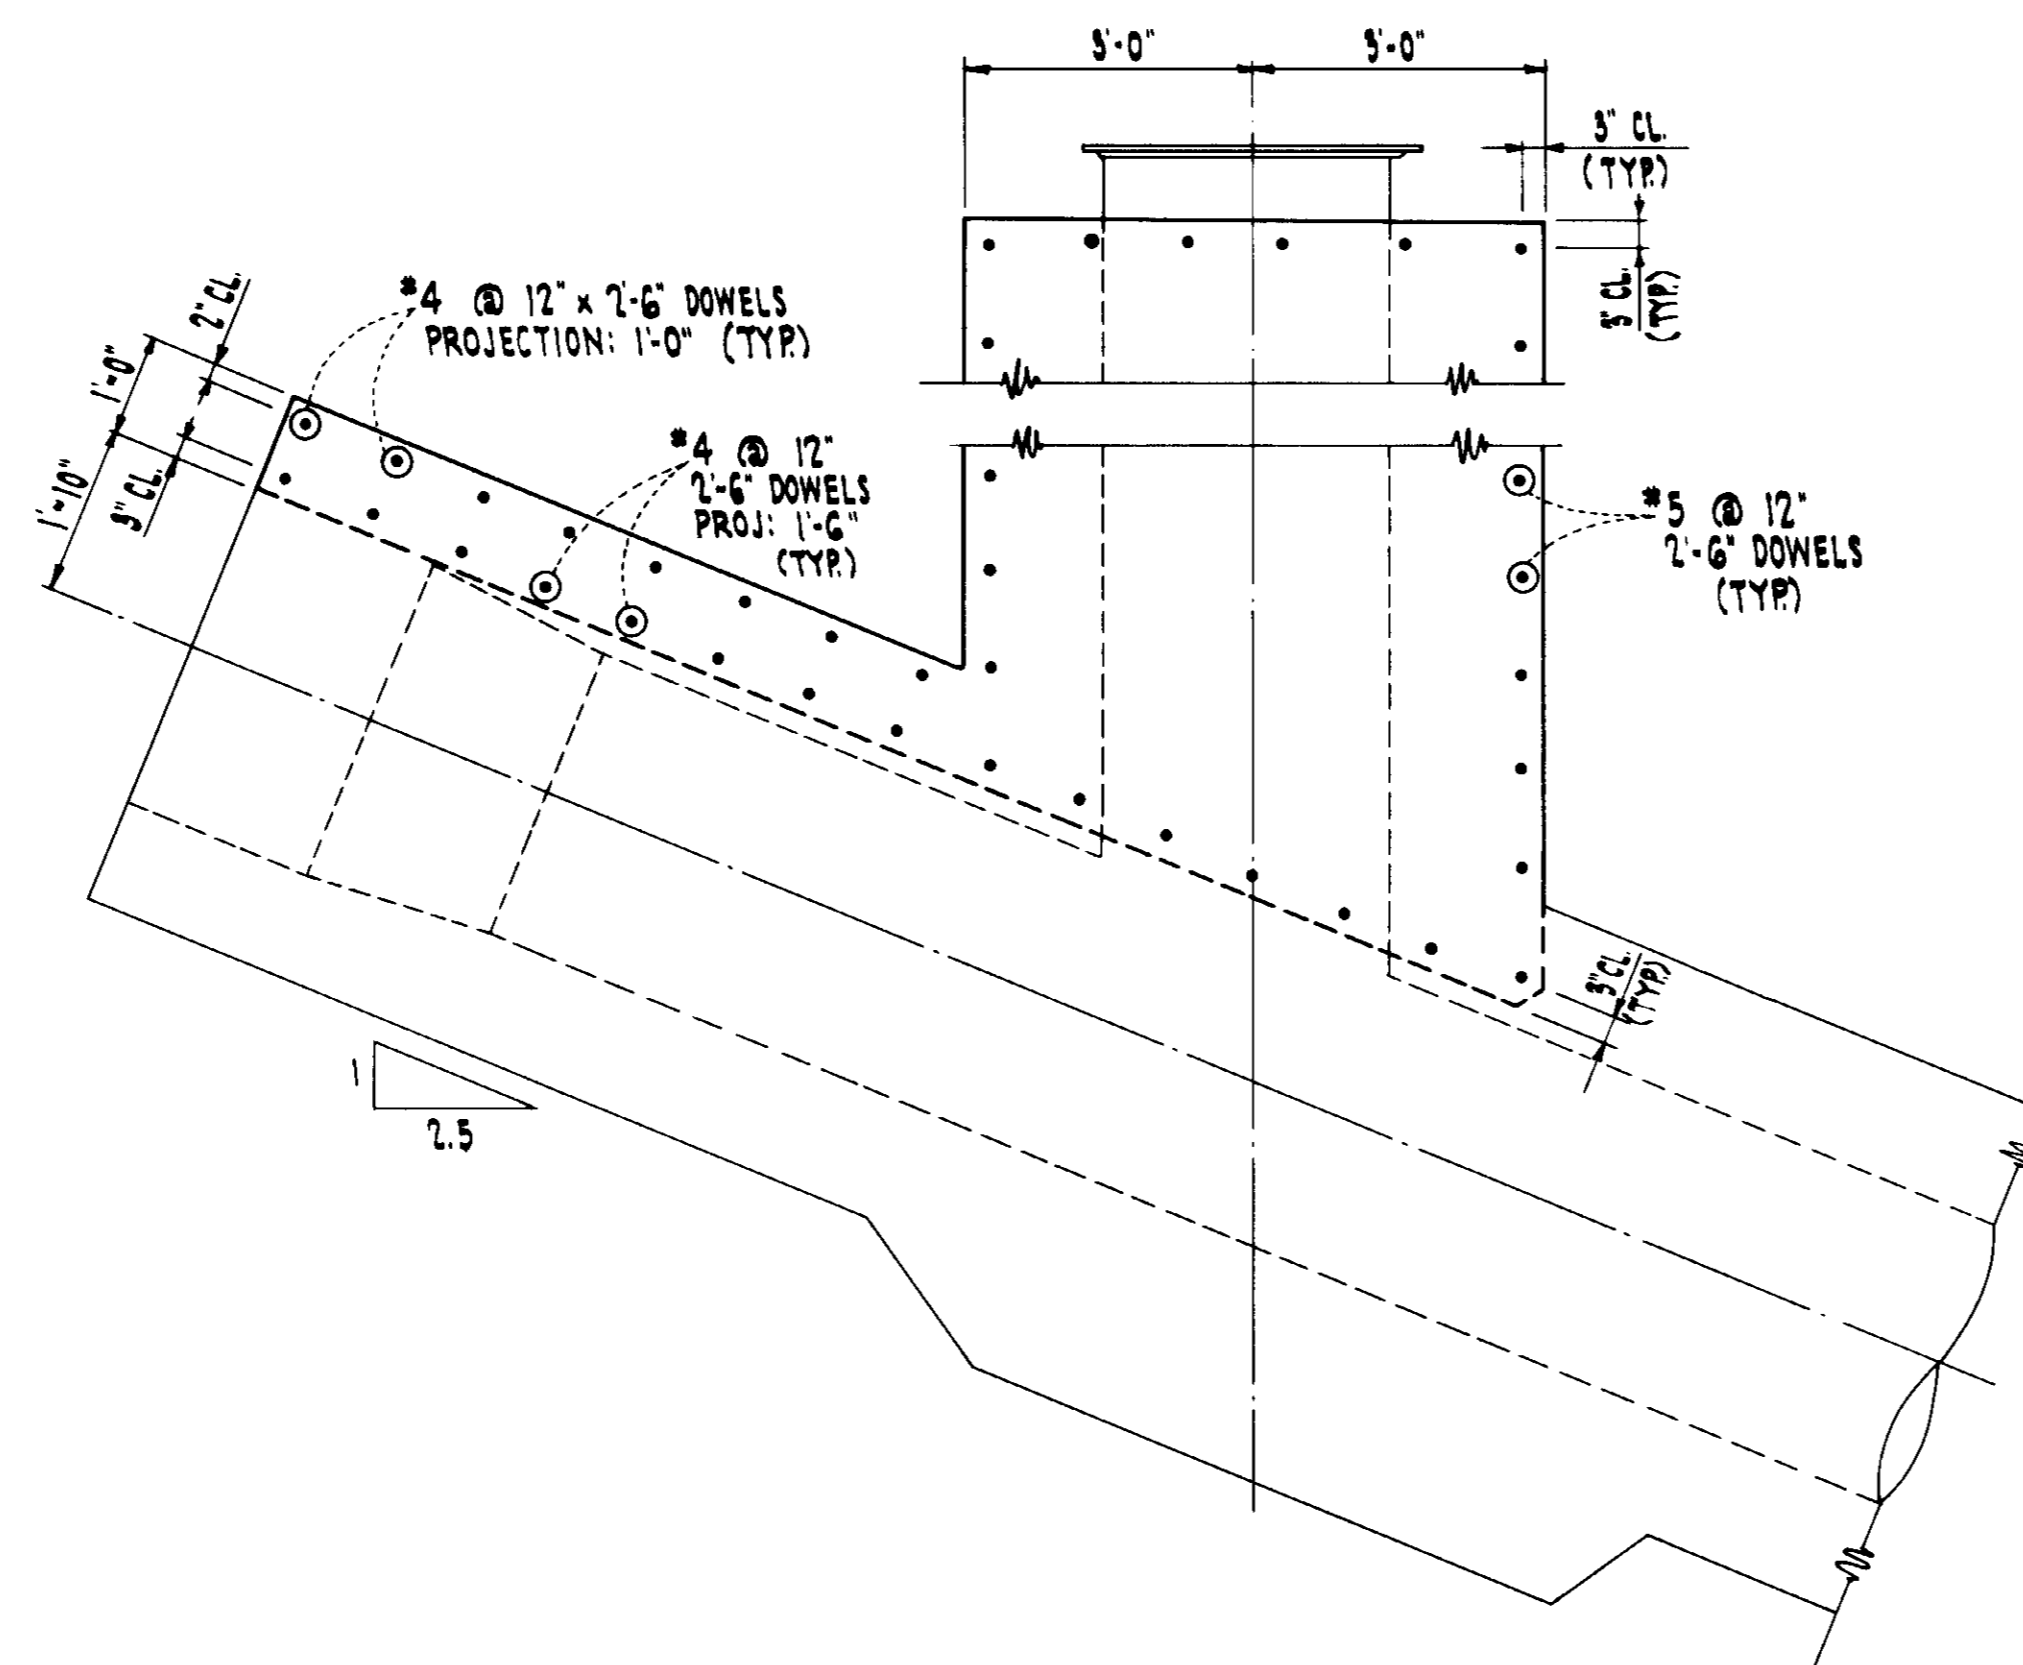

**ELEVATION - SECOND STAGE REINFORCEMENT**  
**INTAKE - OUTLET NO. 5**  
 SCALE: 1/2" = 1'-0"

REFERENCE DRAWINGS  
 FOR REFERENCE DRAWINGS SEE SHEET NO. 25

**05289**


LAS VIRGENES  
 MUNICIPAL WATER DISTRICT  
 WESTLAKE RESERVOIR

**INTAKE - OUTLET**  
 REINFORCING DETAILS

**AS CONSTRUCTED**  
 DATE 4/24/73 DFT 98.09.88 CKD DFM


NO.	DATE	DESCRIPTION	BY	APP.
1	4-29-71	ISSUED FOR CONSTRUCTION	P.P.E.	J.S.H.
REVISION				
DESIGNED BY P.P.E. DRAWN BY H.P.S. CHECKED BY J.S.H.				

SCALE: 1/2" = 1'-0"  
**BOYLE ENGINEERING**  
 SAN DIEGO SANTA ANA BAKERSFIELD VENTURA  
 DATE: MAR. 1971  
 SHEET NO. **26 A**  
 OF 35 SHEETS  
 84-2577-00

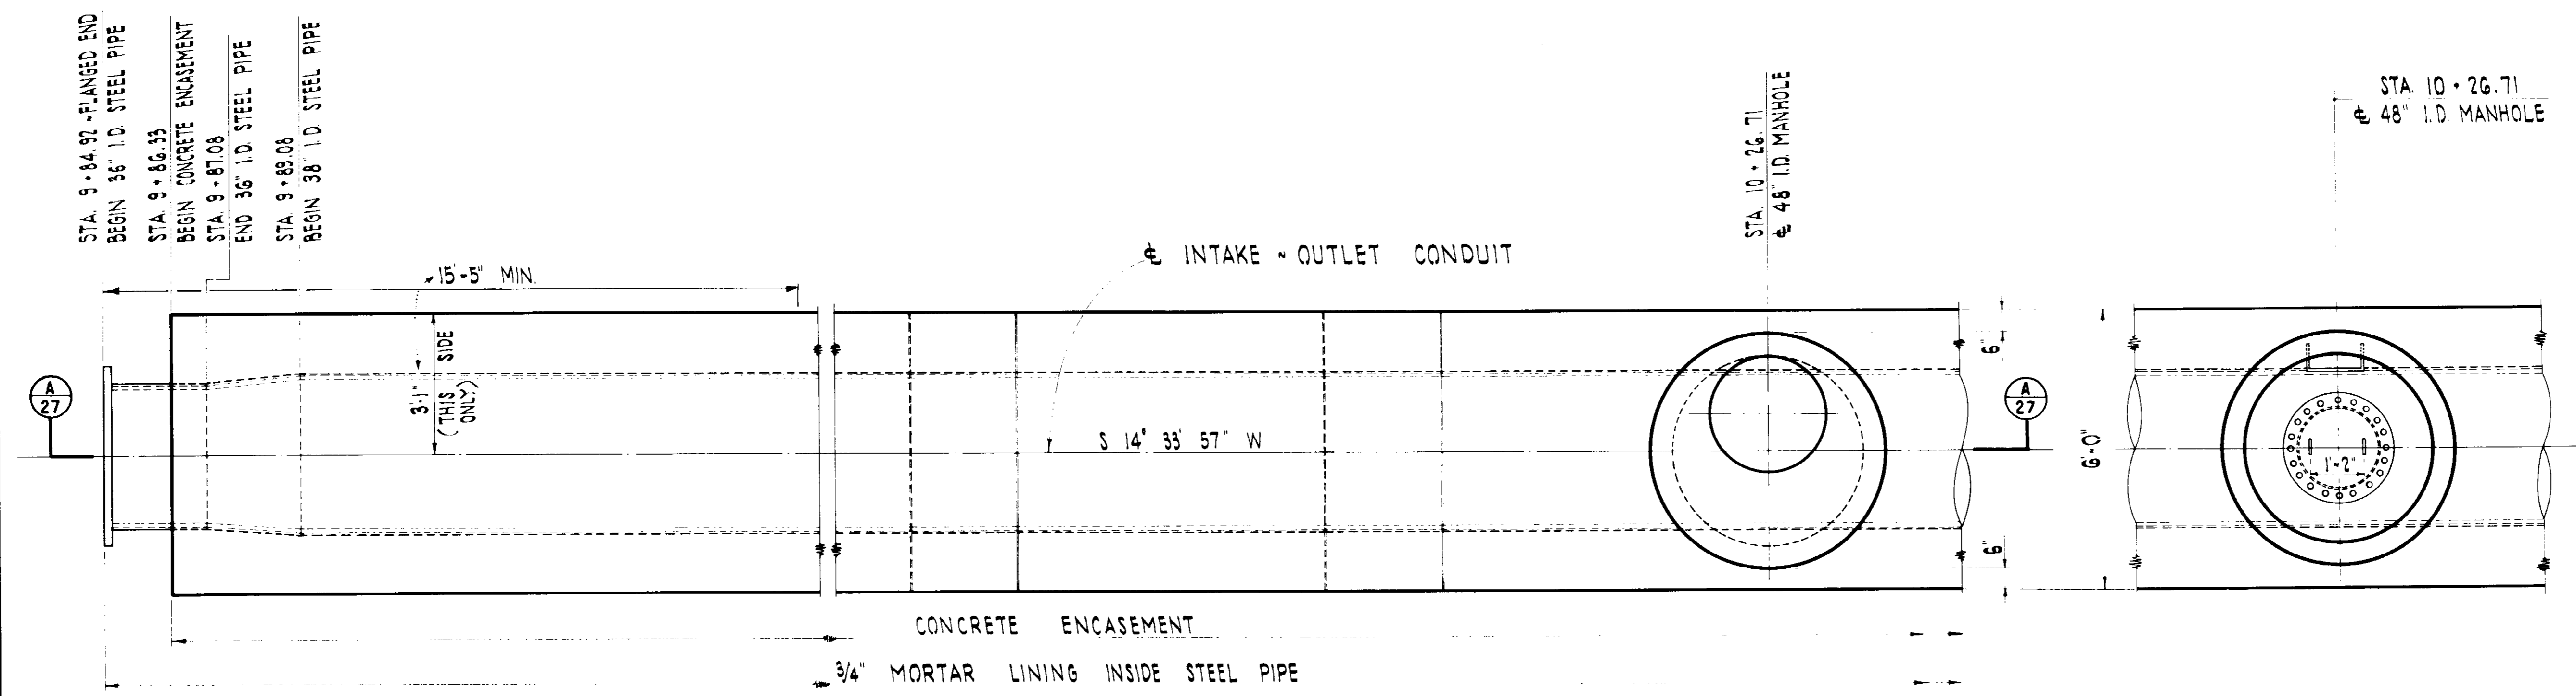

**PLAN**  
SCALE: 1/2" = 1'-0"

PLAN-BELOW TOP SLAB OF M.H.

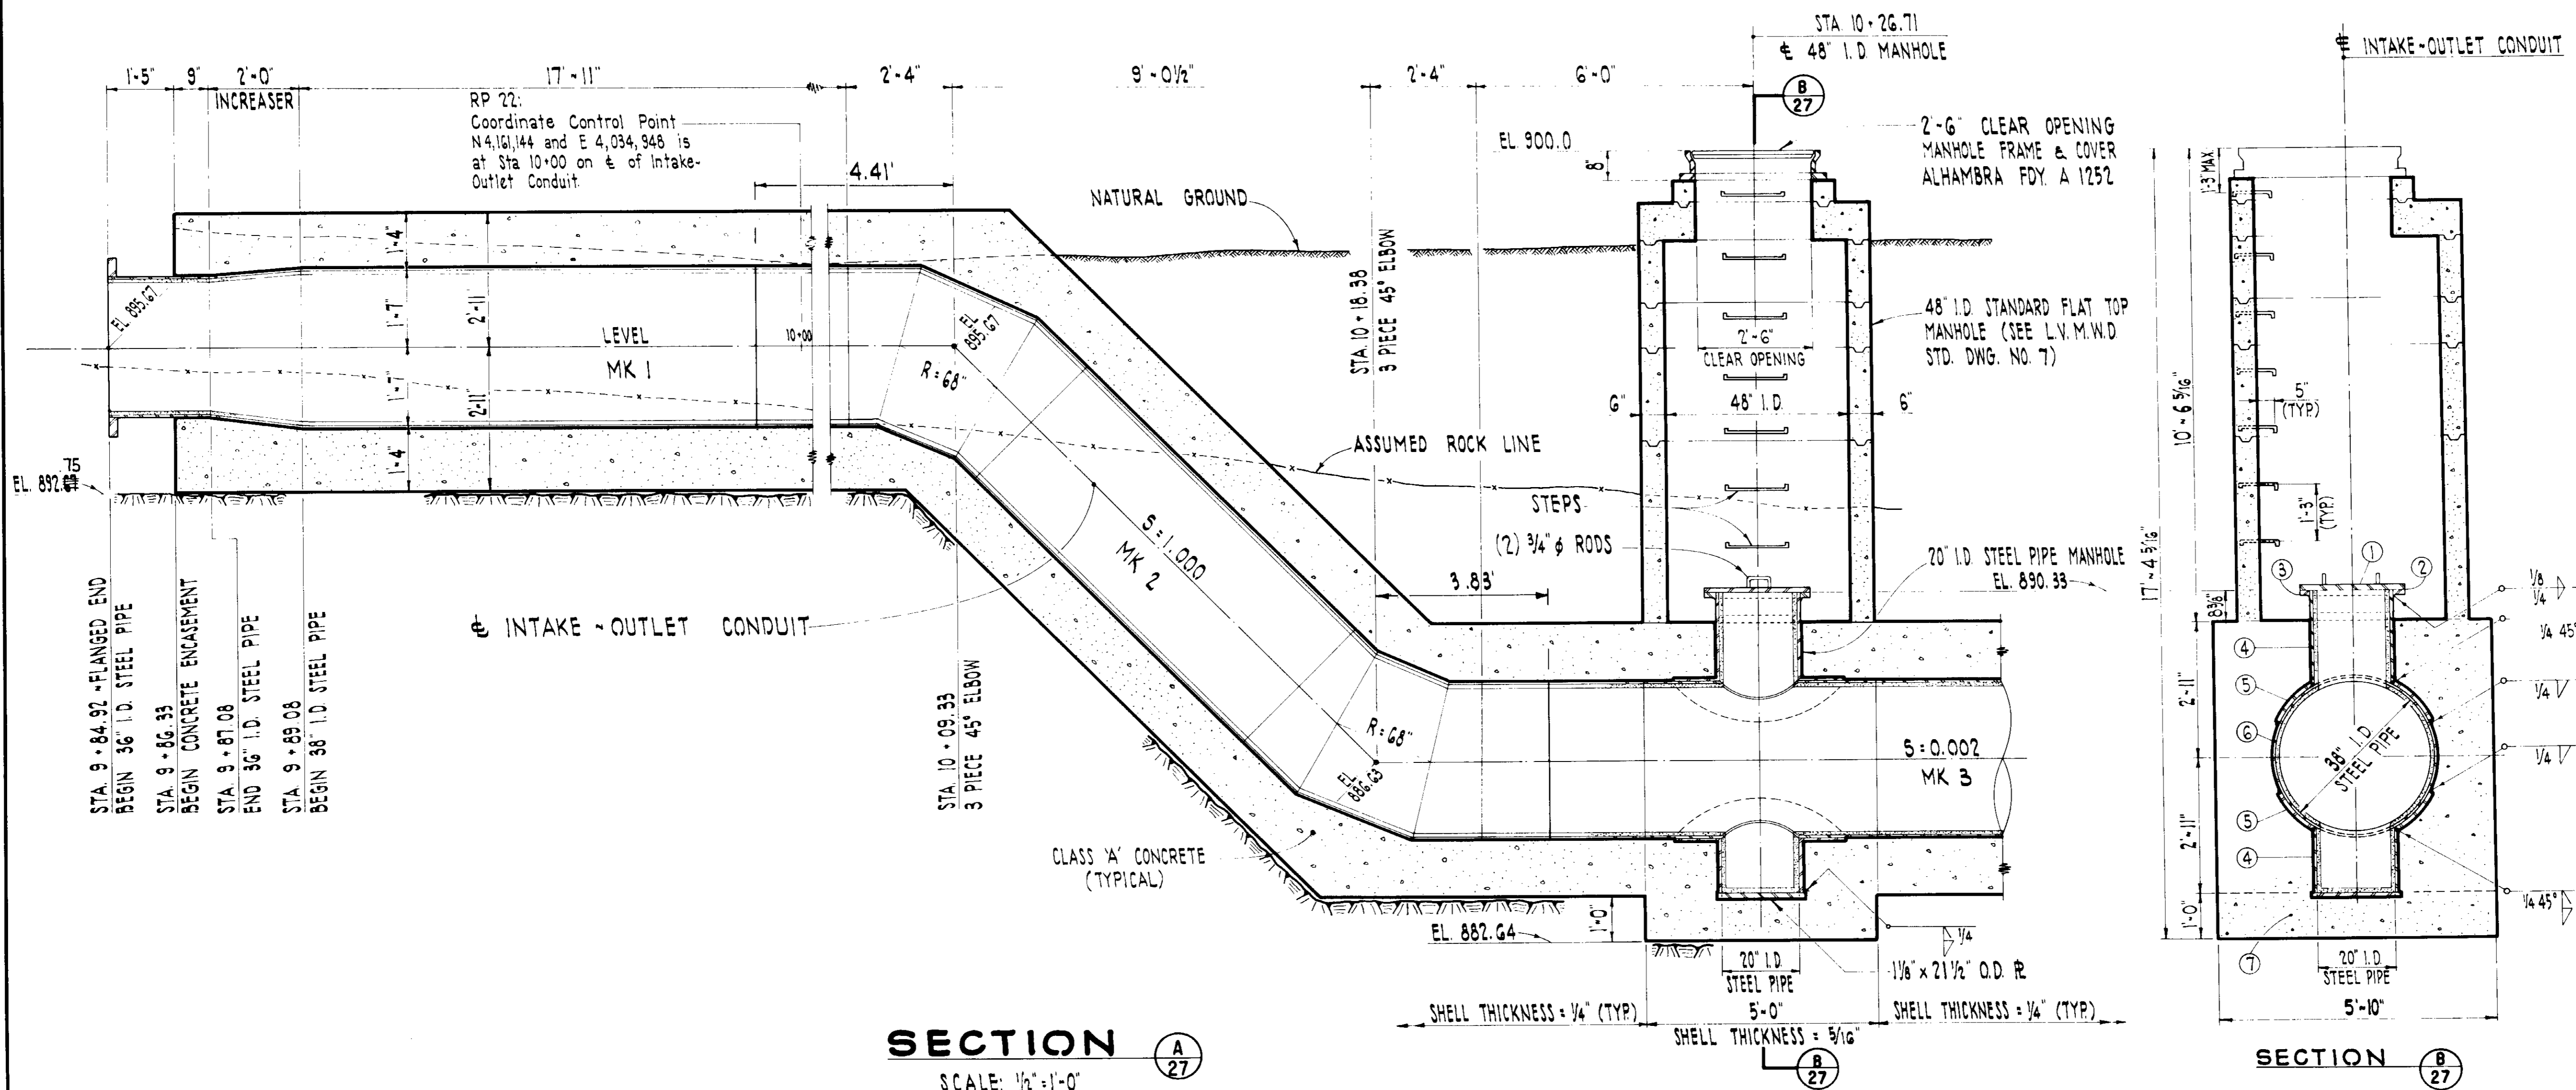

**SECTION**  
SCALE: 1/2" = 1'-0"

**SECTION**

**NOTES**

- Manhole steps shall be 3/4" galv. steel embedded in manhole wall. Alhambra Fdy. A 3315 or equal.
- 20" I.D. steel pipe manhole shall conform to applicable sections of AWWA Standards C207 and C208.
- Mortar lining shall be refinished in the field to provide 3/4" minimum cover for all exposed steel inside surfaces.
- All exposed steel surfaces shall be painted with coal tar enamel in conformance with AWWA Std C203 for above ground conditions; Section 5.


**AS CONSTRUCTED**  
DATE 4/24/73 DFI [Signature] CKD [Signature]

**LIST OF MATERIALS**


ITEM NO.	DESCRIPTION
①	27 1/2" O.D. x 1 1/8" steel plate with 3/4" ϕ rod handles - use washers and galvanize.
②	1/16" cloth inserted rubber sheet packing gasket. (Fed. Spec. H-H-P-151).
③	27 1/2" O.D. AWWA C207-55 Class D steel hub flange.
④	20" I.D. x 5/16" wall steel pipe with 3/4" mortar lining.
⑤	12" x 5/16" steel collar welded to pipe.
⑥	36" I.D. x 3/16" wall steel pipe with 3/4" mortar lining.
⑦	Concrete encasement.

**REFERENCE DRAWINGS**

25 PLAN AND PROFILE - SHEET 1 OF 3

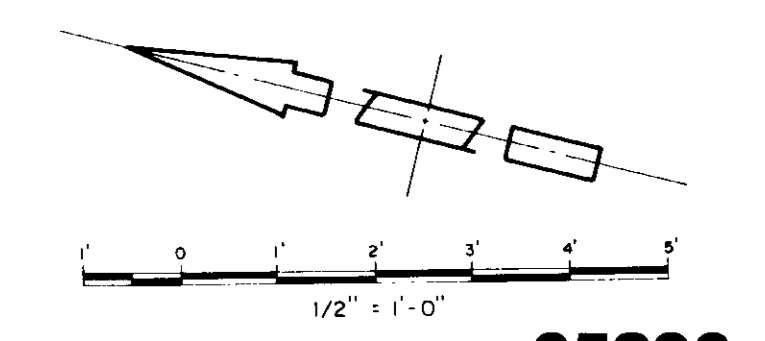


<b>LAS VIRGENES MUNICIPAL WATER DISTRICT</b>			
BOYLE ENGINEERING W. A. WAHLER & ASSOCIATES			
WESTLAKE RESERVOIR			
<b>INTAKE-OUTLET CONDUIT</b>			
DETAILS - SHEET 1 OF 2			
DESIGNED [Signature]	DATE: 11-70	JOB ENG. [Signature]	PROJ. ENG. [Signature]
DRAWN [Signature]		CHECKED [Signature]	DRAWING NUMBER
			27
SCALE AS SHOWN			

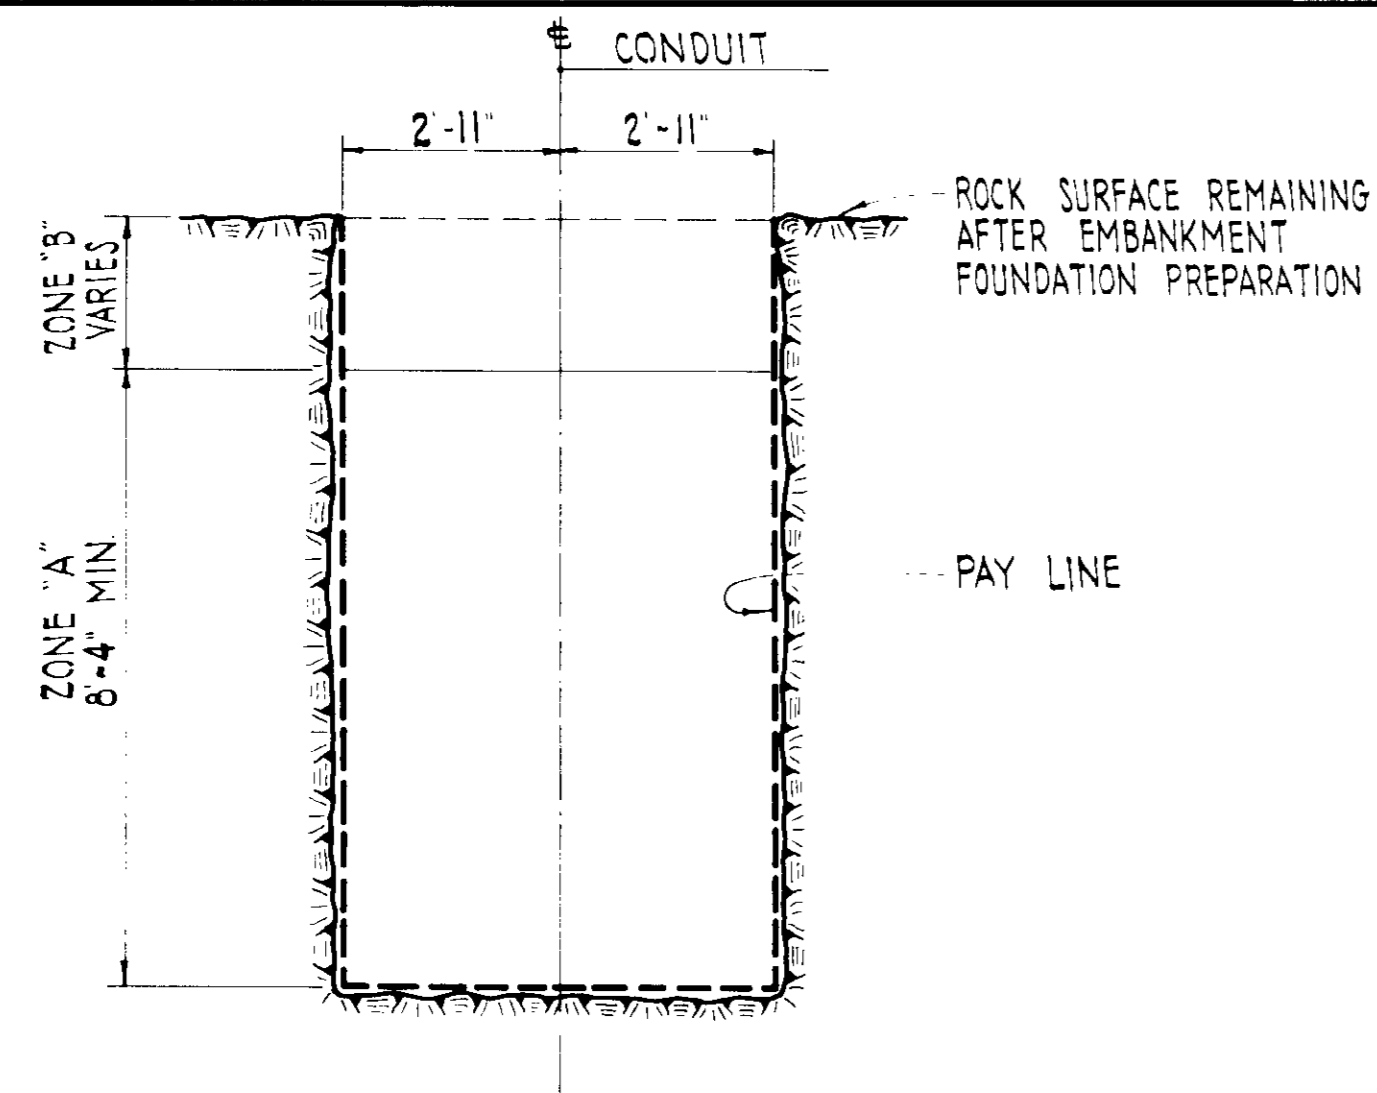


TYPICAL SECTION  
CONDUIT TRENCH EXCAVATION

SCALE: 3/8" = 1'-0"

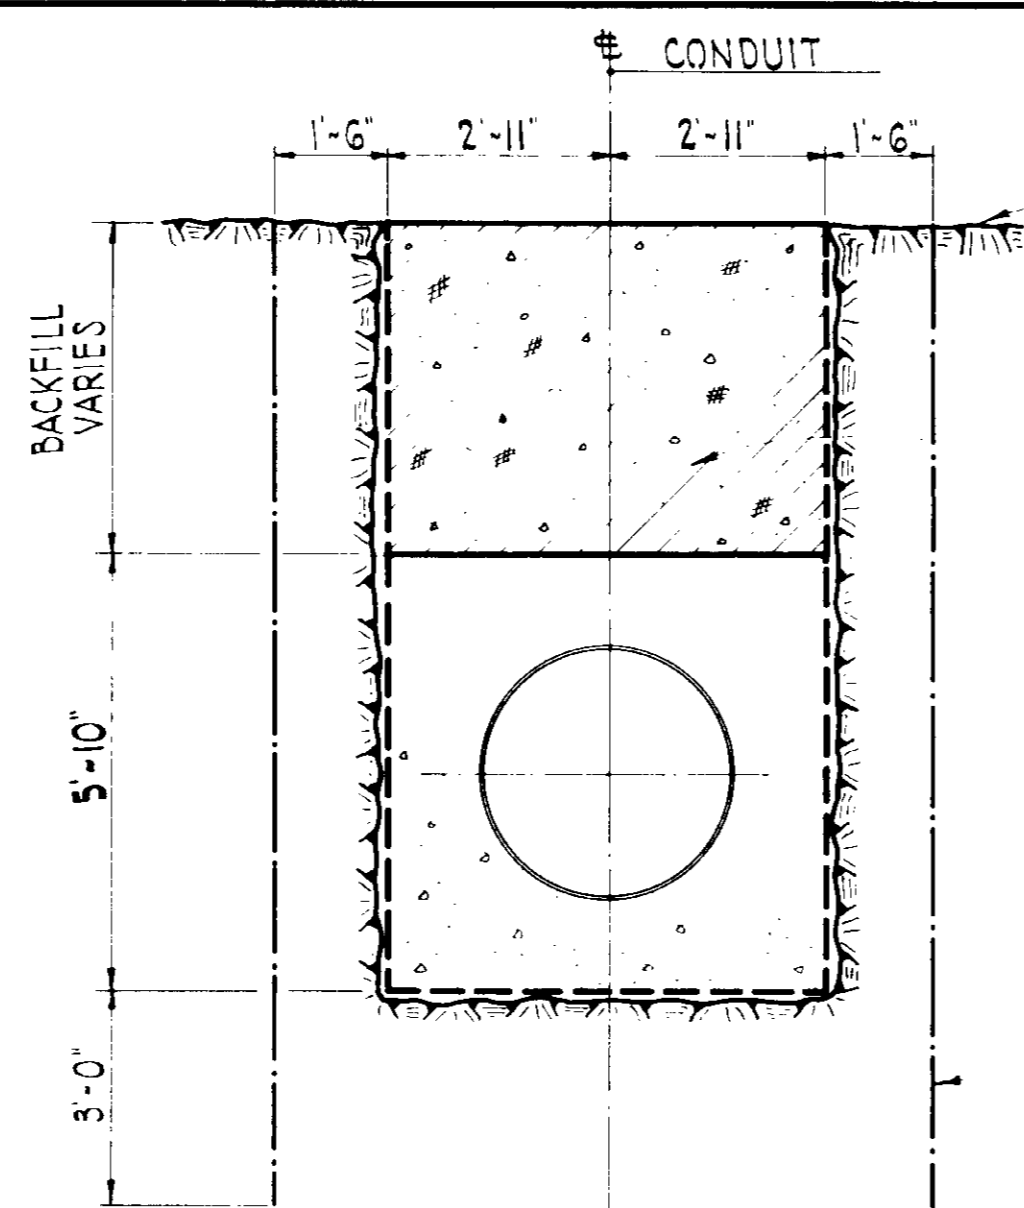

TYPICAL SECTION  
CONDUIT BACKFILL FOR ZONE 1

SCALE: 3/8" = 1'-0"

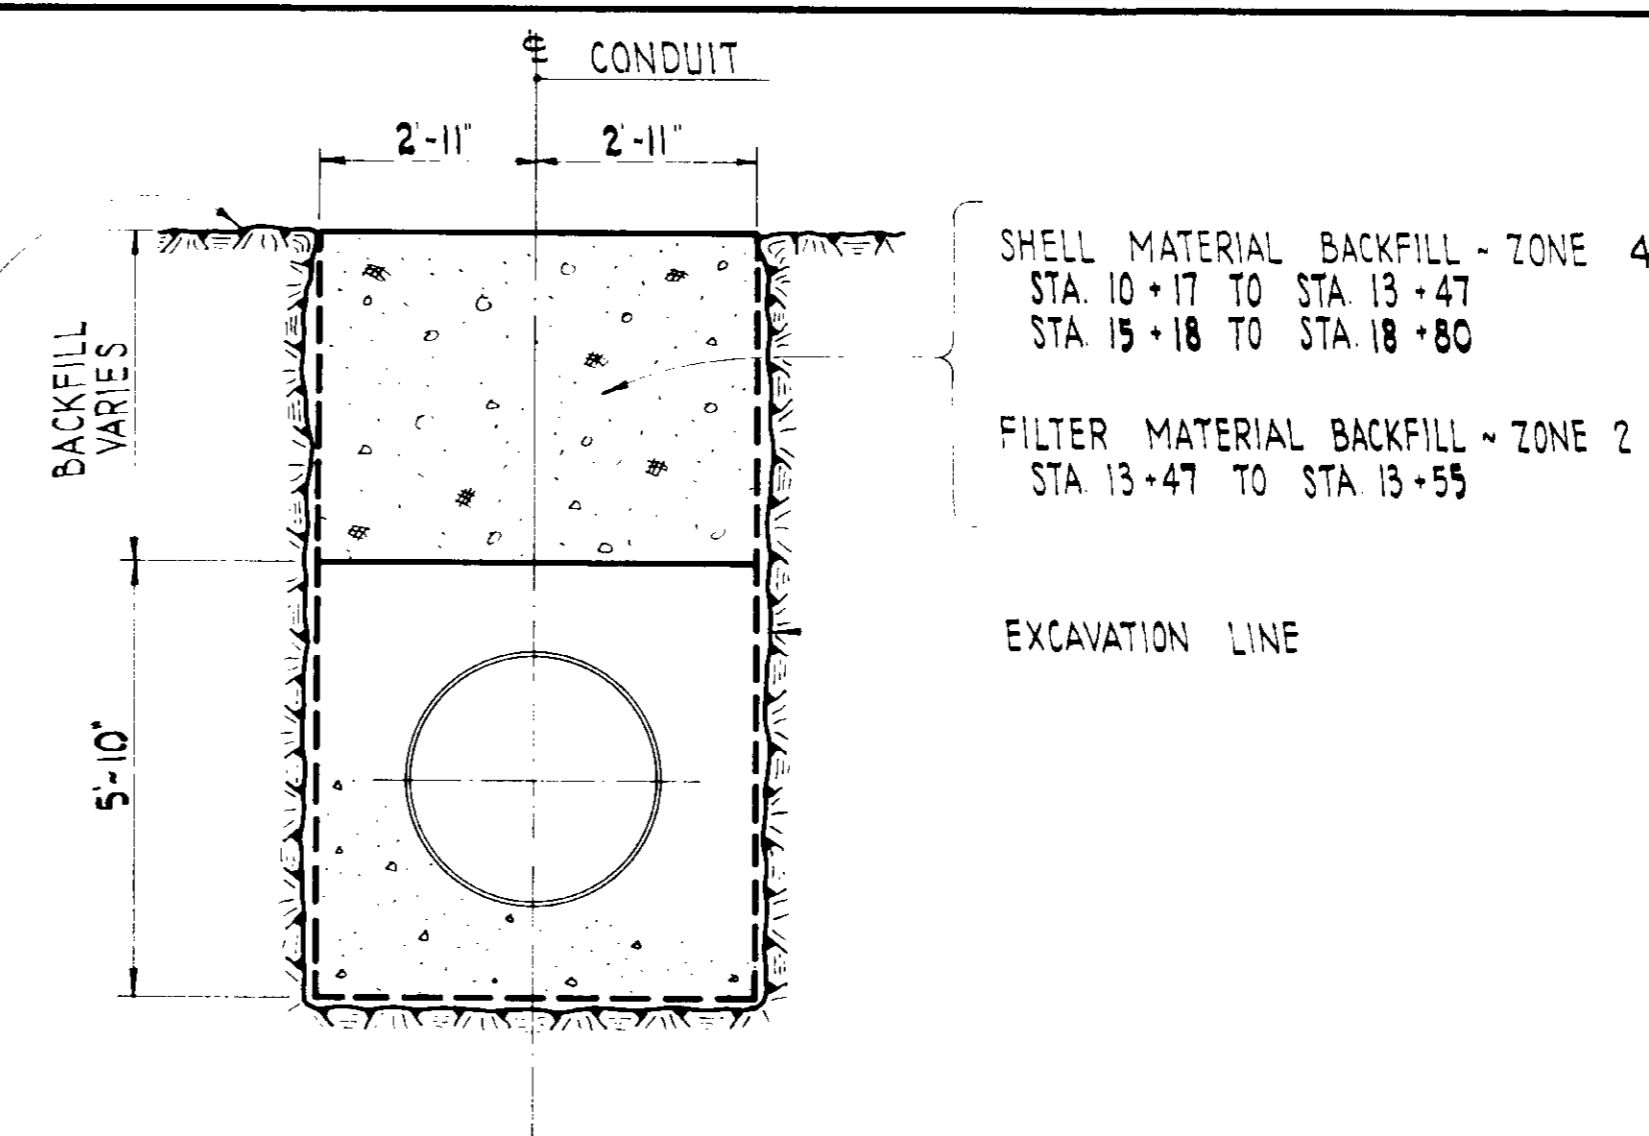

TYPICAL SECTION  
CONDUIT BACKFILL FOR ZONES 2, 3 & 4

SCALE: 3/8" = 1'-0"

CASE	STATION		LENGTH	REINFORCING SCHEDULE		
	FROM	TO		"A"	"B"	"C"
I	9+86.33	11+40	413.67	#5 @ 6"	#5 @ 6"	#5 @ 6"
II	11+40	12+00	60'	#7 @ 6"	#6 @ 6"	#6 @ 6"
III	12+00	12+68	68'	#8 @ 6"	#6 @ 6"	#6 @ 6"
IV	12+68	14+90	222'	#8 @ 6"	#7 @ 6"	#7 @ 6"
V	14+90	16+50	110'	#6 @ 6"	#6 @ 6"	#6 @ 6"

NOTES

- ZONE "A" EXCAVATION: The overbreak beyond excavation lines shall not exceed 4" and inward projection from excavation lines shall not exceed 3". The area projecting inward shall not exceed 5% of the total area.
- ZONE "B" EXCAVATION: The overbreak beyond excavation lines shall not exceed 9" and inward projection from excavation lines shall not exceed 6". The area projecting inward shall not exceed 10% of the total area.
- Backfill material shall be compacted to not less than 95% density as determined by ASTM-D1557-66T test.
- Grouting shall be started not less than 7 days after the Class "C" Concrete Backfill is completed.
- Second stage concrete, as shown in Detail (A) shall be placed not less than 7 days after placement of first stage concrete.

GENERAL NOTES

- All concrete shall be Class "A" (3000 psi @ 28 days) unless otherwise shown.
- Class "A" concrete shall have a minimum of 6 sacks of cement for each cubic yard of mix.
- Foundation concrete shall be placed only on firm, undisturbed rock, approved by District's representative.
- Before placing concrete, verify requirements of sieves, openings, utilities, embedded parts, etc.
- All construction joint surfaces shall be sand blasted to leave a clean roughened surface of sound concrete. Immediately prior to placing the next concrete lift, 1/2" of 1:2 mortar shall be placed on the cleaned surface of the previous lift.
- Chamfer all exposed corners 3/4" unless otherwise shown.
- Reinforcement shall conform to the latest ASTM designation A-615, Grade 40.
- Minimum bar lap at splices and minimum projection of dowels, shall be 24 diameters of smaller bar, unless otherwise shown.
- Class "A" and Class "C" concrete for intake-outlet conduit shall have San Gabriel Valley aggregates. For all other structures, concrete shall have aggregates treated by "heavy media" process and used from State approved stockpiles.
- Before placement of concrete, the foundation surfaces shall be thoroughly cleaned by hand sweeping and high pressure air and/or water jets. Immediately prior to placing concrete, the surface of the foundation shall be free of standing water and loose material.
- Class "C" concrete shall have a minimum 2000 psi ultimate strength at 28 days and shall have not less than 4 sacks of cement per cubic yard of concrete.

REFERENCE DRAWINGS

FOR REFERENCE DRAWINGS SEE DRAWING NO. 25.

05291


LAS VIRGENES MUNICIPAL WATER DISTRICT

BOYLE ENGINEERING  
W. A. WAHLER & ASSOCIATES

WESTLAKE RESERVOIR


INTAKE-OUTLET CONDUIT  
DETAILS - SHEET 2 OF 2

DESIGNED BY: <i>[Signature]</i>	DATE: 11-70	JOB: D.F.M.	PROJ. ENG. <i>[Signature]</i>
DRAWN BY: <i>[Signature]</i>	CHECKED BY: <i>[Signature]</i>	SCALE AS SHOWN	DRAWING NUMBER: 28

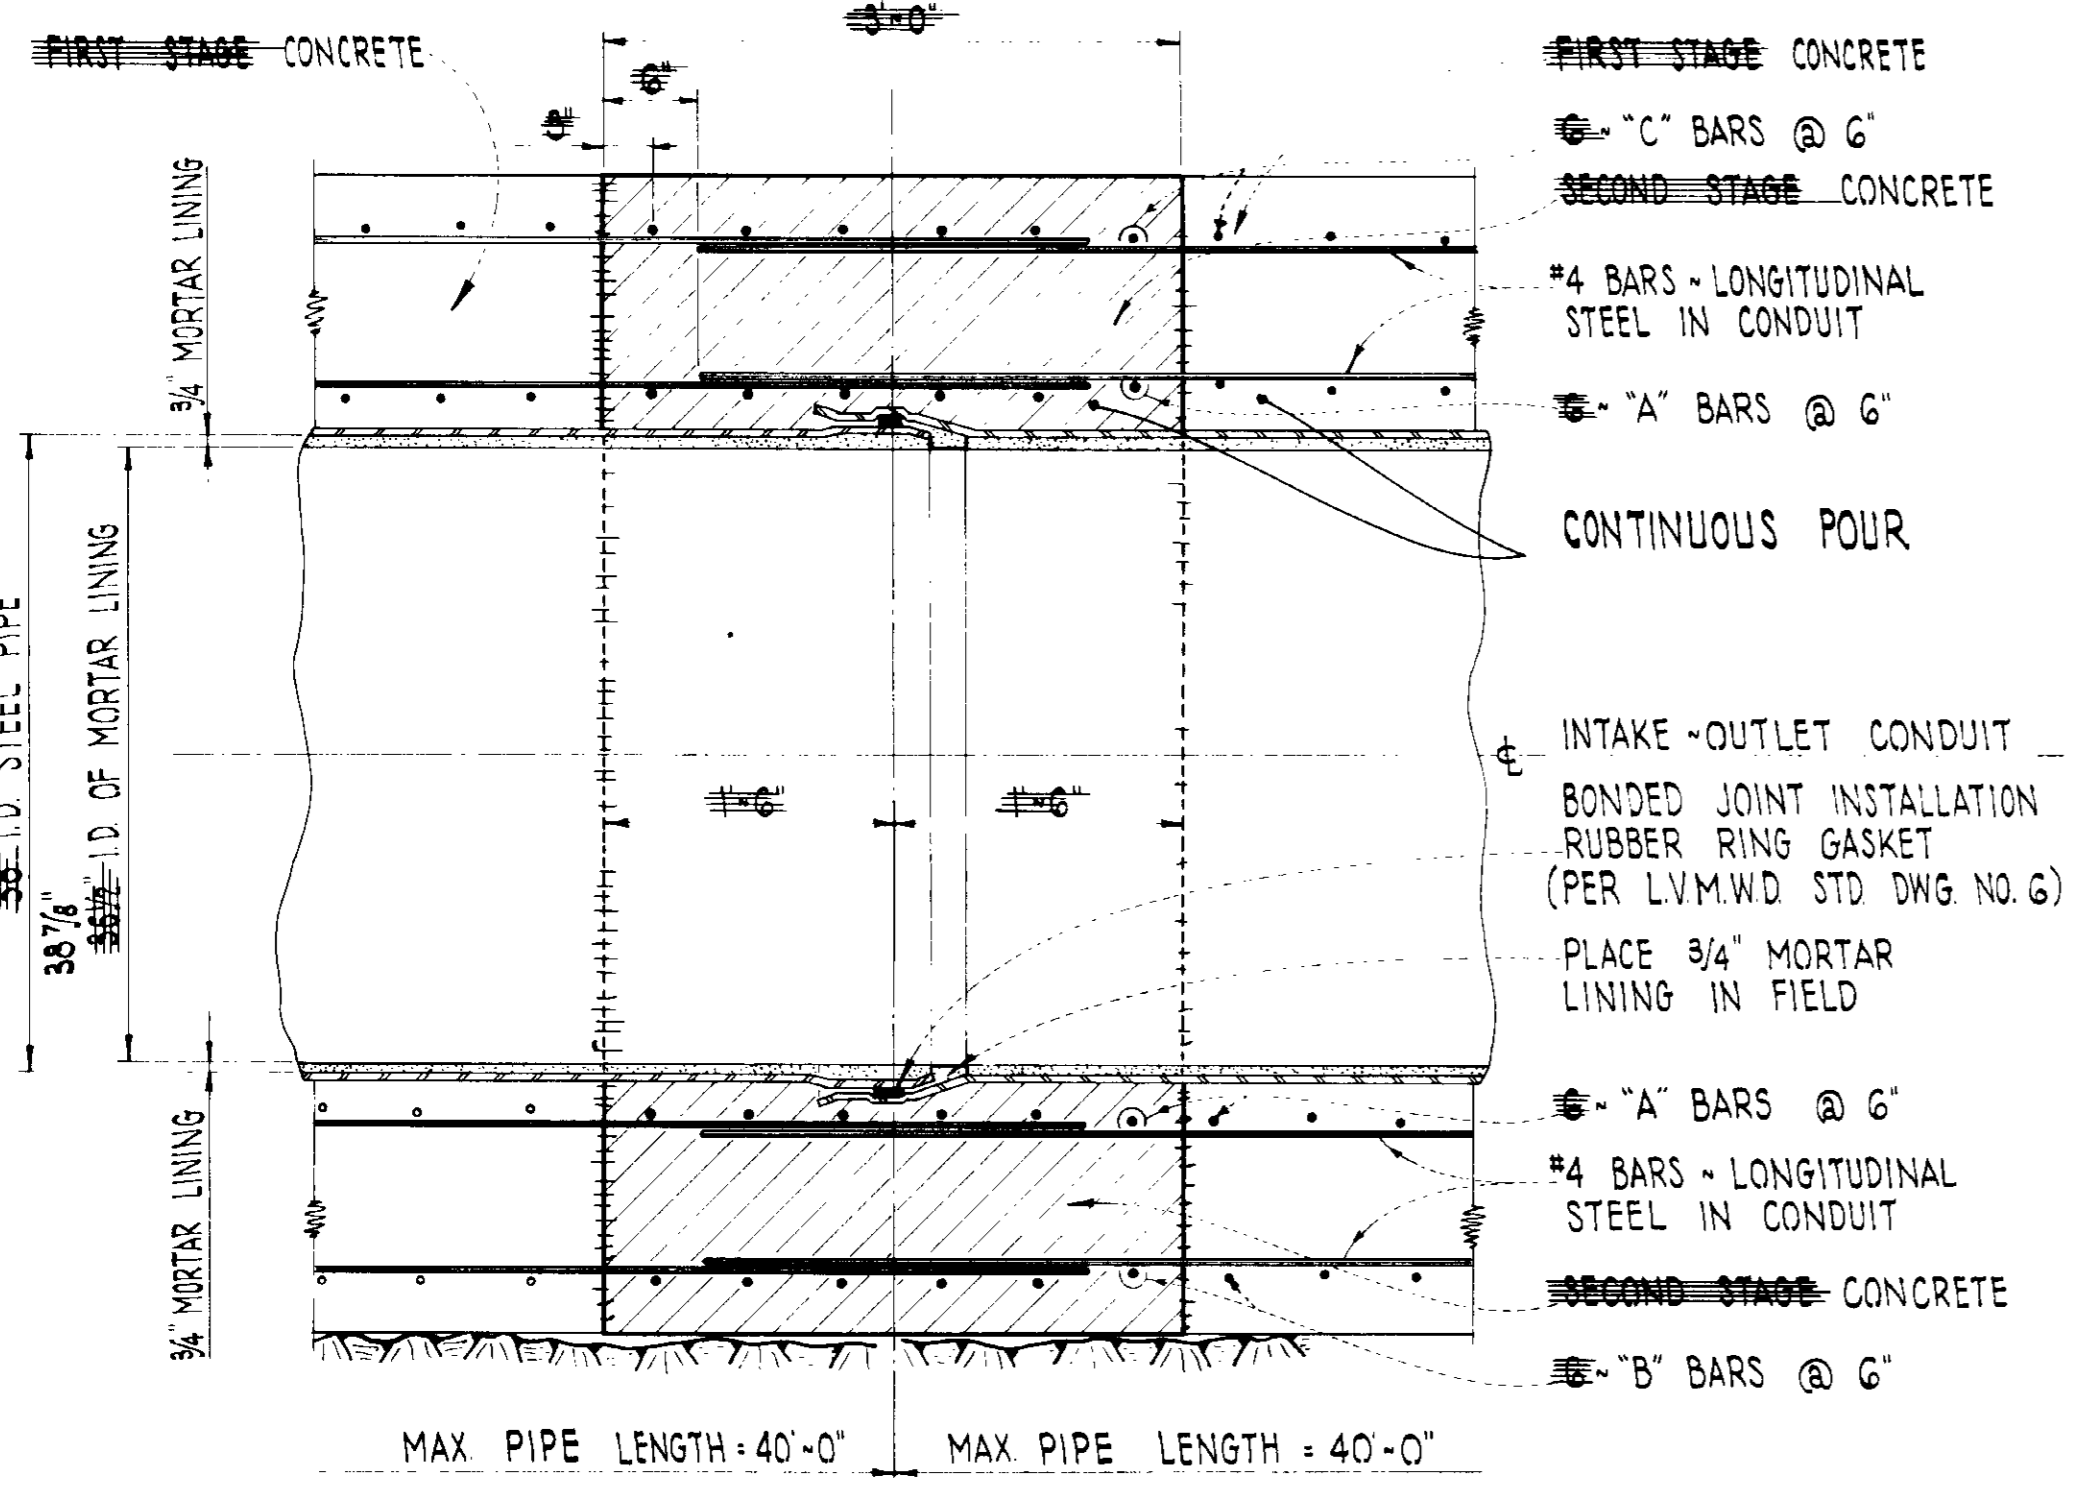

BELL & SPIGOT JOINT WITH  
CONCRETE ENCASMENT & REINFORCING


DETAIL (A)  
SCALE: 1" = 1'-0"

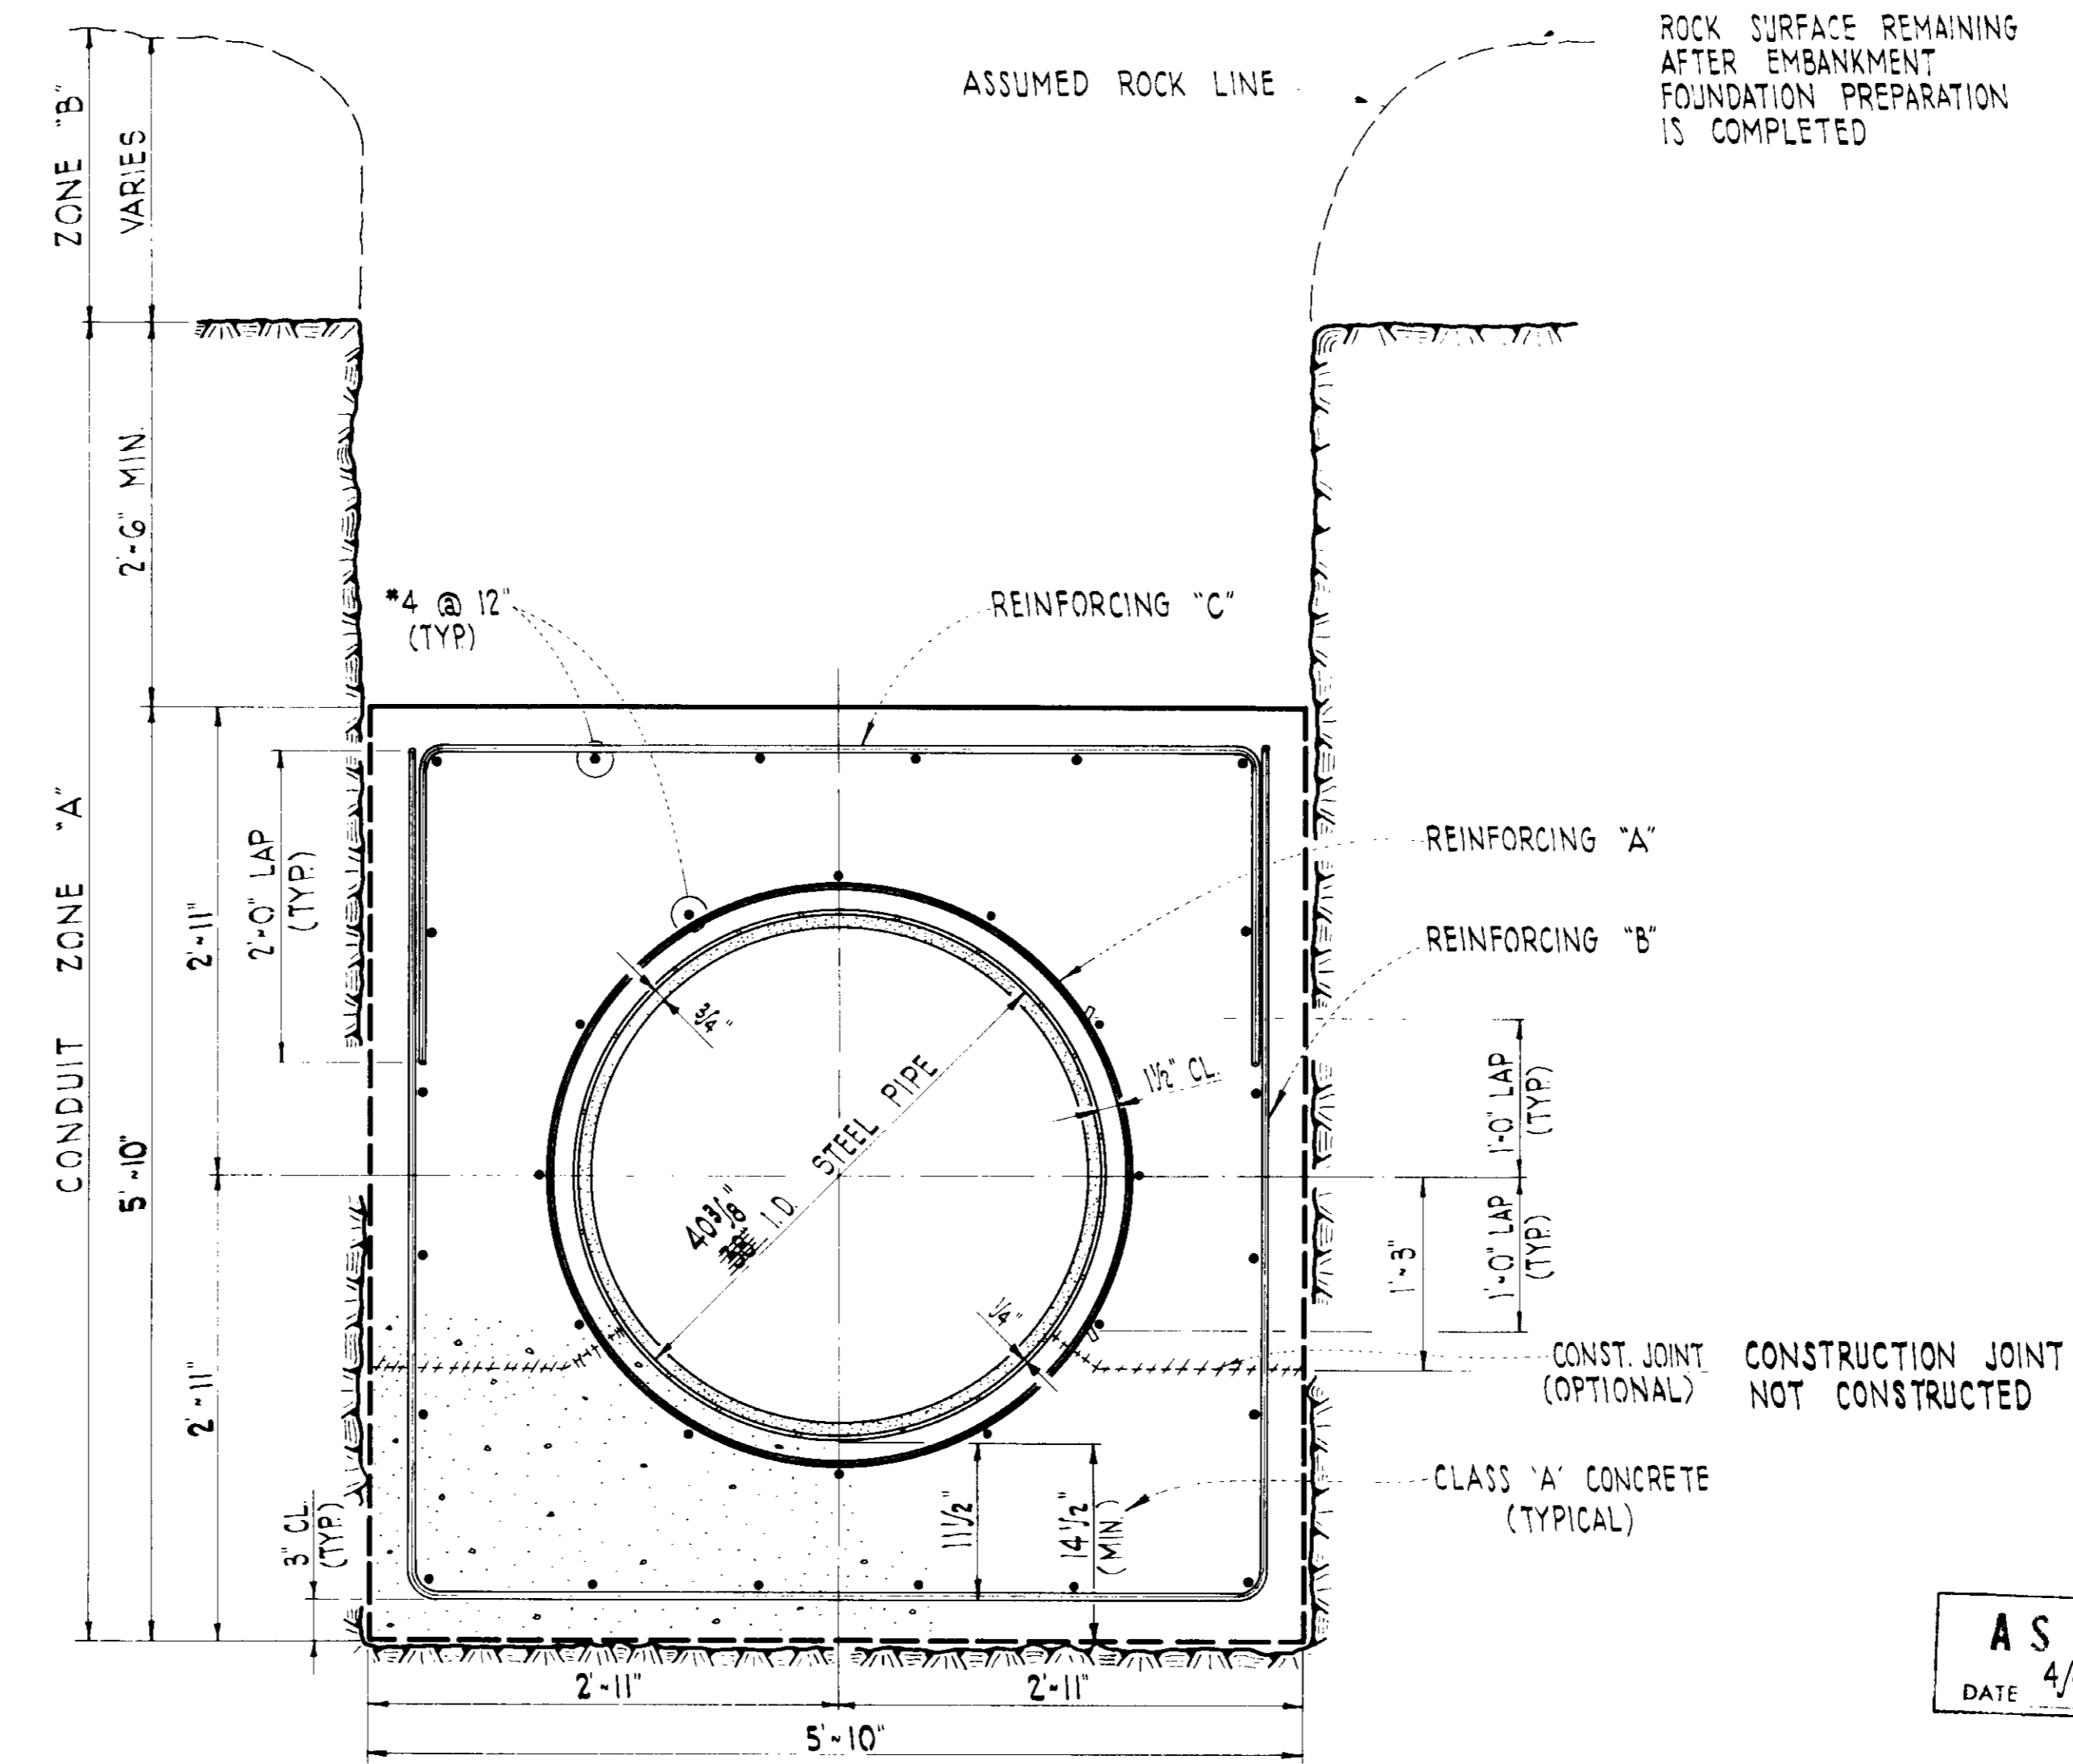


TYPICAL SECTION OF CONDUIT WITH  
CONCRETE ENCASMENT & REINFORCING


DETAIL (B)  
SCALE: 1" = 1'-0"

AS CONSTRUCTED  
DATE 4/24/73  
LFT 88.88.88  
LND D.F.M.

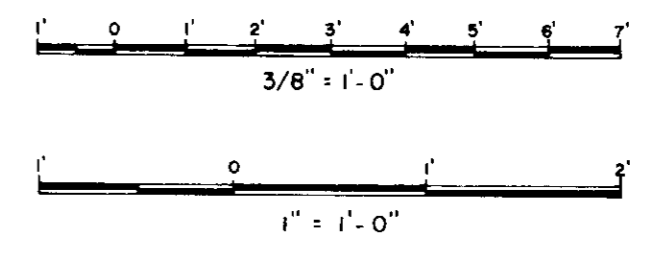


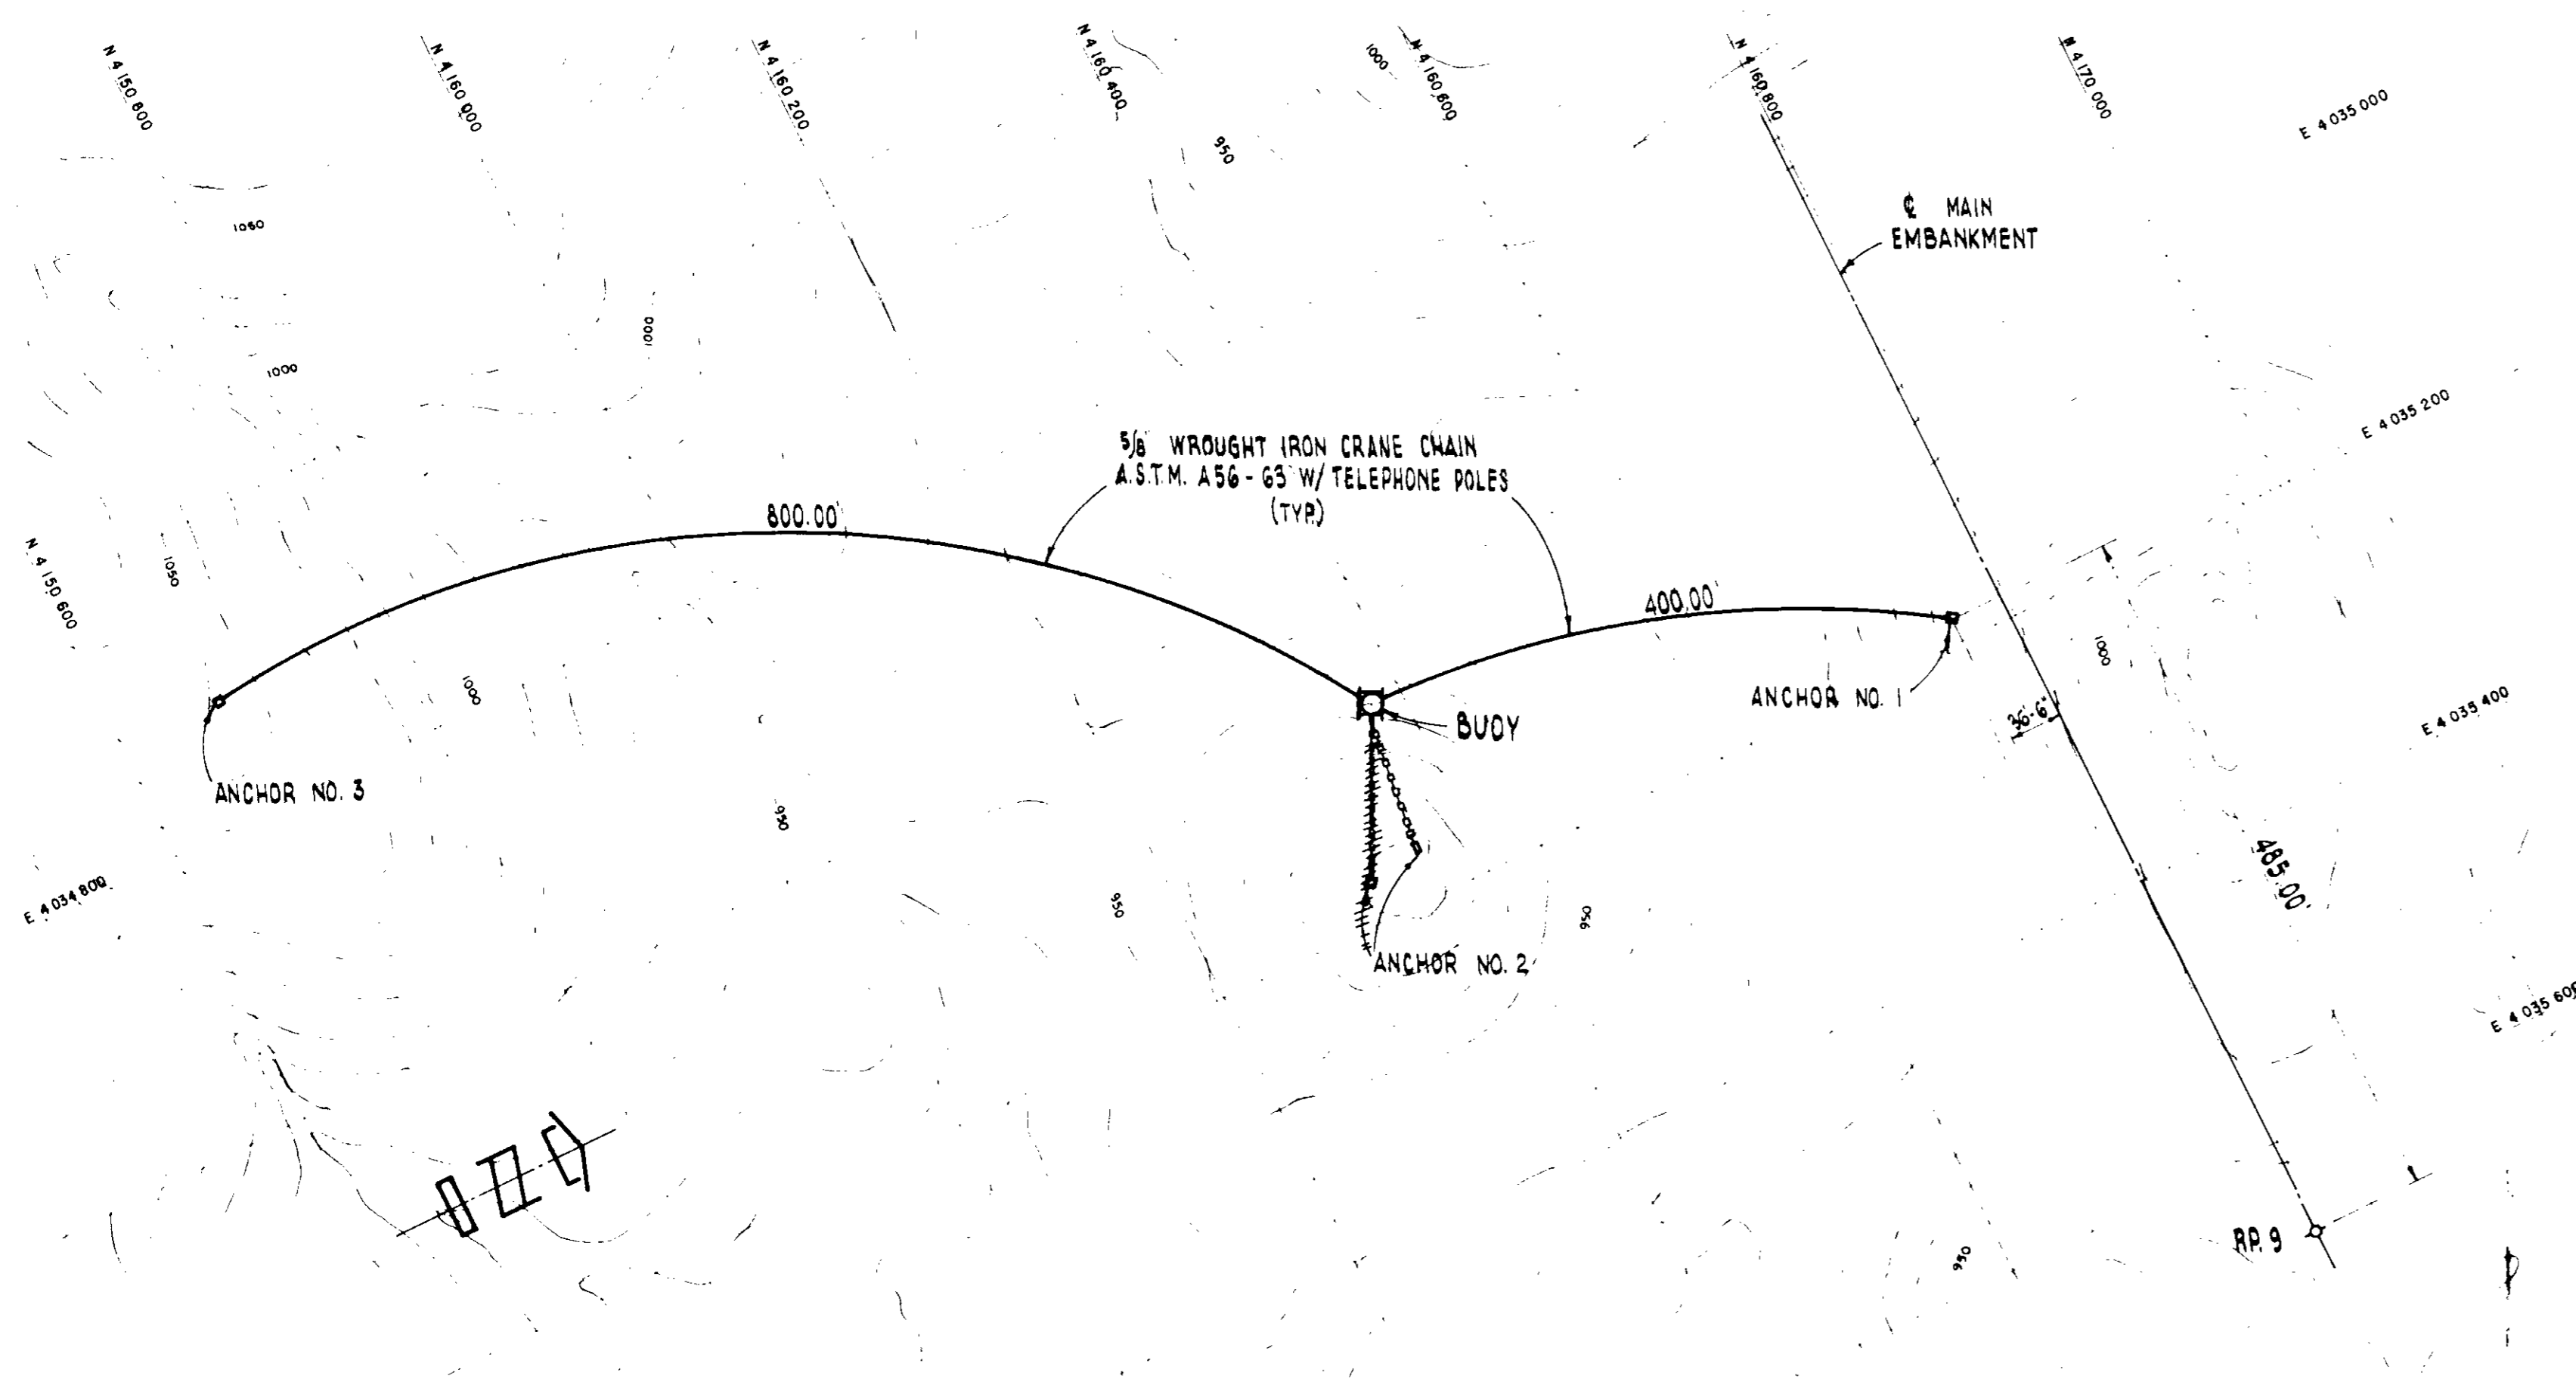

**PLAN - LOG BOOM**  
SCALE: 1" = 100'

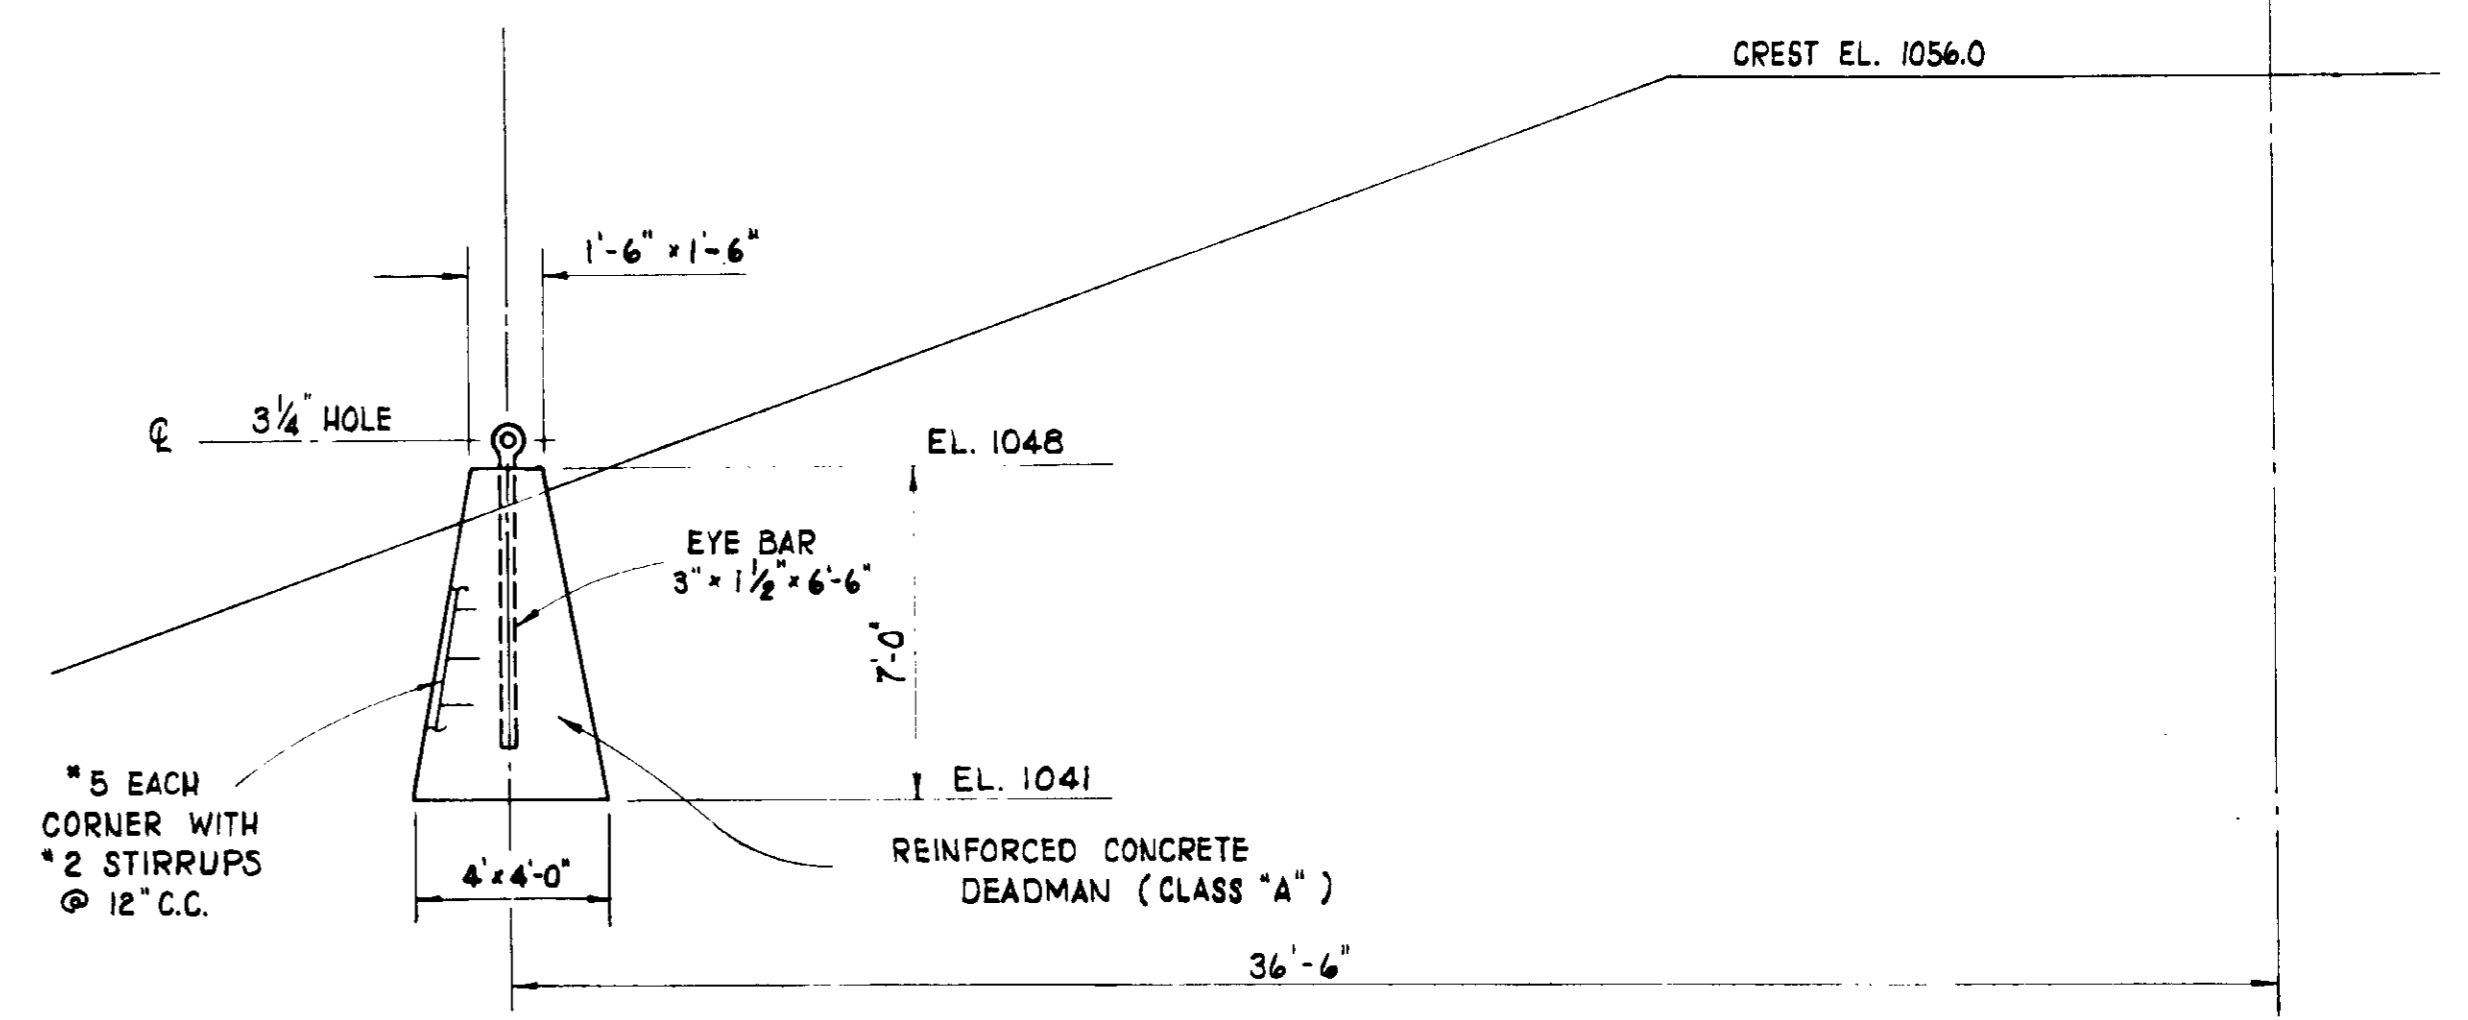


**ANCHOR NO. 1 - DETAIL** (D)  
SCALE: 1/4" = 1'-0"

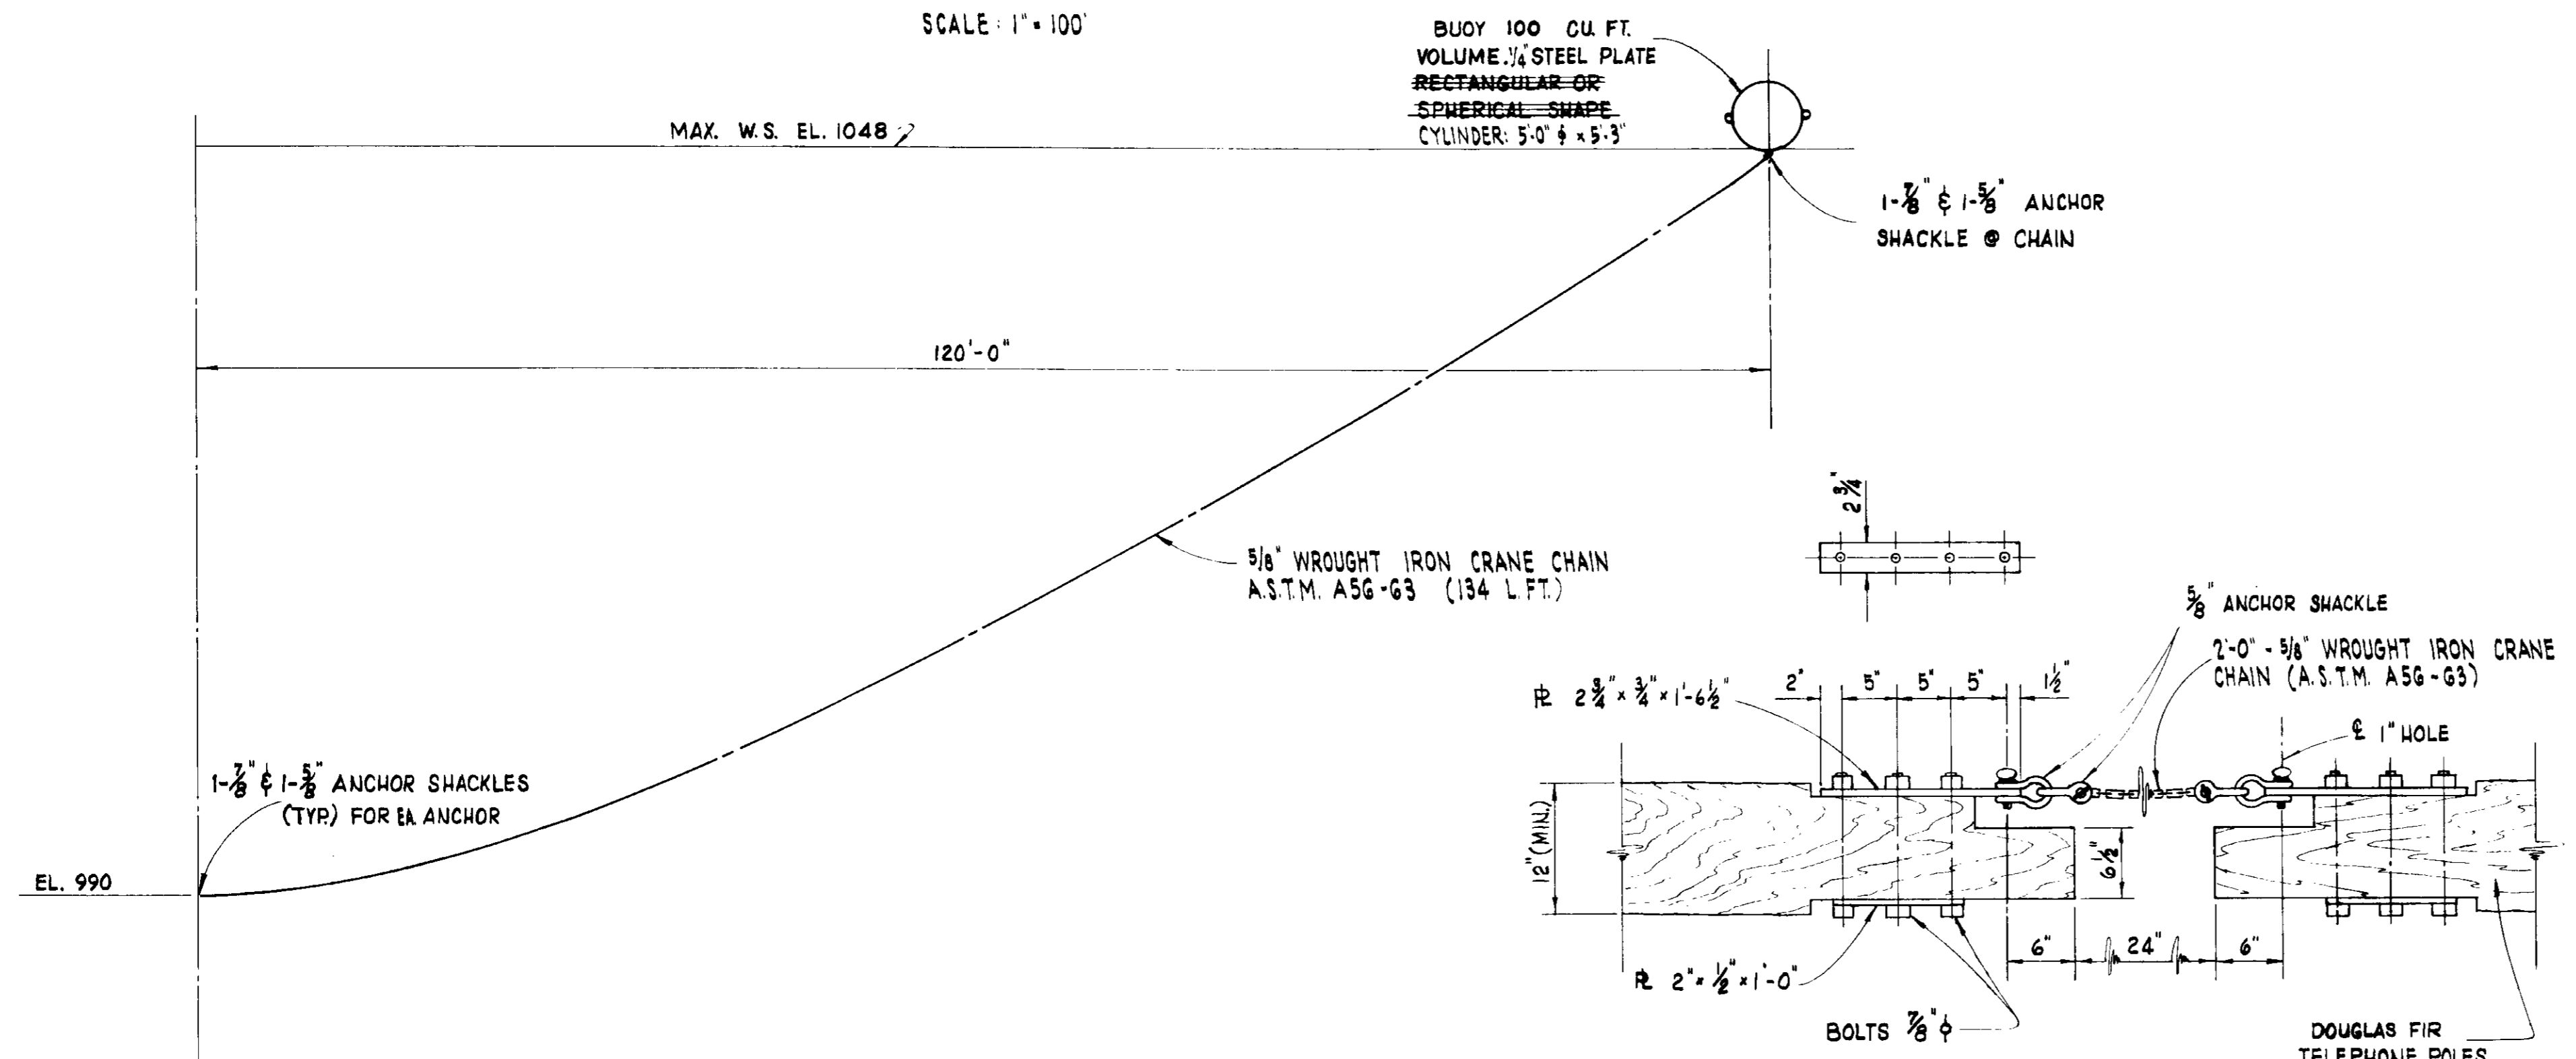

**ANCHOR BUOY - DETAIL** (A)  
SCALE: 1" = 10'-0"


**ANCHOR SHACKLE - DETAIL** (B)  
SCALE: 1" = 1'-0"

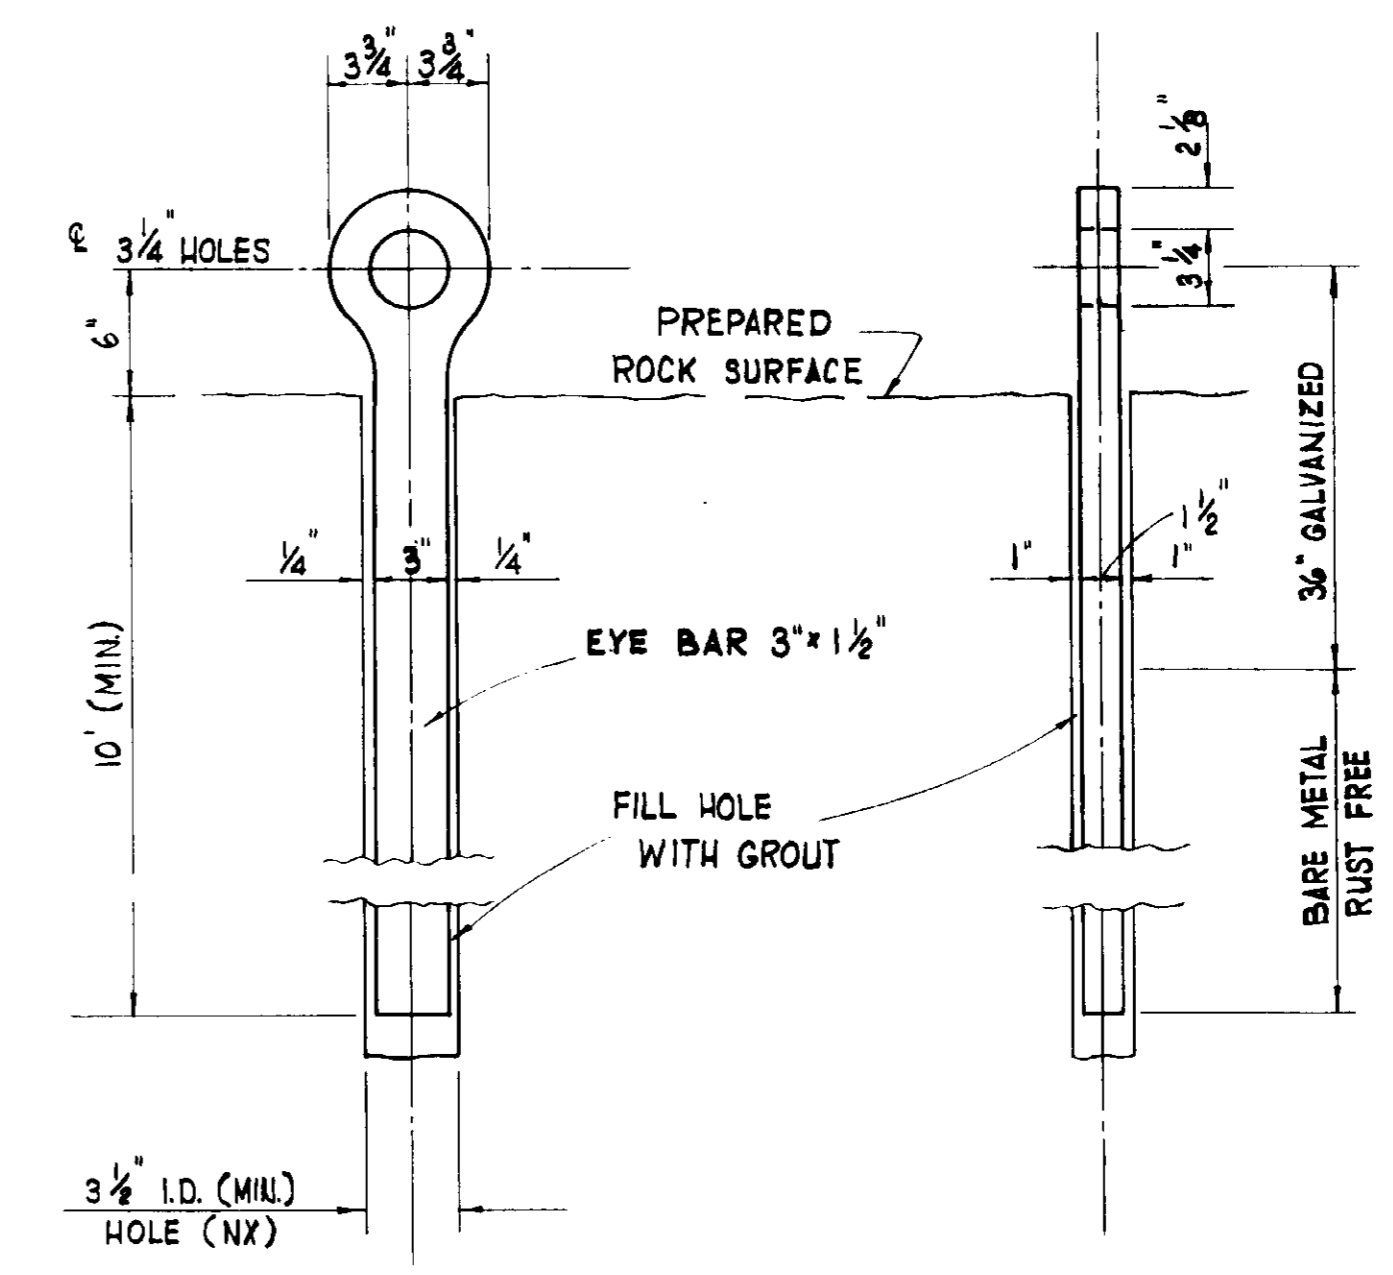

**ANCHORS NO. 2 & 3 - DETAIL** (C)  
SCALE: 1 1/2" = 1'-0"

**NOTES:**

1. USE 30'-0" CHAINS ON EACH SIDE OF THE BUOY.
2. THE CHAINS @ THE ANCHORS NO. 1, 2, & 3 SHALL HAVE LENGTHS OF 20'-0".
3. ALL METAL SHALL BE GALVANIZED UNLESS OTHERWISE SHOWN.
4. PAINT BUOY IN ACCORDANCE TO A.W.W.A. D102-64 SECT. 1.4 OUTSIDE PAINT NO. 3

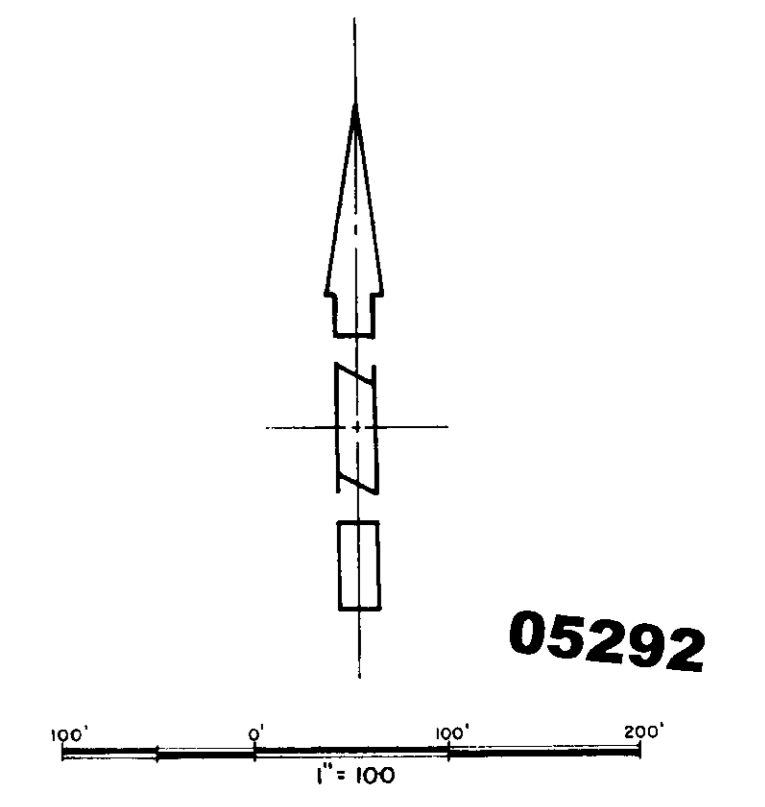


**05292**

**AS CONSTRUCTED**  
DATE: 4/25/73 DFT: R.R.P. CKD: D.F.M.

DESIGNED: <i>[Signature]</i>	DATE: 11-70	JOB ENG. <i>D.F.M.</i>	PROJ. ENG. <i>[Signature]</i>
DRAWN: <i>ALL</i>	CHECKED: <i>[Signature]</i>	DRAWING NUMBER: <b>29</b>	REV.

SCALE AS SHOWN

**LAS VIRGENES MUNICIPAL WATER DISTRICT**  
**BOYLE ENGINEERING**  
**W. A. WAHLER & ASSOCIATES**  
WESTLAKE RESERVOIR  
**LOG BOOM**  
LOG BOOM DETAILS

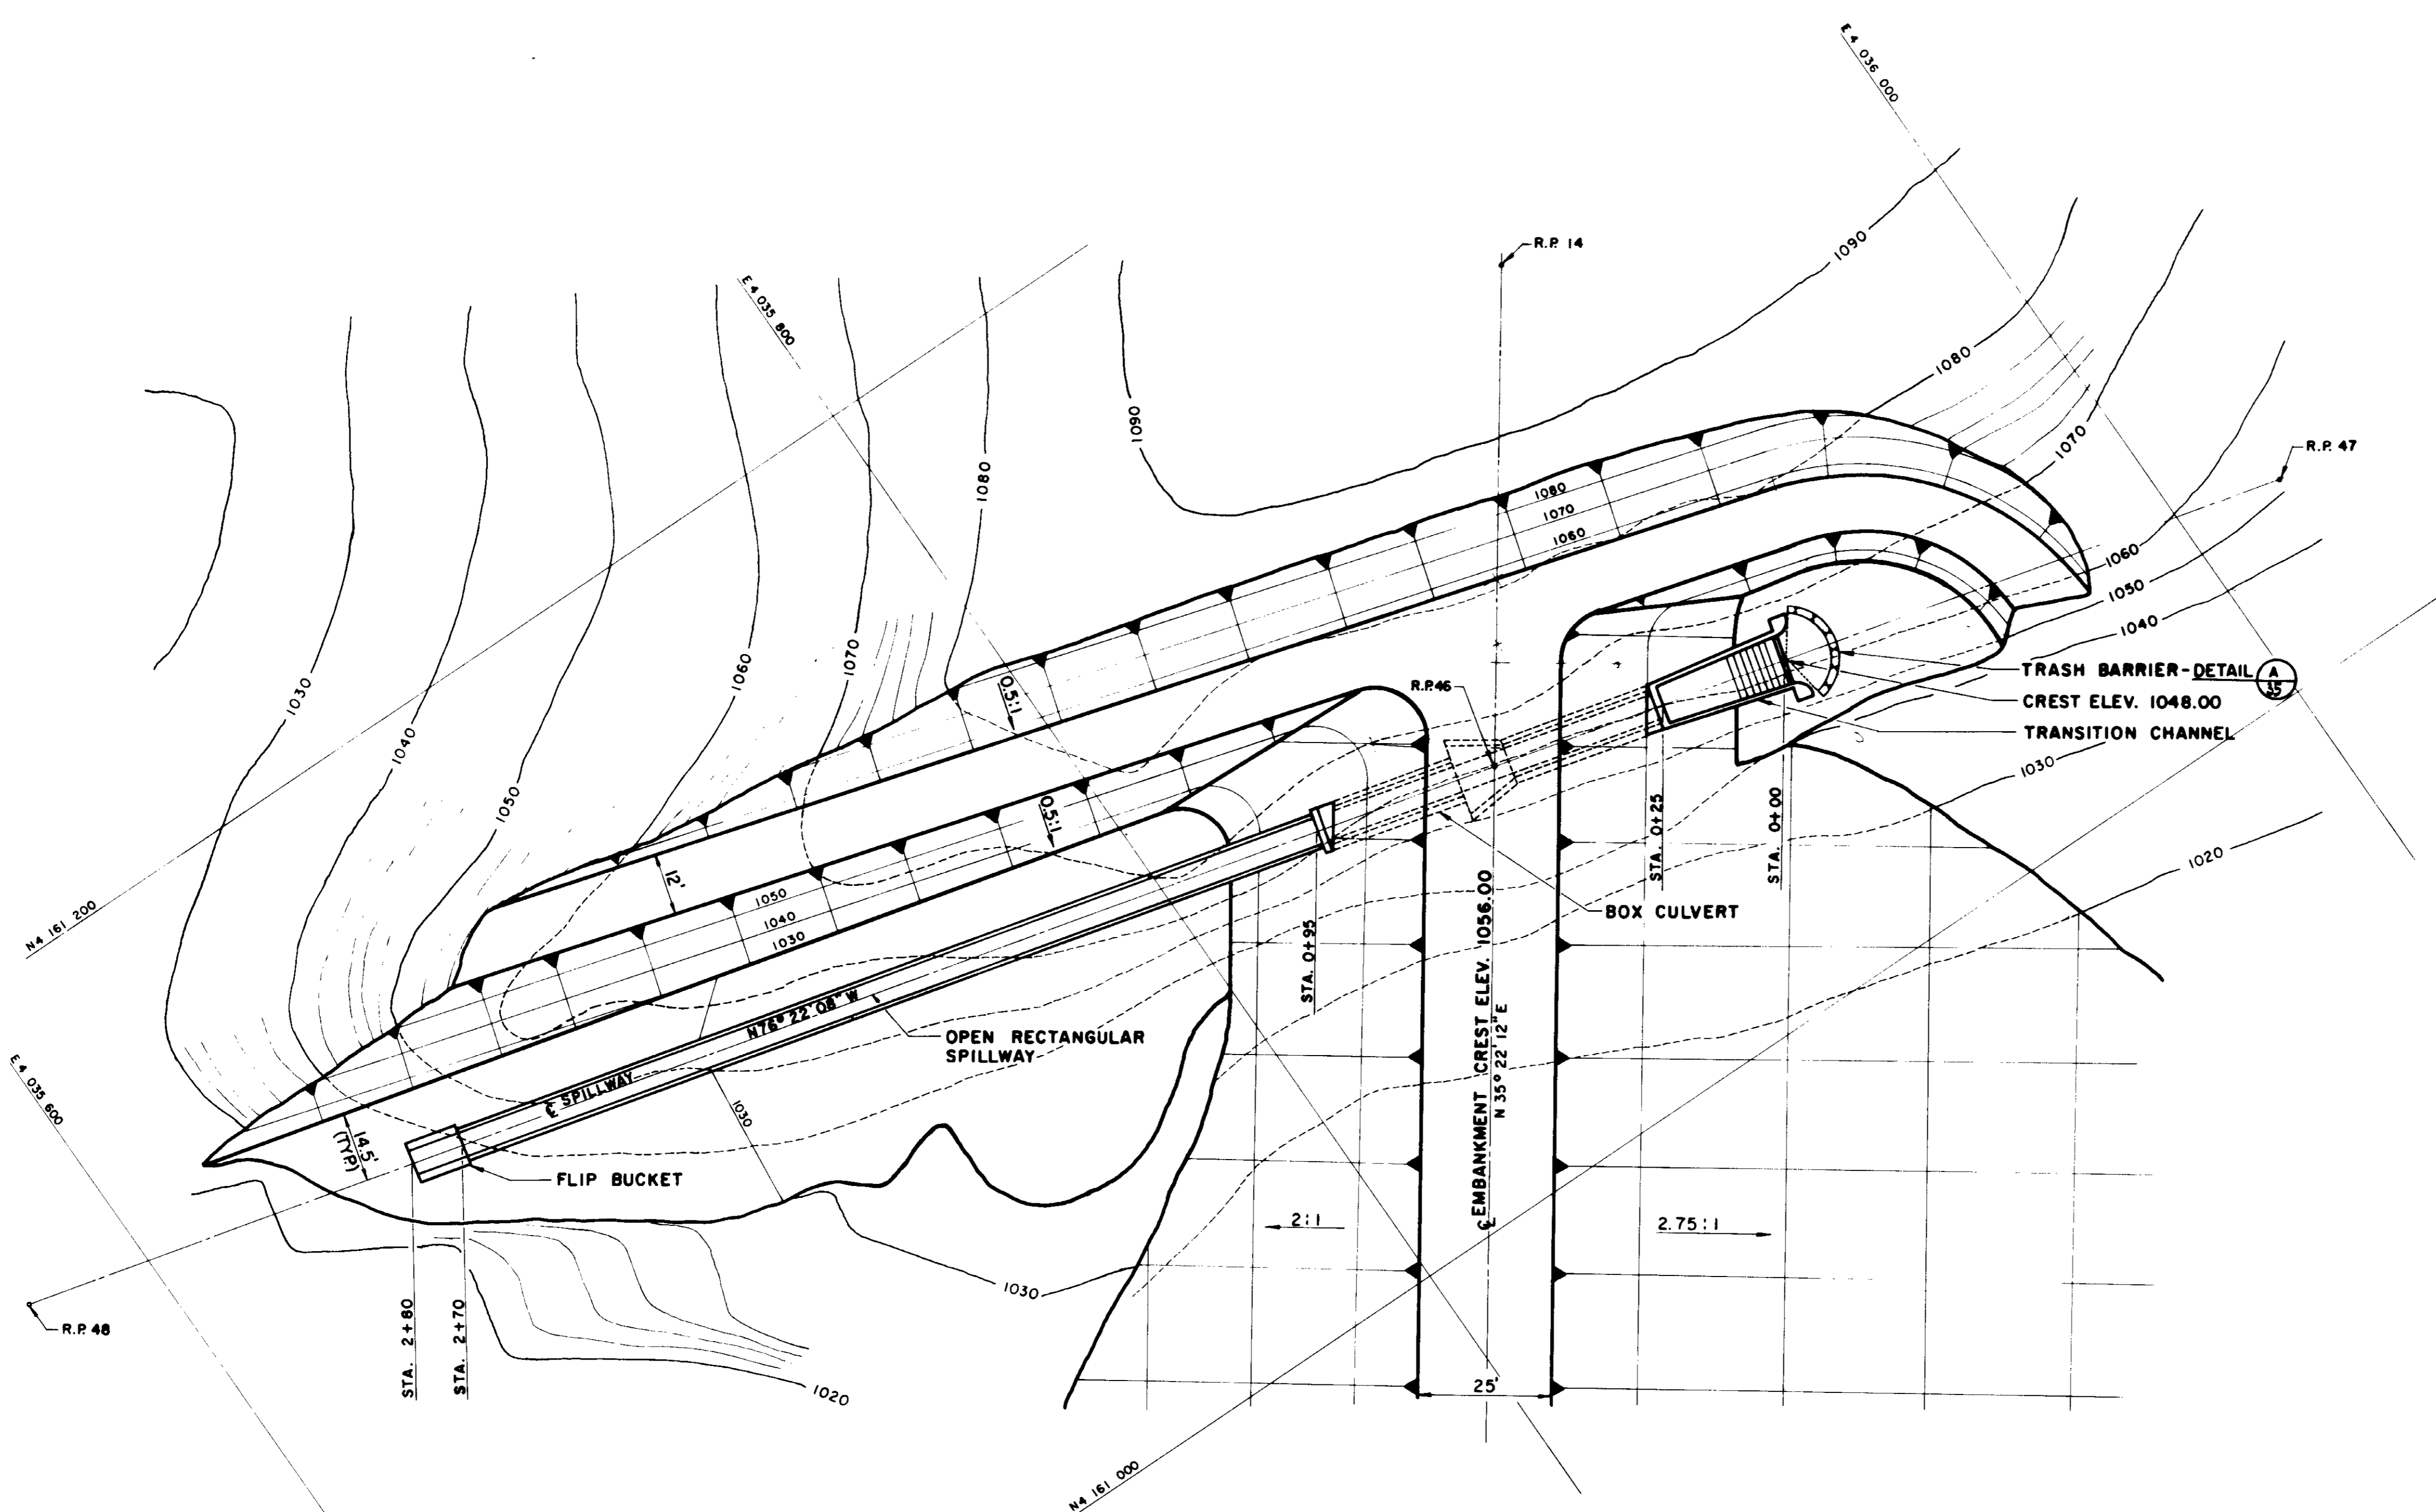


**PLAN**  
**SPILLWAY AND ACCESS ROAD GENERAL LAYOUT**

SCALE: 1" = 20'

**AS CONSTRUCTED**  
 DATE 12-13-73 DIT N.H.R. CHD DPM

REFERENCE DRAWINGS

- 31 EXCAVATION
- 32 CONCRETE OUTLINES
- 33 REINFORCING - SHEET 1 OF 2
- 34 REINFORCING - SHEET 2 OF 2
- 35 TRASH BARRIER DETAILS
- 4 HORIZONTAL CONTROL LINES

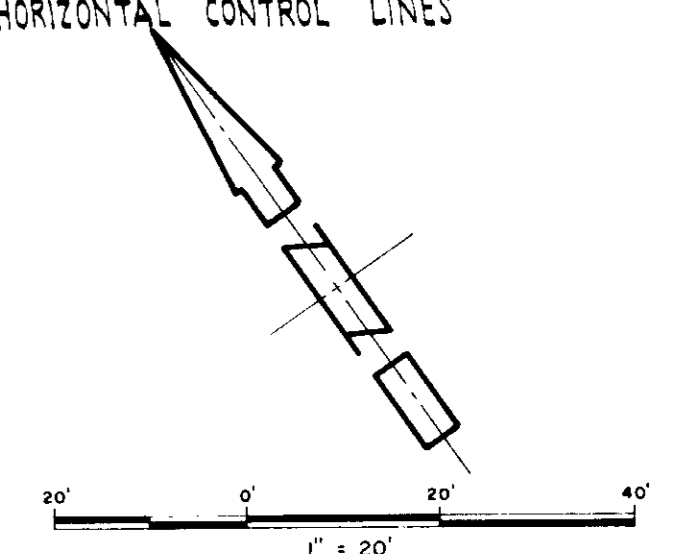

**05293**

NO.	DATE	REVISIONS	BY	CHK	ENG.	PROJ.	ENGR.	MGR.
1		REVISE SPILLWAY ALIGNMENT	T.E.M.	R.L.E.	R.L.E.			
2		ISSUED FOR CONSTRUCTION	T.E.M.	R.C.E.	D.P.M.			



**LAS VIRGENES MUNICIPAL WATER DISTRICT**

BOYLE ENGINEERING  
 W. A. WAHLER & ASSOCIATES

WESTLAKE RESERVOIR  
**SPILLWAY**

GENERAL LAYOUT

DESIGNED: <i>[Signature]</i>	DATE: 11-70	JOB: <i>[Signature]</i>	PROJ. ENGR.: <i>[Signature]</i>
DRAWN: <i>[Signature]</i>	CHECKED: <i>[Signature]</i>	SCALE AS SHOWN	DRAWING NUMBER: <b>30</b>

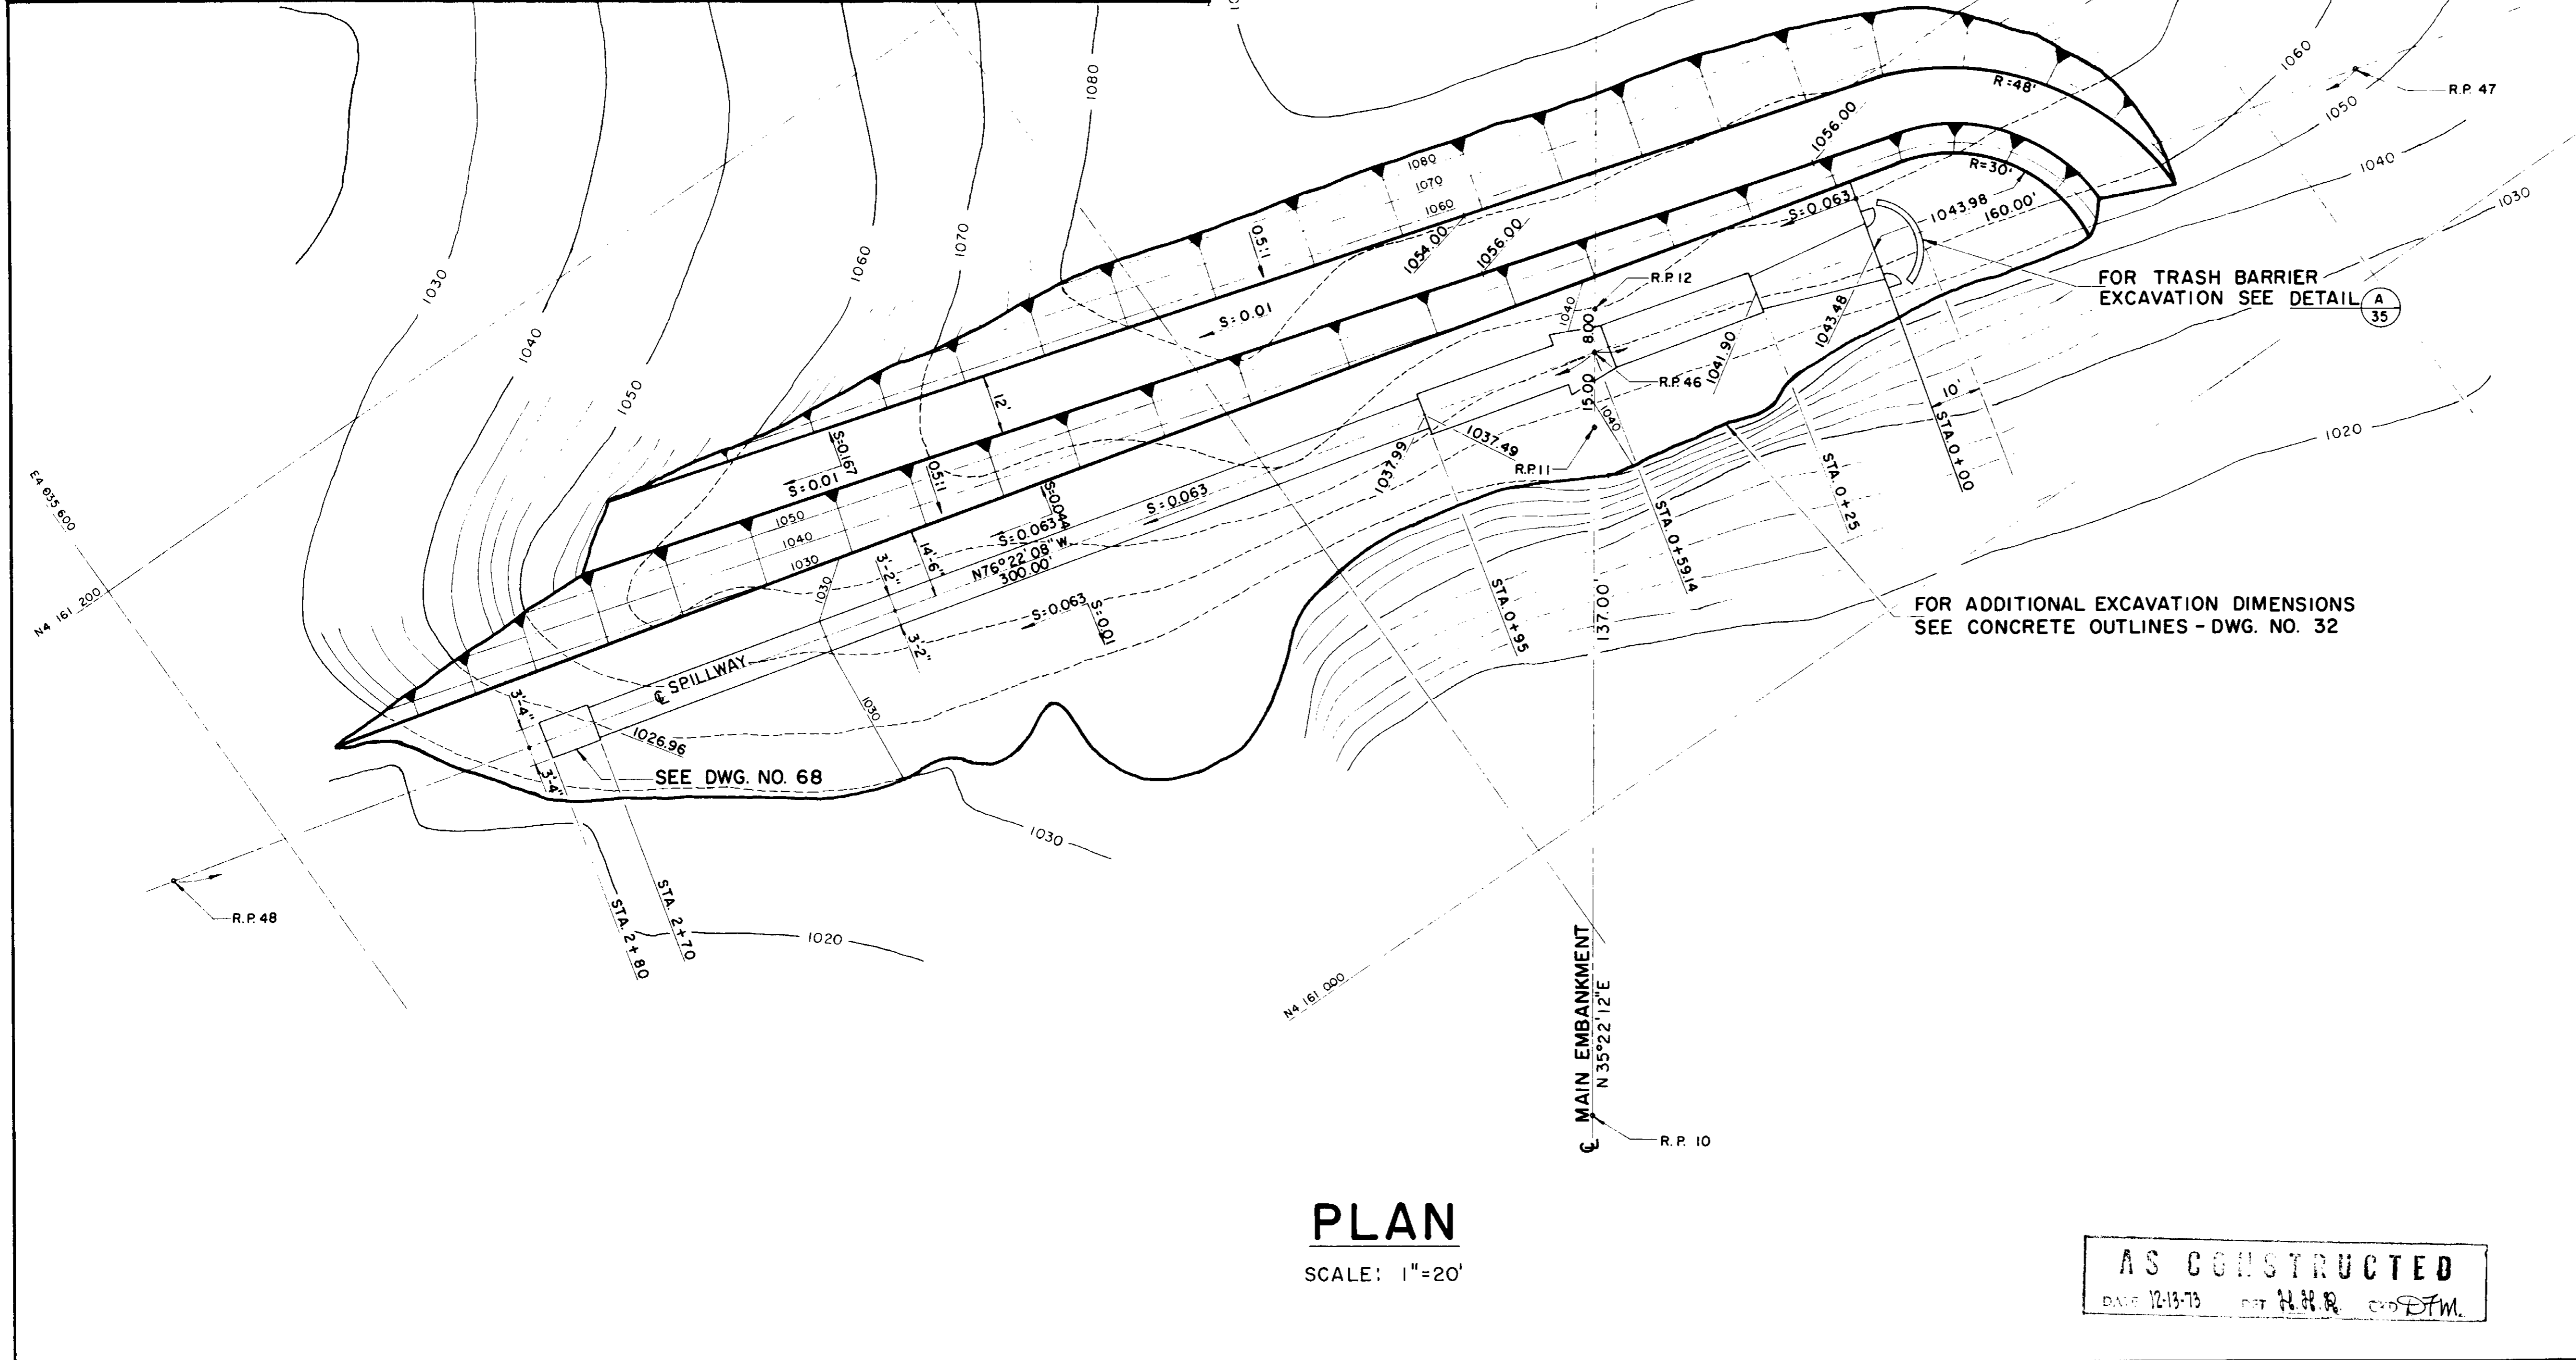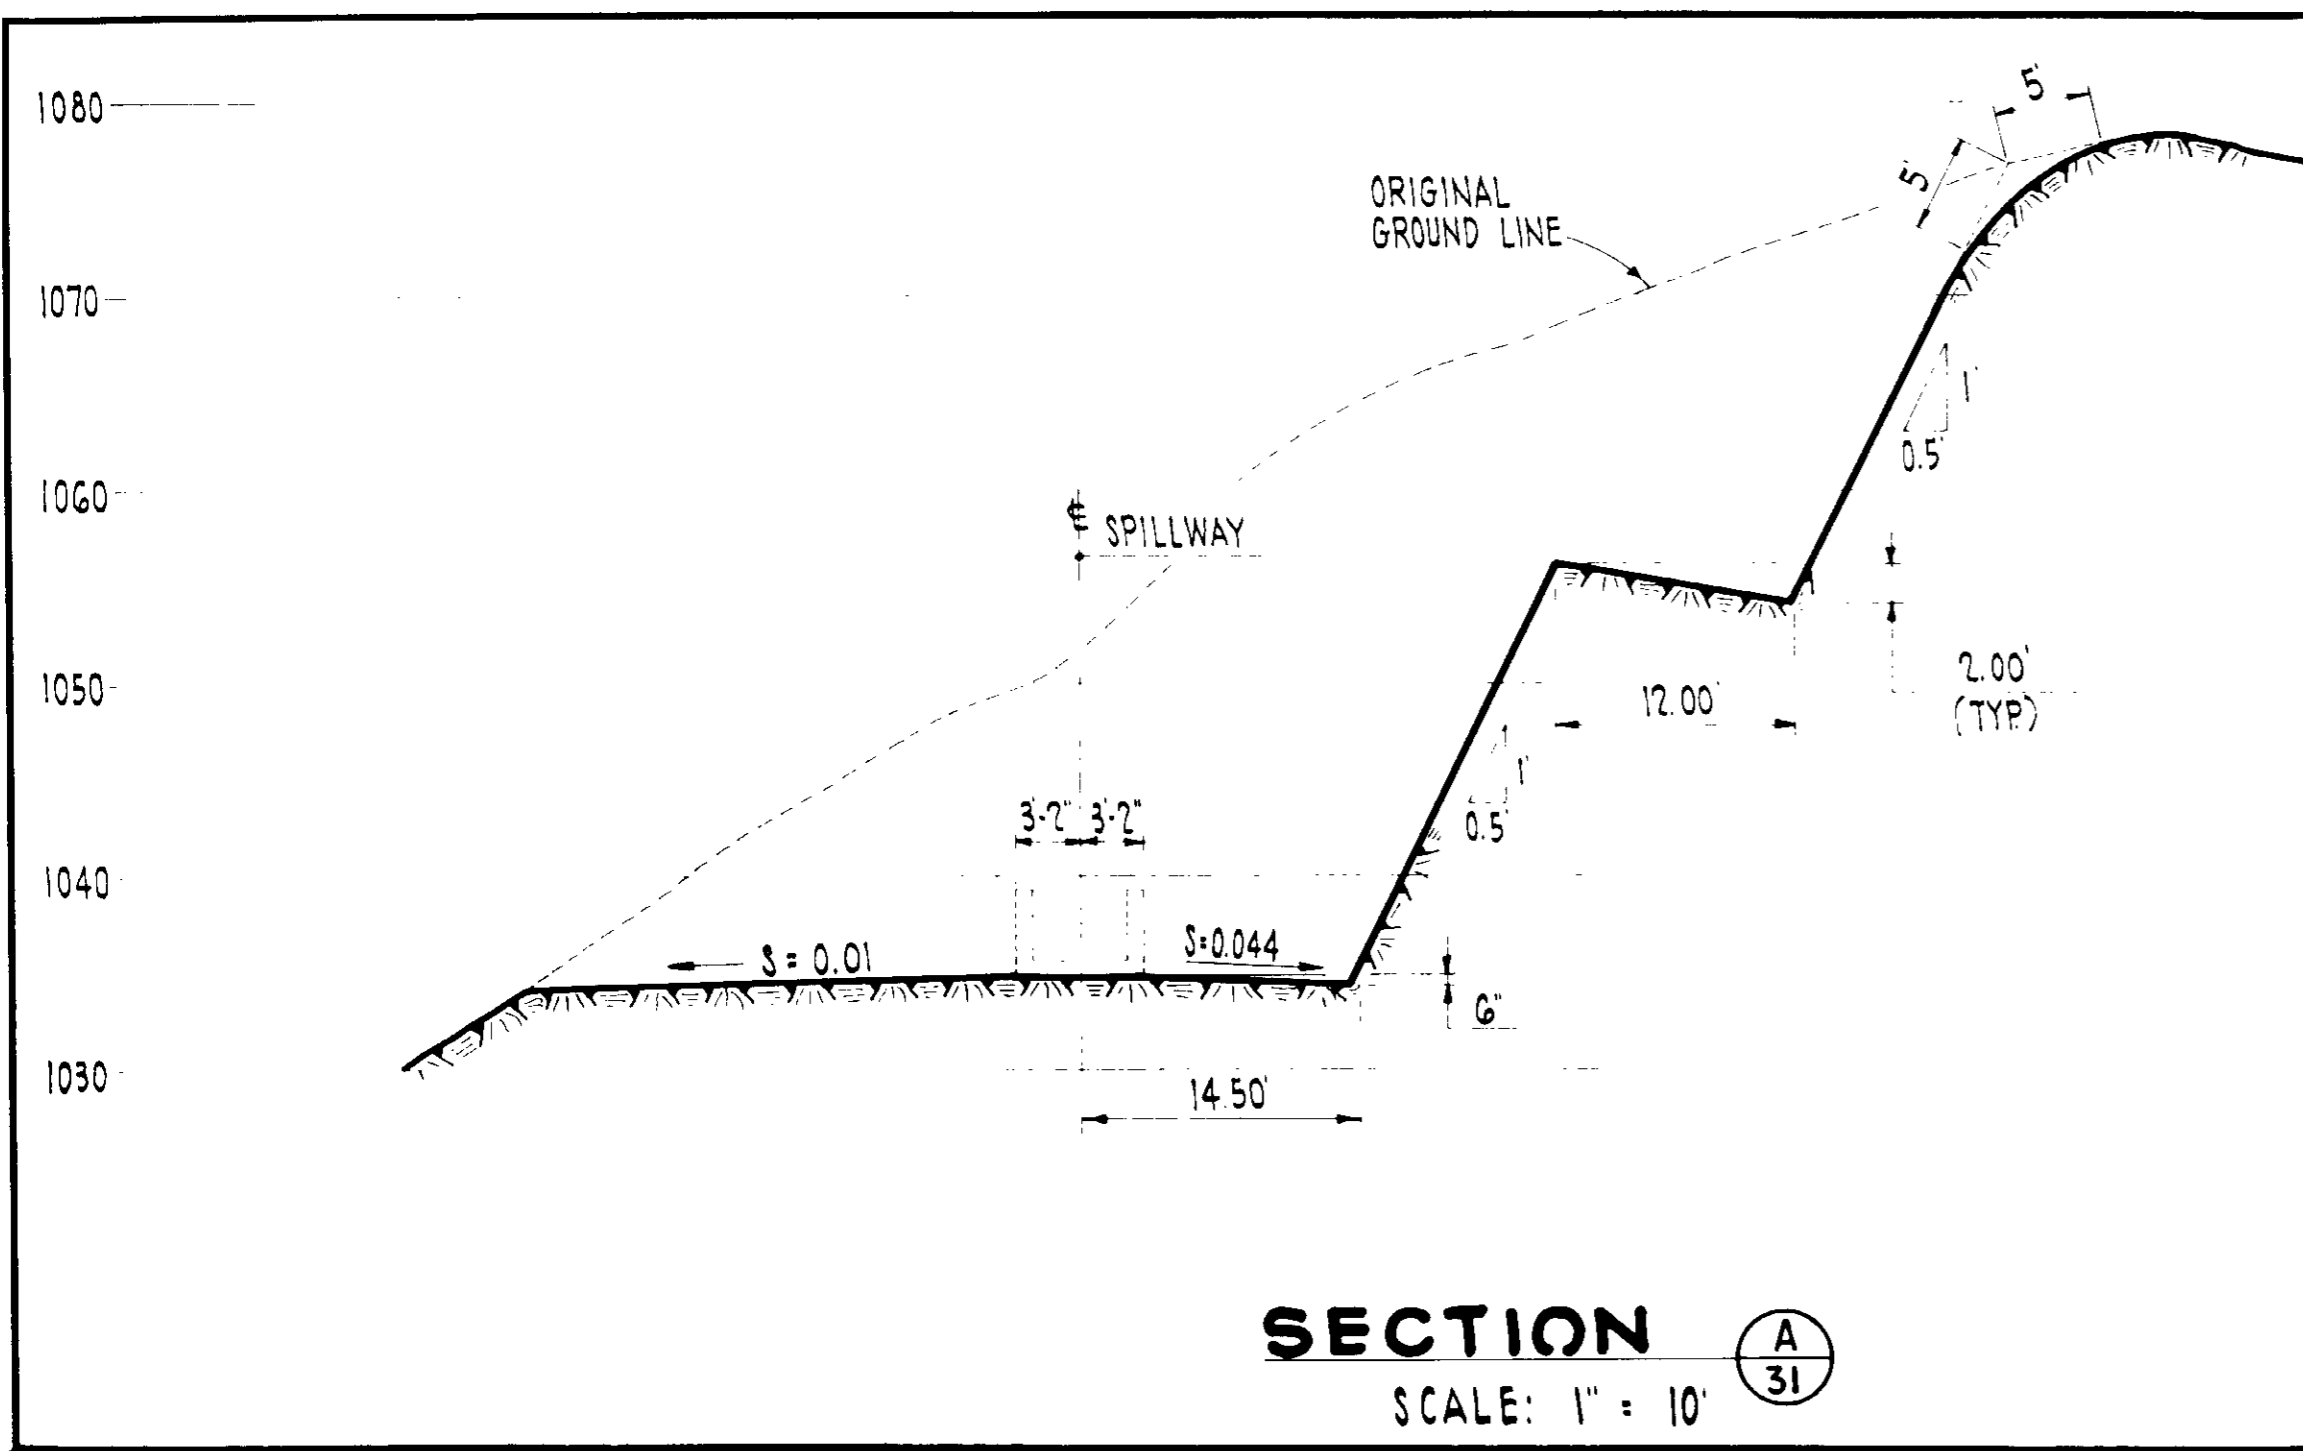

REFERENCE DRAWINGS  
30 GENERAL LAYOUT

**05294**

20' 0 20' 40'  
1" = 20'

NO.	DATE	REVISIONS	BY	CHK	ENG.	PROJ.	ENG.	MGR.
1	11/16/76	REVISE SPILLWAY ALIGNMENT	T.E.M.	R.L.E.	R.L.E.	J.M.	J.M.	J.M.
2	11/16/76	ISSUED FOR CONSTRUCTION	T.E.M.	R.L.E.	R.L.E.	J.M.	J.M.	J.M.

**LAS VIRGENES MUNICIPAL WATER DISTRICT**

BOYLE ENGINEERING  
W. A. WAHLER & ASSOCIATES

WESTLAKE RESERVOIR  
**SPILLWAY EXCAVATION**


DESIGNED: R.L.E. DATE: 11-70 JOB: D.T.M. PROJ. ENG.: J.M.  
DRAWN: W.A. CHECKED: D.T.M. SCALE AS SHOWN

DWG 12-13-75 BY: H.H.R. CVD: D.T.M.


DRAWING NUMBER: **31**

NOTES

1. FOR GENERAL NOTES SEE DWG. 28

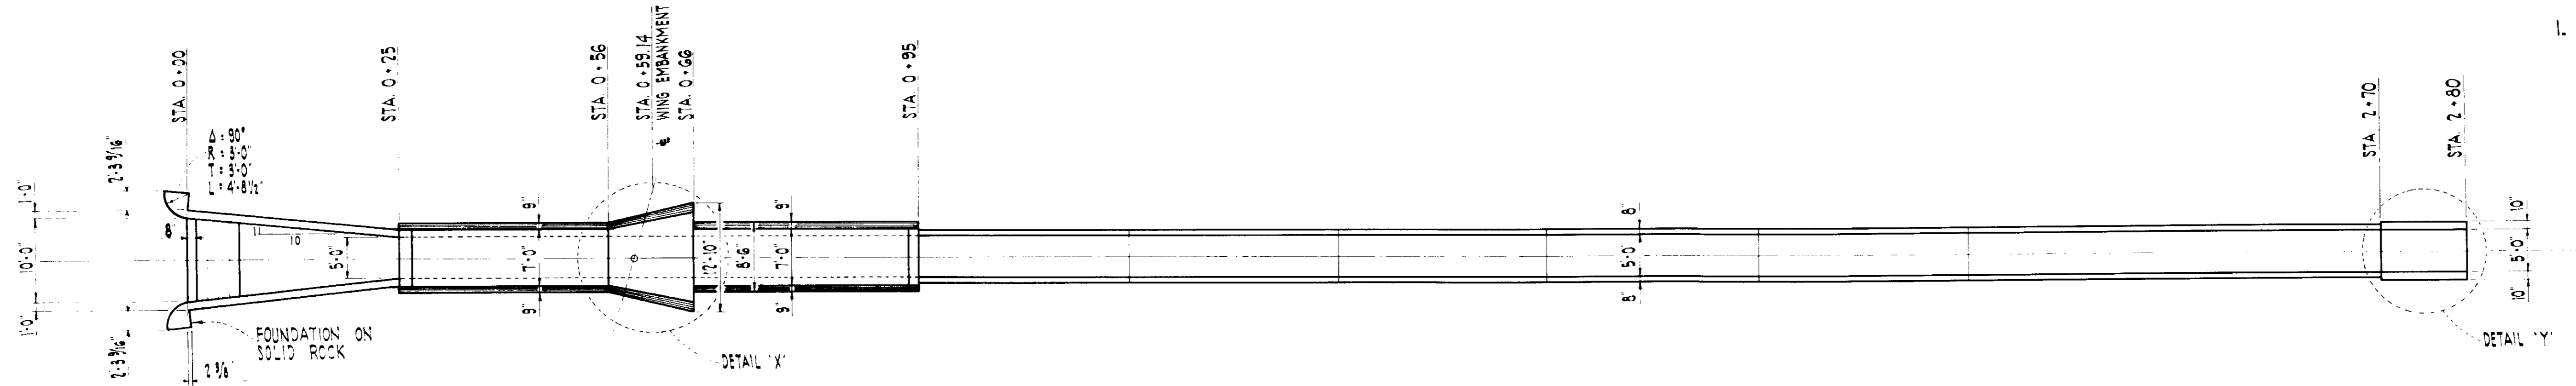


PLAN

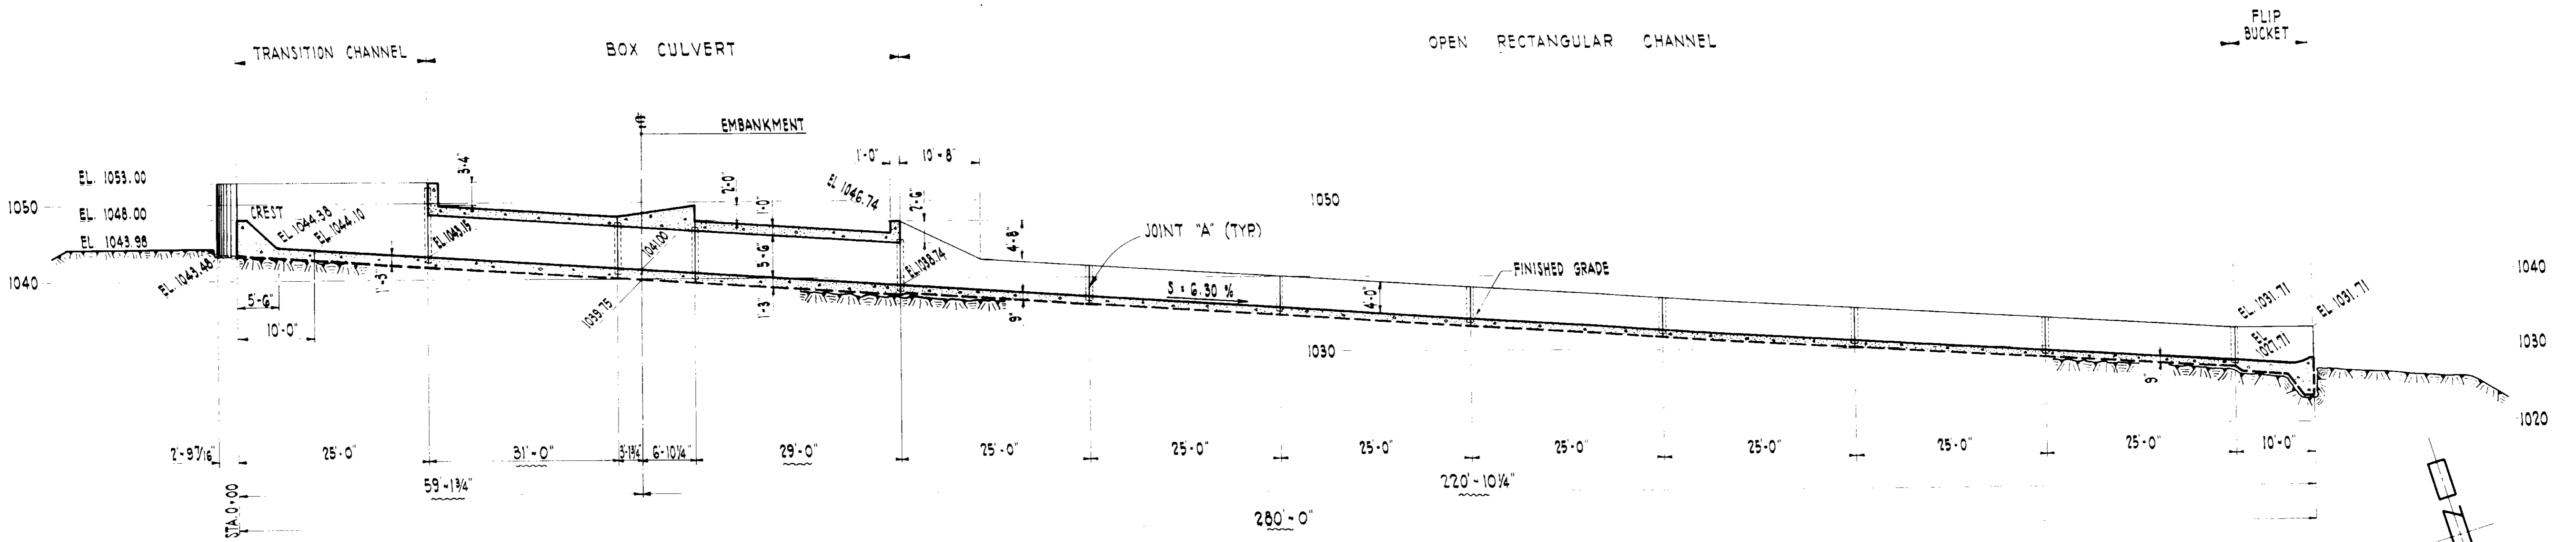


LONGITUDINAL SECTION

SPILLWAY ~ CONCRETE OUTLINES

SCALE: 3/32" = 1'-0"

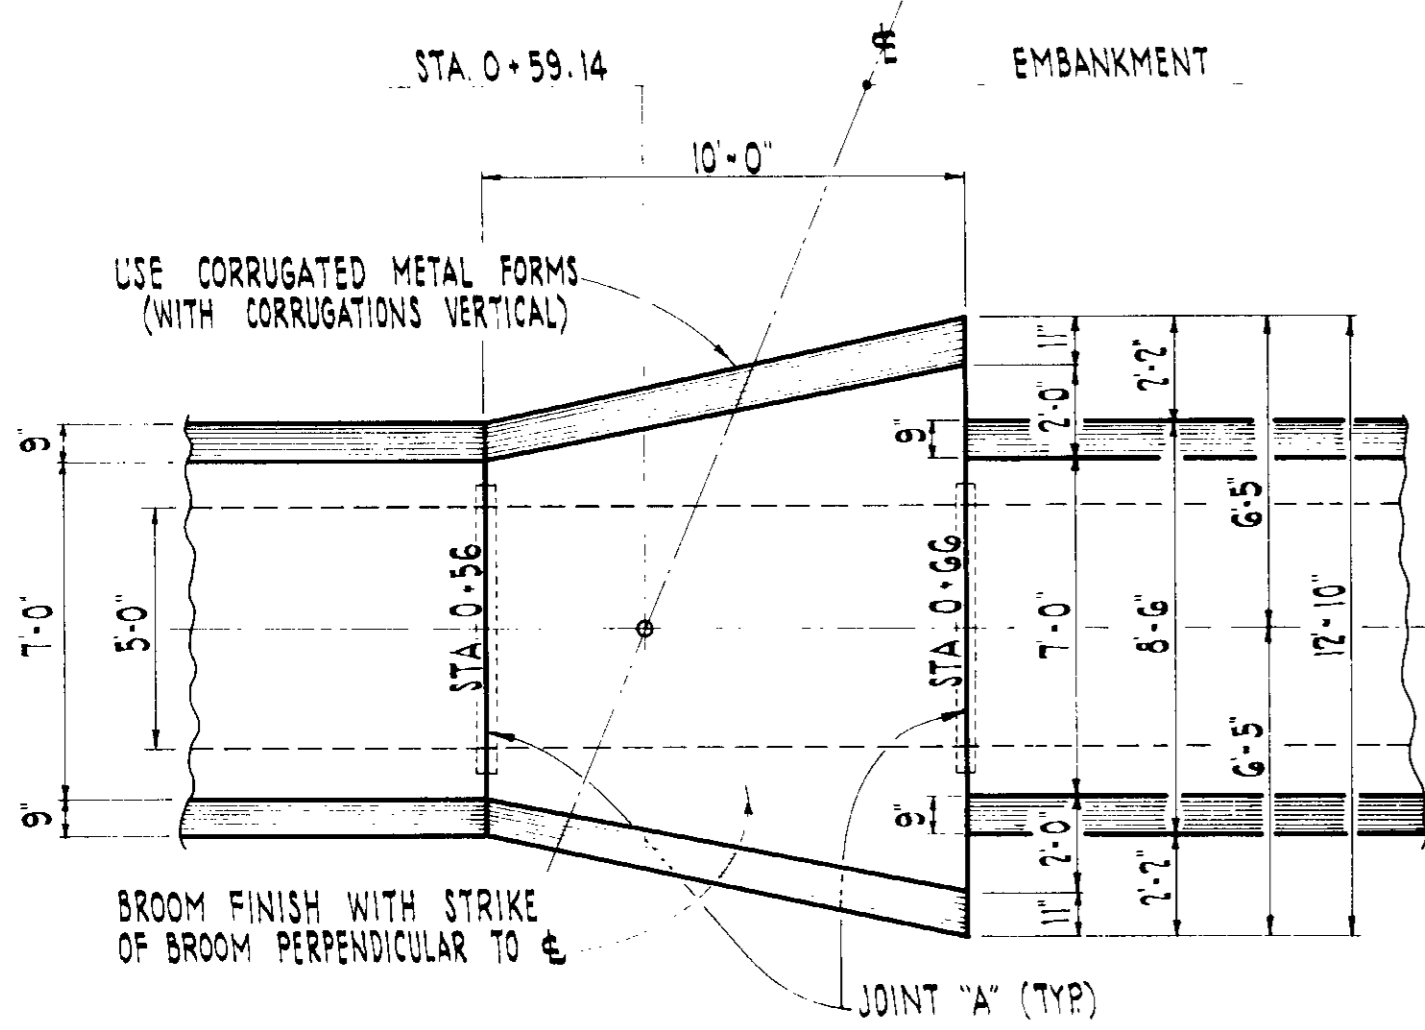


DETAIL 'X'  
SCALE: 1/4" = 1'-0"

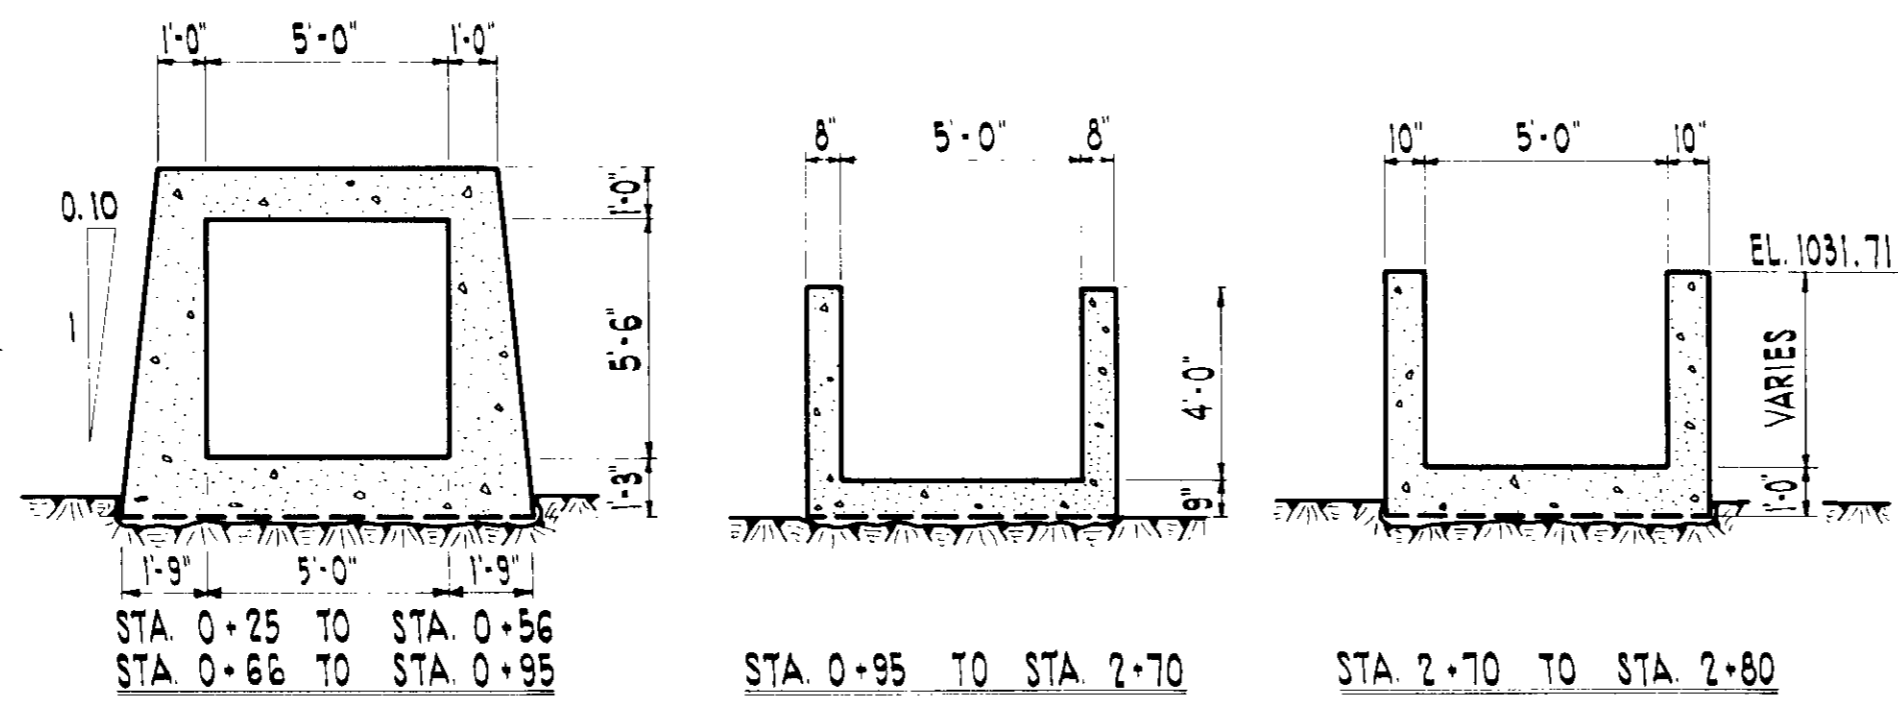


TYPICAL SPILLWAY SECTIONS


SCALE: 1/4" = 1'-0"

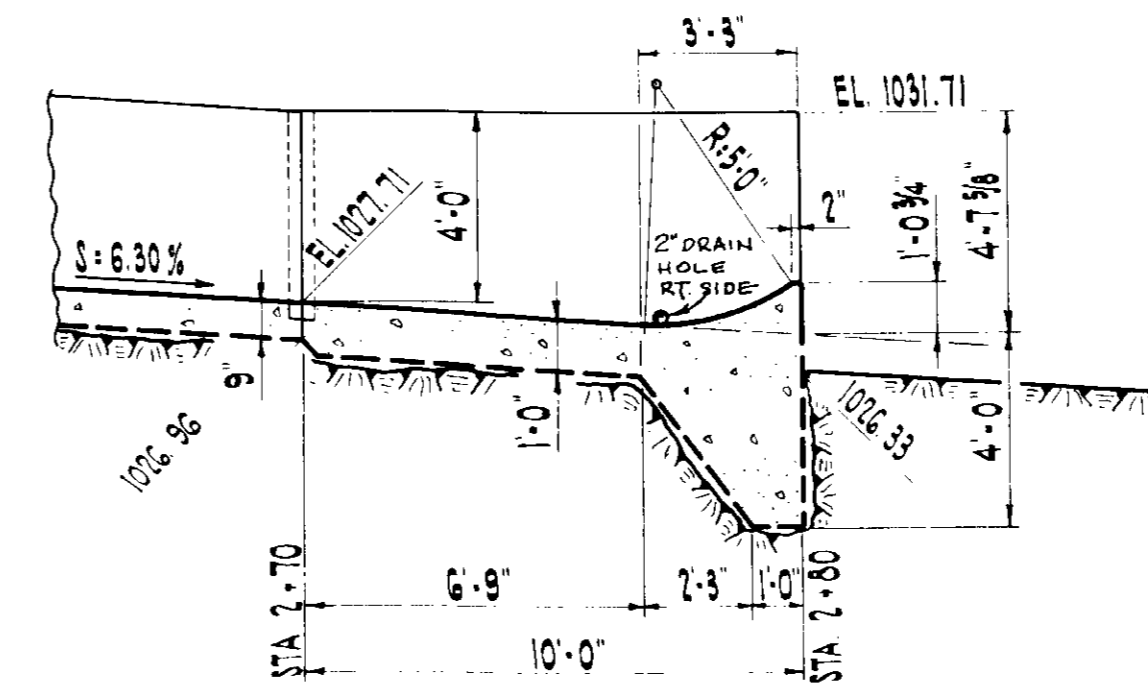

DETAIL 'Y'  
SCALE: 1/4" = 1'-0"

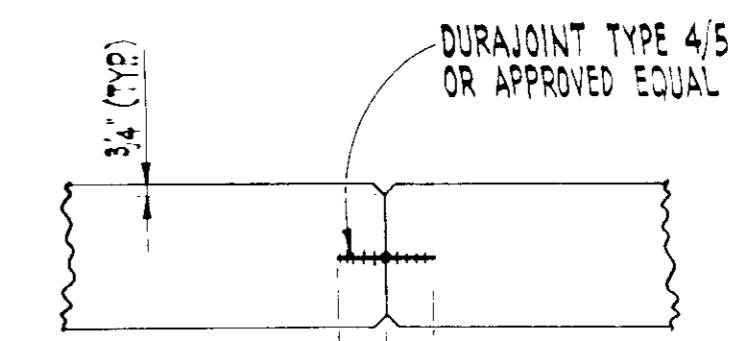

JOINT 'A'  
SCALE: NONE

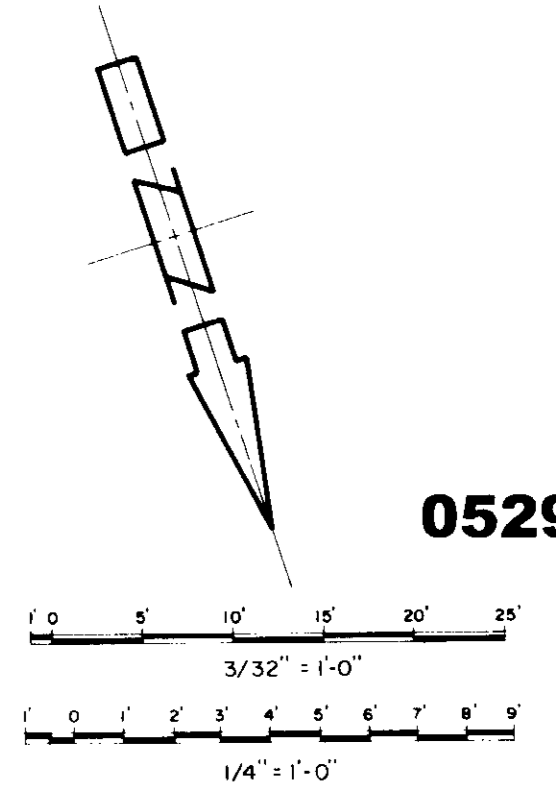


05295

ISSUED FOR CONSTRUCTION				DATE		BY		CHK		JOB		PROJ.		ENG.		MGR.	
LAS VIRGENES MUNICIPAL WATER DISTRICT																	
BOYLE ENGINEERING W. A. WAHLER & ASSOCIATES																	
WESTLAKE RESERVOIR SPILLWAY CONCRETE OUTLINES																	
DESIGNED	DATE	11-70	JOB	ENG.	D.M.	PROJ.	ENG.	L.A.									
DRAWN	DRAWING NUMBER																
CHECKED	REV.																
SCALE AS SHOWN	32																


NOTES

1. For General Concrete Notes see Drawing No. 28

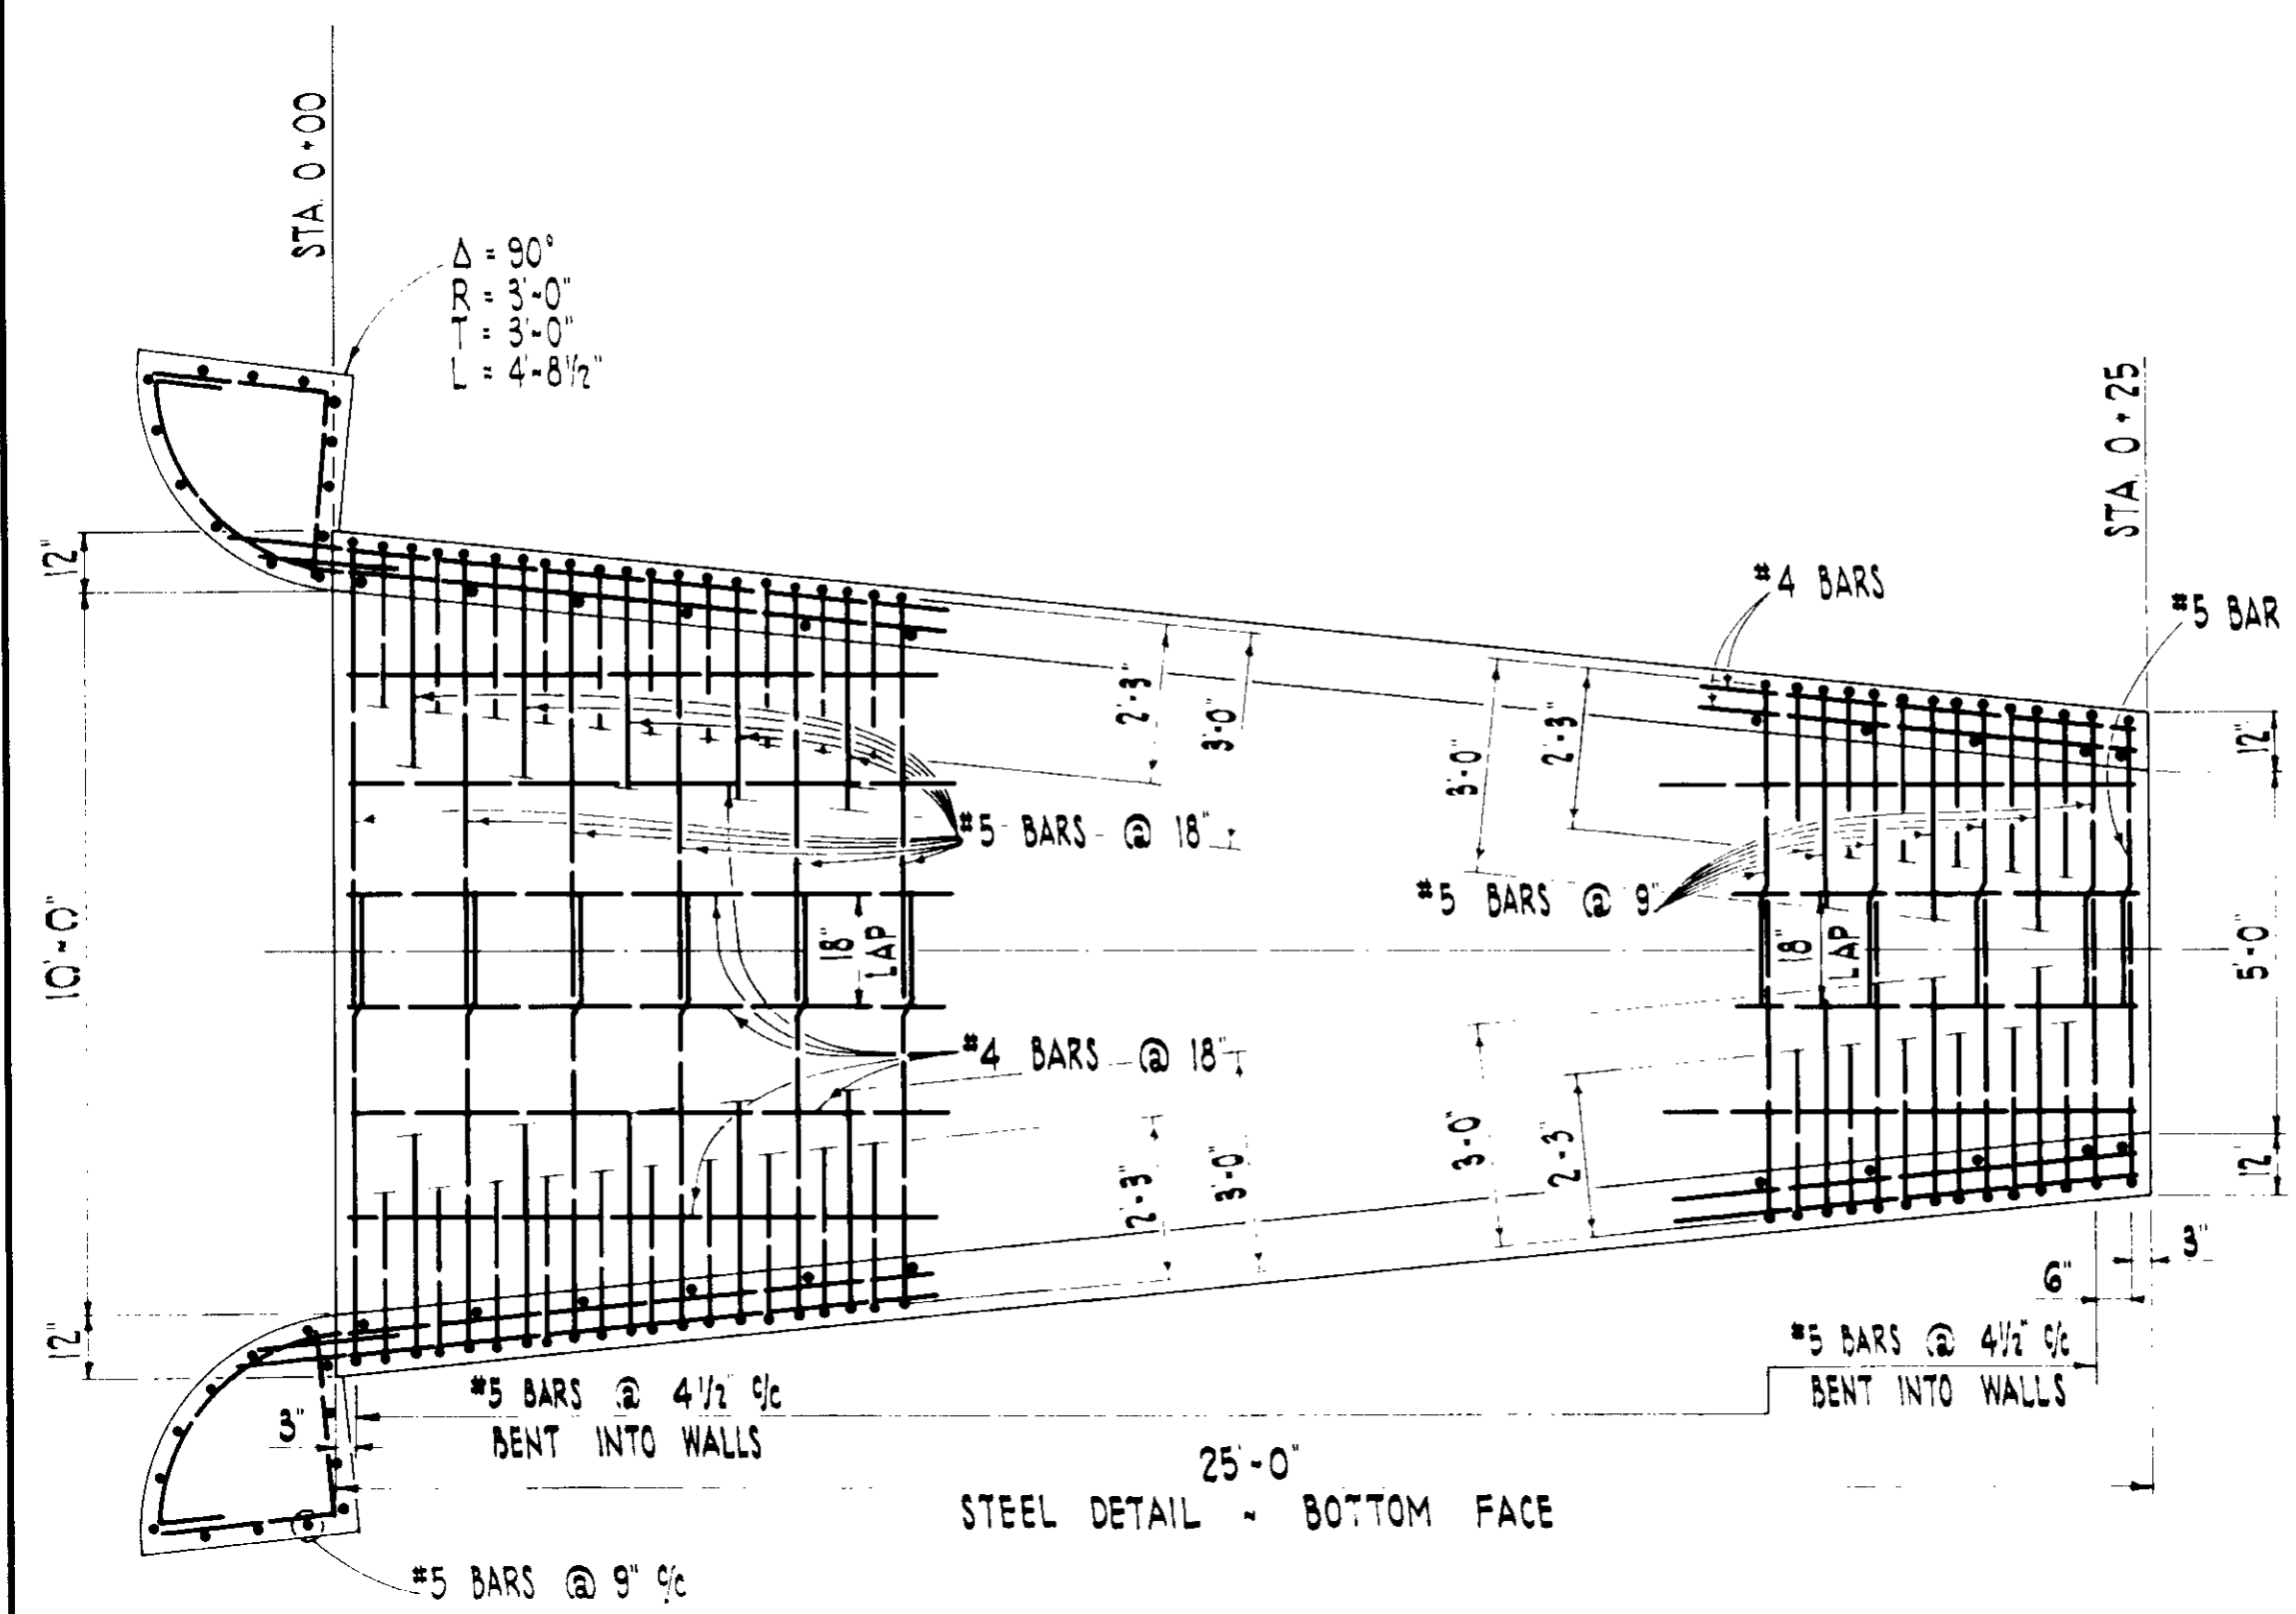

STEEL DETAIL - BOTTOM FACE

PLAN

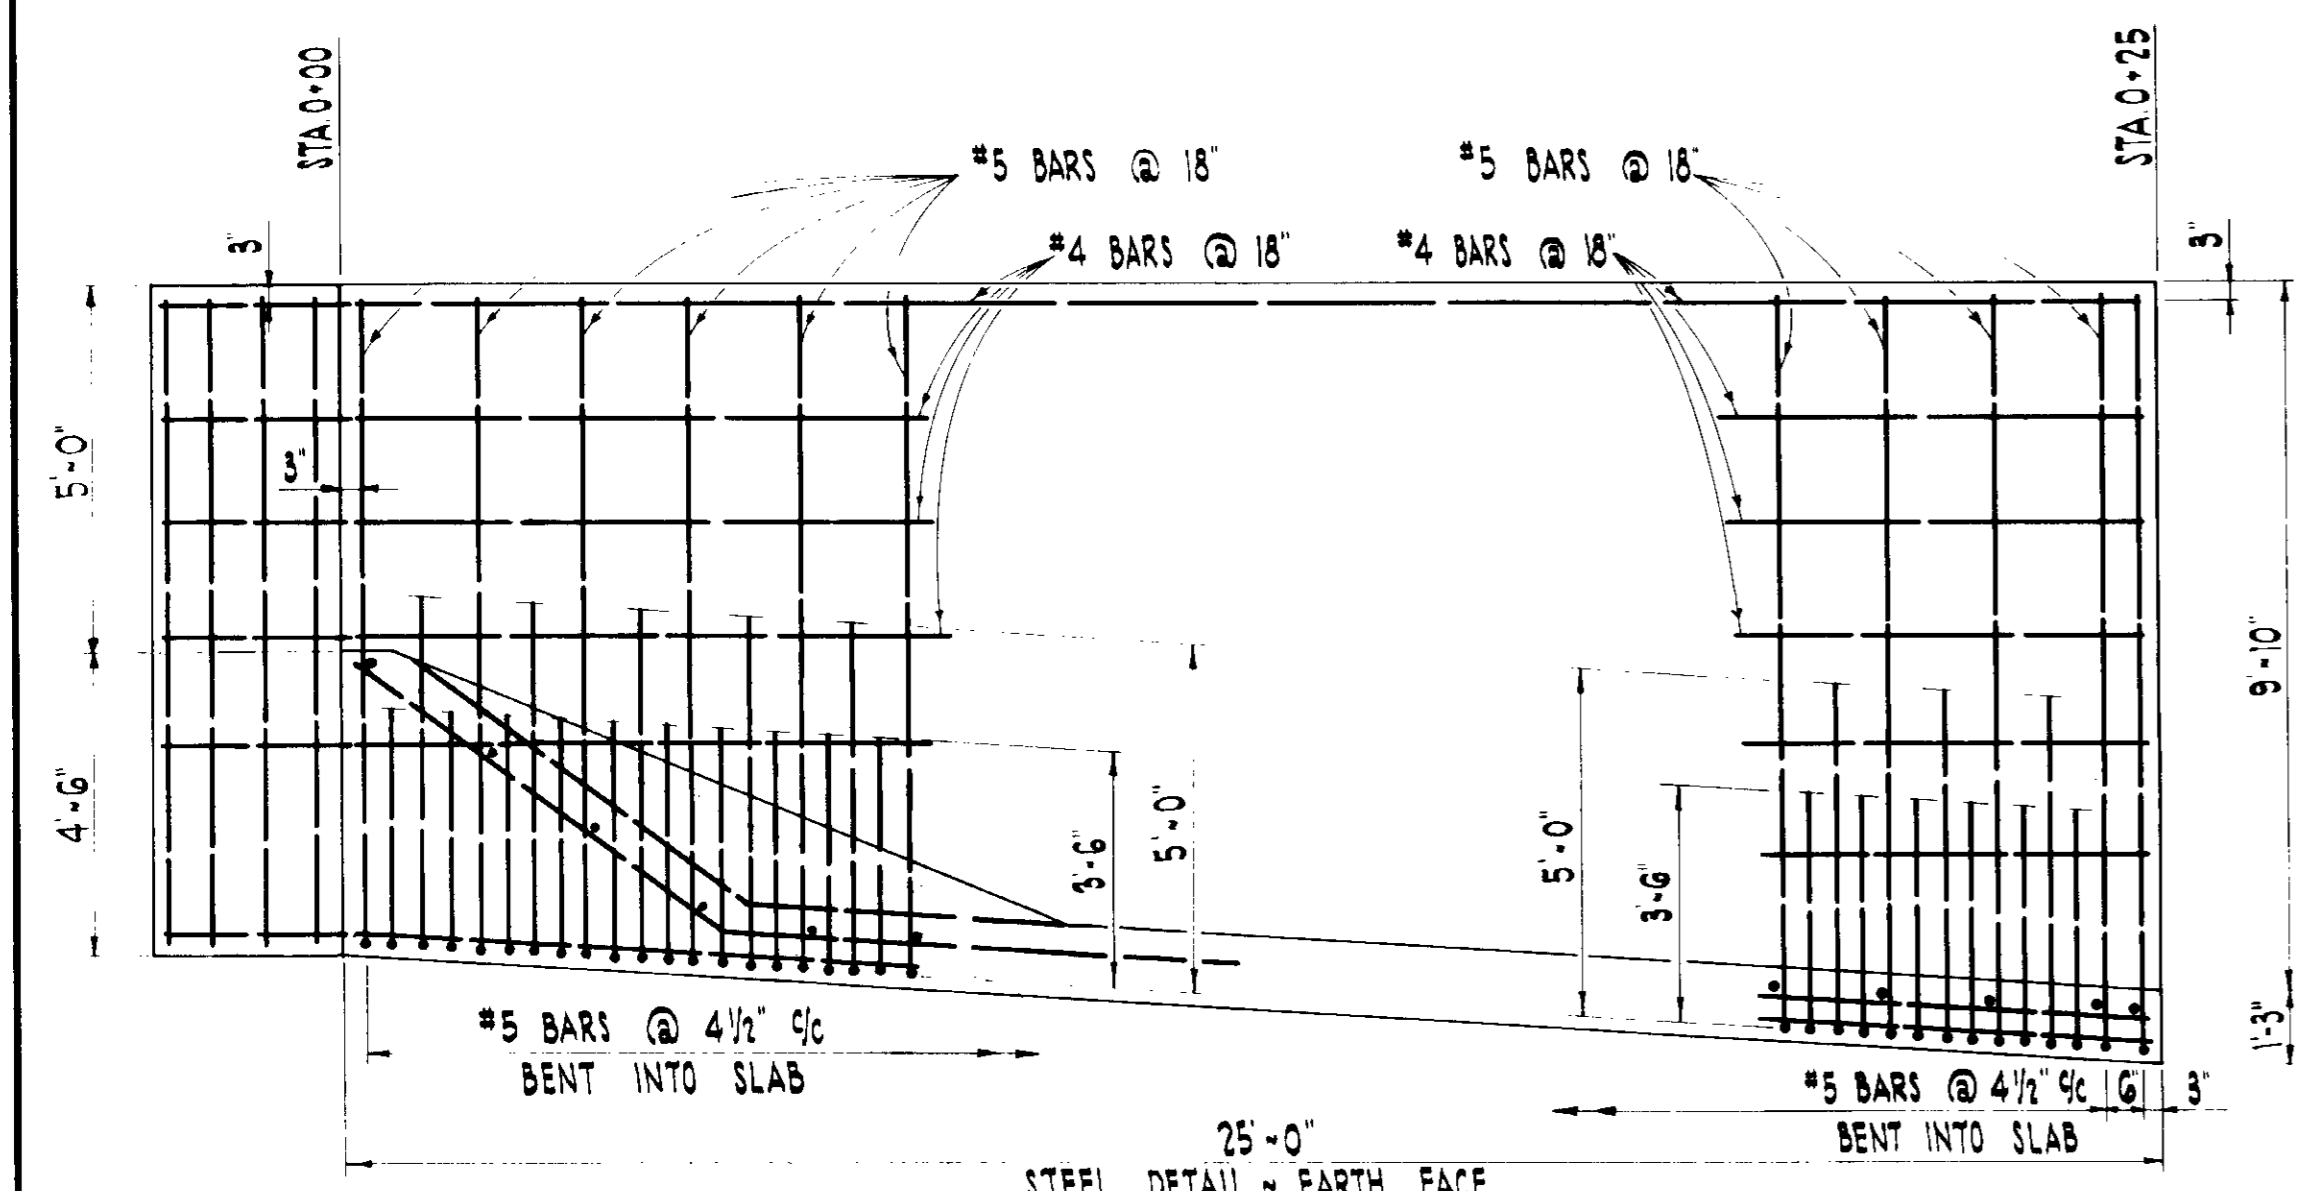


STEEL DETAIL - EARTH FACE

ELEVATION


SPILLWAY INLET TRANSITION

SCALE: 3/8" = 1'-0"

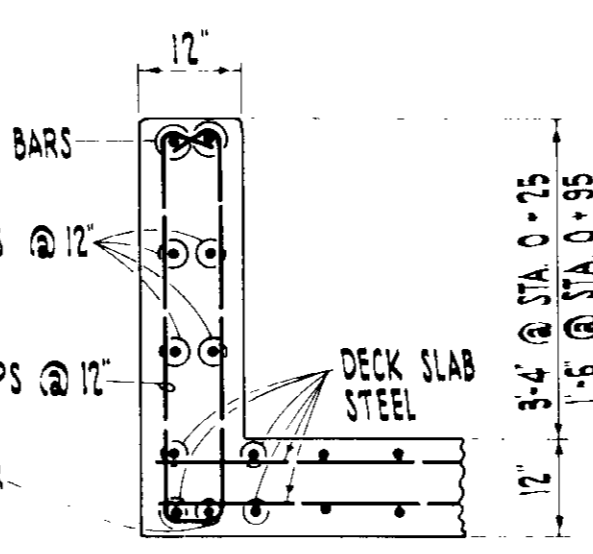

DETAIL 'A'


SCALE: 1/2" = 1'-0"

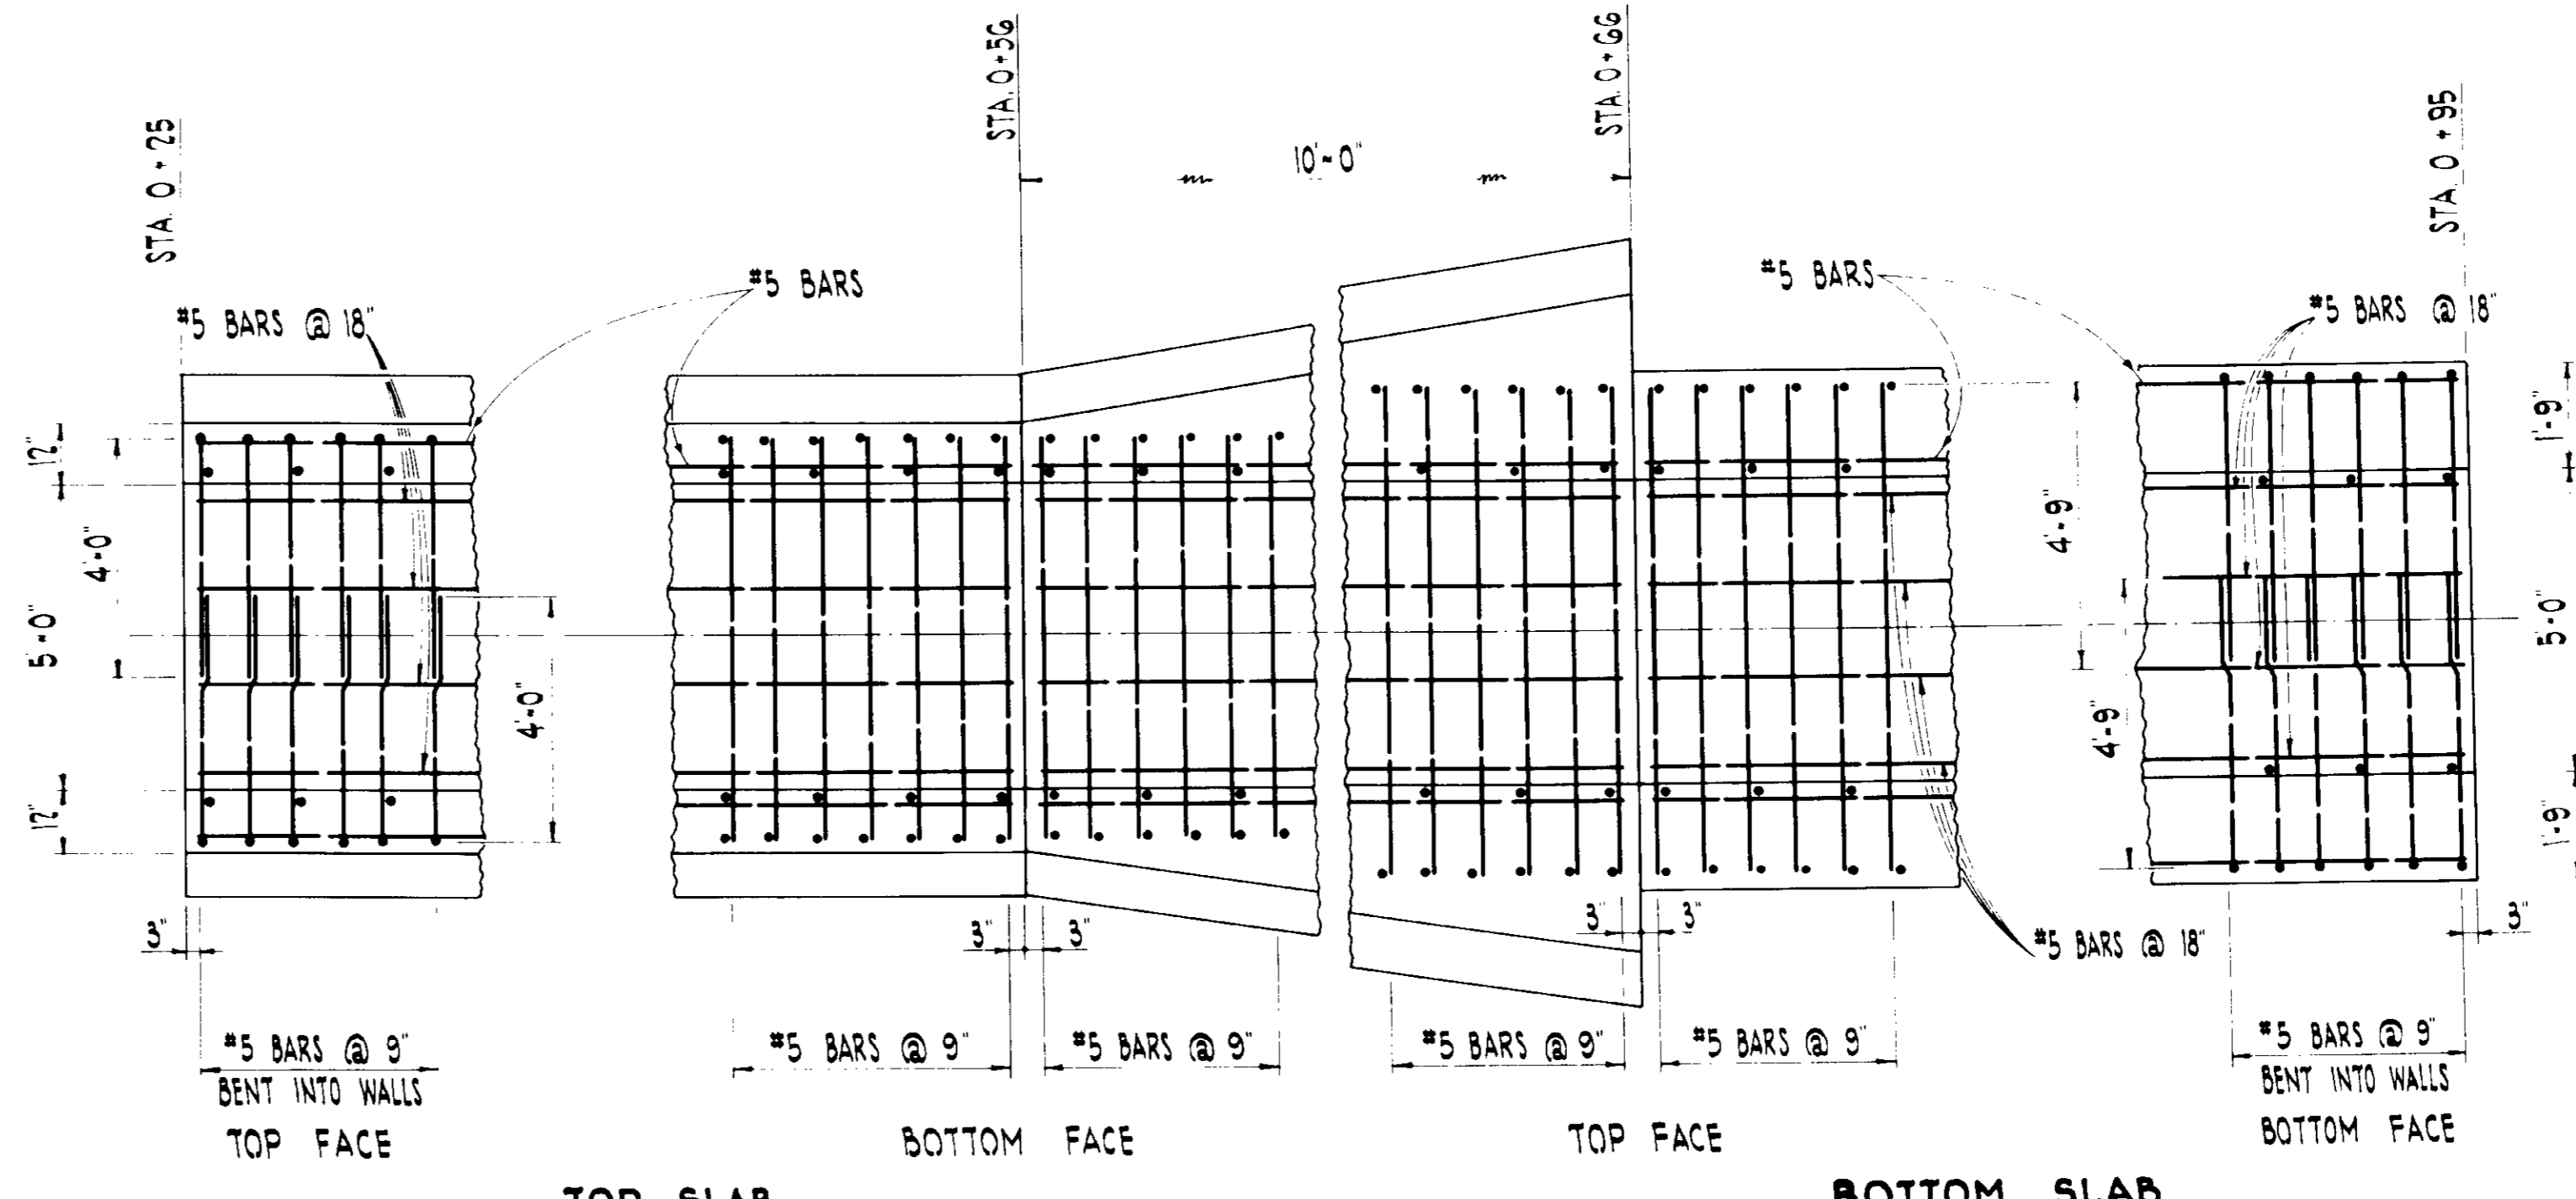

TOP SLAB

PLAN

BOTTOM SLAB

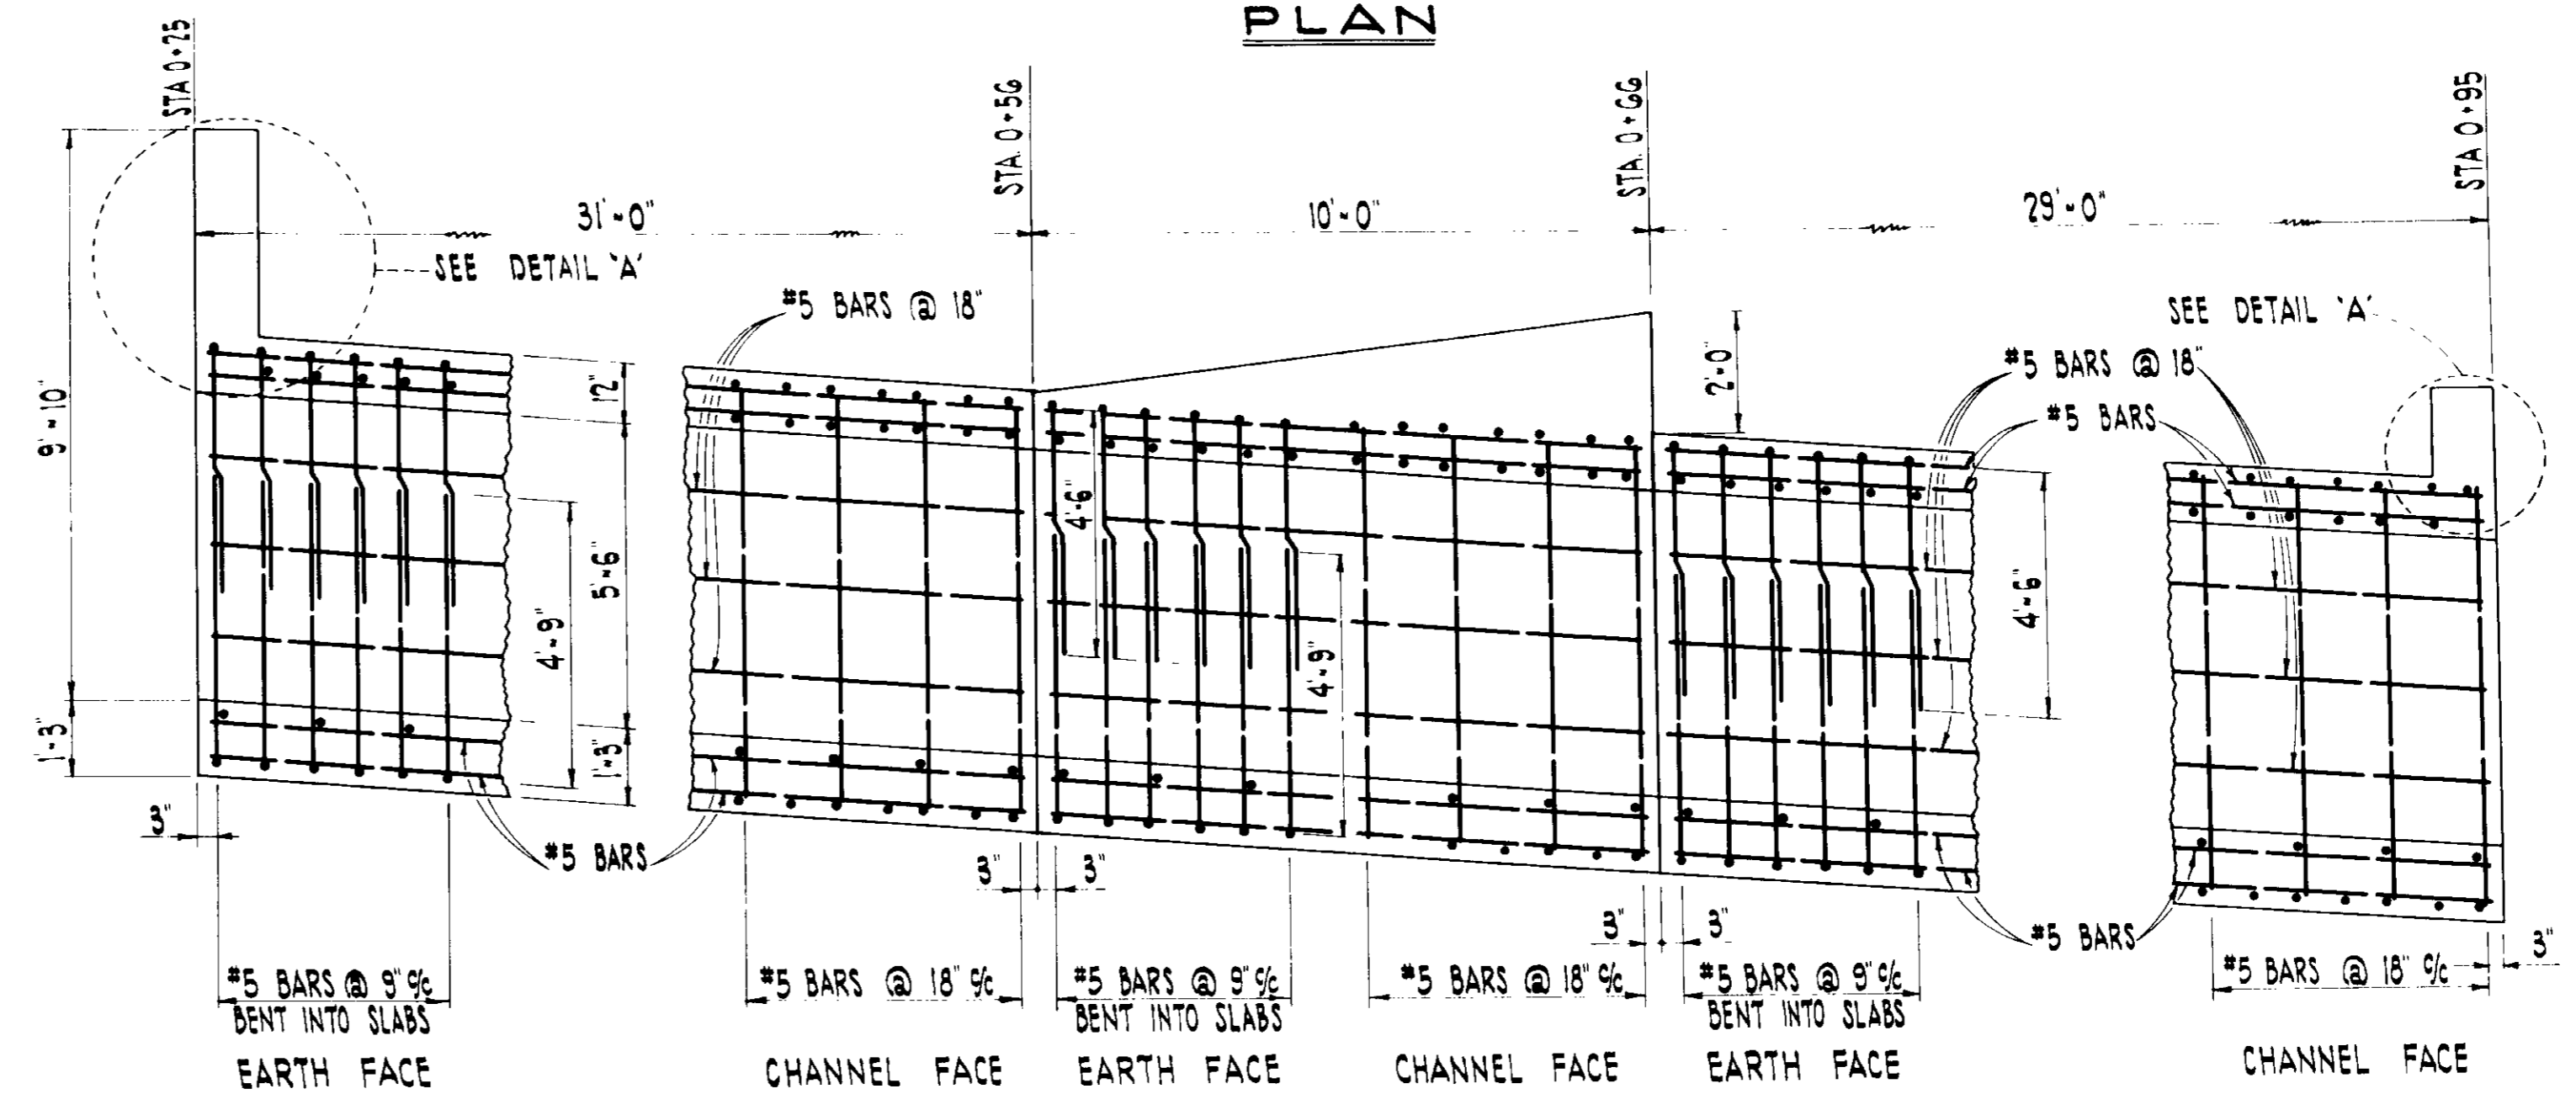

EARTH FACE

ELEVATION


SPILLWAY BOX CULVERT SECTION

SCALE: 3/8" = 1'-0"

REFERENCE DRAWINGS

32 CONCRETE OUTLINES

05296

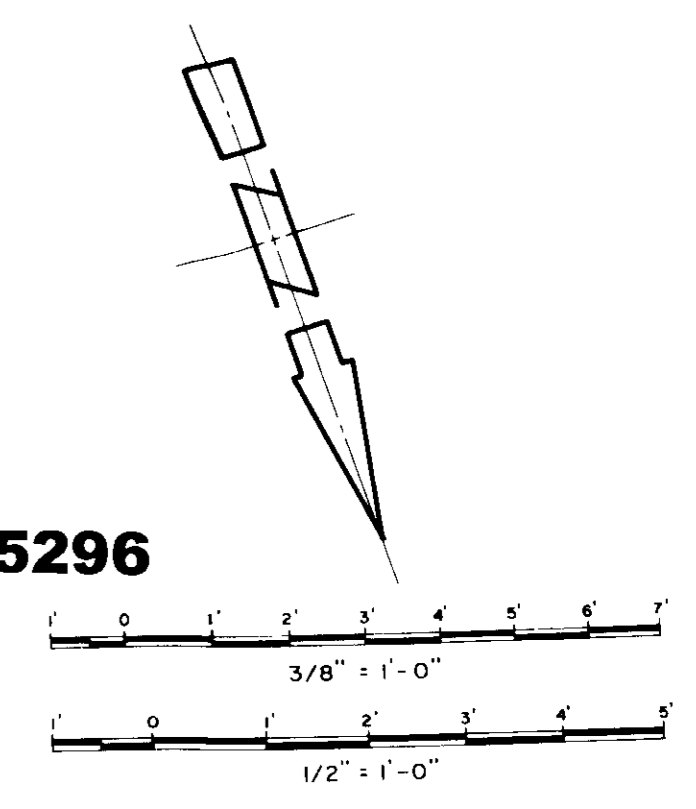

NO.	DATE	ISSUED FOR CONSTRUCTION	REVISIONS	BY	CHK	JOB	PROJ.

LAS VIRGENES MUNICIPAL WATER DISTRICT

BOYLE ENGINEERING  
W. A. WAHLER & ASSOCIATES


WESTLAKE RESERVOIR  
SPILLWAY

REINFORCING - SHEET 1 OF 2


DESIGNED	DATE: 11-70	JOB	PROJ.
DRAWN		ENG. DFM	ENG. JW
CHECKED			
SCALE AS SHOWN			

NOT REPRODUCED  
DATE: 12-18-73  
BY: H.W.R. DFM




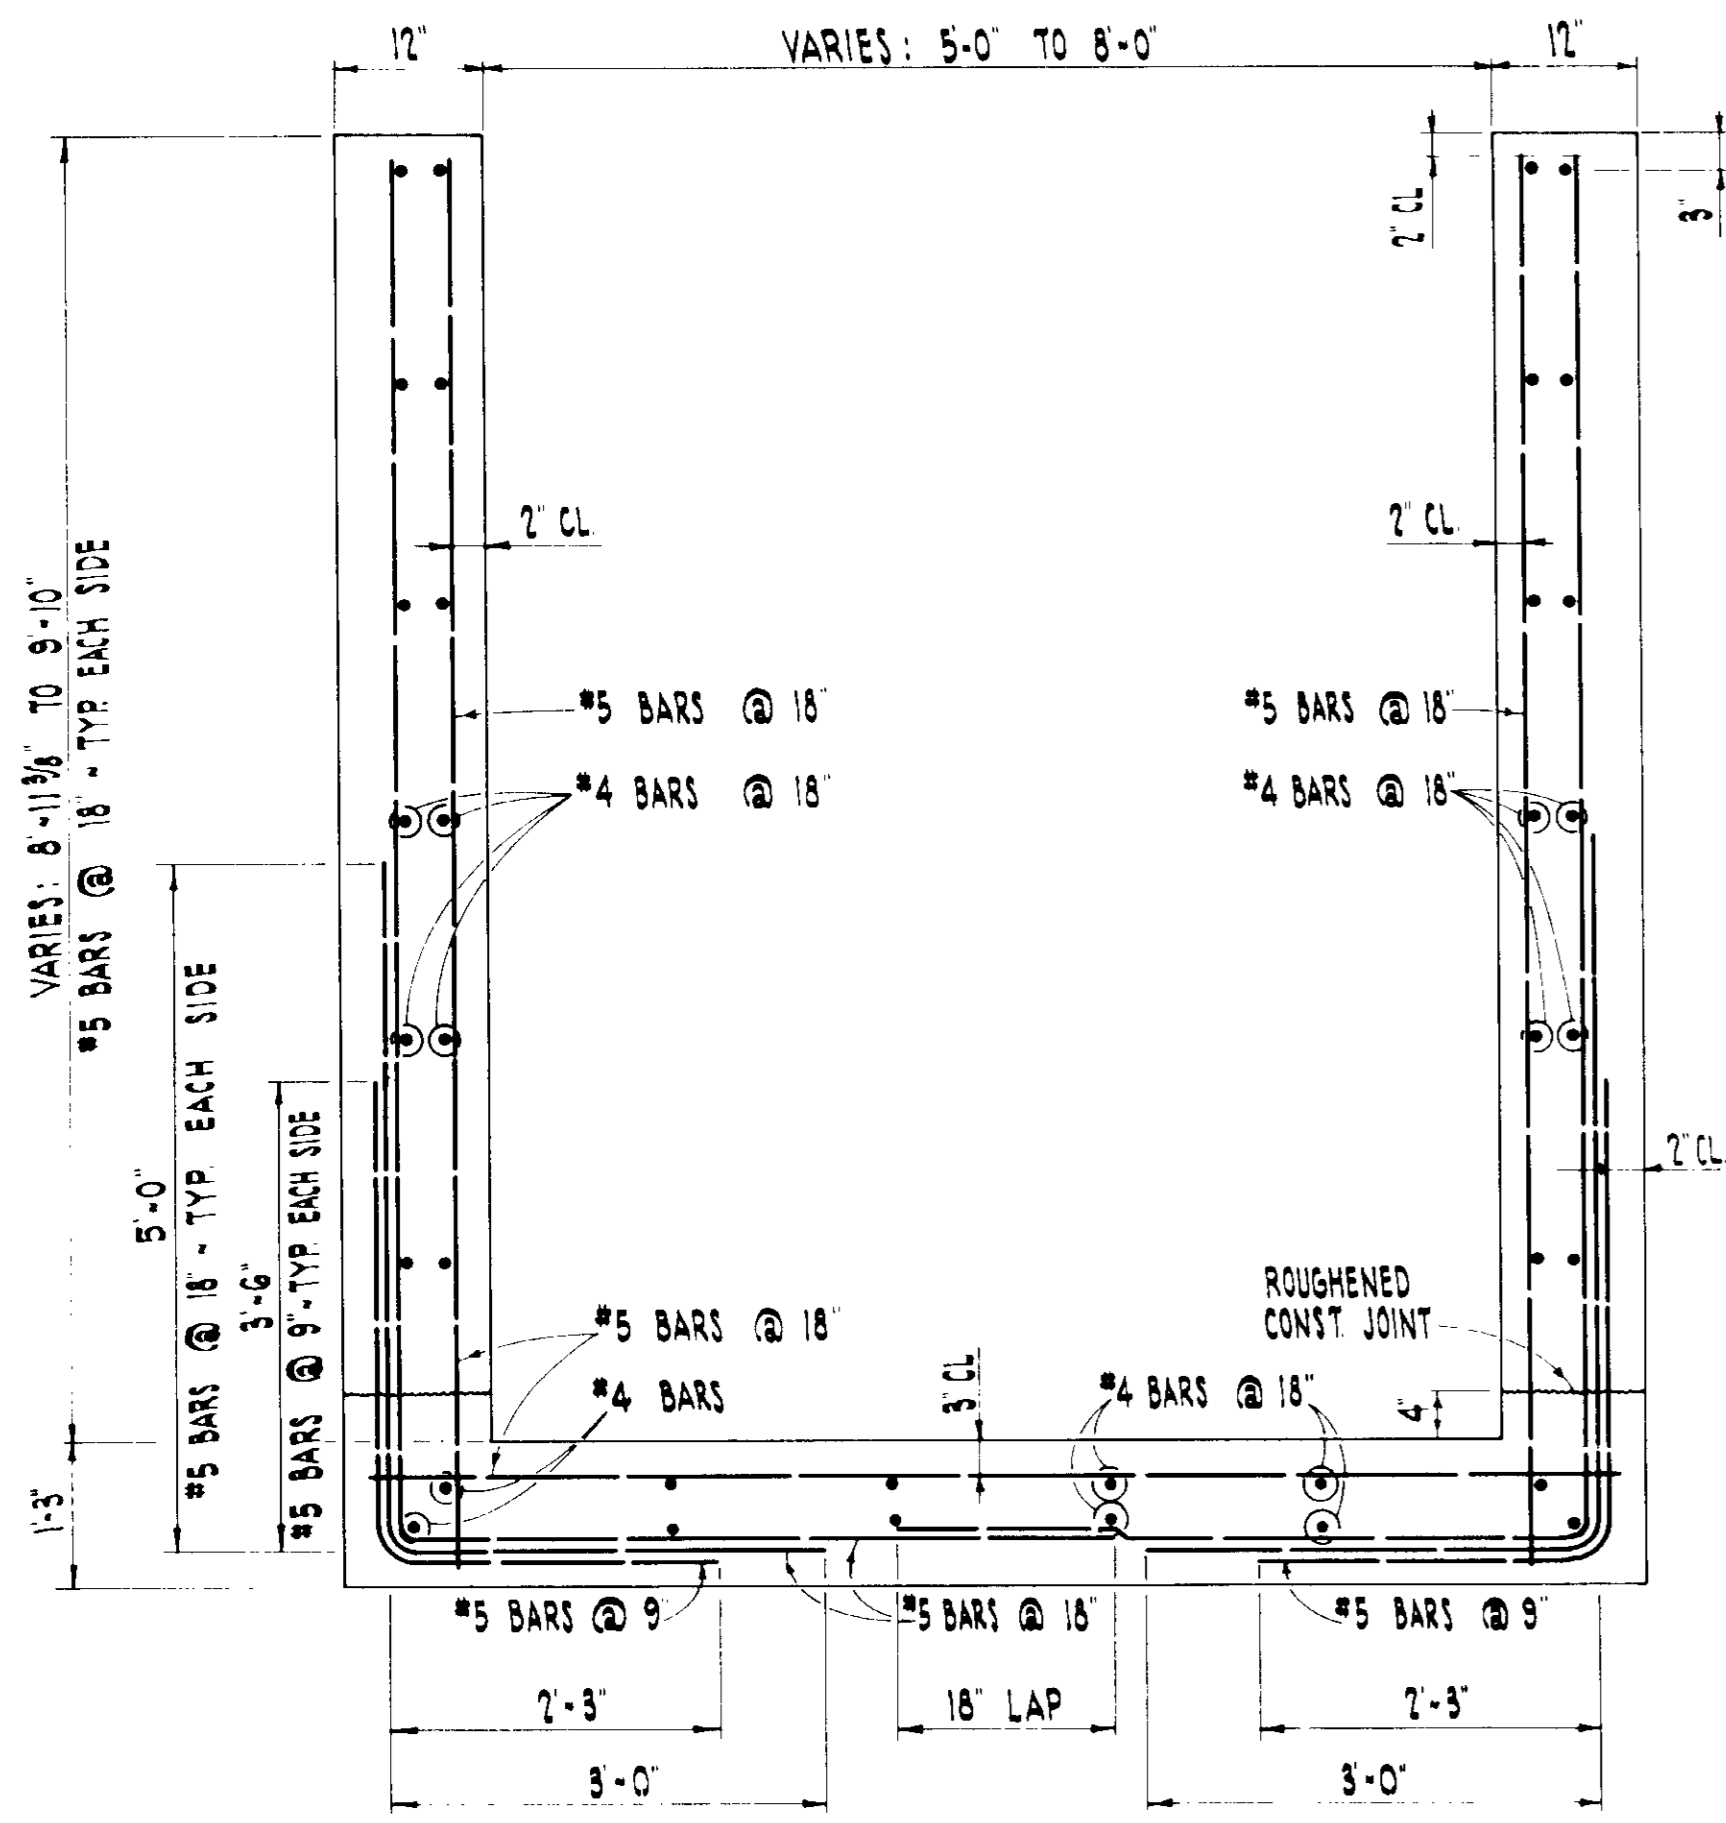


**TYPICAL TRANSITION SECTION**  
 STA. 0+10 TO STA. 0+25  
 SCALE: 3/4" = 1'-0"

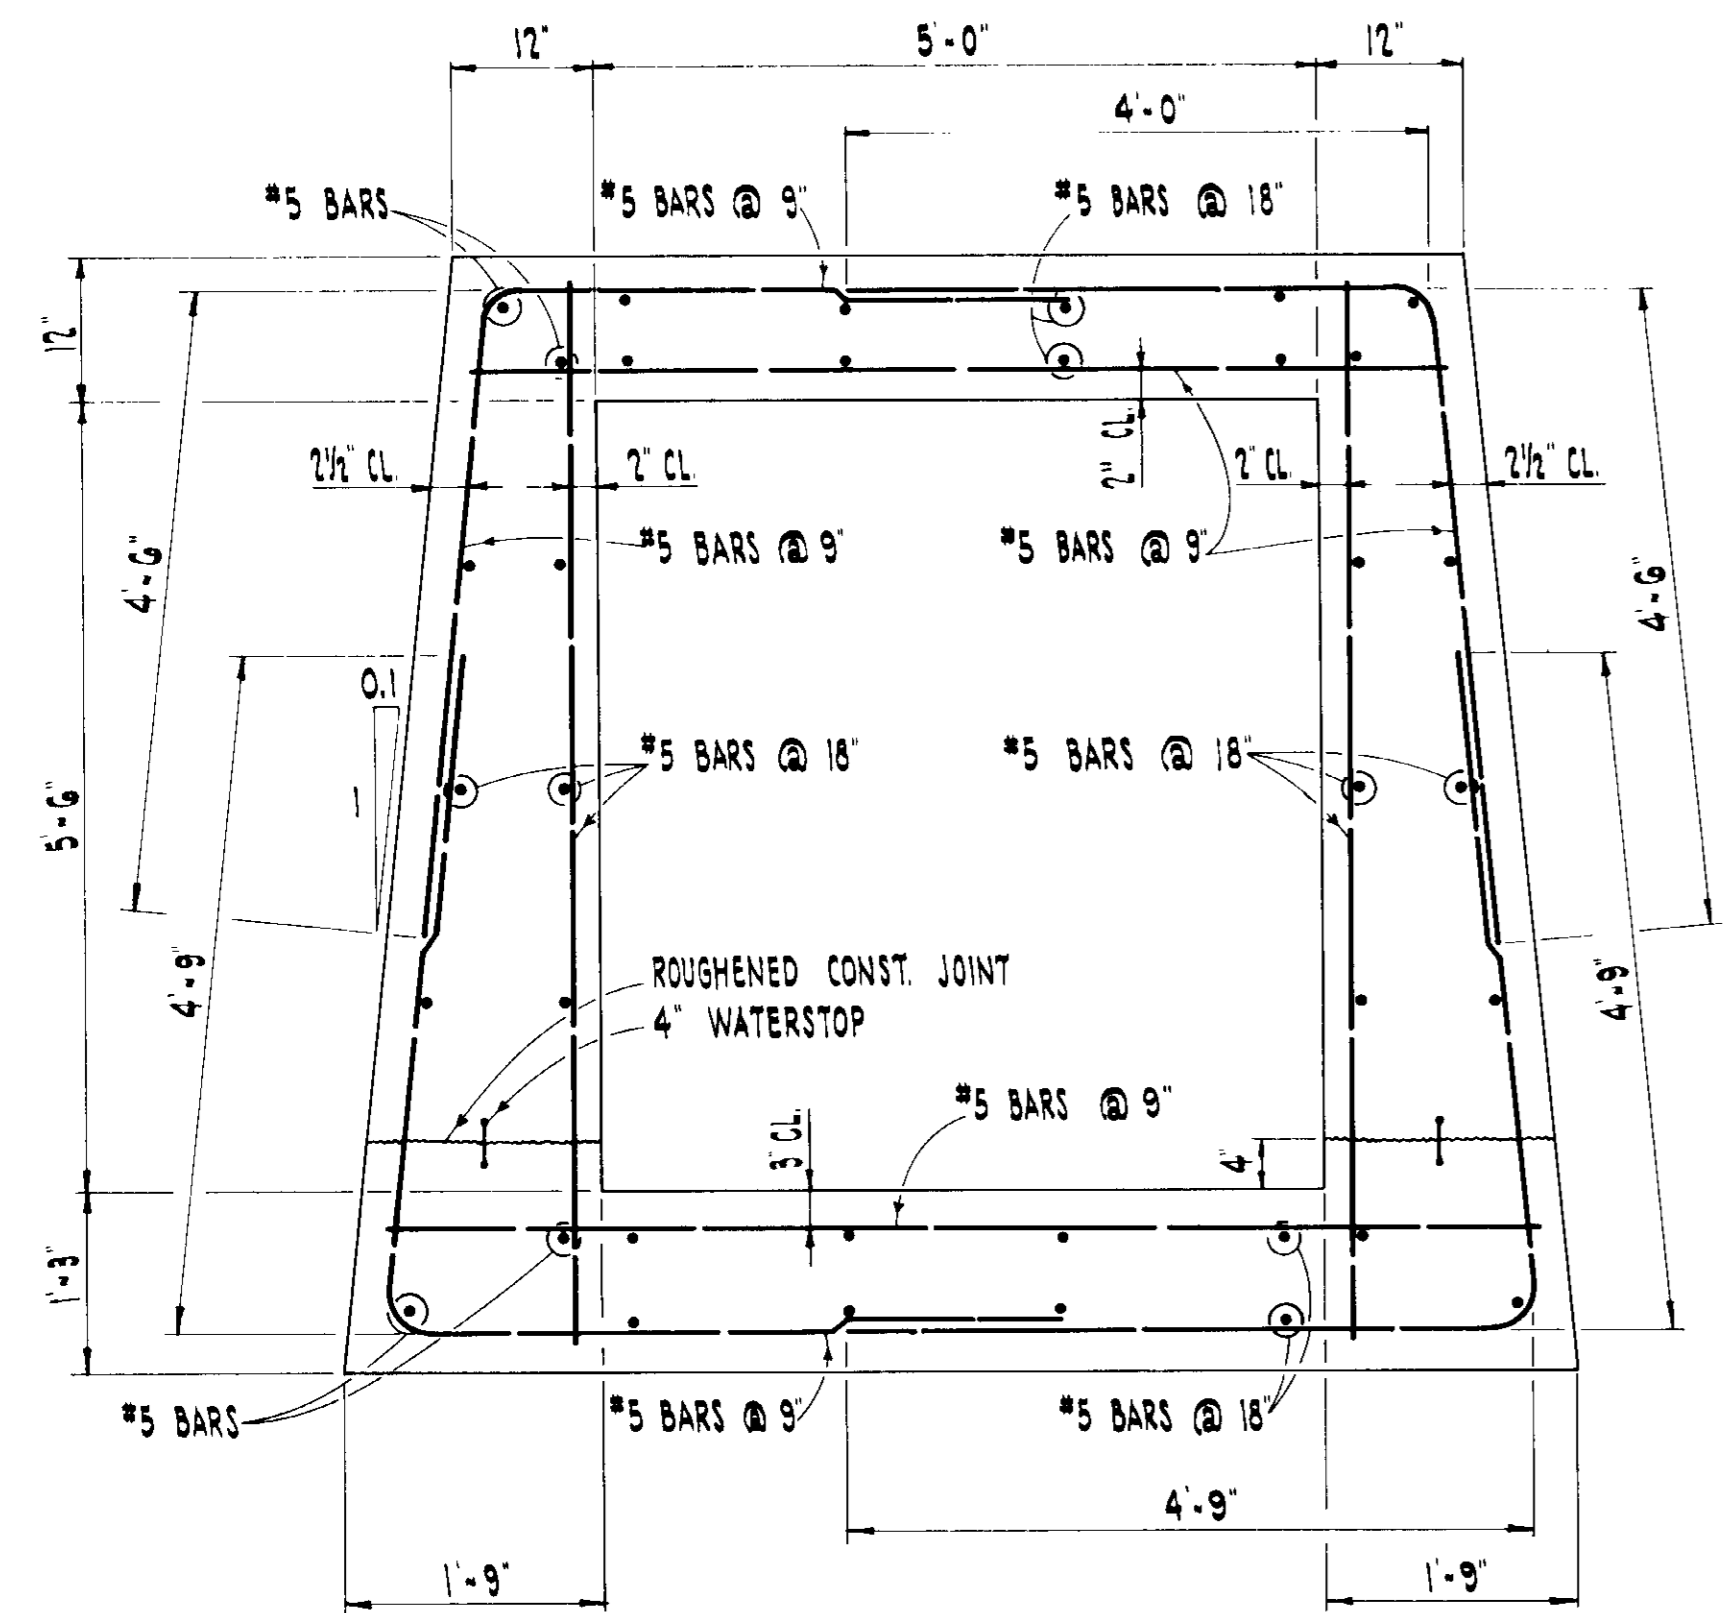


**TYPICAL BOX CULVERT SECTION**  
 SCALE: 3/4" = 1'-0"

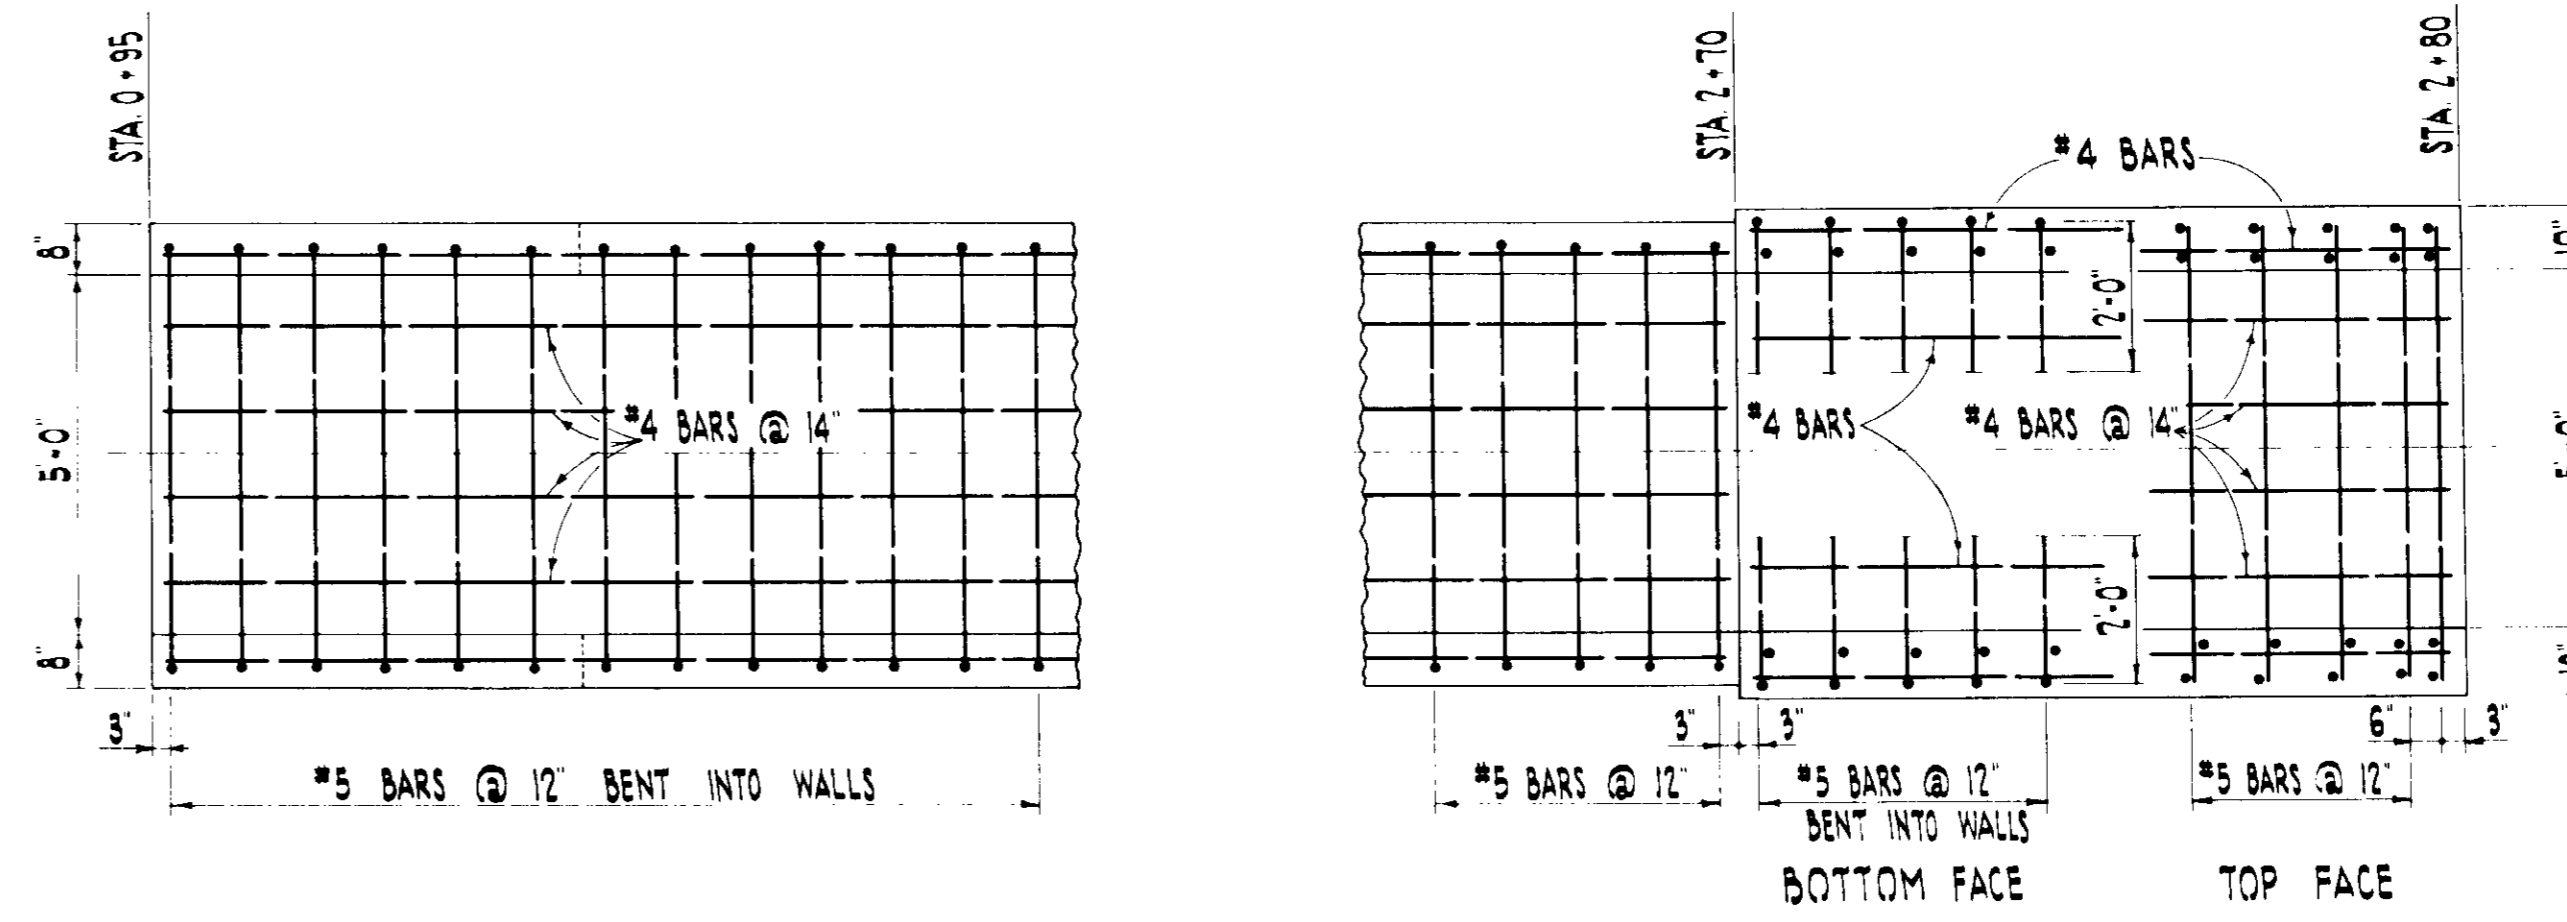

**PLAN**

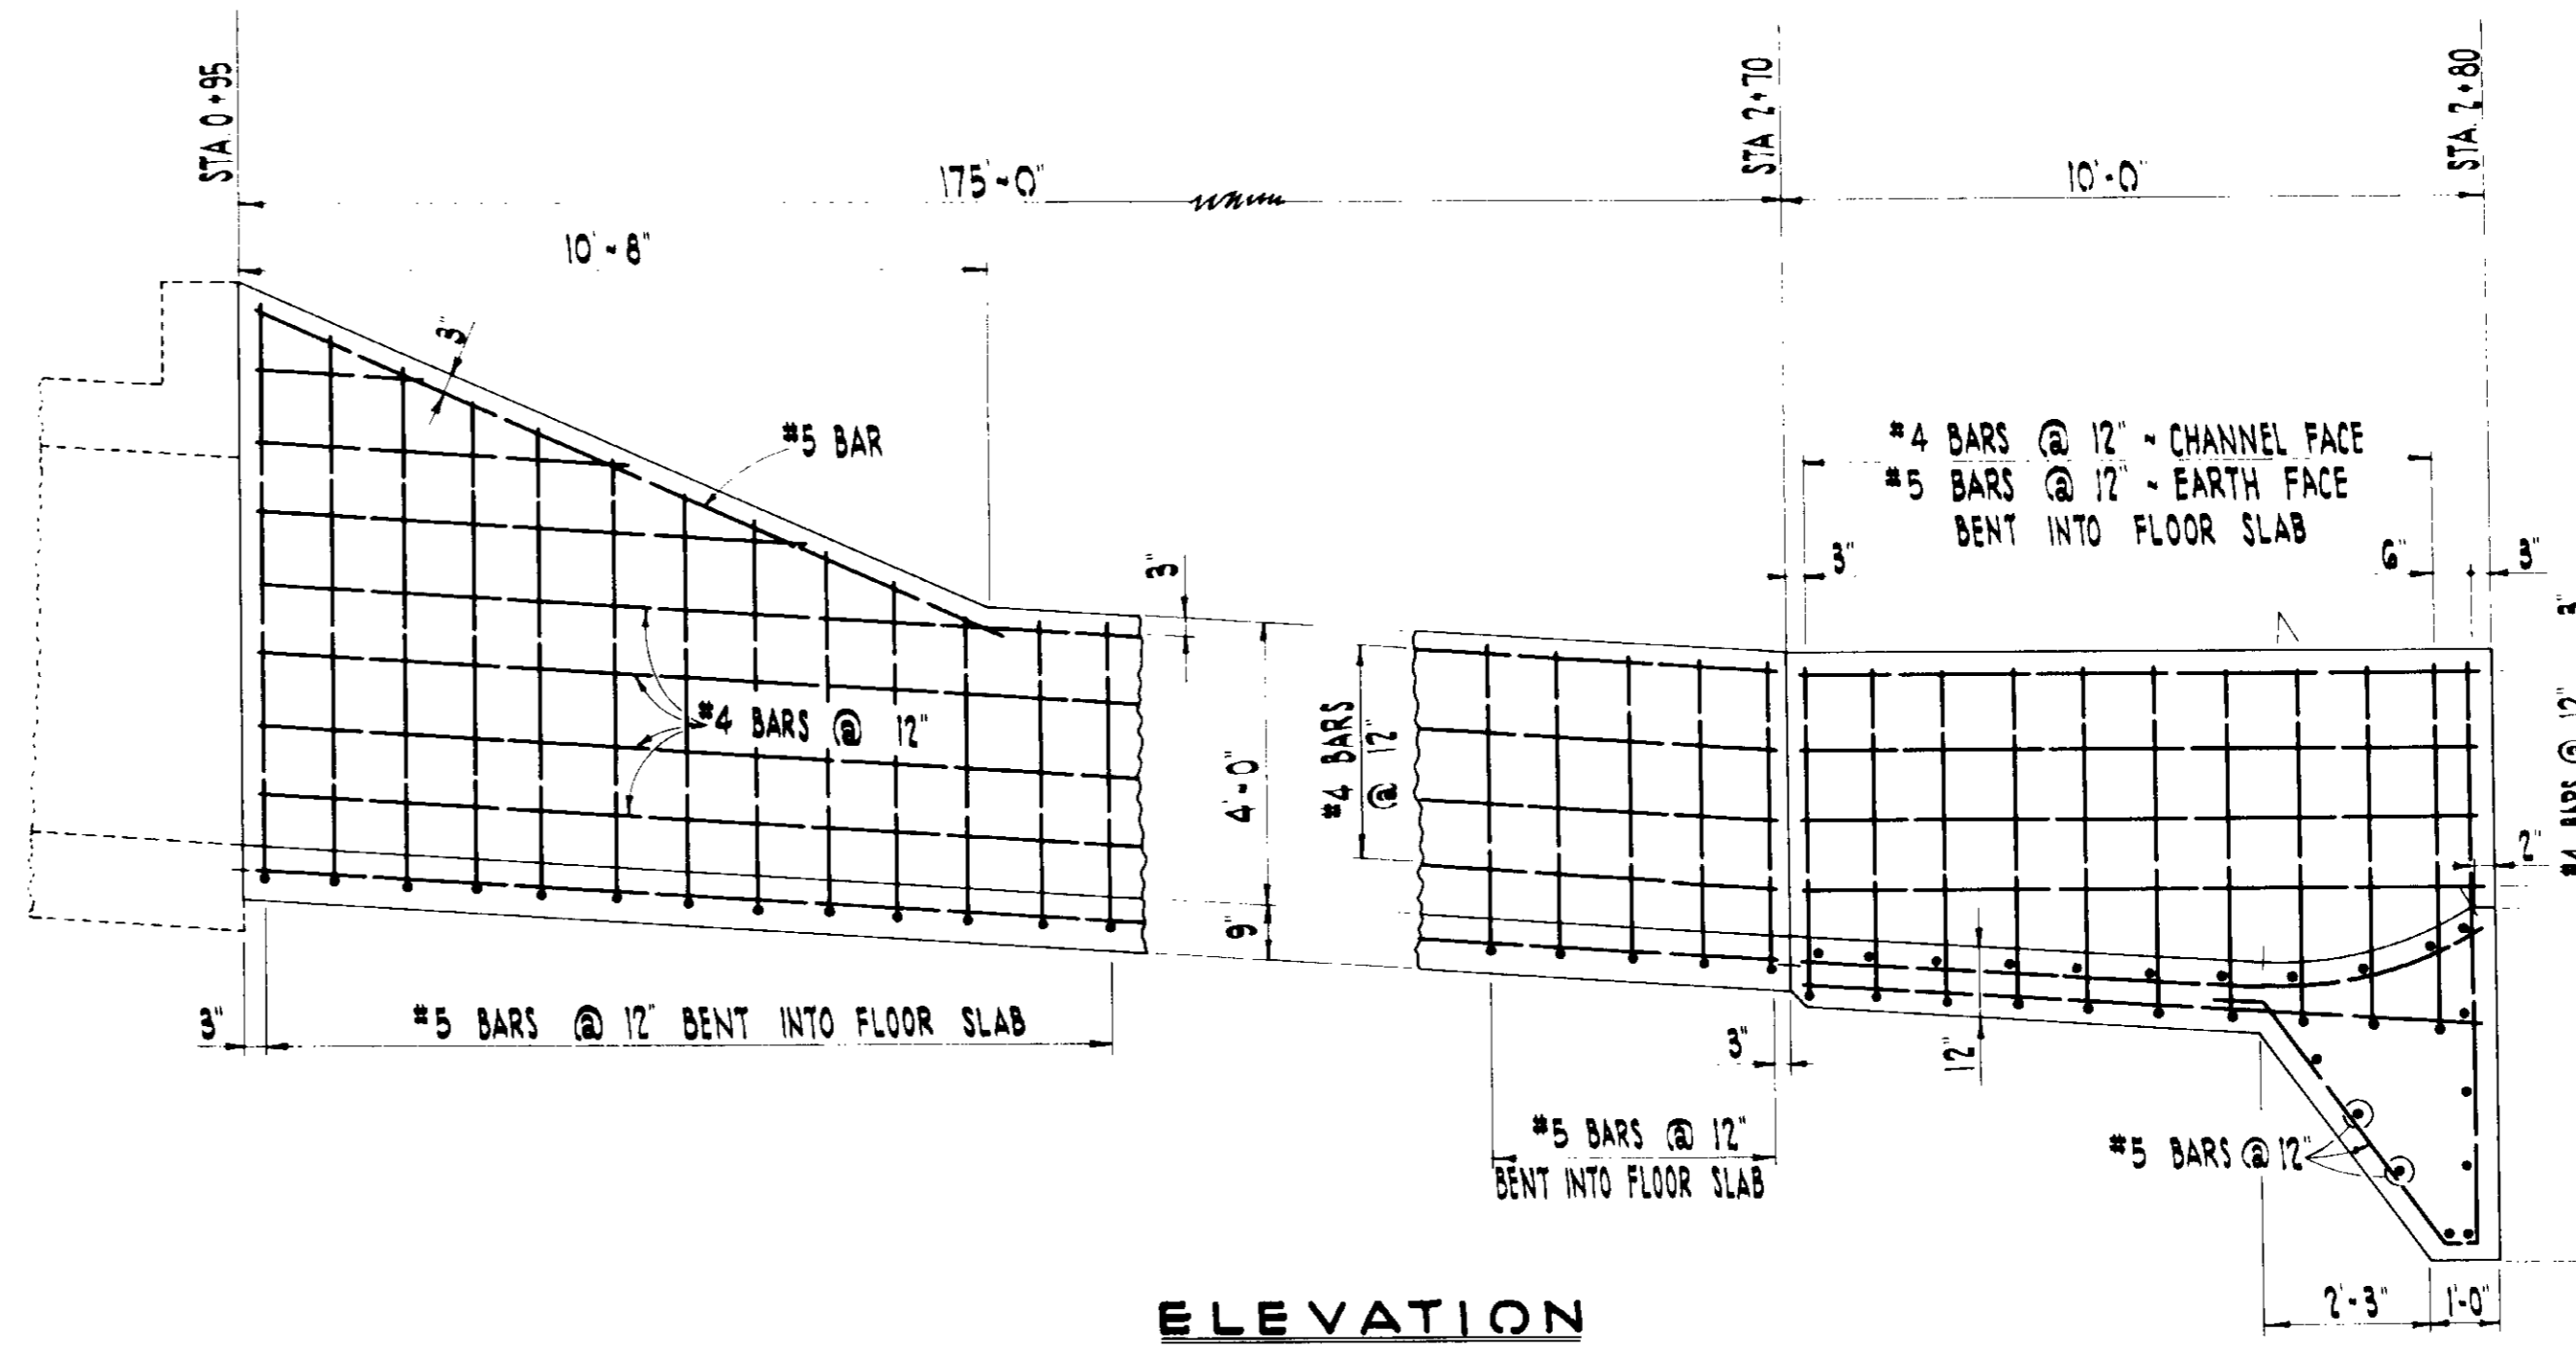

**ELEVATION**  
**OPEN RECTANGULAR CHANNEL SPILLWAY**  
 SCALE: 3/8" = 1'-0"

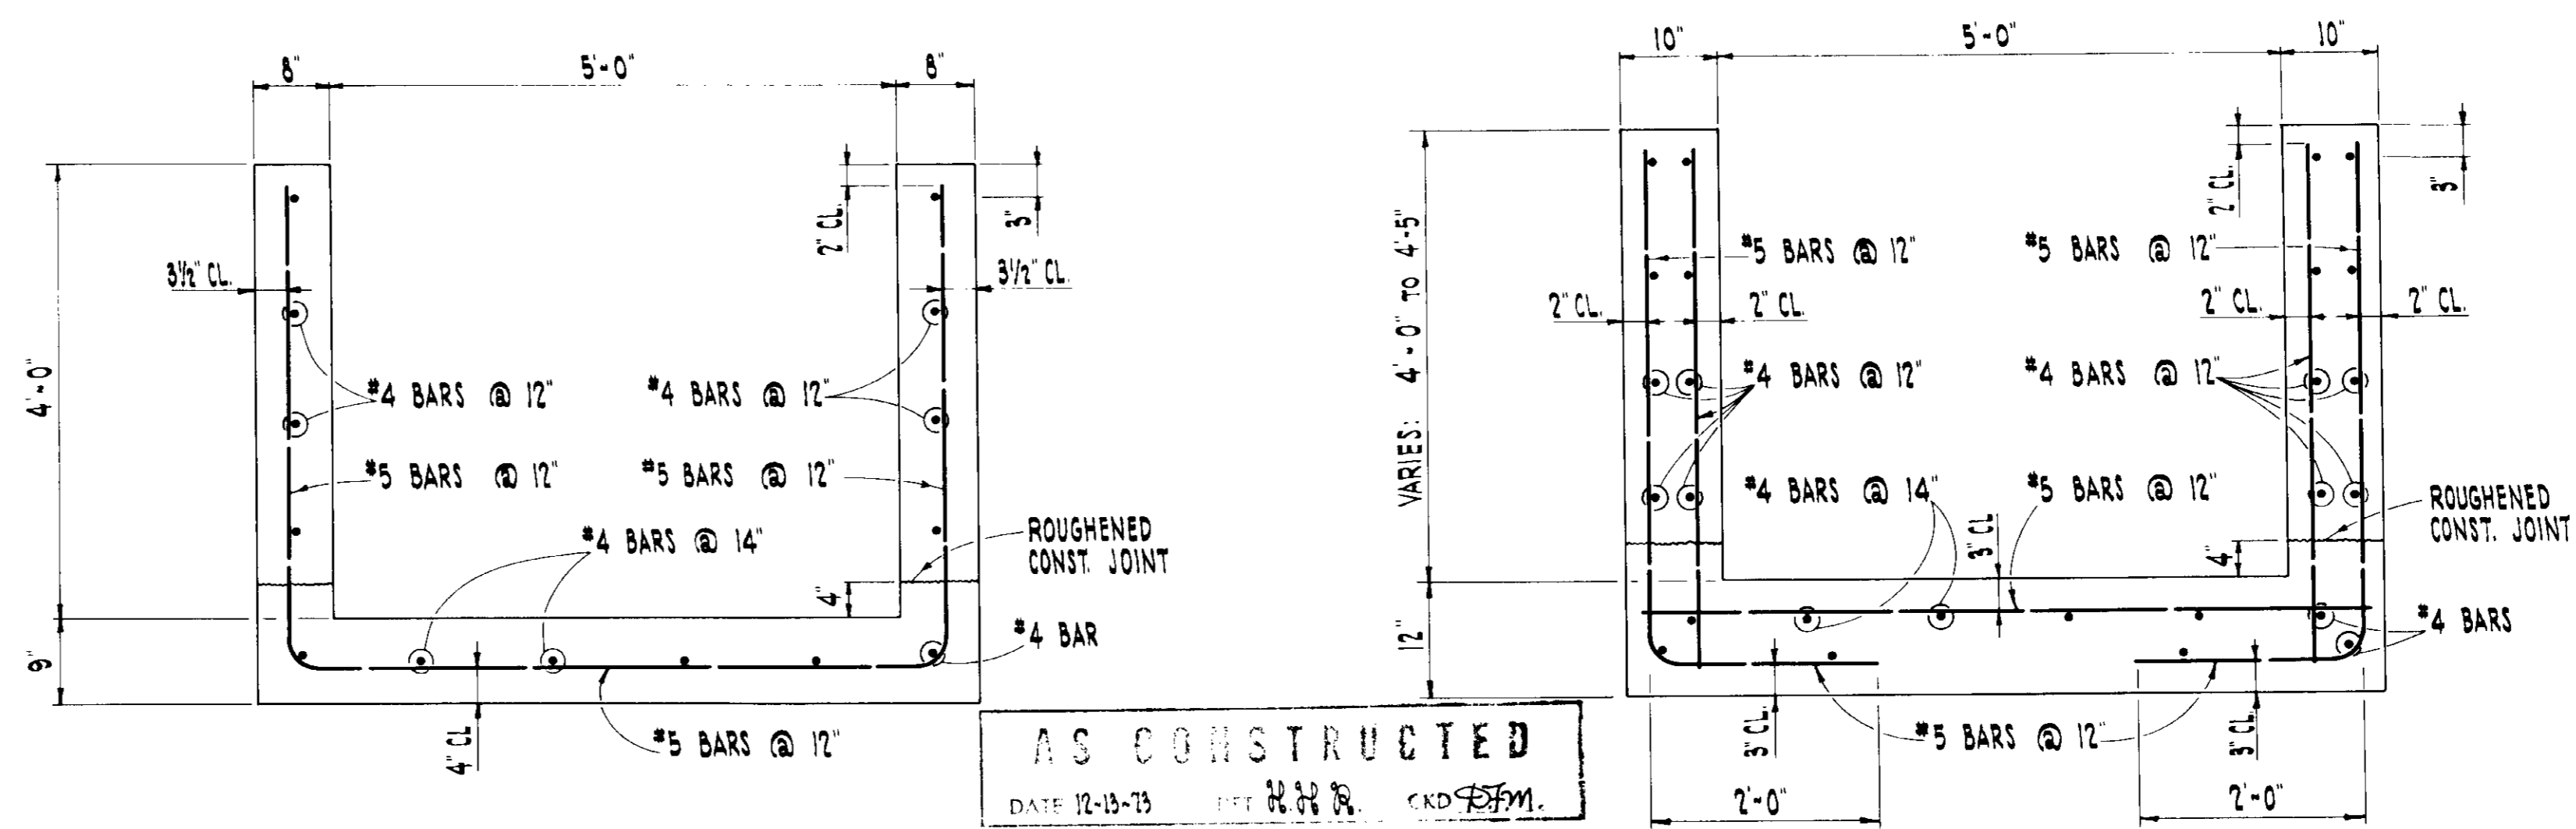


**TYPICAL CHANNEL SECTION**  
 STA. 0+95.00 TO STA. 2+70  
 SCALE: 3/4" = 1'-0"


**TYPICAL CHANNEL SECTION**  
 STA. 2+70 TO STA. 2+76.75  
 SCALE: 3/4" = 1'-0"

REFERENCE DRAWINGS


32 CONCRETE OUTLINES

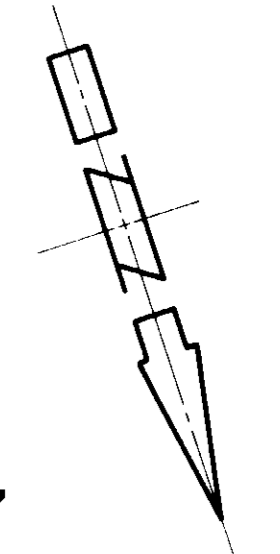

05297

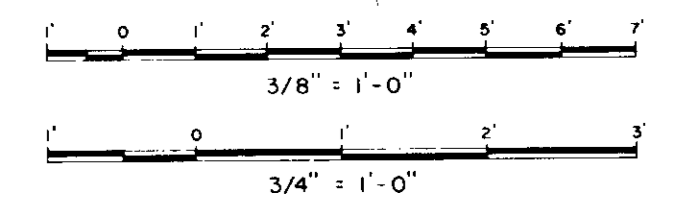


ISSUED FOR CONSTRUCTION		DATE: 11-70		JOB: WESTLAKE RESERVOIR	
NO.	DATE	REVISIONS	BY	CHK	PROJ. ENGR.
<b>LAS VIRGENES MUNICIPAL WATER DISTRICT</b>					
BOYLE ENGINEERING W. A. WAHLER & ASSOCIATES					
WESTLAKE RESERVOIR <b>SPILLWAY</b>					
REINFORCING - SHEET 2 OF 2					
DESIGNED	DATE	CHECKED	DATE	PROJ. ENGR.	REV.
DRWN	11-70	CHKD	11-70	W.A. WAHLER	1
CHECKED		DRN			
SCALE AS SHOWN				DRAWING NUMBER	REV.
				34	

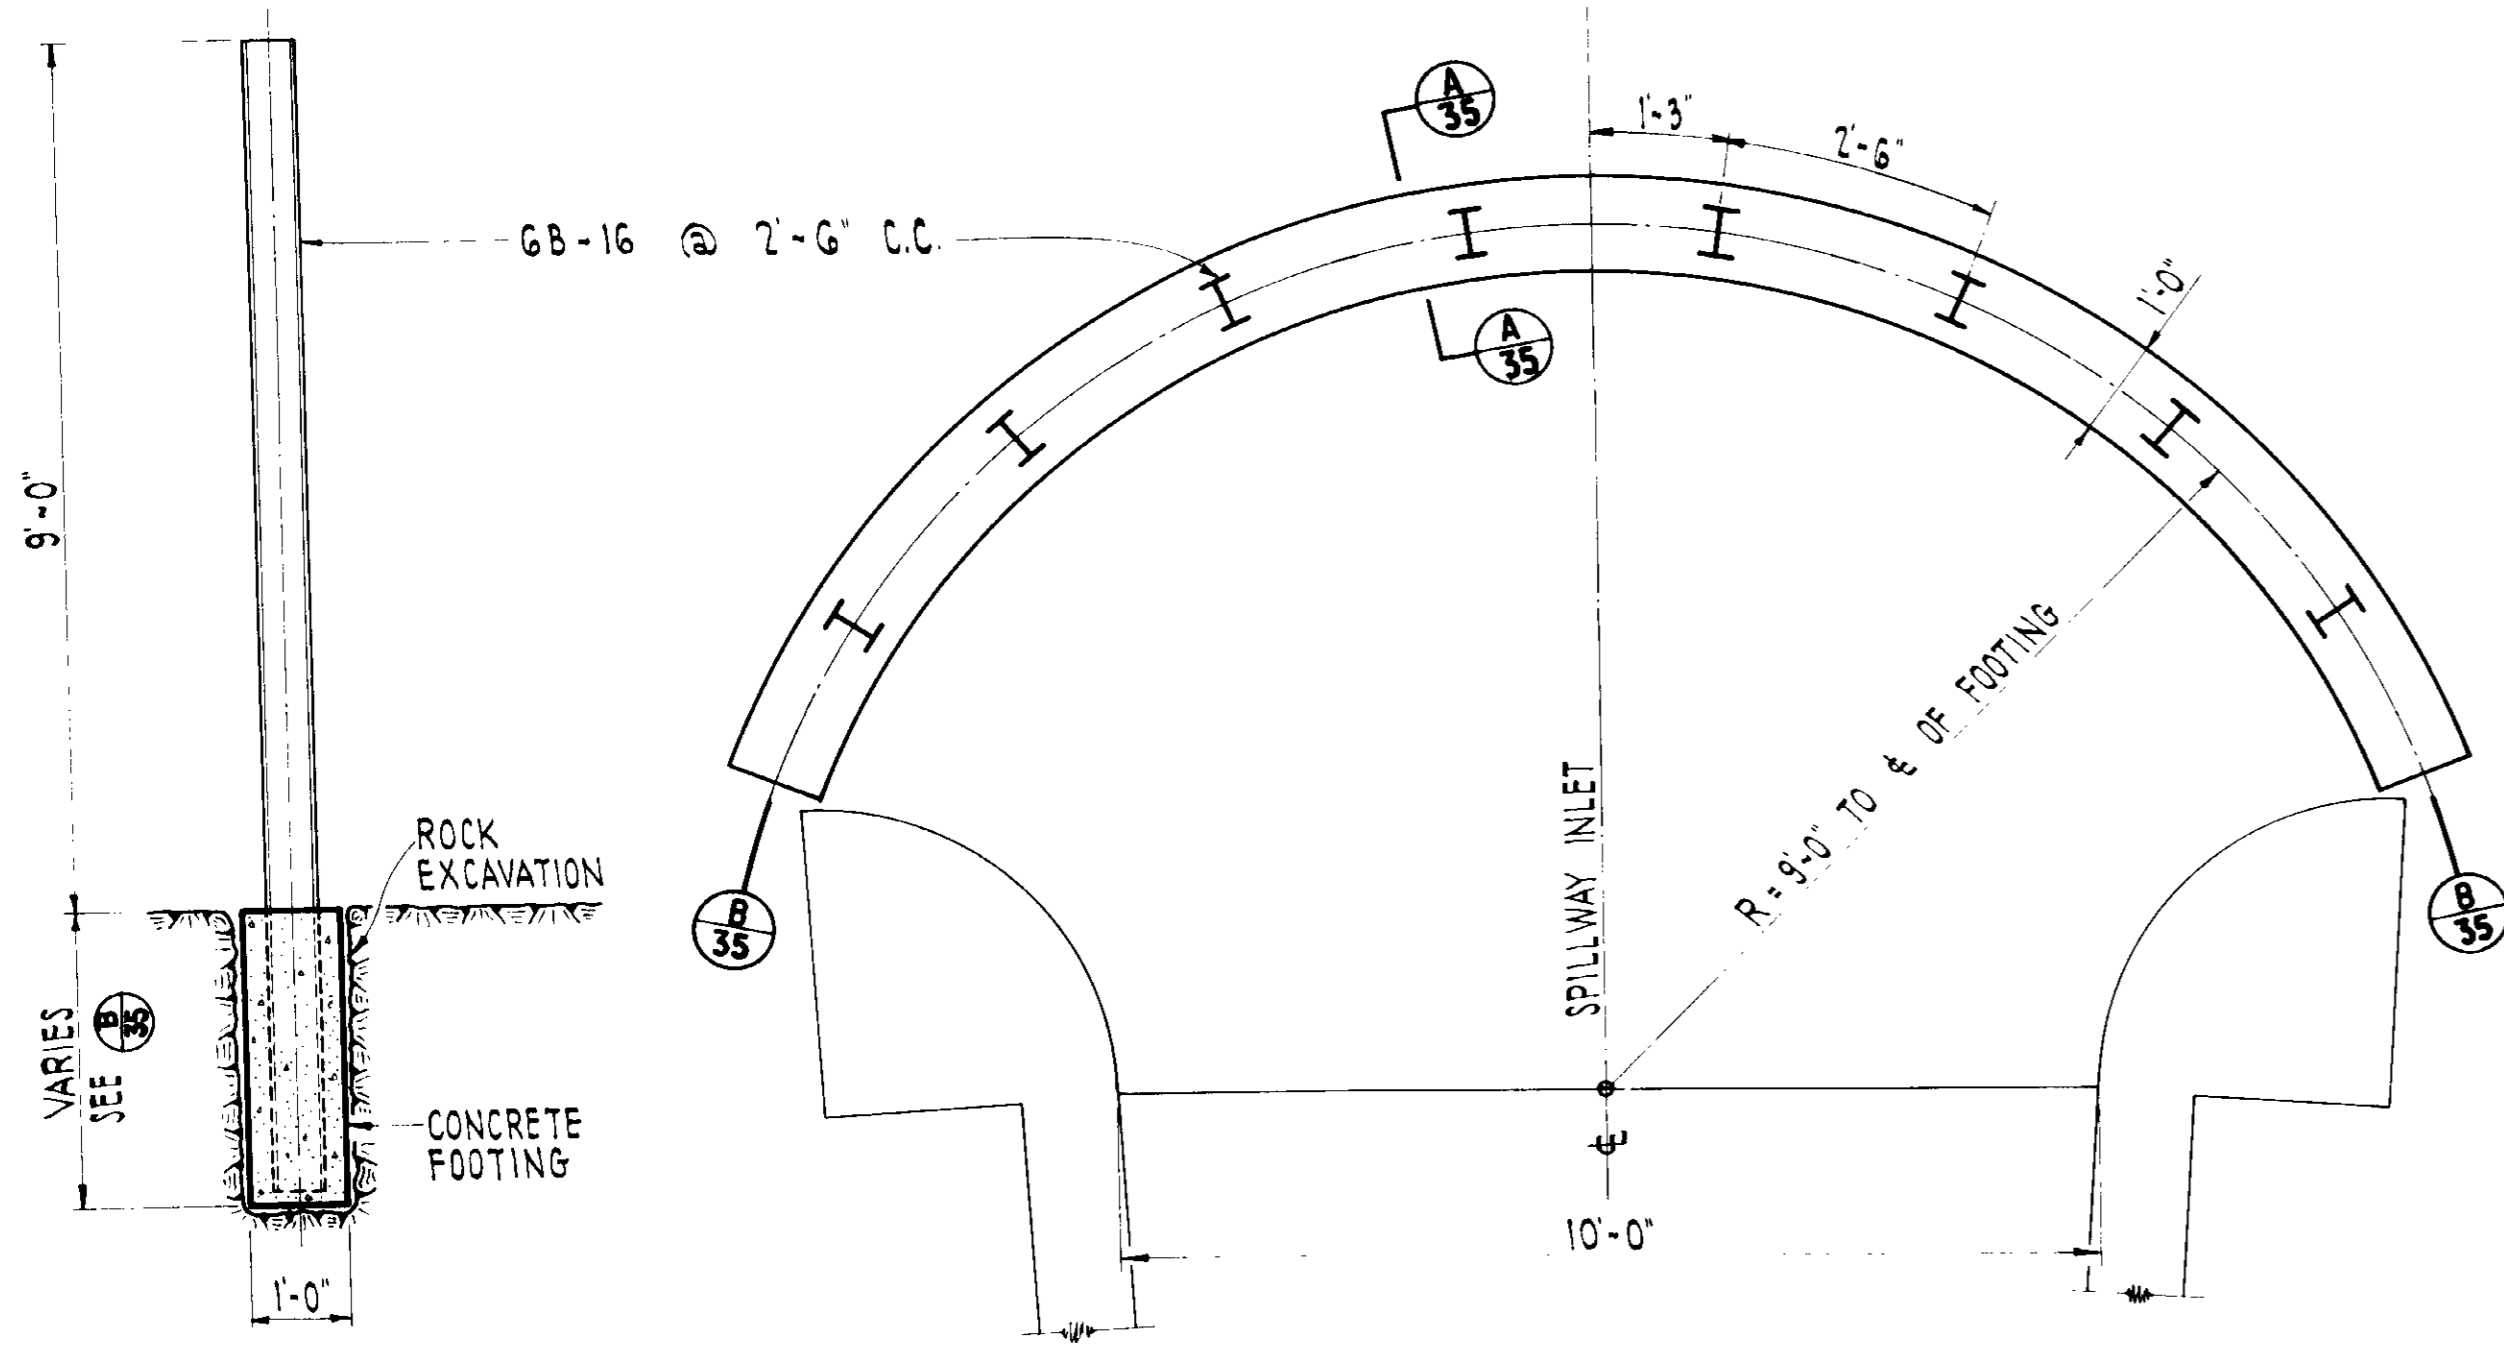

SECTION **A**


PLAN

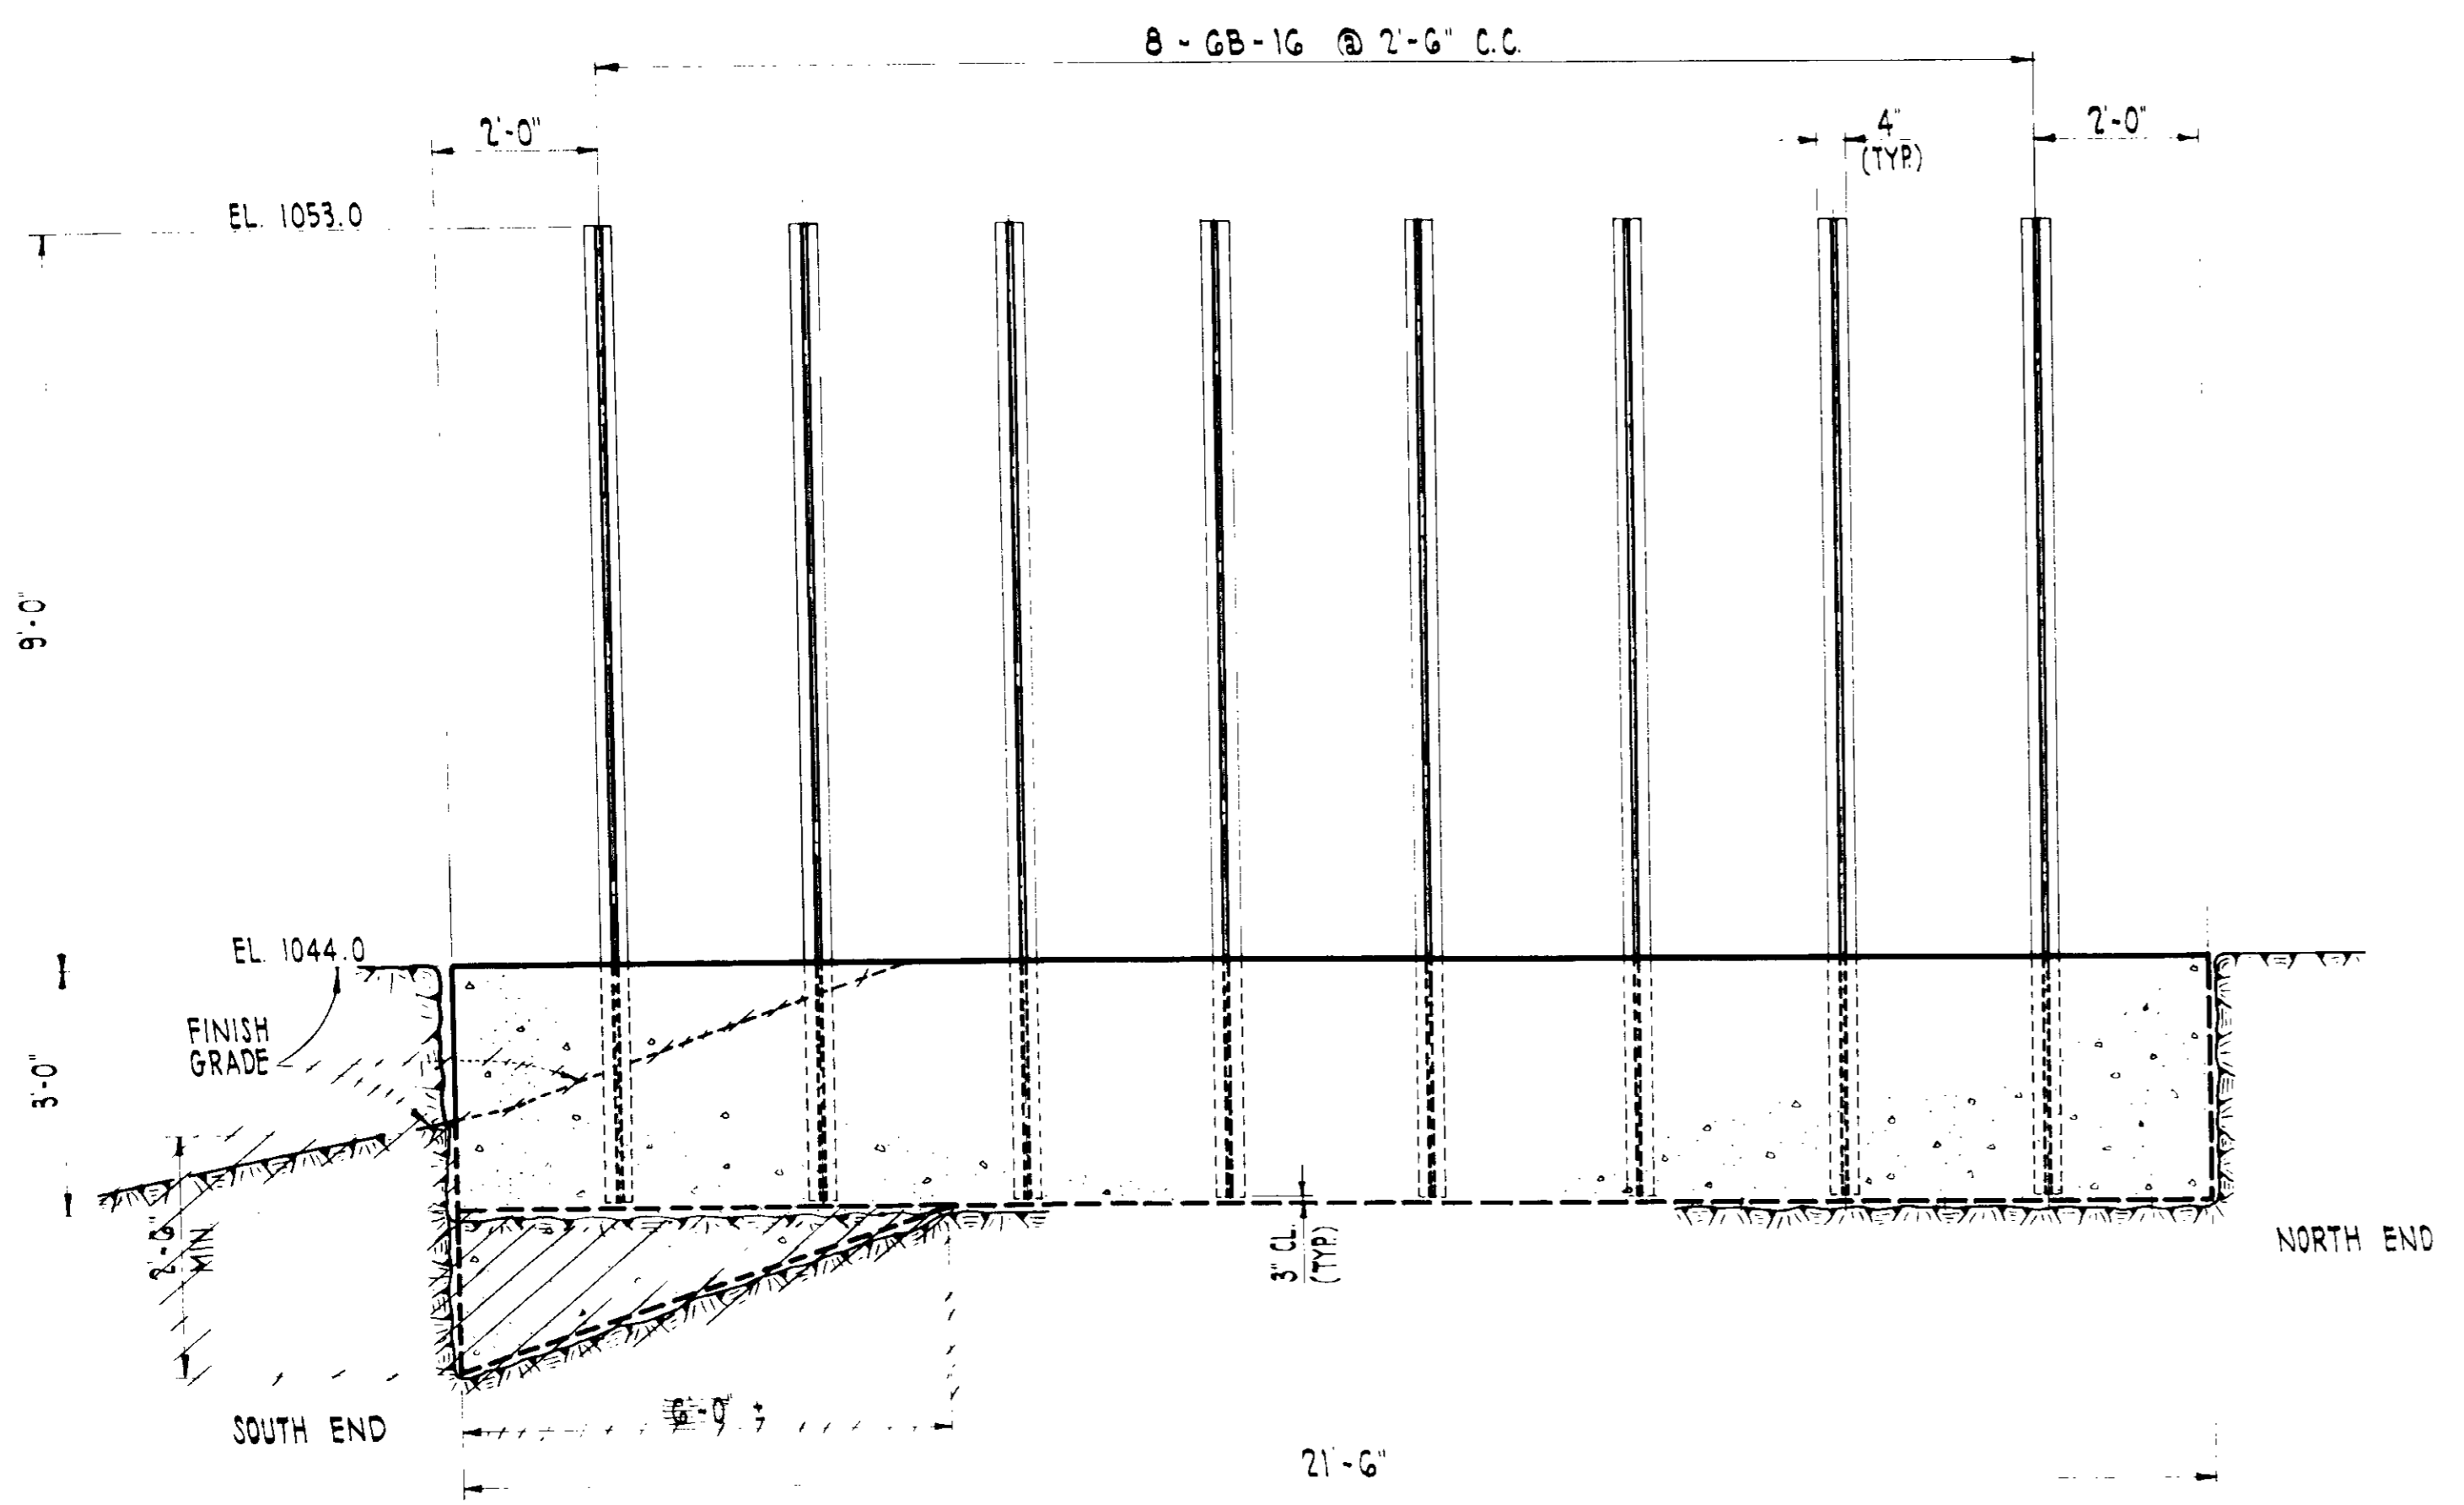

SECTION **B**  
**TRASH BARRIER** ~ **DETAIL**  
 SCALE: 1/2" = 1'-0"

REFERENCE DRAWINGS

30 GENERAL LAYOUT

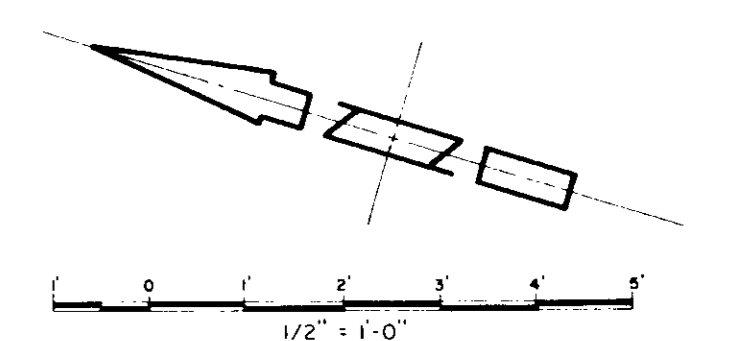

05298

NO.	DATE	REVISIONS	BY	CHK	JOB ENG.	PROJ. ENG.	MAN. GR.
1	4/25/73	ISSUED FOR CONSTRUCTION	W.A.W.	W.A.W.	W.A.W.	W.A.W.	W.A.W.

LAS VIRGENES MUNICIPAL WATER DISTRICT

BOYLE ENGINEERING  
 W. A. WAHLER & ASSOCIATES

WESTLAKE RESERVOIR  
 SPILLWAY

TRASH BARRIER DETAILS

**AS CONSTRUCTED**  
 DATE: 4/25/73 DFT: W.A.W. CKD: W.A.W.

DESIGNED: W.A.W.	DATE: 11-70	JOB ENG.: W.A.W.	PROJ. ENG.: W.A.W.
DRAWN: W.A.W.	CHECKED: W.A.W.	SCALE AS SHOWN	DRAWING NUMBER: 35