

01872-01

NO.	DATE	DESCRIPTION	BY
A	12-30-85	PLOTTED METERS PER FIELD MEASUREMENTS.	AD

**LAS VIRGENES
MUNICIPAL WATER DISTRICT**

**HIDDEN HILLS WATER PLANS
JED SMITH & ROUND MEADOW**

PREPARED BY
LVM.W.D. ENGINEERING DEPT.
4232 LAS VIRGENES RD.
CALABASAS CALIF

APPROVED FOR LAS VIRGENES
MUNICIPAL WATER DISTRICT


DATE: SEPT. 8, 78

BY: _____ CHIEF ENGR
DATE: _____ RCE 9555

NO.	DATE	DESCRIPTION	SCALE	DATE APP'D	TRACT	DWG NO
1		MODIFICATIONS PER JED SMITH PIPELINE IMPROVEMENTS	1" = 40'			SHEET 16 OF 32

SEE JED SMITH PIPELINE IMPROVEMENTS (SHT. 3 & DET. 'A')

DETAIL 'A'

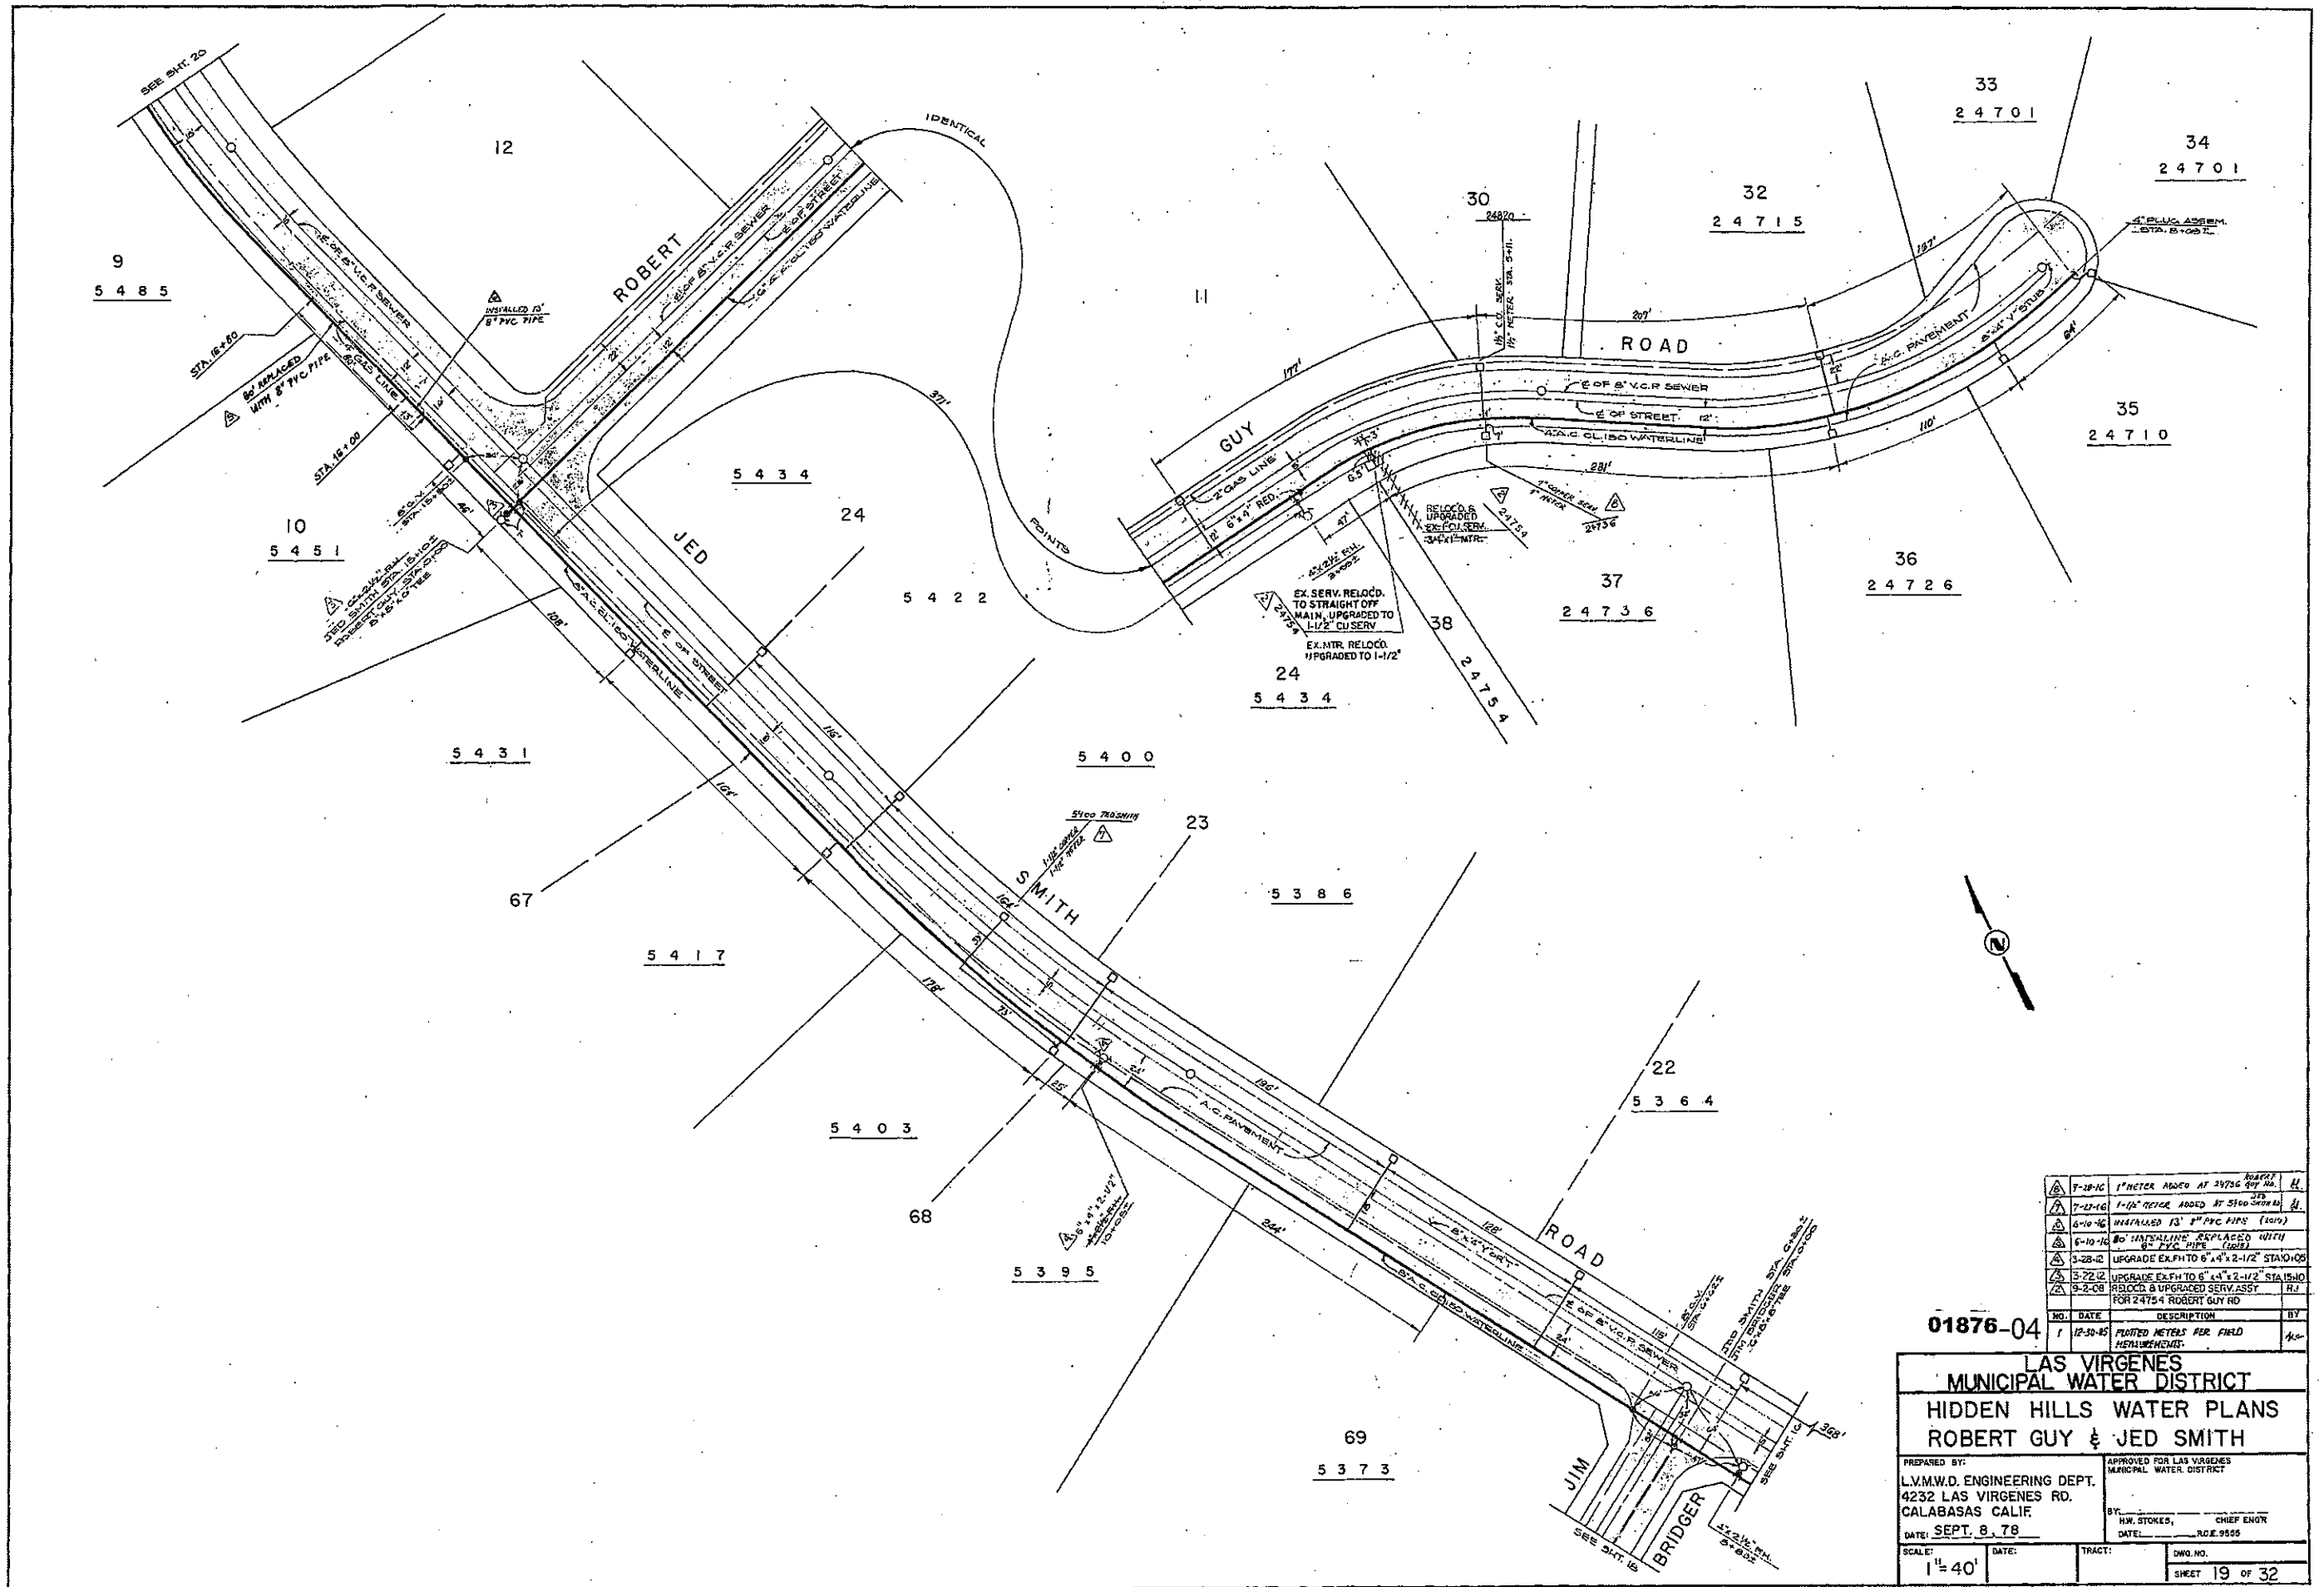

7-18-10	1" METER ADDED AT 24736 497' RD.	HJ
7-11-10	1-1/2" METER ADDED AT 5100 3474' RD.	HJ
6-10-10	INSTALLED 13" PVC PIPE (100')	HJ
6-10-10	8" WATERLINE REPLACED WITH 8" PVC PIPE (100')	HJ
3-28-10	UPGRADE EX.FH TO 6" 4" x 2-1/2" STA 1510	HJ
3-22-10	UPGRADE EX.FH TO 6" 4" x 2-1/2" STA 1510	HJ
9-2-08	RELOC. & UPGRADE SERV. ASSY FOR 24754 ROBERT GUY RD	HJ

NO.	DATE	DESCRIPTION	BY
1	12-30-85	PLOTTED METERS PER FIELD MEASUREMENTS	HJ

01876-04

LAS VIRGENES MUNICIPAL WATER DISTRICT

HIDDEN HILLS WATER PLANS

ROBERT GUY & JED SMITH

PREPARED BY:
L.V.M.W.D. ENGINEERING DEPT.
4232 LAS VIRGENES RD.
CALABASAS CALIF.


APPROVED FOR LAS VIRGENES MUNICIPAL WATER DISTRICT

BY: H.W. STOKES, CHIEF ENGR
DATE: SEPT. 8, 78

SCALE: 1" = 40'

DATE: _____ TRACT: _____ DWG. NO. _____

SHEET 19 OF 32

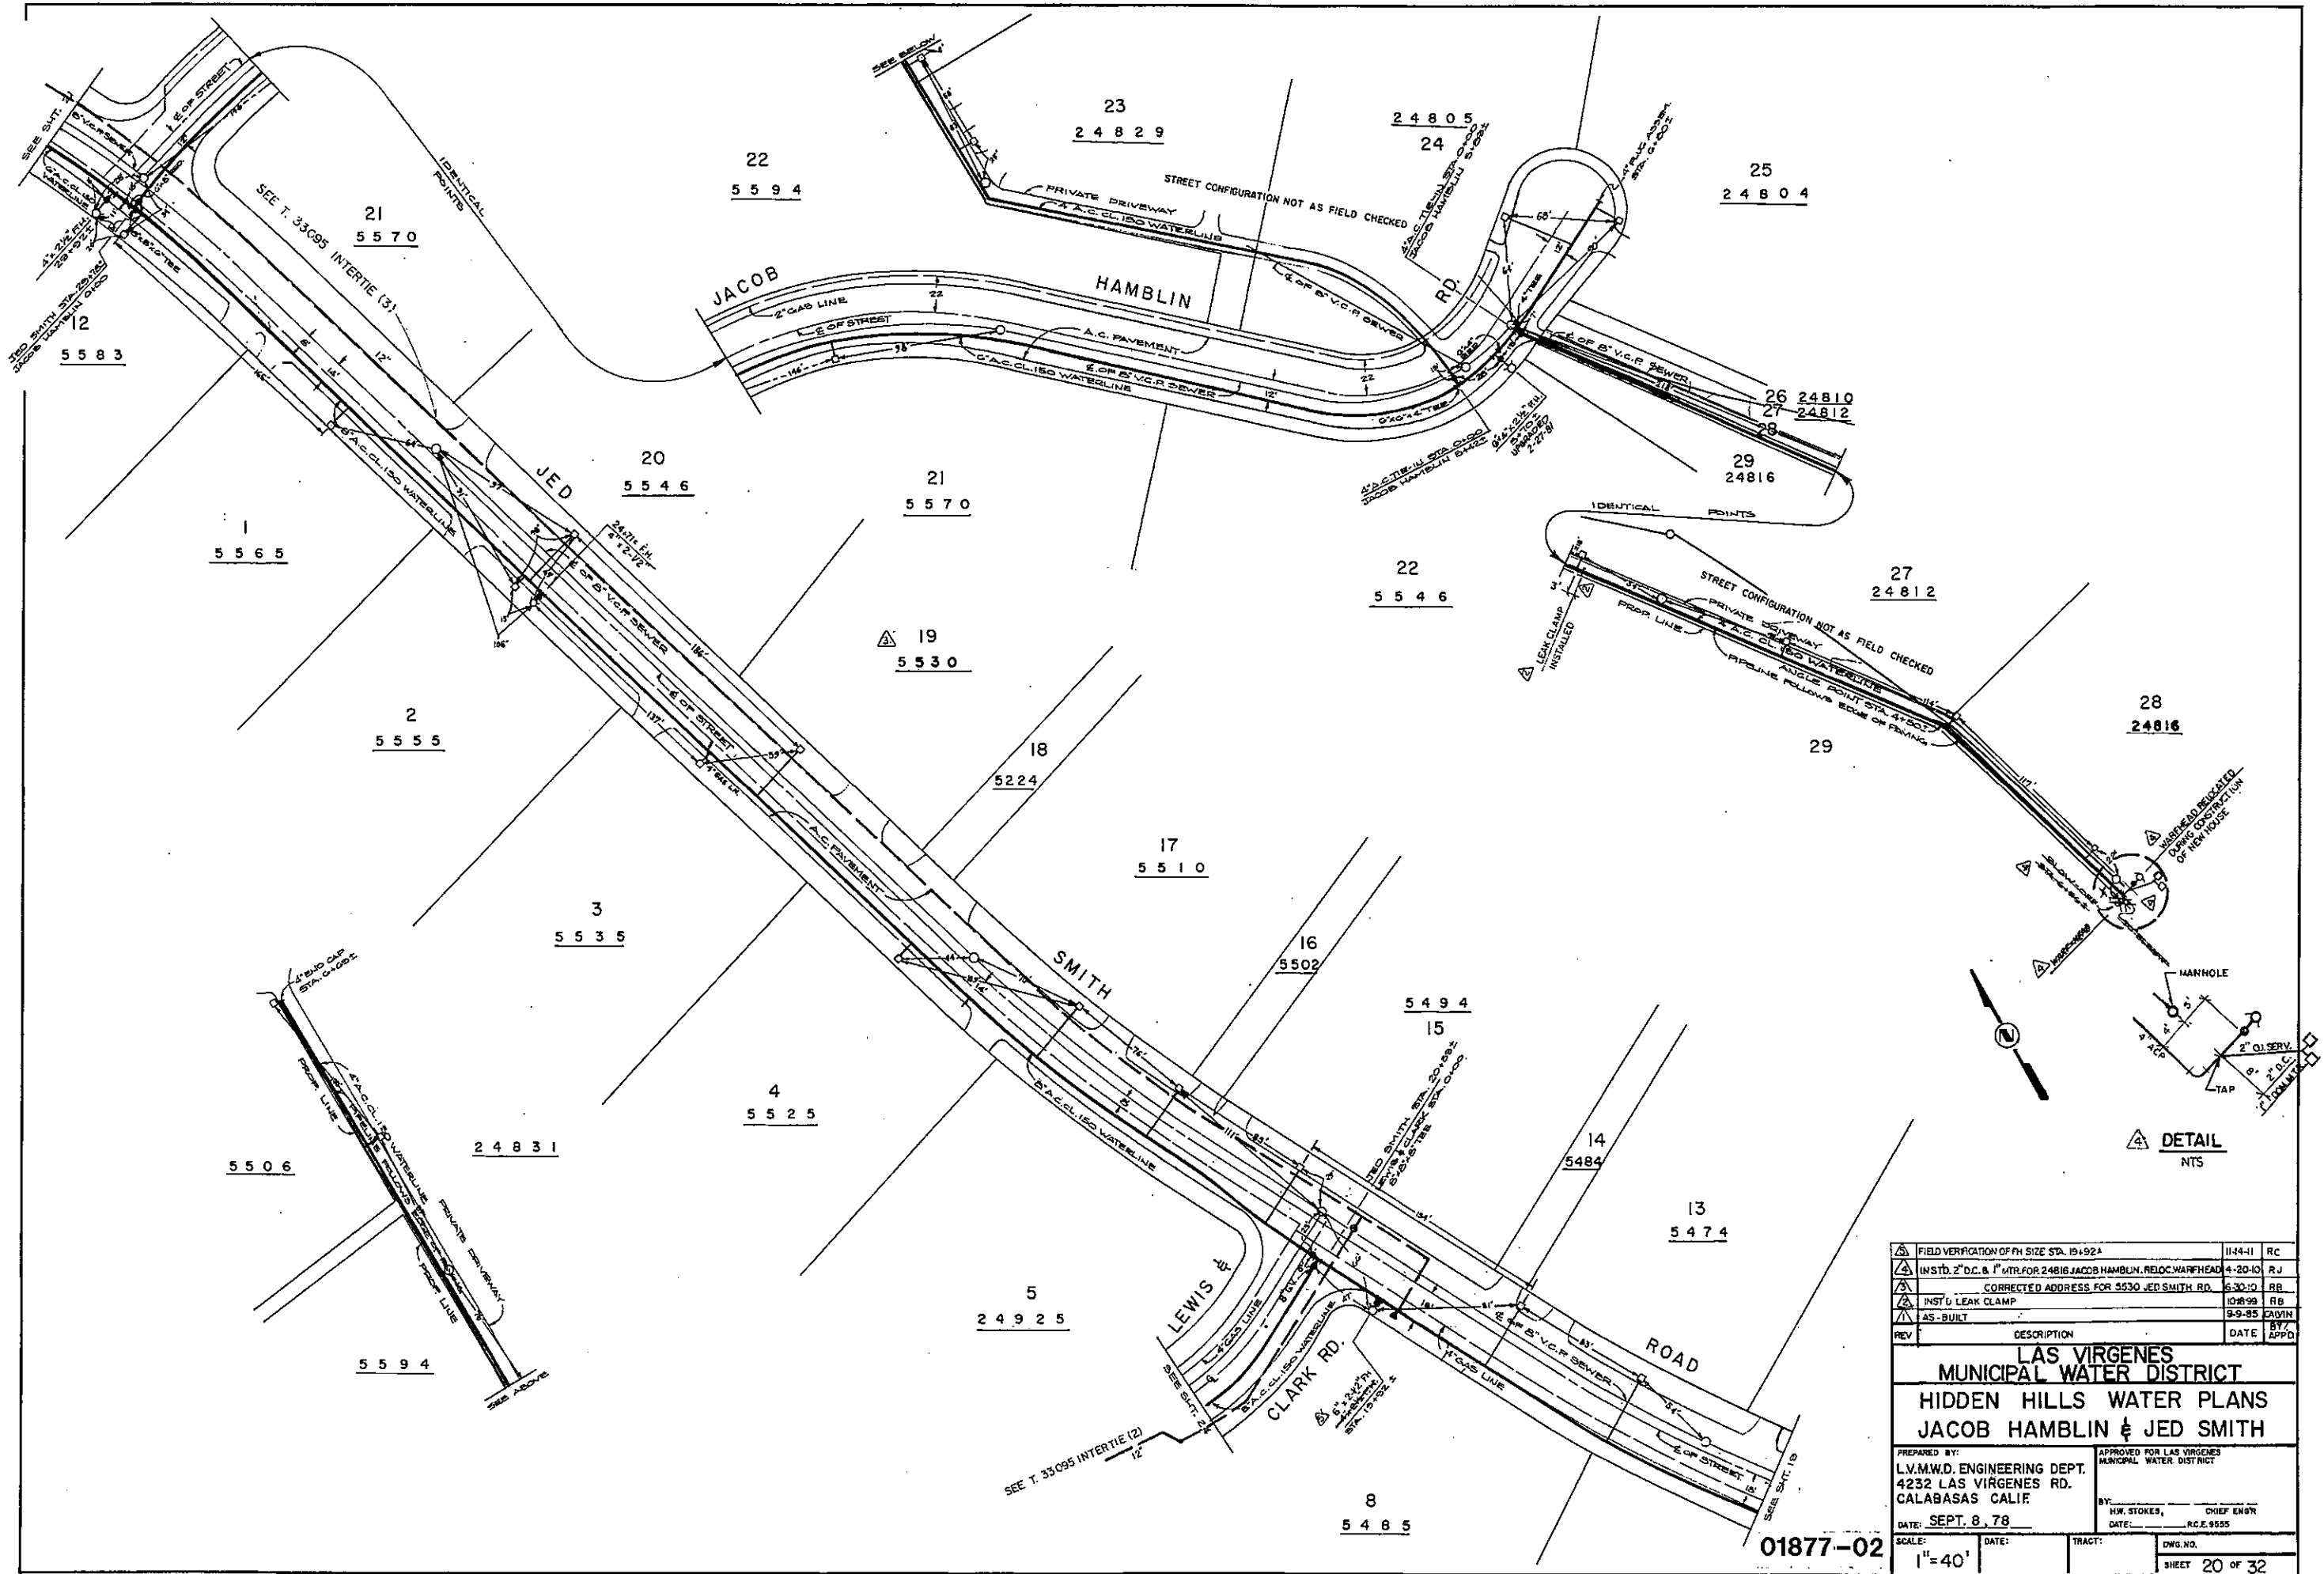

4 DETAIL
NTS

FIELD VERIFICATION OF FH SIZE STA. 19+92.4	11-44-11	RC
INST'D 2" D.C. & 1" MTR. FOR 24816 JACOB HAMBLIN RELOC. W/RELOC. 4-20-10	4-20-10	RJ
CORRECTED ADDRESS FOR 5530 JED SMITH RD.	6-30-10	RB
INST'D LEAK CLAMP	10-18-99	RB
AS-BUILT	9-9-85	CVIN
REV	DESCRIPTION	DATE
LAS VIRGENES MUNICIPAL WATER DISTRICT HIDDEN HILLS WATER PLANS JACOB HAMBLIN & JED SMITH		
PREPARED BY: LV.M.W.D. ENGINEERING DEPT. 4232 LAS VIRGENES RD. CALABASAS CALIF.	APPROVED FOR LAS VIRGENES MUNICIPAL WATER DISTRICT	
DATE: SEPT. 8, 78	BY: HW. STOKES, CHIEF ENGR	DATE: R.C.E. 9555
SCALE: 1" = 40'	TRACT:	DWG. NO. SHEET 20 OF 32

01877-02